

## Designation: **OSO-C-91**

Date Destroyed:

Date Revised: 5/10/1999

GPS #:

OCS Index Map: Q17-08


Page/Grid: 922/F-4

City / Location: Unin., Orange Co.

Line #/SSN: 378/0090

Established By: OCS 1991

Monument Type: Orange County Surveyor's 3 3/4"  
Aluminum Disk

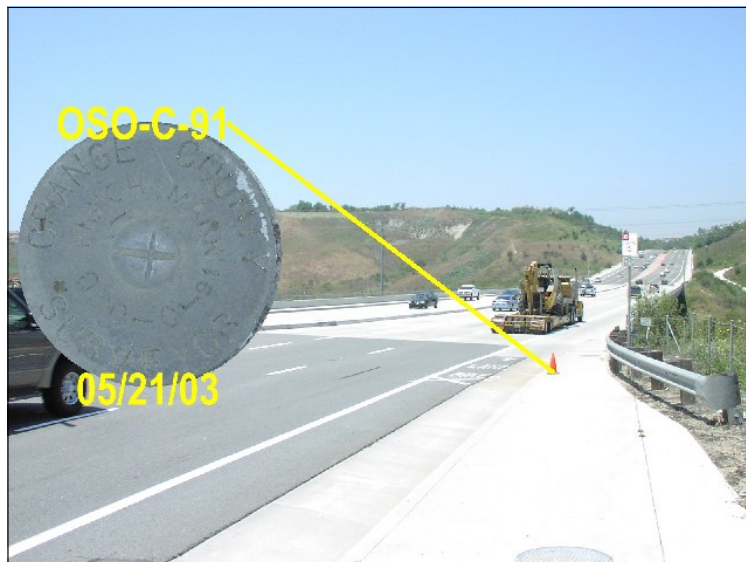

NAVD88 (ft)	NGVD29 (ft)	Year Leveled
542.422	540.076	1999
542.395	539.949	1991

For Reconnaissance Only!	
Latitude (30' +/-)	Longitude (30' +/-)
33 35 04.27	117 38 03.89

### Description:

DESCRIBED BY OCS 2003 - FOUND 3 3/4" OCS ALUMINUM BENCHMARK DISK STAMPED "OSO-C-91", SET IN THE SOUTHEASTERLY CORNER OF A 5 FT. BY 20 FT. CONCRETE CATCH BASIN. MONUMENT IS LOCATED IN THE NORTHEASTERLY CORNER OF THE INTERSECTION OF OSO PARKWAY AND ITS OVERCROSSING OF TRABUCO CREEK, 40 FT. EASTERLY OF THE EASTERLY ABUTMENT OF THE BRIDGE AND 46 FT. NORTHERLY OF THE CENTERLINE OF OSO PARKWAY. MONUMENT IS SET LEVEL WITH THE SIDEWALK.

