

Designation: SA-189-70

Date Destroyed:

Date Revised:

GPS #:

OCS Index Map: Q06-12


Page/Grid: 799/B-5

City / Location: Garden Grove

Line #/SSN: 700/0070

Established By: OCS 1970

Monument Type: Orange County Surveyor's 3 3/4"
Aluminum Disk

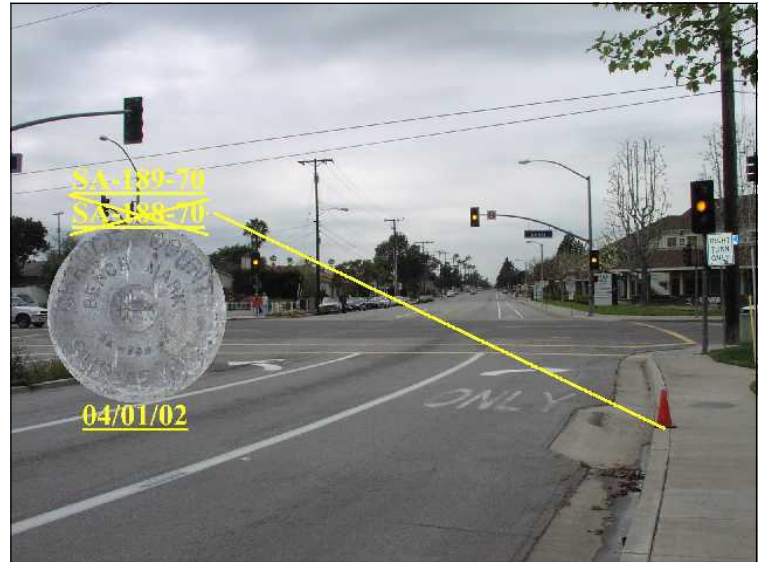

NAVD88 (ft)	NGVD29 (ft)	Year Leveled
123.448	121.030	2010
123.562	121.119	1992

For Reconnaissance Only!	
Latitude (30' +/-)	Longitude (30' +/-)
33 46 54.40	117 53 49.77

Description:

DESCRIBED BY OCS 2002 - FOUND 3 3/4" OCS ALUMINUM BENCHMARK DISK STAMPED "SA-189-70", SET IN THE SOUTHEASTERLY CORNER OF A 5 FT. BY 8 FT. CONCRETE CATCH BASIN. MONUMENT IS LOCATED IN THE NORTHEASTERLY CORNER OF THE INTERSECTION OF LEWIS STREET AND LAMPSON AVENUE, 37.5 FT. WESTERLY OF THE CENTERLINE OF LAMPSON AND 64 FT. EASTERLY OF THE PROLONGATION OF THE EAST CURB ALONG LEWIS. MONUMENT IS SET LEVEL WITH THE SIDEWALK.

