

## VERTICAL CONTROL DATA SHEET O.C.S. 1995 ADJUSTMENT



## **Designation: SA-237-70**

**Date Destroyed:** 

Date Revised:

GPS #:

OCS Index Map: Q06-16 Page/Grid: 799/E-6 City / Location: Santa Ana

Line #/SSN: 402/0640 Established By: OCS 1970

Monument Type: Orange County Surveyor's 3 3/4"


**Aluminum Disk** 

NAVD88 (ft)	NGVD29 (ft)	Year Leveled
133.484	131.065	2010
133.569	131.132	1990

NAVD88 (ft)	NGVD29 (ft)	Year Leveled
133.484	131.065	2010
133.569	131.132	1990

## **Description:**

DESCRIBED BY OCS 2002 - FOUND 3 3\4" OCS **ALUMINUM BENCHMARK DISK STAMPED "SA-237-**70", SET IN THE NORTHWEST CORNER OF A 3.5 FT. BY 11 FT. CONCRETE CATCH BASIN. MONUMENT IS LOCATED IN THE SOUTHEAST CORNER OF THE INTERSECTION OF MEMORY LANE AND FLOWER STREET, 40 FT. SOUTHERLY OF THE CENTERLINE OF MEMORY LANE AND 29 FT. EASTERLY OF THE CENTERLINE OF FLOWER STREET. MONUMENT IS SET LEVEL WITH THE SIDEWALK.

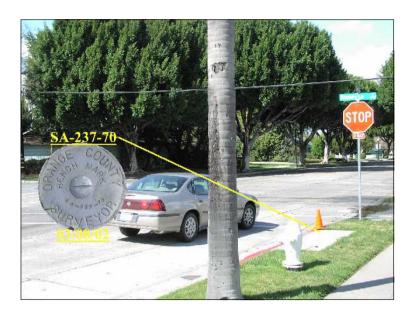

For Reconnaisance Only!		
Latitude (30' +/-)	Longitude (30' +/-)	
33 46 22.72	117 52 33.30	

