

Designation: SA-281-75

Date Destroyed:

Date Revised:

GPS #:

OCS Index Map: Q07-09


Page/Grid: 799/F-4

City / Location: Orange

Line #/SSN: 700/0010

Established By: OCS 1975

Monument Type: Orange County Surveyor's 3 3/4"
Aluminum Disk

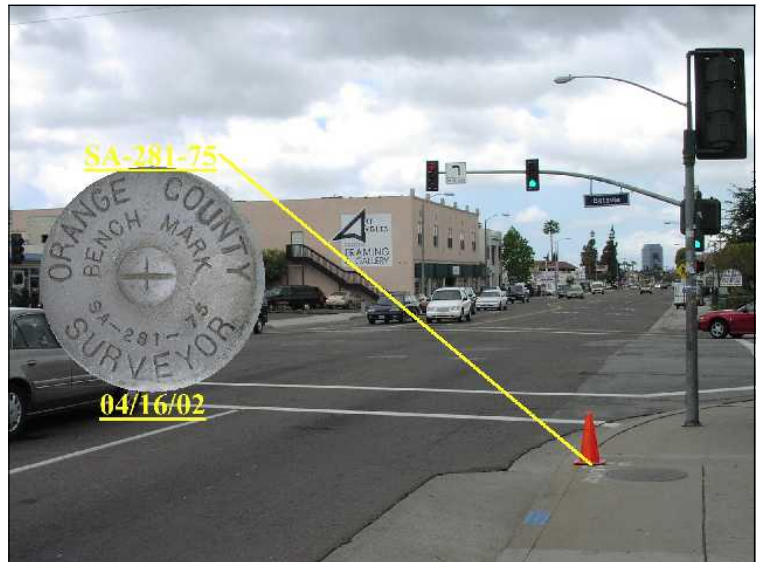

NAVD88 (ft)	NGVD29 (ft)	Year Leveled
171.689	169.261	2010
171.706	169.273	1990

For Reconnaissance Only!	
Latitude (30' +/-)	Longitude (30' +/-)
33 47 16.69	117 51 41.75

Description:

DESCRIBED BY OCS 2002 - FOUND 3 3/4" OCS ALUMINUM BENCHMARK DISK STAMPED "SA-281-75", SET IN THE SOUTHWEST CORNER OF A 4 FT. BY 15 FT. CONCRETE CATCH BASIN. MONUMENT IS LOCATED IN THE NORTHEASTERLY CORNER OF THE INTERSECTION OF BATAVIA STREET AND CHAPMAN AVENUE, 66 FT. EASTERLY OF THE CENTERLINE OF BATAVIA AND 32.5 FT. NORTHERLY OF THE CENTERLINE OF CHAPMAN. MONUMENT IS SET LEVEL WITH THE SIDEWALK.

