

## Designation: SA-299-82

Date Destroyed:

Date Revised:

GPS #:

OCS Index Map: Q06-16


Page/Grid: 829/B-2

City / Location: Santa Ana

Line #/SSN: 161/0210

Established By: OCS 1982

Monument Type: Orange County Surveyor's 3 3/4"  
Aluminum Disk

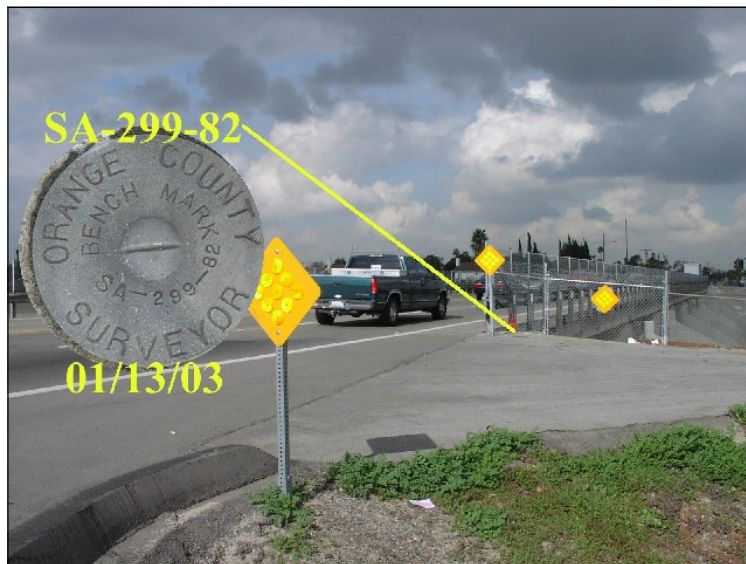

NAVD88 (ft)	NGVD29 (ft)	Year Leveled
102.196	99.781	2010
102.353	99.914	1991

For Reconnaissance Only!	
Latitude (30' +/-)	Longitude (30' +/-)
33 45 23.06	117 54 09.82

### Description:

DESCRIBED BY OCS 2001 - FOUND 3 3/4" OCS ALUMINUM BENCHMARK DISK STAMPED "SA-299-82", SET ON THE TOP OF A CONCRETE BRIDGE ABUTMENT. MONUMENT IS LOCATED ON THE SOUTHEAST CORNER OF THE FAIRVIEW ROAD BRIDGE AT THE SANTA ANA RIVER, 28.7' EASTERLY OF FAIRVIEW ROAD CENTERLINE, LEVEL WITH THE TOP OF THE BRIDGE DECK.

