Vertical Control Data Sheet
O.C.S. 1995 Adjustment

Designation: SA-331-99

Date Destroyed:
Date Revised: 5/3/1999
GPS #:
OCS Index Map: Q11-04
Page/Grid: 829/C-6
City / Location: Santa Ana

Line #/SSN: 724/0100
Established By: OCS 1999
Monument Type: Orange County Surveyor's 3 3/4" Aluminum Disk

NAVD88 (ft)	NGVD29 (ft)	Year Leveled
57.047	54.636	2010
57.259	54.823	1999

For Reconnaisance Only!	
Latitude (30' +/-)	Longitude (30' +/-)
33 43 38.33	117 53 37.97
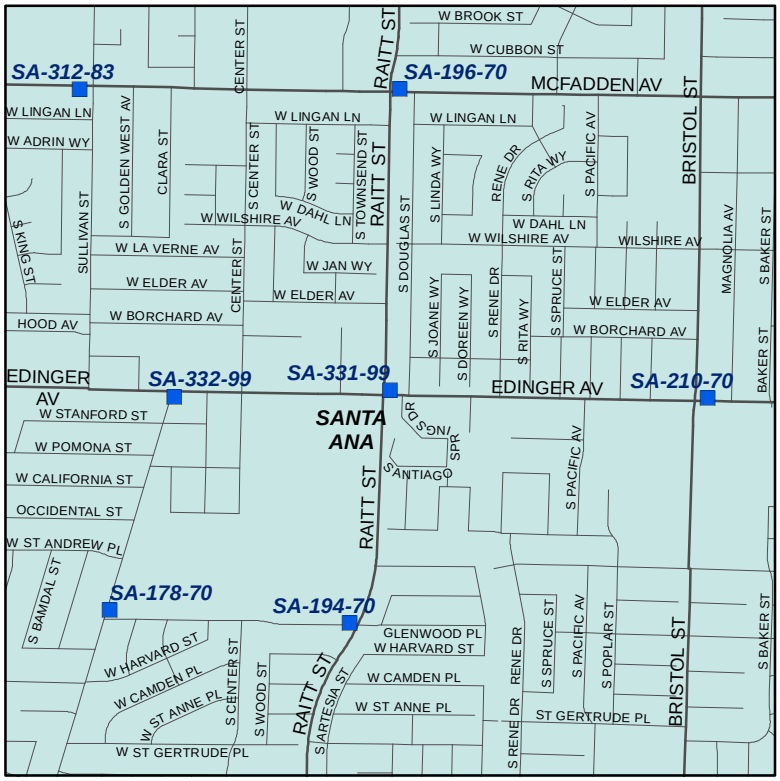
Description:
DESCRIBED BY OCS 2001 - FOUND 3 3\4" OCS ALUMINUM BENCHMARK DISK STAMPED "SA-331-99", SET ON THE WESTERLY END OF A CONCRETE FLOOD CONTROL CHANNEL WALL. MONUMENT IS LOCATED ON THE NORTHEAST CORNER OF THE INTERSECTION OF RAITT STREET AND EDINGER AVENUE, 40FT. NORTHERLY OF THE CENTERLINE OF EDINGER AVENUE AND 60FT. EASTERLY OF THE CENTERLINE OF RAITT STREET. MONUMENT IS UP 0.5FT. ABOVE SIDEWALK.