Vertical Control Data Sheet
O.C.S. 1995 Adjustment

Designation: SA-332-99

Date Destroyed:
Date Revised: 5/3/1999
GPS #:
OCS Index Map: Q11-04
Page/Grid: 829/B-6
City / Location: Santa Ana

Line #/SSN: 724/0110
Established By: OCS 1999
Monument Type: Orange County Surveyor's 3 3/4" Aluminum Disk

NAVD88 (ft)	NGVD29 (ft)	Year Leveled
57.559	55.148	2010
57.777	55.342	1999

For Reconnaisance Only!	
Latitude (30' +/-)	Longitude (30' +/-)
33 43 37.51	117 54 00.24
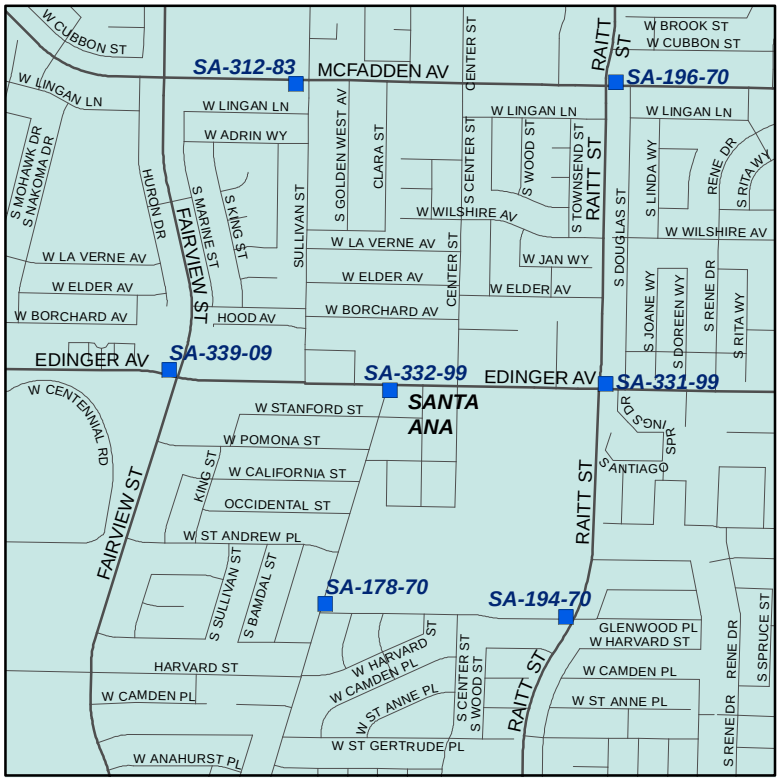
Description:
DESCRIBED BY OCS 2001 - FOUND 3 3\4" OCS ALUMINUM BENCHMARK DISK STAMPED "SA-332-99", SET IN THE FOOTING OF A TRAFFIC SIGNAL LOCATED ON THE SOUTHEAST CORNER OF THE INTERSECTION OF GREENVILLE STREET AND EDINGER AVENUE, 50FT. SOUTHERLY OF THE CENTERLINE OF EDINGER AVENUE, AND 35FT. EASTERLY OF THE CENTERLINE OF GREENVILLE STREET. MONUMENT IS SET LEVEL WITH THE SIDEWALK.