Vertical Control Data Sheet
O.C.S. 1995 Adjustment

Designation: SA-339-09

Date Destroyed:

Date Revised:

GPS #:

OCS Index Map: Q11-04

Page/Grid: 829/A6

City / Location: Santa Ana

Line #/SSN: 724

Established By: OCS 2009

Monument Type: Orange County Surveyor's 4" Aluminum Disk

NAVD88 (ft)	NGVD29 (ft)	Year Leveled
56.976	54.565	2010

For Reconnaisance Only!	
Latitude (30' +/-)	Longitude (30' +/-)
33 43 38.9609	117 54 23.0783

Description:
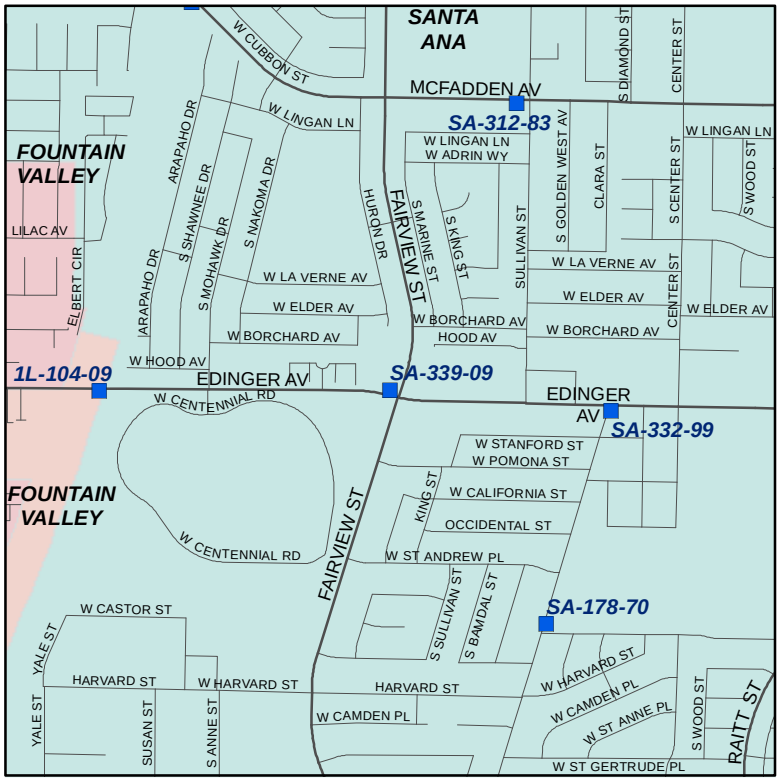
DESCRIBED BY OCS 2009 - FOUND 4" OCS ALUMINUM BENCHMARK DISK STAMPED "SA-339-09" SET IN THE SOUTHWESTERLY CORNER OF A 4' BY 10' CONCRETE CATCH BASIN. MONUMNET IS LOCATED IN THE NORTHWESTERLY CORNER OF THE INTERSECTION OF FAIRVIEW RD. AND EDINGER AVE. 42' NORTHERLY OF THE CENTERLINE OF EDINGER AVENUE AND 96' WESTERLY OF THE CENTERLINE OF FAIRVIEW ROAD. MONUMENT IS SET LEVEL WITH THE SIDEWALK.