

Designation: TIDAL-L

Date Destroyed:

Date Revised: 6/27/2011

GPS #:

OCS Index Map: Q11-20


Page/Grid: 919/D-1

City / Location: Newport Beach

Line #/SSN: 406/0130

Established By: USC & GS 1977

Monument Type: Stainless Steel Rod

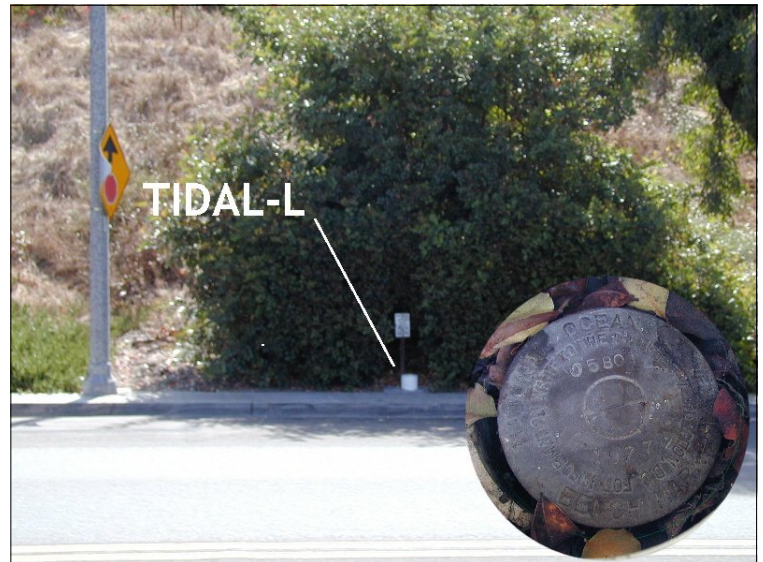

NAVD88 (ft)	NGVD29 (ft)	Year Leveled
20.823	18.473	2011
20.797	18.466	1994

For Reconnaissance Only!	
Latitude (30' +/-)	Longitude (30' +/-)
33 36 20.88	117 53 01.63

Description:

RECOVERY NOTE BY OCS 2001 - FOUND 3 3/4" NATIONAL OCEAN SURVEY BENCHMARK BRASS DISK STAMPED "0580L 1977" DOWN 0.5' IN WHITE 8" DIAMETER PVC PIPE WHICH IS UP 0.8' FROM GROUND. MONUMENT IS LOCATED 0.10 MILES SOUTHERLY ALONG BAYSIDE DRIVE FROM ITS INTERSECTION WITH EL PASEO, ON THE OUTSIDE AND NEAR THE SOUTH END OF A CURVE, EAST AND ACROSS THE DRIVE FROM A HOUSE NUMBERED 1645, 22' EAST OF THE DRIVE CENTERLINE, 11' SOUTH OF A STREET LIGHT POLE, 0.7' EAST OF THE EAST EDGE OF A SIDEWALK. THE ROD IS FLUSH WITH GROUND LEVEL AND DRIVEN TO A DEPTH OF 4.9 METERS.

