

Designation: Z-33

Date Destroyed:

Date Revised:

GPS #:

OCS Index Map: Q06-07


Page/Grid: 768/J-5

City / Location: Anaheim

Line #/SSN: 402/0770

Established By: USC & GS 1920

Monument Type: Bronze / Brass Disk

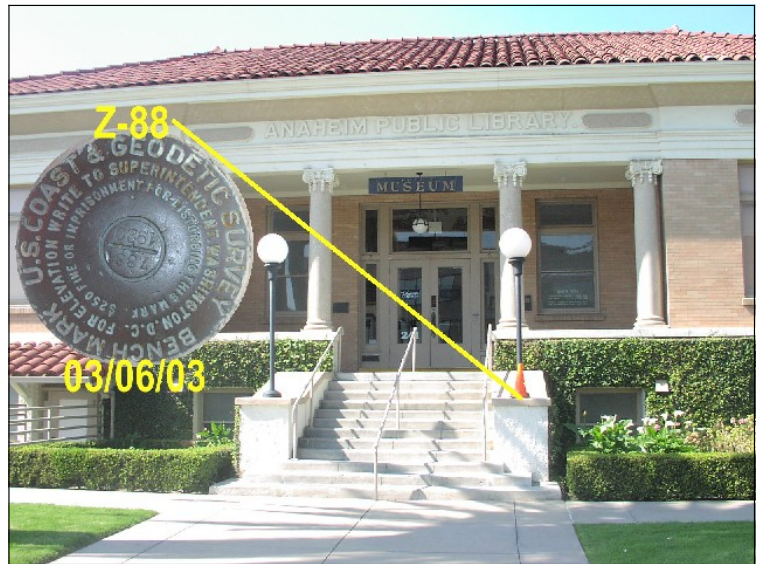

NAVD88 (ft)	NGVD29 (ft)	Year Leveled
162.129	159.711	2006
162.198	159.756	2004
162.198	159.756	1990

For Reconnaissance Only!	
Latitude (30' +/-)	Longitude (30' +/-)
33 50 01.18	117 54 48.62

Description:

DESCRIBED BY OCS 2003 - FOUND 3 3/4" USCGS BRONZED DISK STAMPED "Z 33 1920", SET IN THE TOP OF A CONCRETE STAIRCASE PILLAR. MONUMENT IS LOCATED IN THE NORTHWESTERLY CORNER OF THE INTERSECTION OF BROADWAY AND ANAHEIM BOULEVARD, 81 FT. NORTHERLY OF THE NORTHERLY CURB ALONG BROADWAY AND 46 FT. WESTERLY OF THE WESTERLY CURB ALONG ANAHEIM. MONUMENT IS SET LEVEL WITH THE TOP OF THE WALL.

