

Chapter 13 – Preparation of the Field Note Package

Policy Statement


All projects initiated by a formal Survey Request shall be memorialized and archived in the format defined within this document.

Preliminary Actions

Prior to assembling the final field note package, the following files need to be generated from the Star*Net project:

DXF File:

A .DXF file can be exported from Star*Net by clicking **Tools>DXF Exporter** from the main menu.

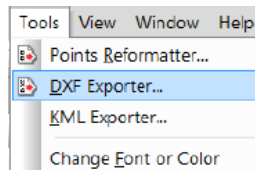

This file provides a graphic representation of network connectivity and becomes the basis for the Control Establishment Sheets.


Worksheets for Conventional Observations, GPS Vector Summary, and Final Coordinates:

Excel worksheets are created for the following data sets:

- Conventional observations - extracted from the .DAT files
- GPS Vector Residual Summary - extracted from the .LST file
- Final coordinates with standard deviations (along with a note stating that coordinate standard deviations are reported at 1 sigma or 68% confidence level) - extracted from the .PTS and .LST files

Conventional observation data and the GPS Vector Residual Summary will be shown on the **Control Establishment Sheets**. The coordinate worksheet becomes a live reference for the coordinate table on the **Monument Summary Sheet**. Population of these worksheets is achieved as follows:

1. Open a blank Excel Workbook. From the main menu, click **Data>Get External Data>From Text**.

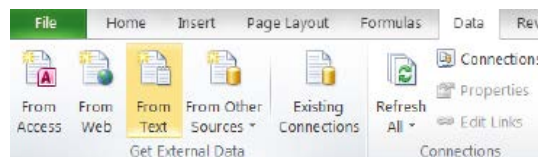

2. Browse to the desired text file and click **Import**. Follow steps 1-3 in the **Text Import Wizard** and click **Finish**.
3. Add desired column headings and fine tune formatting as needed, then save the file.


Required Elements of the Final Field Note Package

For convenience and consistency, a template file in .DWG format is located here: (\\lis017)\Civil 3d\OCS Notes.dwg. Open the drawing and save it in the desired location. This file is to be used as the basis for the project Final Note Package and will contain each of the elements described below.


Monument Location Map / Title Sheet:

The Monument Location Map provides a plot of all monuments found and set, georeferenced to aerial imagery. Creation of this sheet is achieved as follows:

1. Import network control points and boundary points into the drawing
2. Add appropriate monument symbols, either by manual placement or by editing the point style. Edit point style labels to display point number only.
3. Insert the most recent Orange County Eagle Aerial imagery. **Important note:** The project coordinate system must be verified before imagery is inserted. From the **Raster Tools** tab, click **Insert Image** or type the command **"iinsert"**.

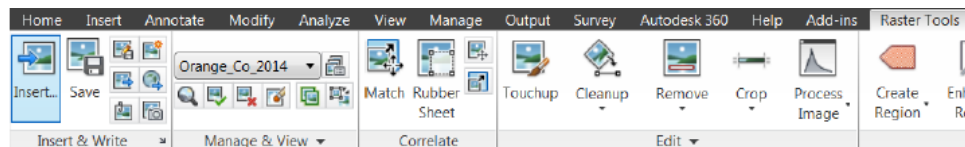

From the **Insert Image** dialog box, select **Insertion Wizard** as the desired **Insert option**. Browse to **Orange_Co_20xx.ecw** under the Eagle drive (\\lis017\Eagle20xx) and click **Open**. Click **Next** through each menu, accepting the default settings, and click **Finish**.

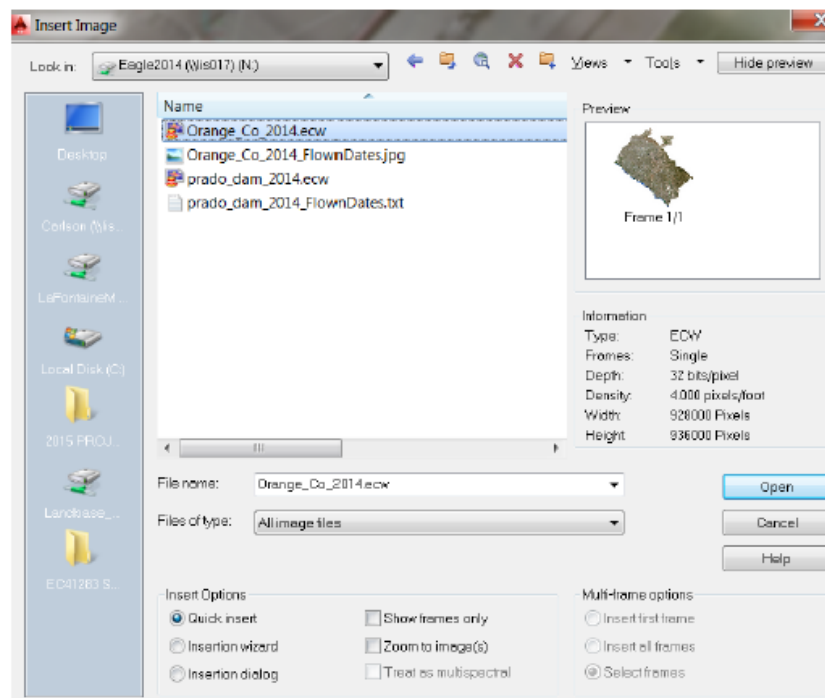


If the image does not appear in the correct location, verify coordinate system and project units.

Important note regarding attachment of images: Images should be loaded prior to printing and then unloaded before closing the drawing. Leaving the image loaded may cause the drawing to create a “fatal error” which will immediately close the program, and all unsaved work will be lost!

4. Place the image on a layer of its own. This will allow the transparency to be adjusted **By Layer** to establish a suitable contrast between image and points. If points are not visible after the image is inserted, change the **Display Order** of the image to **Send to Back**.
5. After point numbers, monument symbols, and aerial image are correctly displayed, the sheets are set up in Paper Space by creating viewports in the correct layout, copying layouts if more sheets are necessary.
6. Once sheets are positioned and scaled in Paper Space, a monument legend, north arrow, scale bar, and miscellaneous text (street names, etc.) are added.
7. Fill out the **Project Details** table at the bottom of the sheet.


Final Sheet Appearance

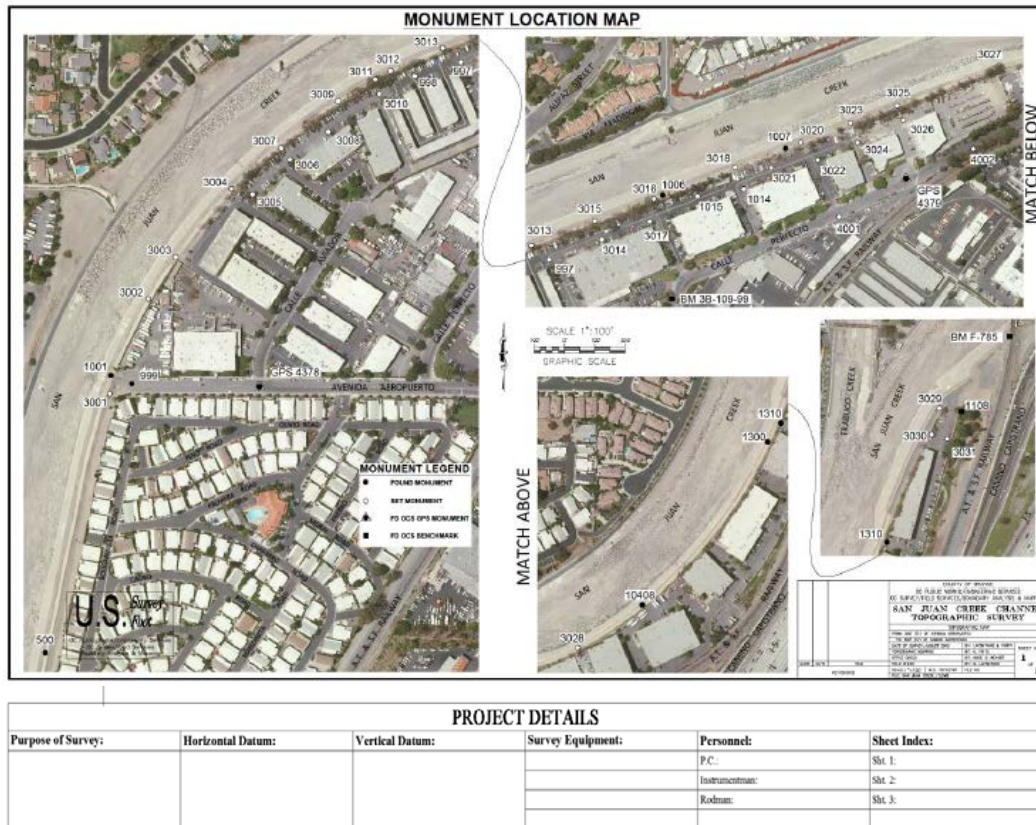


Control Establishment Sheets:

The Control Establishment Sheets provide a graphic representation of how the control points and boundary points were tied to the network. Creation of these sheets is achieved as follows:

1. Open the .DXF file exported from Star*Net, copy the linework from the .DXF, and paste into the proper layer of the new .DWG file.
2. Set up sheets in Paper Space, displaying line connectivity, point numbers, and monument symbols. Add a monument legend and north arrow.
3. **Establishment Notes**, a narrative outlining the control method, control constraints, etc. shall be included. If existing control was used as the basis of the survey, the process which was used to verify the network shall be documented within the narrative.
4. Insert the Excel worksheet containing observation data (created in **“Preliminary Actions”** on Page 1) as follows:
 - a. From the **Insert** tab click **Linking and Extraction>Data Link**, or type the command **“datalink”**.

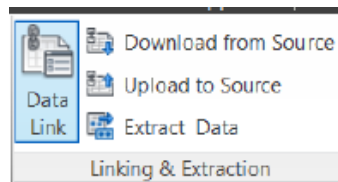

- b. Click **Create a new Excel Data Link**, name the link, and click **OK**. Browse to the Excel file and click **OK**. Select the sheet to be linked and choose **Link Entire Sheet**, **Link to a Named Range**, or **Link to Range**. Click **OK** and again click **OK**.

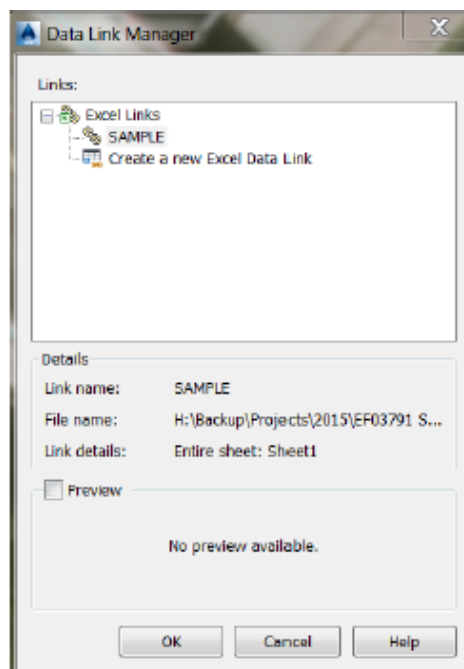

- | Title | | |
|--------|--------|--------|
| Header | Header | Header |
| Data | Data | Data |
| Data | Data | Data |
| Data | Data | Data |
| Data | Data | Data |
| Data | Data | Data |
| Data | Data | Data |
| Data | Data | Data |
| Data | Data | Data |

The screenshot shows the "Insert Table" dialog box with the following settings:

 - Table style:** Column-Ctr
 - Insert options:** Start from empty table (selected)
 - Column & row settings:** Columns: 5, Column width: 2.500000, Data rows: 1, Row height: 1 Line(s)
 - Set cell styles:** First row cell style: Title, Second row cell style: Header, All other row cell styles: Data

[illegible]


Content from .DAT File to be Imported into Civil 3d

AT-FROM-TO	ANGLE RT.	DIST.
104-5004R1		1572.42
104-5004R1-5013	151-49-10.50	1328.18
5013-104		1328.17
5013-104-105	293-08-55.00	386.16
5013-104-106	253-05-55.75	1378.79
105-5013		386.18
105-5013-103	217-56-58.50	951.53
105-5013-102	220-01-35.50	998.94
105-5013-101	221-53-52.00	1047.70
103-105		951.54
103-105-102	217-45-10.25	59.14
103-105		951.54
103-105-106	48-53-56.00	1474.56
103-105-101	217-36-12.25	118.24
106-103		1474.55
106-103-105	40-10-58.25	1111.31
106-103-5013	53-06-05.75	1378.78
106-103-107	230-46-15.00	809.27
107-106		809.28
107-106-6201	152-00-29.50	116.71

GPS Vector Residual Summary

GPS Vector Residual Summary (FeetUS)							
(Sorted by 2D Residual Length)							
From	To	N	E	Up	2D	3D	Length
OEOC	900	-0.017	0.062	0.148	0.064	0.161	48208
MJPK	957	0.005	0.04	0.036	0.041	0.055	65723
MJPK	957	-0.005	-0.041	-0.162	0.041	0.167	65723
MJPK	933	0.012	-0.032	0.042	0.034	0.054	39843
MJPK	900	0.001	-0.033	-0.006	0.033	0.034	24602
WHYT	957	0.014	0.026	-0.089	0.029	0.093	51049
OEOC	MJPK	0.012	-0.021	-0.008	0.024	0.025	61903
OEOC	933	-0.006	0.022	0.088	0.023	0.091	22158
OEOC	900	0.02	0.004	-0.006	0.02	0.021	48208
OEOC	949	-0.011	0.014	-0.004	0.018	0.019	7048
MJPK	933	0.014	0.01	-0.062	0.017	0.065	39843
WHYT	900	-0.013	-0.01	-0.01	0.016	0.019	7567
WHYT	933	0.015	0	0.02	0.015	0.025	28393
OEOC	949	-0.002	-0.015	-0.031	0.015	0.034	7048
941	933	-0.014	0.005	-0.01	0.014	0.017	7316
949	941	-0.013	0.005	-0.017	0.014	0.022	8788
OEOC	957	0	-0.013	0.019	0.013	0.023	6473
WHYT	900	-0.002	-0.013	0.022	0.013	0.025	7567
910	933	-0.008	0.009	-0.006	0.012	0.014	20494
OEOC	957	-0.003	-0.011	0.006	0.011	0.013	6473
910	900	0.009	-0.005	-0.006	0.01	0.011	8501
WHYT	957	-0.009	-0.004	-0.086	0.01	0.087	51049
MJPK	900	0.001	0.009	-0.033	0.009	0.034	24602
OEOC	WHYT	0.003	-0.009	-0.036	0.009	0.037	45200
933	923	0.007	0.005	-0.003	0.008	0.009	9120

Final Sheet Appearance

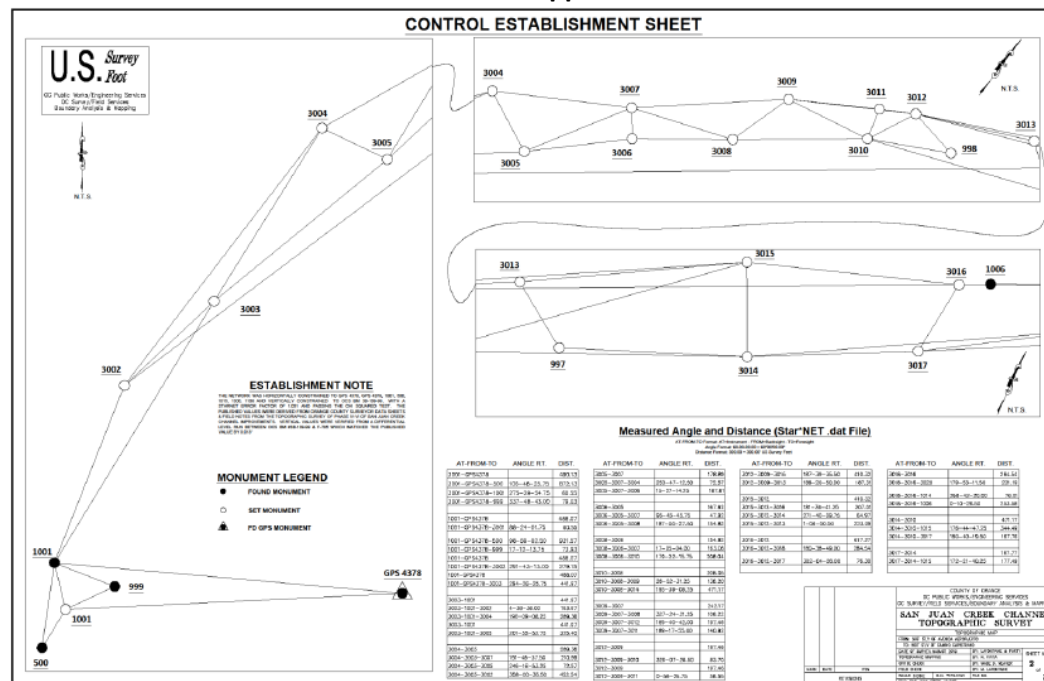

Monument Summary Sheets:

The Monument Summary Sheets compile photographs, descriptions, and coordinates of all monuments found or set during the course of the survey. Statistical data, such as coordinate standard deviations or semi-major error ellipses may also be required. Creation of these sheets is achieved as follows:

1. Set up sheets in Paper Space. Insert monument photos – quick insert method can be used, as the photos are not georeferenced.
2. Label monument photos with point numbers and descriptions – type the command “mtext” for multi-line text input.
3. Insert the Excel worksheet containing coordinate data (created in **“Preliminary Actions”** on Page 12-1) by creating a data link (follow the procedures outlined in **“Control Establishment Sheets”**, steps 4a-c on Pages 12-4 through 12-6). Note: Edits to coordinate data should be made within the Excel file – once the changes are saved in Excel, Civil 3d will prompt for update.

Final Sheet Appearance

MONUMENT DESCRIPTION & COORDINATE LIST

MONUMENT DESCRIPTIONS

#997
SET SURVEY MARKER SPIKE & WOOD CAP
WASHER, FLUSH IN ASPHALT

#998
SET 1/2" BANG SPIKE & WOOD CAP WASHER,
FLUSH IN ASPHALT

#999
FOUND 1/2" BANG SPIKE & WOOD CAP WASHER,
FLUSH IN ASPHALT

#1000
FOUND 1" BANG SPIKE & WOOD CAP WASHER,
FLUSH IN ASPHALT

#1001
FOUND 1" BANG SPIKE & WOOD CAP WASHER,
FLUSH IN ASPHALT

#1002
FOUND 1" BANG SPIKE & WOOD CAP WASHER,
FLUSH IN ASPHALT

#1003
FOUND 1" BANG SPIKE & WOOD CAP WASHER,
FLUSH IN ASPHALT

#1004
FOUND 1" BANG SPIKE & WOOD CAP WASHER,
FLUSH IN ASPHALT

#1005
FOUND 1" BANG SPIKE & WOOD CAP WASHER,
FLUSH IN ASPHALT

#1006
FOUND 1" BANG SPIKE & WOOD CAP WASHER,
FLUSH IN ASPHALT


#1007
FOUND 1" BANG SPIKE & WOOD CAP WASHER,
FLUSH IN ASPHALT

Coordinate List (Adjusted using StarNET)

POINT	NORTHING	EASTING	HEIGHT

Field File Organization

Data for all projects initiated by a formal Survey Request shall be organized on the Field Survey Server as detailed below:

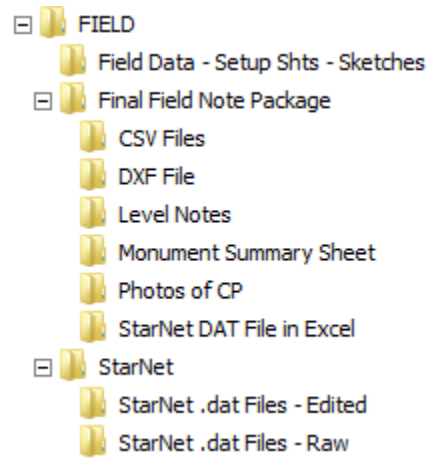

1. Field Data - Setup Shts - Sketches: Setup sheets; field sketches; raw files (JOB, DC, CSV attribute files, etc.)
2. Final Field Note Package:
 - a. (Root): Final Field Note Package DWG and signed PDF files
 - b. CSV Files: CSV files with final adjusted coordinates of control and boundary points in P,N,E,Z format
 - c. DXF File: DXF file(s) exported from Star*Net project(s) (see page 12-1 for instructions on creating DXF files)
 - d. Level Notes: Level notes in spreadsheet format, showing closures
 - e. Monument Summary Sheet: Excel spreadsheet listing coordinates and descriptions of all monuments tied to the survey, along with horizontal and vertical datum statements and a detailed narrative explaining the horizontal and vertical control strategy; points searched for and not found (SNF) should also be listed, along with a description of the search process
 - f. Photos of CP: Photos of control points (only necessary if the Monument App was down at the time the photos were captured); photos of the search area of points searched for and not found (SNF) should also be included
 - g. StarNet DAT File in Excel: Excel spreadsheet showing Star*Net DAT file data (follow steps 4a-4c on Pages 12-4 through 12-6 for instructions on creating this spreadsheet)
3. StarNet: Star*Net project files (.SNPROJ)
 - a. StarNet .dat Files - Edited: Topo edit logs; edited DAT files, following this required naming convention: [Abbreviated Project Name] [Task] [Date] [Crew – if more than one crew is involved] Edited.dat (e.g. Hazard Topo 8-25-18 EM Edited.dat)
 - b. StarNet .dat Files - Raw: Unedited DAT files, following this required naming convention: [Abbreviated Project Name] [Task] [Date] [Crew – if more than one crew is involved] Raw.dat (e.g. Hazard Topo 8-25-18 EM Raw.dat)