

  
 SURVEY  
 OF  
 PROSPECT AVE  
 FROM: 17<sup>TH</sup> STREET  
 TO: CHAPMAN AVE

COUNTY SURVEY NO. 6963

Date: 11/21/73

DATE: MAY, 1972

## FIELD PARTY

P.C.: J. HATTER

T: B. JOHNSON

∞: H. RUUD

∞: W. GREEN

∞: S. SUMMERLIN

## EQUIPMENT

1) TRANSIT: T-1A # 65966

2) TAPES. 1) ADD FT. # 32  
@ 25 LB TENSION = 100.00' @ 51° F.2) METER # 38  
@ 25 LB TENSION = 30.000 m @ 43° F

## REFERENCES.

- 1) TR 1900
- 2) TR 3186
- 3) TR. 3663
- 4) TR. 3693
- 5) TR. 3772
- 6) TR. 5913
- 7) TR. 6632
- 8) PM. 27-50
- 9) CSTB 120-53
- 10) CSTB 120-63
- 11) CSTB 120-73
- 12) CSTB 126-64
- 13) CSTB 128-22
- 14) AOR-022E-23
- 15) AOR-022E-0030
- 16) OCS A/4-9-126
- 17) OCS A/4-9-289
- 18) OCS A/4-9-852
- 19) OCS A/5-9-682
- 20) OCS A/5-9-693 to 704

PROSPECT AVE.


HATTER & PTY

A/4-9

MAY 1972

1022

2 OF 12

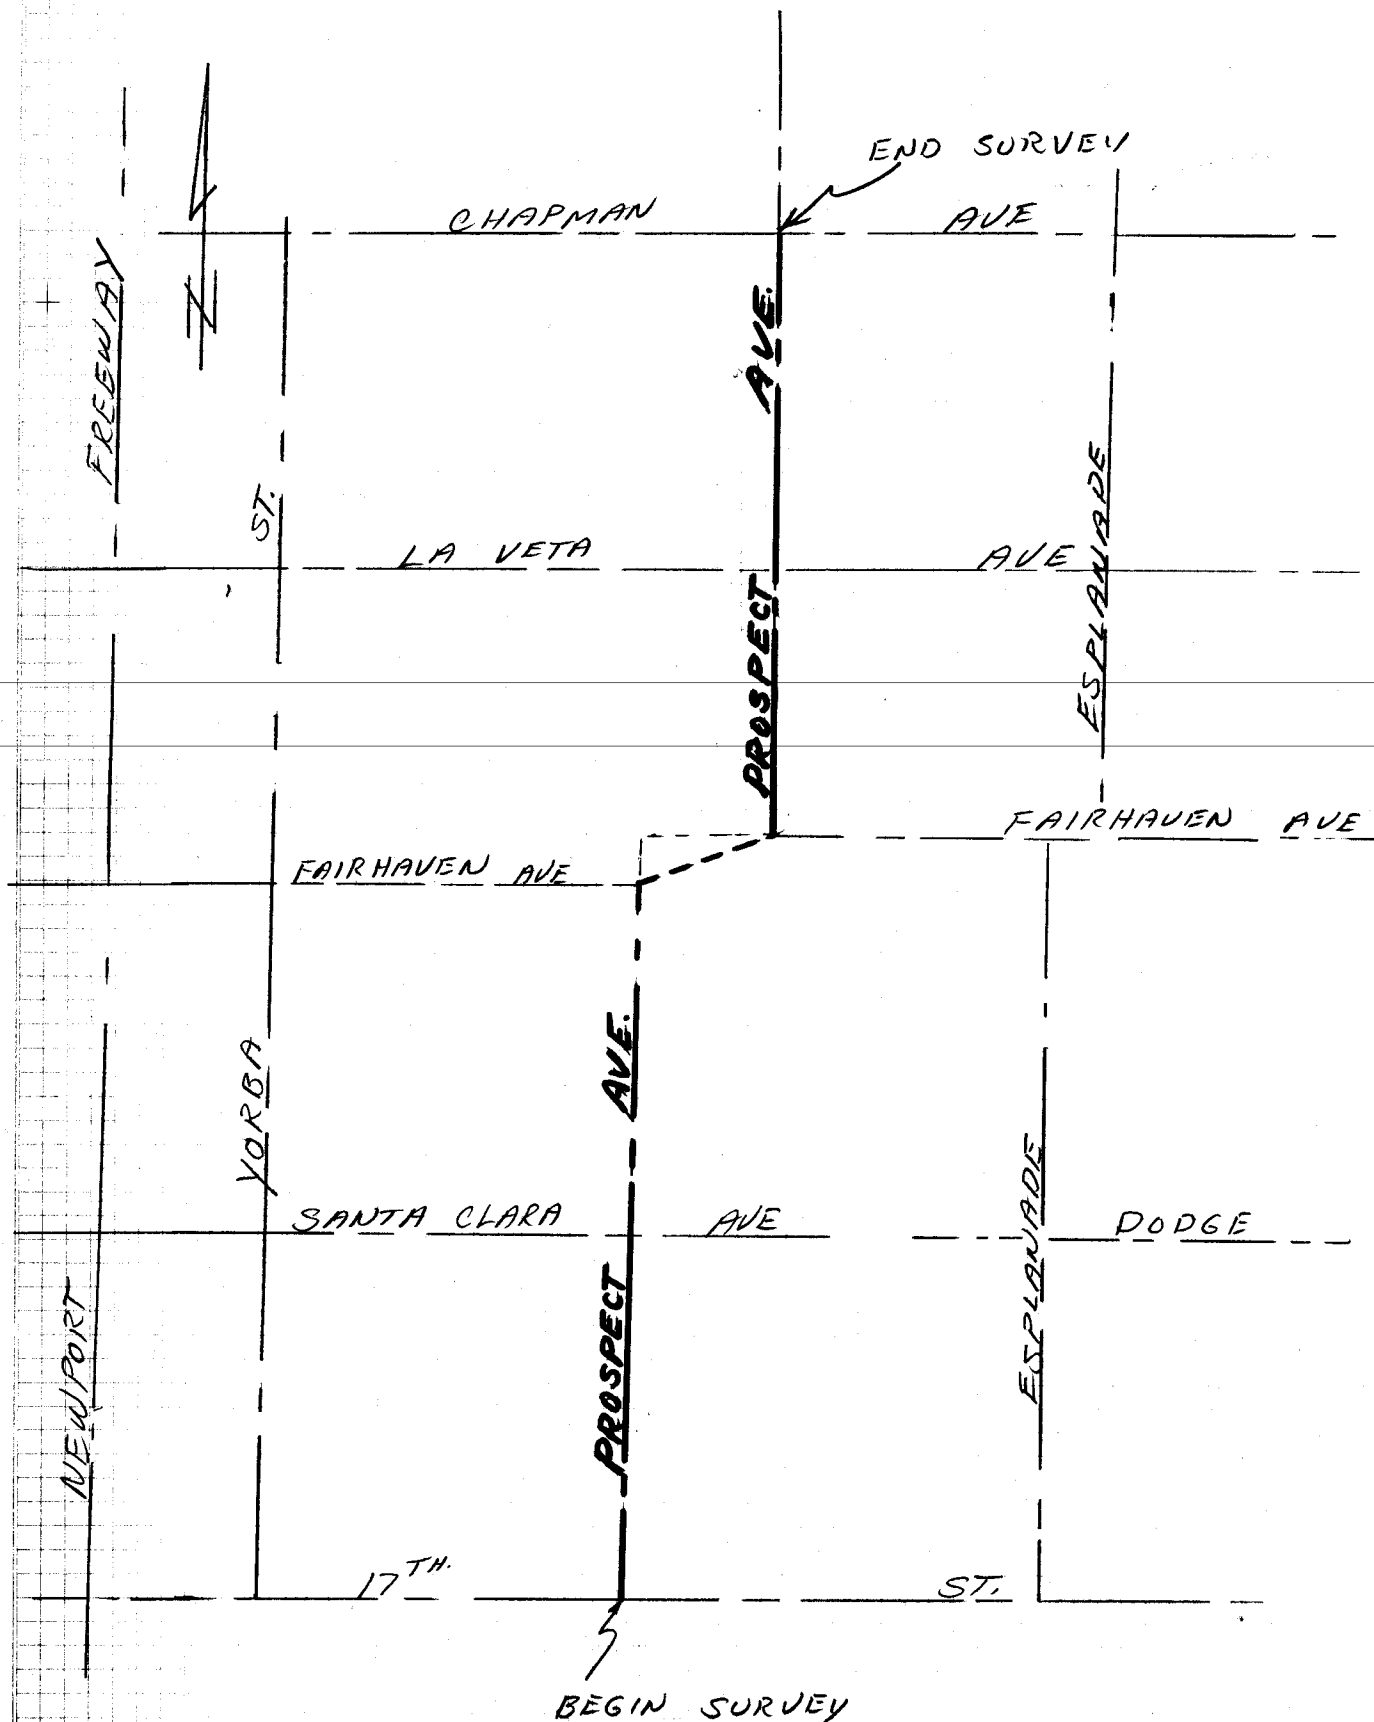

PROSPECT AVE


A/4-9

1023

3 OF 12

HATTER & PTY.

MAY 1972

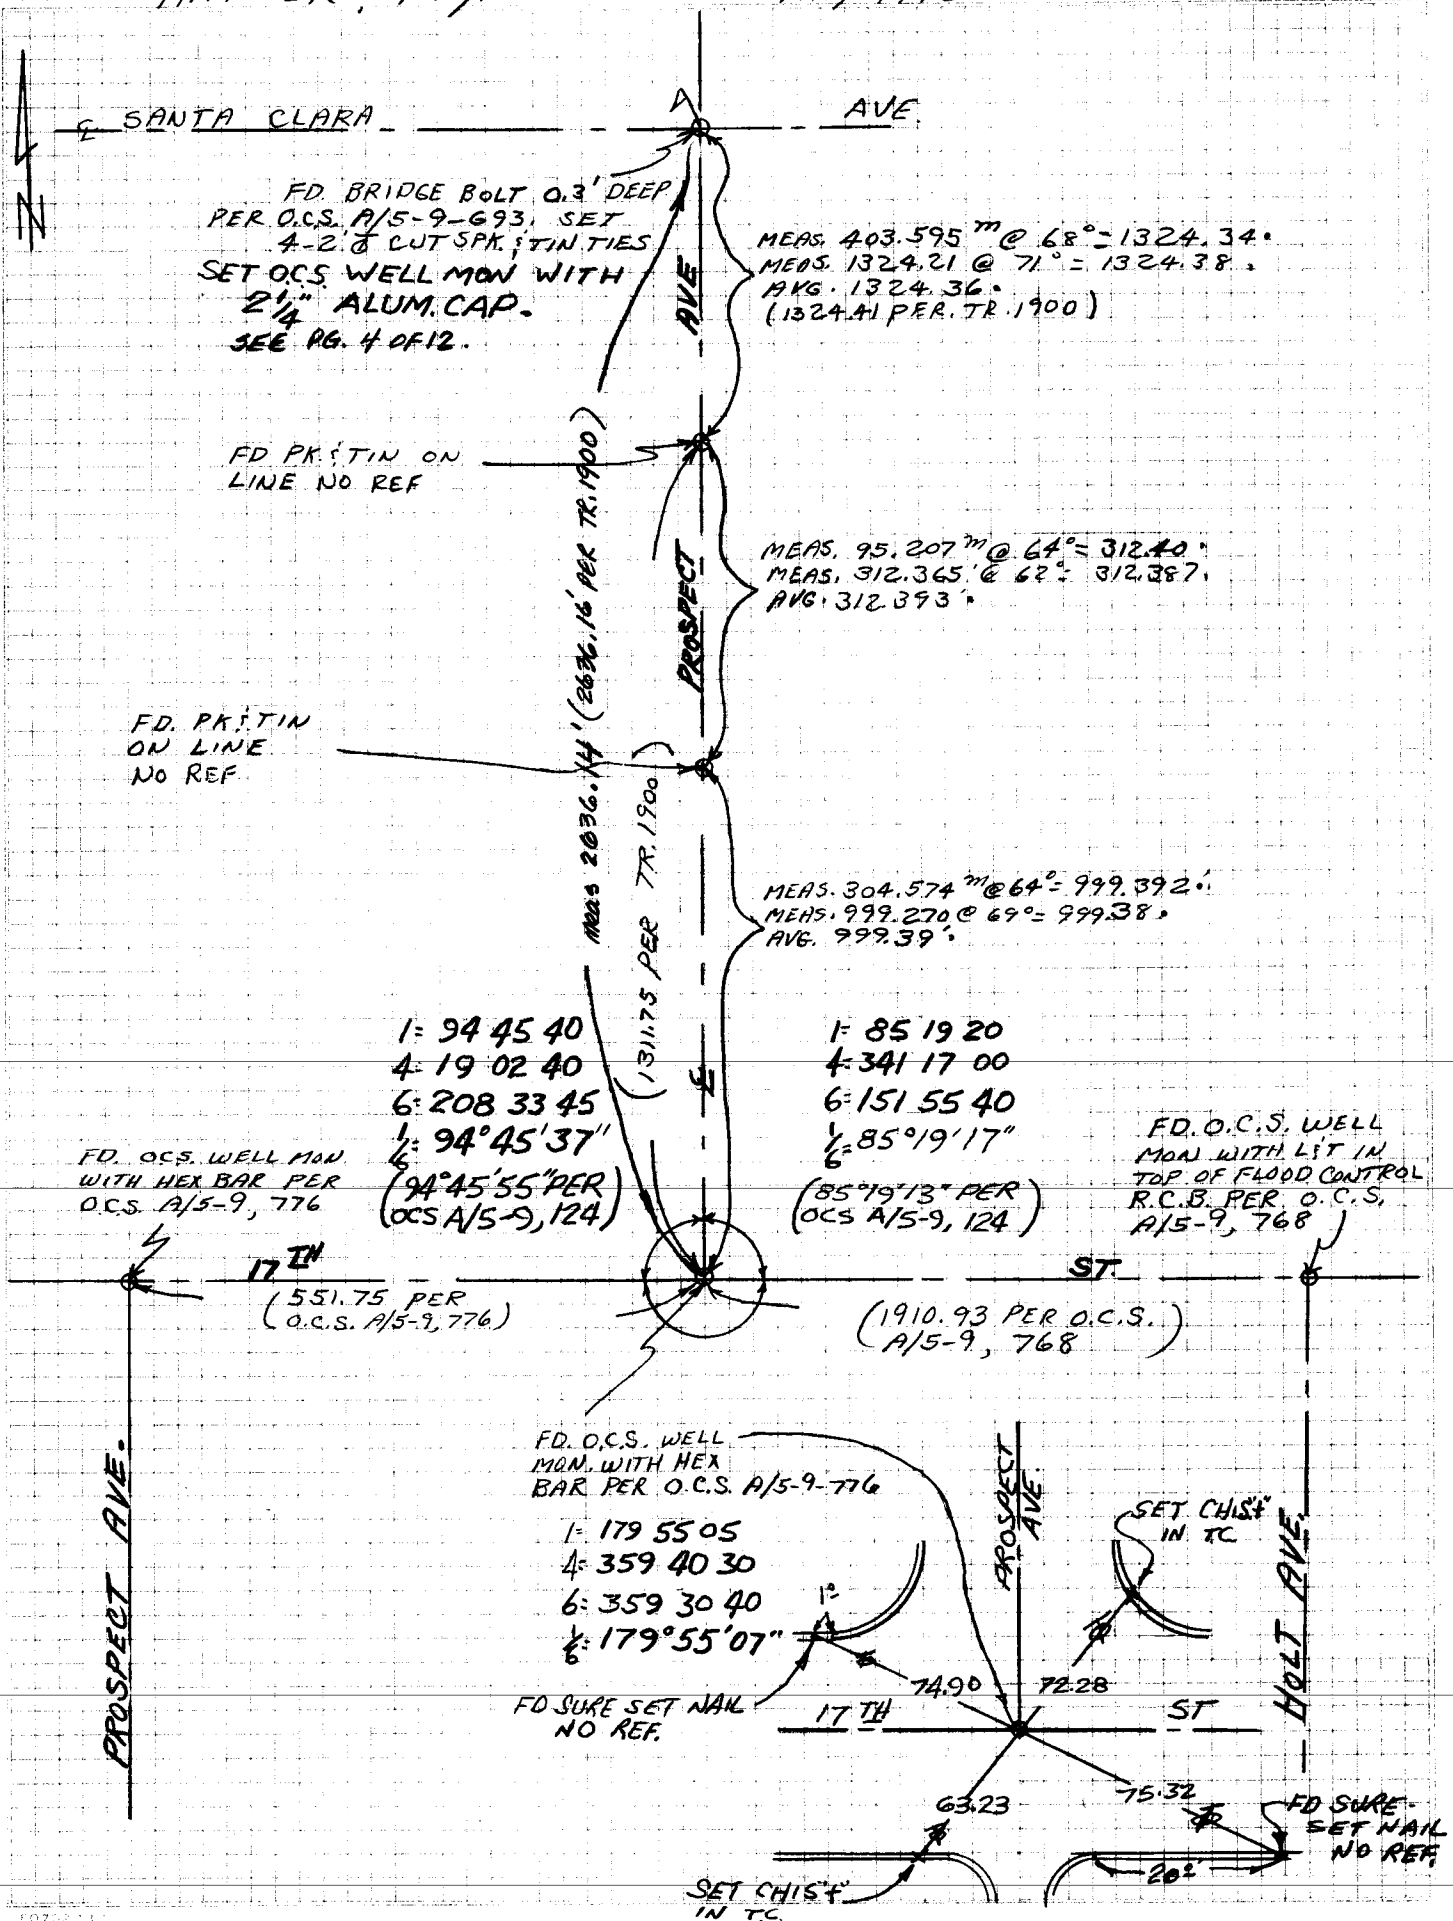


PROSPECT AVE  
HATTER & PTY.

A/4-9

1024

4 OF 12

MAY 1972

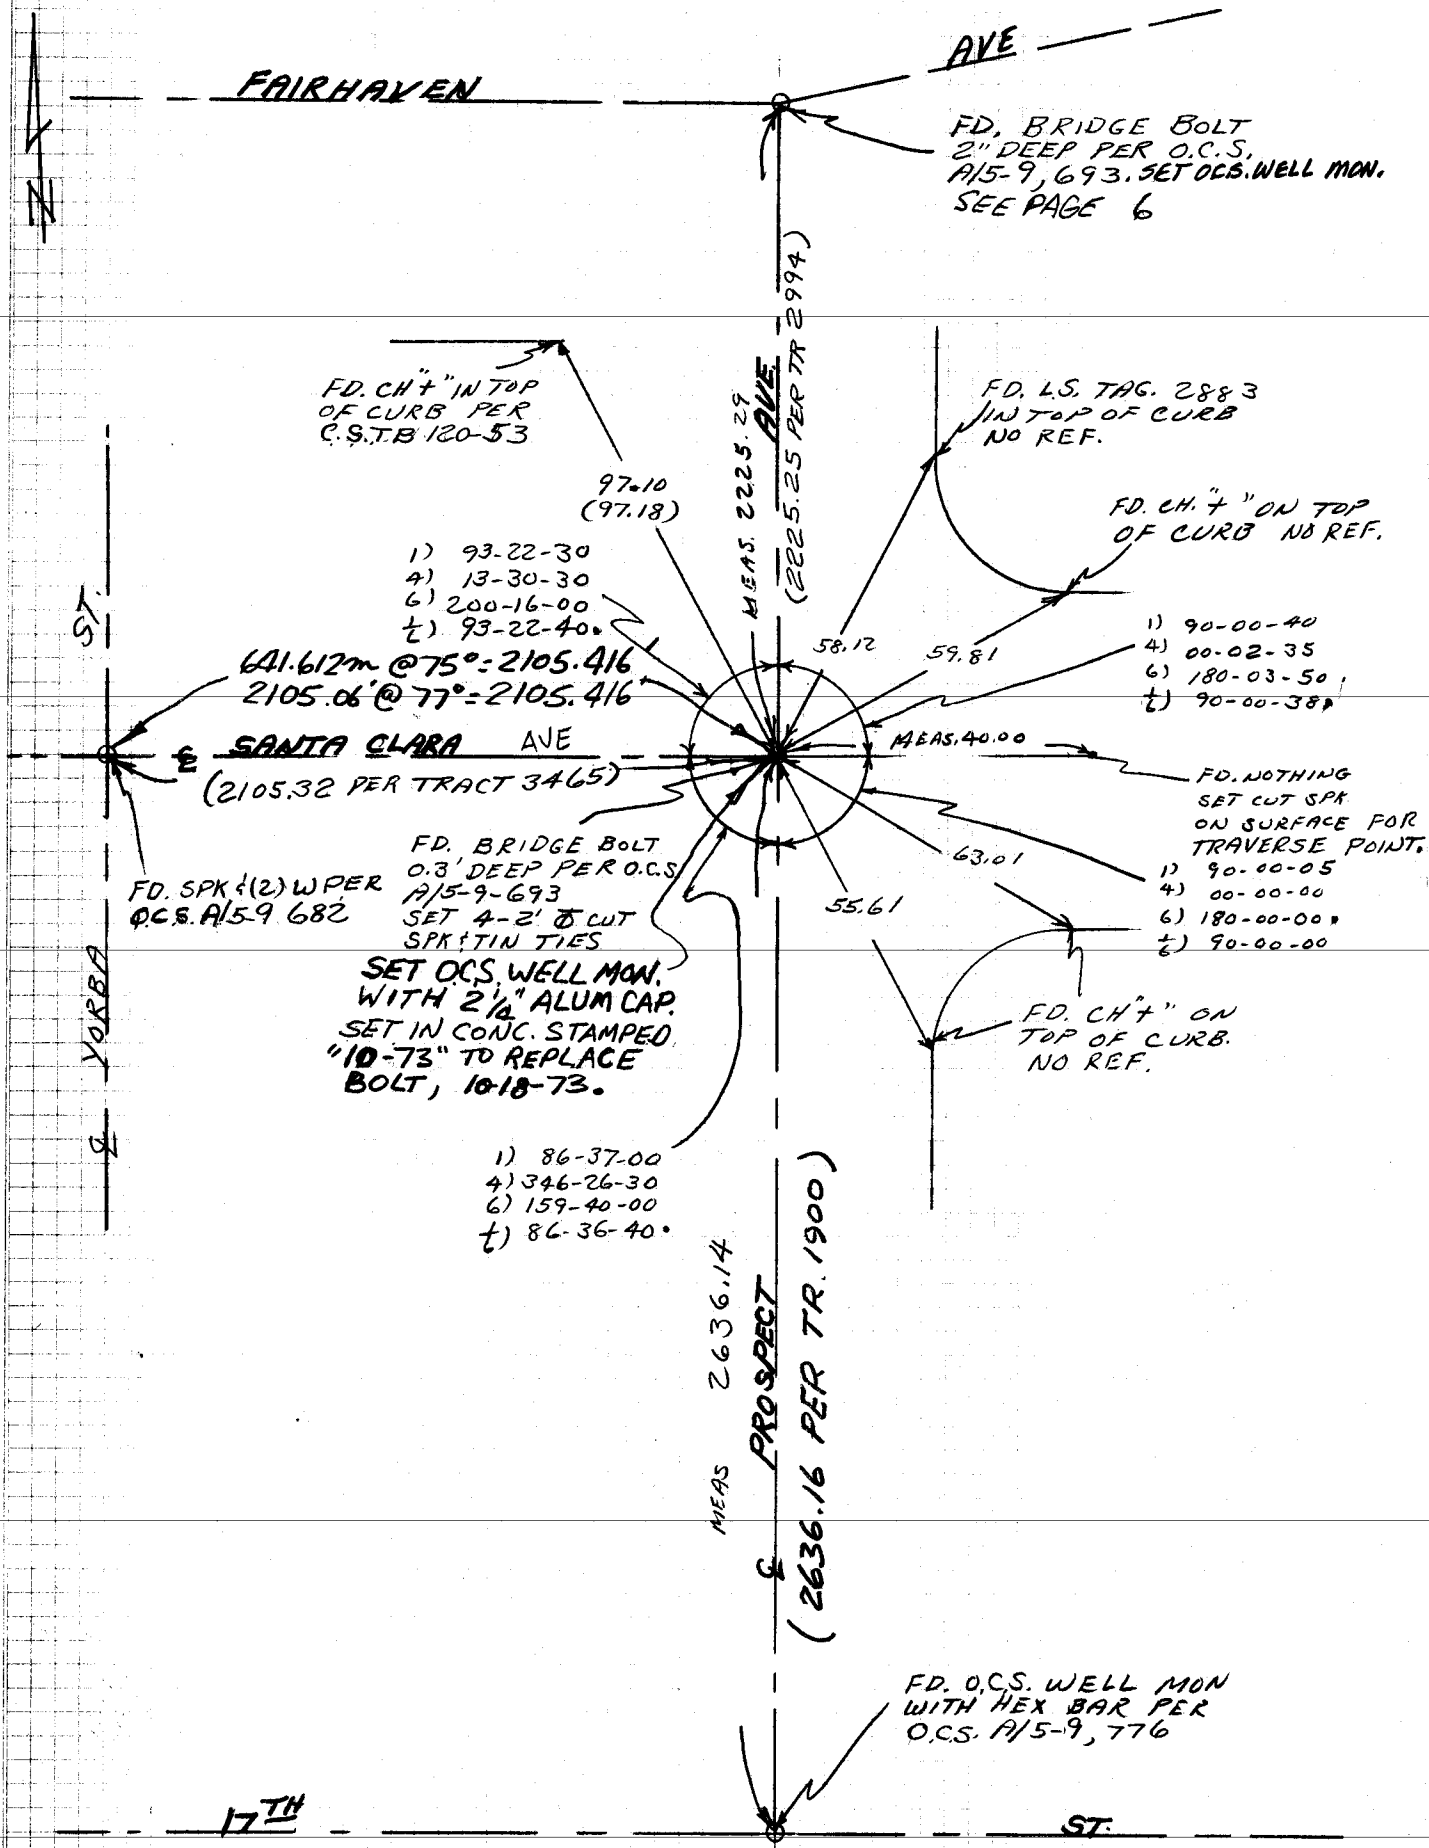

PROSPECT AVE  
HATTER PTY

A/4-9

1025  
5 OF 12

MAY 1972

FAIRHAVEN

AVE

FD. BRIDGE BOLT  
2" DEEP PER D.C.S.  
A/5-9-693, SET  
OCS WELL MON. WITH  
2 1/4" ALUM. CAP.  
SEE PAGE 6

(2225.25' PER TR. 2994)

AVE

MEAS. 92.132 m @ 70° = 302.323'  
MEAS. 302.225 @ 70° = 302.332'  
AVG. = 302.327'  
(302.34 PER TR. 5913)

FD. SPR. & W  
ON ON LINE  
ON SURFACE  
PER TR. 5913

MEAS. 2225.29'

PROSPECT

MEAS. 586.006 m @ 69° = 1922.91'  
MEAS. 1922.785 @ 68.8° = 1923.01'  
AVE. 1922.96'

FD. BRIDGE BOLT 0.3'  
DEEP PER D.C.S. A/5-9-693  
SET 4 2' 8" CUT SPR.  
& TINTIES.  
SET OCS WELL MON.  
WITH 2 1/4" ALUM. CAP.

SANTA CLARA

AVE

PROSPECT AVE



A/4-9


1026

6 OF 12

HATTER PTY

MAY 1972

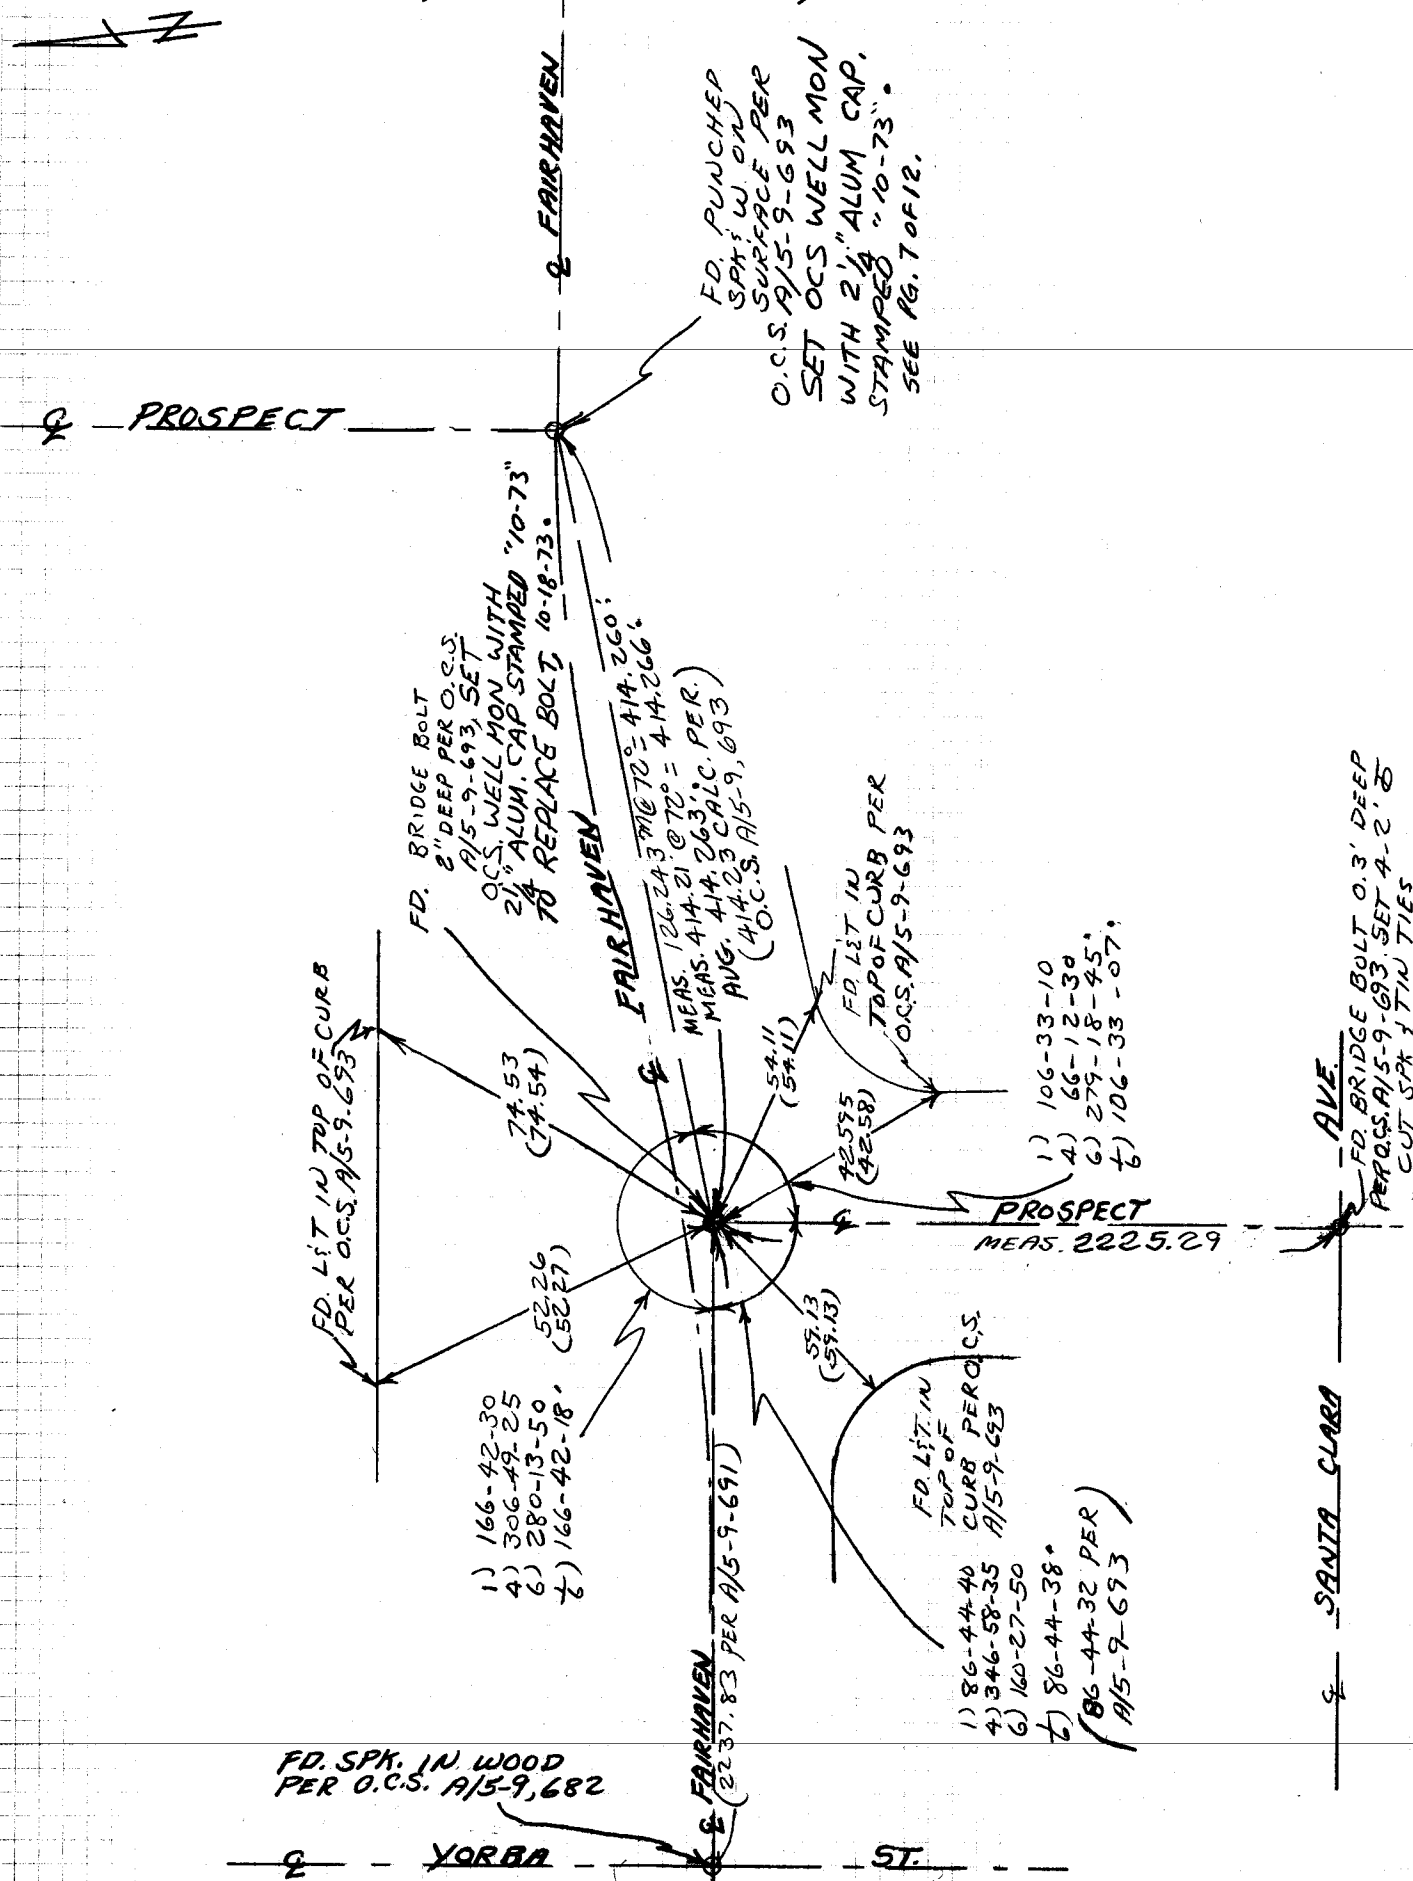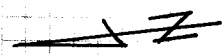

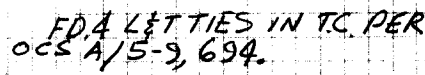

PROSPECT AVE

A/4-9

1028

HATTER 1/2 PTY

8 OF 12

MAY 1972

TO LA VETA AVE

FD. S.I.T PER  
TR. 3186  
SEE PAGE 9

FD LARGE PK. ON SURFACE  
0.04' W. OF LINE NO. REF.

MEAS. 30.495 m @ 68° = 100.065'  
MEAS 100.051 @ 64° = 100.060  
AVG. 100.063'

FD. PUN. SPK I.T.  
ON LINE PER  
TR. 3186, 0.1 DEEP

LARKSTONE DR.

MEAS. 87.561 m @ 68° = 287.33'  
MEAS. 287.306 @ 64° = 287.33'  
AVG. 287.33'

FD. CUT SPK I.T. IN  
ON SURFACE NO REF.  
0.065' W. OF LINE

CASSELLE AVE.

MEAS. 326.111 m @ 66° = 1070.076'  
MEAS. 1069.980 @ 67° = 1070.090  
AVG. 1070.083'  
(1070.00 PER TR 3693)

FAIRHAVEN AVE

FD. PUNCHED SPK I.W. ON  
SURFACE PER O.G.S. A/59-693  
SET O.G.S. WELL MON. WITH  
2 1/4" ALUM. CAP.

HATTER & PTY

MAY 1972

9 OF 12



LA VETA

**PVE**

FD. P.A. NAIL  
ON SURFACE PER  
TR. 3772 WITH  
4.2" NITTIES  
SET OCS WELL  
MON WITH 2 1/4"  
ALUM. CAP.

MEAS. 97.837' @ 69° = 321.04'  
MEAS. 321.008 @ 63° = 321.033'.  
AVG. 321.036'.  
(321.04 PER TR. 4737)

FD. SPK 5 TIN.  
ON LINE ON  
SURFACE PER  
TR. 4737

TR 3186)

661.04 PER

MEAS. 103.608 m @ 69° = 339.977'.  
MEAS. 339.947' @ 64° = 339.976'.  
AUG. 339.976'.  
(340.00 PER TR. 4737)

FD. SPK & TIN  
ON LINE ON  
SURFACE PER  
TR. 3186

← TO FAIRHAVEN (2549/86 PER C57B 128.22)

# PROSPECT

MEAS. 131.361 m @ 69° = 431.046'  
MEAS 430.999' @ 64° = 431.035'  
AVG. 431.04'

Q LARKSTONE DR

FD. LARGE PK ON  
SURFACE NO REF  
0.04' W. OF LINE

TO FAIRHAVEN AVE.

PROSPECT AVE.

A/4-9

1030

10 OF 12

HATTER & PTY.

MAY 1972

E PALMYRA AVE

FD. P.K. NAIL  
ON SURFACE  
WITH 2-2' N/T TIES  
PER TR 6632

FD. CH. "T" ON  
TOP OF CURB  
PER O.C.S.  
A/5-9, 694  
1) 89-47-15  
4) 359-08-50  
6) 178-43-15  
t) 89-47-13.  
(89-47-40 PER  
CSTB 120-73)

1) 89-56-05  
4) 359-45-30  
6) 179-38-00  
t) 89-56-20.  
(89-56-00 PER  
CSTB 120-73)

FD. R.C.E. TAG  
#12578 SET  
IN SIDEWALK  
NO REF.

FD. PUNCHED  
BOLT 0.1' DEEP  
PER O.C.S.  
A/5-9-599

E LA VETA  
(1319.24 PER CSTB 120-73)

AVE  
(1839.11 PER CSTB 120-73)

1) 90-07-10  
4) 00-29-20  
6) 180-44-20  
t) 90-07-23.  
(90-07-10 PER  
CSTB 120-73)

FD. NAIL IN LEAD  
ON TOP OF CURB  
PER O.C.S.  
A/5-9-694

FD. 3/4" I.P. NO TAG  
8" DEEP PER O.C.S.  
A/4-9-591

1) 90-09-00  
4) 00-36-25  
6) 180-54-35  
t) 90-09-06.  
(90-09-10 PER  
CSTB 120-73)

FD. LET IN TOP  
OF CURB PER O.C.S.  
A/5-9, 694

FD P.K. NAIL ON SURFACE  
WITH 4-2' N/T TIES IN  
LIEU OF SPK. & T PER O.C.S.  
A/5-9, 694. TIE DISTANCES  
SHOWN IN ( ) ARE PER O.C.S.  
A/5-9, 694.  
SET OCS WELL MON WITH  
2 1/4" ALUM. CAP SET IN CONC.  
STAMPED "10-73" TO  
REPLACE P.K. NAIL, 10-18-73.

MEAS. 2549.53

E PROSPECT

FAIRHAVEN AVE

FD. PUNCHED SPK & W  
ON SURFACE PER O.C.S. A/5-9-693  
SET OCS WELL MON  
WITH 2 1/4" ALUM CAP.

PROSPECT AVE


A/4-9

1031

11 OF 12

HATTER & PTY.

MAY 1972

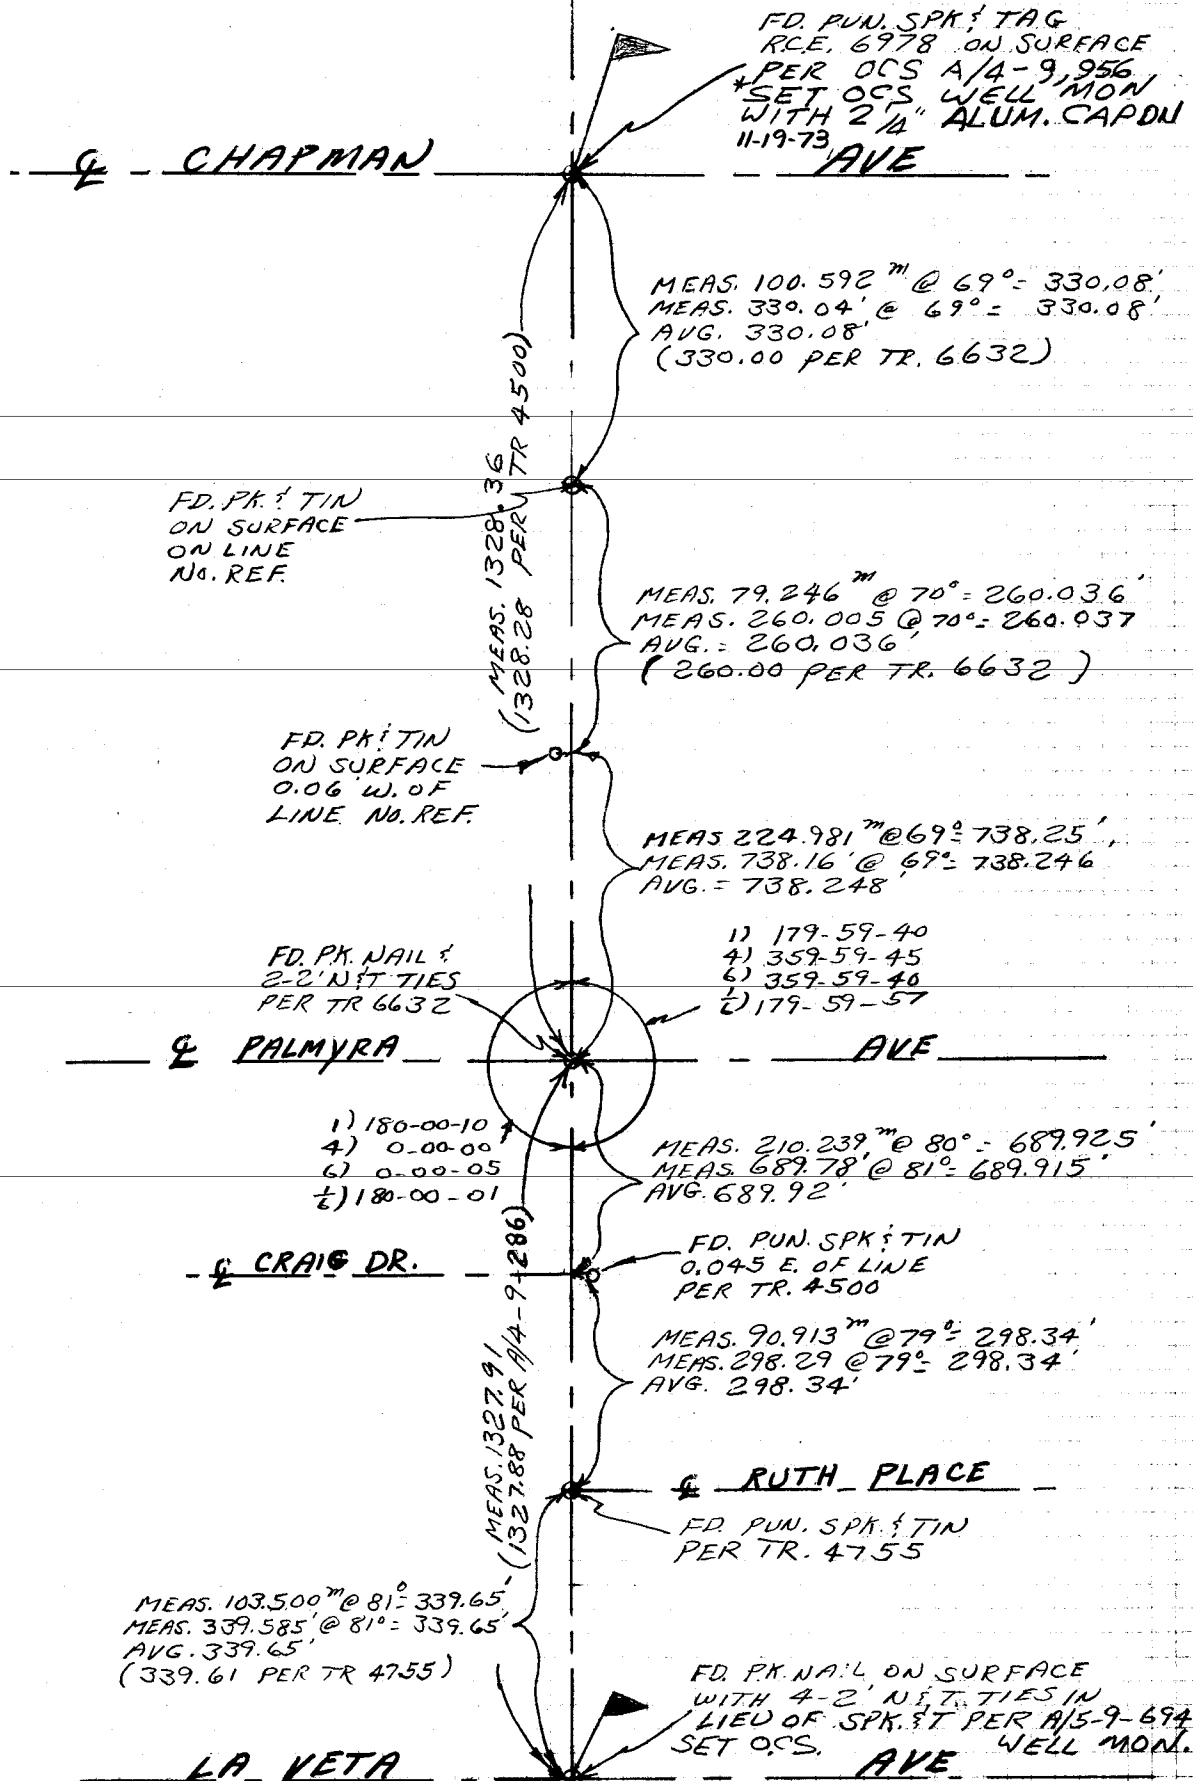

12 of 12

MAY 1972

ORANGE COUNTY SURVEYOR

