

ORANGE COUNTY SURVEYOR
SURVEY NOTES

A/5-11 & 12

534

ALIGNMENT INDEX BOOK AND PAGE

ALIGNMENT NOTES PG. ____ OF ____

PPB ____ WORK ORDER NUMBER 240253410

SURVEY NOTES PAGE 1 OF 5

SURVEY COMPLETION DATE 9-23-86

SURVEY FILE NUMBER F85-35

PROJECT NAME PURDY STREET CENTERLINE

SURVEY LIMITS FROM BOLSA TO HAZARD

PURPOSE OF SURVEY CENTERLINE TIES

THOMAS BROS.:

BLOCK AND MODULES:

PG 21

5747 84 85 94 95

5847 04 05 14 15

SURVEY NOTE PAGE INDEX:

EQUIPMENT:

PERSONNEL:

TIES

P.C. J. FLYNN

INST L VEGA

R&C P ZELLNER


AII P. McNALLY

REFERENCES/REMARKS:


RS 86 -1047 FOR ALIGNMENT

SURVEY OF 4 PURDY ST INDEX 2 of 5SURVEYED BY FlynnDATE 9-22-86

ORANGE COUNTY SURVEYOR

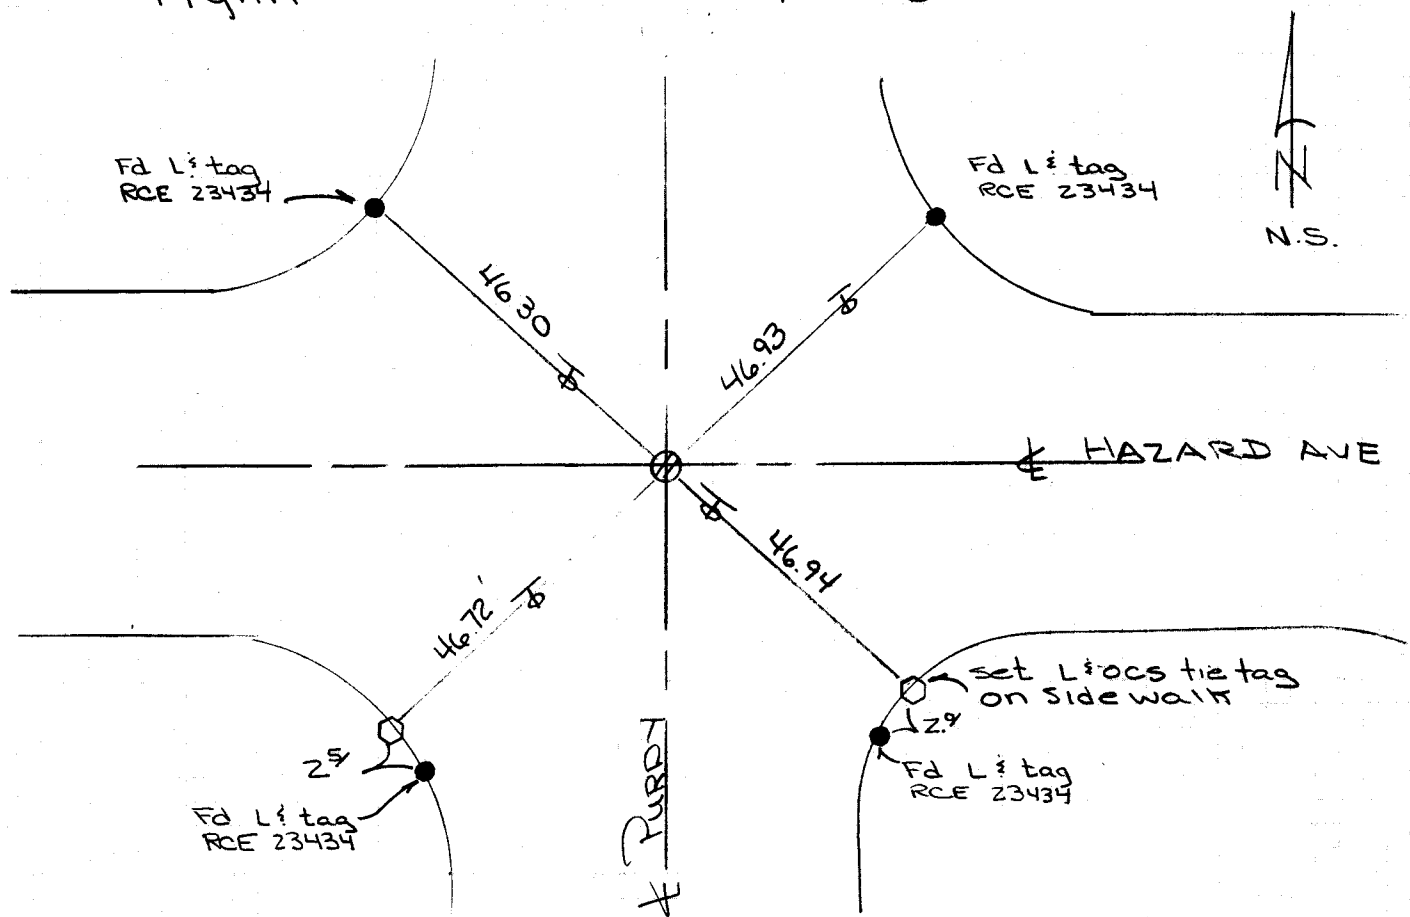

- ⊗ Nothing set - pt falls on MANHOLE cover
- SET L: OCS Tie tag and pin on T.C.

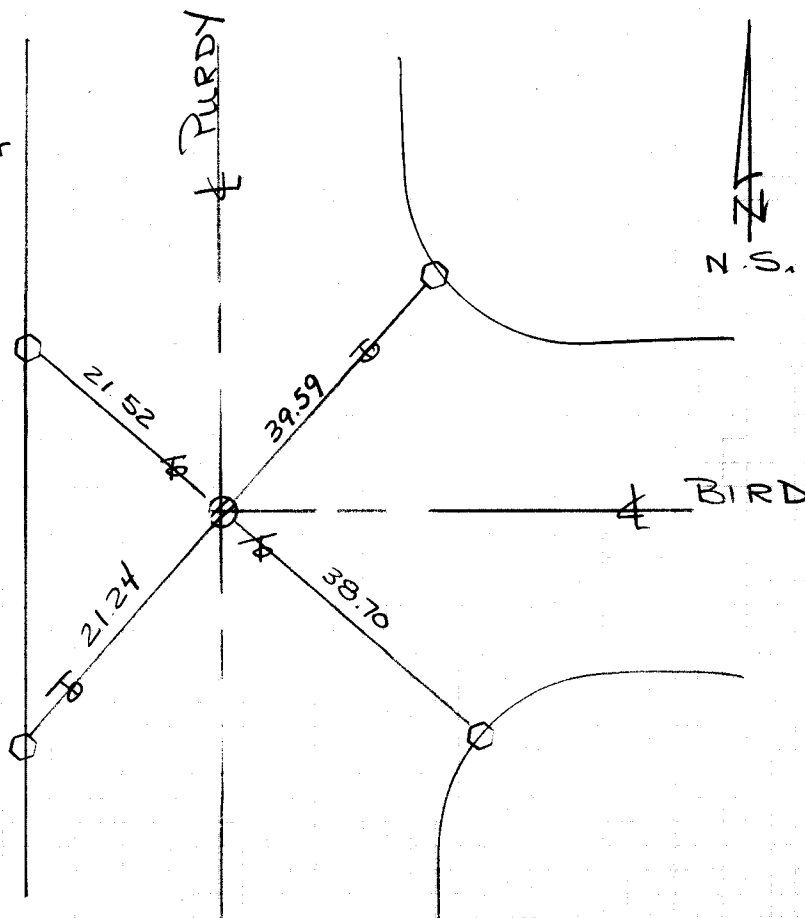

SURVEY OF 4 Purdy St

INDEX

PAGE 3 of 5


SURVEYED BY

Flynn

DATE


9-22-86

ORANGE COUNTY SURVEYOR

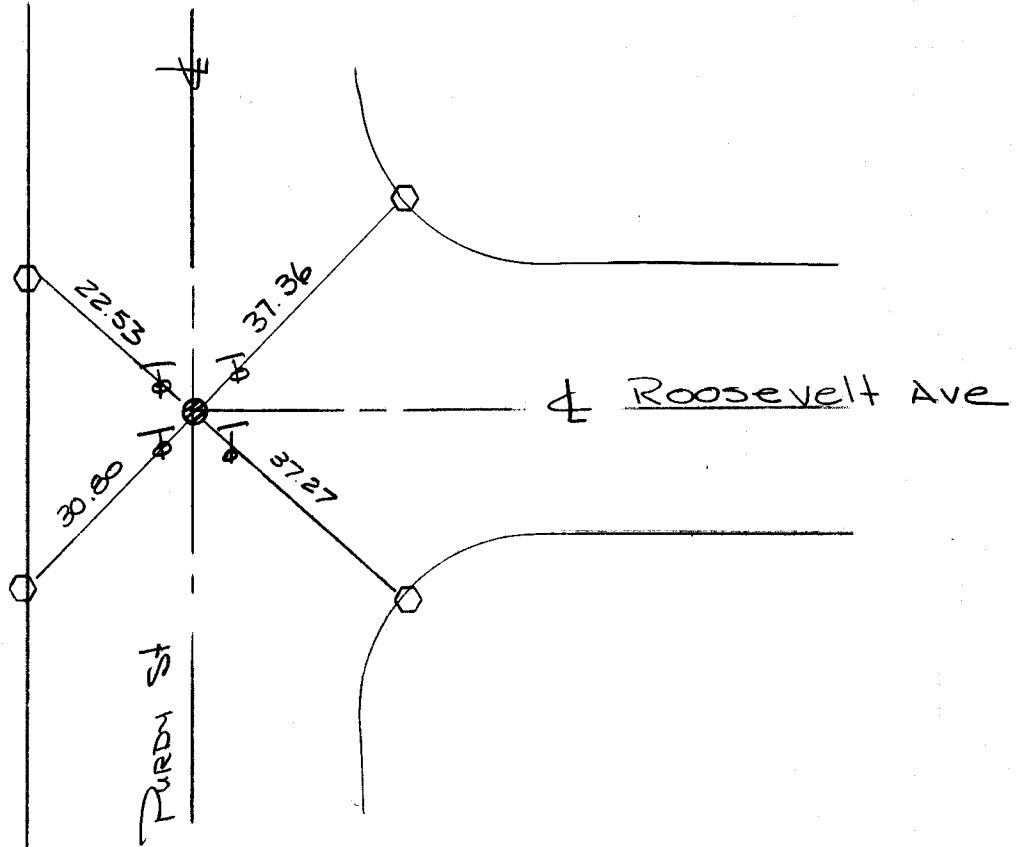

⊗ Nothing Set - pt. falls on manhole cover

○ Set L&O C.S. tie tag and pin on T.C.

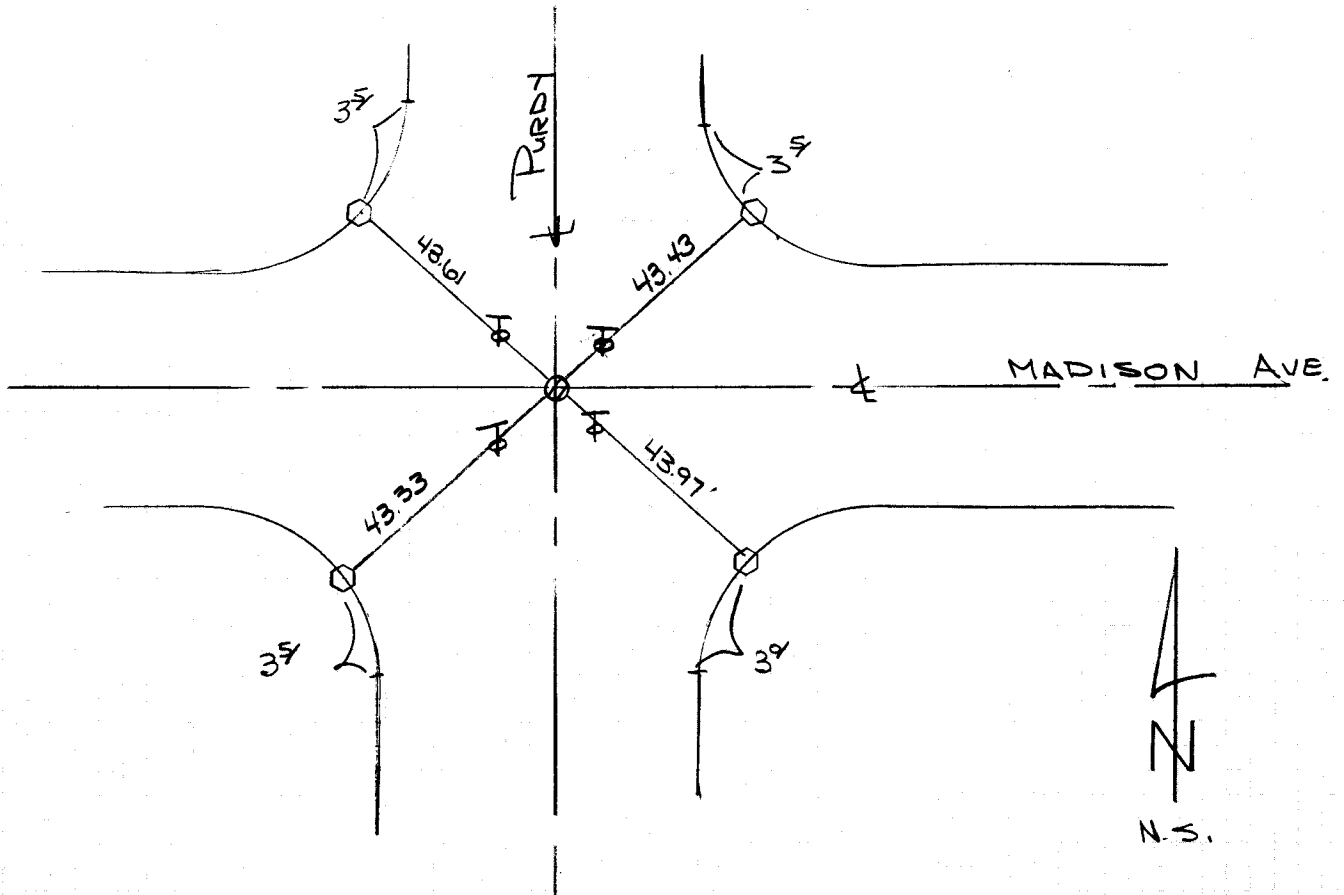

SURVEY OF E PURDY ST

INDEX

PAGE

4 of 5


SURVEYED BY

Flynn


DATE

9-22-86

ORANGE COUNTY SURVEYOR

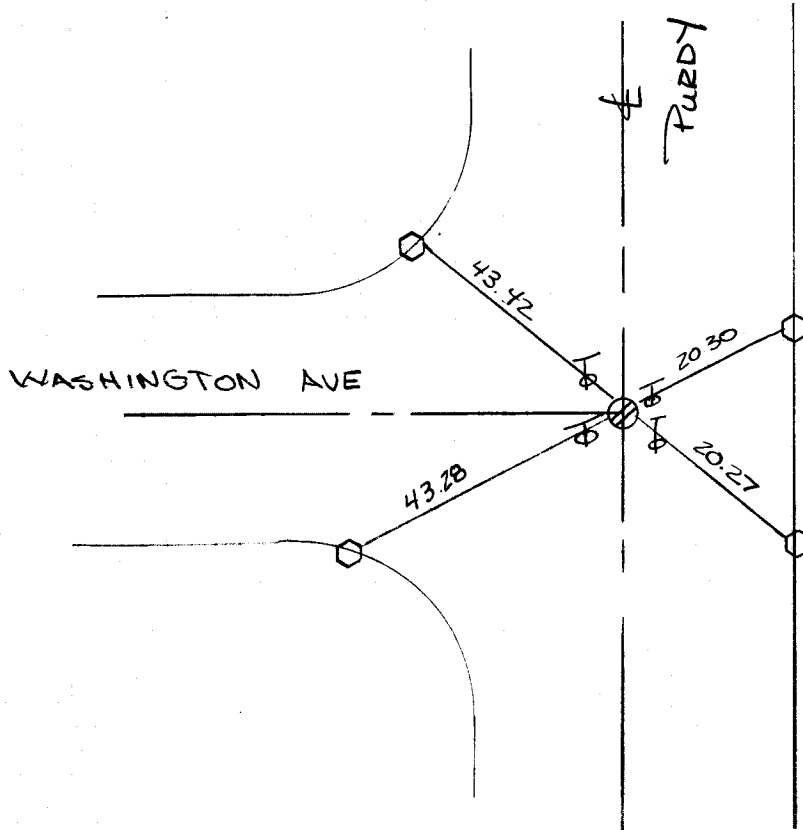

- ⊗ nothing set - pt. falls on manhole cover.
- set L & o.c. tie tag and pin on T.C.

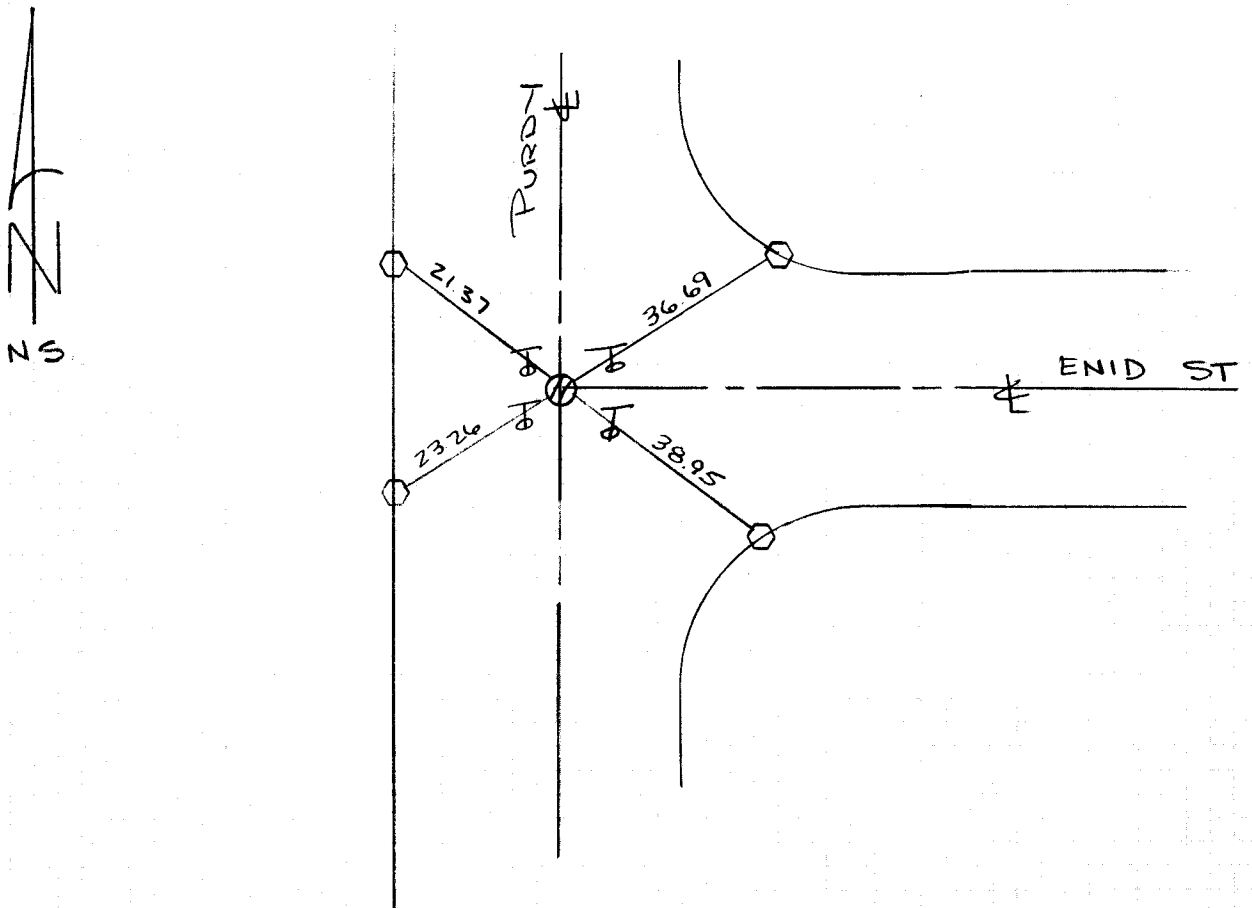

SURVEY OF

Purdy ST

INDEX

PAGE

5 of 5

SURVEYED BY

Flynn

DATE

9-22-86

ORANGE COUNTY SURVEYOR

