

ORANGE COUNTY SURVEYOR
SURVEY NOTES

A/5-11&12 561

ALIGNMENT INDEX BOOK AND PAGE

ALIGNMENT NOTES PG. ____ OF ____

PPB _____ WORK ORDER NUMBER C40253410

SURVEY NOTES PAGE 1 OF 28

SURVEY COMPLETION DATE 10-3-85

SURVEY FILE NUMBER F85-035

PROJECT NAME PURDY STREET STORM DRAIN

SURVEY LIMITS PURDY STREET FROM BOLSA AVE TO HAZARD AVE

PURPOSE OF SURVEY X-SECTIONS

THOMAS BROS.:

BLOCK AND MODULES:

Pg. 21

5747/85, 5747/95, 5847/05, 5847/15, 5847/20
5747/24, 5847/04, 5847/14

SURVEY NOTE PAGE INDEX:

EQUIPMENT:

PERSONNEL:

ALIGNMENT 1 THRU 5

LEVEL 6 THRU 7

X-SECTIONS 8 THRU 23

TIES 24 THRU 25

TOPCON #4235

WILD T-1

ZEISS LEVEL

LENKER ROD

P.C. J. FLYNN

INST W. SAKACH

R/C P. BUBE

CHAIN T. BURNS

REFERENCES / REMARKS :

R.S. 86-1047

DEPUTY COUNTY SURVEYOR'S NOTE:

The purpose of these notes is to show the relationship of the points and/or lines shown herein to other lines of record, control lines, or to each other. The Deputy County Surveyor does not claim at this time, that the points or lines shown herein are true existing boundary, point or control points or lines. Without further analysis, the interpretation of these notes is left to the discretion of the user.

John Ennis
Deputy County Surveyor

By:


Lain Toomey
Supervising Land Surveyor

PURDY STORM DRAIN


FLYNN


10-385

ORANGE COUNTY SURVEYOR

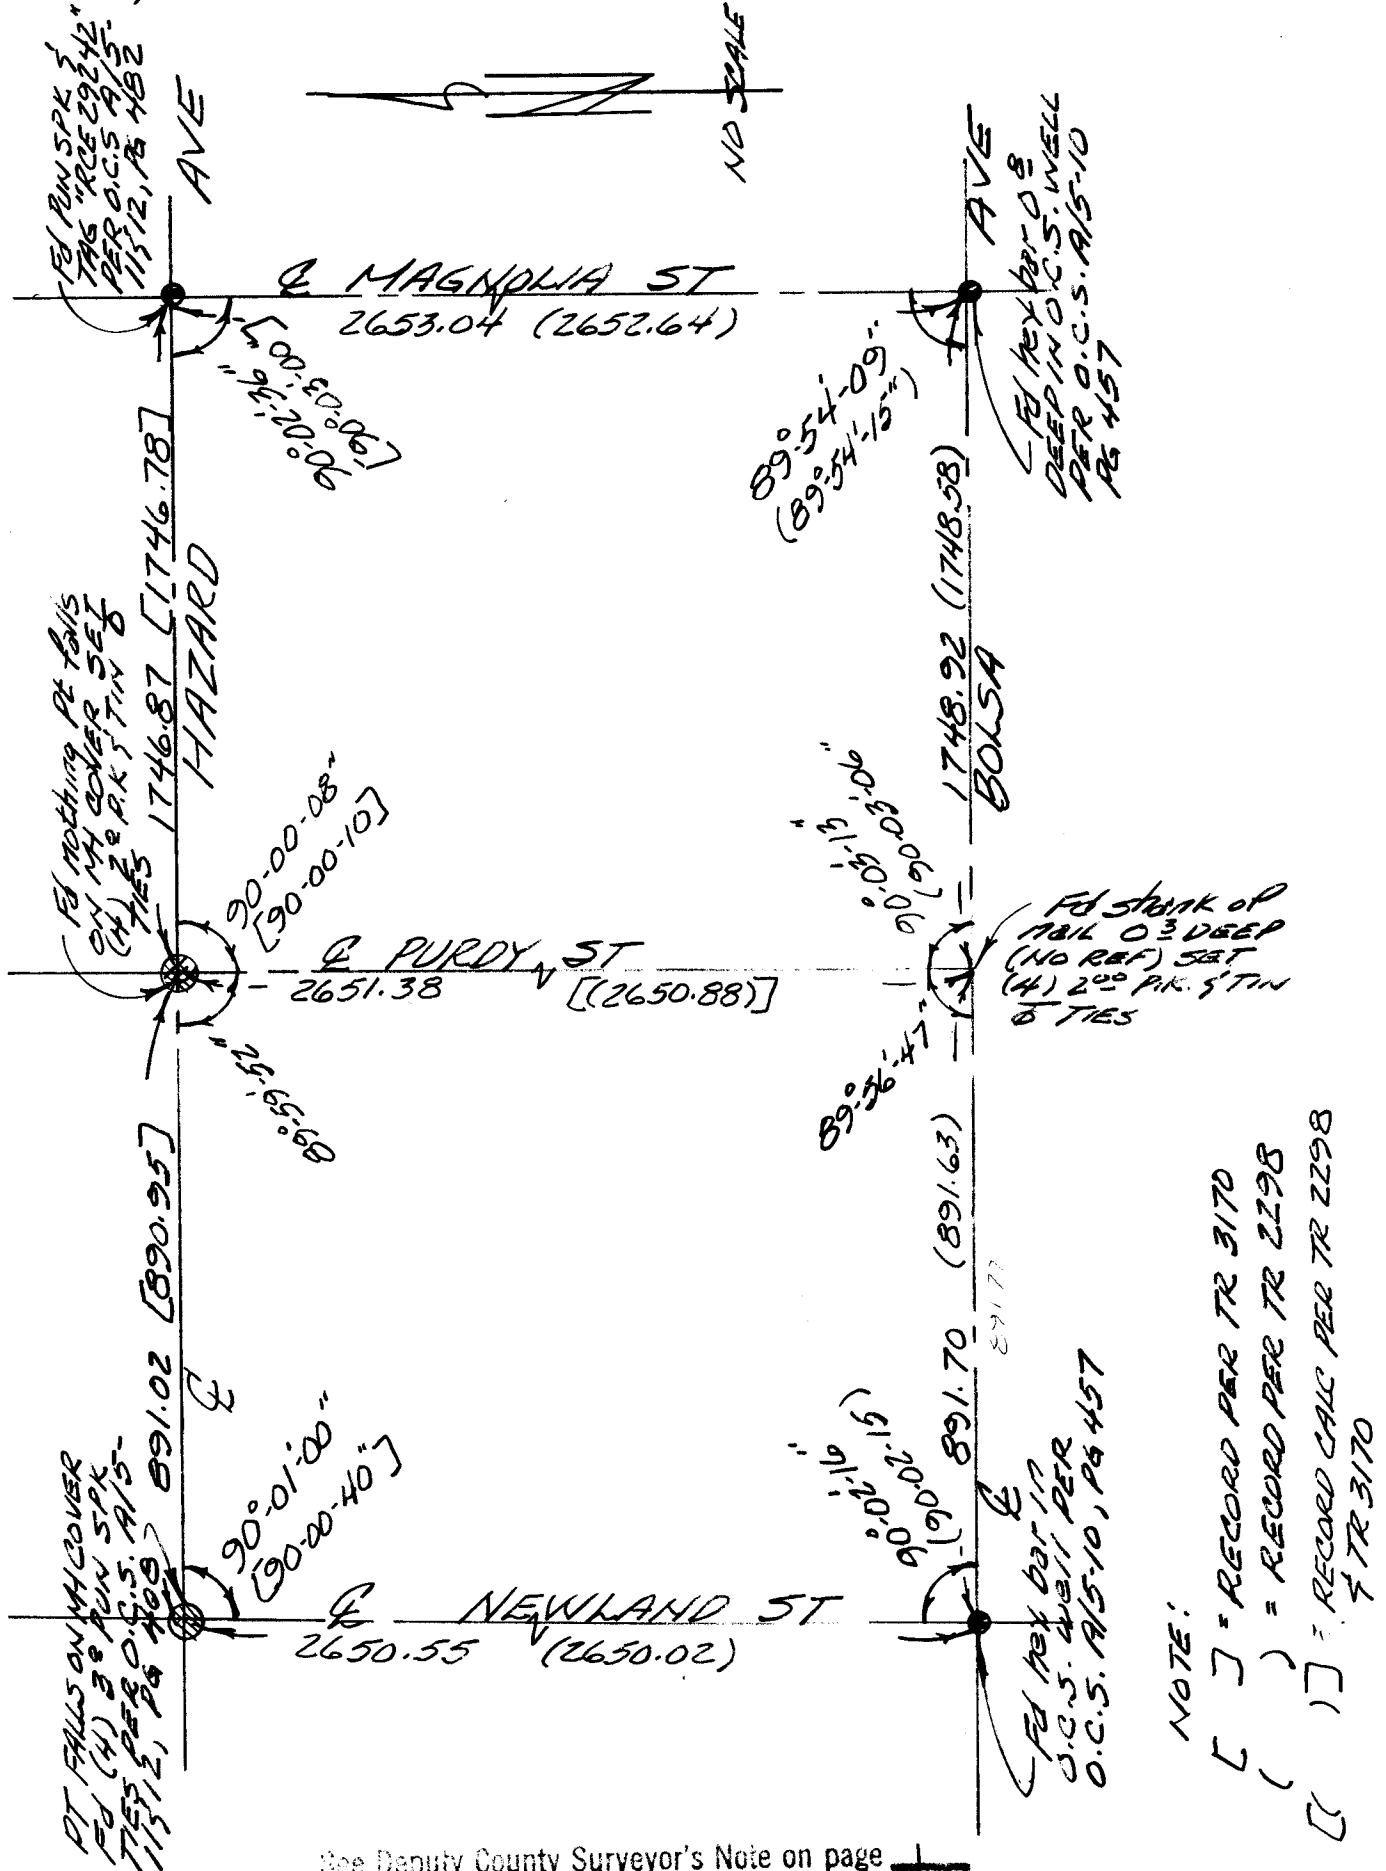

10-3-85

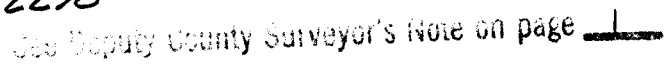

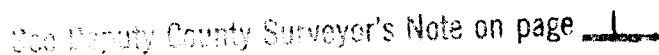


PURDY ST STORM DRAIN
FLYNN

A/5-11&12

565

5 of 28

10-3-85

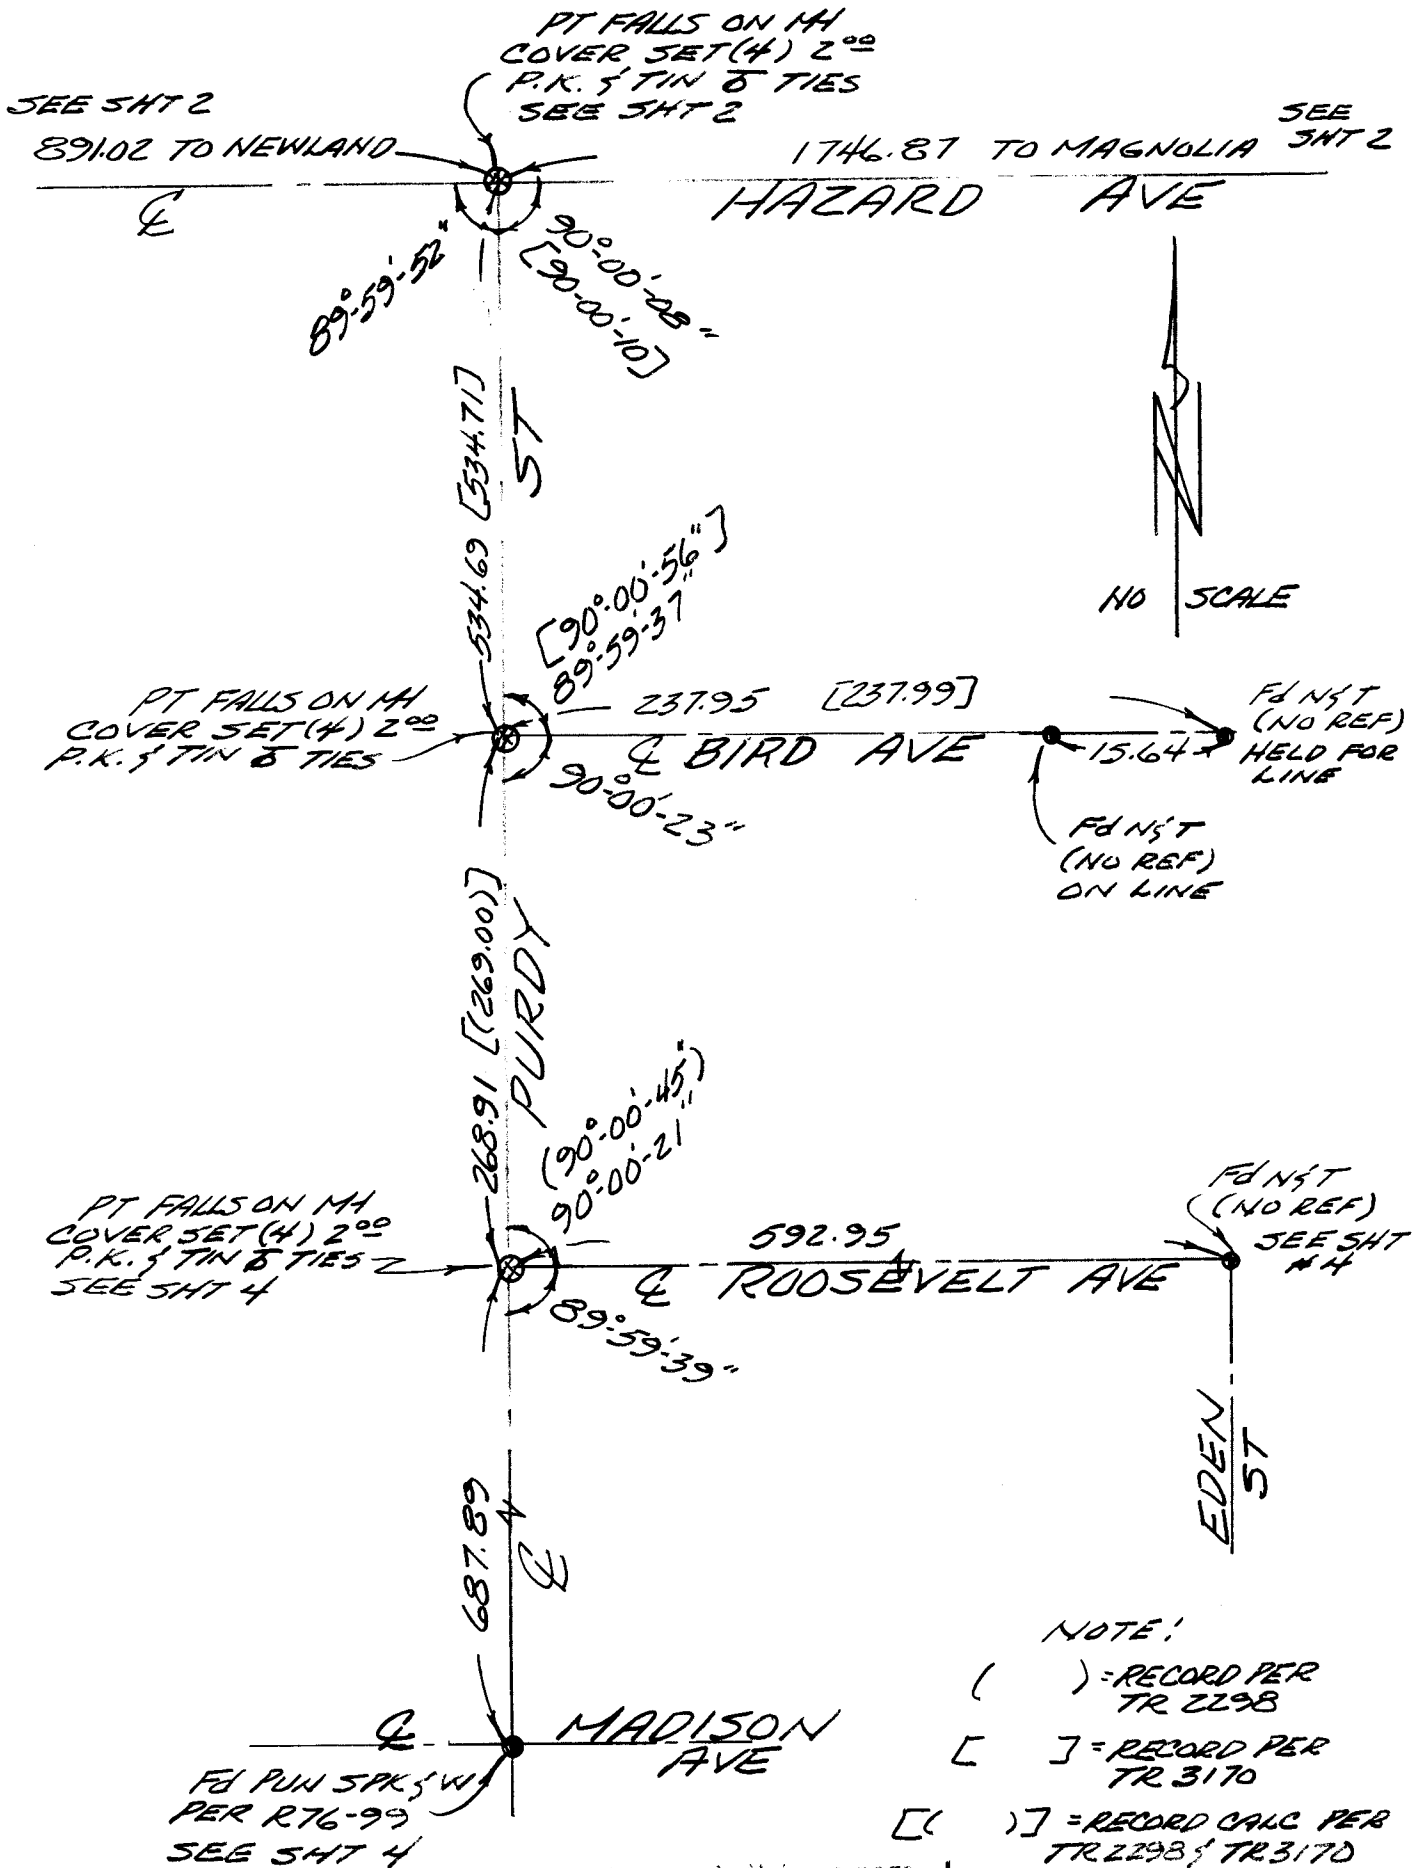


PURDY ST. STORM DRAIN

A/5-11&12 566

240P28

FLYING

10-3-85

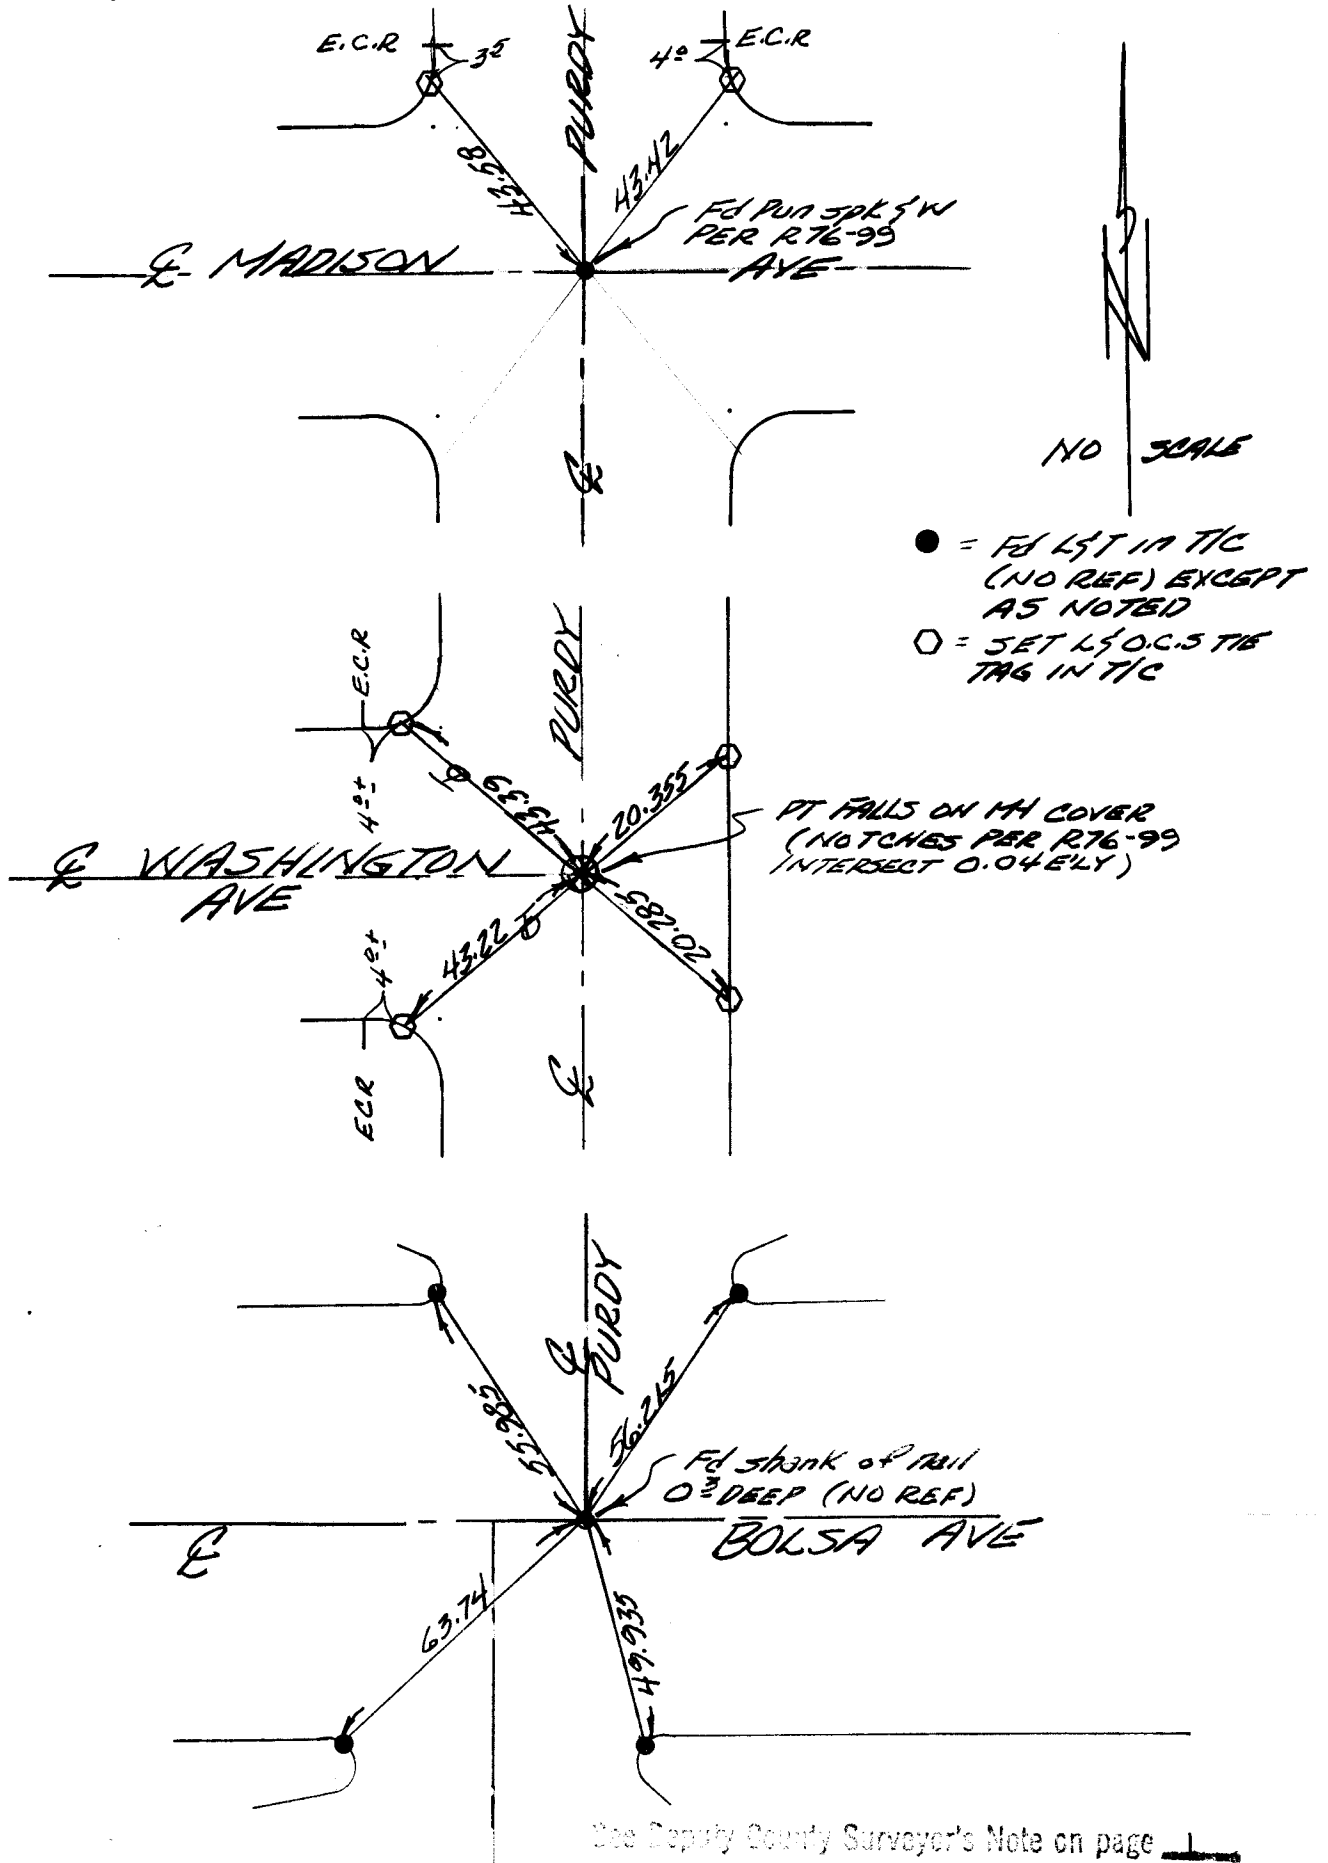


PURDY ST. STORM DRAIN
FLYNN



A/5-11&12 567

10-3-85

250P28

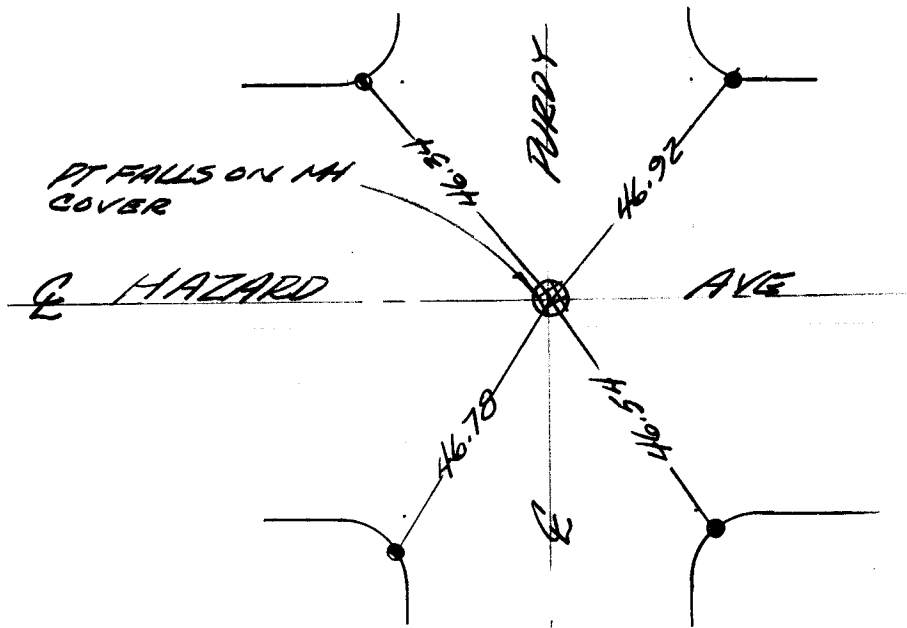

- = FD LST IN TIC (NO REF) NOT TIES
- ▲ = FD CH " IN TIC (NO REF)
- = SET LST 5" O.C. 5 TIE TAG IN TIC

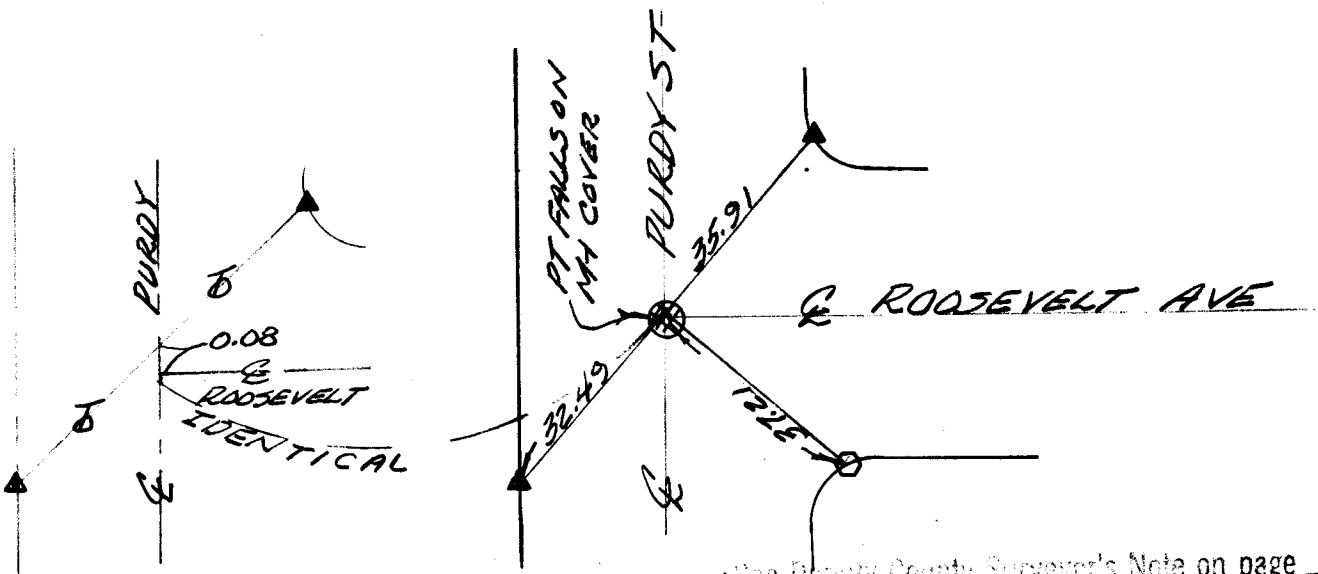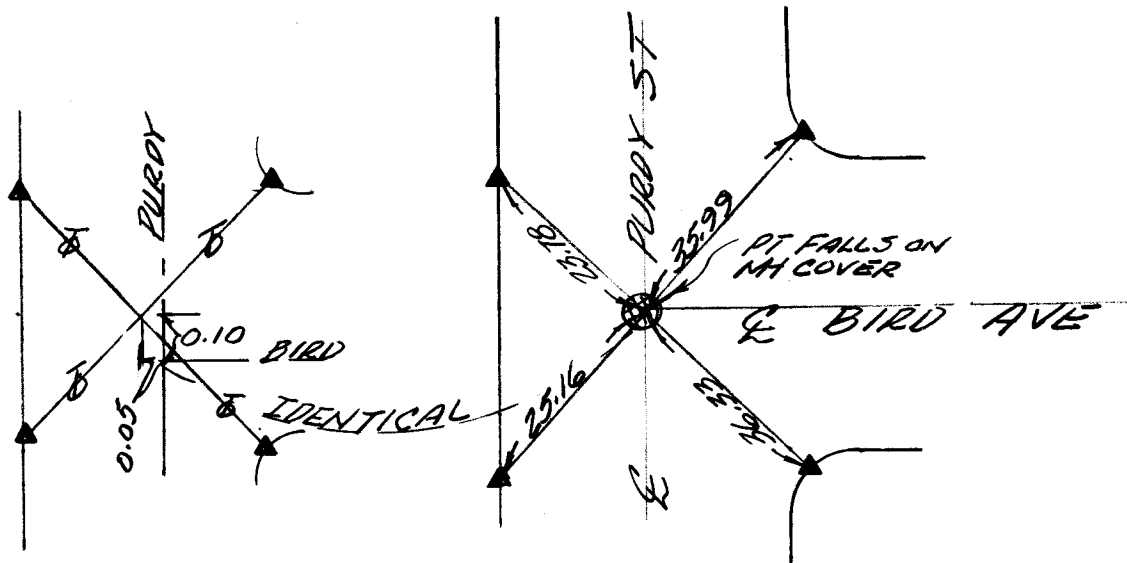

SURVEY OF PURDY ST STORM DRAIN

A/5-11&12


568

PAGE 26 of 28

SURVEYED BY Flynn & PTY

DATE 11-18-85

ORANGE COUNTY SURVEYOR

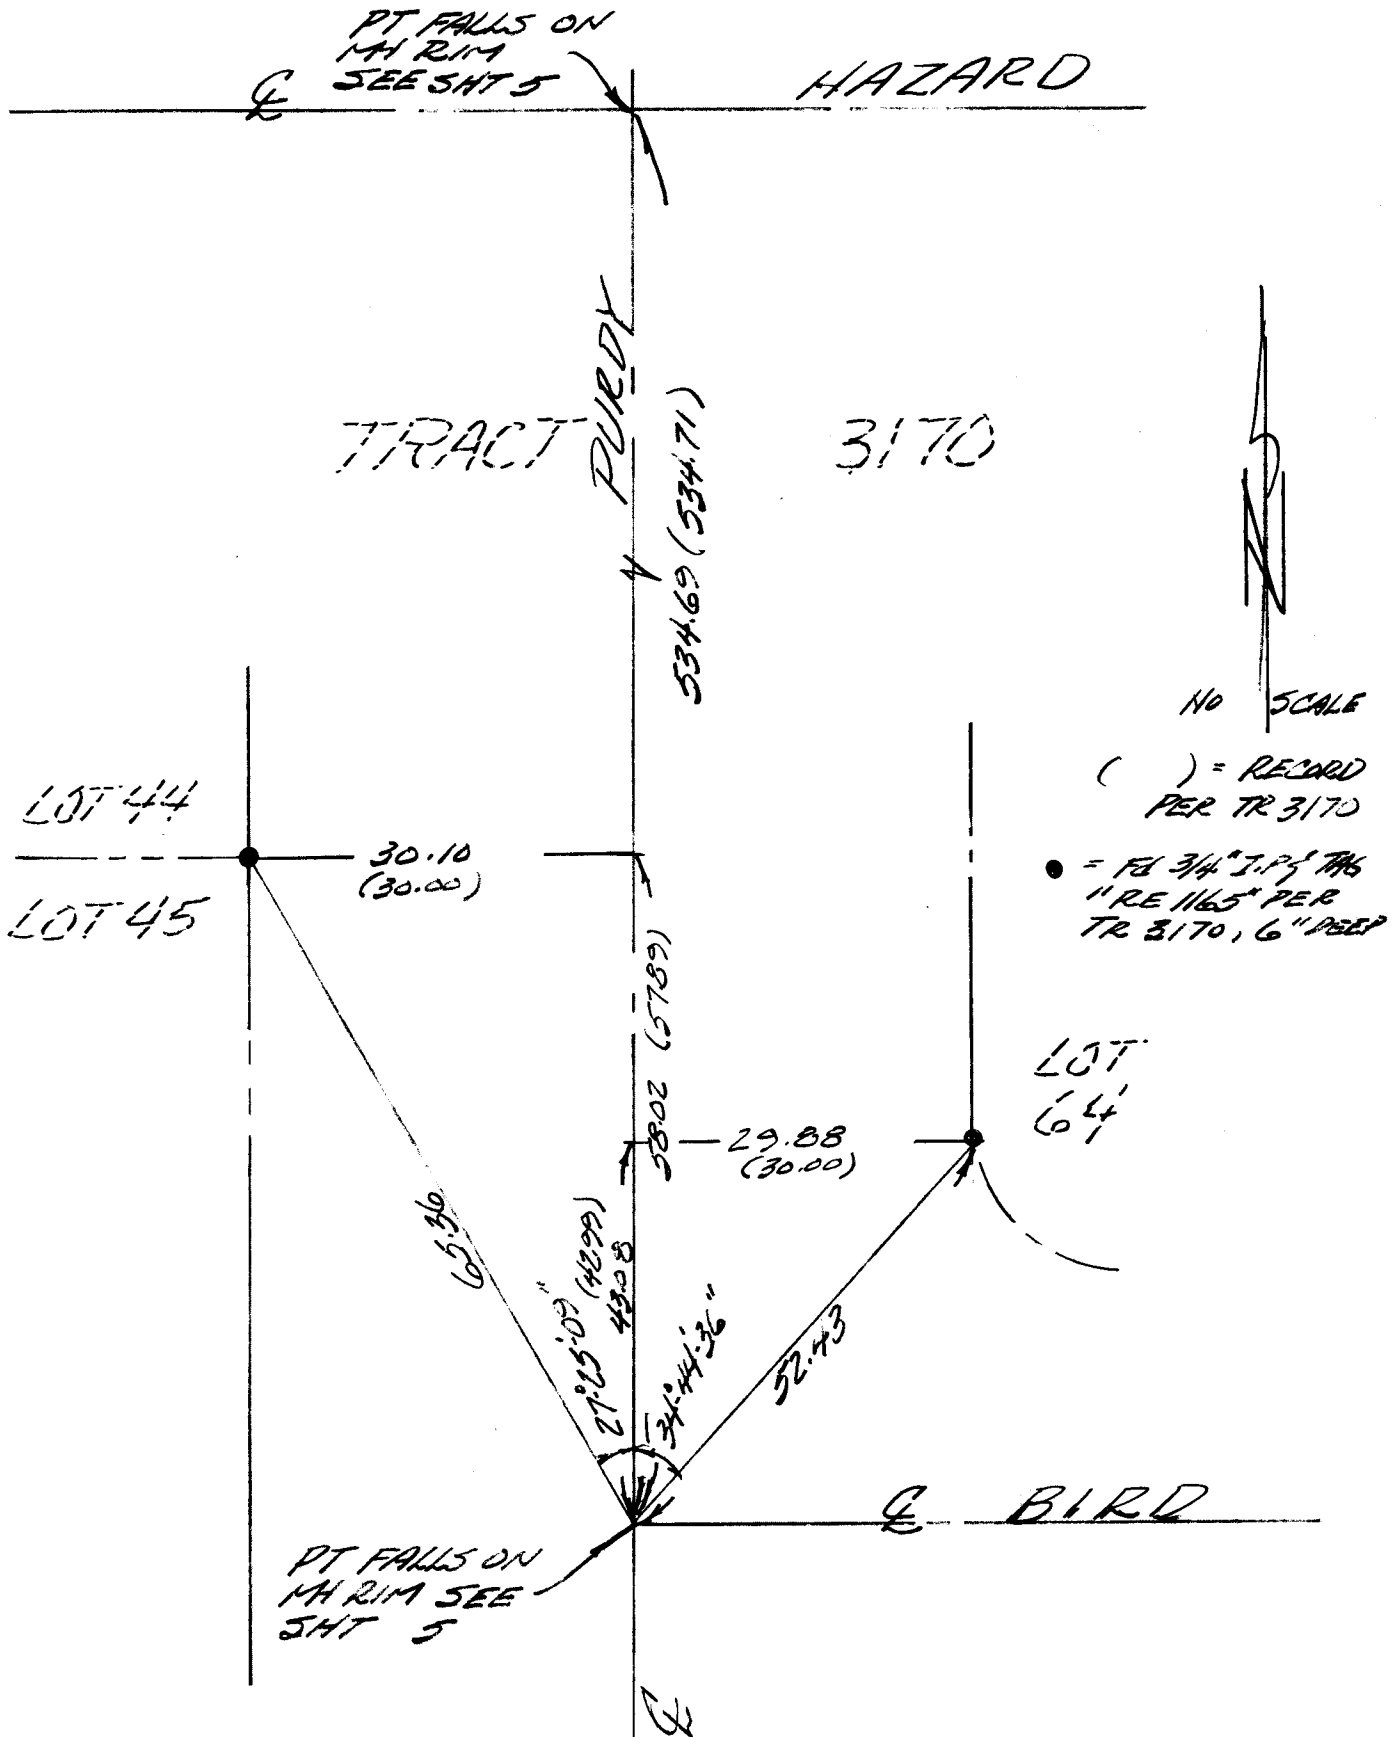

APPROVED BY *Flynn & PTH*

DATE 11-18-85

ORANGE COUNTY SURVEYOR

