

ORANGE COUNTY SURVEYOR
PRELIMINARY SURVEY

R77-37 (MF)

A/5-11&12 591

PROJECT

NEWLAND STREET

LIMITS OR LOCATION

150' S/O Balsa Ave. to 150'
N/O Hazard Ave.

WORK ORDER NUMBER PPB DATED

R1431120

KB

3-25-77

PAGE INDEX

ALIGNMENT PG. 1 TO PG. 5

LEVEL RUN PG. 6 TO PG. 11

TOPO PG. 12 TO PG. 45

DETAILS PG. 46 TO PG. 50

X-SECTION PG. 51 TO PG. 80

DATE COMPLETED

4-28-77

REMARKS

Int. ties @ Newland St. @
Washington, Madison Ave, & Roosevelt Ave.
Per C.S.T.B. 130-B are on displaced curbs

DEPUTY COUNTY SURVEYOR'S NOTE:

The purpose of these notes is to show the relationship of the points and/or lines shown hereon to either lines or record, control lines, or to each other. The Deputy County Surveyor does not claim at this time, that the points or lines shown hereon are true centerline, boundary, deed, or control points or lines. Without further analysis, the interpretation of these notes is left to the discretion of the user.

John Canas
Deputy County Surveyor

By:


John Toomey
Supervising Land Surveyor

EQUIPMENT

TZ 169318
EDM 2549
Level 14208
FT. chain 63
Meter chain 55

PERSONNEL

R. Bailey
D. Minich
J. DelSigne
J. Pfeifer

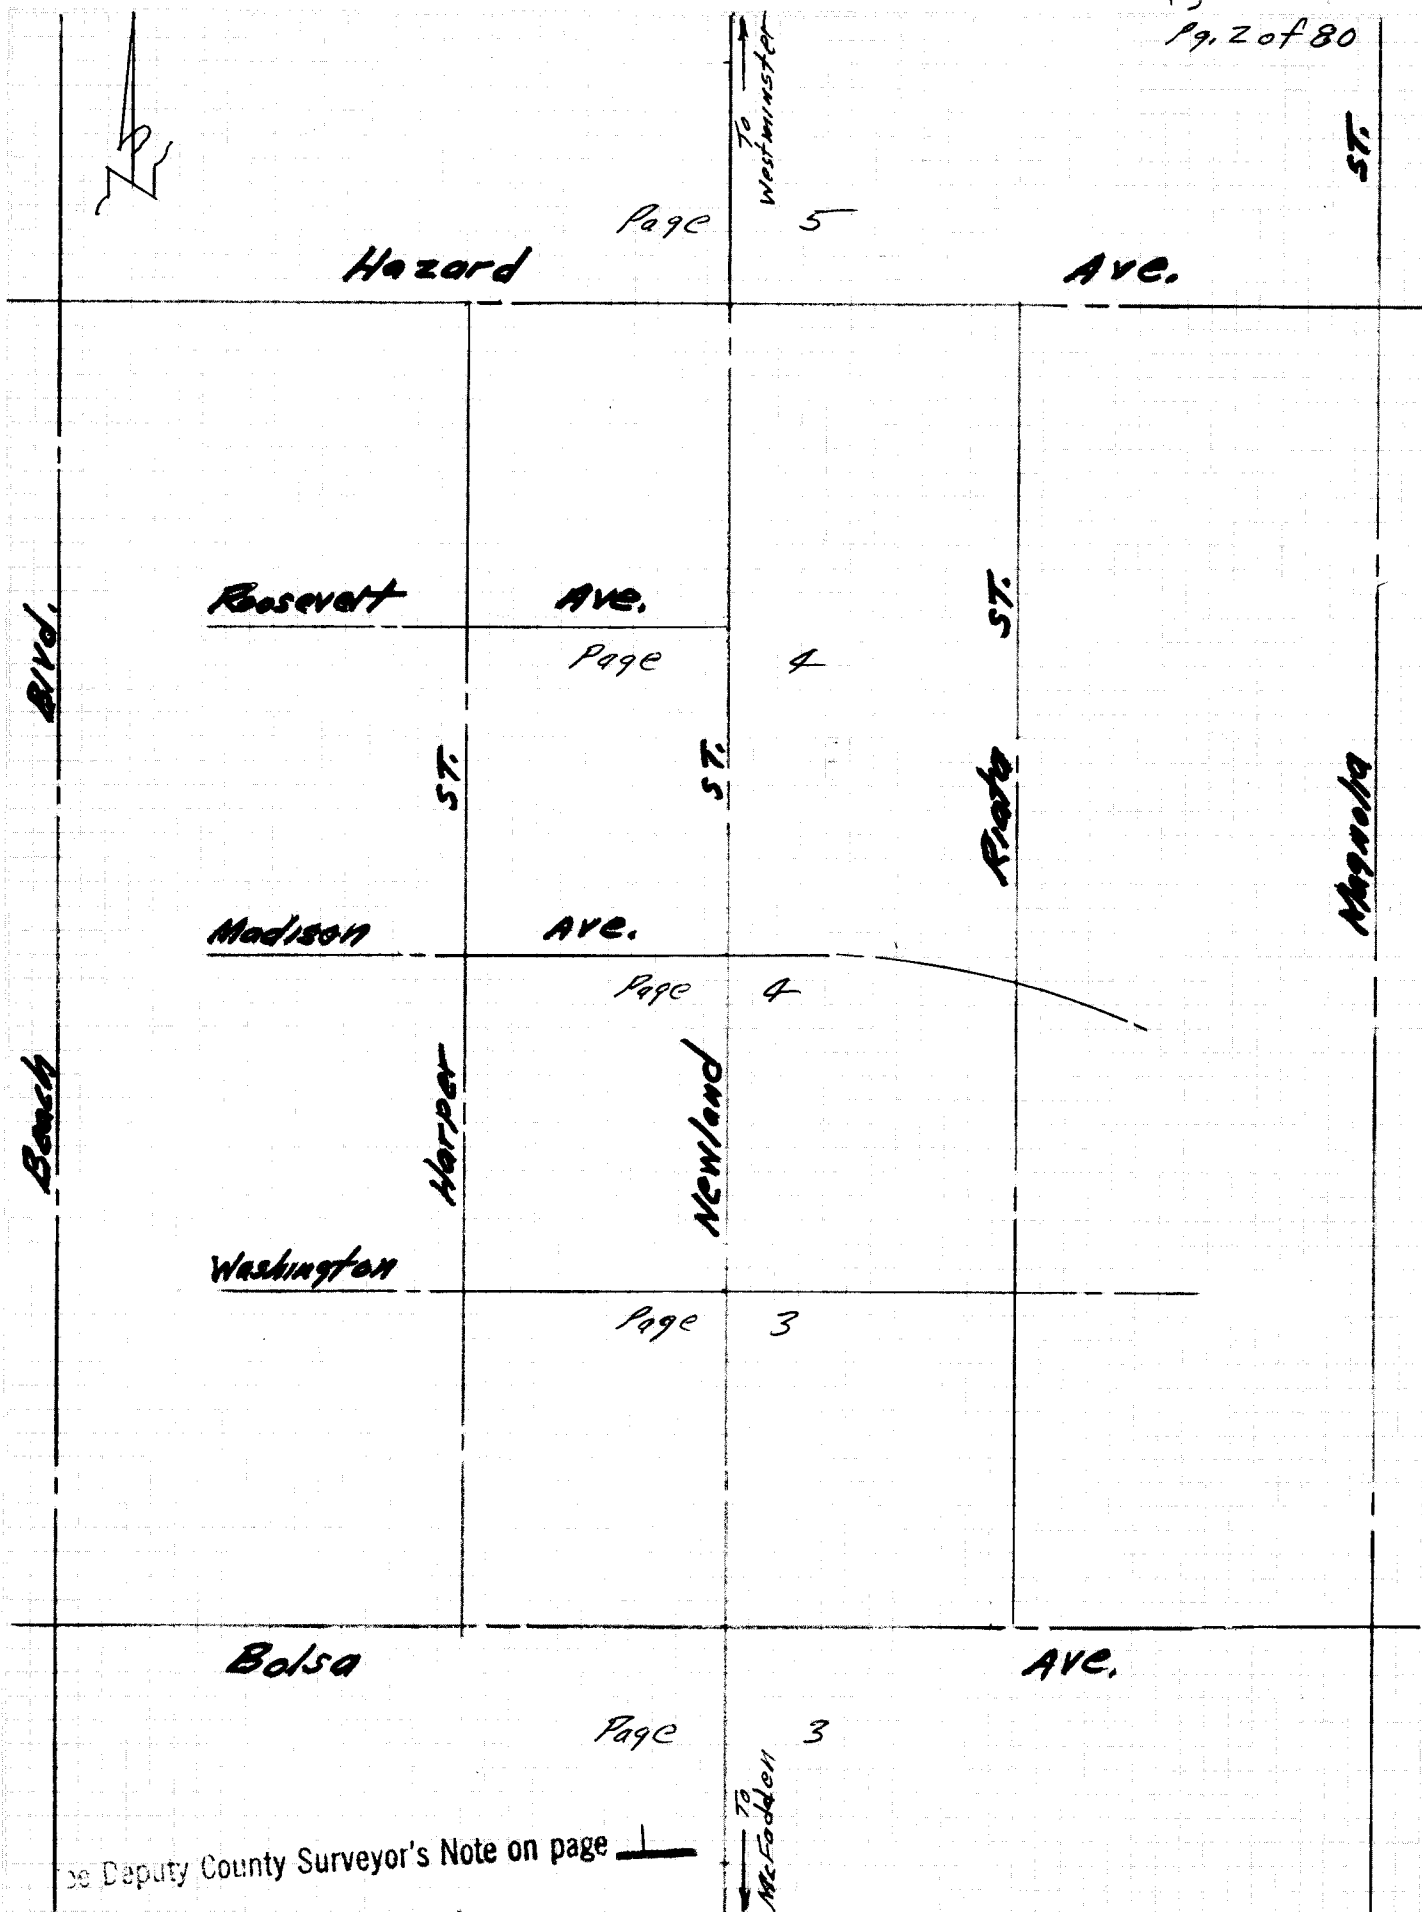

Newland ST.

A/5-11&12

594

pg 4 of 5

Bailey & pty.

4-12-77

Sec Pg. 5

Ave.

pg. 4 of 80

Hazard

INT. PT. ON "S" NH LID

• = Fd. chis. "t" IN T.C.
PER C.S.T.B. 133-36

Roosevelt Ave.

329.78 EDM
(329.73 TR. 665)

Set P.M. SPK. IN
CTR. of $\square$ formed
by the intersection
Notes: curbs are
displaced

90°00'00"
TR. 635.55
Fd. chis. "t"

ST.

662.76 EDM
(662.51 PER TR. 2298)

• = set chis. "t" IN T.C.

Set INT. PT. ON "S"
NH LID PER TIES (2) chis. "t"
C.S.T.B. 130-8
Set 2 N&T TIES
2005 S. WIX
1995 S. ELY

2650.555 EDM
(2650.02 PER TR. 2298)
2650.570 C.S. 11512
109.408

90°00'00"
TR. 2298
Set INT. ON "S" NH LID
PER TIES (2) PER C.S.T.B.
130-8 Set 2-300
N&T TIES S. WIX &
S. ELY

Set chis. "t" @ P.I.
Cal. conc. nail
1300 009 SIX 5 005 ELY ST.

• = Fd. chis. "t"
IN T.C.

Madison

329.95 EDM
(329.89 TR. 635)

• = Fd. chis. "t"
IN T.C. PER C.S.T.B. 133-36
Notes: curbs
are displaced

Set INT. PT. ON
"S" NH LID @ ELY
of $\square$ formed by
the intersection
Set 2-200 N&T
TIES S. WIX
& S. ELY

90°00'00"
TR. 635.55
Fd. chis. "t"

Newland

662.725 EDM
(662.50 PER TR. 2298)

Ave.

253.14 EDM
(253.15 TR. 2298)

Fd. PK NAIL
ON LINE

• = Set chis. "t" IN T.C.
1/2 E/O ECR

90°00'00"
TR. 2298
2005.650
2005.650

156.29.06"
TR. 2298.00"

Piota

ROC. Set conc. nail by 2
curve defl. & chords

(4=13056'45"
R=1000
PER TR. 2298)

Set chis. "t"
Fd. N&T 0.135 IV
1000 ELY OF ARC

Washington

INT. PT. ON "S"
NH LID

Bolsa

Fd. OCS W/II MOM.
W/ hex bar
Ave.

See Pg. 3

