

Orange County Surveyor

MANHOLE DETAIL:

JOB NO: EX15DM18

DATE: 03/18/2024

CREW: T. LOFGREEN & CREW

STREET: ARC SE'LY OF BUILDING



TIME: _____ AM / PM

MANHOLE TYPE: SEWER

LID POINT NO: 600082

PHOTO NO: MHH 2

PIPE MATERIAL: CONCRETE

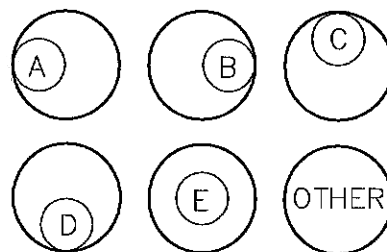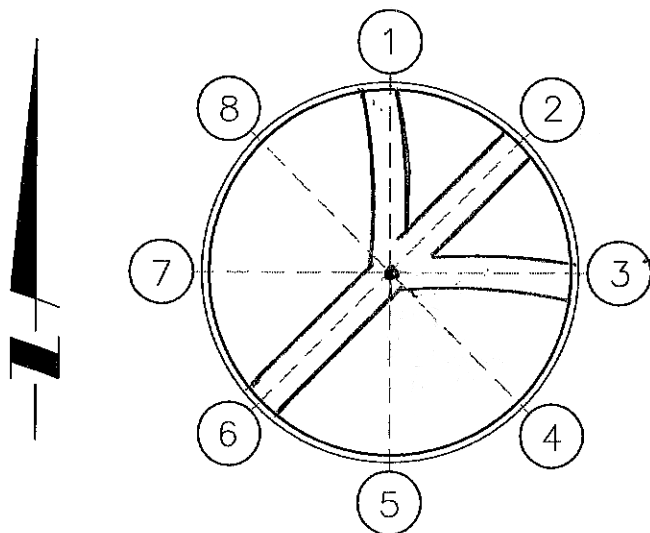

RIM OFFSET TYPE: _____

POINT:	RIM ELEV:	INVERT:	F.L. ELEV:	PIPE DIA:	
1	129.69	7.77	121.92	4"	☒ WET / ☐ DRY
2	129.65	7.75	121.90	4"	☒ WET / ☐ DRY
3	129.63	7.77	121.86	8"	☒ WET / ☐ DRY
4					☐ WET / ☐ DRY
5					☐ WET / ☐ DRY
6	129.68	7.91	121.77	8"	☒ WET / ☐ DRY
7					☐ WET / ☐ DRY
8					☐ WET / ☐ DRY
CNTR:	129.71	7.88	121.83	-----	☒ WET / ☐ DRY

