

Orange County Surveyor

MANHOLE DETAIL:

JOB NO: EX15DM18

DATE: 03/18/2024

CREW: T. LOFGREEN & CREW

STREET: ARC PARKING LOT



TIME: _____ AM / PM

MANHOLE TYPE: SEWER

LID POINT NO: 601573

PHOTO NO: N/A

PIPE MATERIAL: CONCRETE

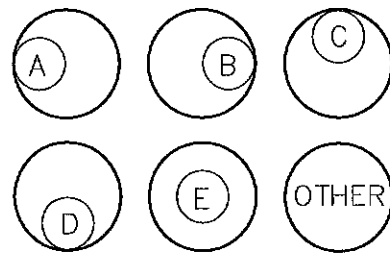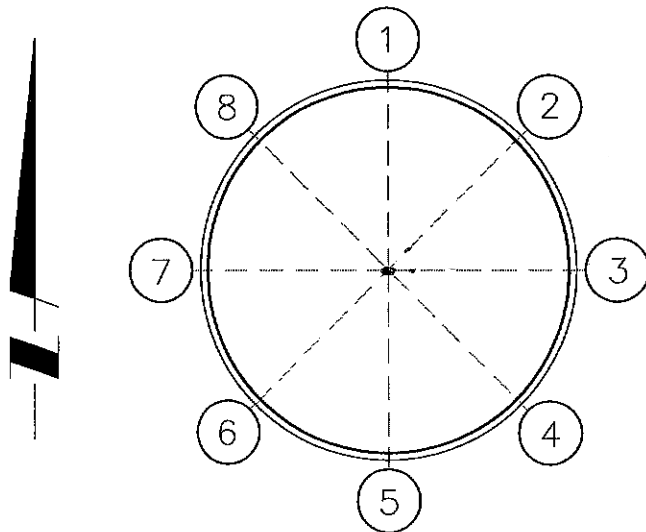

RIM OFFSET TYPE: _____

POINT:	RIM ELEV:	INVERT:	F.L. ELEV:	PIPE DIA:	
1					WET / DRY
2	126.99	7.80	119.19	8"	WET / DRY
3					WET / DRY
4					WET / DRY
5					WET / DRY
6	126.91	7.90	119.01	8"	WET / DRY
7					WET / DRY
8					WET / DRY
CNTR:	126.93	7.83	119.10	-----	WET / DRY