


- Easement Deeds**
to Metropolitan Water District
- 1 O.R. 1049-171 T.I. 245150 Ex. 12
 - 2 O.R. 1061-12, T.I. 245367 Ex. 7
 - 3 O.R. 1053-516, T.I. 245149 Ex. 8
 - 4 O.R. 1059-553, O.R. 1057-218, T.I. 245149 Ex. 9
 - 5 O.R. 2721-644, T.I. 245149 Ex. 15

- OCFCD GRANT (PCL. 1105.1) TO COUNTY IN
FEE PER O.R. 20030369248 FOR PARKING;
OCFCD RESERVED ACCESS EASEMENT
- PCL. 1110.01 IS A REMAINDER PARCEL
AFTER GRANTING PCL. 1105.1 TO COUNTY
- PCL. 1106.01 IS A REMAINDER PARCEL
AFTER GRANTING PCL. 1105.1 TO COUNTY
- PCL. 1105.01 IS A REMAINDER PARCEL
AFTER GRANTING PCL. 1105.1 TO COUNTY
- PCL. 1107
- PCL. 1103
- PCL. R1601 (ENTRY PERMIT ONLY; PROPERTY IS
STATE OF CALIFORNIA)

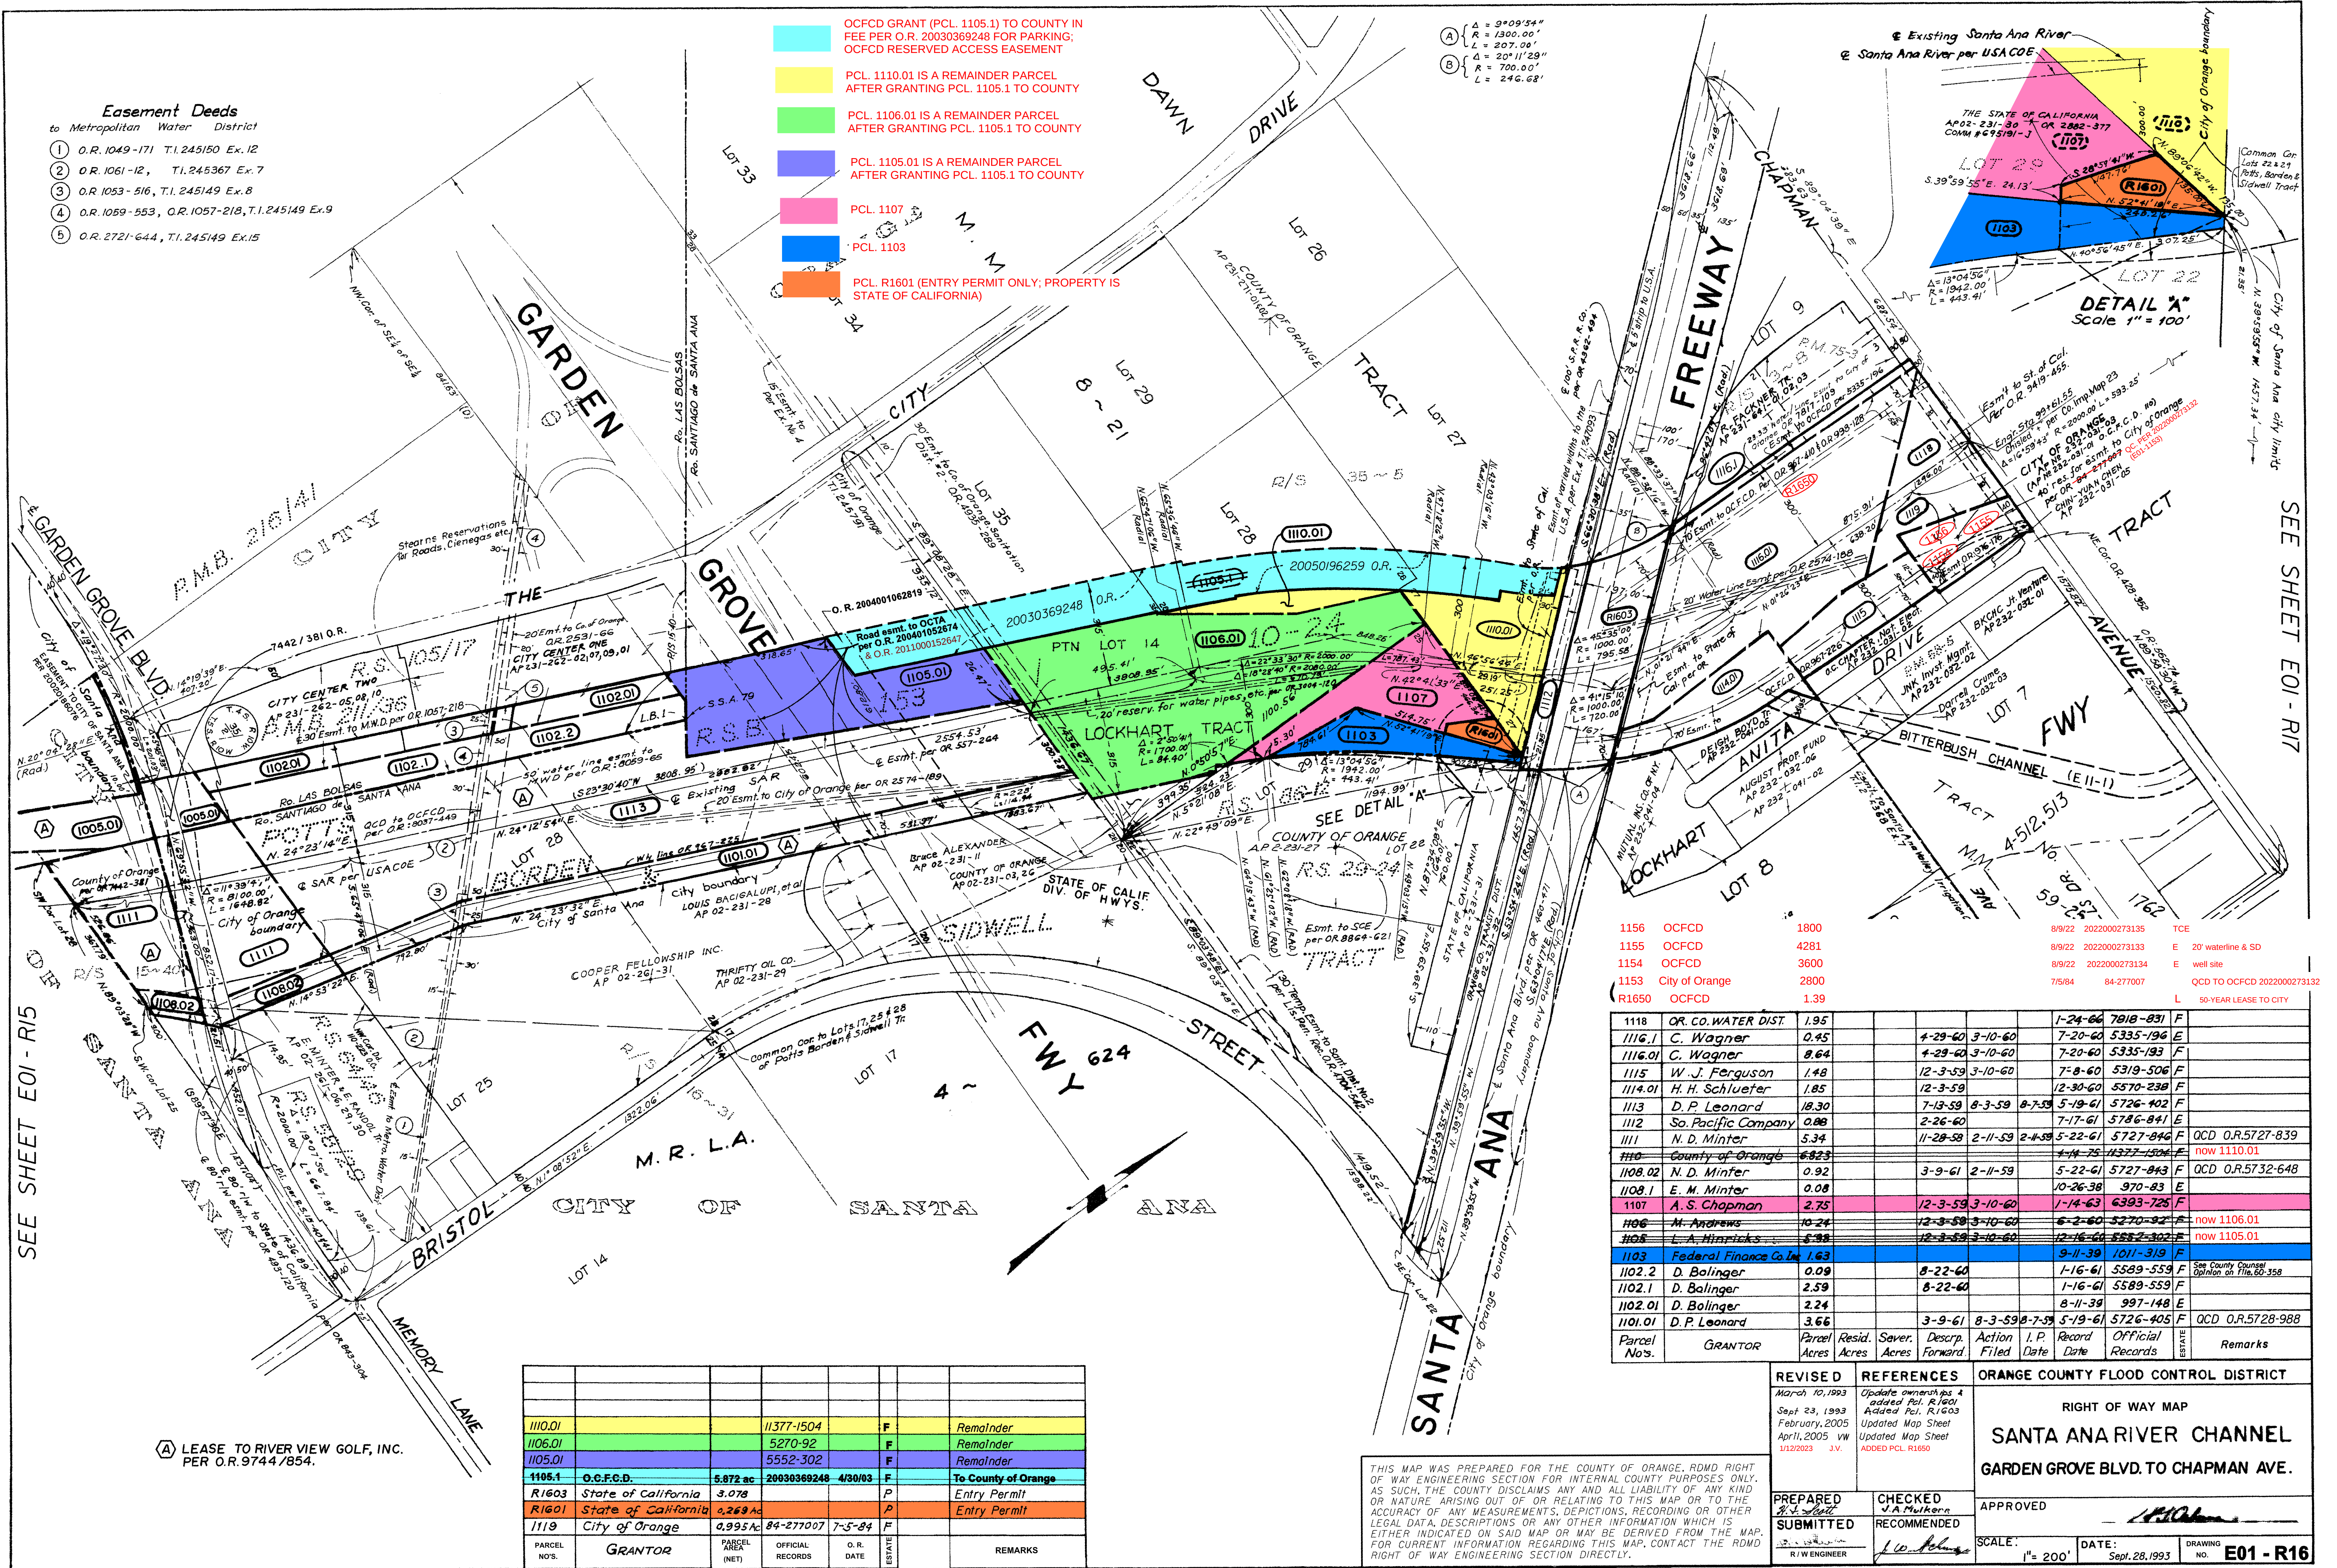

PARCEL NO'S.	GRANTOR	PARCEL AREA (NET)	OFFICIAL RECORDS	O.R. DATE	ESTATE	REMARKS
1110.01			11377-1504	F		Remainder
1106.01			5270-92	F		Remainder
1105.01			5552-302	F		Remainder
1105.1	O.C.F.C.D.	5.872 ac	20030369248 4/30/03	F		To County of Orange
R1603	State of California	3.078		P		Entry Permit
R1601	State of California	6.269 ac		P		Entry Permit
1119	City of Orange	0.995 ac	84-277007 7-5-84	F		

1156	OCFCD	1800	8/9/22	2022000273135	TCE
1155	OCFCD	4281	8/9/22	2022000273133	E 20' waterline & SD
1154	OCFCD	3600	8/9/22	2022000273134	E well site
1153	City of Orange	2800	7/5/84	84-277007	QCD TO OCFCD 2022000273132
R1650	OCFCD	1.39			L 50-YEAR LEASE TO CITY

1118	OR. CO. WATER DIST.	1.95				1-24-66	7818-831	F	
1116.1	C. Wagner	0.45				4-29-60	5335-196	E	
1116.01	C. Wagner	0.64				4-29-60	5335-193	F	
1115	W. J. Ferguson	1.48				12-3-59	5319-506	F	
1114.01	H. H. Schluefer	1.85				12-3-59	5570-238	F	
1113	D. P. Leonard	18.30				7-13-59	5726-402	F	
1112	So. Pacific Company	0.08				2-26-60	5786-841	E	
1111	N. D. Minter	5.34				11-28-58	5727-846	F	QCD O.R. 5727-839
1110	County of Orange	6.823				4-14-75	11377-1504	F	now 1110.01
1108.02	N. D. Minter	0.92				3-9-61	5727-843	F	QCD O.R. 5732-648
1108.1	E. M. Minter	0.08				10-26-38	970-83	E	
1107	A. S. Chapman	2.75				12-3-59	6393-725	F	
1106	M. Andrews	10.24				12-3-59	5270-82	F	now 1106.01
1105	L. A. Hinricks	6.98				12-3-59	5582-302	F	now 1105.01
1103	Federal Finance Co. Inc.	1.63				9-11-39	1011-319	F	
1102.2	D. Bolinger	0.09				1-16-61	5589-559	F	
1102.1	D. Bolinger	2.59				1-16-61	5589-559	F	
1102.01	D. Bolinger	2.24				8-11-39	997-148	E	
1101.01	D. P. Leonard	3.66				3-9-61	5726-405	F	QCD O.R. 5728-988
Parcel No's.	GRANTOR	Parcel Resid. Acres	Sever. Acres	Action Forward	I. P. Record Filed	Date	Official Records	ESTATE	Remarks