


CITY OF ORANGE
CENTERLINE INTERSECTION TIES
TRACT or S.P. No. SP 1599

THE CITY DRIVE

~~MANCHESTER AVE~~

AND E BC - EC

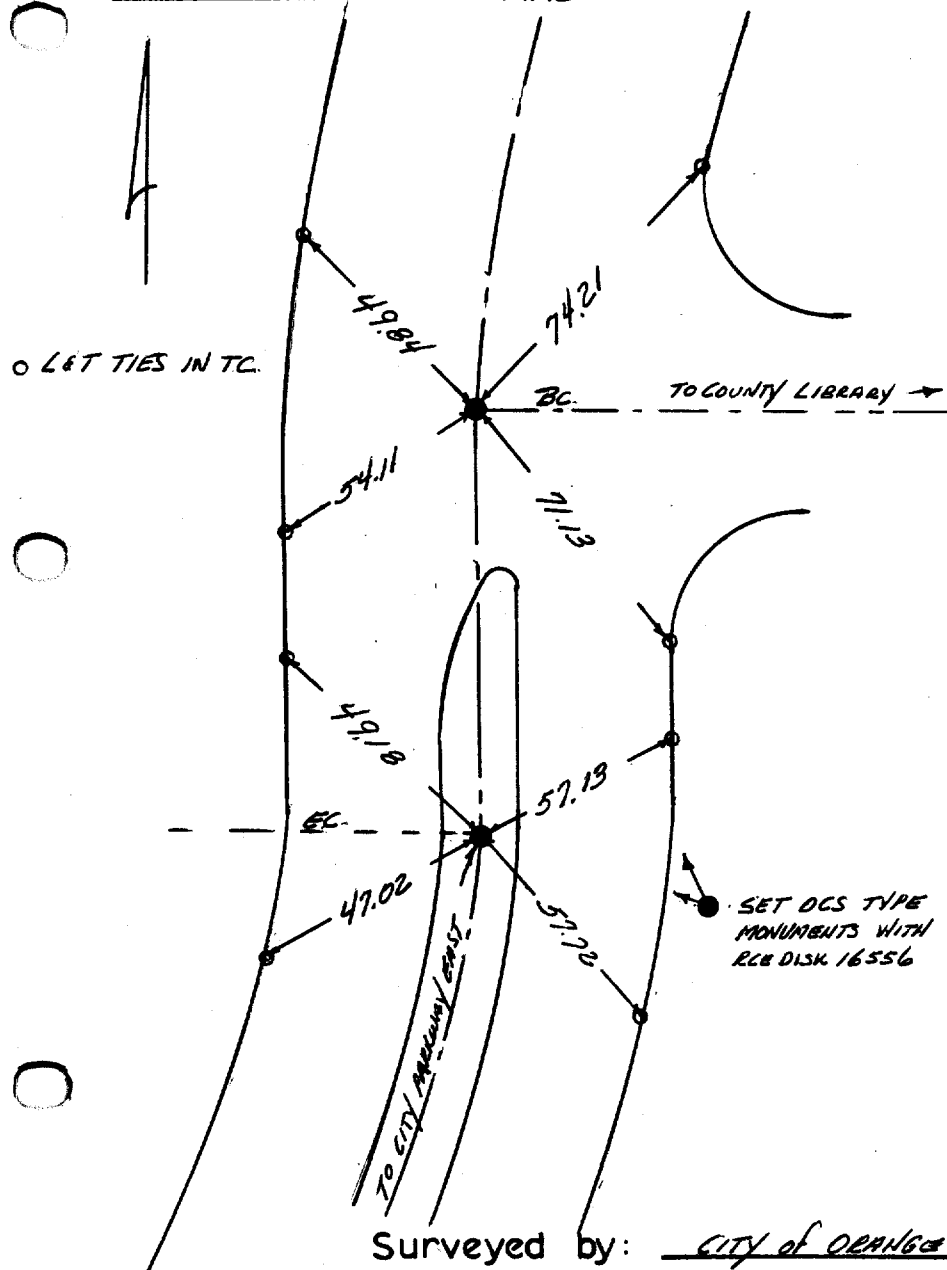

Surveyed by: CITY OF ORANGE

Date: 11-16-71

1506⁰⁰