



OC PUBLIC WORKS DEPARTMENT

SHANE SILSBY, DIRECTOR

KEVIN HILLS, COUNTY SURVEYOR

BOLSA CHICA CHANNEL (C02) PHASE I

LIMITS: LAMPSON AVE TO 783' D/S KATELLA AVE



SECTIONS WERE DERIVED FROM RECORD AS-BUILT PLAN C02-101-2A JUNE 1959 BETWEEN STATIONS 291+52.24 TO 361+87.25 AND O.C.S TOPOGRAPHIC SURVEY DATED NOVEMBER 2019

THE DOCUMENT IS SUPPLEMENTAL TO THE TOPOGRAPHIC SURVEY MAP DATED NOVEMBER 2019.

PROJECT CROSS SECTIONS

U.S. Survey Foot


OC Public Works/Engineering Services
OC Survey/Field Services
Boundary Analysis & Mapping



BOLSA CHICA CHANNEL (C02)

291+52.24

CL

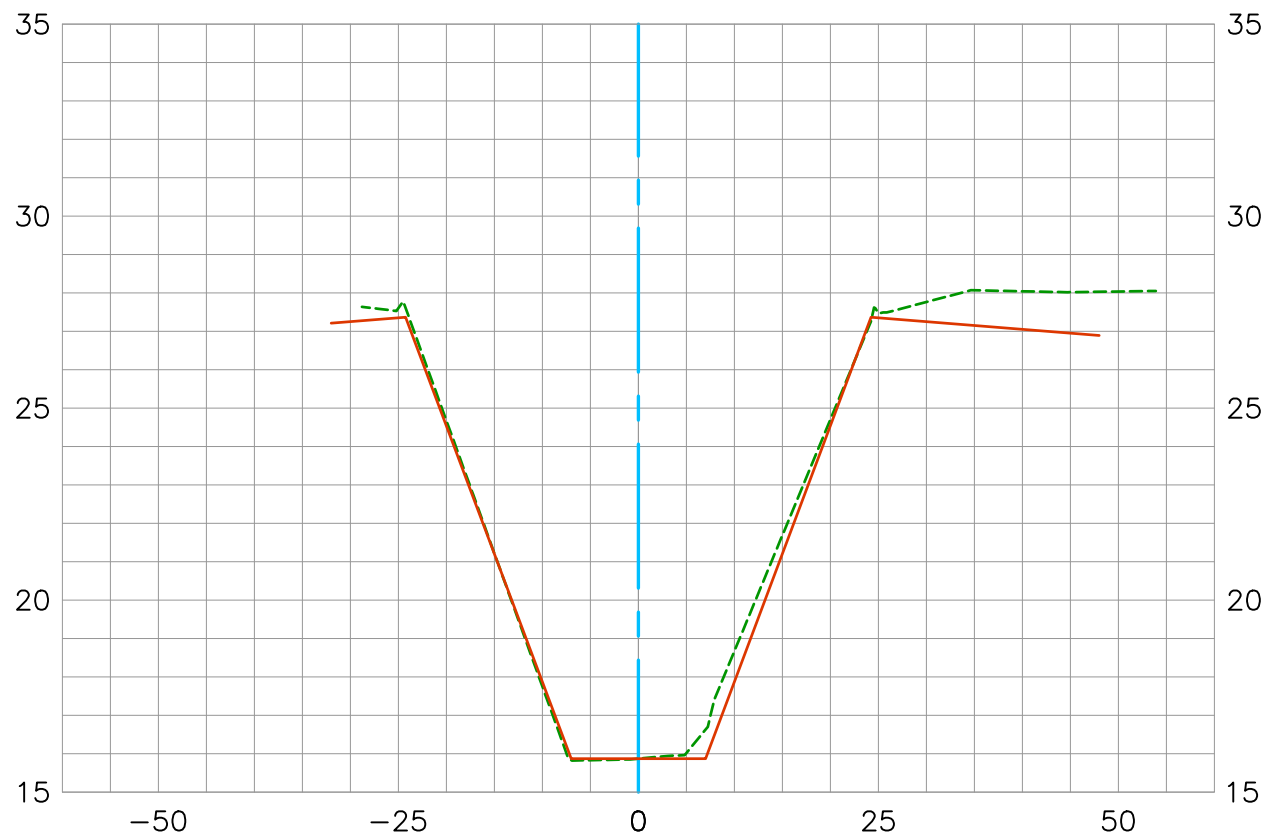

Existing Condition 2019 ---
Record As-Built Plan (1959) —
Construction Centerline ---

Horizontal Scale 1"=20'
Vertical Scale 1"=5'


DATE PREPARED: 11/12/2019

U.S. Survey Foot

OC Public Works/Engineering Services
OC Survey/Field Services
Boundary Analysis & Mapping

BOLSA CHICA CHANNEL (C02)

292+00.00
CL

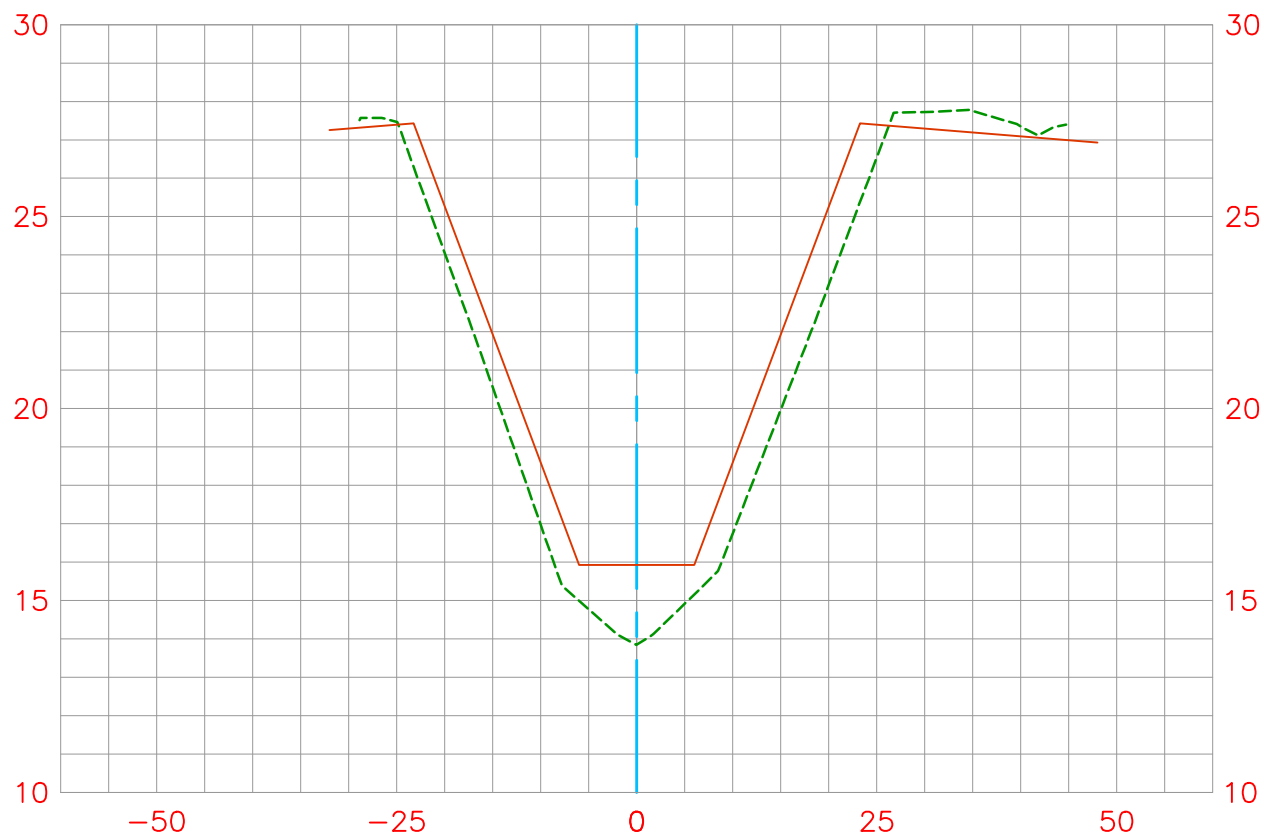

Existing Condition 2019 ---
Record As-Built Plan (1959) ---
Construction Centerline ---

Horizontal Scale 1"=20'
Vertical Scale 1"=5'


DATE PREPARED: 11/12/2019

U.S. *Survey
Foot*

OC Public Works/Engineering Services
OC Survey/Field Services
Boundary Analysis & Mapping

BOLSA CHICA CHANNEL (C02)

292+50.00
CL

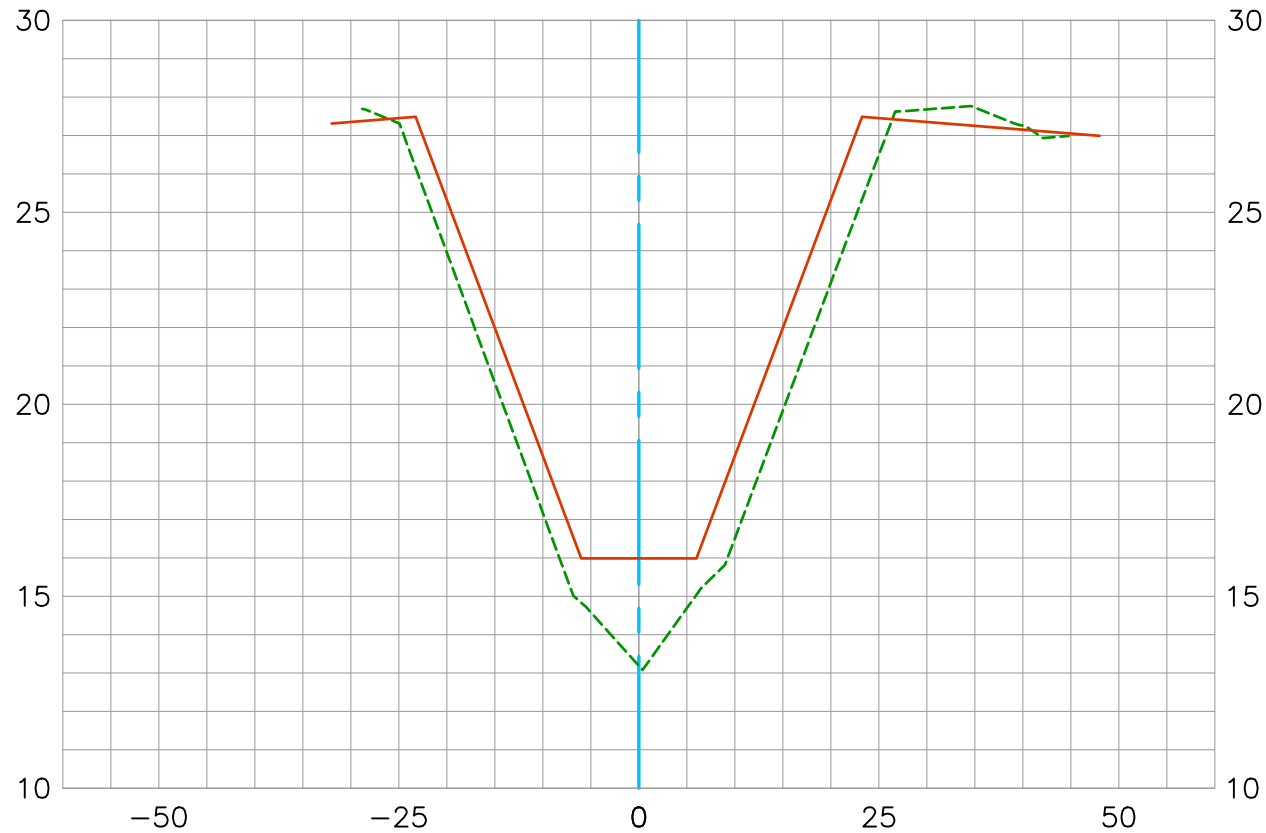

Existing Condition 2019 ---
Record As-Built Plan (1959) ---
Construction Centerline ---

Horizontal Scale 1"=20'
Vertical Scale 1"=5'

DATE PREPARED: 11/12/2019

U.S. Survey Foot


OC Public Works/Engineering Services
OC Survey/Field Services
Boundary Analysis & Mapping



BOLSA CHICA CHANNEL (C02)

293+00.00

CL

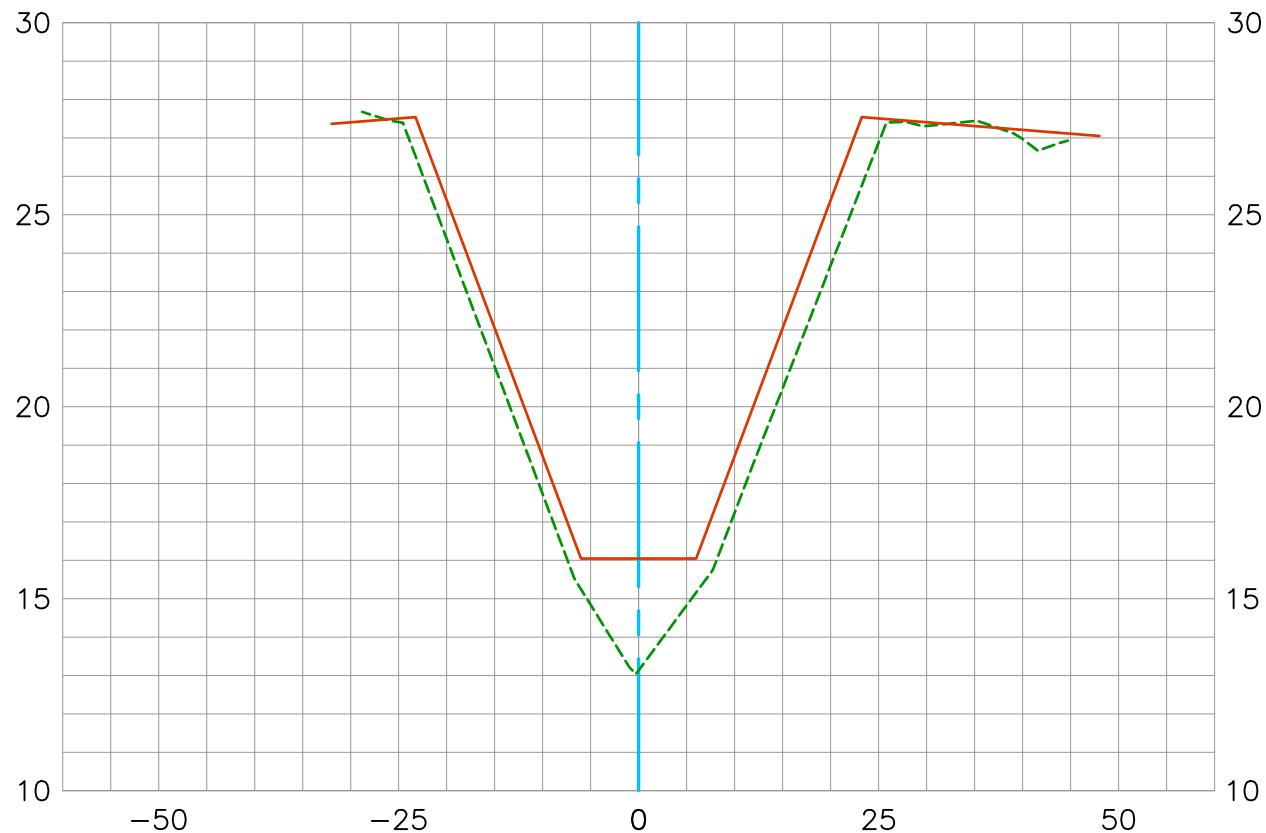

Existing Condition 2019 ---
Record As-Built Plan (1959) ---
Construction Centerline ---

Horizontal Scale 1"=20'
Vertical Scale 1"=5'

DATE PREPARED: 11/12/2019


U.S. *Survey
Foot*

OC Public Works/Engineering Services
OC Survey/Field Services
Boundary Analysis & Mapping

BOLSA CHICA CHANNEL (C02)

293+50.00

CL

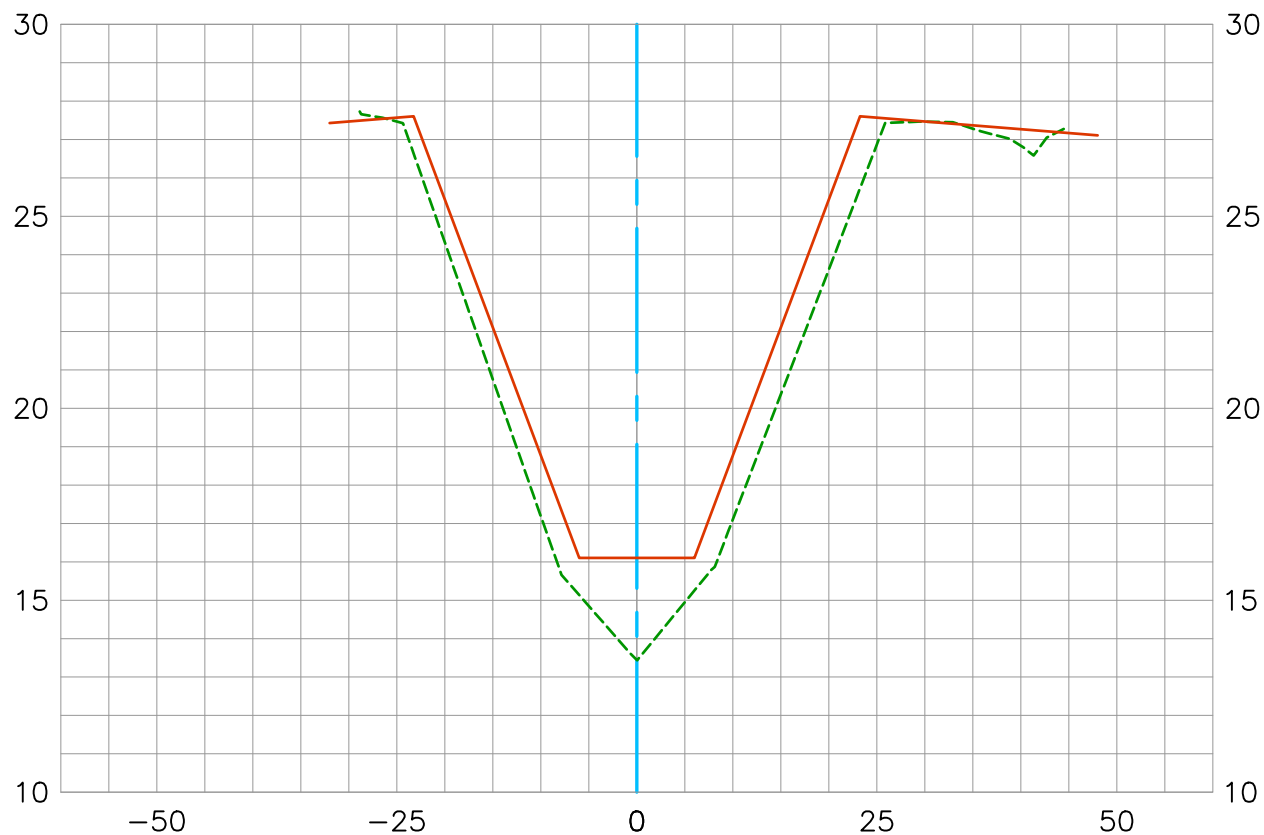

Existing Condition 2019 ---
Record As-Built Plan (1959) ---
Construction Centerline ---

Horizontal Scale 1"=20'
Vertical Scale 1"=5'


DATE PREPARED: 11/12/2019

U.S. *Survey
Foot*

OC Public Works/Engineering Services
OC Survey/Field Services
Boundary Analysis & Mapping

BOLSA CHICA CHANNEL (C02)

294+00.00
CL

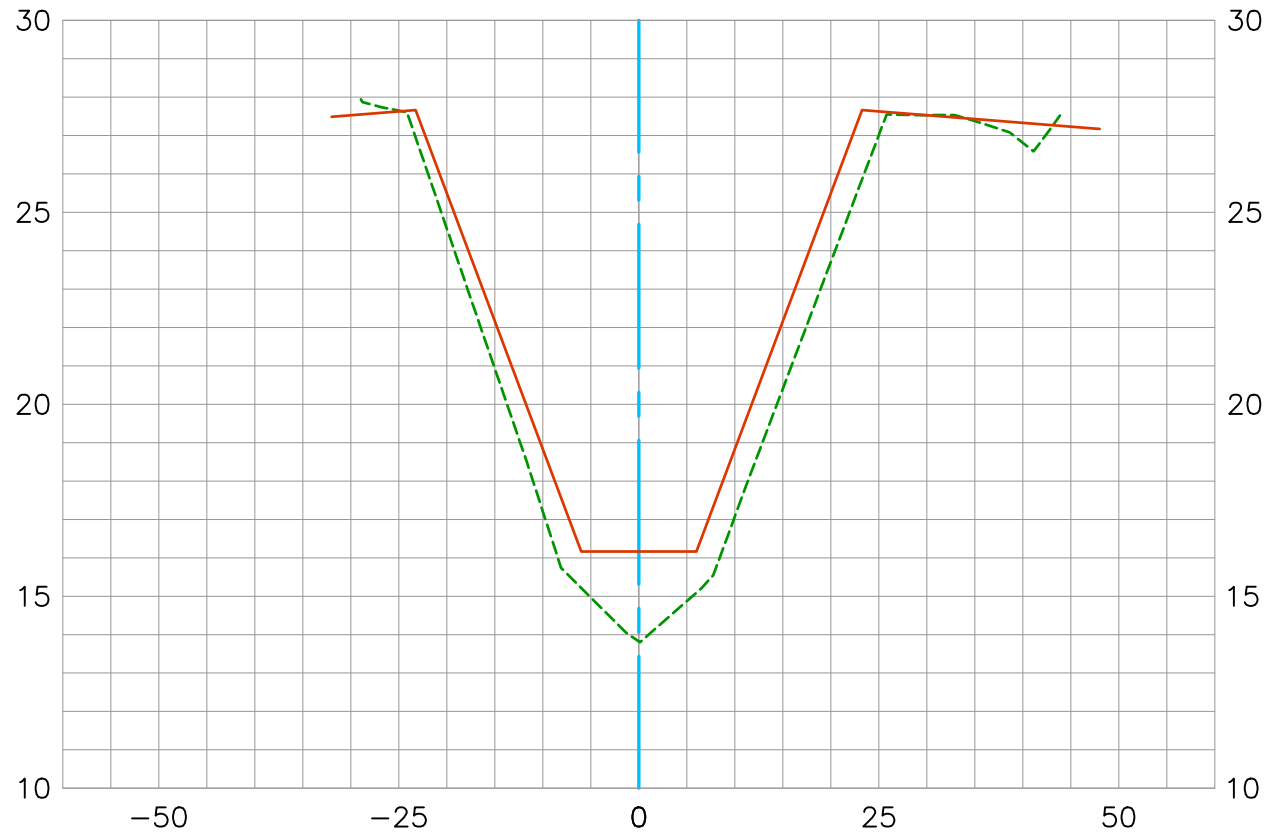

Existing Condition 2019 ---
Record As-Built Plan (1959) ---
Construction Centerline ---

Horizontal Scale 1"=20'
Vertical Scale 1"=5'

DATE PREPARED: 11/12/2019

U.S. Survey Foot


OC Public Works/Engineering Services
OC Survey/Field Services
Boundary Analysis & Mapping



BOLSA CHICA CHANNEL (C02)

294+50.00

CL

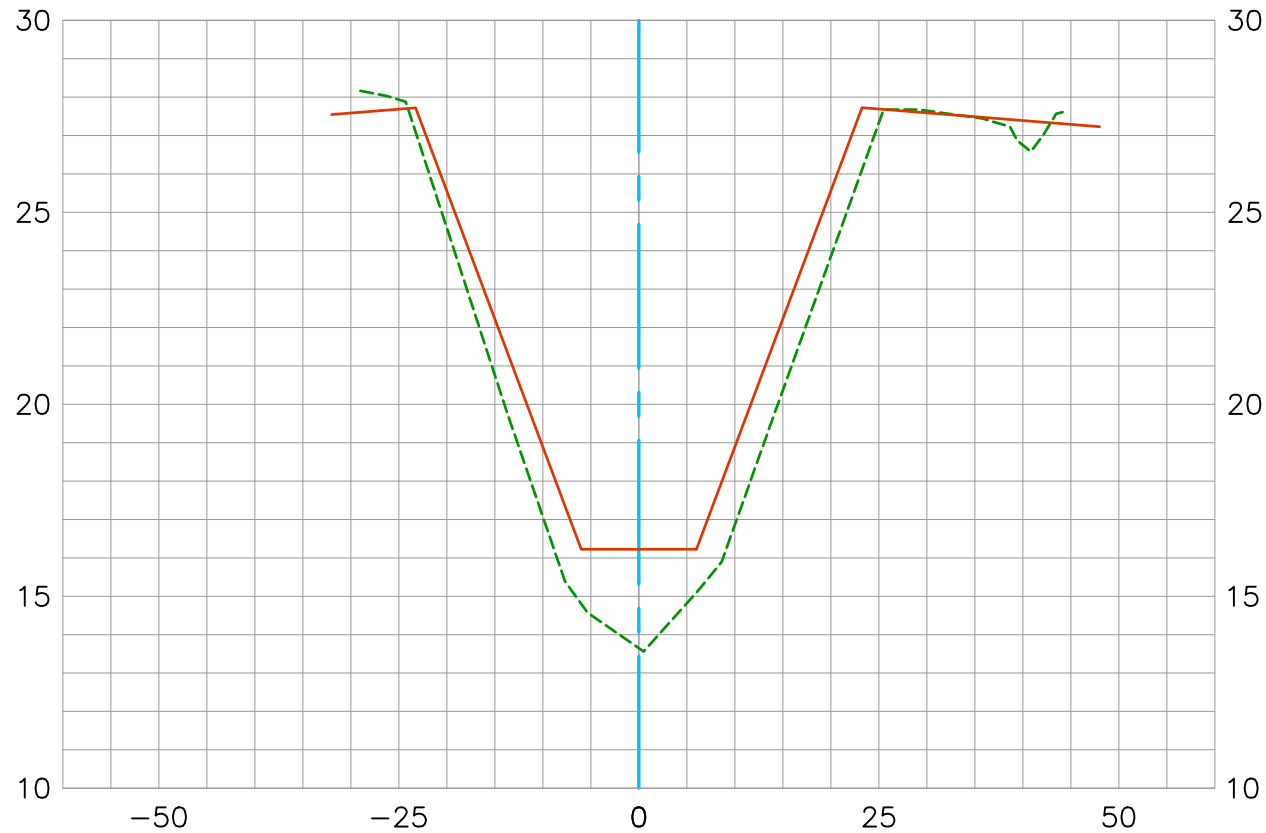

Existing Condition 2019 ---
Record As-Built Plan (1959) ---
Construction Centerline ---


Horizontal Scale 1"=20'
Vertical Scale 1"=5'

DATE PREPARED: 11/12/2019



BOLSA CHICA CHANNEL (C02)

295+00.00
CL

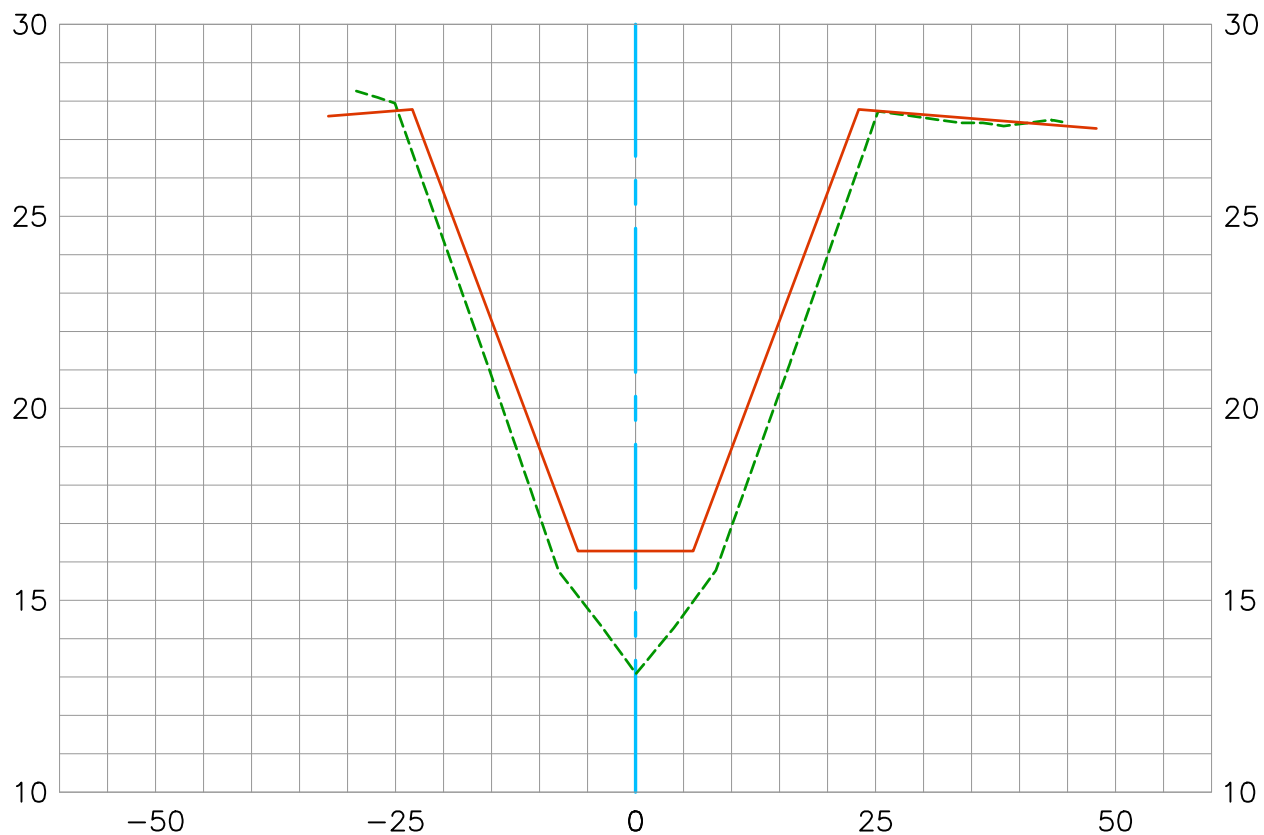

Existing Condition 2019 ---
Record As-Built Plan (1959) ---
Construction Centerline ---

Horizontal Scale 1"=20'
Vertical Scale 1"=5'


DATE PREPARED: 11/12/2019

U.S. Survey Foot

OC Public Works/Engineering Services
OC Survey/Field Services
Boundary Analysis & Mapping

BOLSA CHICA CHANNEL (C02)

295+50.00
CL

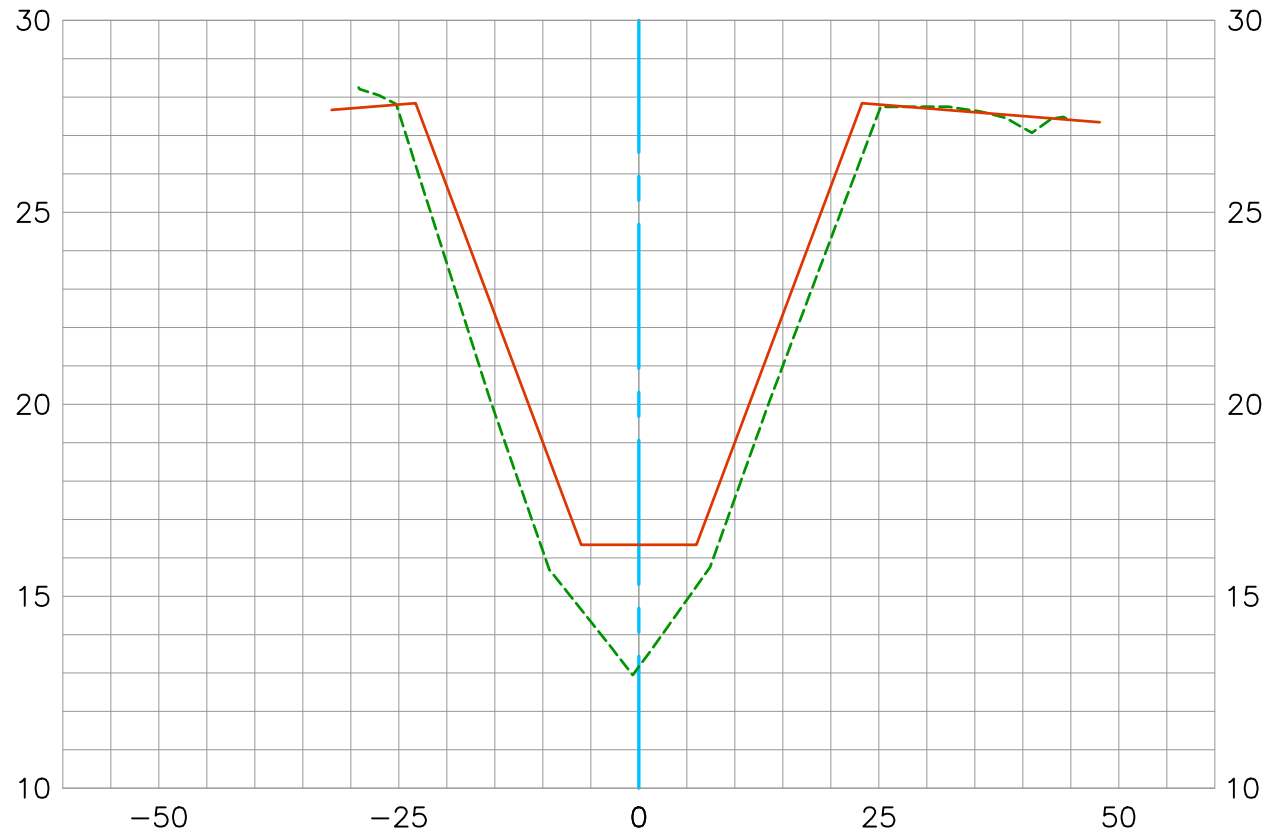

Existing Condition 2019 ---
Record As-Built Plan (1959) ---
Construction Centerline ---

Horizontal Scale 1"=20'
Vertical Scale 1"=5'


DATE PREPARED: 11/12/2019

U.S. Survey Foot

OC Public Works/Engineering Services
OC Survey/Field Services
Boundary Analysis & Mapping

BOLSA CHICA CHANNEL (C02)

296+00.00
CL

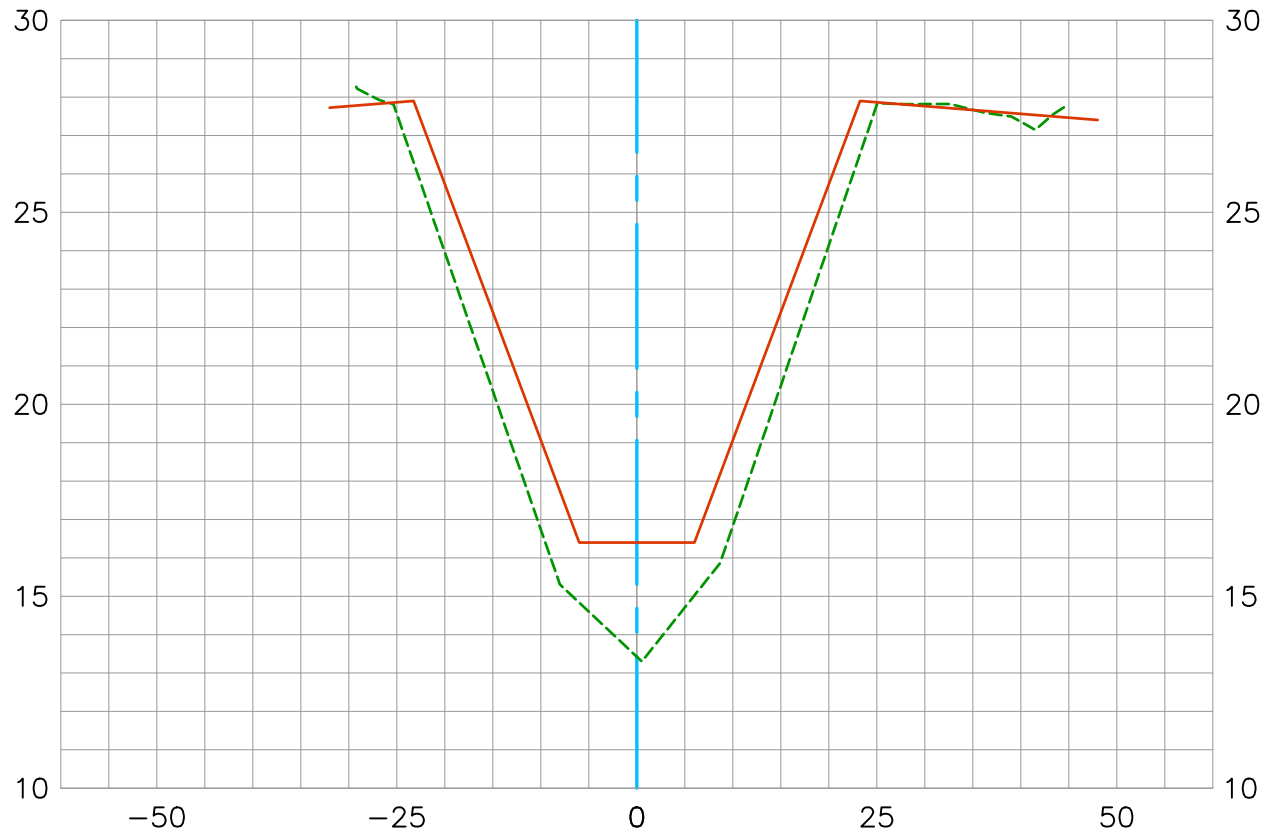

Existing Condition 2019 ---
Record As-Built Plan (1959) ---
Construction Centerline ---

Horizontal Scale 1"=20'
Vertical Scale 1"=5'


DATE PREPARED: 11/12/2019

U.S. Survey Foot

OC Public Works/Engineering Services
OC Survey/Field Services
Boundary Analysis & Mapping

BOLSA CHICA CHANNEL (C02)

296+50.00
CL

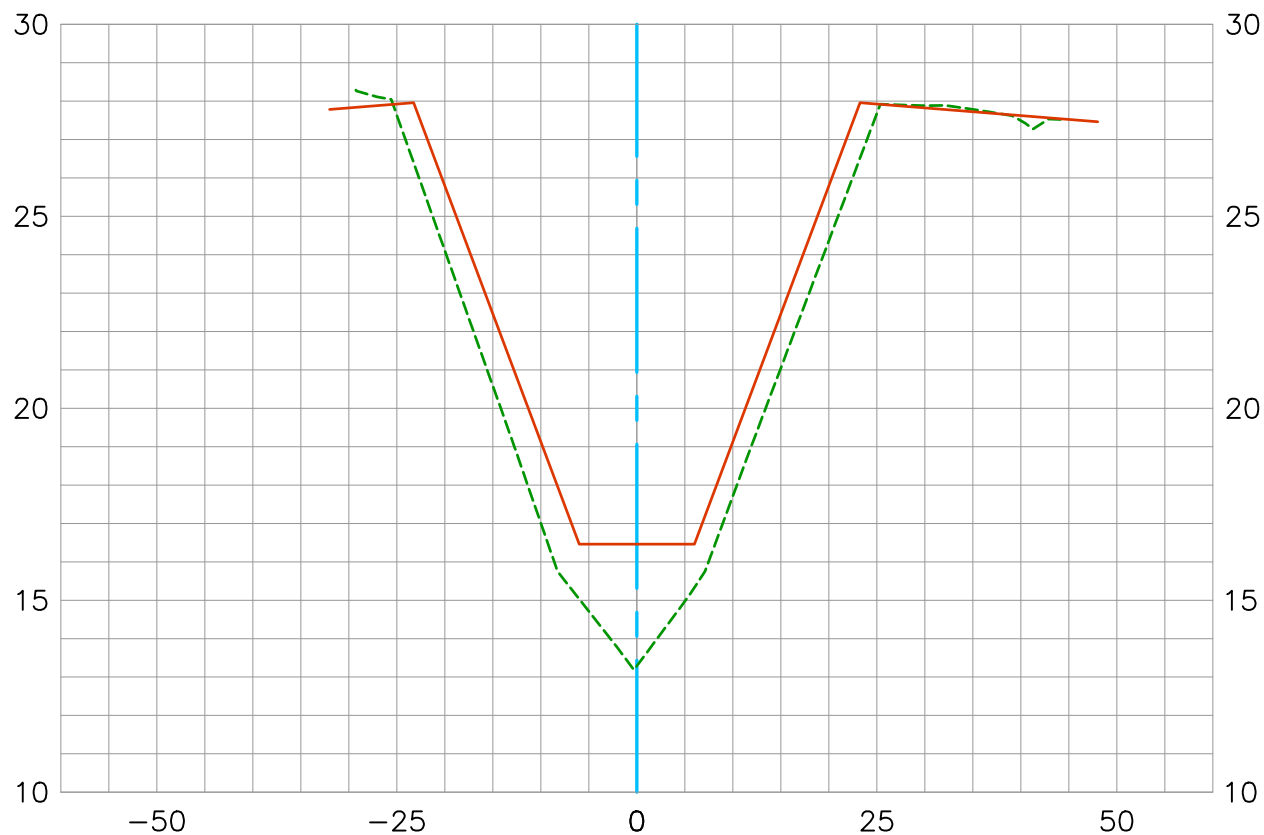

Existing Condition 2019 
Record As-Built Plan (1959) 
Construction Centerline 

Horizontal Scale 1"=20'
Vertical Scale 1"=5'


DATE PREPARED: 11/12/2019

U.S. *Survey
Foot*

OC Public Works/Engineering Services
OC Survey/Field Services
Boundary Analysis & Mapping

BOLSA CHICA CHANNEL (C02)

297+00.00
CL

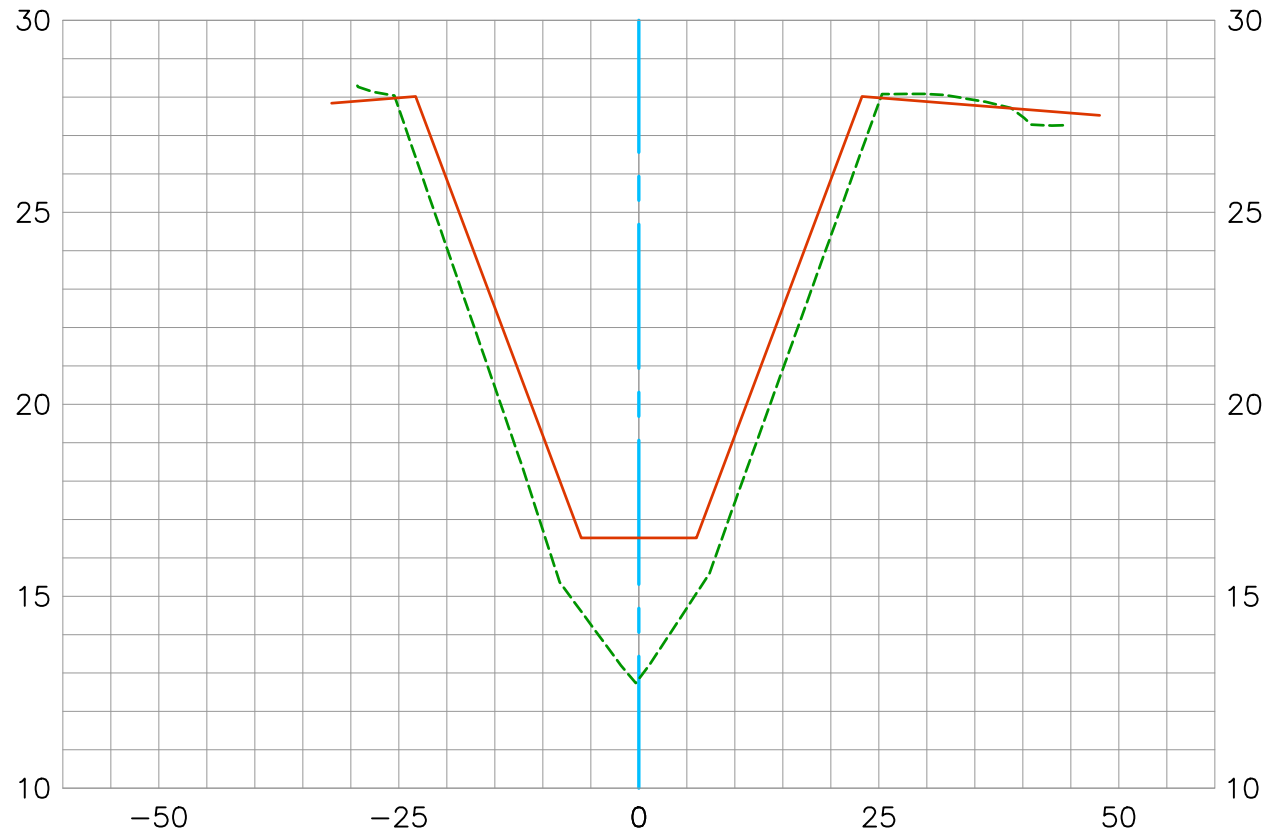

Existing Condition 2019 ---
Record As-Built Plan (1959) ---
Construction Centerline ---

Horizontal Scale 1"=20'
Vertical Scale 1"=5'


DATE PREPARED: 11/12/2019

U.S. Survey Foot

OC Public Works/Engineering Services
OC Survey/Field Services
Boundary Analysis & Mapping

BOLSA CHICA CHANNEL (C02)

297+50.00
CL

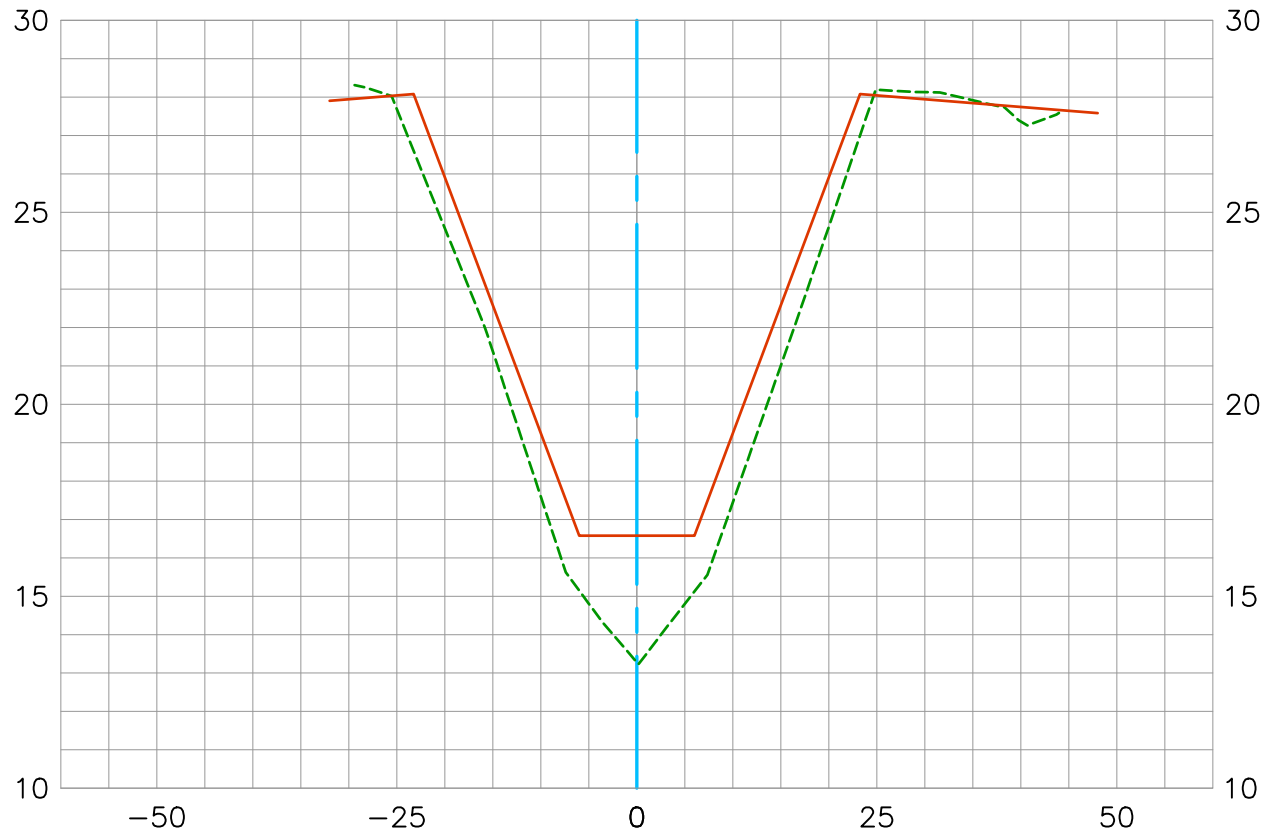

Existing Condition 2019 ---
Record As-Built Plan (1959) ---
Construction Centerline ---


Horizontal Scale 1"=20'
Vertical Scale 1"=5'

DATE PREPARED: 11/12/2019



BOLSA CHICA CHANNEL (C02)

298+00.00
CL

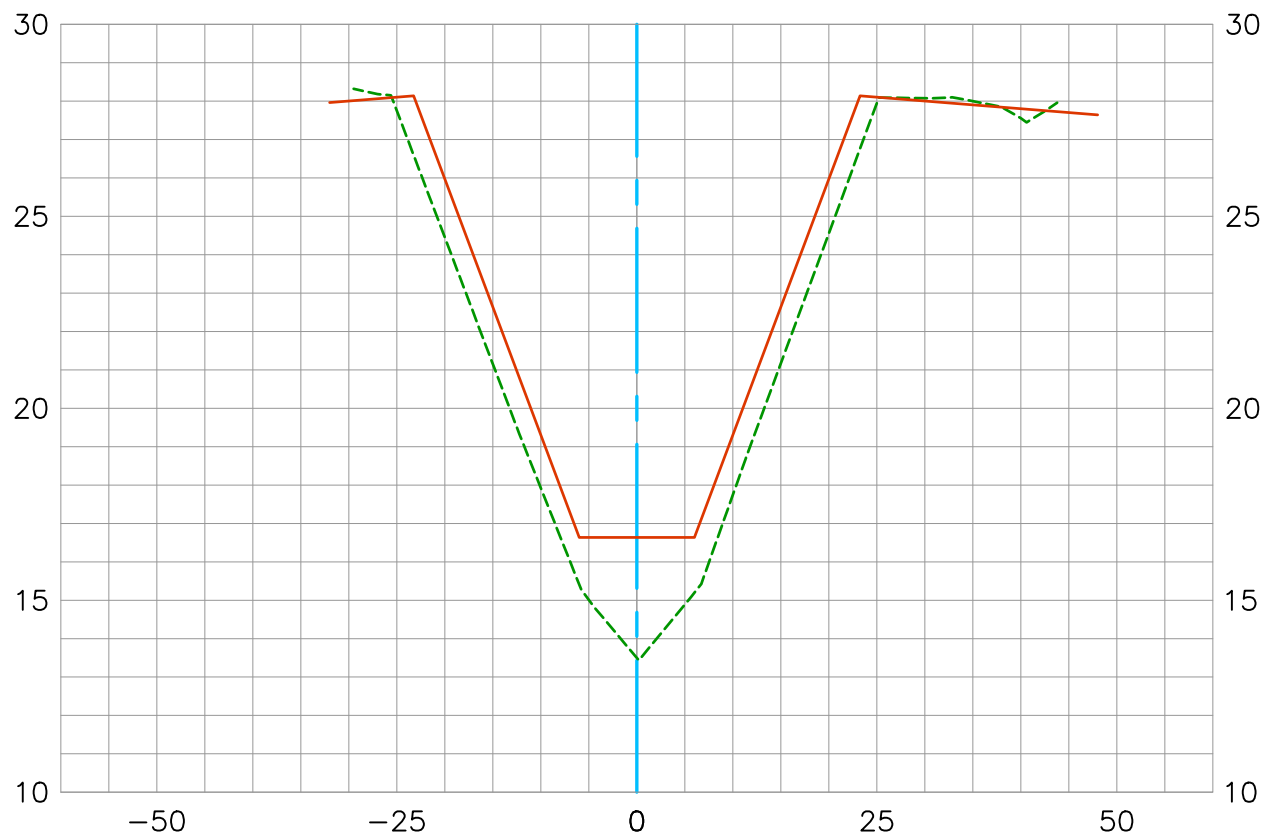

Existing Condition 2019 
Record As-Built Plan (1959) 
Construction Centerline 


Horizontal Scale 1"=20'
Vertical Scale 1"=5'

DATE PREPARED: 11/12/2019



BOLSA CHICA CHANNEL (C02)

298+50.00
CL

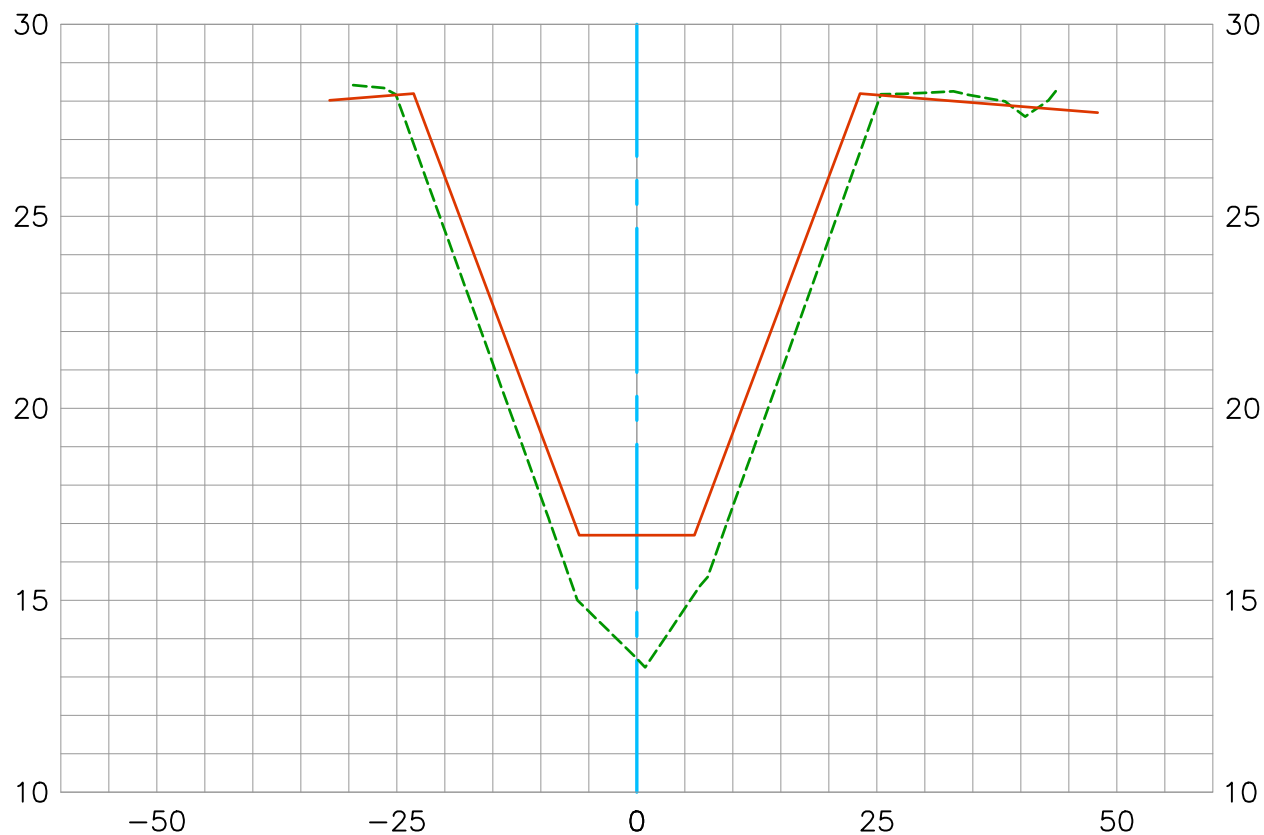

Existing Condition 2019 ---
Record As-Built Plan (1959) ---
Construction Centerline ---

Horizontal Scale 1"=20'
Vertical Scale 1"=5'


DATE PREPARED: 11/12/2019



BOLSA CHICA CHANNEL (C02)

299+00.00

CL

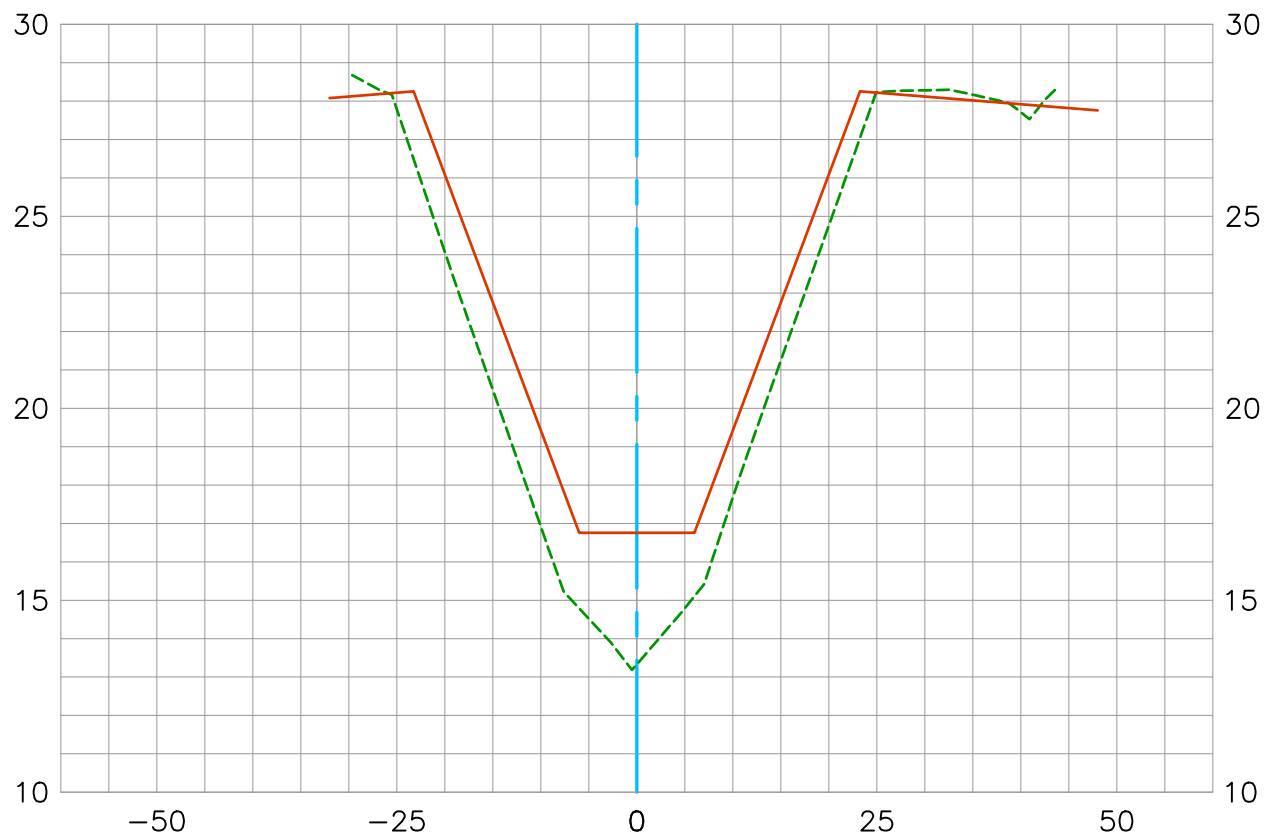

Existing Condition 2019 ---
 Record As-Built Plan (1959) ---
 Construction Centerline ---

Horizontal Scale 1"=20'
 Vertical Scale 1"=5'


DATE PREPARED: 11/12/2019

U.S. Survey Foot

OC Public Works/Engineering Services
OC Survey/Field Services
Boundary Analysis & Mapping

BOLSA CHICA CHANNEL (C02)

299+50.00
CL

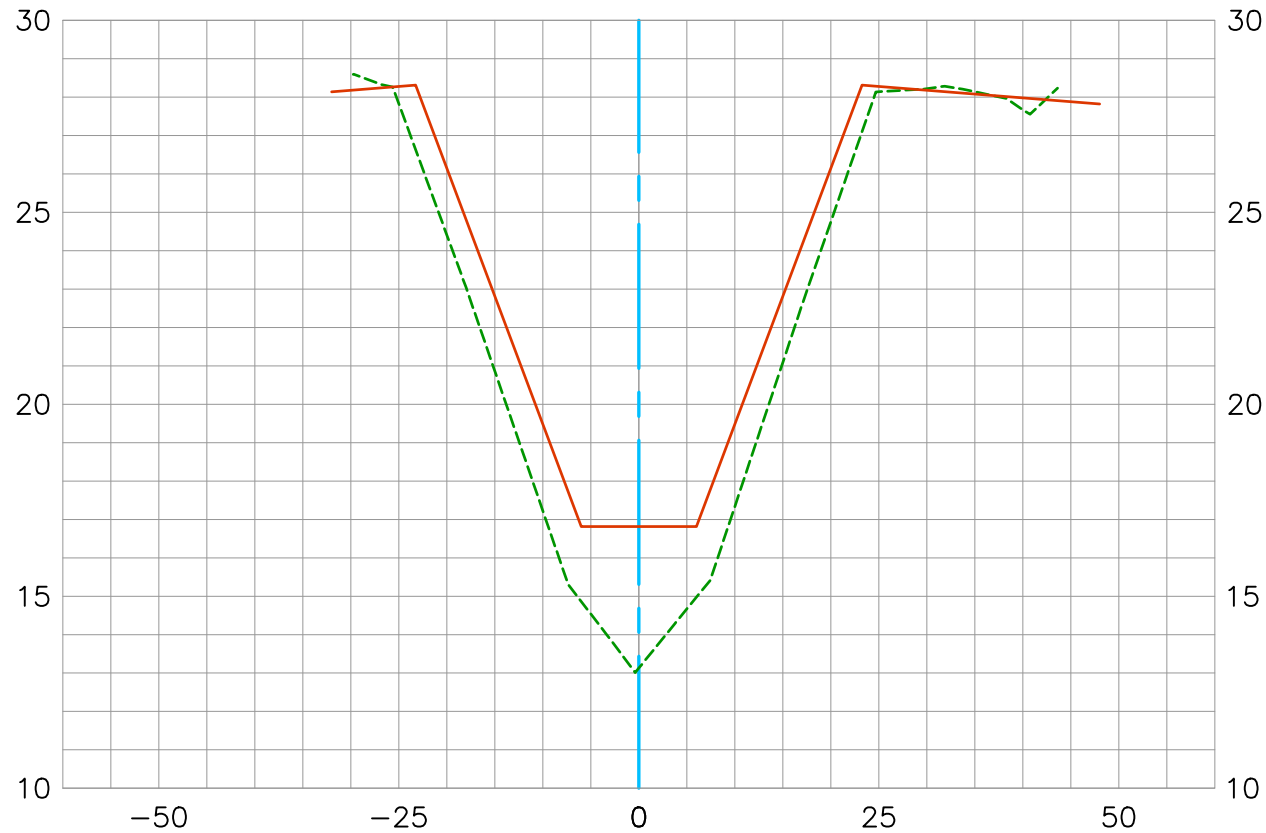

Existing Condition 2019 ---
Record As-Built Plan (1959) ---
Construction Centerline ---

Horizontal Scale 1"=20'
Vertical Scale 1"=5'


DATE PREPARED: 11/12/2019

U.S. Survey Foot

OC Public Works/Engineering Services
OC Survey/Field Services
Boundary Analysis & Mapping

BOLSA CHICA CHANNEL (C02)

300+00.00
CL

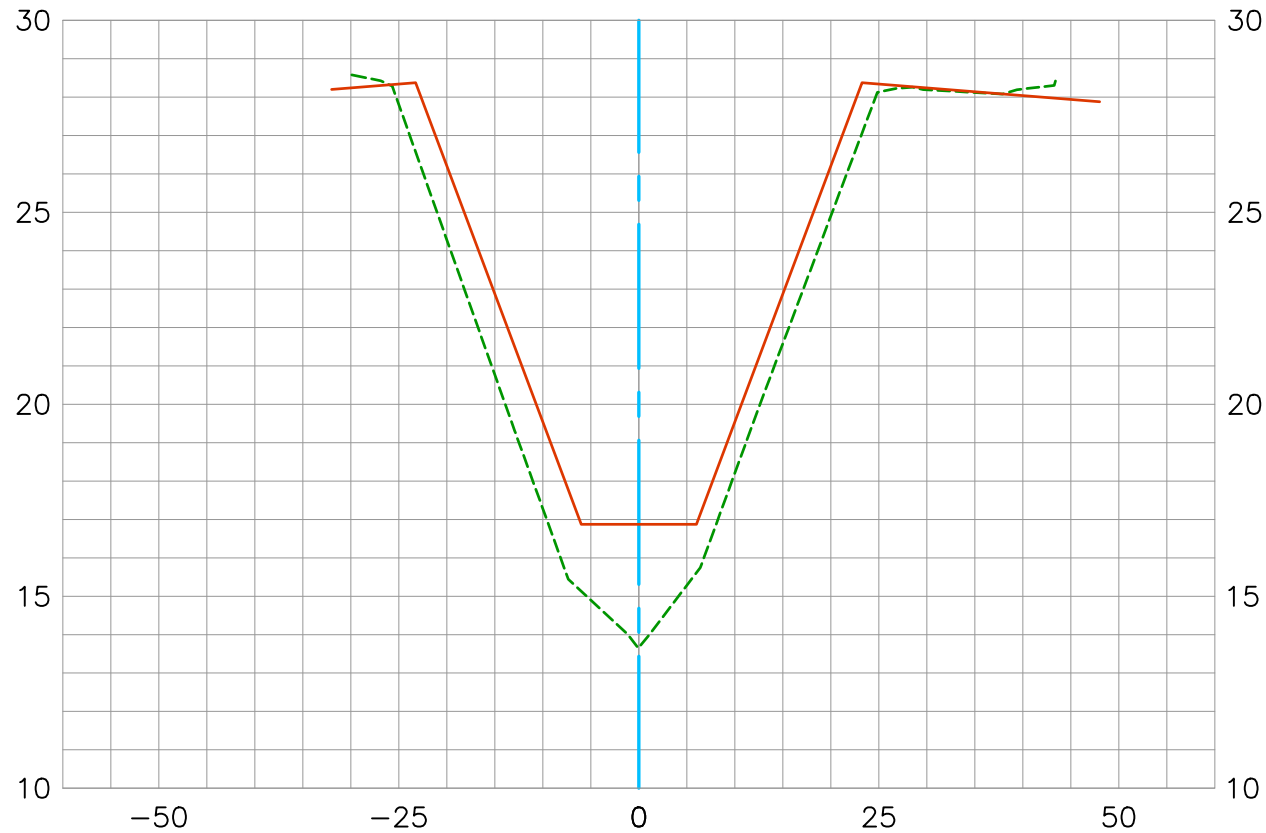

Existing Condition 2019 ---
Record As-Built Plan (1959) ---
Construction Centerline ---


Horizontal Scale 1"=20'
Vertical Scale 1"=5'

DATE PREPARED: 11/12/2019



BOLSA CHICA CHANNEL (C02)

300+50.00
CL

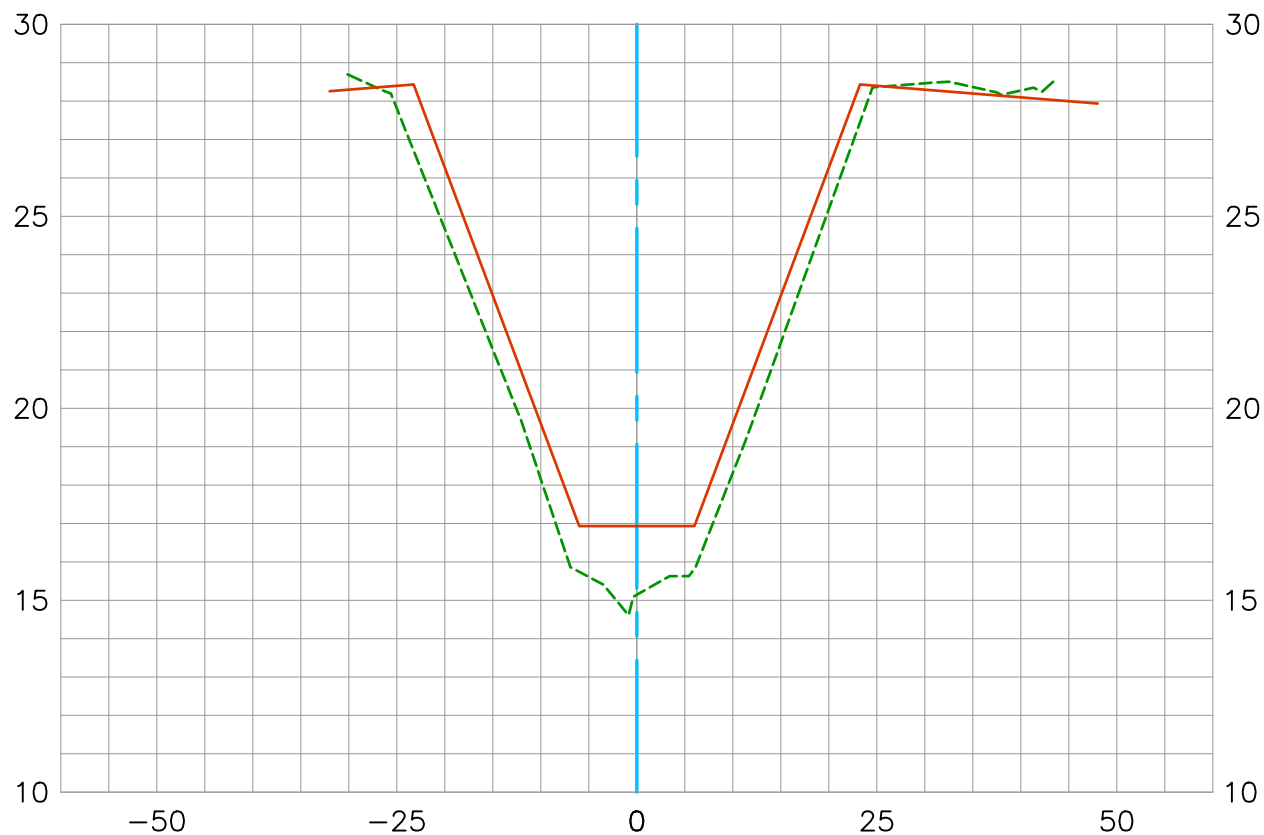

Existing Condition 2019 ---
Record As-Built Plan (1959) ---
Construction Centerline ---

Horizontal Scale 1"=20'
Vertical Scale 1"=5'


DATE PREPARED: 11/12/2019

U.S. *Survey
Foot*

OC Public Works/Engineering Services
OC Survey/Field Services
Boundary Analysis & Mapping

BOLSA CHICA CHANNEL (C02)

301+00.00
CL

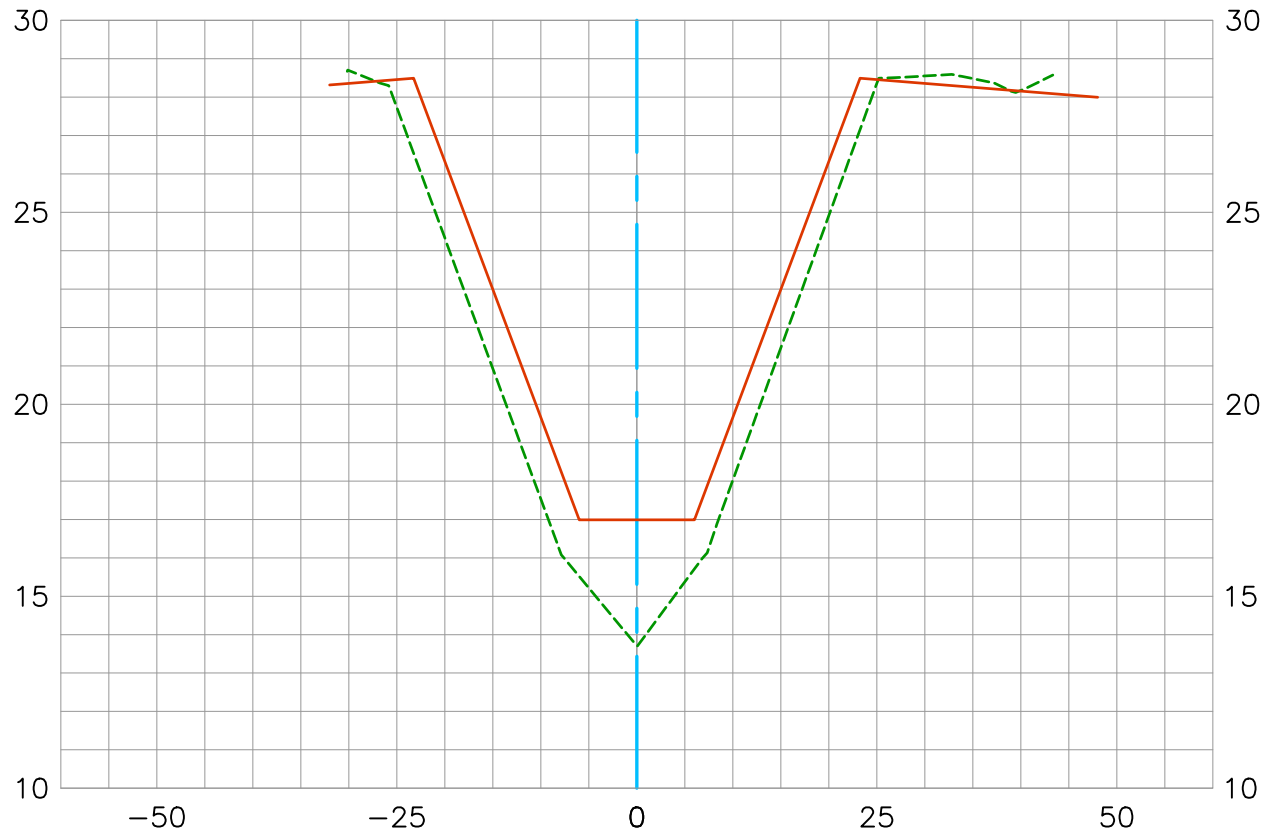

Existing Condition 2019 ---
Record As-Built Plan (1959) ---
Construction Centerline ---

Horizontal Scale 1"=20'
Vertical Scale 1"=5'


DATE PREPARED: 11/12/2019

U.S. Survey Foot

OC Public Works/Engineering Services
OC Survey/Field Services
Boundary Analysis & Mapping

BOLSA CHICA CHANNEL (C02)

301+50.00
CL

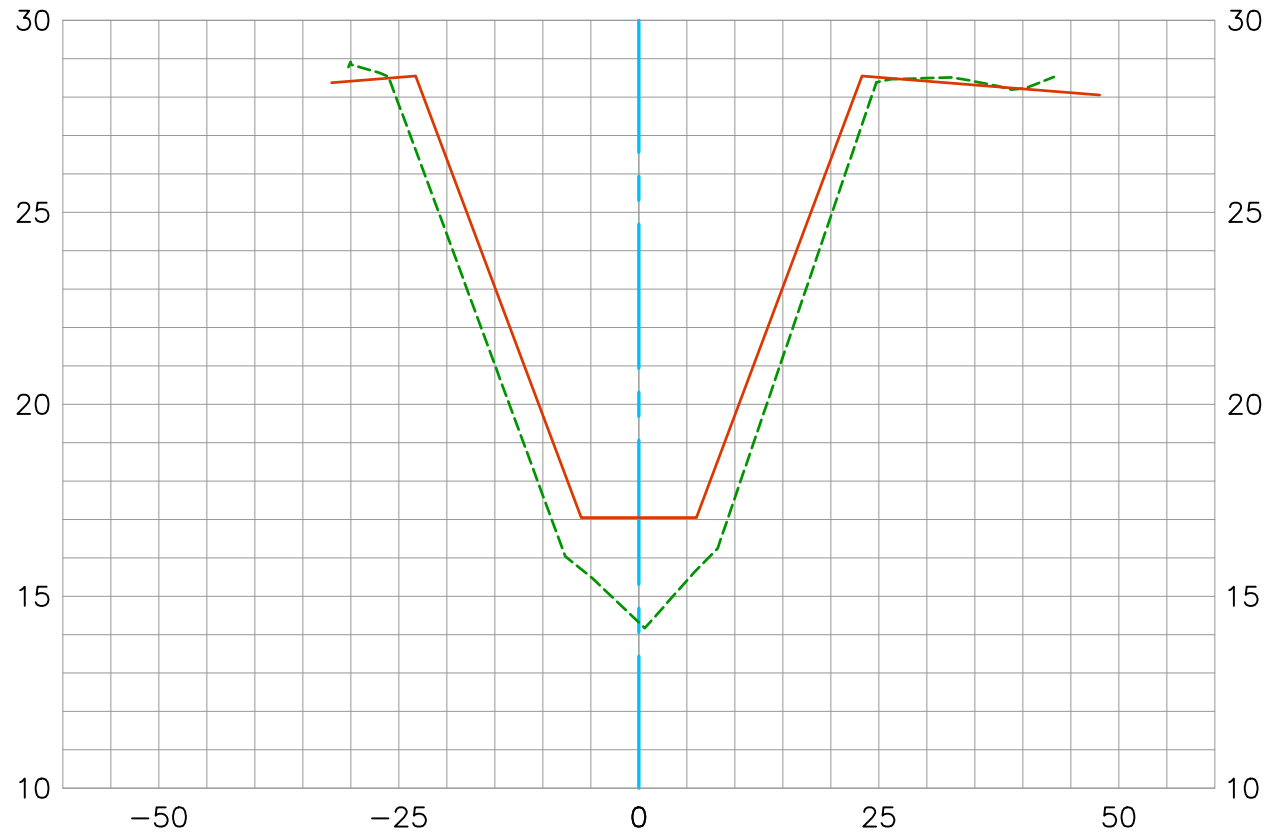

Existing Condition 2019 ---
Record As-Built Plan (1959) ---
Construction Centerline ---

Horizontal Scale 1"=20'
Vertical Scale 1"=5'

DATE PREPARED: 11/12/2019


U.S. *Survey
Foot*

OC Public Works/Engineering Services
OC Survey/Field Services
Boundary Analysis & Mapping

BOLSA CHICA CHANNEL (C02)

302+00.00

CL

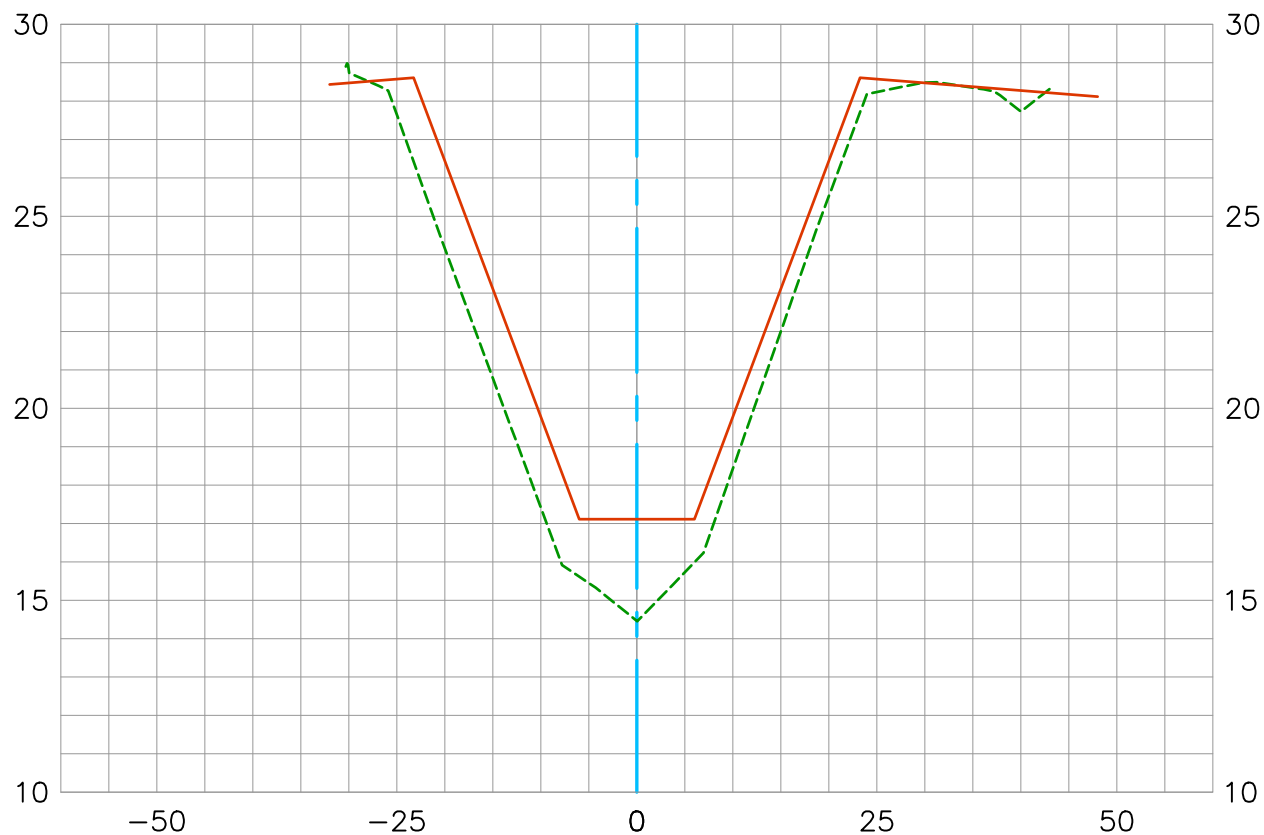


Existing Condition 2019 ---
Record As-Built Plan (1959) —
Construction Centerline ---

Horizontal Scale 1"=20'
Vertical Scale 1"=5'

DATE PREPARED: 11/12/2019

BOLSA CHICA CHANNEL (C02) 302+50.00 CL

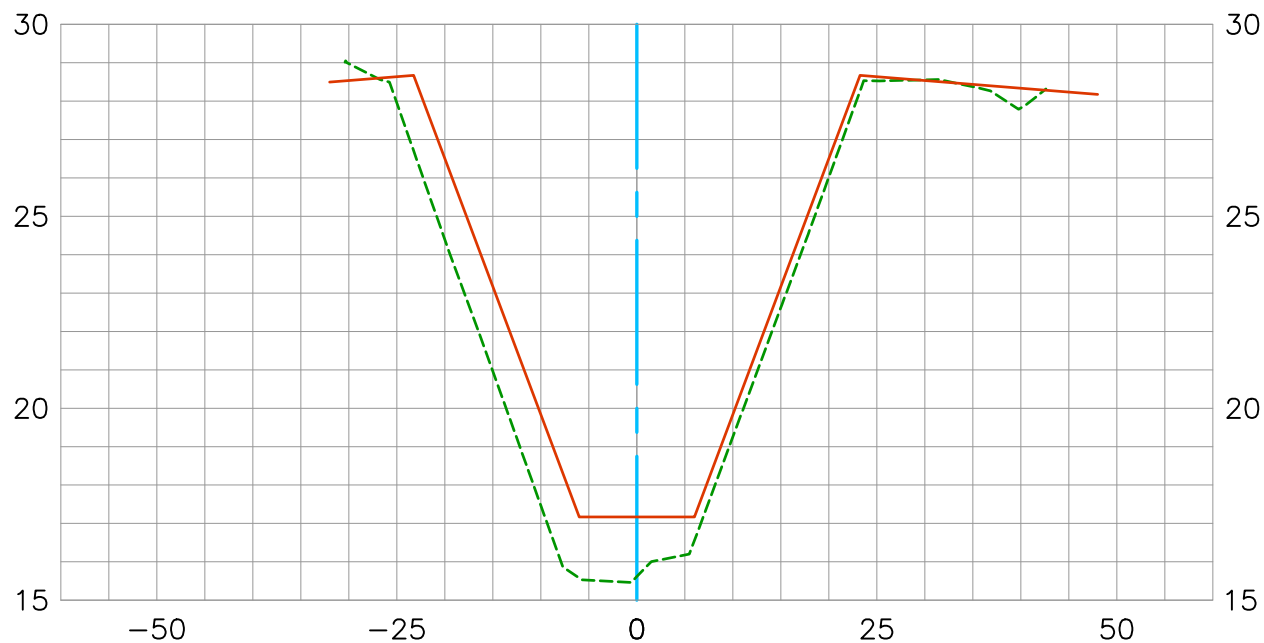

Existing Condition 2019 
Record As-Built Plan (1959) 
Construction Centerline 

Horizontal Scale 1"=20'
Vertical Scale 1"=5'


DATE PREPARED: 11/12/2019

U.S. Survey Foot

OC Public Works/Engineering Services
OC Survey/Field Services
Boundary Analysis & Mapping



BOLSA CHICA CHANNEL (C02) 303+00.00 CL

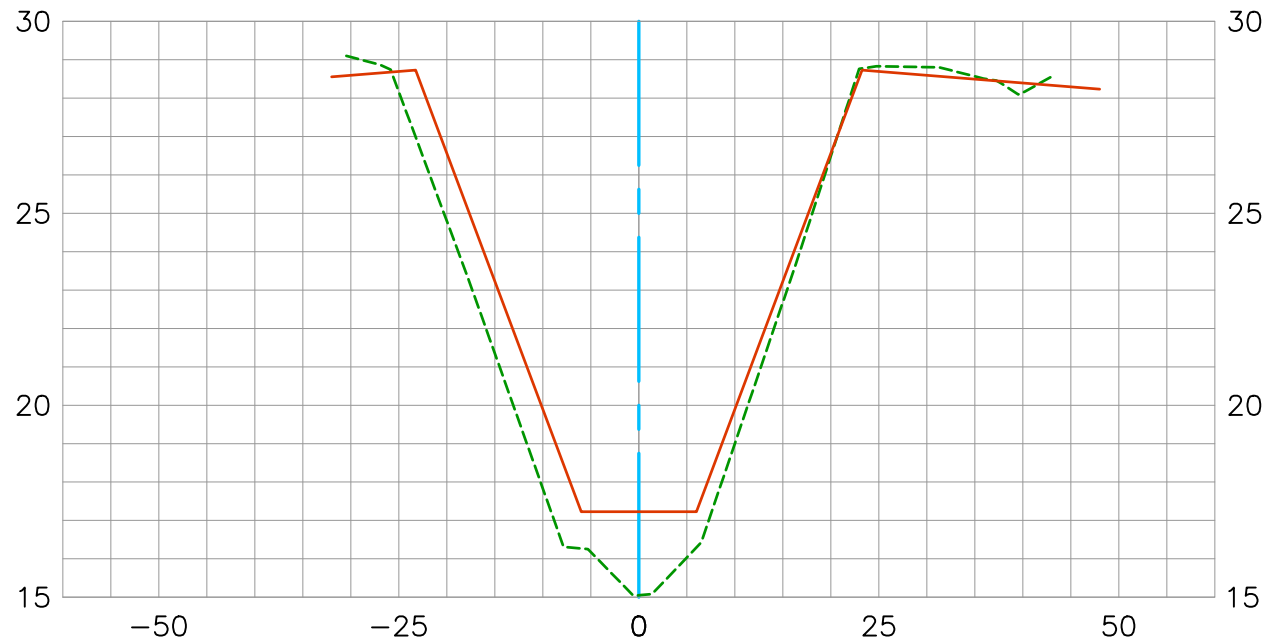

Existing Condition 2019 ---
Record As-Built Plan (1959) —
Construction Centerline ---

Horizontal Scale 1"=20'
Vertical Scale 1"=5'


DATE PREPARED: 11/12/2019

U.S. Survey Foot

OC Public Works/Engineering Services
OC Survey/Field Services
Boundary Analysis & Mapping



BOLSA CHICA CHANNEL (C02) 303+50.00 CL

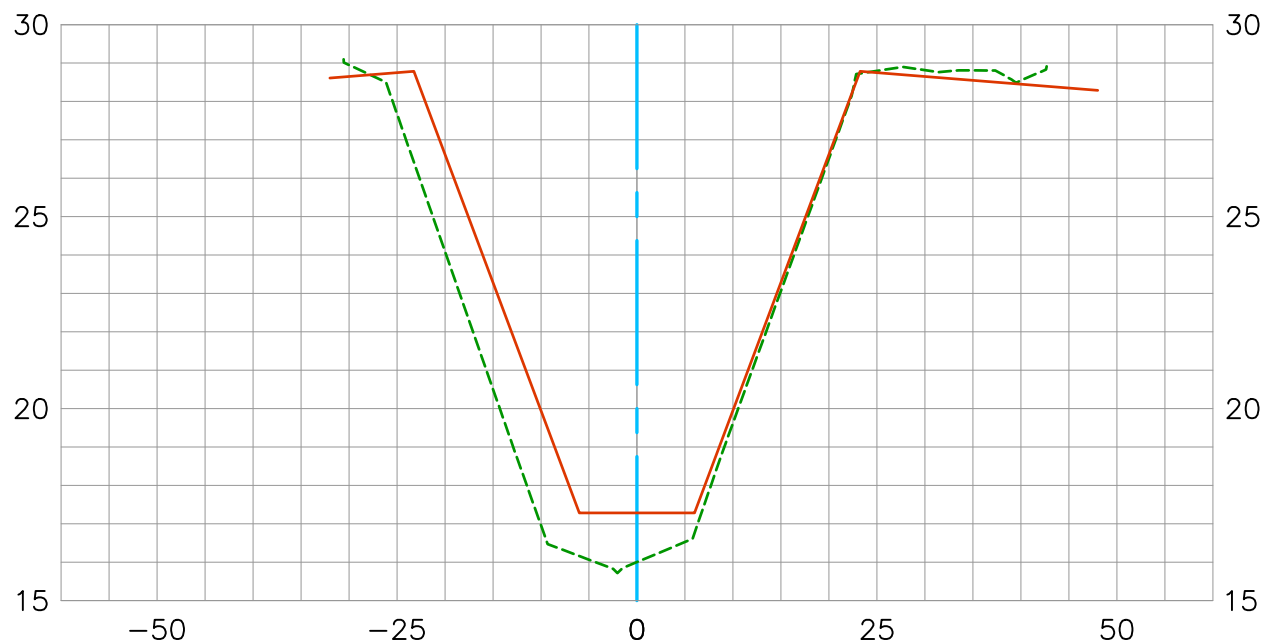

Existing Condition 2019 ---
Record As-Built Plan (1959) ---
Construction Centerline ---

Horizontal Scale 1"=20'
Vertical Scale 1"=5'


DATE PREPARED: 11/12/2019



BOLSA CHICA CHANNEL (C02)

304+00.00

CL

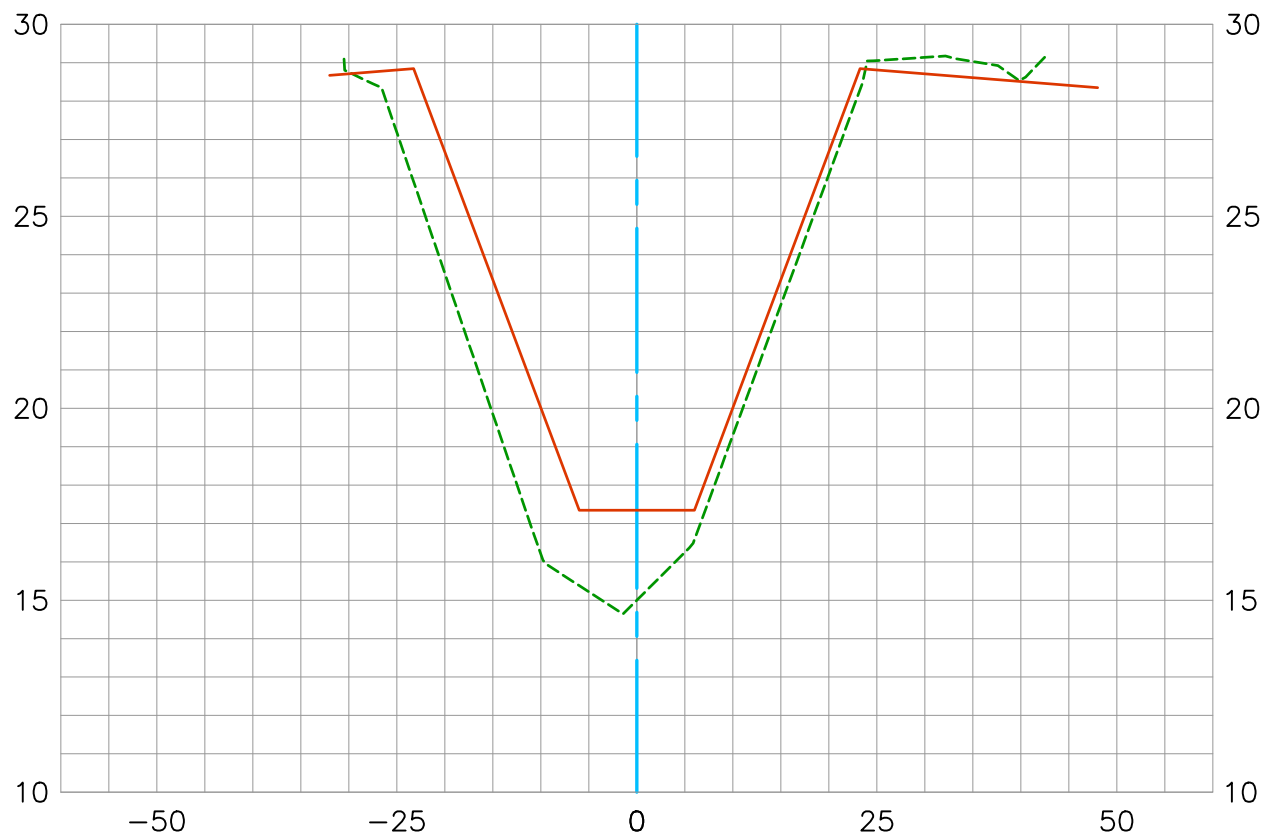

Existing Condition 2019 ----
 Record As-Built Plan (1959) ————
 Construction Centerline - - - -

Horizontal Scale 1"=20'
 Vertical Scale 1"=5'


DATE PREPARED: 11/12/2019



BOLSA CHICA CHANNEL (C02)

304+50.00

CL

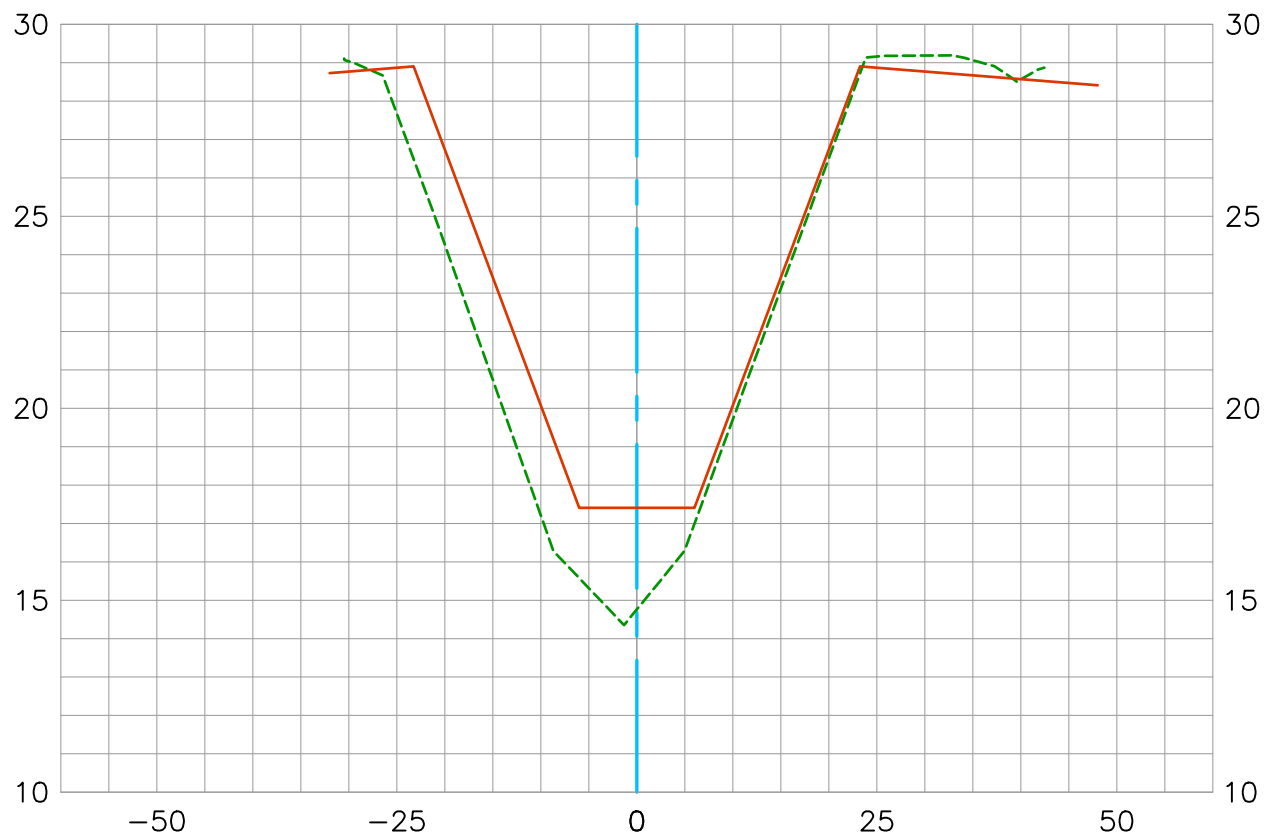

Existing Condition 2019 ---
 Record As-Built Plan (1959) ---
 Construction Centerline ---

Horizontal Scale 1"=20'
 Vertical Scale 1"=5'

DATE PREPARED: 11/12/2019


U.S. Survey Foot

OC Public Works/Engineering Services
OC Survey/Field Services
Boundary Analysis & Mapping



BOLSA CHICA CHANNEL (C02)

305+00.00
CL

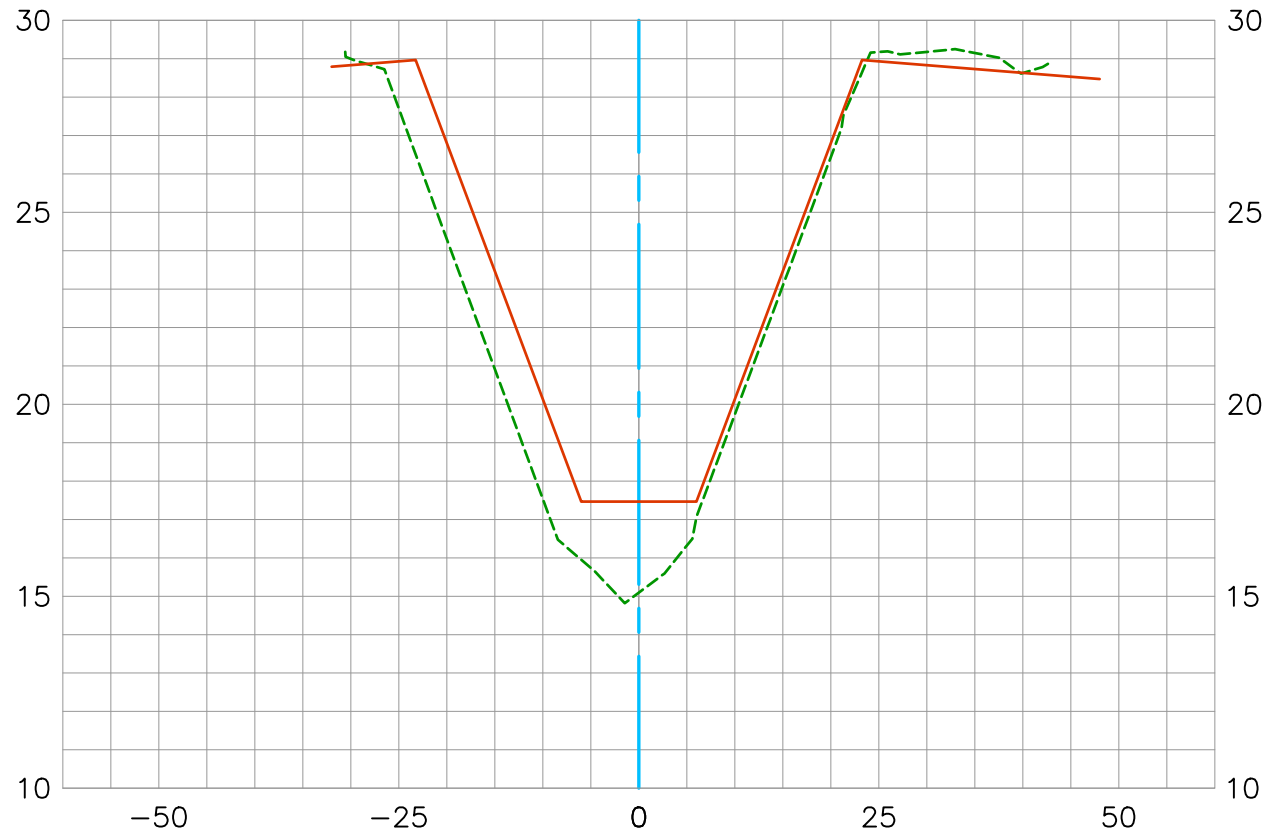

Existing Condition 2019 ---
Record As-Built Plan (1959) ---
Construction Centerline ---


Horizontal Scale 1"=20'
Vertical Scale 1"=5'

DATE PREPARED: 11/12/2019



BOLSA CHICA CHANNEL (C02)

305+50.00
CL

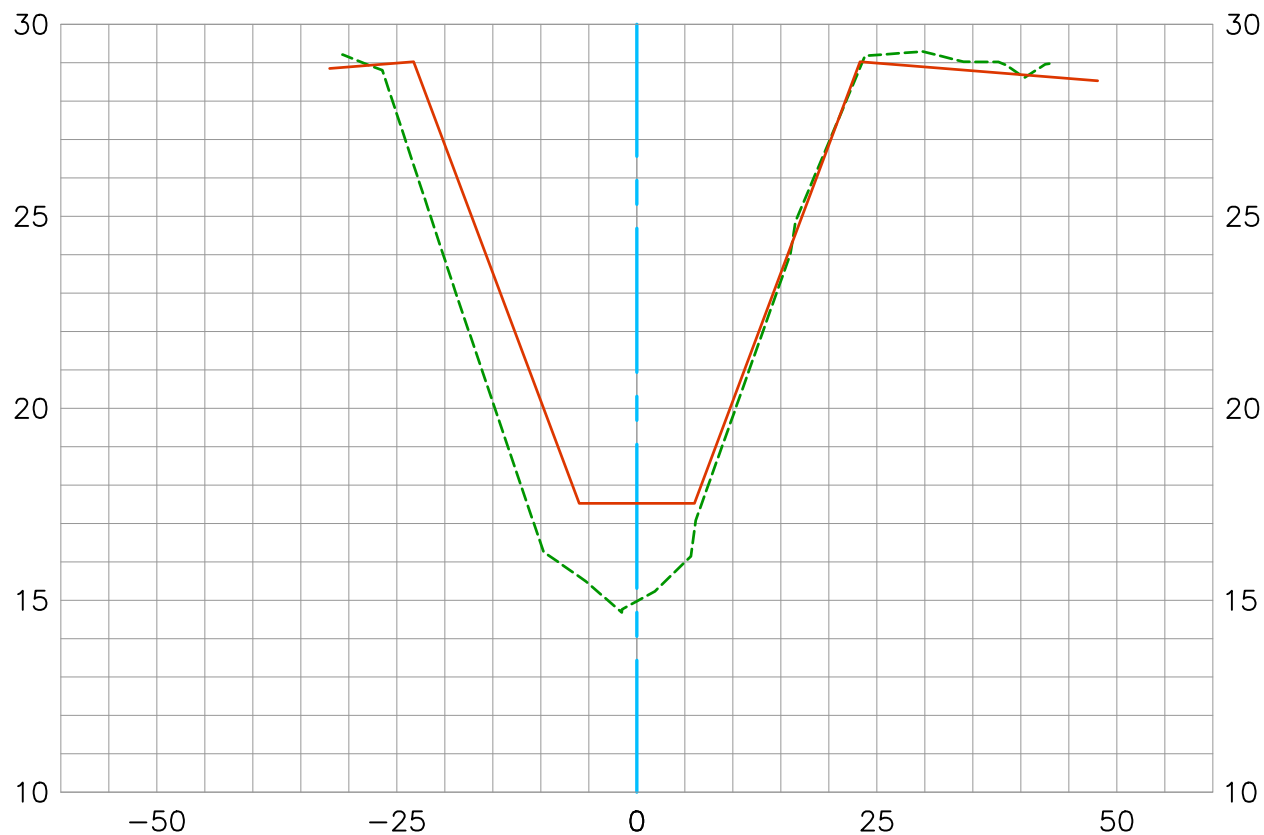

Existing Condition 2019 ---
Record As-Built Plan (1959) ---
Construction Centerline ---

Horizontal Scale 1"=20'
Vertical Scale 1"=5'


DATE PREPARED: 11/12/2019

U.S. Survey Foot

OC Public Works/Engineering Services
OC Survey/Field Services
Boundary Analysis & Mapping

BOLSA CHICA CHANNEL (C02)

306+00.00
CL

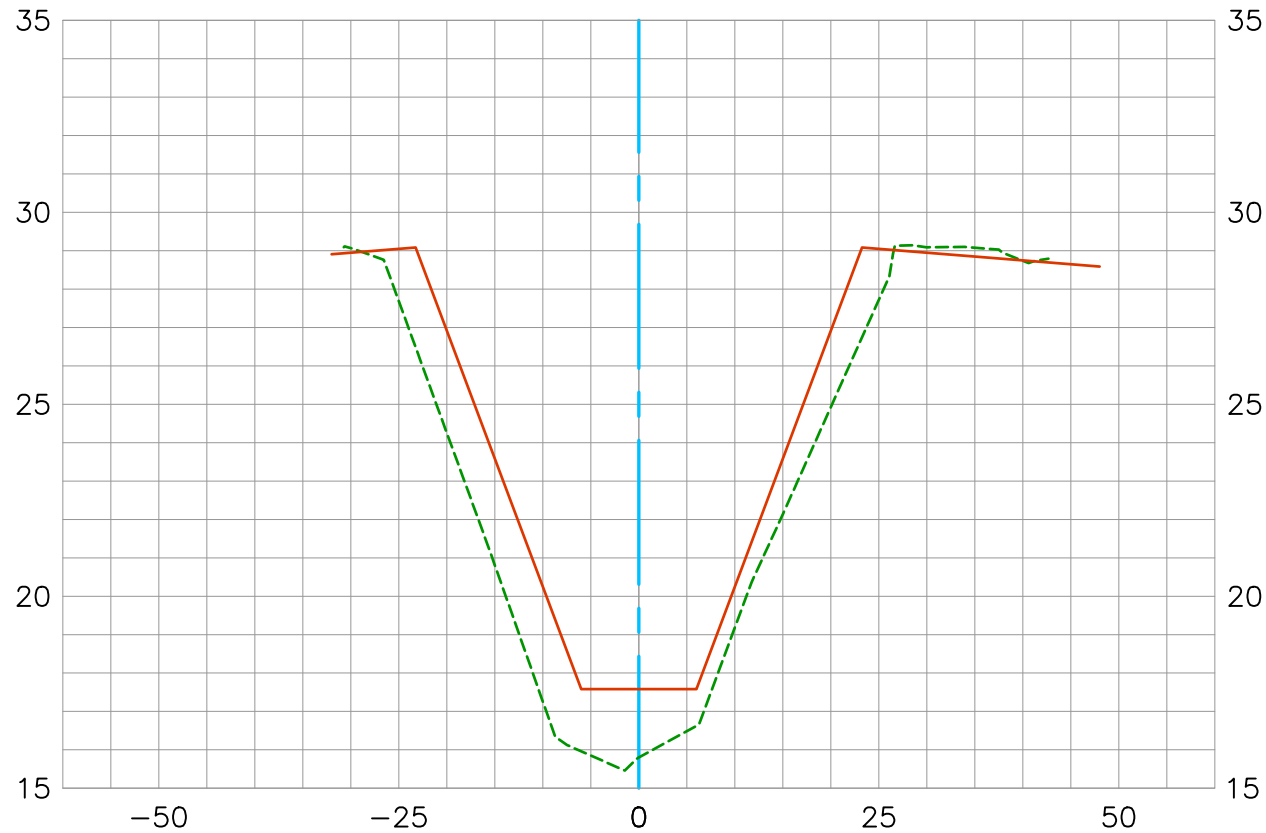

Existing Condition 2019 ---
Record As-Built Plan (1959) ---
Construction Centerline ---

Horizontal Scale 1"=20'
Vertical Scale 1"=5'

DATE PREPARED: 11/12/2019


U.S. Survey Foot

OC Public Works/Engineering Services
OC Survey/Field Services
Boundary Analysis & Mapping



BOLSA CHICA CHANNEL (C02)

306+50.00
CL

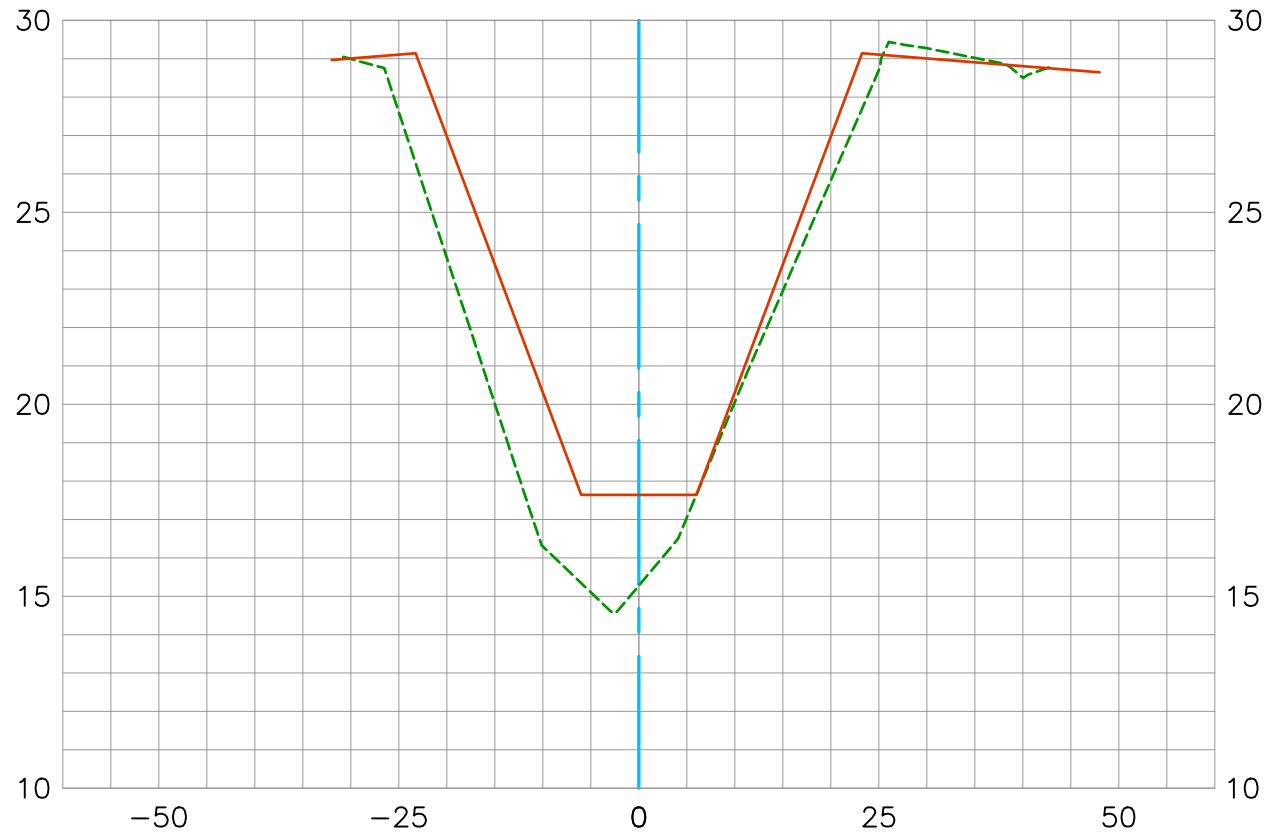

Existing Condition 2019 ---
Record As-Built Plan (1959) —
Construction Centerline ---

Horizontal Scale 1"=20'
Vertical Scale 1"=5'


DATE PREPARED: 11/12/2019

U.S. Survey Foot

OC Public Works/Engineering Services
OC Survey/Field Services
Boundary Analysis & Mapping

BOLSA CHICA CHANNEL (C02)

307+00.00
CL

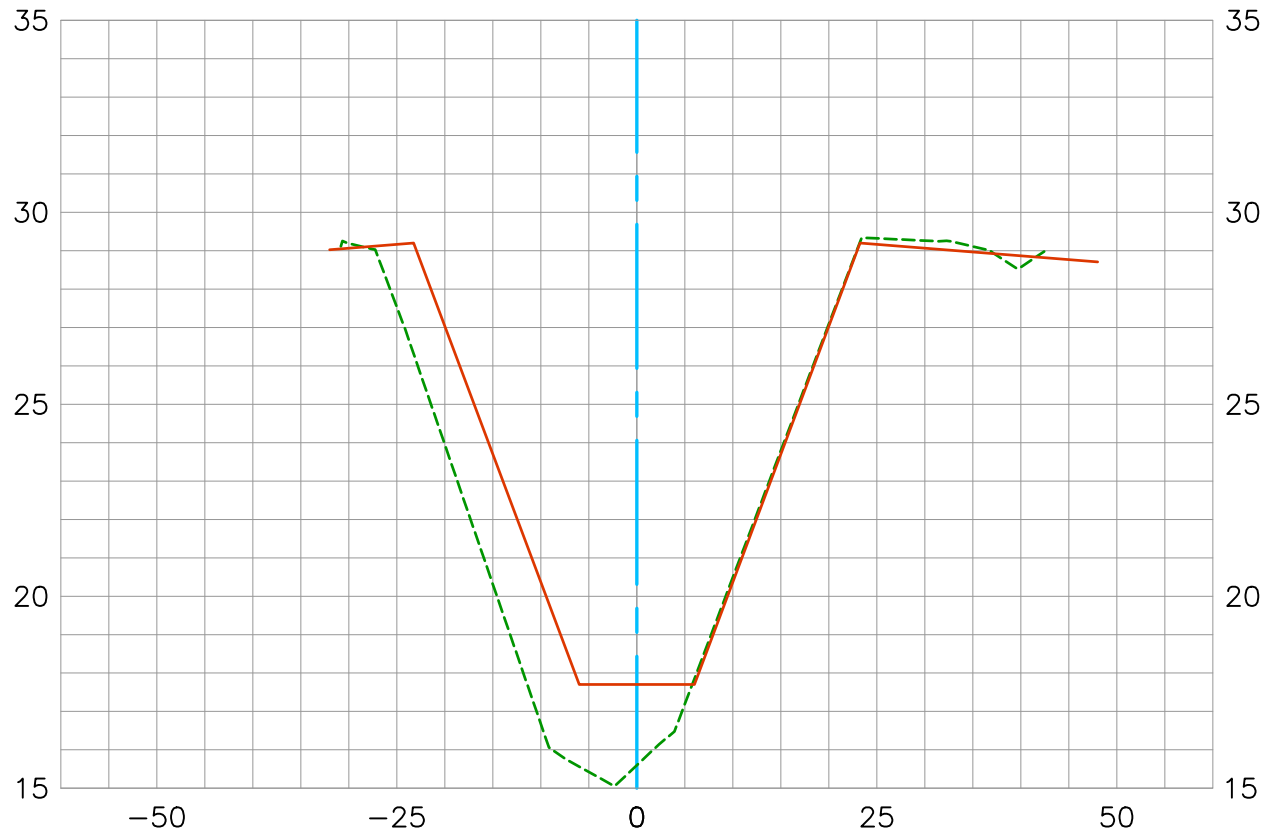

Existing Condition 2019 ---
Record As-Built Plan (1959) ---
Construction Centerline ---

Horizontal Scale 1"=20'
Vertical Scale 1"=5'


DATE PREPARED: 11/12/2019

U.S. Survey Foot

OC Public Works/Engineering Services
OC Survey/Field Services
Boundary Analysis & Mapping

BOLSA CHICA CHANNEL (C02)

307+50.00
CL

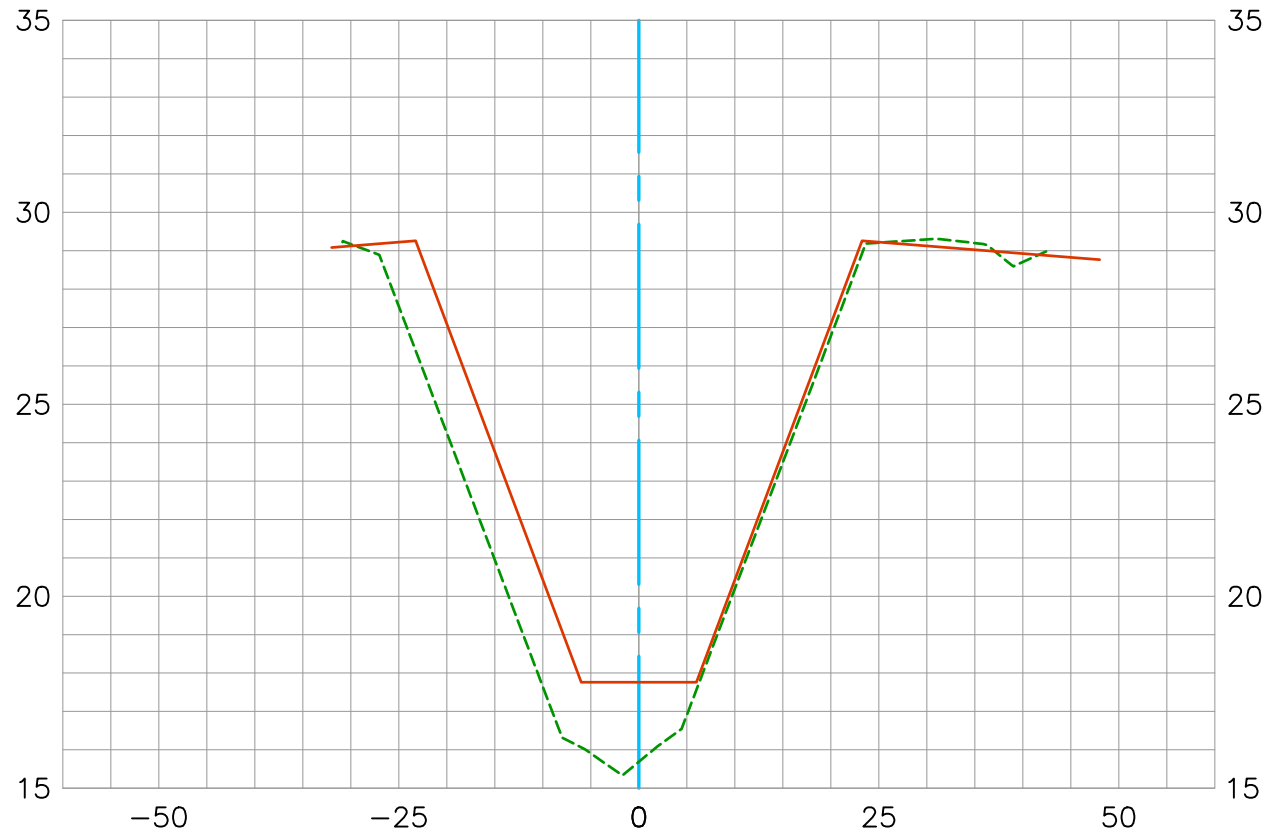

Existing Condition 2019 ---
Record As-Built Plan (1959) ---
Construction Centerline ---

Horizontal Scale 1"=20'
Vertical Scale 1"=5'


DATE PREPARED: 11/12/2019

U.S. Survey Foot

OC Public Works/Engineering Services
OC Survey/Field Services
Boundary Analysis & Mapping

BOLSA CHICA CHANNEL (C02)

308+00.00
CL

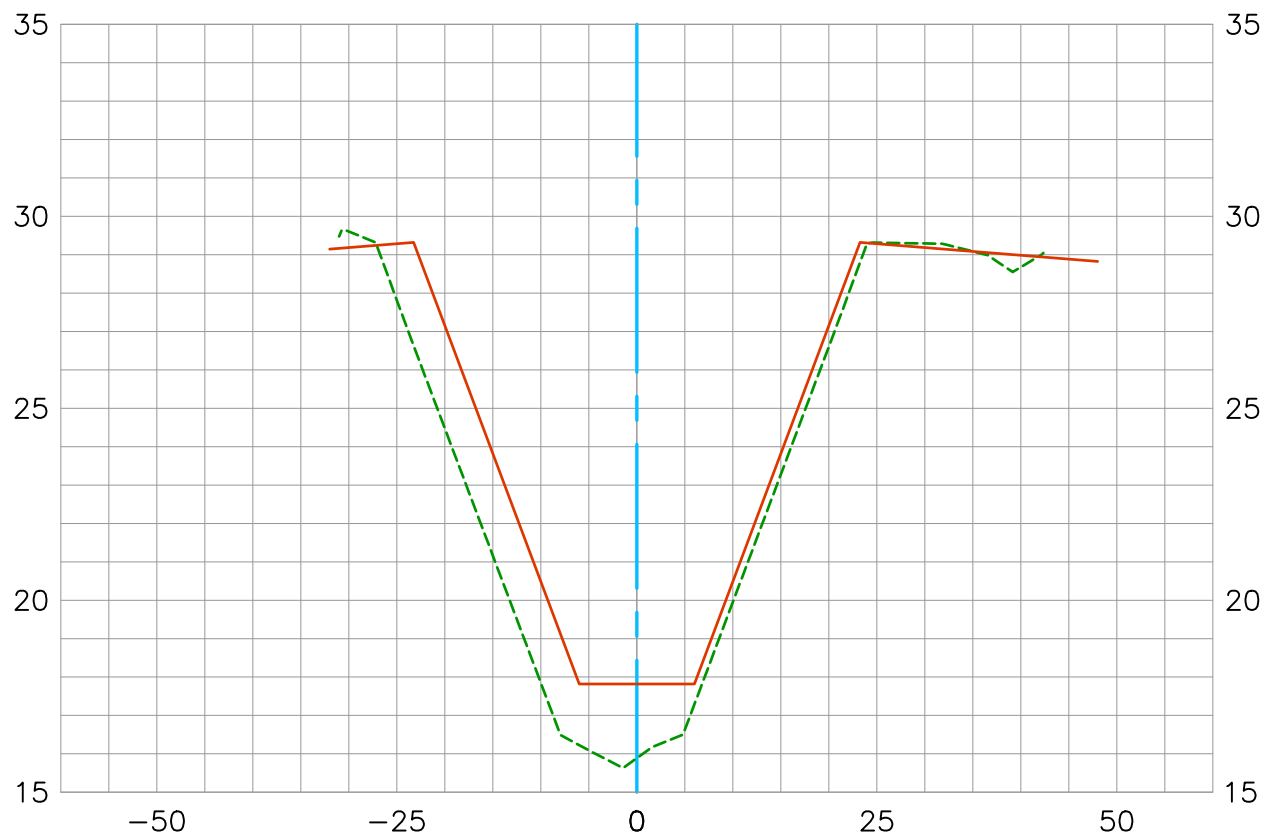

Existing Condition 2019 ---
Record As-Built Plan (1959) ---
Construction Centerline ---


Horizontal Scale 1"=20'
Vertical Scale 1"=5'

DATE PREPARED: 11/12/2019



BOLSA CHICA CHANNEL (C02)

308+50.00
CL

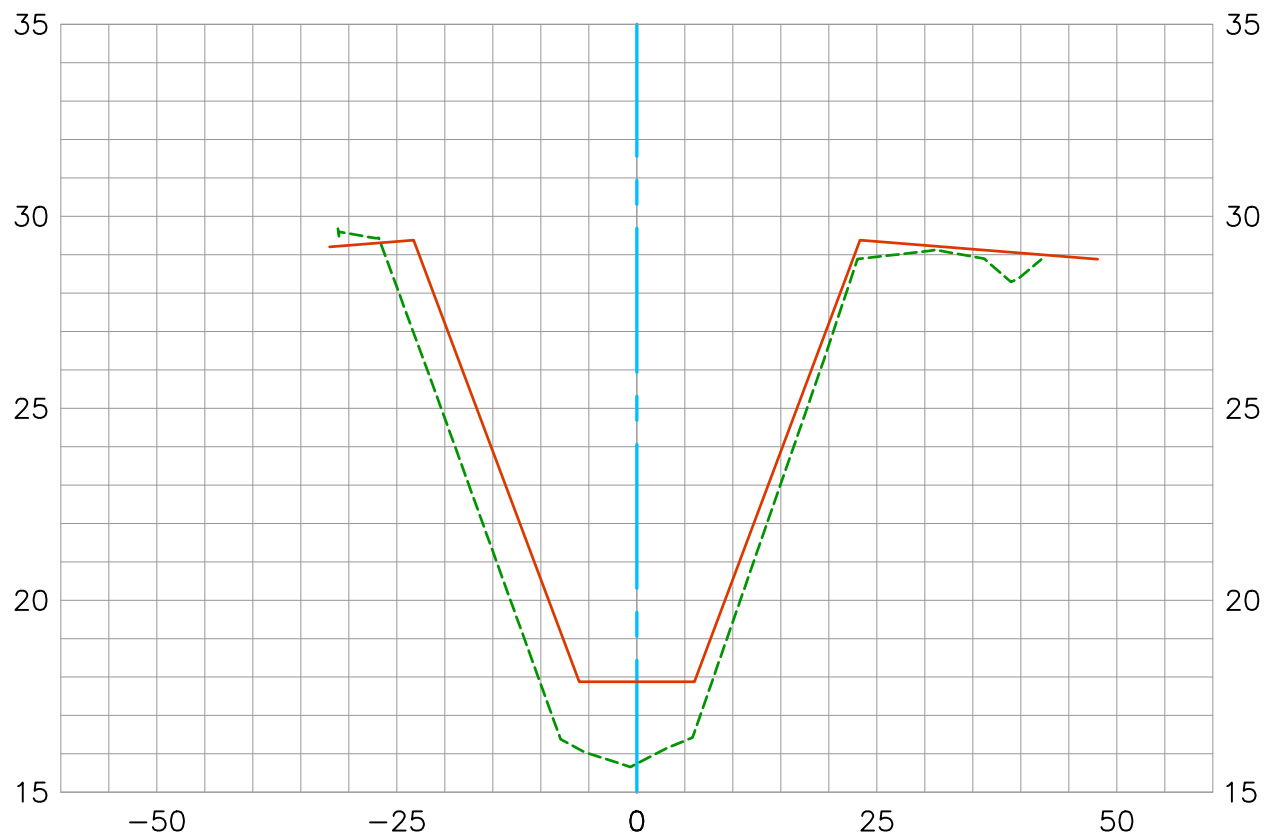

Existing Condition 2019 ---
Record As-Built Plan (1959) ---
Construction Centerline ---


Horizontal Scale 1"=20'
Vertical Scale 1"=5'

DATE PREPARED: 11/12/2019



BOLSA CHICA CHANNEL (C02)

309+00.00
CL

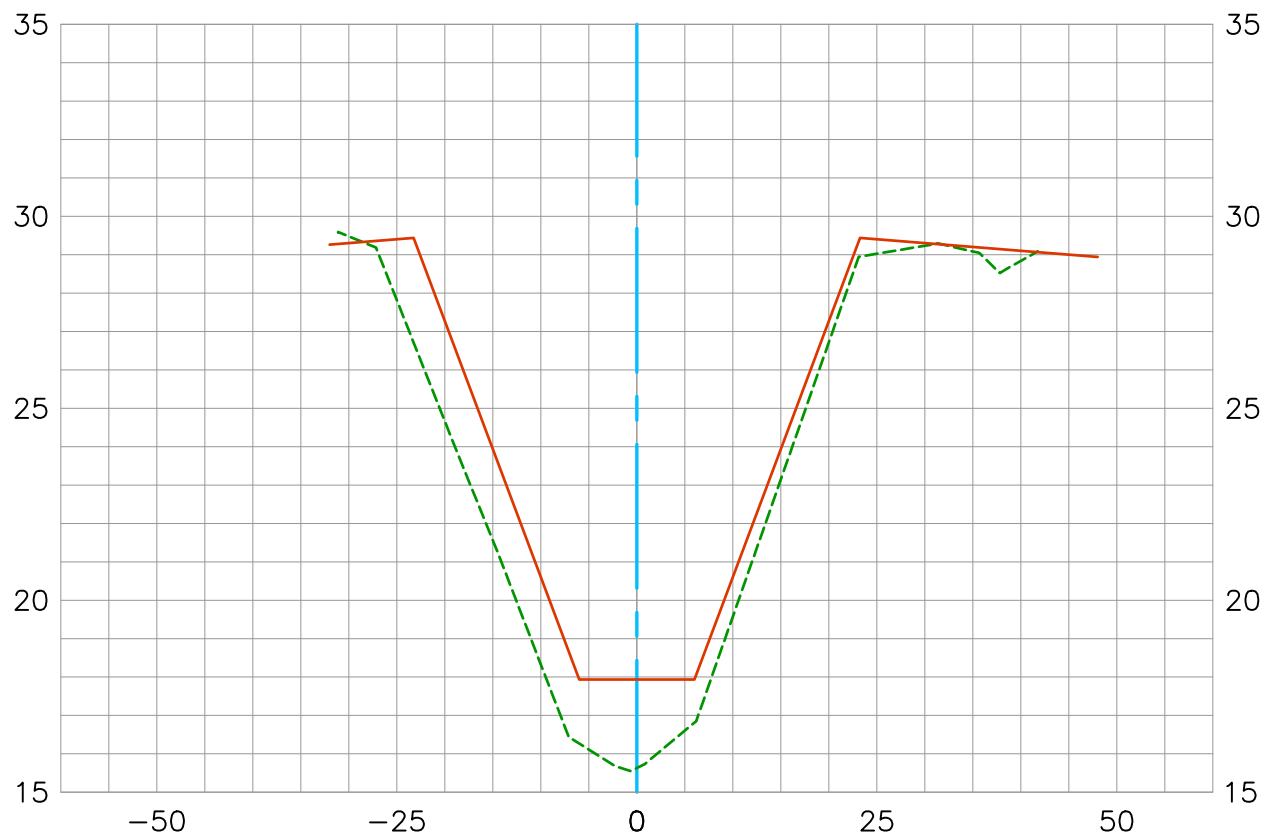

Existing Condition 2019 ---
Record As-Built Plan (1959) ---
Construction Centerline ---

Horizontal Scale 1"=20'
Vertical Scale 1"=5'


DATE PREPARED: 11/12/2019

U.S. Survey Foot

OC Public Works/Engineering Services
OC Survey/Field Services
Boundary Analysis & Mapping

BOLSA CHICA CHANNEL (C02)

309+50.00
CL

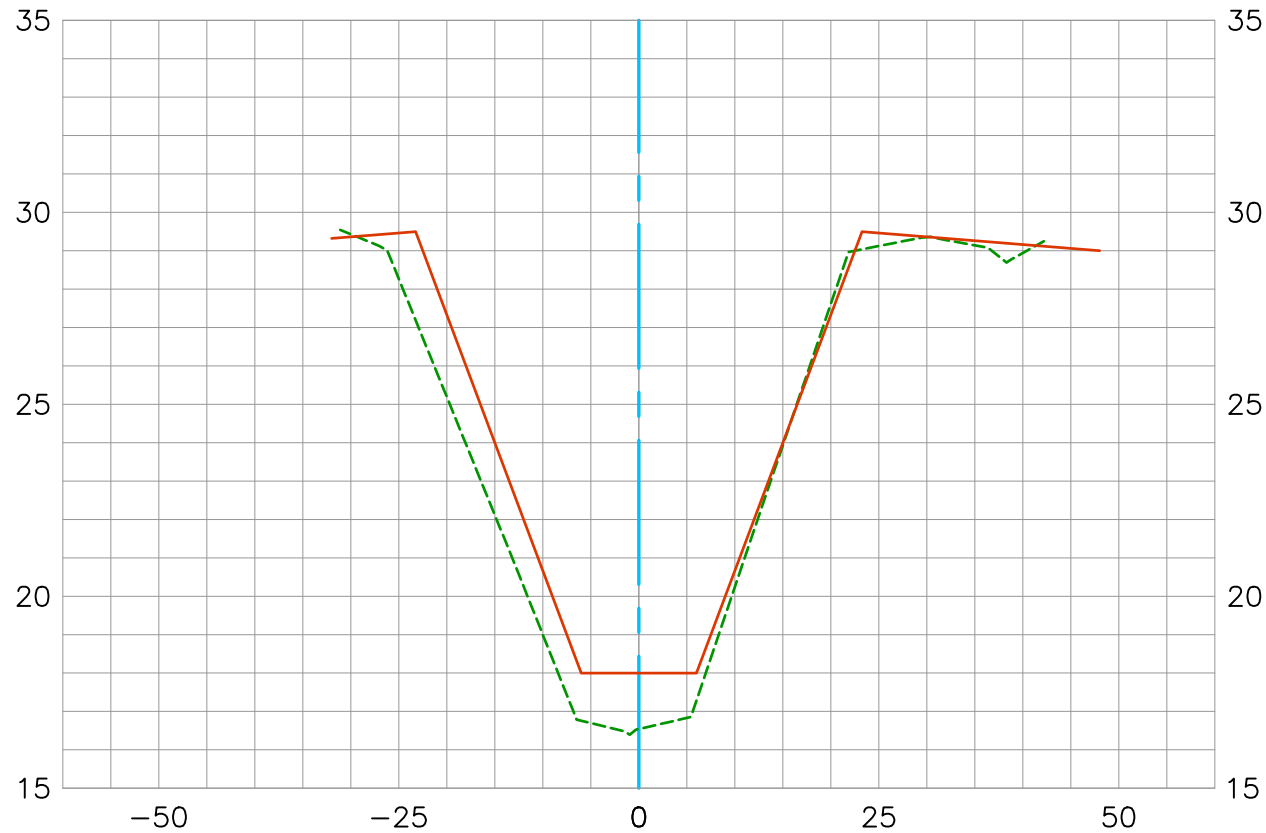

Existing Condition 2019 ---
Record As-Built Plan (1959) ---
Construction Centerline ---

Horizontal Scale 1"=20'
Vertical Scale 1"=5'


DATE PREPARED: 11/12/2019

U.S. Survey Foot

OC Public Works/Engineering Services
OC Survey/Field Services
Boundary Analysis & Mapping

BOLSA CHICA CHANNEL (C02)

310+00.00
CL

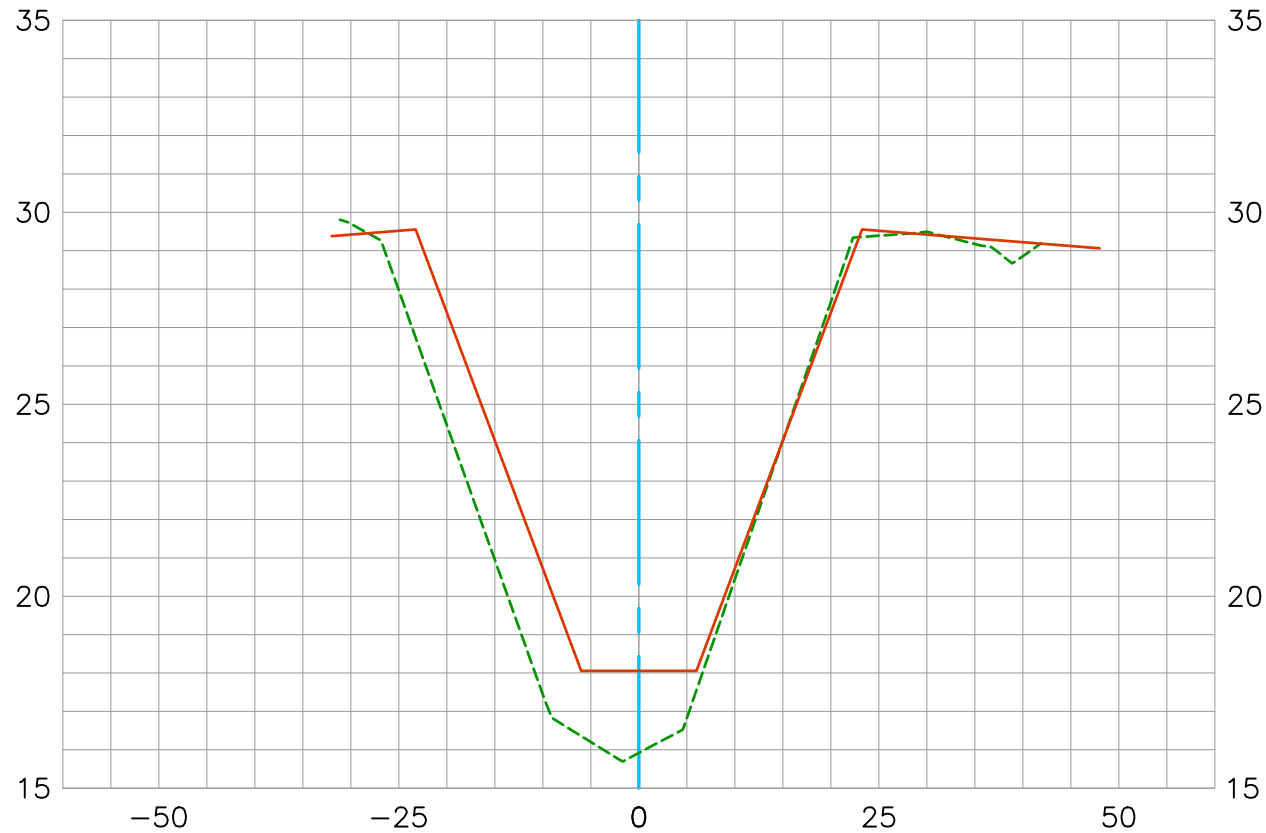

Existing Condition 2019 ---
Record As-Built Plan (1959) ---
Construction Centerline ---

Horizontal Scale 1"=20'
Vertical Scale 1"=5'


DATE PREPARED: 11/12/2019

U.S. Survey Foot

OC Public Works/Engineering Services
OC Survey/Field Services
Boundary Analysis & Mapping

BOLSA CHICA CHANNEL (C02)

310+50.00
CL

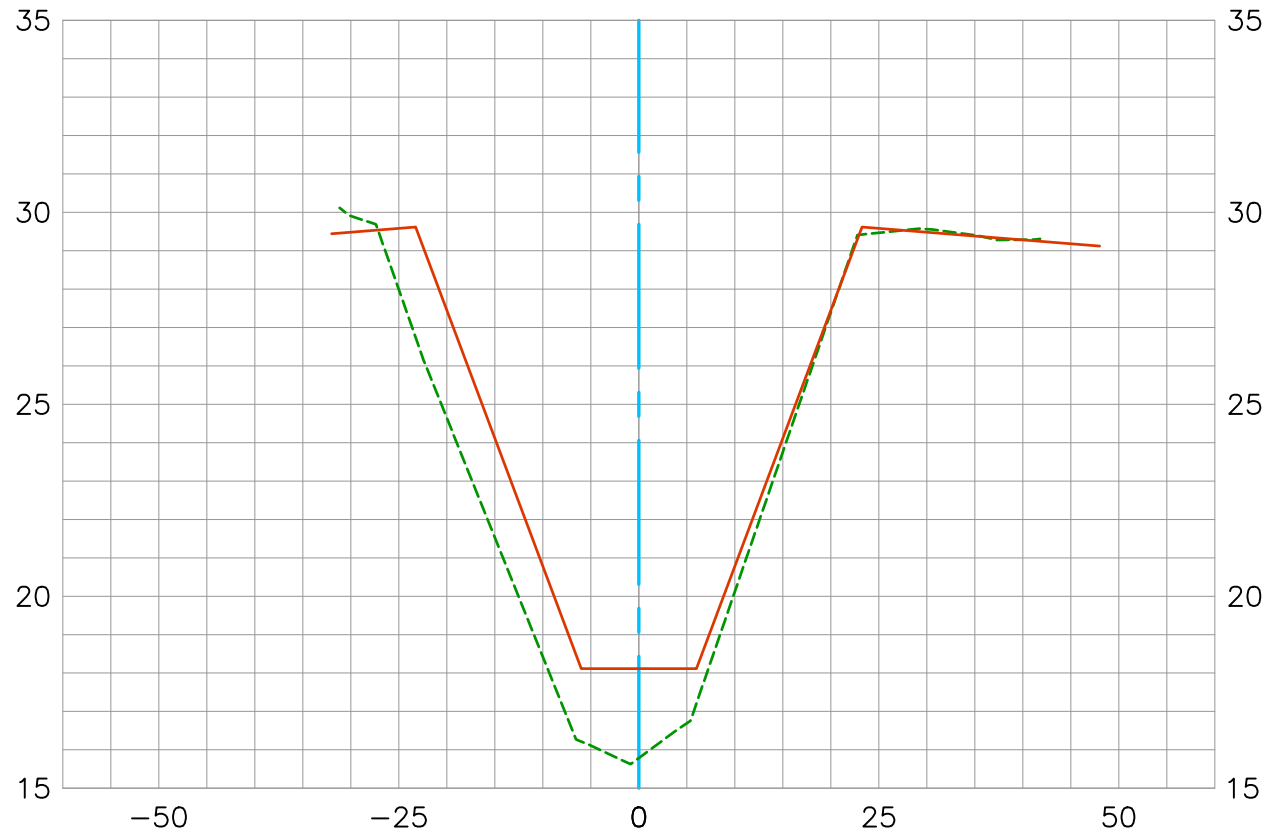

Existing Condition 2019 ---
Record As-Built Plan (1959) ---
Construction Centerline ---

Horizontal Scale 1"=20'
Vertical Scale 1"=5'


DATE PREPARED: 11/12/2019

U.S. Survey Foot

OC Public Works/Engineering Services
OC Survey/Field Services
Boundary Analysis & Mapping

BOLSA CHICA CHANNEL (C02)

311+00.00
CL

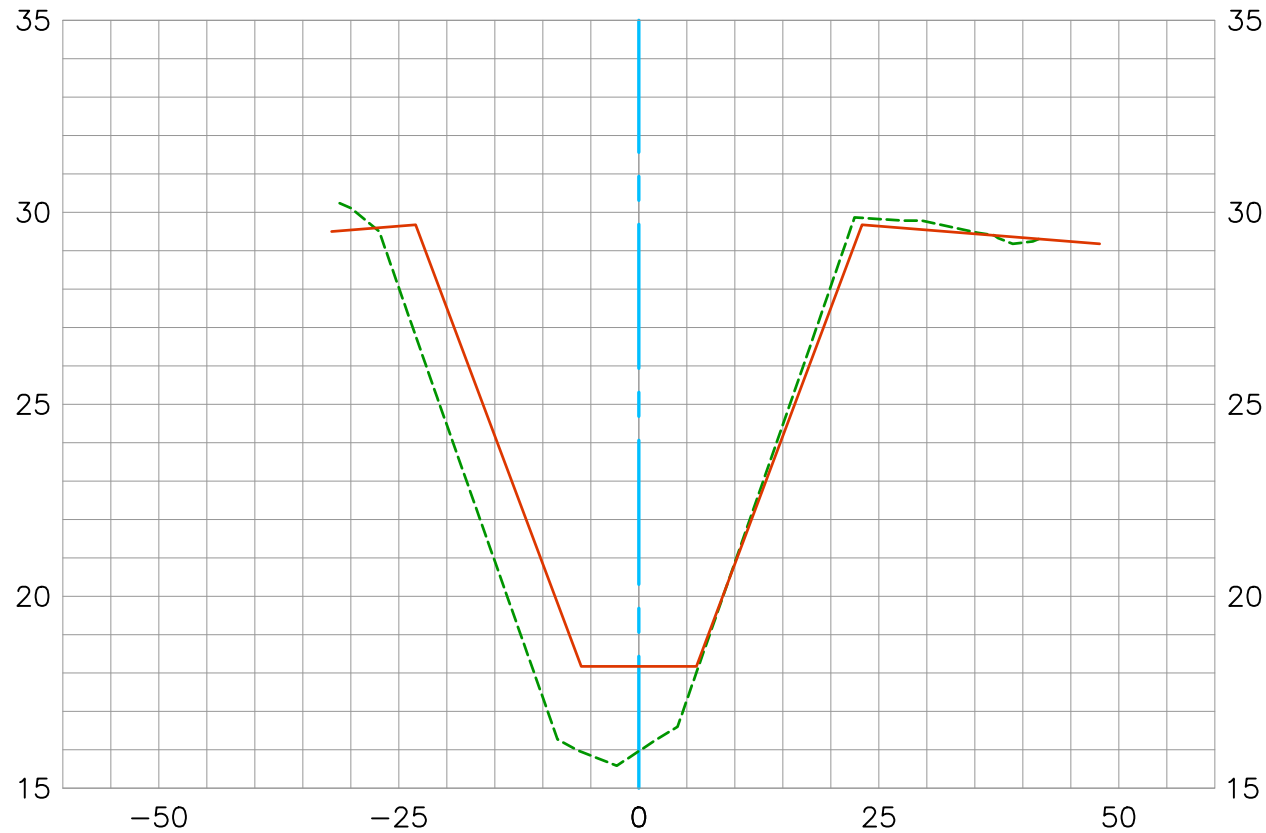

Existing Condition 2019 
Record As-Built Plan (1959) 
Construction Centerline 


Horizontal Scale 1"=20'
Vertical Scale 1"=5'

DATE PREPARED: 11/12/2019



BOLSA CHICA CHANNEL (C02)

311+50.00
CL

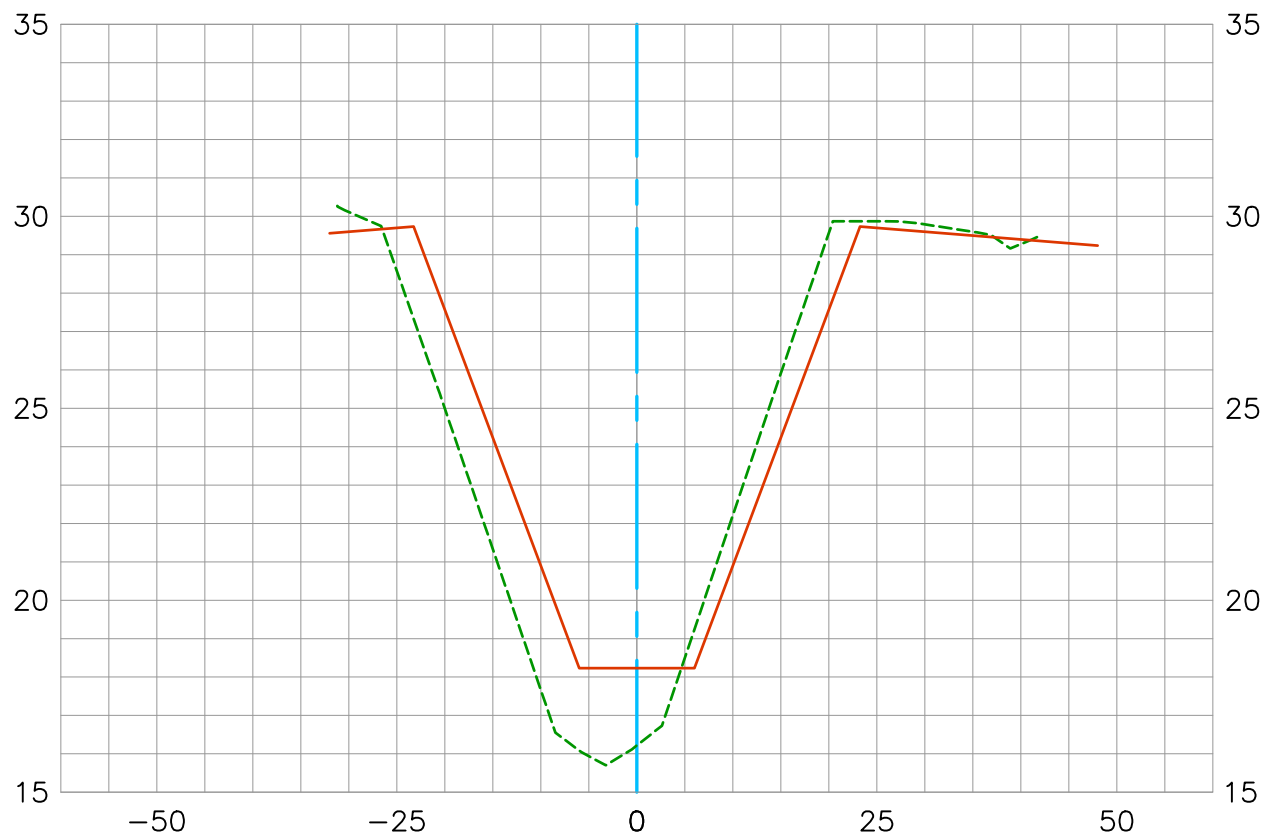

Existing Condition 2019 - - - - -
Record As-Built Plan (1959) —————
Construction Centerline - - - - -


Horizontal Scale 1"=20'
Vertical Scale 1"=5'

DATE PREPARED: 11/12/2019



BOLSA CHICA CHANNEL (C02)

312+00.00
CL

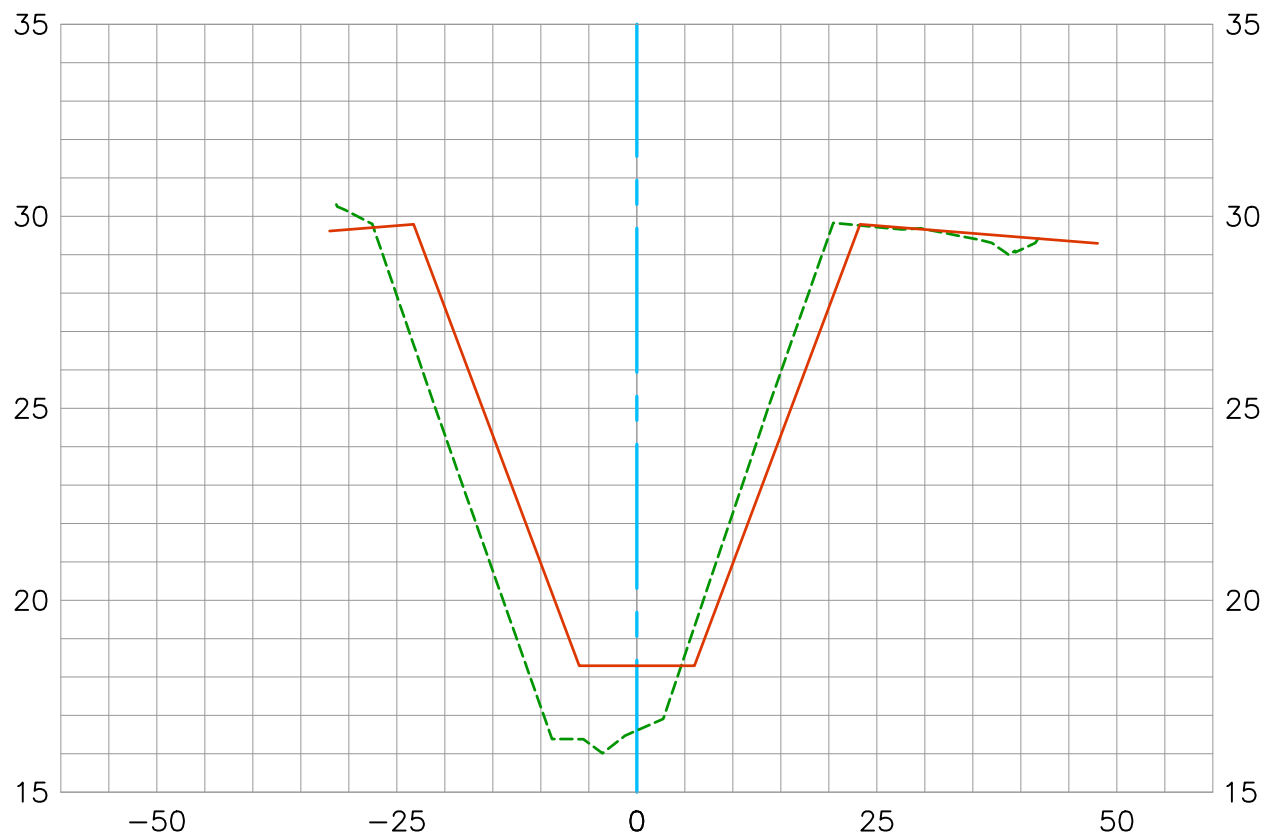

Existing Condition 2019 ---
Record As-Built Plan (1959) ---
Construction Centerline ---


Horizontal Scale 1"=20'
Vertical Scale 1"=5'

DATE PREPARED: 11/12/2019



BOLSA CHICA CHANNEL (C02)

312+50.00
CL

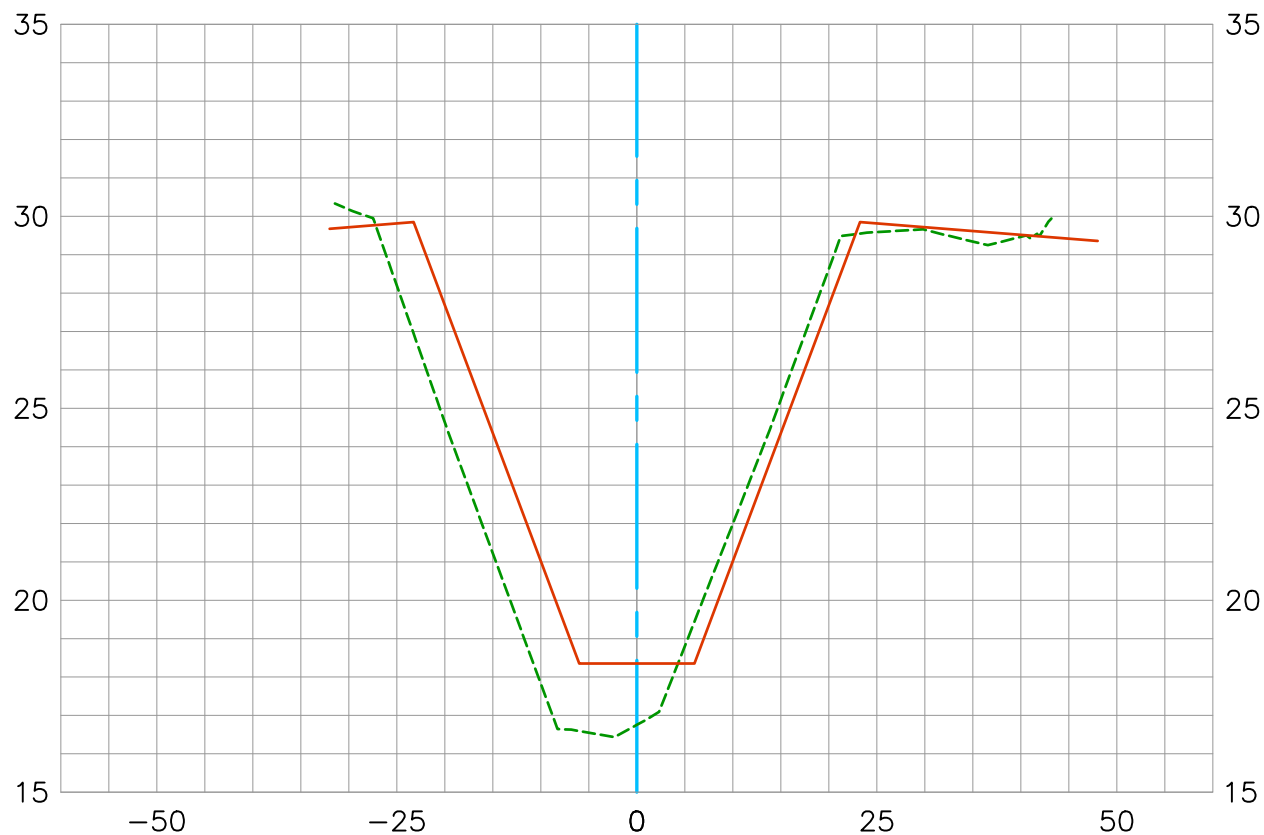

Existing Condition 2019 ---
Record As-Built Plan (1959) ---
Construction Centerline ---

Horizontal Scale 1"=20'
Vertical Scale 1"=5'


DATE PREPARED: 11/12/2019

U.S. Survey Foot

OC Public Works/Engineering Services
OC Survey/Field Services
Boundary Analysis & Mapping

BOLSA CHICA CHANNEL (C02)

313+00.00
CL

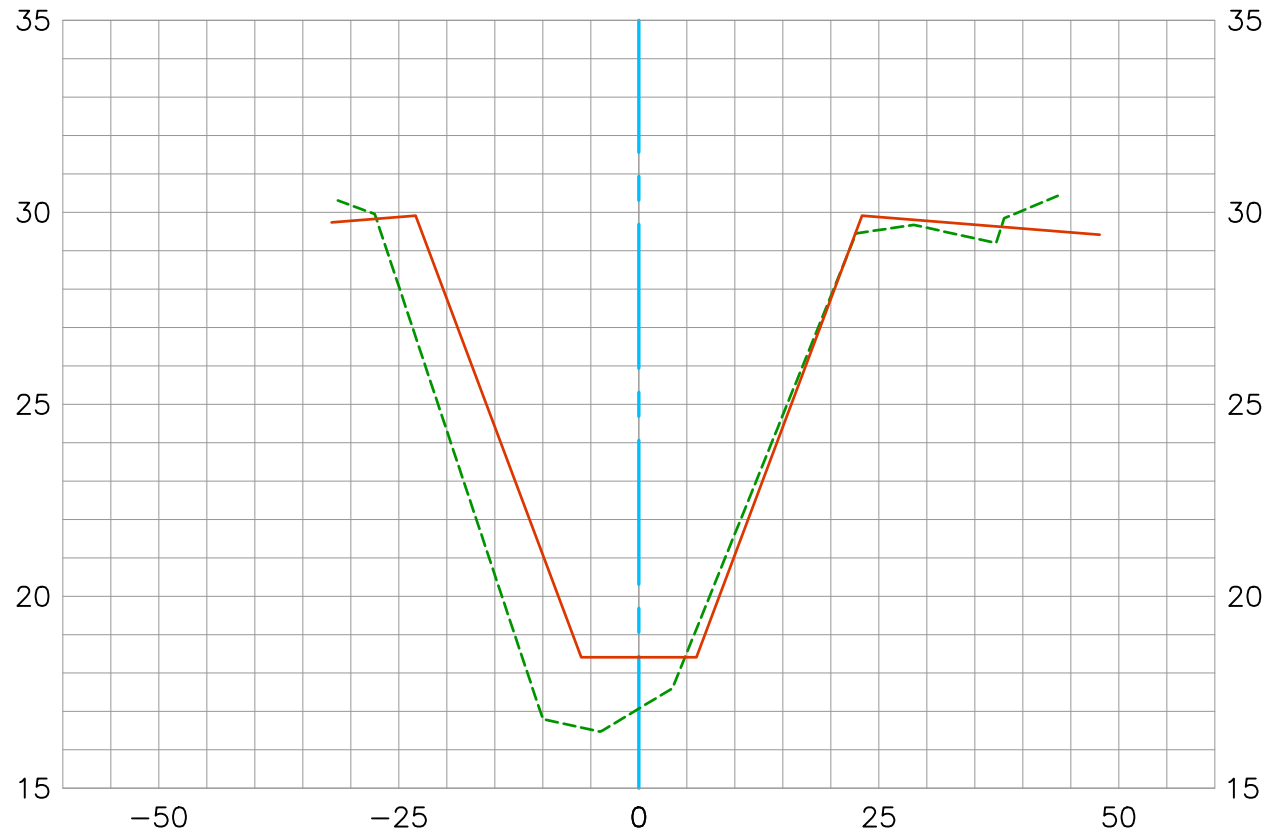

Existing Condition 2019 ---
Record As-Built Plan (1959) ---
Construction Centerline ---

Horizontal Scale 1"=20'
Vertical Scale 1"=5'


DATE PREPARED: 11/12/2019

U.S. Survey Foot

OC Public Works/Engineering Services
OC Survey/Field Services
Boundary Analysis & Mapping

BOLSA CHICA CHANNEL (C02)

313+50.00
CL

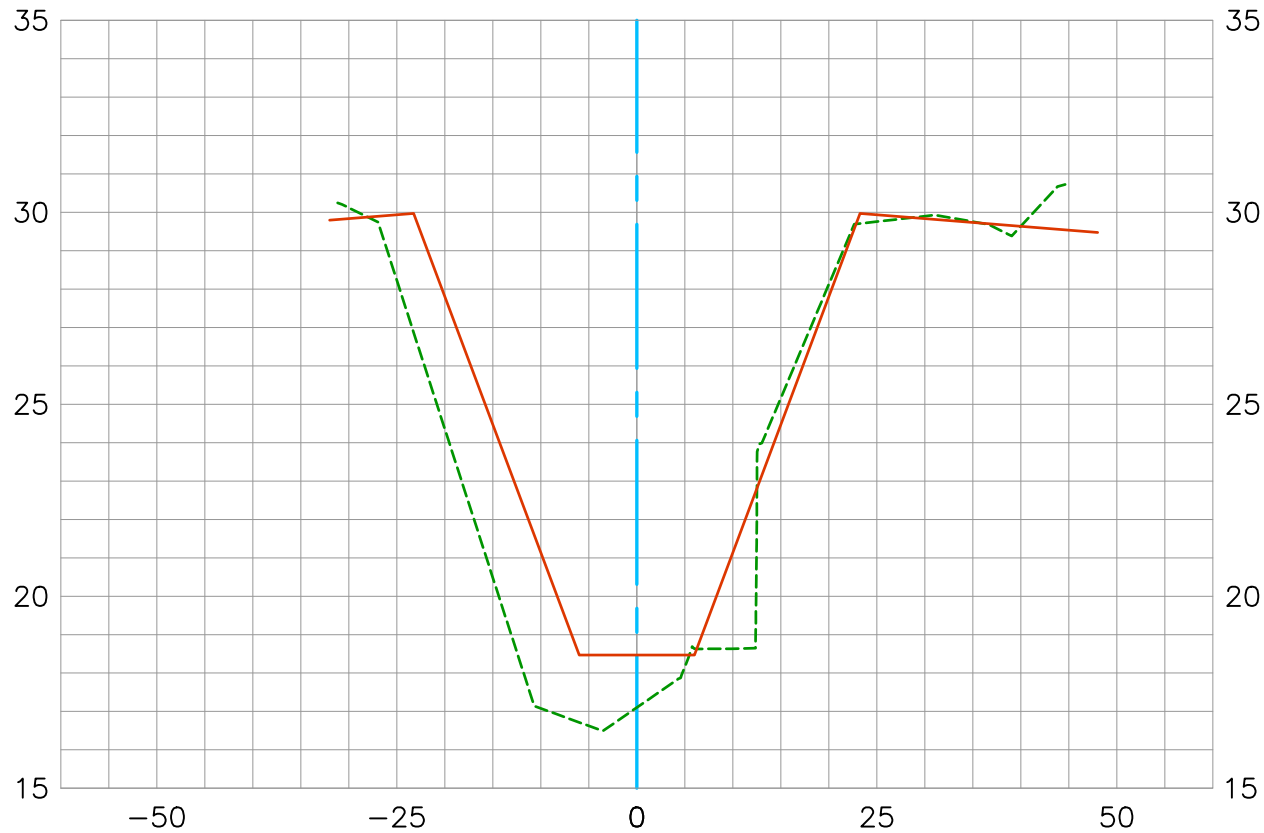

Existing Condition 2019 ---
Record As-Built Plan (1959) ---
Construction Centerline ---

Horizontal Scale 1"=20'
Vertical Scale 1"=5'


DATE PREPARED: 11/12/2019

U.S. Survey Foot

OC Public Works/Engineering Services
OC Survey/Field Services
Boundary Analysis & Mapping

BOLSA CHICA CHANNEL (C02)

314+00.00
CL

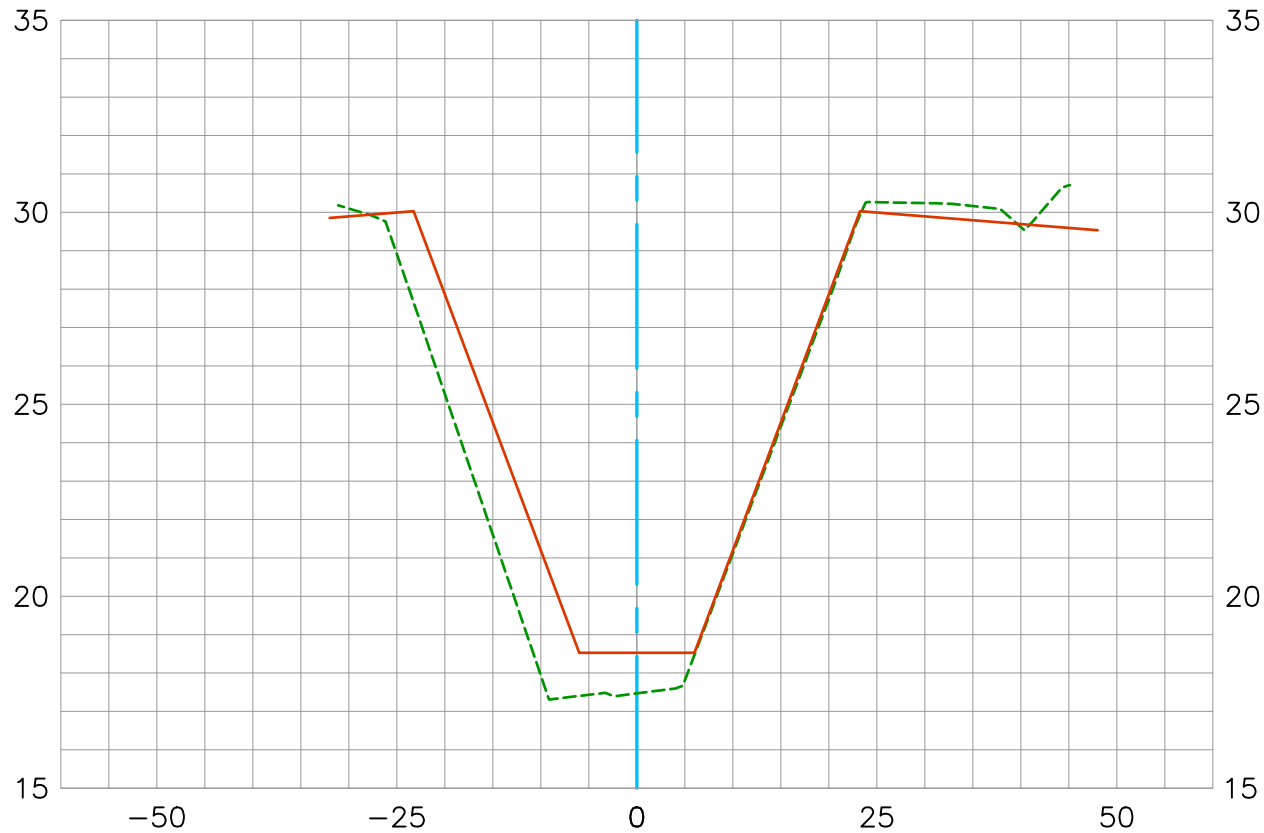

Existing Condition 2019 ---
Record As-Built Plan (1959) ---
Construction Centerline ---

Horizontal Scale 1"=20'
Vertical Scale 1"=5'


DATE PREPARED: 11/12/2019

U.S. Survey Foot

OC Public Works/Engineering Services
OC Survey/Field Services
Boundary Analysis & Mapping

BOLSA CHICA CHANNEL (C02)

314+50.00
CL

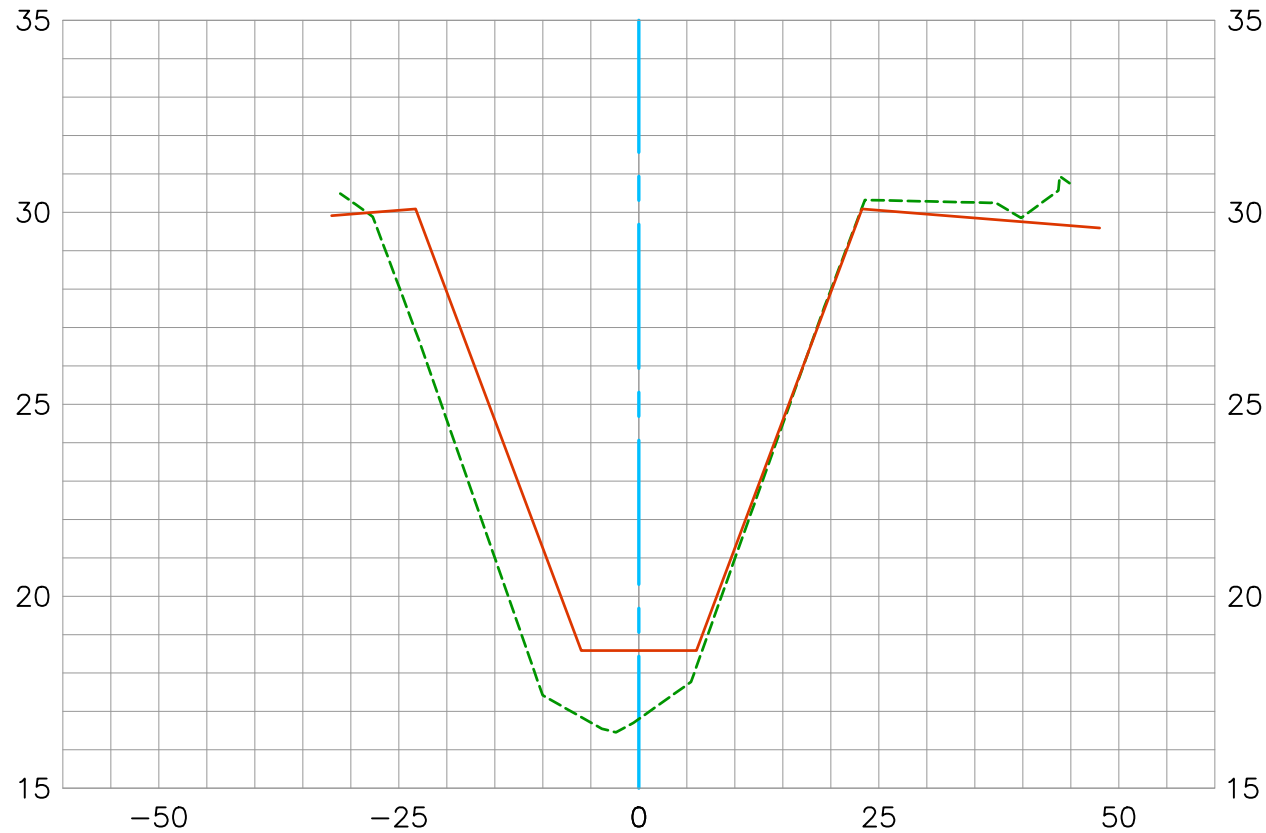

Existing Condition 2019 ---
Record As-Built Plan (1959) ---
Construction Centerline ---

Horizontal Scale 1"=20'
Vertical Scale 1"=5'

DATE PREPARED: 11/12/2019

U.S. Survey Foot


OC Public Works/Engineering Services
OC Survey/Field Services
Boundary Analysis & Mapping



BOLSA CHICA CHANNEL (C02)

315+00.00

CL

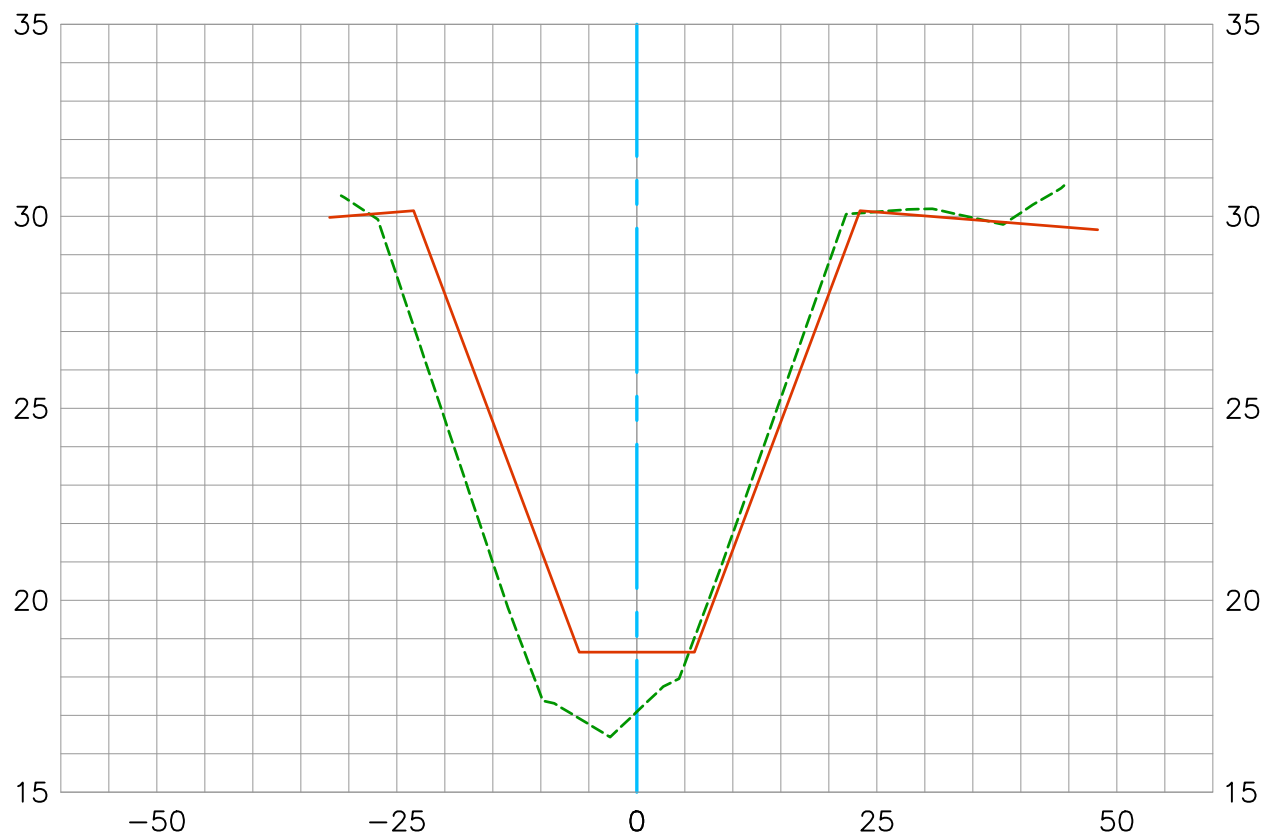

Existing Condition 2019 ---
Record As-Built Plan (1959) ---
Construction Centerline ---

Horizontal Scale 1"=20'
Vertical Scale 1"=5'

DATE PREPARED: 11/12/2019

U.S. Survey Foot


OC Public Works/Engineering Services
OC Survey/Field Services
Boundary Analysis & Mapping



BOLSA CHICA CHANNEL (C02)

315+50.00

CL

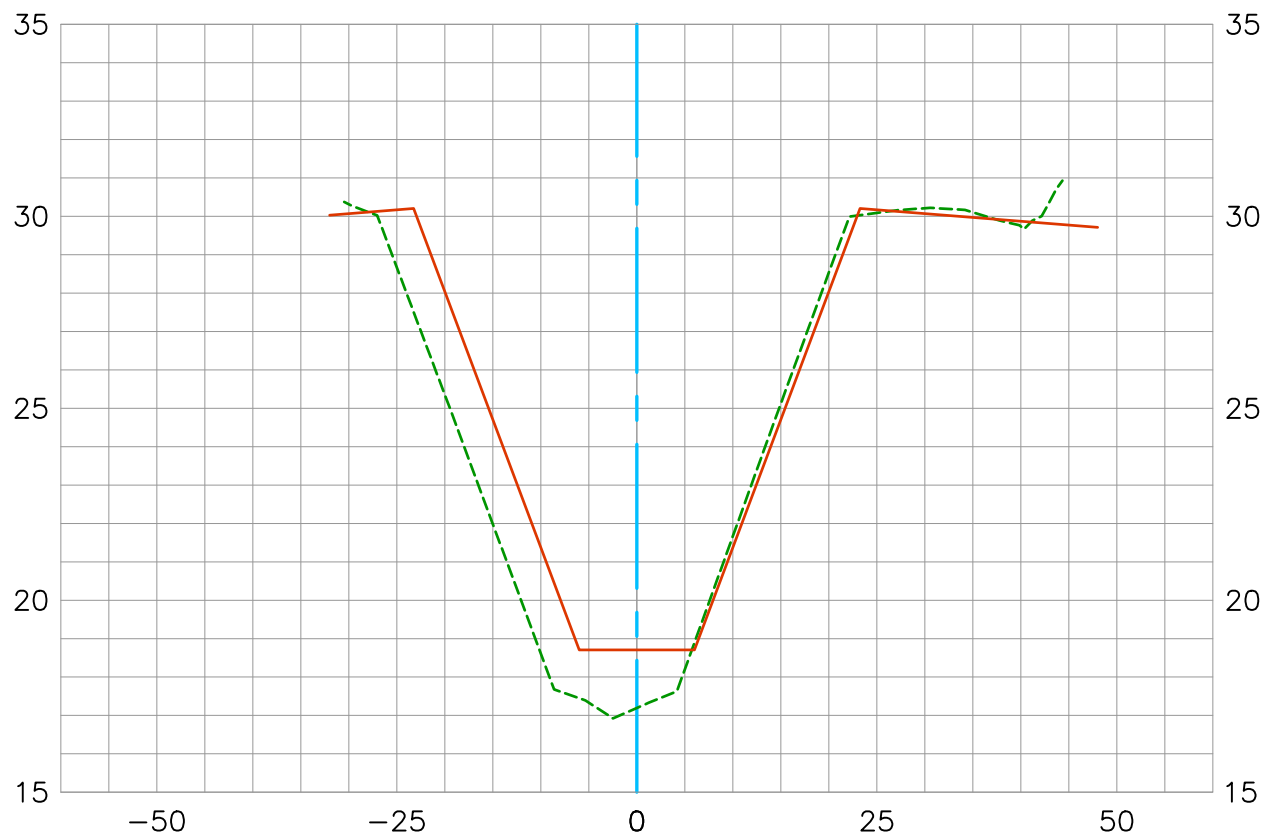

Existing Condition 2019 ----
Record As-Built Plan (1959) ————
Construction Centerline - - - -

Horizontal Scale 1"=20'
Vertical Scale 1"=5'


DATE PREPARED: 11/12/2019

U.S. Survey Foot

OC Public Works/Engineering Services
OC Survey/Field Services
Boundary Analysis & Mapping

BOLSA CHICA CHANNEL (C02)

316+00.00
CL

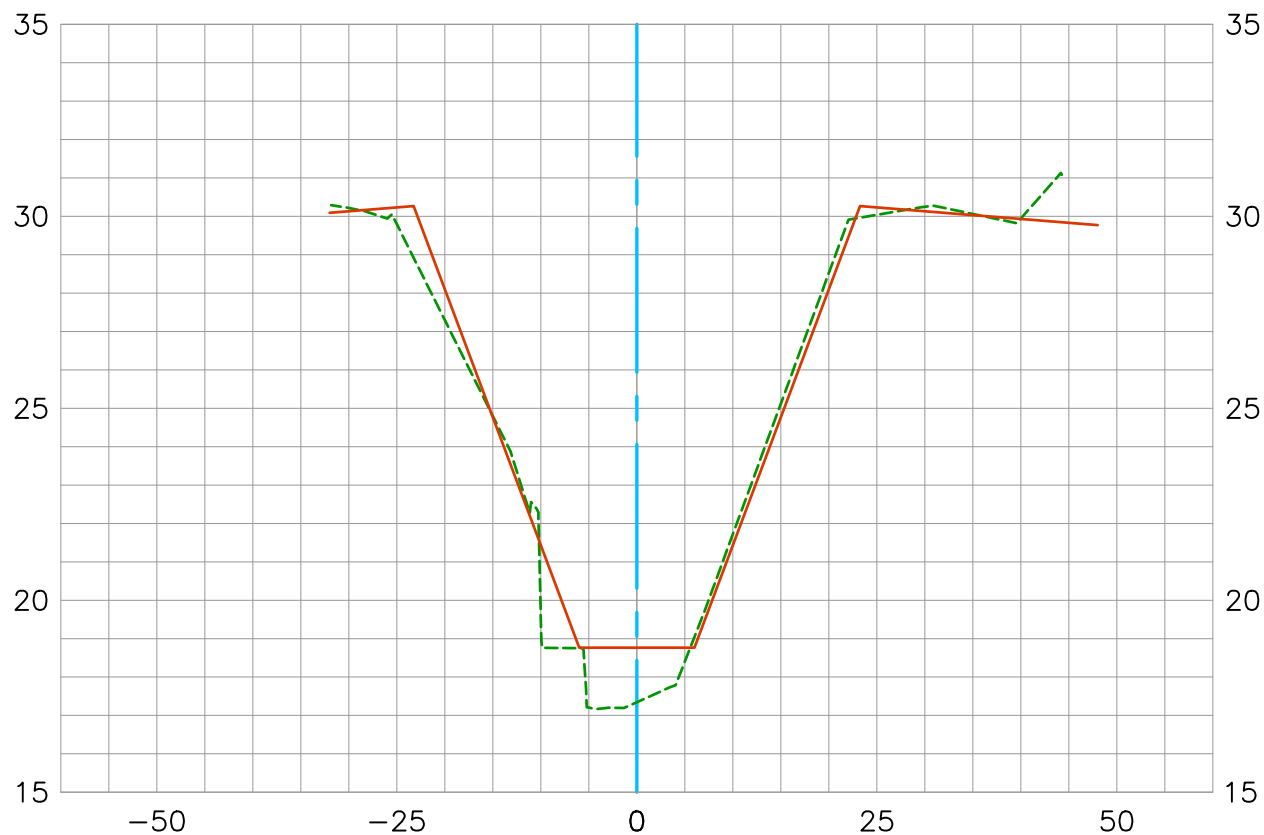

Existing Condition 2019 ---
Record As-Built Plan (1959) ---
Construction Centerline ---

Horizontal Scale 1"=20'
Vertical Scale 1"=5'

DATE PREPARED: 11/12/2019


U.S. *Survey
Foot*

OC Public Works/Engineering Services
OC Survey/Field Services
Boundary Analysis & Mapping

BOLSA CHICA CHANNEL (C02)

316+50.00

CL

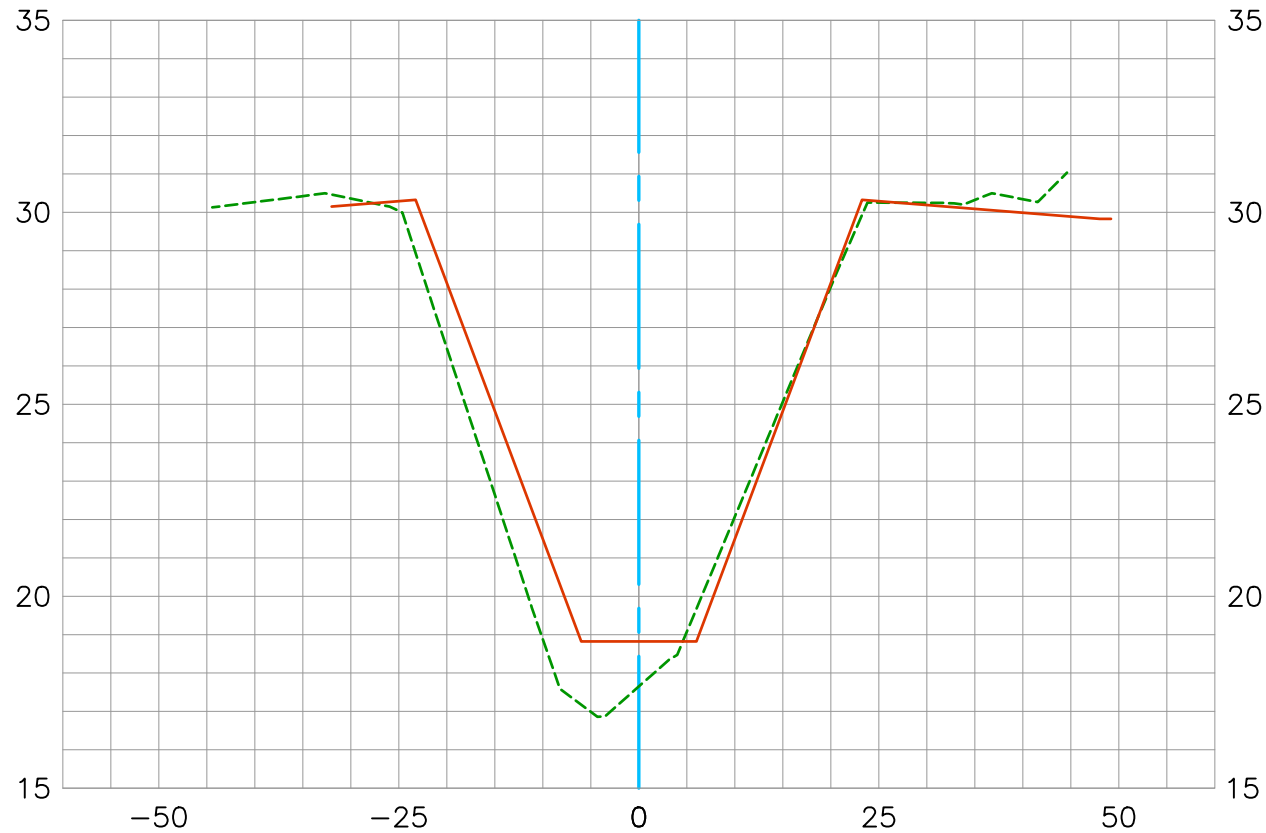

Existing Condition 2019 ---
Record As-Built Plan (1959) ---
Construction Centerline ---


Horizontal Scale 1"=20'
Vertical Scale 1"=5'

DATE PREPARED: 11/12/2019



BOLSA CHICA CHANNEL (C02)

317+00.00
CL

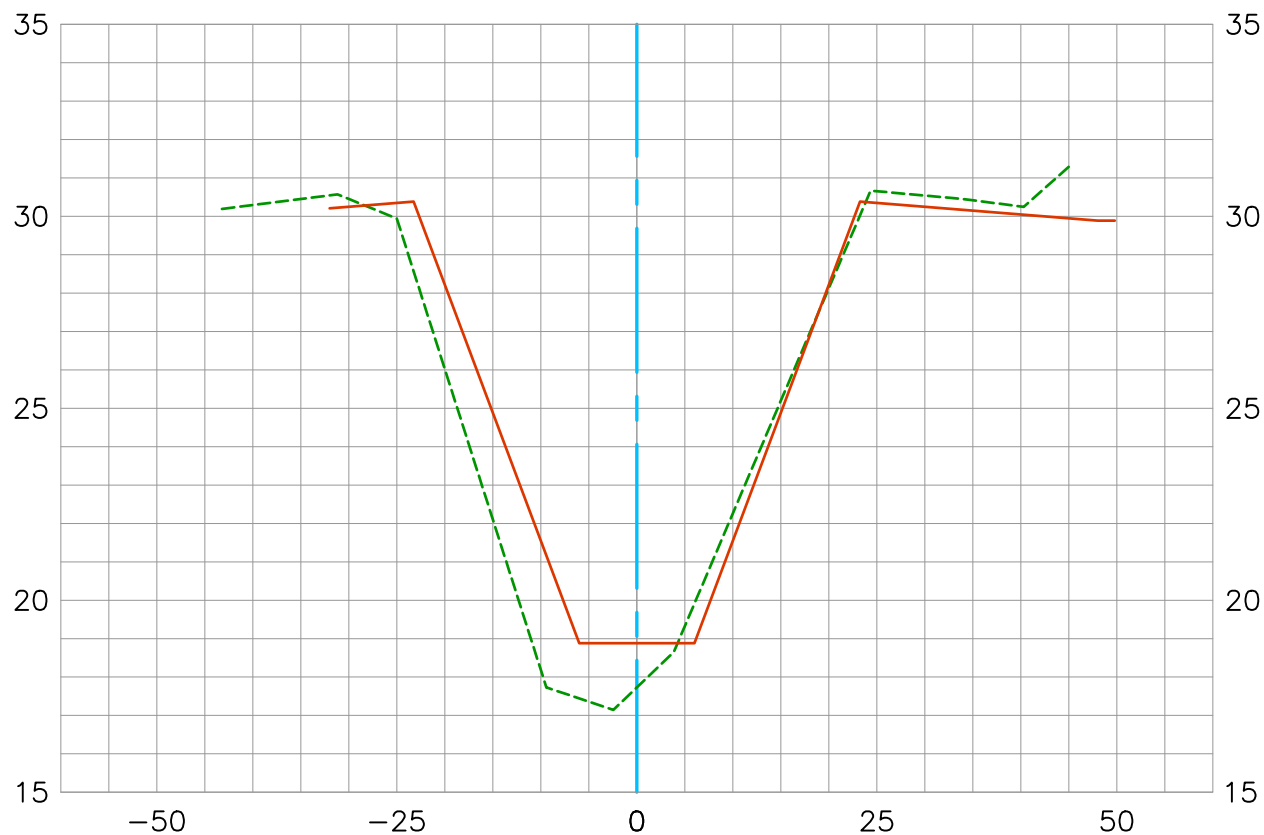

Existing Condition 2019 ---
Record As-Built Plan (1959) ---
Construction Centerline ---


Horizontal Scale 1"=20'
Vertical Scale 1"=5'

DATE PREPARED: 11/12/2019



BOLSA CHICA CHANNEL (C02)

317+50.00
CL

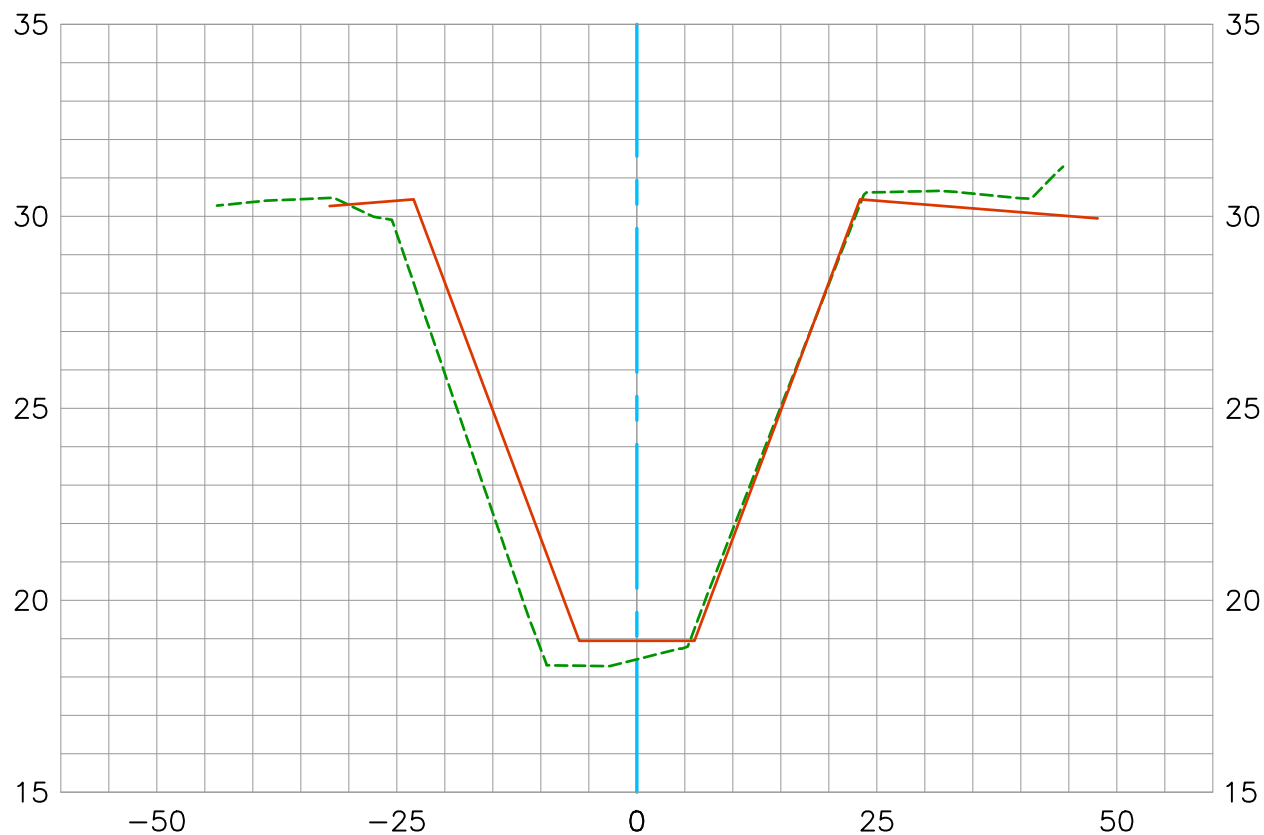

Existing Condition 2019 ---
Record As-Built Plan (1959) ---
Construction Centerline ---


Horizontal Scale 1"=20'
Vertical Scale 1"=5'

DATE PREPARED: 11/12/2019

U.S. Survey Foot

OC Public Works/Engineering Services
OC Survey/Field Services
Boundary Analysis & Mapping

BOLSA CHICA CHANNEL (C02)
317+73.53
@ CONCRETE STRUCTURE
CL

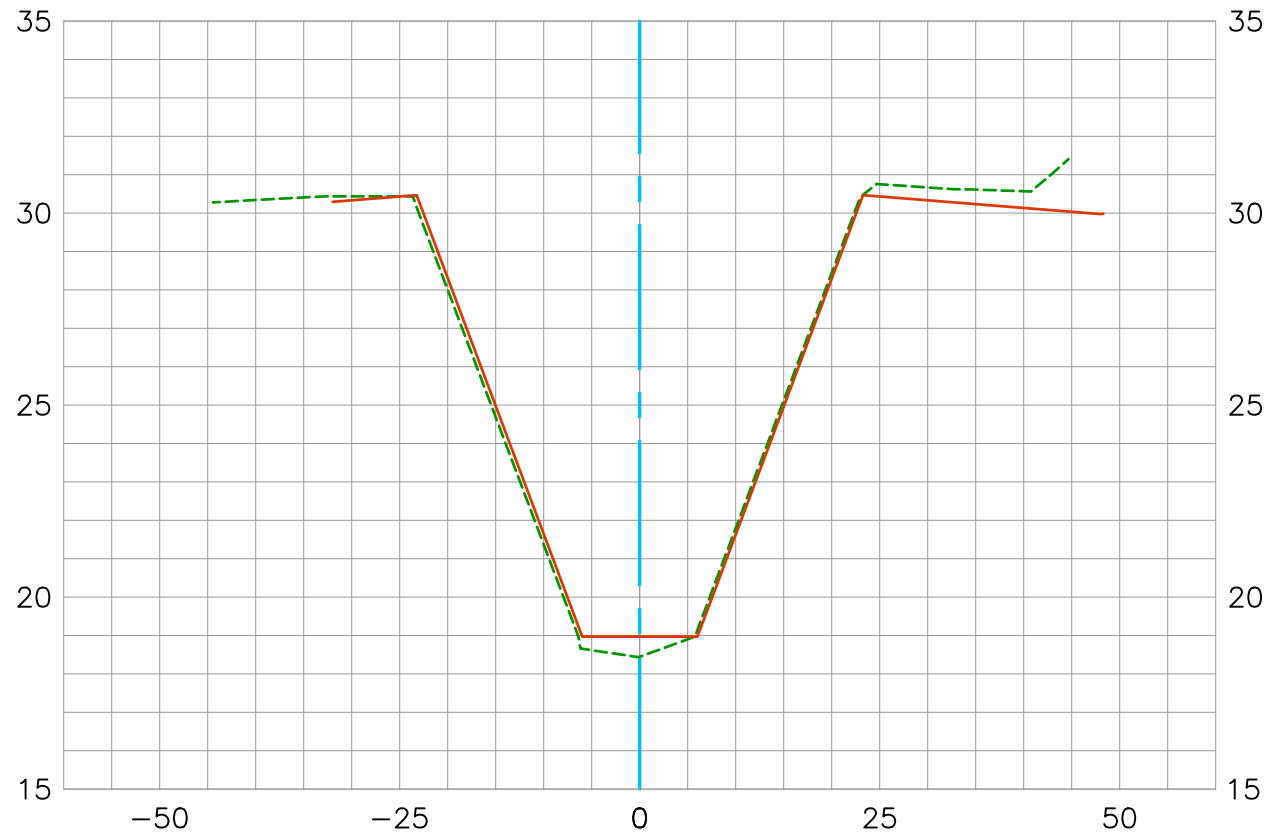


Existing Condition 2019 ---
Record As-Built Plan (1959) ---
Construction Centerline ---

Horizontal Scale 1"=20'
Vertical Scale 1"=5'

DATE PREPARED: 11/12/2019



BOLSA CHICA CHANNEL (C02) 317+93.65 @ CONCRETE STRUCTURE CL

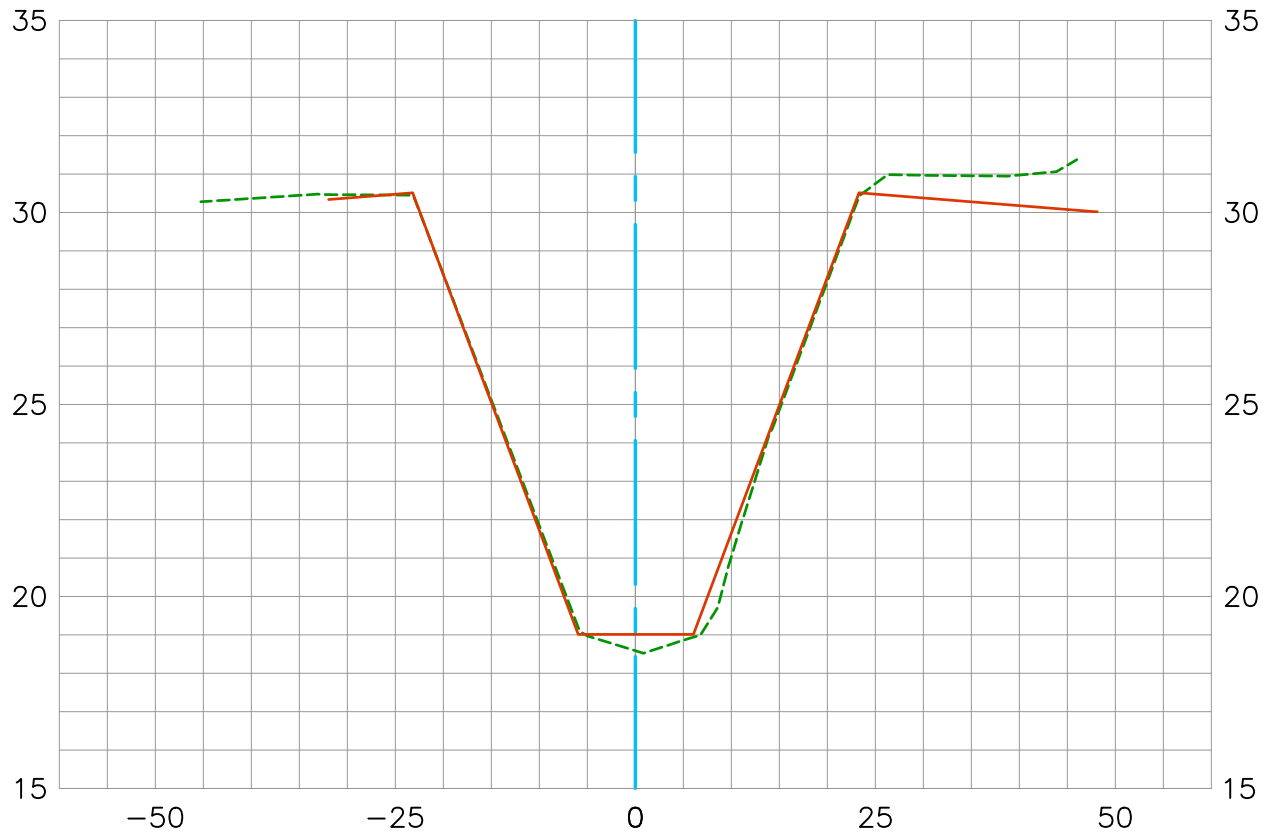

Existing Condition 2019 ---
Record As-Built Plan (1959) ---
Construction Centerline ---

Horizontal Scale 1"=20'
Vertical Scale 1"=5'


DATE PREPARED: 11/12/2019

U.S. *Survey
Foot*

OC Public Works/Engineering Services
OC Survey/Field Services
Boundary Analysis & Mapping

BOLSA CHICA CHANNEL (C02)

318+00.00
CL

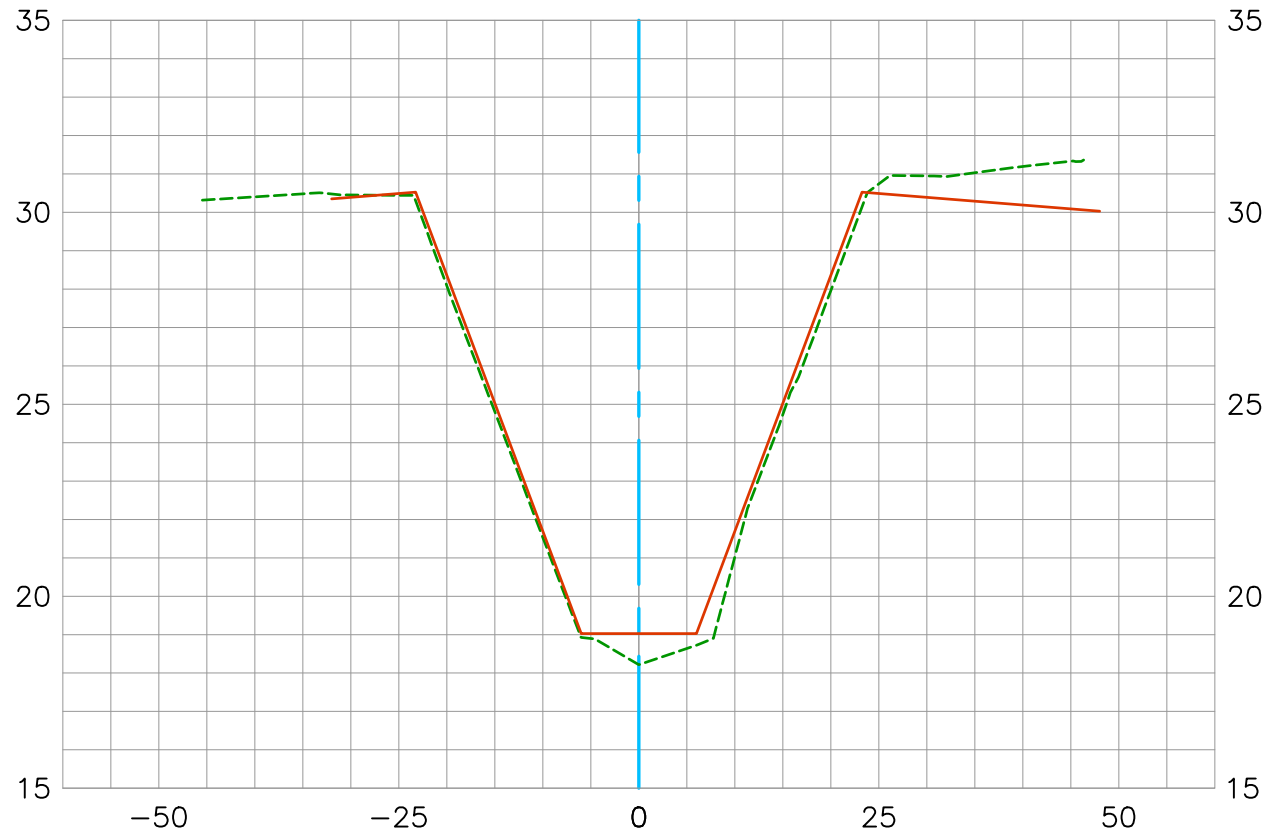

Existing Condition 2019 ---
Record As-Built Plan (1959) ---
Construction Centerline ---

Horizontal Scale 1"=20'
Vertical Scale 1"=5'


DATE PREPARED: 11/12/2019

U.S. Survey Foot

OC Public Works/Engineering Services
OC Survey/Field Services
Boundary Analysis & Mapping

BOLSA CHICA CHANNEL (C02)

318+50.00
CL

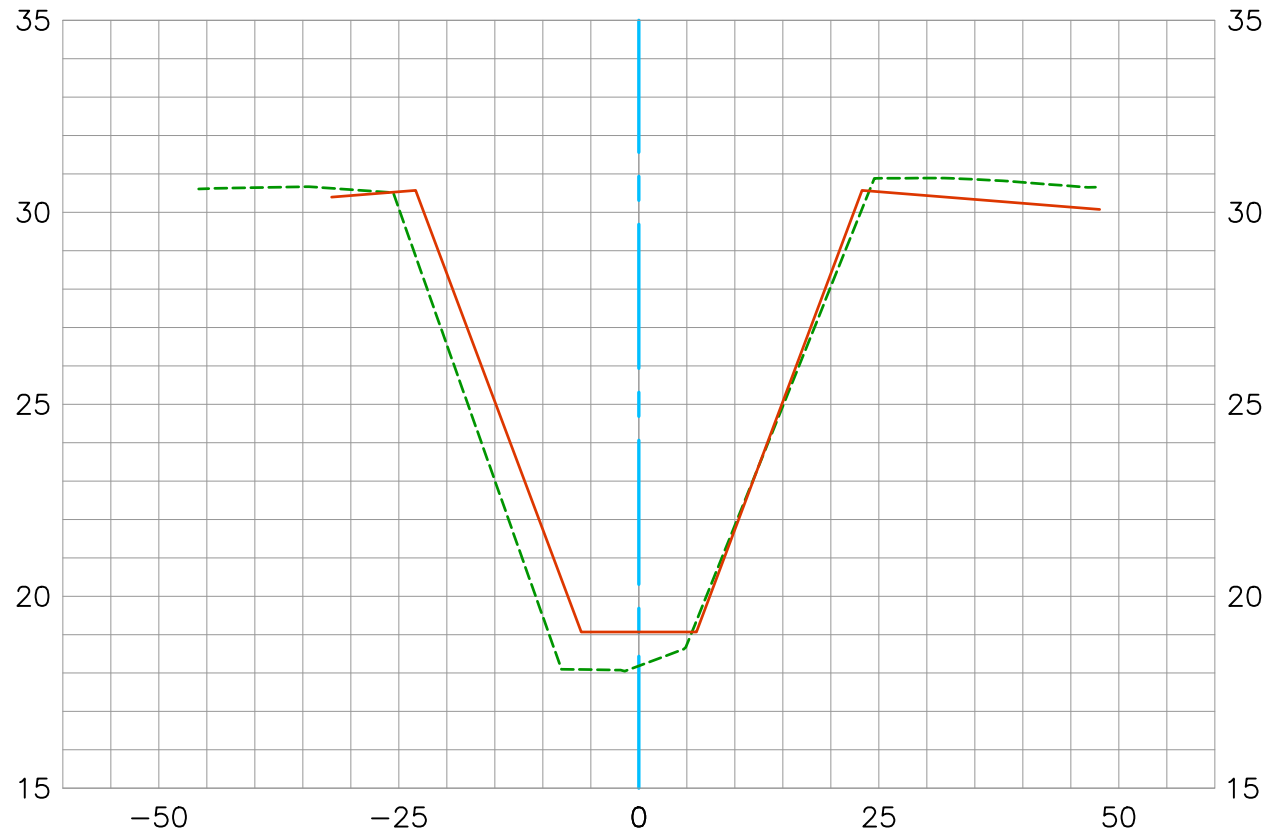

Existing Condition 2019 ---
Record As-Built Plan (1959) ---
Construction Centerline ---

Horizontal Scale 1"=20'
Vertical Scale 1"=5'


DATE PREPARED: 11/12/2019

U.S. Survey Foot

OC Public Works/Engineering Services
OC Survey/Field Services
Boundary Analysis & Mapping

BOLSA CHICA CHANNEL (C02)

319+00.00
CL

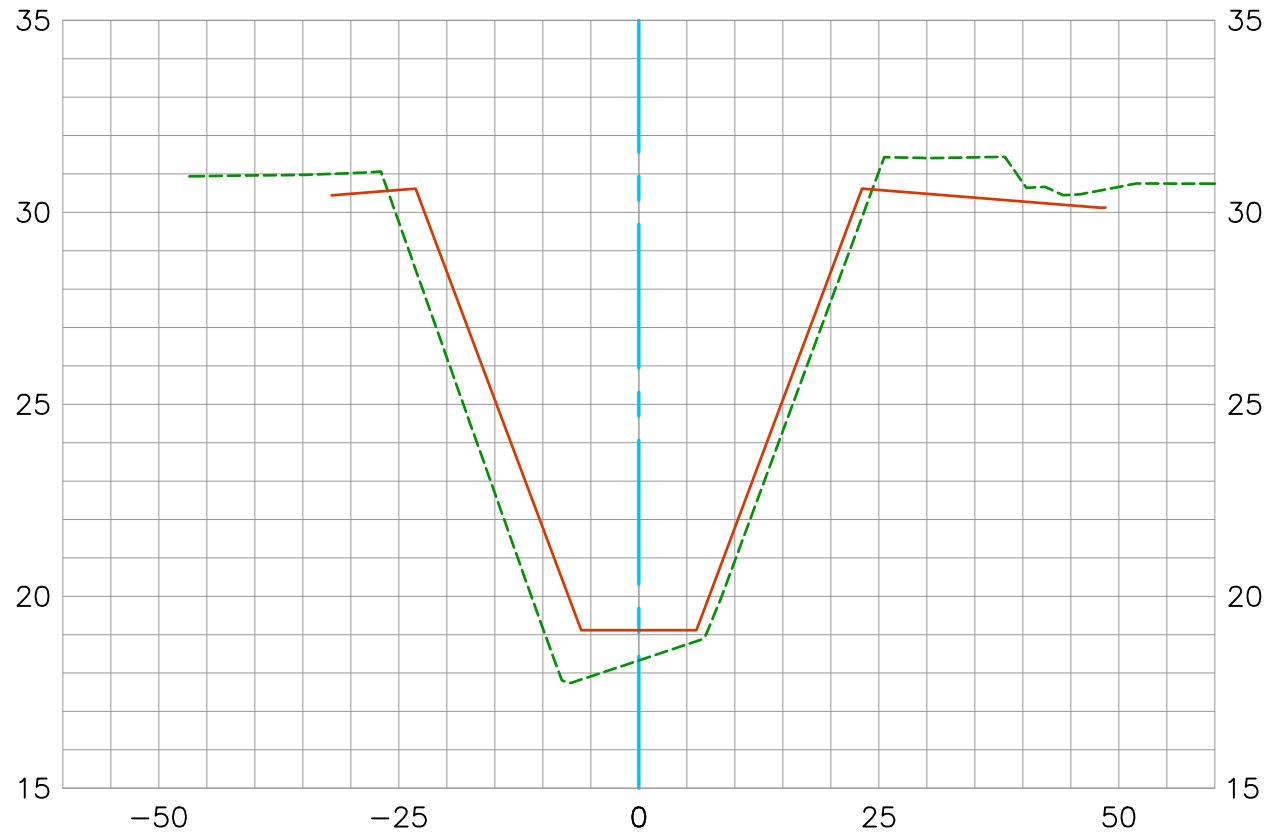

Existing Condition 2019 ---
Record As-Built Plan (1959) ---
Construction Centerline ---


Horizontal Scale 1"=20'
Vertical Scale 1"=5'

DATE PREPARED: 11/12/2019



BOLSA CHICA CHANNEL (C02)

319+50.00
CL

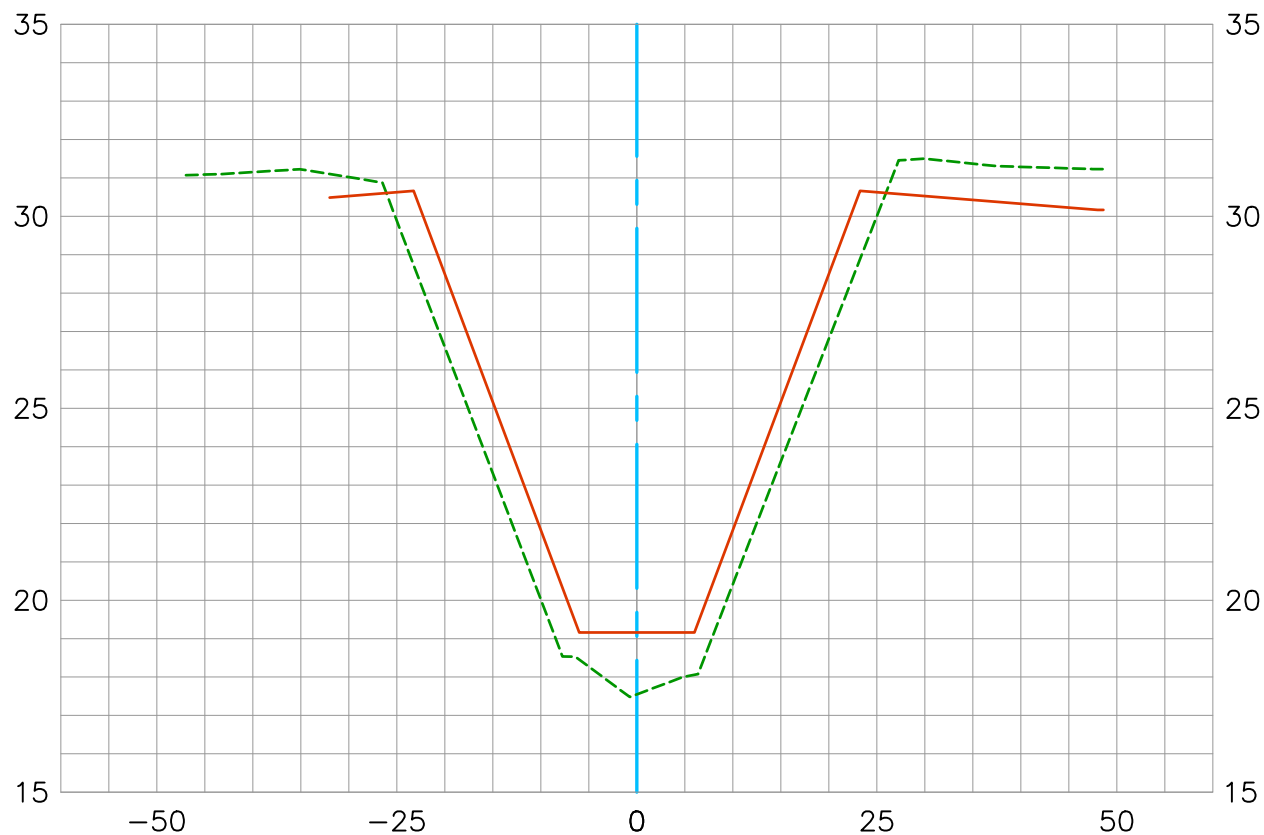

Existing Condition 2019 ---
Record As-Built Plan (1959) ---
Construction Centerline ---

Horizontal Scale 1"=20'
Vertical Scale 1"=5'


DATE PREPARED: 11/12/2019

U.S. Survey Foot

OC Public Works/Engineering Services
OC Survey/Field Services
Boundary Analysis & Mapping

BOLSA CHICA CHANNEL (C02)

320+00.00
CL

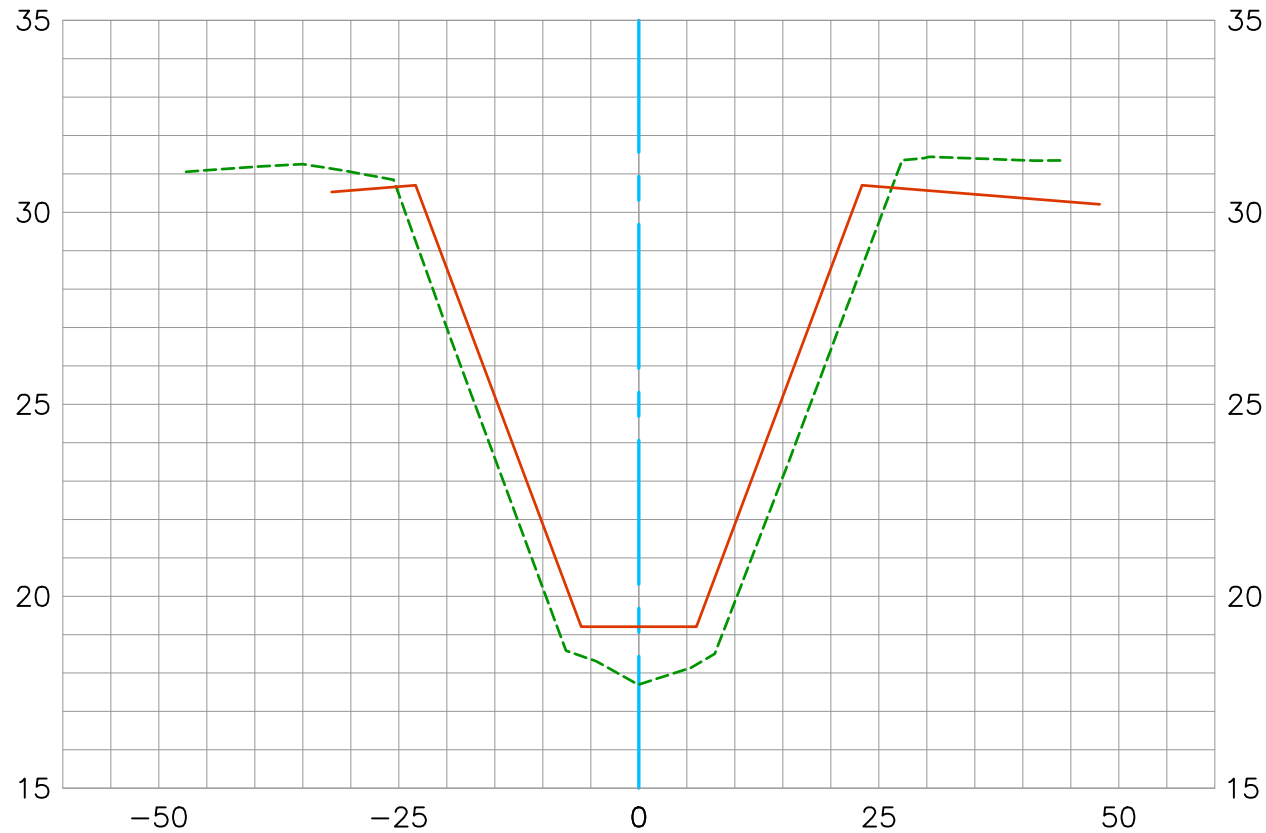

Existing Condition 2019 ---
Record As-Built Plan (1959) ---
Construction Centerline ---

Horizontal Scale 1"=20'
Vertical Scale 1"=5'


DATE PREPARED: 11/12/2019

U.S. *Survey
Foot*

OC Public Works/Engineering Services
OC Survey/Field Services
Boundary Analysis & Mapping

BOLSA CHICA CHANNEL (C02)

320+50.00
CL

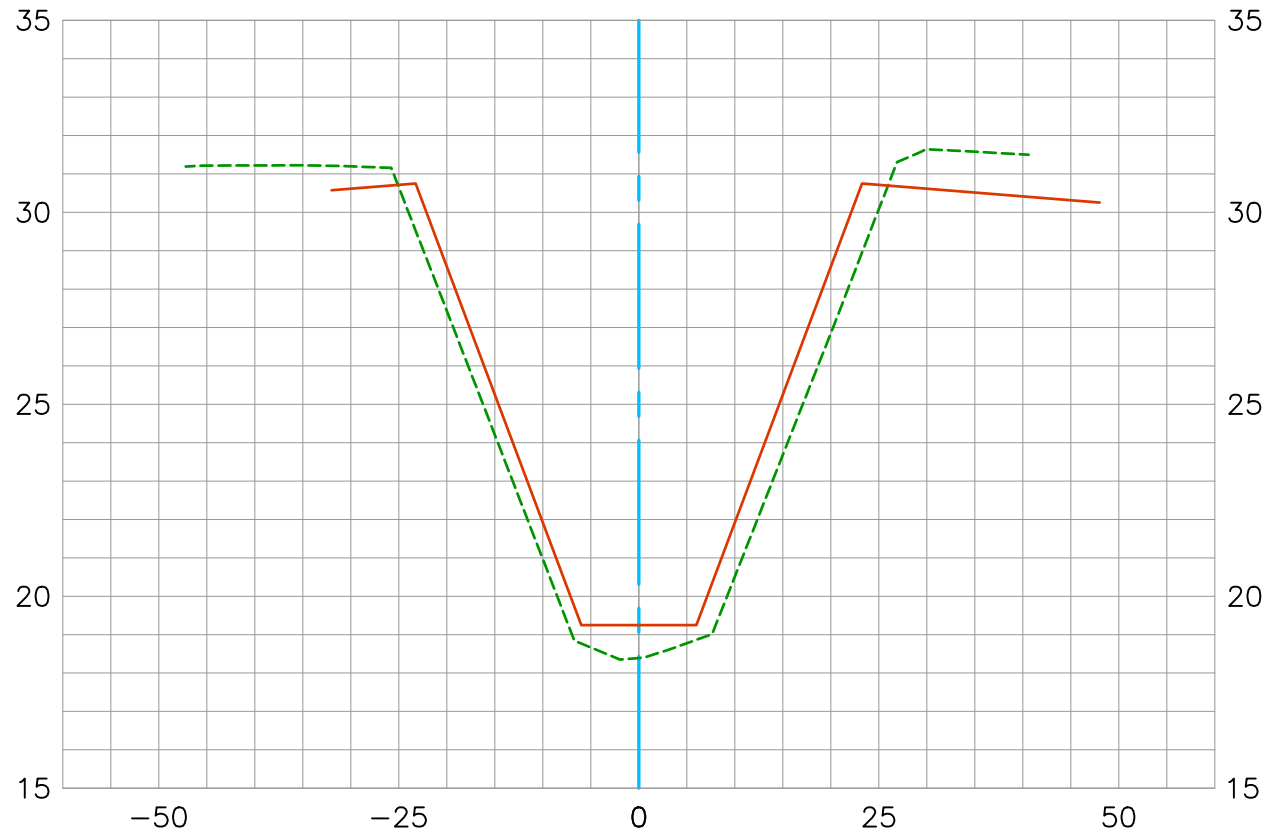

Existing Condition 2019 ---
Record As-Built Plan (1959) ---
Construction Centerline ---

Horizontal Scale 1"=20'
Vertical Scale 1"=5'

DATE PREPARED: 11/12/2019

U.S. Survey Foot


OC Public Works/Engineering Services
OC Survey/Field Services
Boundary Analysis & Mapping



BOLSA CHICA CHANNEL (C02)

321+00.00

CL

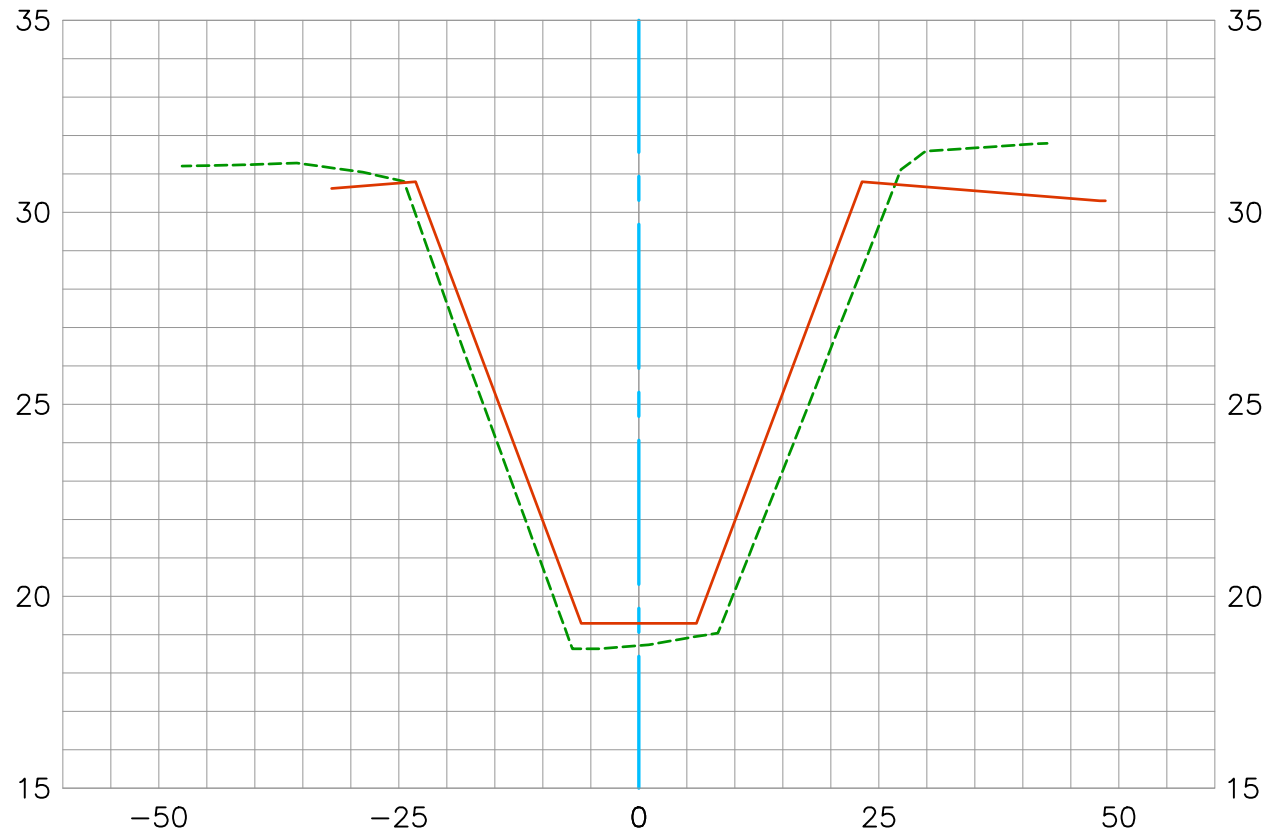

Existing Condition 2019 ---
Record As-Built Plan (1959) ---
Construction Centerline ---

Horizontal Scale 1"=20'
Vertical Scale 1"=5'

DATE PREPARED: 11/12/2019


U.S. Survey Foot

OC Public Works/Engineering Services
OC Survey/Field Services
Boundary Analysis & Mapping

BOLSA CHICA CHANNEL (C02)

321+50.00

CL

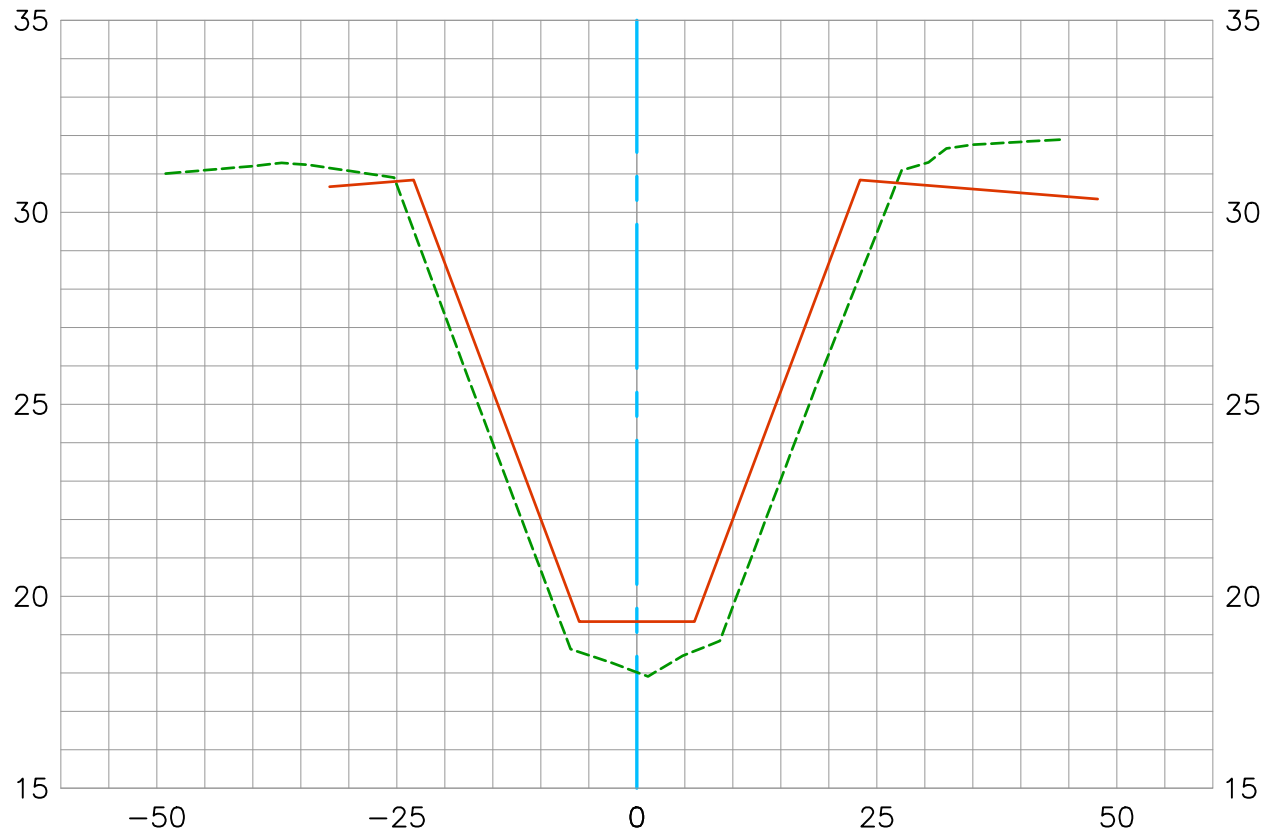

Existing Condition 2019 ---
Record As-Built Plan (1959) ---
Construction Centerline ---


Horizontal Scale 1"=20'
Vertical Scale 1"=5'

DATE PREPARED: 11/12/2019



BOLSA CHICA CHANNEL (C02)

322+00.00
CL

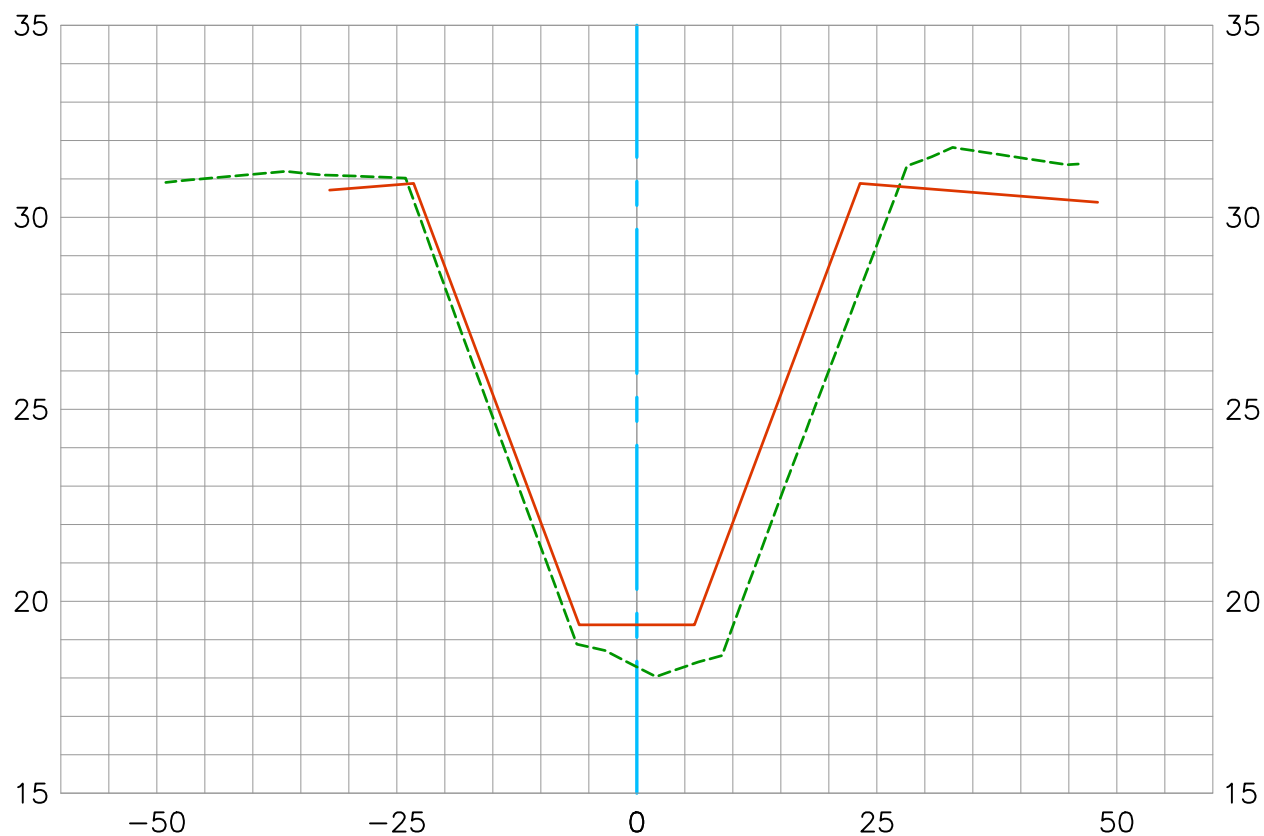

Existing Condition 2019 ---
Record As-Built Plan (1959) ---
Construction Centerline ---

Horizontal Scale 1"=20'
Vertical Scale 1"=5'

DATE PREPARED: 11/12/2019


U.S. *Survey
Foot*

OC Public Works/Engineering Services
OC Survey/Field Services
Boundary Analysis & Mapping

BOLSA CHICA CHANNEL (C02)

322+50.00

CL

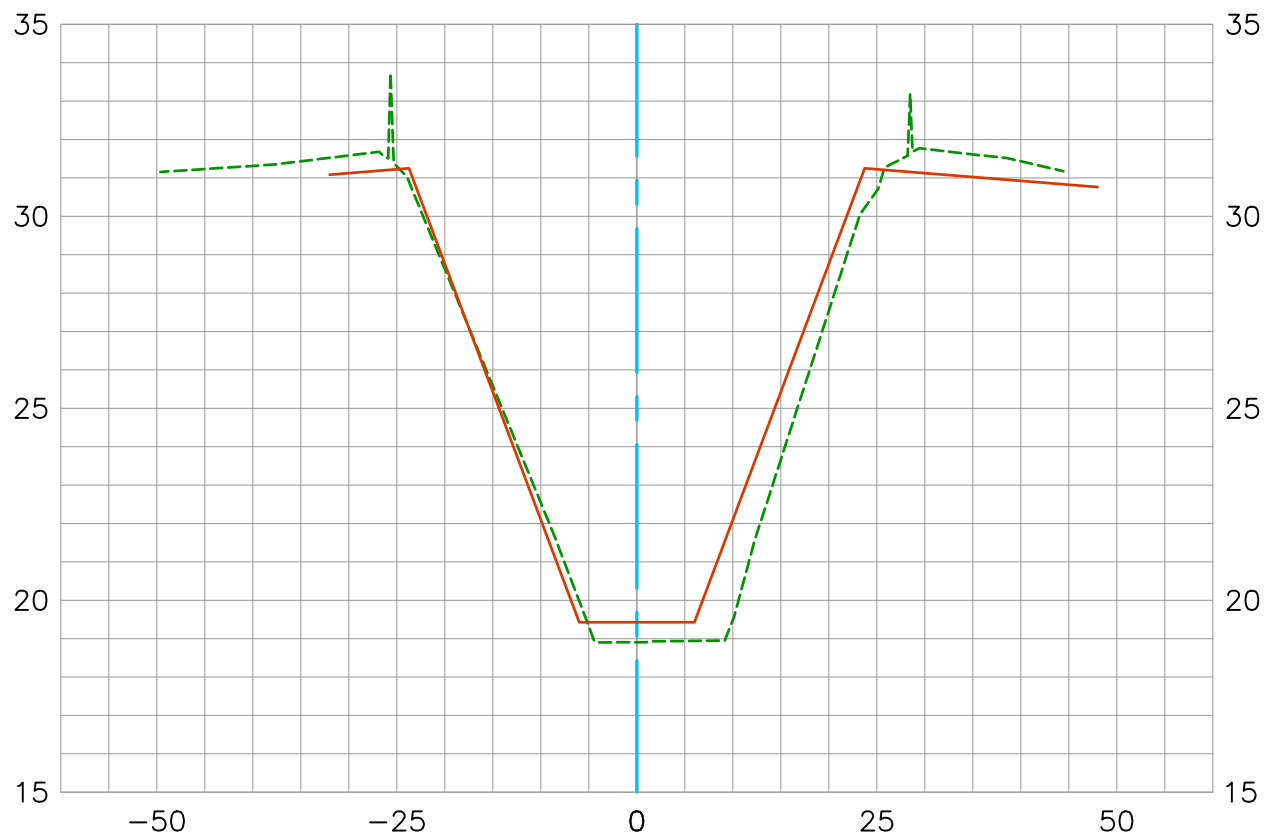

Existing Condition 2019 ---
Record As-Built Plan (1959) ---
Construction Centerline ---

Horizontal Scale 1"=20'
Vertical Scale 1"=5'

DATE PREPARED: 11/12/2019


U.S. Survey Foot

OC Public Works/Engineering Services
OC Survey/Field Services
Boundary Analysis & Mapping



BOLSA CHICA CHANNEL (C02)

323+00.00
CL

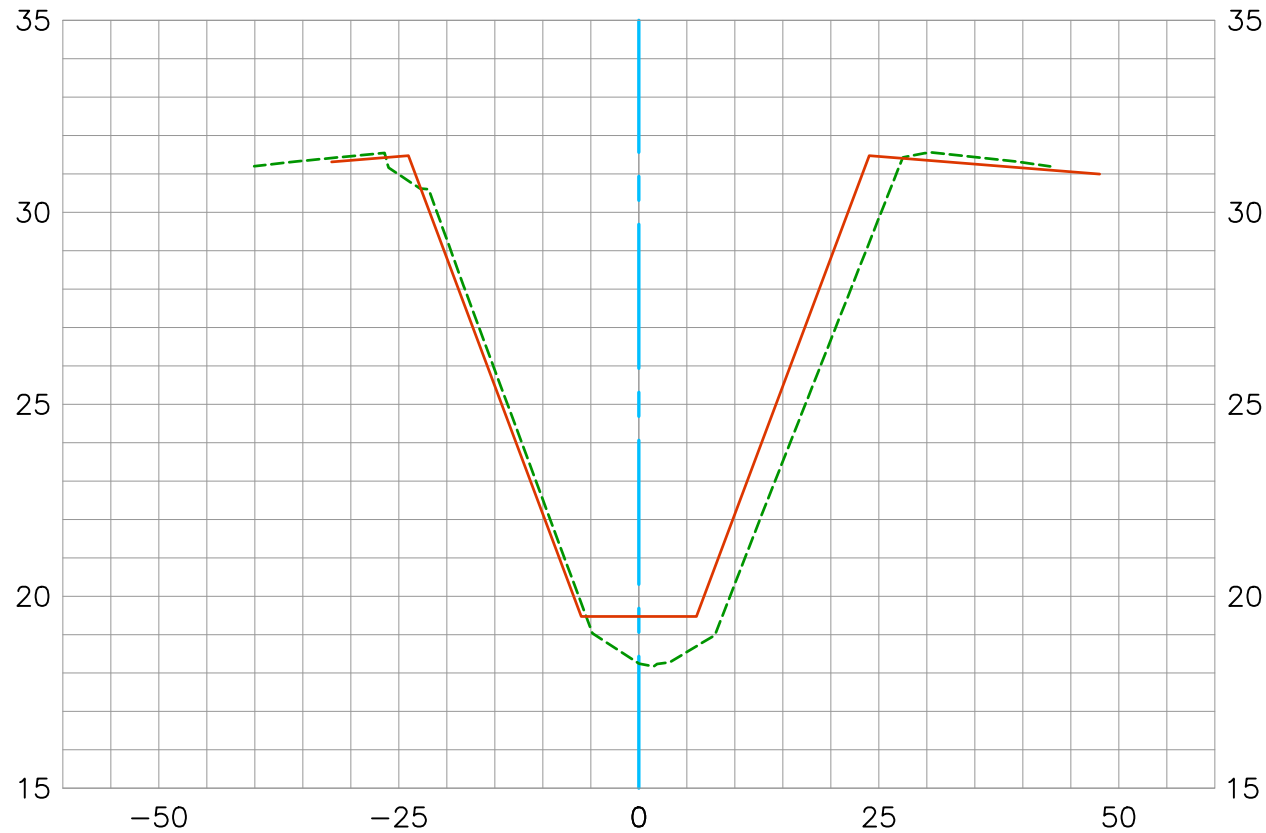

Existing Condition 2019 ---
Record As-Built Plan (1959) ---
Construction Centerline ---

Horizontal Scale 1"=20'
Vertical Scale 1"=5'

DATE PREPARED: 11/12/2019


U.S. Survey Foot

OC Public Works/Engineering Services
OC Survey/Field Services
Boundary Analysis & Mapping



BOLSA CHICA CHANNEL (C02)

323+50.00
CL

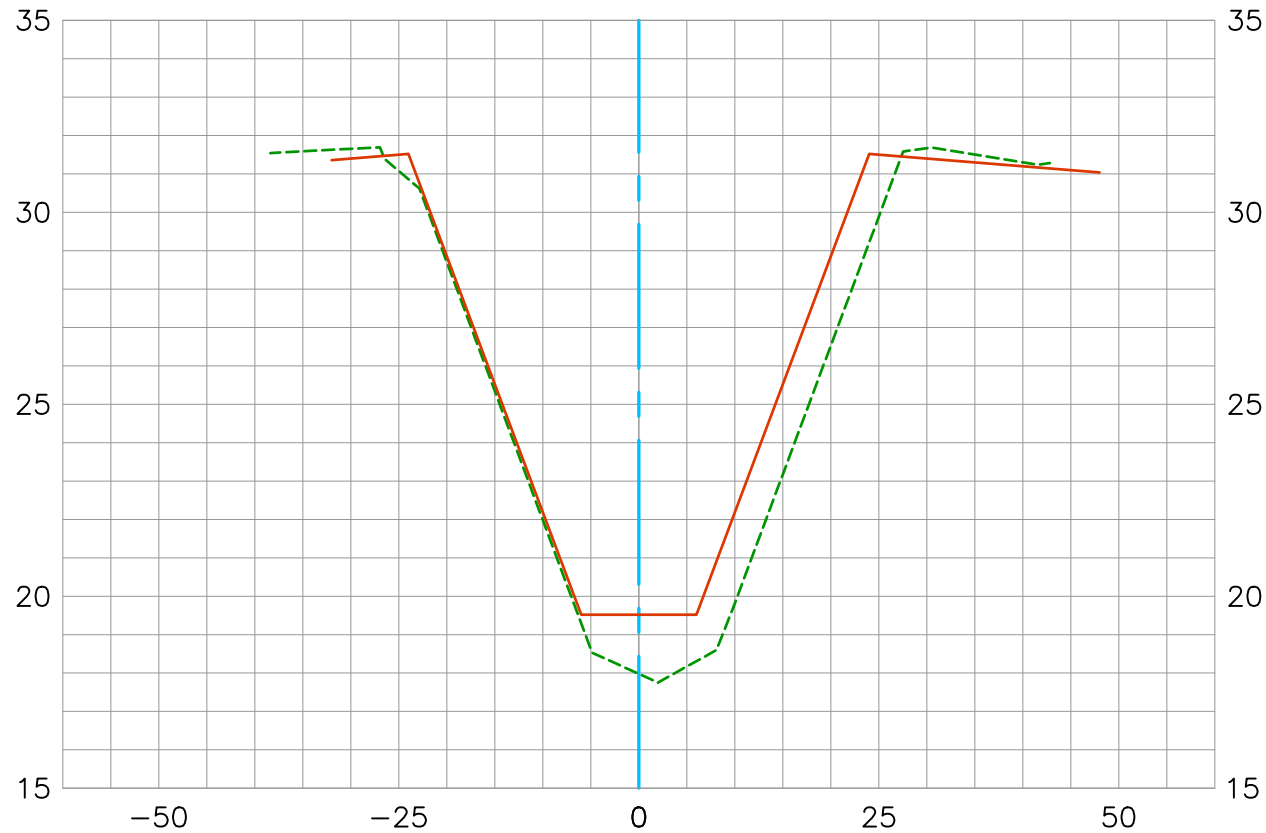

Existing Condition 2019 ---
Record As-Built Plan (1959) ---
Construction Centerline ---

Horizontal Scale 1"=20'
Vertical Scale 1"=5'

DATE PREPARED: 11/12/2019


U.S. Survey Foot

OC Public Works/Engineering Services
OC Survey/Field Services
Boundary Analysis & Mapping



BOLSA CHICA CHANNEL (C02)

324+00.00
CL

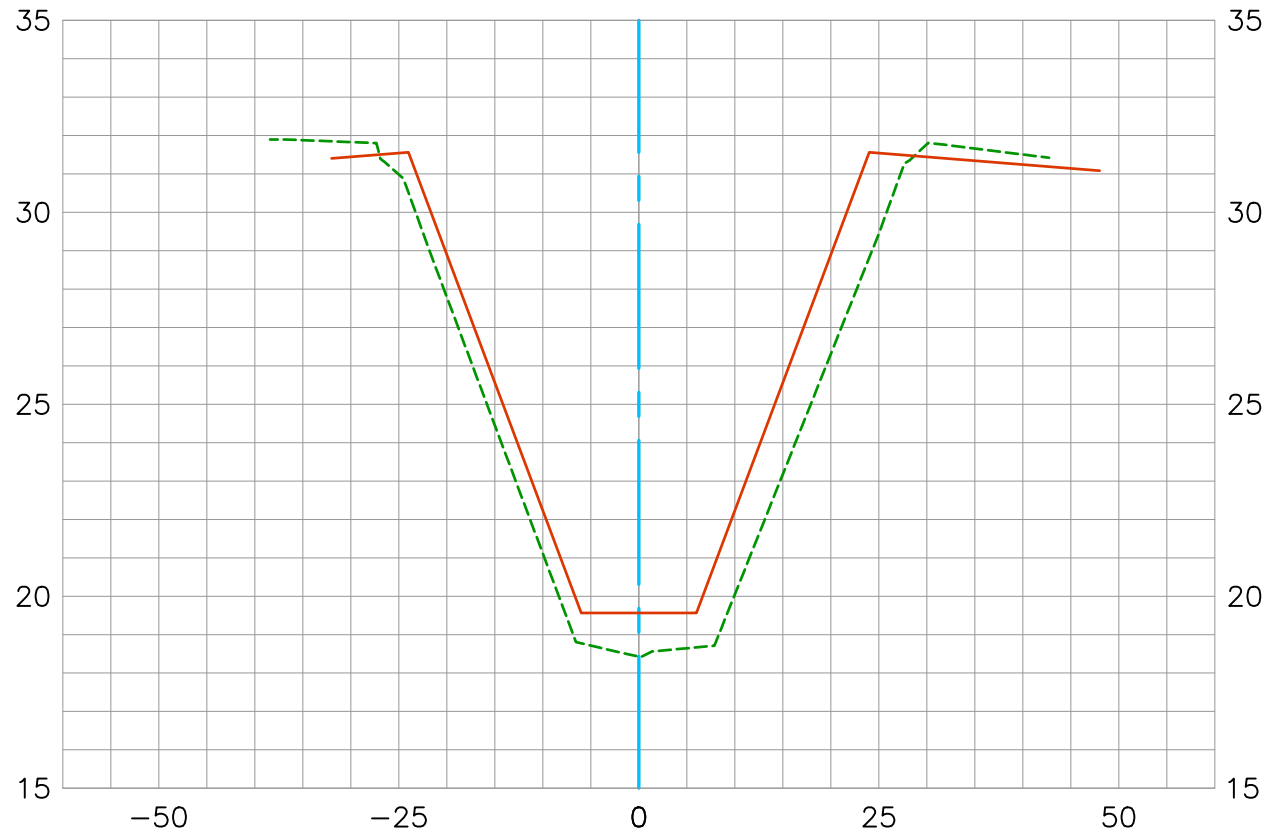

Existing Condition 2019 ---
Record As-Built Plan (1959) ---
Construction Centerline ---

Horizontal Scale 1"=20'
Vertical Scale 1"=5'

DATE PREPARED: 11/12/2019


U.S. Survey Foot

OC Public Works/Engineering Services
OC Survey/Field Services
Boundary Analysis & Mapping



BOLSA CHICA CHANNEL (C02)

324+50.00
CL

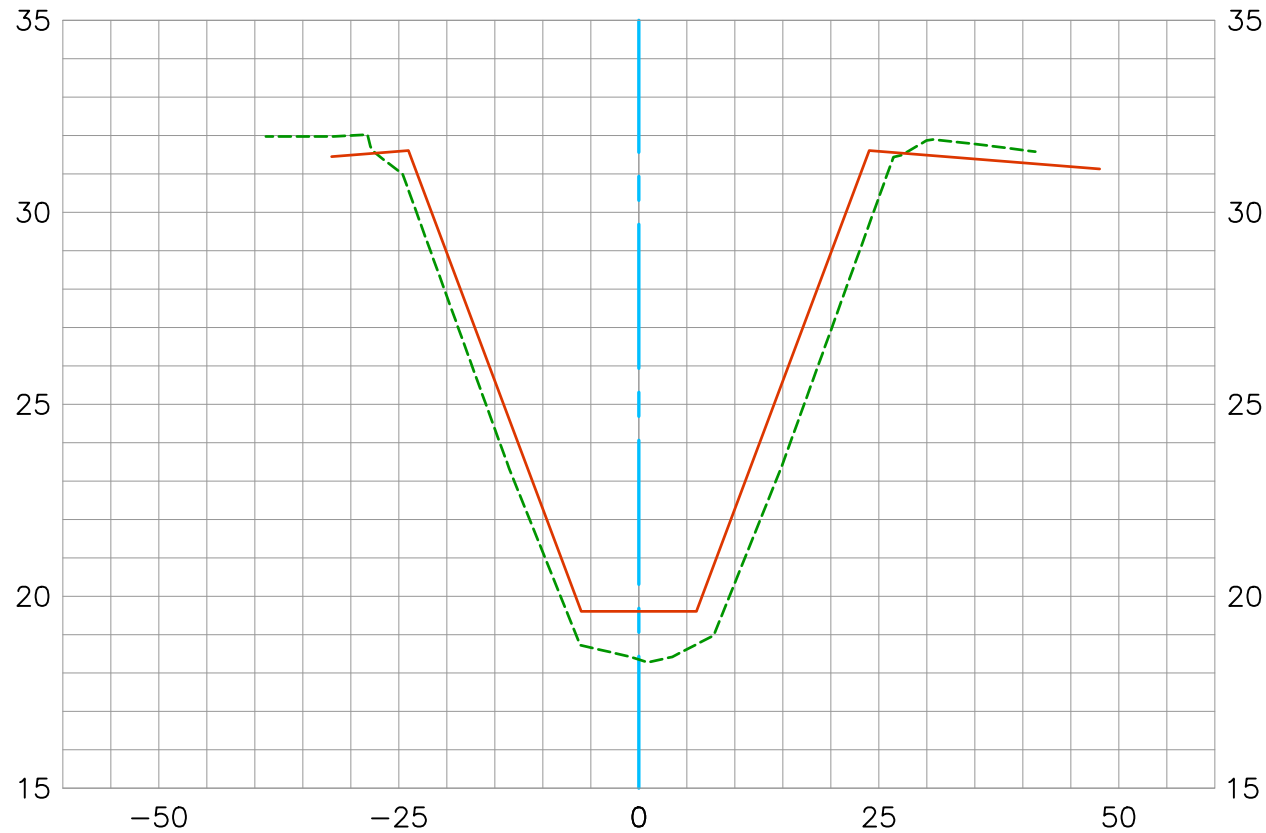

Existing Condition 2019 ---
Record As-Built Plan (1959) ---
Construction Centerline ---

Horizontal Scale 1"=20'
Vertical Scale 1"=5'

DATE PREPARED: 11/12/2019

U.S. Survey Foot


OC Public Works/Engineering Services
OC Survey/Field Services
Boundary Analysis & Mapping



BOLSA CHICA CHANNEL (C02)

325+00.00

CL

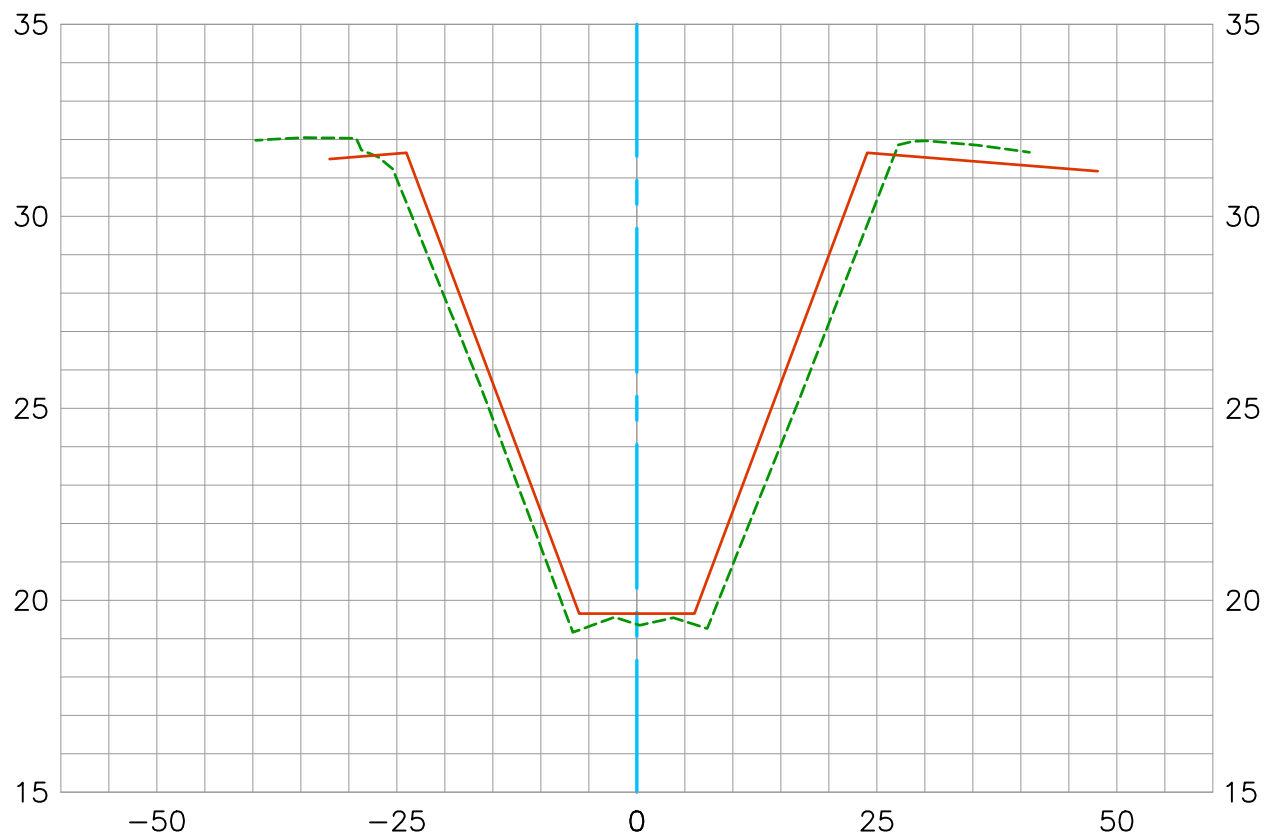

Existing Condition 2019 ---
Record As-Built Plan (1959) ---
Construction Centerline ---

Horizontal Scale 1"=20'
Vertical Scale 1"=5'

DATE PREPARED: 11/12/2019


U.S. Survey Foot

OC Public Works/Engineering Services
OC Survey/Field Services
Boundary Analysis & Mapping



BOLSA CHICA CHANNEL (C02)

326+00.00
CL

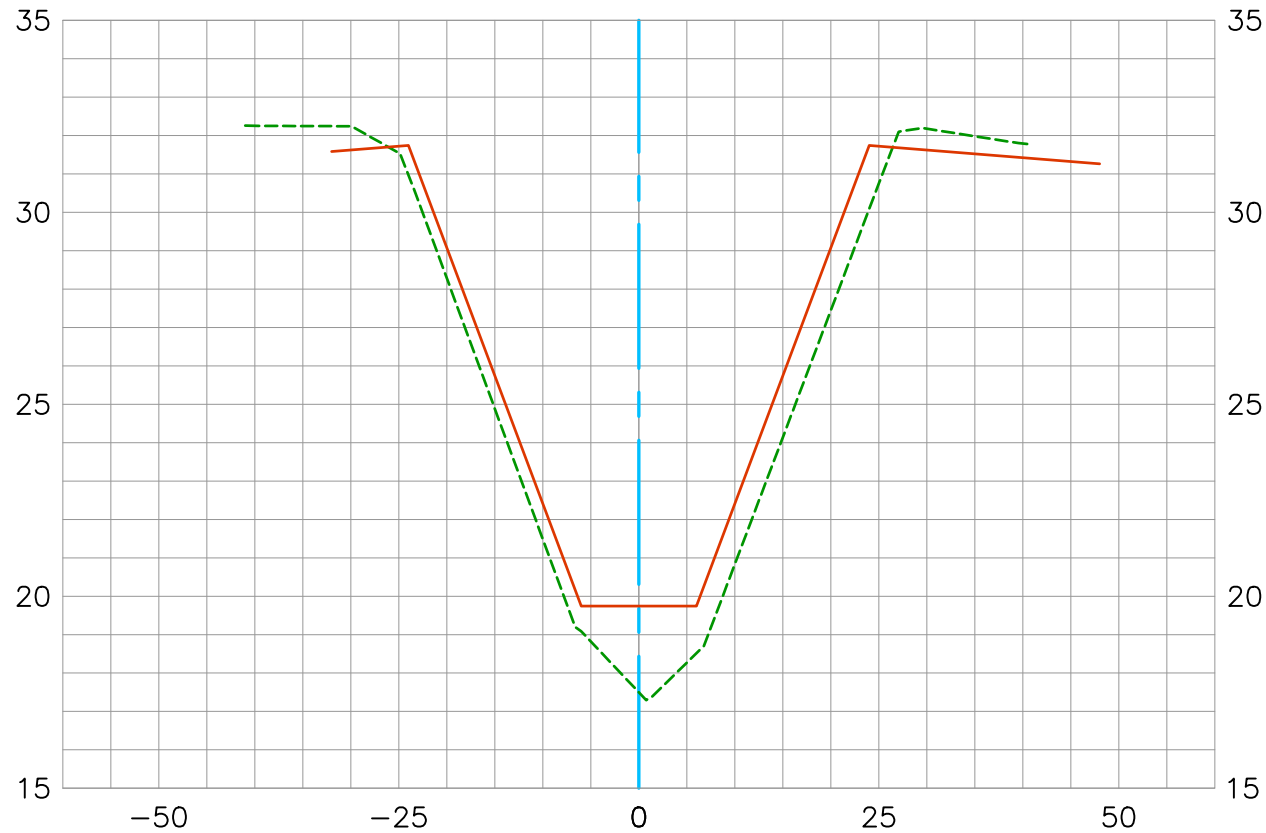

Existing Condition 2019 ---
Record As-Built Plan (1959) ---
Construction Centerline ---

Horizontal Scale 1"=20'
Vertical Scale 1"=5'

DATE PREPARED: 11/12/2019

U.S. Survey Foot


OC Public Works/Engineering Services
OC Survey/Field Services
Boundary Analysis & Mapping



BOLSA CHICA CHANNEL (C02)

326+50.00

CL

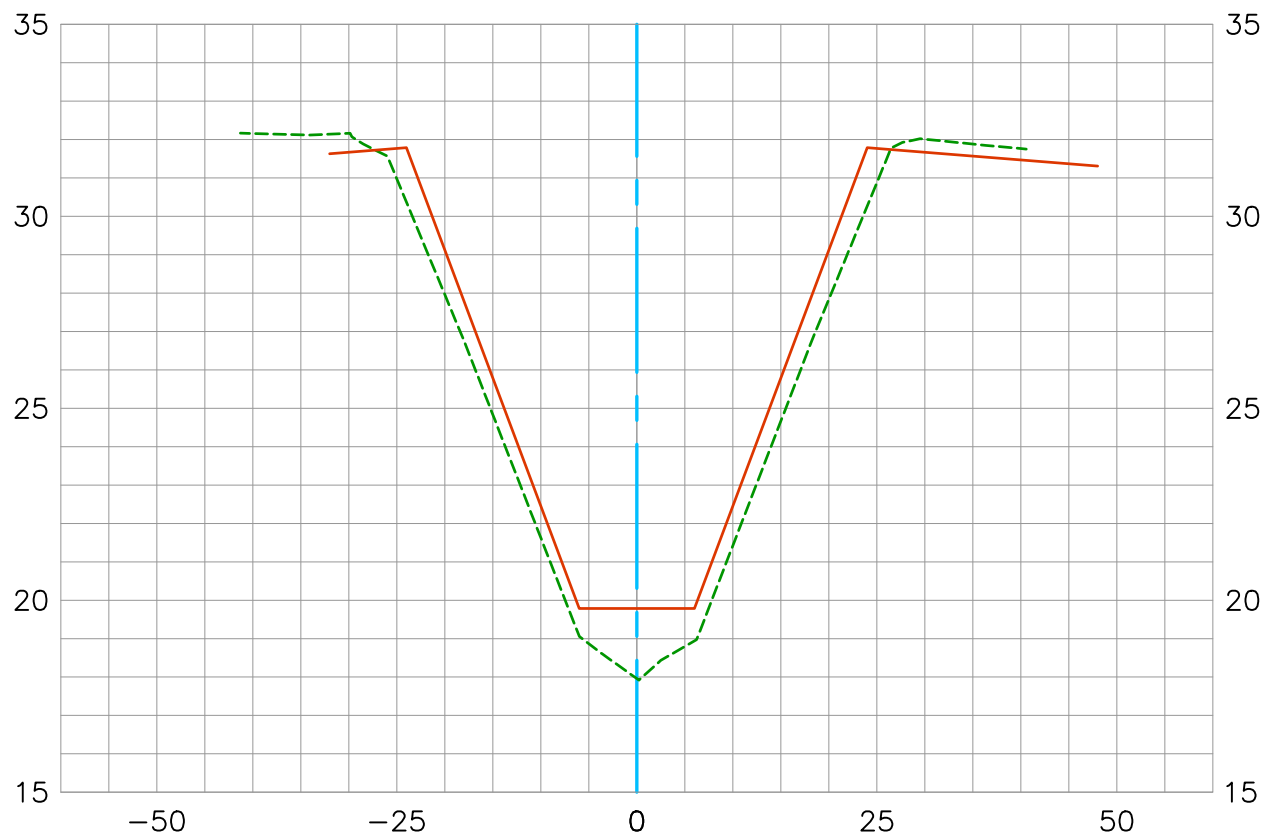

Existing Condition 2019 ---
Record As-Built Plan (1959) ---
Construction Centerline ---

Horizontal Scale 1"=20'
Vertical Scale 1"=5'

DATE PREPARED: 11/12/2019


U.S. Survey Foot

OC Public Works/Engineering Services
OC Survey/Field Services
Boundary Analysis & Mapping

BOLSA CHICA CHANNEL (C02)

327+00.00

CL

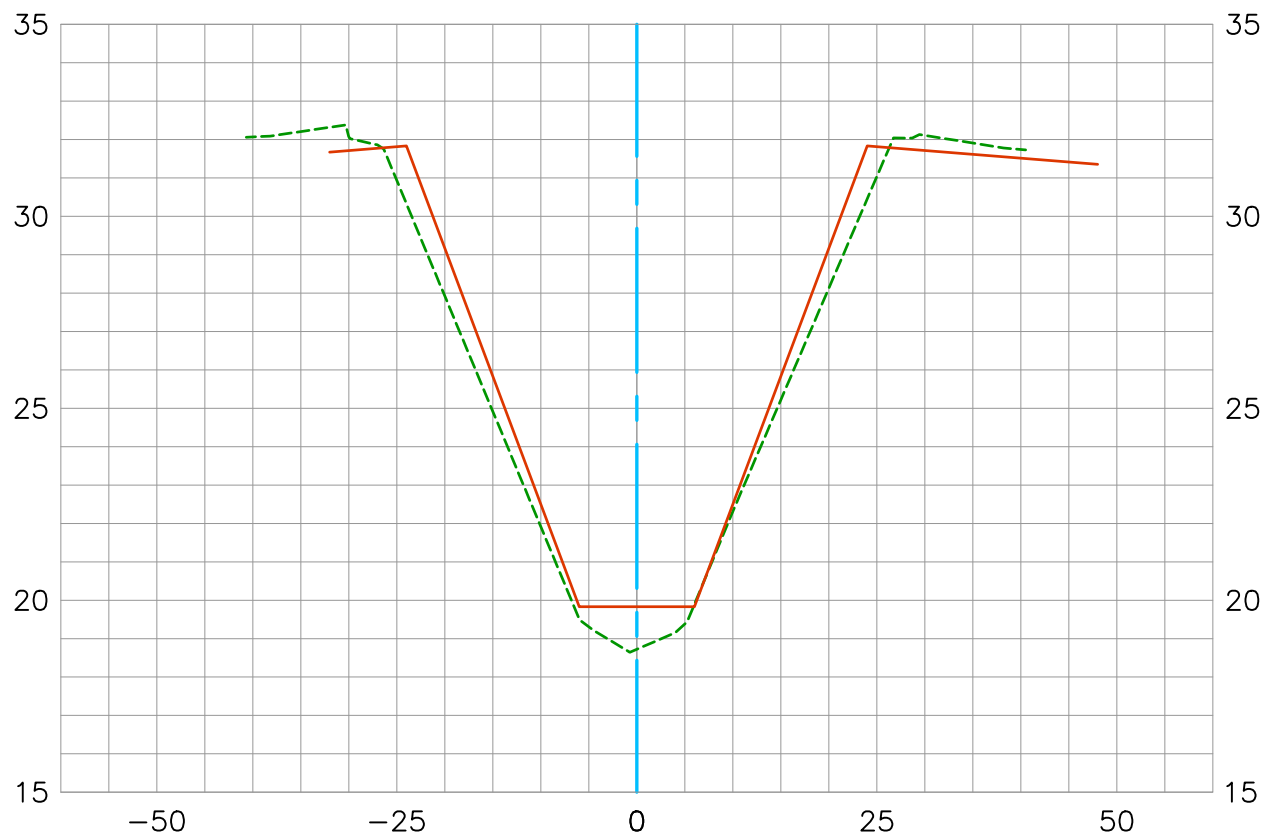

Existing Condition 2019 ---
Record As-Built Plan (1959) ---
Construction Centerline ---

Horizontal Scale 1"=20'
Vertical Scale 1"=5'

DATE PREPARED: 11/12/2019

U.S. Survey Foot


OC Public Works/Engineering Services
OC Survey/Field Services
Boundary Analysis & Mapping



BOLSA CHICA CHANNEL (C02)

327+50.00

CL

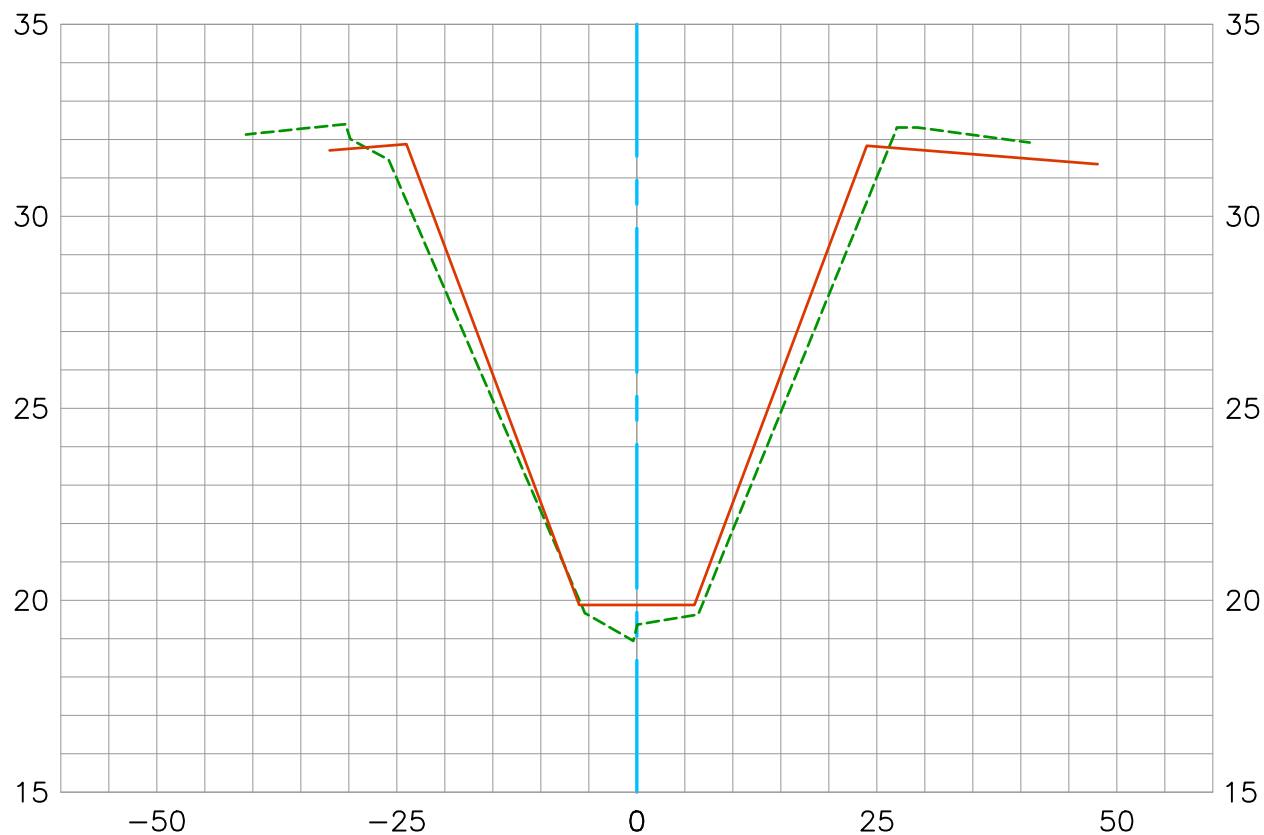

Existing Condition 2019 ---
Record As-Built Plan (1959) ---
Construction Centerline ---


Horizontal Scale 1"=20'
Vertical Scale 1"=5'

DATE PREPARED: 11/12/2019



BOLSA CHICA CHANNEL (C02)

328+00.00
CL

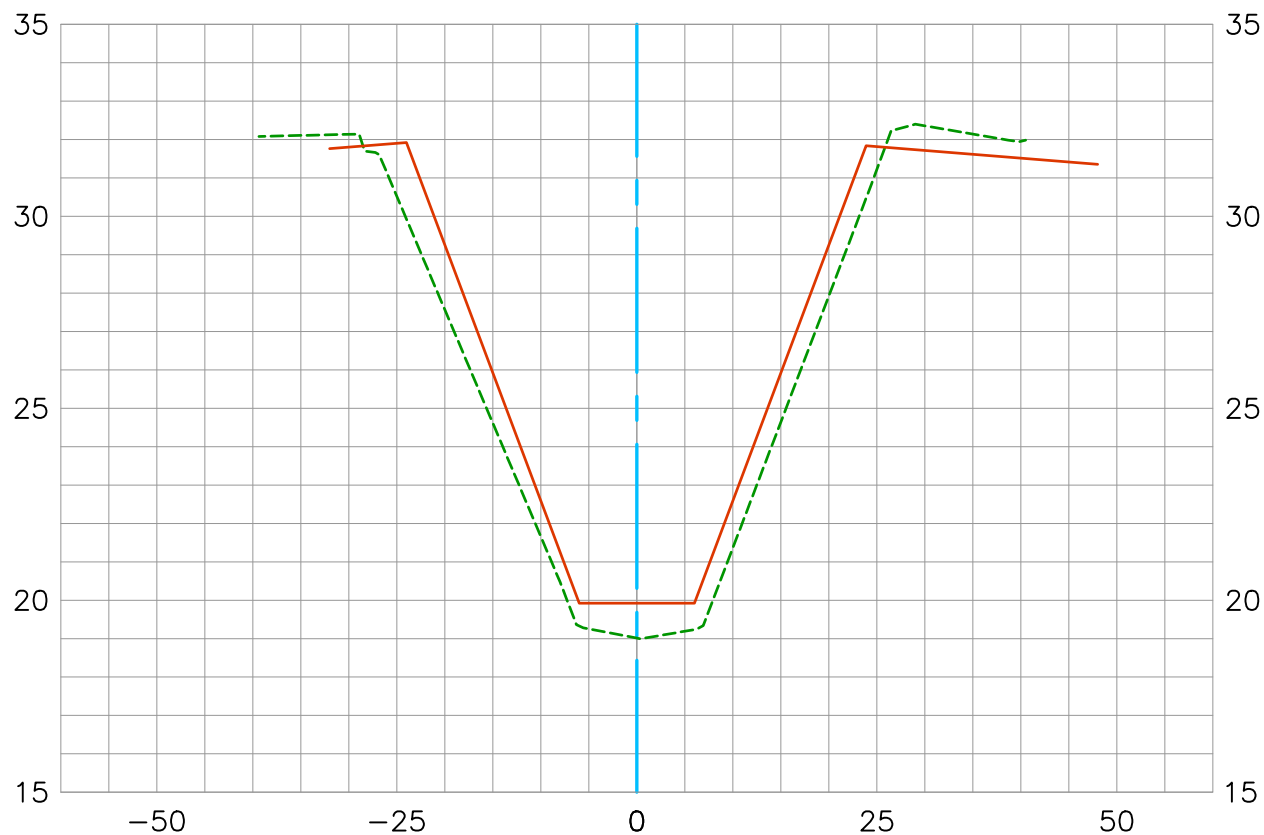

Existing Condition 2019 ---
Record As-Built Plan (1959) ---
Construction Centerline ---


Horizontal Scale 1"=20'
Vertical Scale 1"=5'

DATE PREPARED: 11/12/2019



BOLSA CHICA CHANNEL (C02)

328+50.00
CL

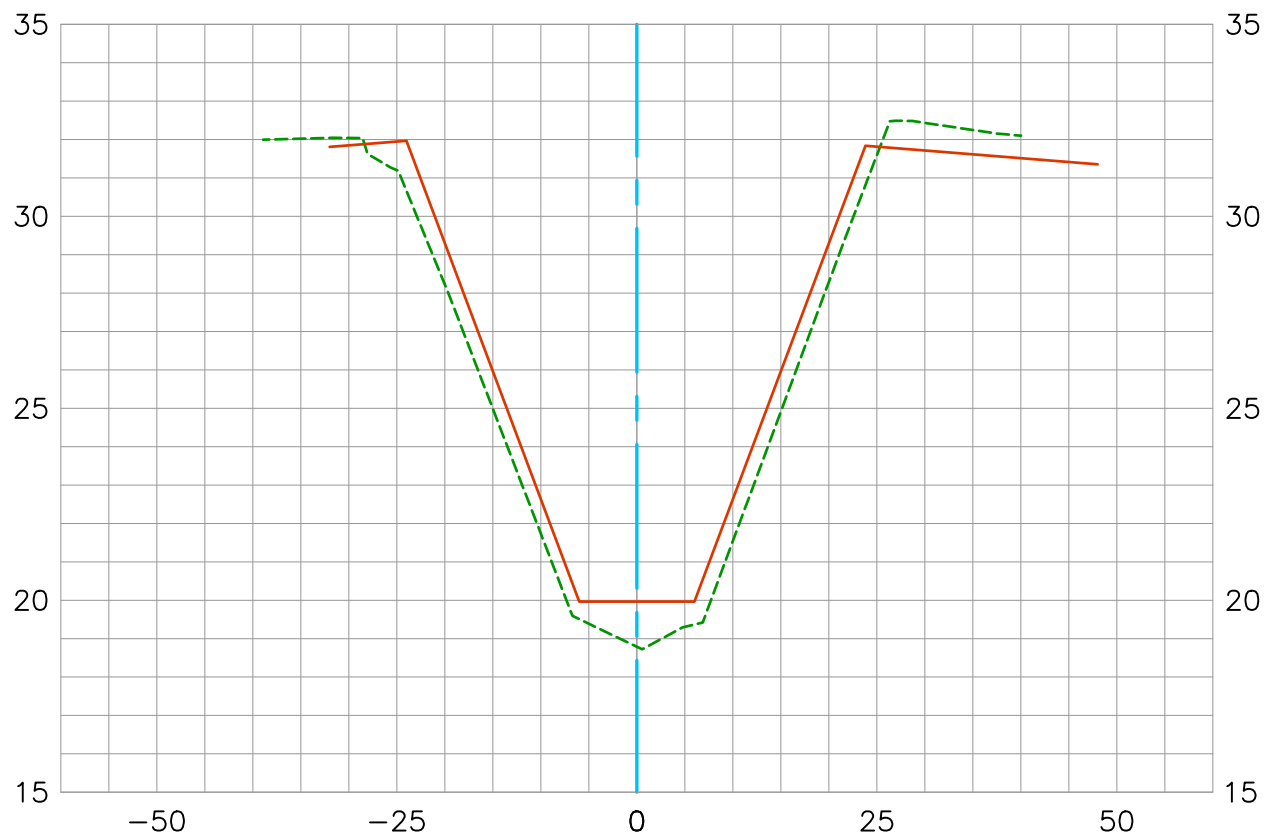

Existing Condition 2019 ---
Record As-Built Plan (1959) ---
Construction Centerline ---

Horizontal Scale 1"=20'
Vertical Scale 1"=5'

DATE PREPARED: 11/12/2019


U.S. Survey Foot

OC Public Works/Engineering Services
OC Survey/Field Services
Boundary Analysis & Mapping



BOLSA CHICA CHANNEL (C02)

329+00.00
CL

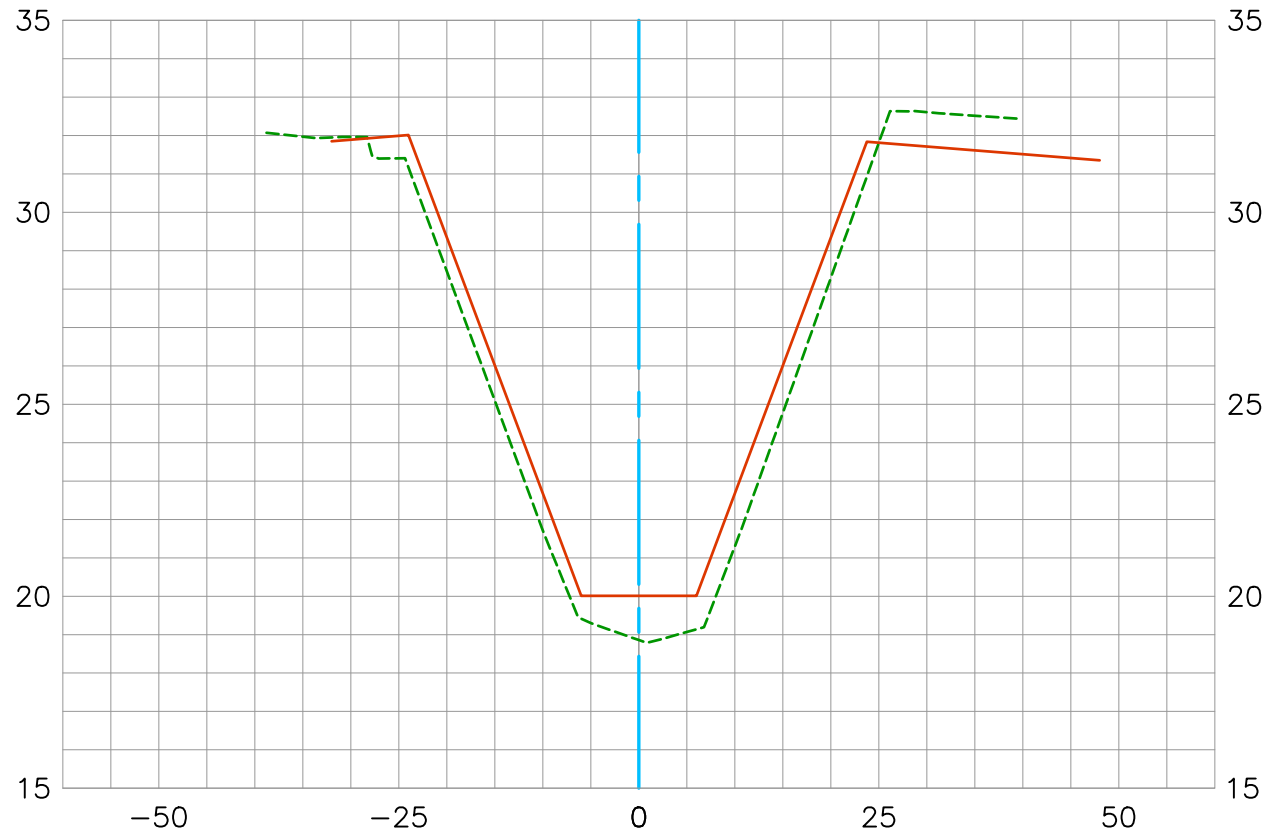

Existing Condition 2019 ---
Record As-Built Plan (1959) ---
Construction Centerline ---


Horizontal Scale 1"=20'
Vertical Scale 1"=5'

DATE PREPARED: 11/12/2019



BOLSA CHICA CHANNEL (C02)

329+50.00
CL

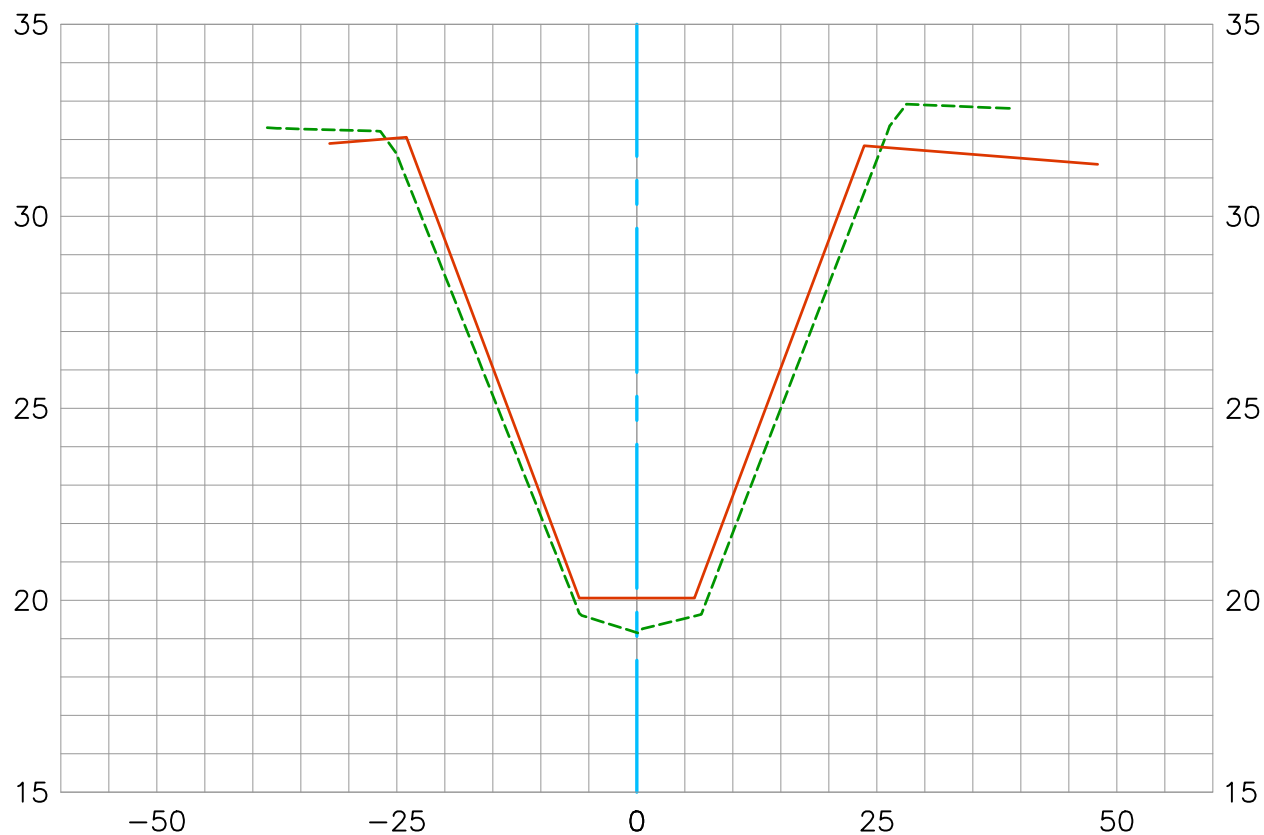

Existing Condition 2019 ---
Record As-Built Plan (1959) ---
Construction Centerline ---


Horizontal Scale 1"=20'
Vertical Scale 1"=5'

DATE PREPARED: 11/12/2019



BOLSA CHICA CHANNEL (C02)

330+00.00
CL

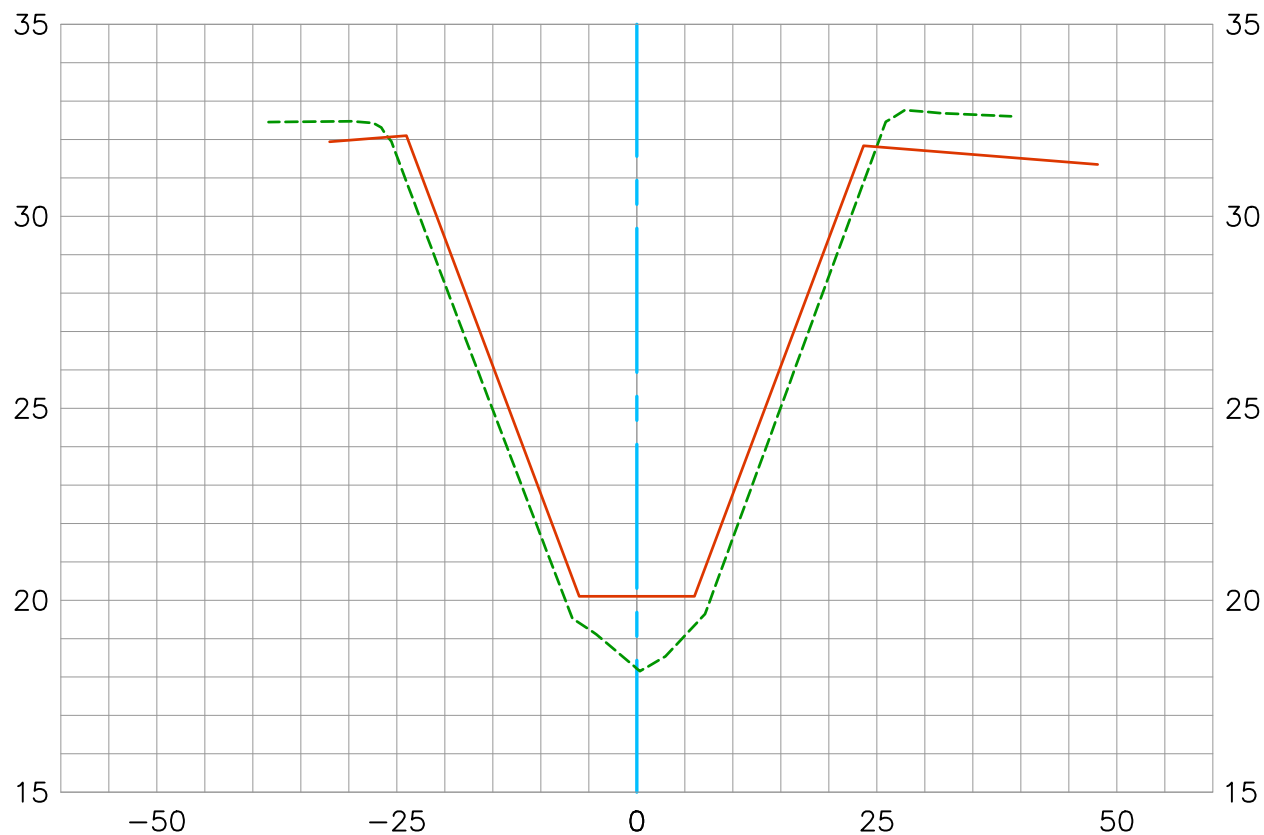

Existing Condition 2019 ---
Record As-Built Plan (1959) ---
Construction Centerline ---

Horizontal Scale 1"=20'
Vertical Scale 1"=5'

DATE PREPARED: 11/12/2019


U.S. Survey Foot

OC Public Works/Engineering Services
OC Survey/Field Services
Boundary Analysis & Mapping



BOLSA CHICA CHANNEL (C02)

330+50.00
CL

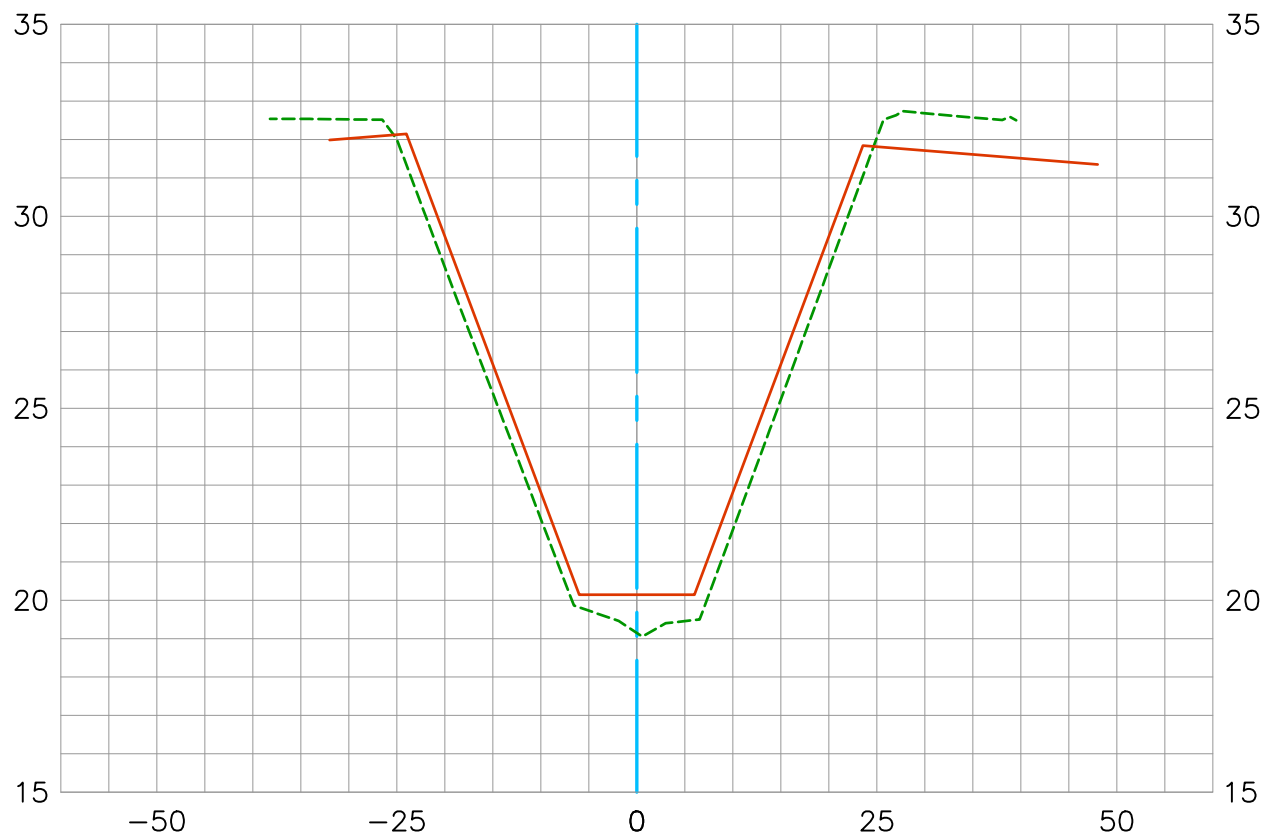

Existing Condition 2019 ---
Record As-Built Plan (1959) ---
Construction Centerline ---

Horizontal Scale 1"=20'
Vertical Scale 1"=5'

DATE PREPARED: 11/12/2019

U.S. Survey Foot


OC Public Works/Engineering Services
OC Survey/Field Services
Boundary Analysis & Mapping



BOLSA CHICA CHANNEL (C02)

331+00.00

CL

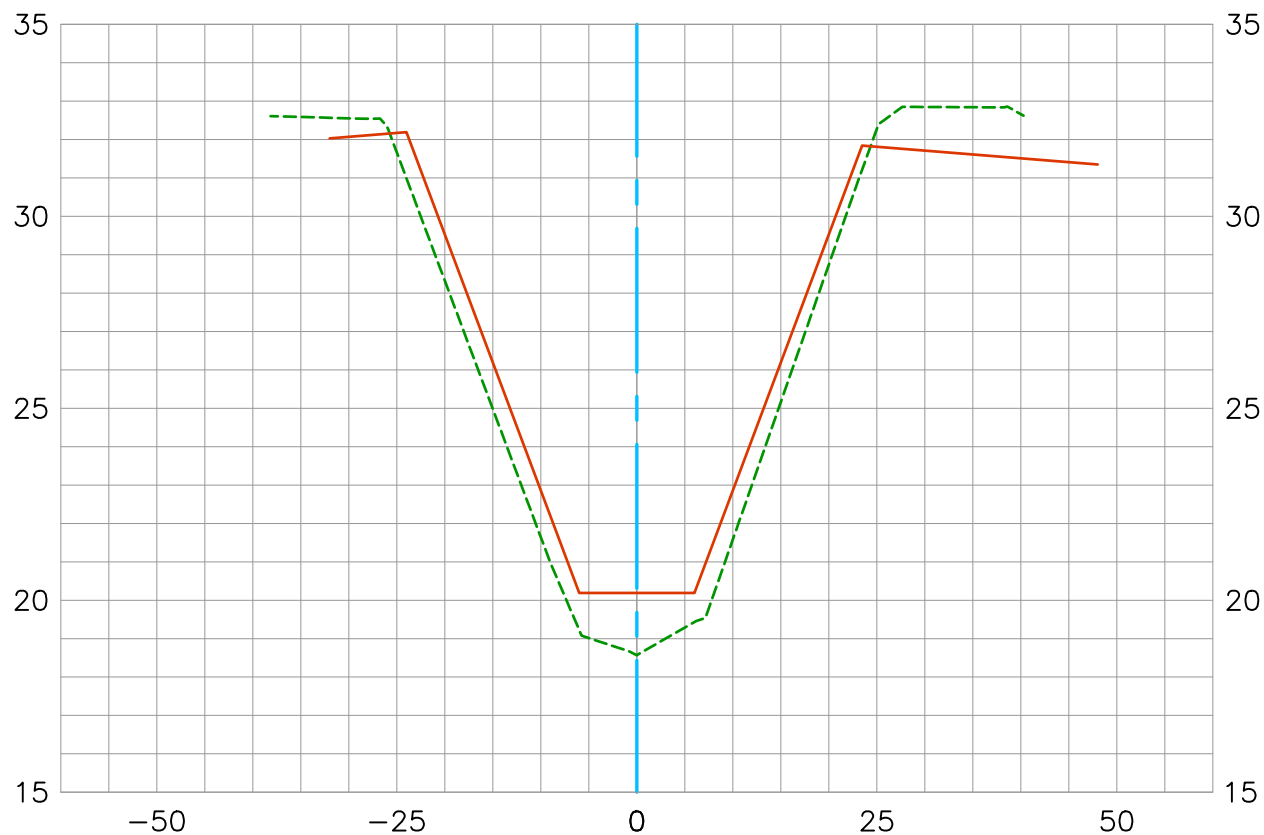

Existing Condition 2019 - - - - -
Record As-Built Plan (1959) _____
Construction Centerline - - - - -

Horizontal Scale 1"=20'
Vertical Scale 1"=5'


DATE PREPARED: 11/12/2019

U.S. Survey Foot

OC Public Works/Engineering Services
OC Survey/Field Services
Boundary Analysis & Mapping

BOLSA CHICA CHANNEL (C02)

331+50.00
CL

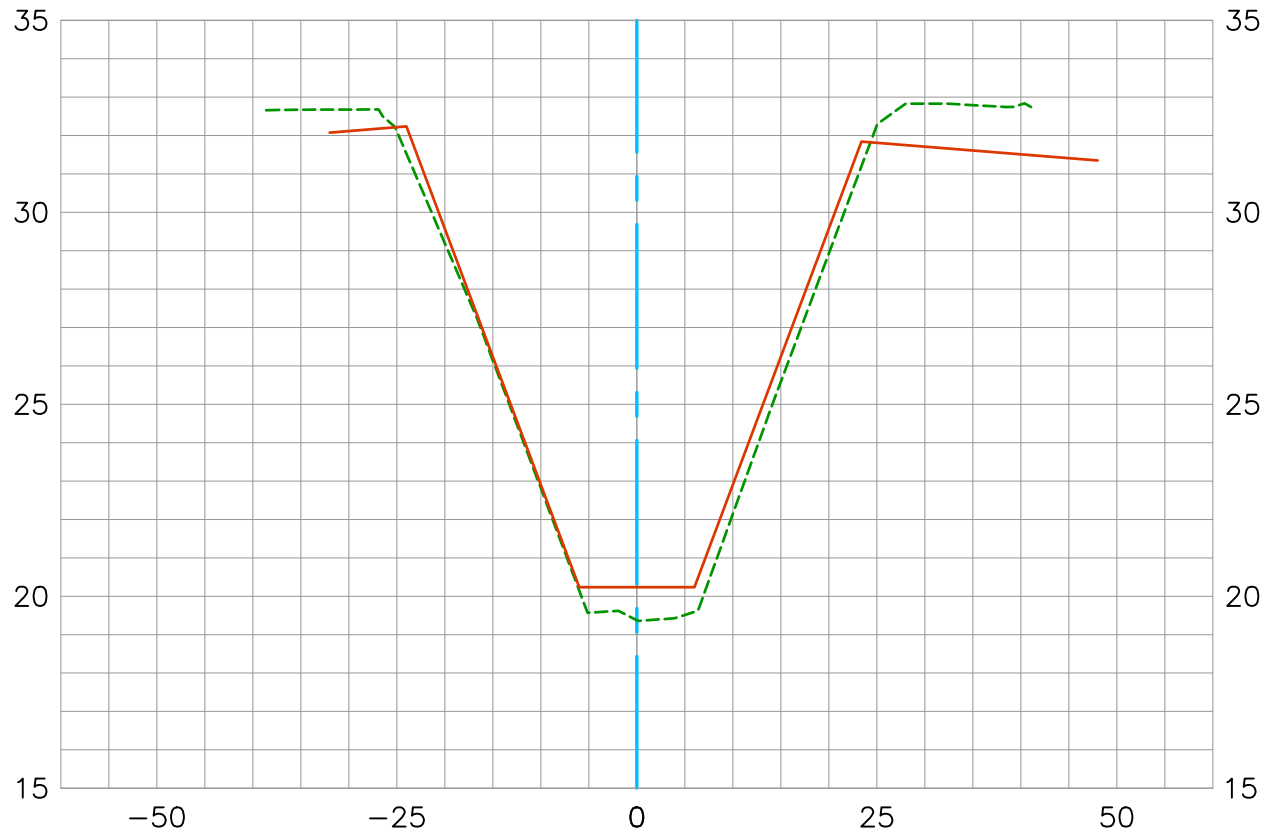

Existing Condition 2019 ---
Record As-Built Plan (1959) ---
Construction Centerline ---

Horizontal Scale 1"=20'
Vertical Scale 1"=5'


DATE PREPARED: 11/12/2019

U.S. Survey Foot

OC Public Works/Engineering Services
OC Survey/Field Services
Boundary Analysis & Mapping

BOLSA CHICA CHANNEL (C02)

332+00.00
CL

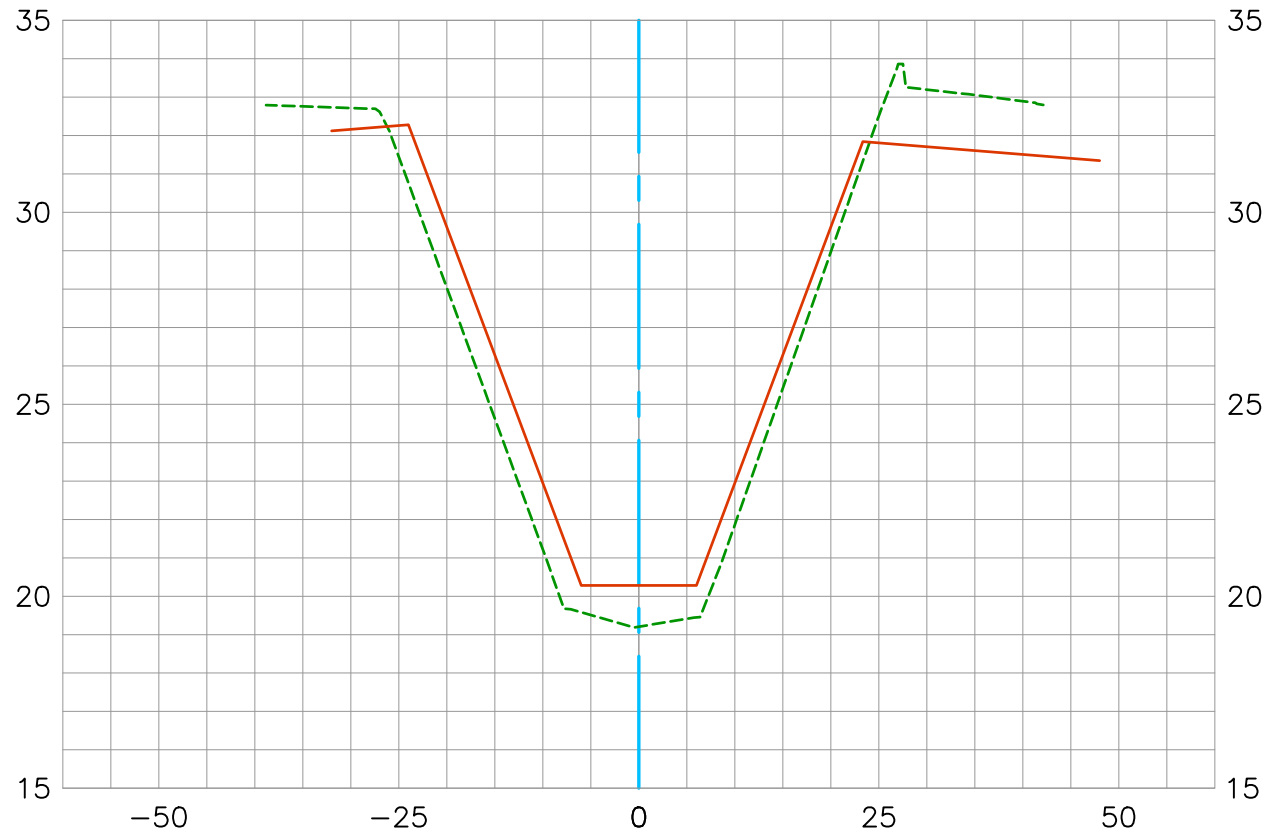

Existing Condition 2019 ---
Record As-Built Plan (1959) ---
Construction Centerline ---

Horizontal Scale 1"=20'
Vertical Scale 1"=5'

DATE PREPARED: 11/12/2019


U.S. Survey Foot

OC Public Works/Engineering Services
OC Survey/Field Services
Boundary Analysis & Mapping



BOLSA CHICA CHANNEL (C02)

332+50.00
CL

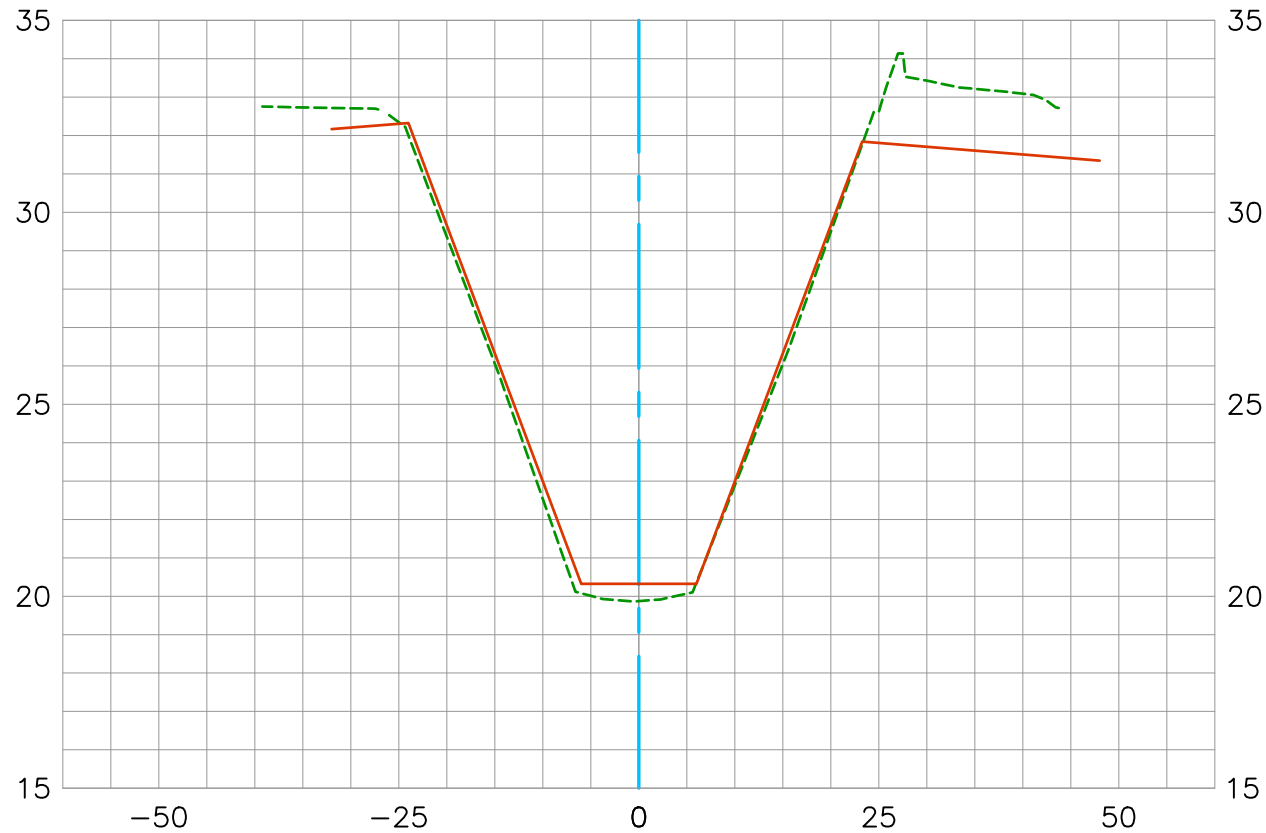

Existing Condition 2019 - - - - -
Record As-Built Plan (1959) - - - - -
Construction Centerline - - - - -


Horizontal Scale 1"=20'
Vertical Scale 1"=5'

DATE PREPARED: 11/12/2019

U.S. *Survey
Foot*

OC Public Works/Engineering Services
OC Survey/Field Services
Boundary Analysis & Mapping

BOLSA CHICA CHANNEL (C02)
332+67.62
@ CONCRETE STRUCTURE
CL

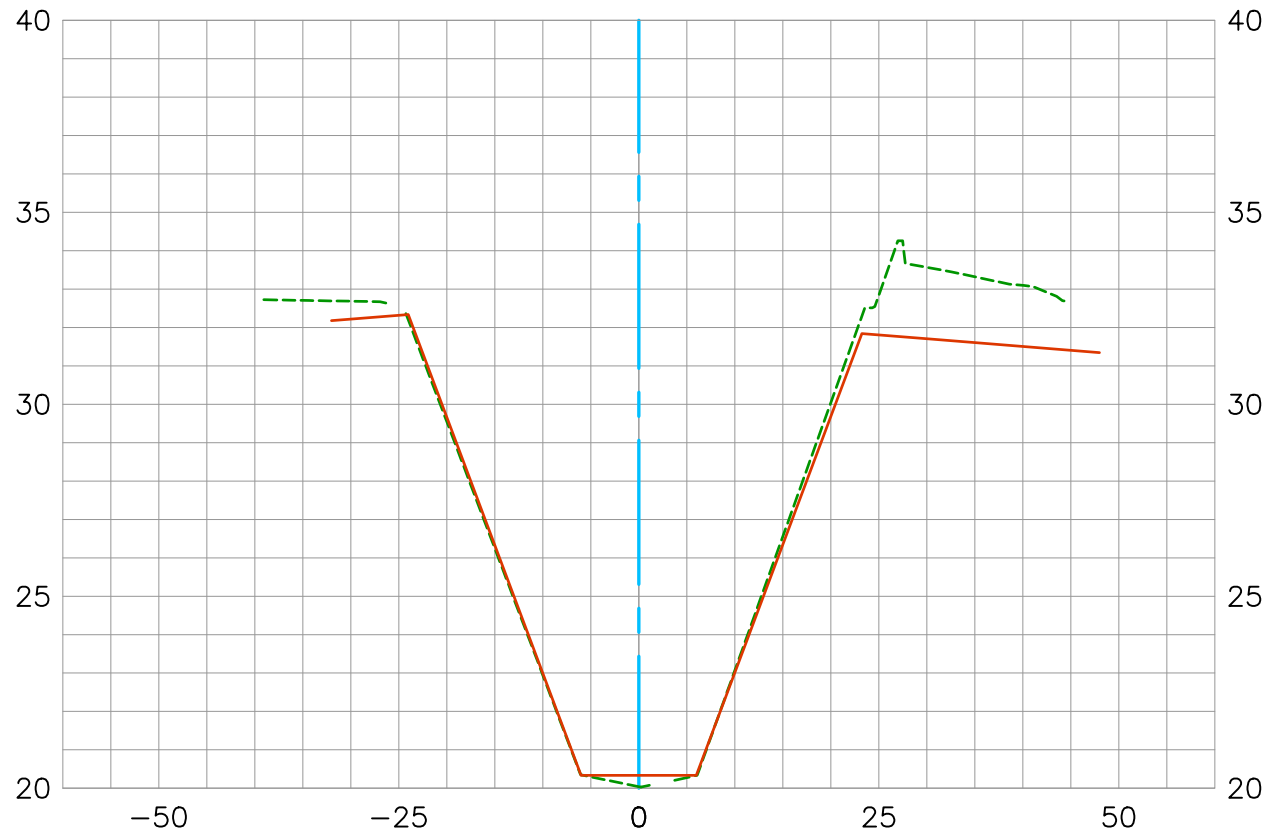

Existing Condition 2019 ---
Record As-Built Plan (1959) ---
Construction Centerline ---

Horizontal Scale 1"=20'
Vertical Scale 1"=5'


DATE PREPARED: 11/12/2019

U.S. Survey Foot

OC Public Works/Engineering Services
OC Survey/Field Services
Boundary Analysis & Mapping



BOLSA CHICA CHANNEL (C02)
333+47.94
@ CONCRETE STRUCTURE
CL

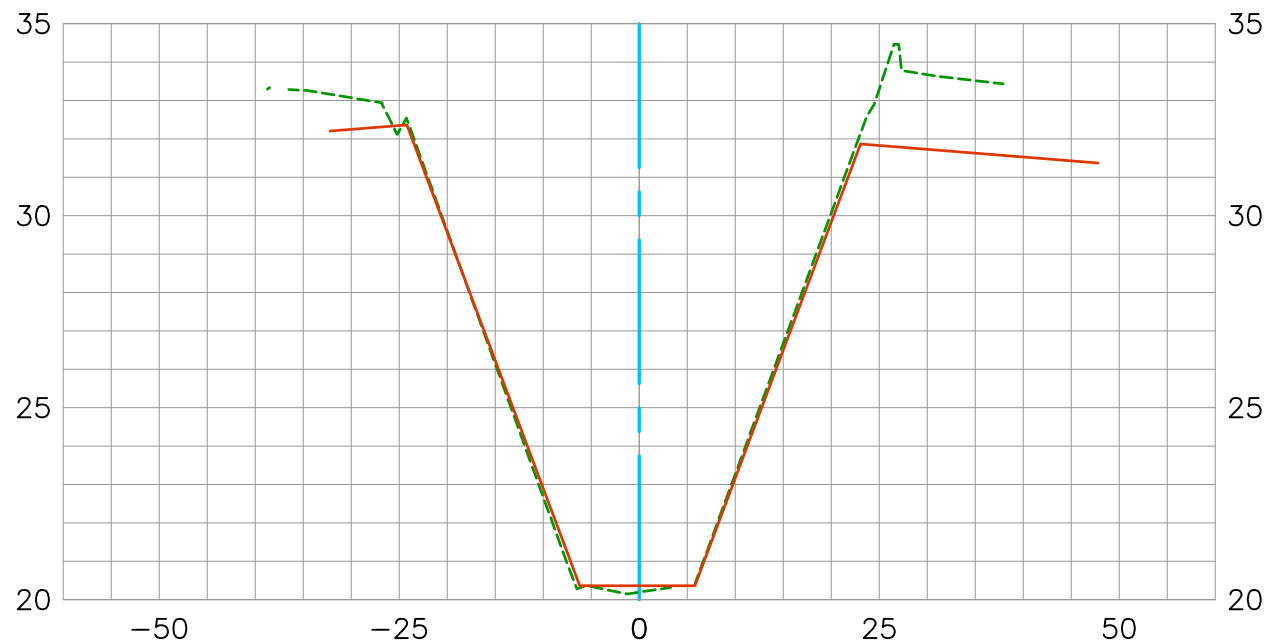

Existing Condition 2019 ---
Record As-Built Plan (1959) —
Construction Centerline ---

Horizontal Scale 1"=20'
Vertical Scale 1"=5'


DATE PREPARED: 11/12/2019

U.S. Survey Foot

OC Public Works/Engineering Services
OC Survey/Field Services
Boundary Analysis & Mapping



BOLSA CHICA CHANNEL (C02) 333+50.00 CL

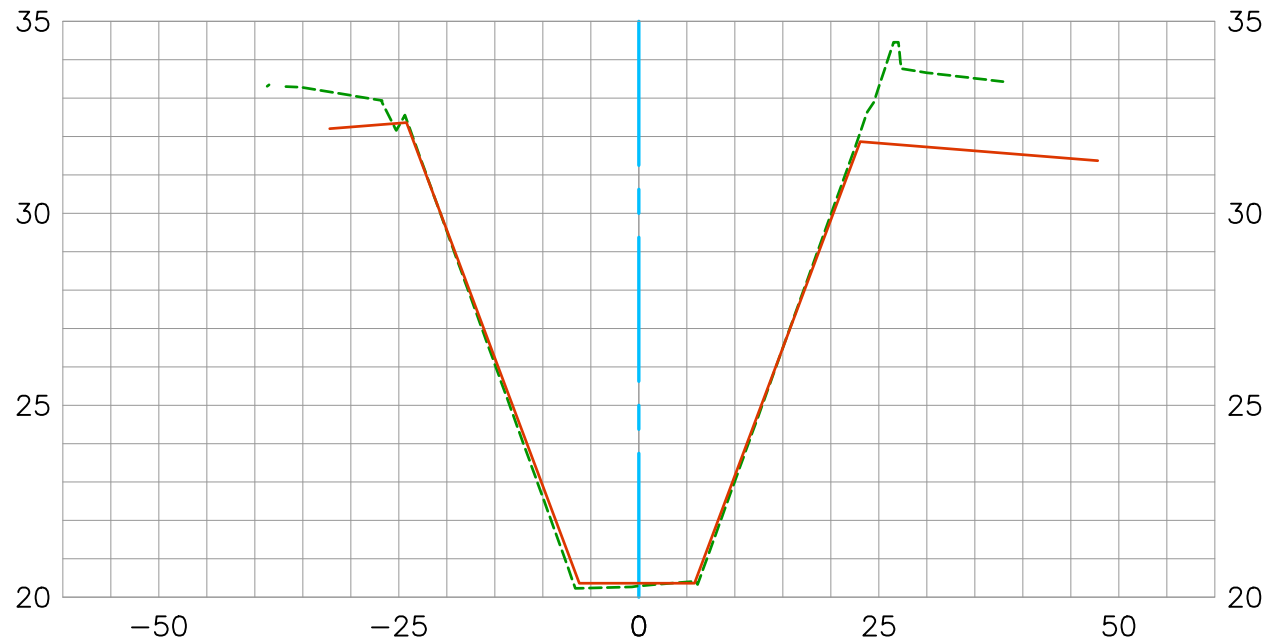

Existing Condition 2019 ---
Record As-Built Plan (1959) ---
Construction Centerline ---

Horizontal Scale 1"=20'
Vertical Scale 1"=5'

DATE PREPARED: 11/12/2019


U.S. Survey Foot

OC Public Works/Engineering Services
OC Survey/Field Services
Boundary Analysis & Mapping



BOLSA CHICA CHANNEL (C02)

334+00.00
CL

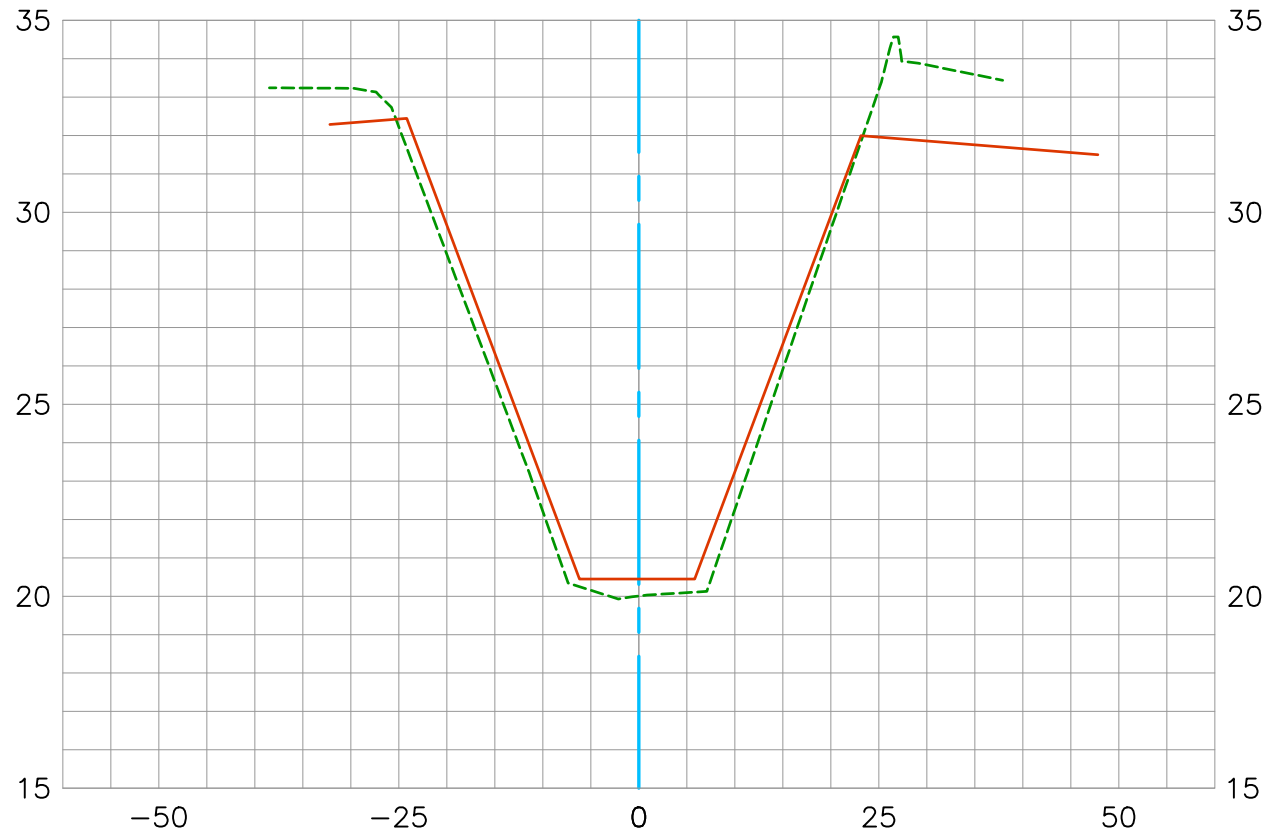

Existing Condition 2019 ---
Record As-Built Plan (1959) ---
Construction Centerline ---

Horizontal Scale 1"=20'
Vertical Scale 1"=5'

DATE PREPARED: 11/12/2019


U.S. Survey Foot

OC Public Works/Engineering Services
OC Survey/Field Services
Boundary Analysis & Mapping



BOLSA CHICA CHANNEL (C02)

334+50.00
CL

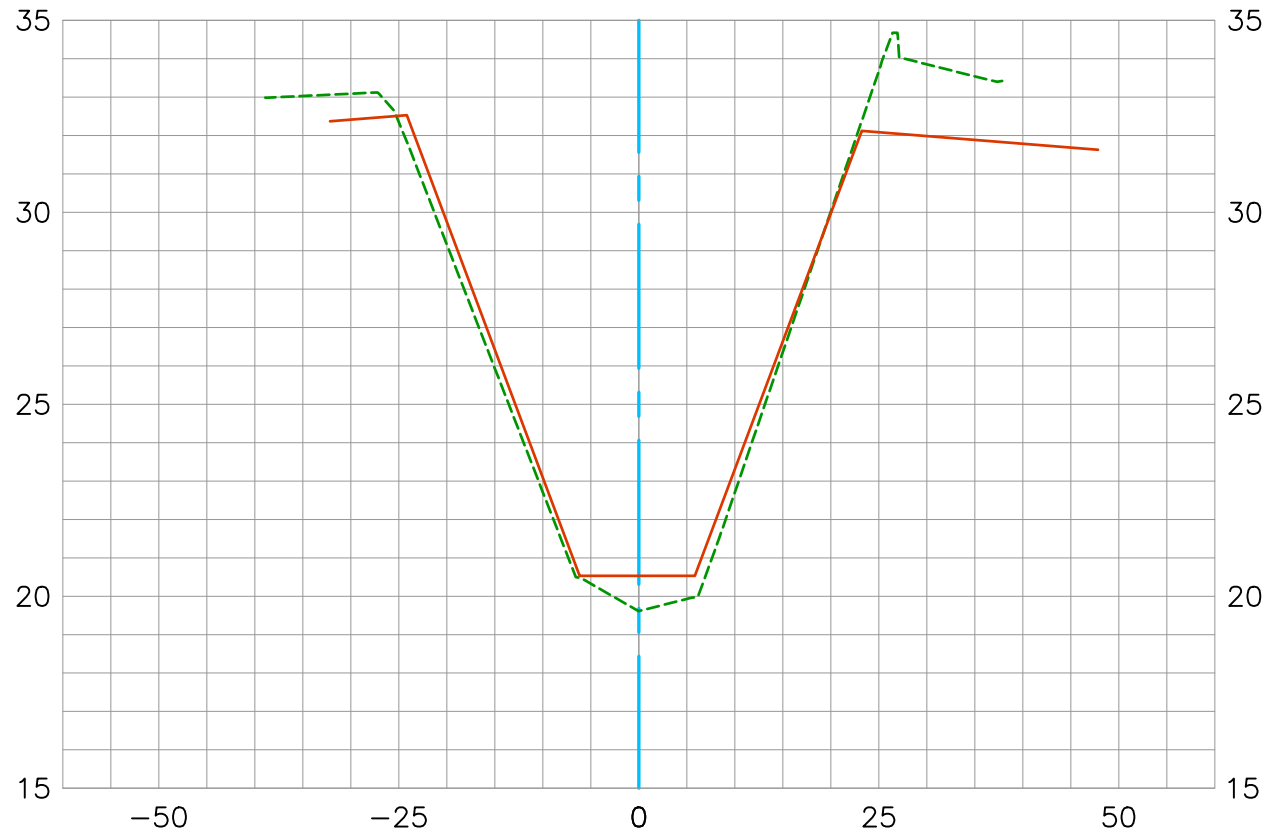

Existing Condition 2019 ---
Record As-Built Plan (1959) ---
Construction Centerline ---

Horizontal Scale 1"=20'
Vertical Scale 1"=5'


DATE PREPARED: 11/12/2019

U.S. Survey Foot

OC Public Works/Engineering Services
OC Survey/Field Services
Boundary Analysis & Mapping

BOLSA CHICA CHANNEL (C02)

335+00.00
CL

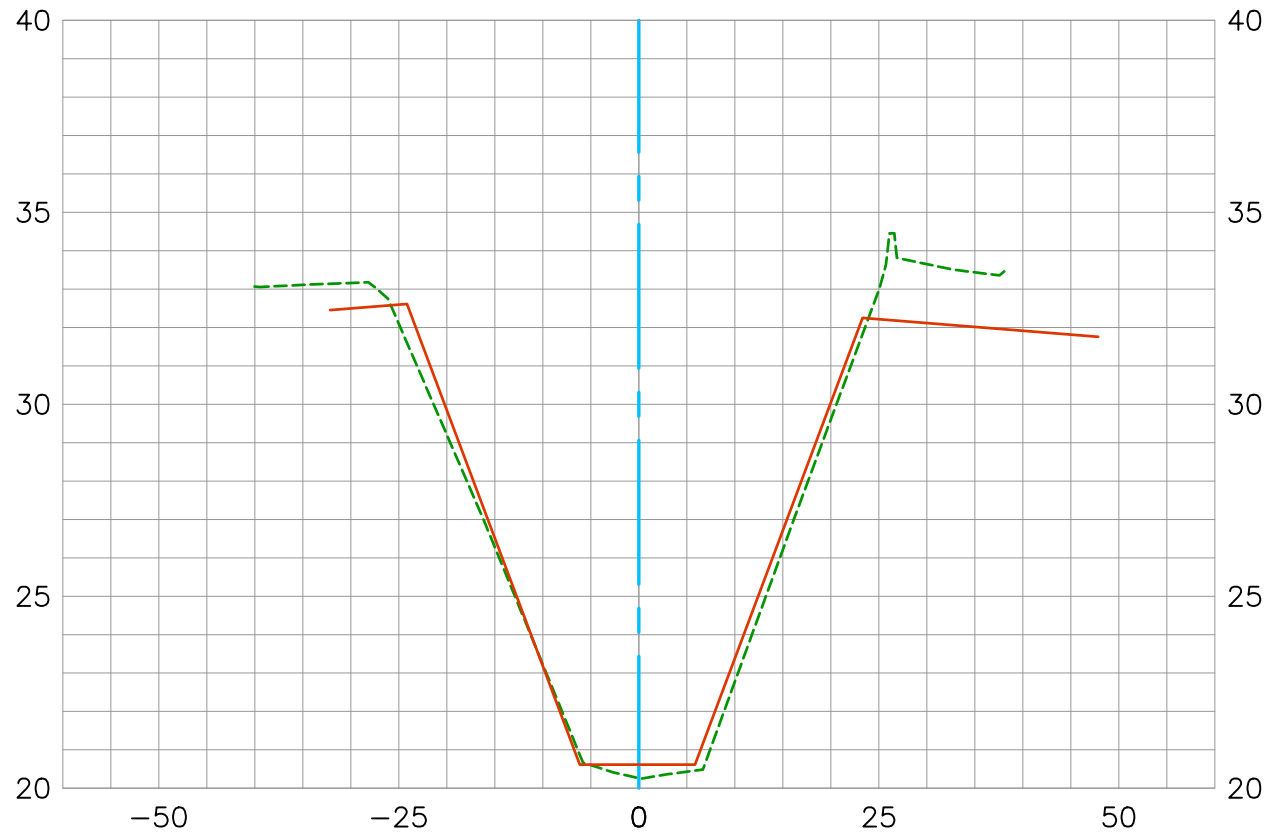

Existing Condition 2019 ---
Record As-Built Plan (1959) ---
Construction Centerline ---

Horizontal Scale 1"=20'
Vertical Scale 1"=5'

DATE PREPARED: 11/12/2019


U.S. Survey Foot

OC Public Works/Engineering Services
OC Survey/Field Services
Boundary Analysis & Mapping



BOLSA CHICA CHANNEL (C02)

335+50.00
CL

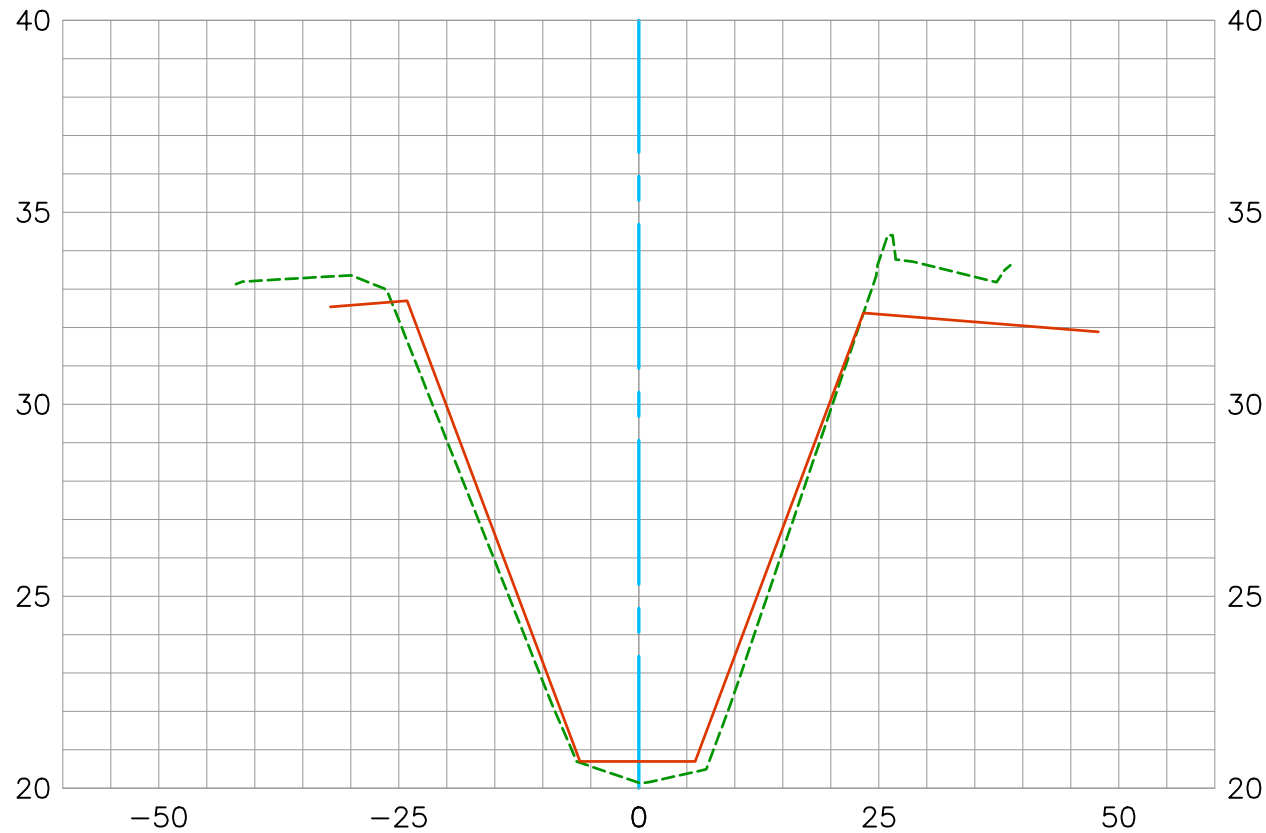

Existing Condition 2019 ---
Record As-Built Plan (1959) ---
Construction Centerline ---

Horizontal Scale 1"=20'
Vertical Scale 1"=5'

DATE PREPARED: 11/12/2019


U.S. Survey Foot

OC Public Works/Engineering Services
OC Survey/Field Services
Boundary Analysis & Mapping

BOLSA CHICA CHANNEL (C02)

336+00.00

CL

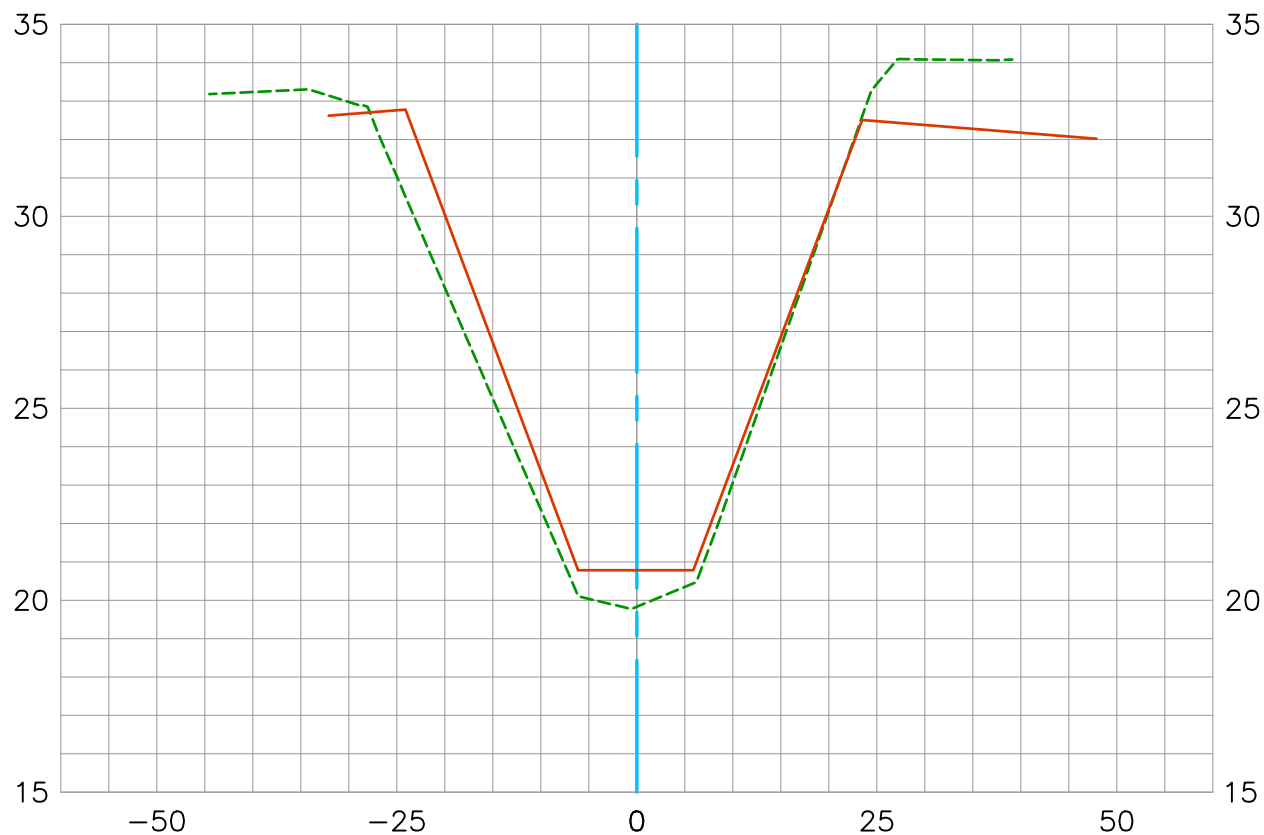

Existing Condition 2019 ---
Record As-Built Plan (1959) ---
Construction Centerline ---

Horizontal Scale 1"=20'
Vertical Scale 1"=5'

DATE PREPARED: 11/12/2019


U.S. Survey Foot

OC Public Works/Engineering Services
OC Survey/Field Services
Boundary Analysis & Mapping



BOLSA CHICA CHANNEL (C02)

336+50.00
CL

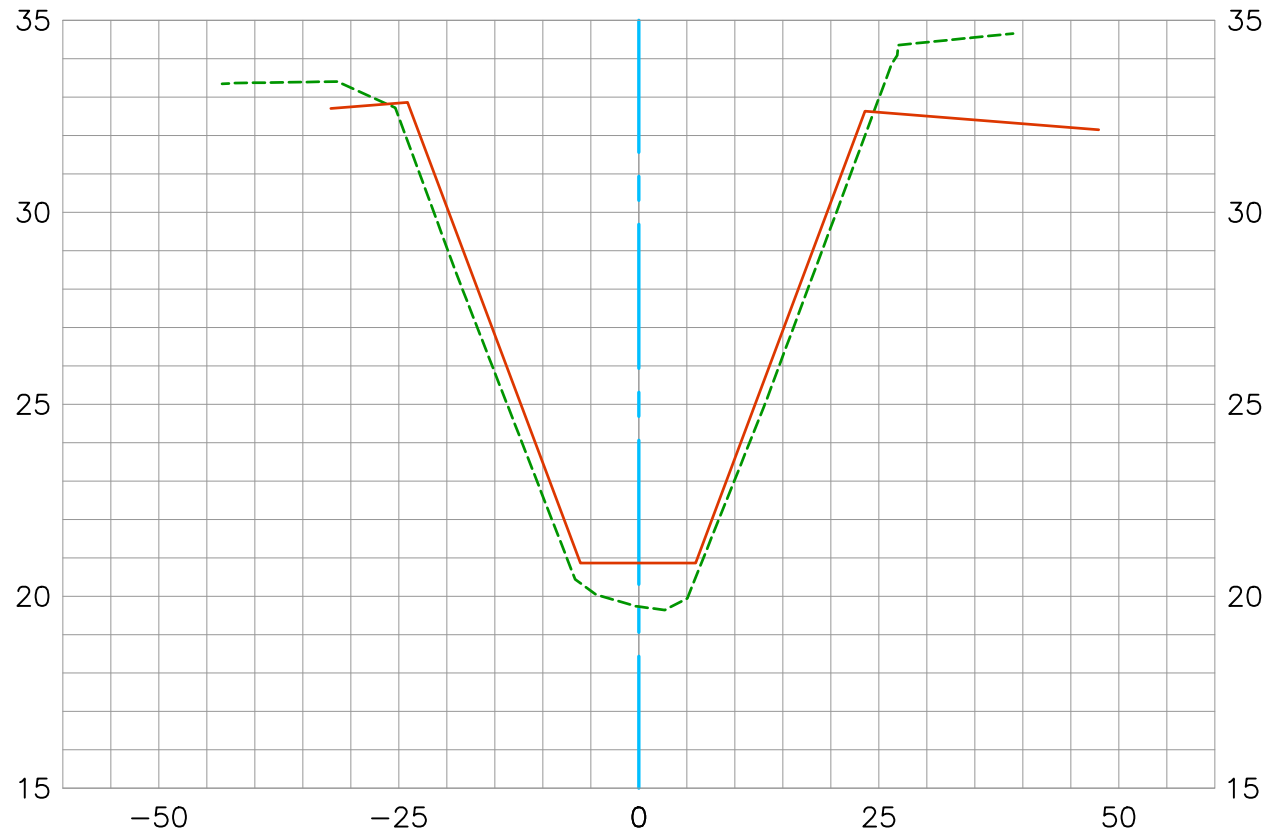

Existing Condition 2019 ---
Record As-Built Plan (1959) ---
Construction Centerline ---

Horizontal Scale 1"=20'
Vertical Scale 1"=5'


DATE PREPARED: 11/12/2019

U.S. *Survey
Foot*

OC Public Works/Engineering Services
OC Survey/Field Services
Boundary Analysis & Mapping

BOLSA CHICA CHANNEL (C02)

337+00.00
CL

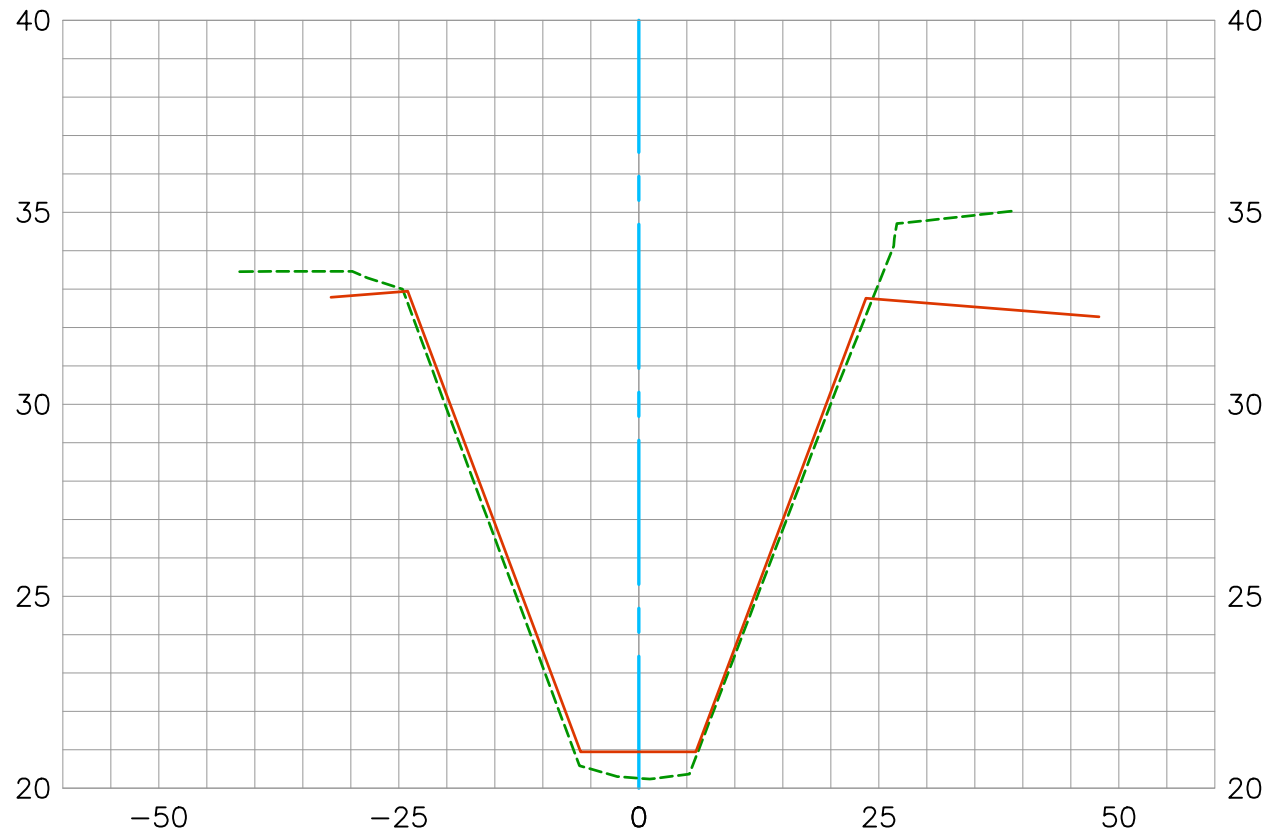

Existing Condition 2019 ---
Record As-Built Plan (1959) ---
Construction Centerline ---

Horizontal Scale 1"=20'
Vertical Scale 1"=5'


DATE PREPARED: 11/12/2019

U.S. Survey Foot

OC Public Works/Engineering Services
OC Survey/Field Services
Boundary Analysis & Mapping

BOLSA CHICA CHANNEL (C02)

337+50.00
CL

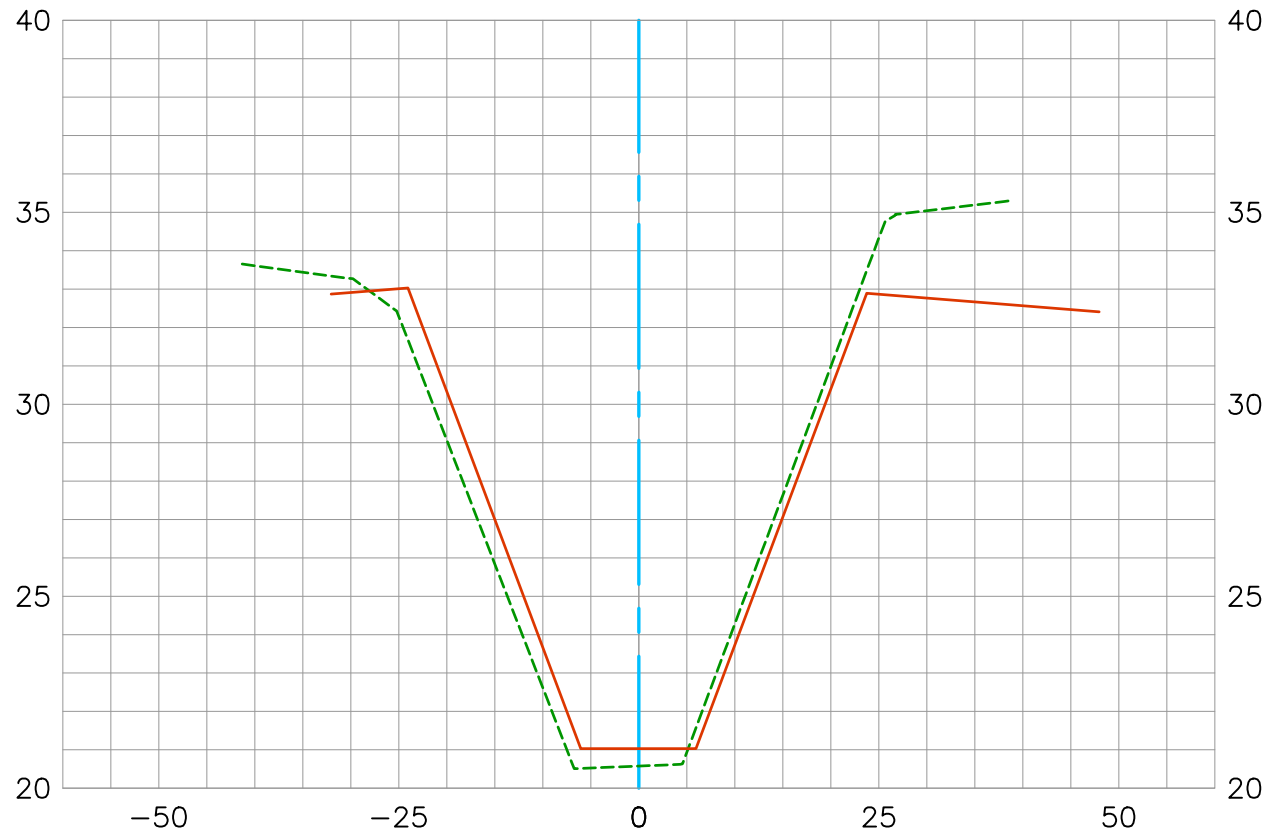

Existing Condition 2019 ---
Record As-Built Plan (1959) —
Construction Centerline ---


Horizontal Scale 1"=20'
Vertical Scale 1"=5'

DATE PREPARED: 11/12/2019



BOLSA CHICA CHANNEL (C02)

338+00.00
CL

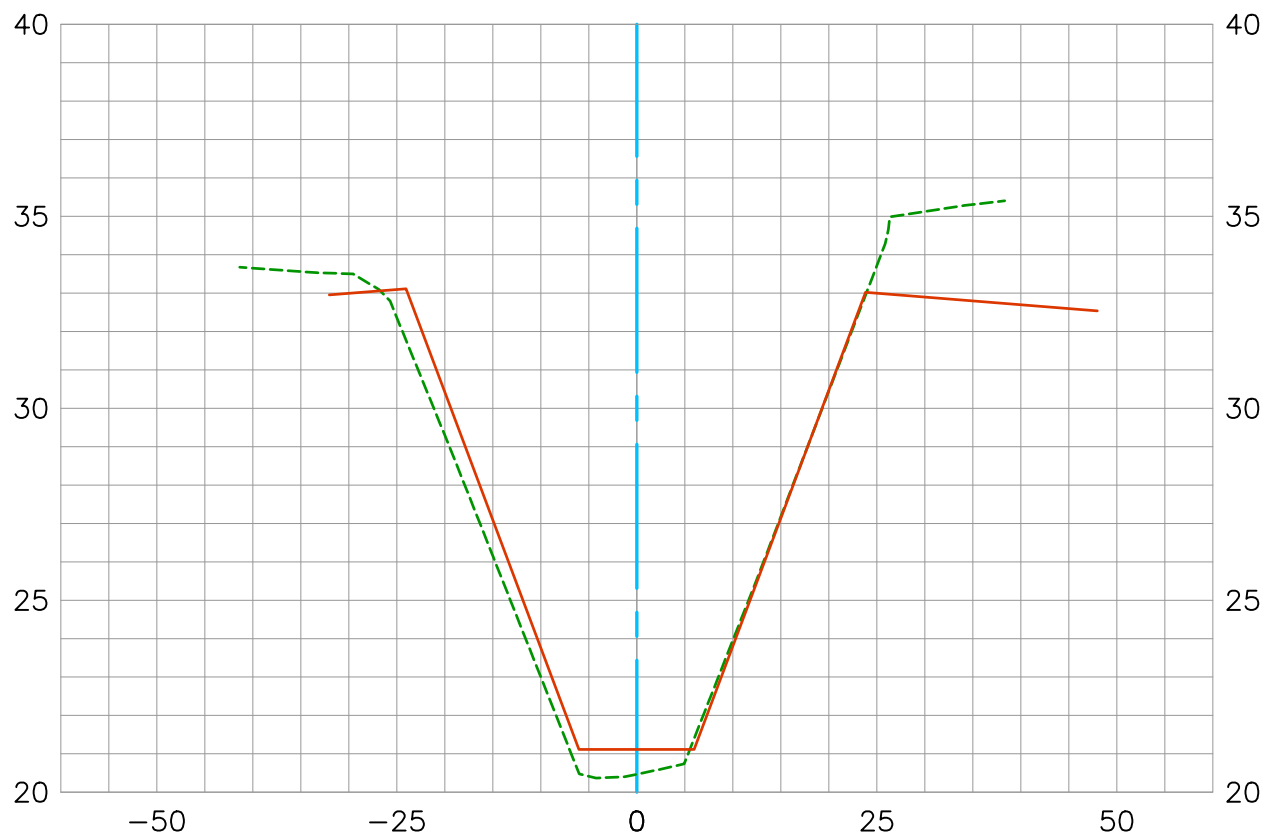


Existing Condition 2019 ---
Record As-Built Plan (1959) ---
Construction Centerline ---

Horizontal Scale 1"=20'
Vertical Scale 1"=5'

DATE PREPARED: 11/12/2019

BOLSA CHICA CHANNEL (C02)

338+50.00
CL

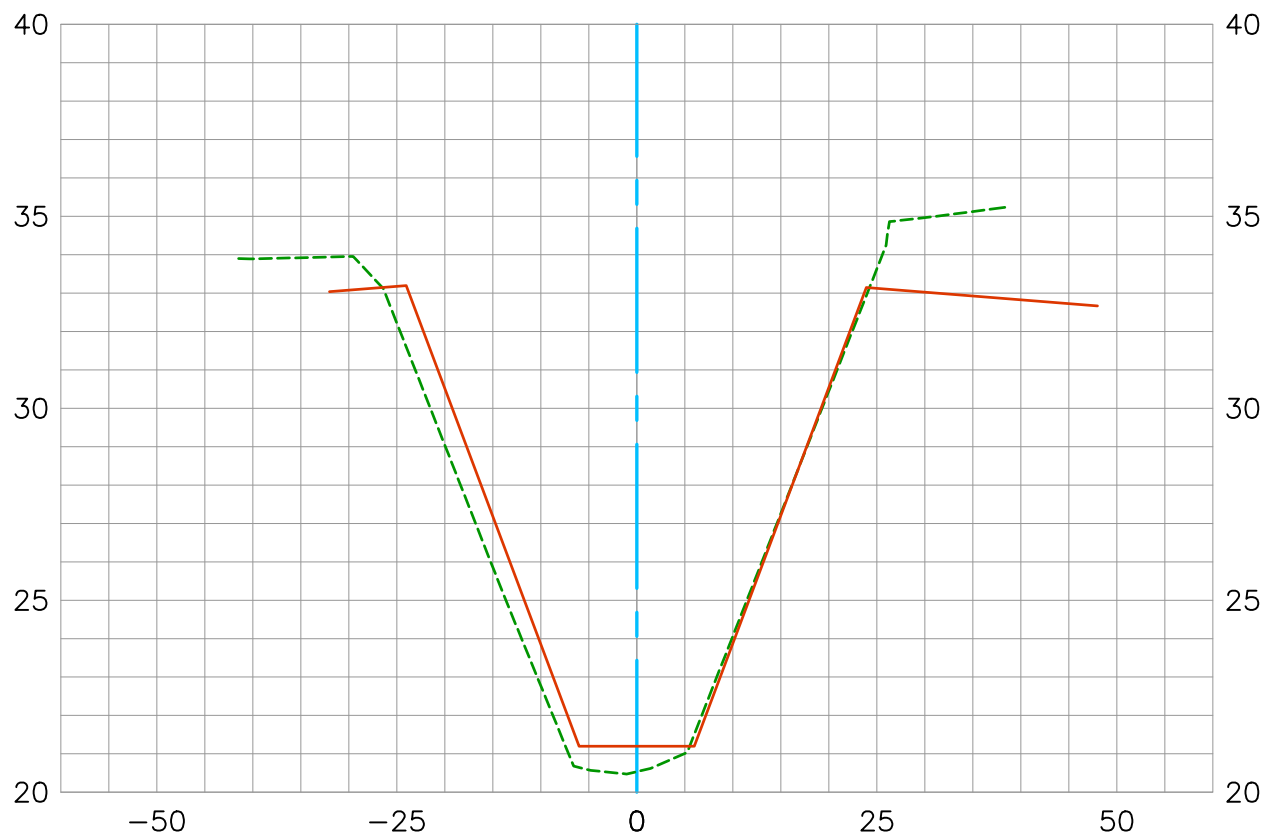

Existing Condition 2019 ---
Record As-Built Plan (1959) ---
Construction Centerline ---


Horizontal Scale 1"=20'
Vertical Scale 1"=5'

DATE PREPARED: 11/12/2019

U.S. *Survey
Foot*

OC Public Works/Engineering Services
OC Survey/Field Services
Boundary Analysis & Mapping

BOLSA CHICA CHANNEL (C02)
339+06.00
@ CONCRETE STRUCTURE
CL

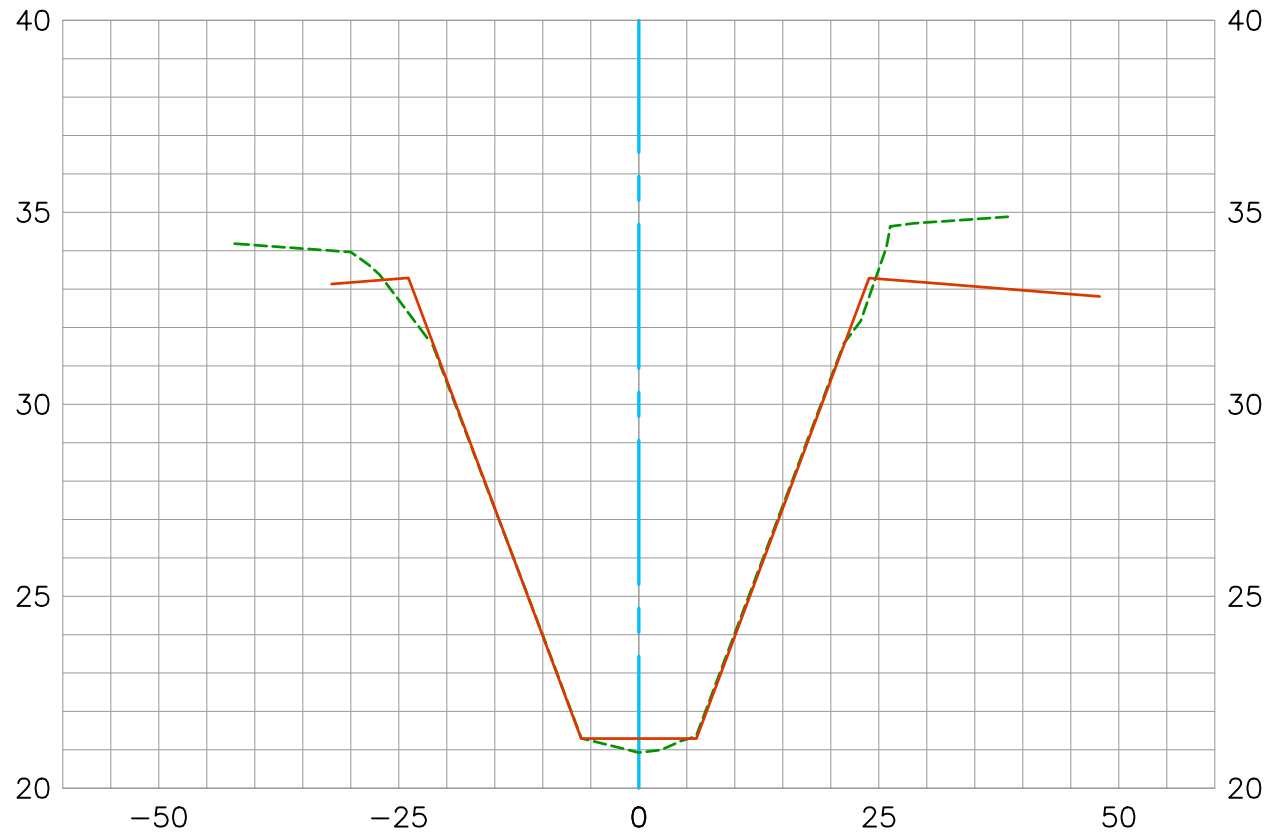


Existing Condition 2019 ---
Record As-Built Plan (1959) ---
Construction Centerline ---

Horizontal Scale 1"=20'
Vertical Scale 1"=5'

DATE PREPARED: 11/12/2019

BOLSA CHICA CHANNEL (C02) 349+59.70 @ CONCRETE STRUCTURE CL

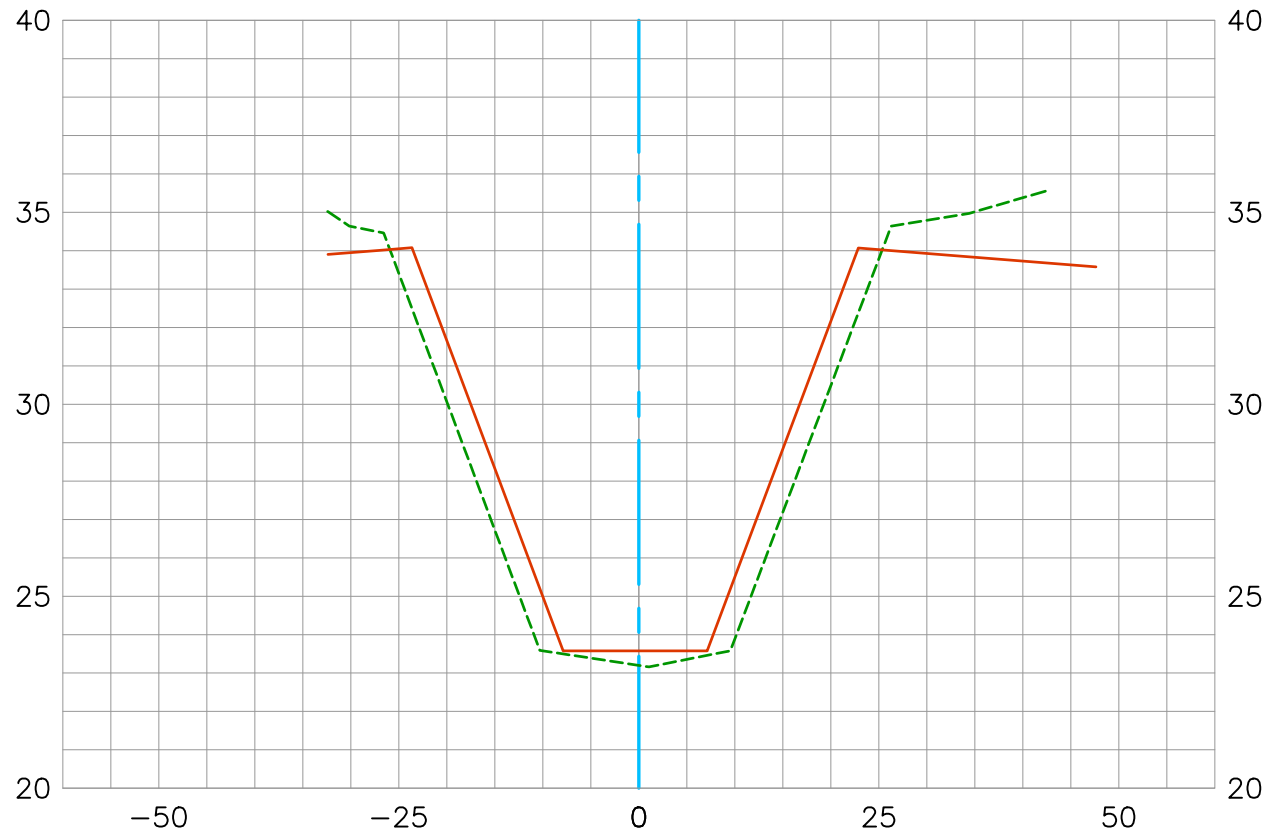

Existing Condition 2019 - - - - -
 Record As-Built Plan (1959) —————
 Construction Centerline - - - - -

Horizontal Scale 1"=20'
 Vertical Scale 1"=5'

DATE PREPARED: 11/12/2019


U.S. Survey Foot

OC Public Works/Engineering Services
OC Survey/Field Services
Boundary Analysis & Mapping

BOLSA CHICA CHANNEL (C02)

350+00.00

CL

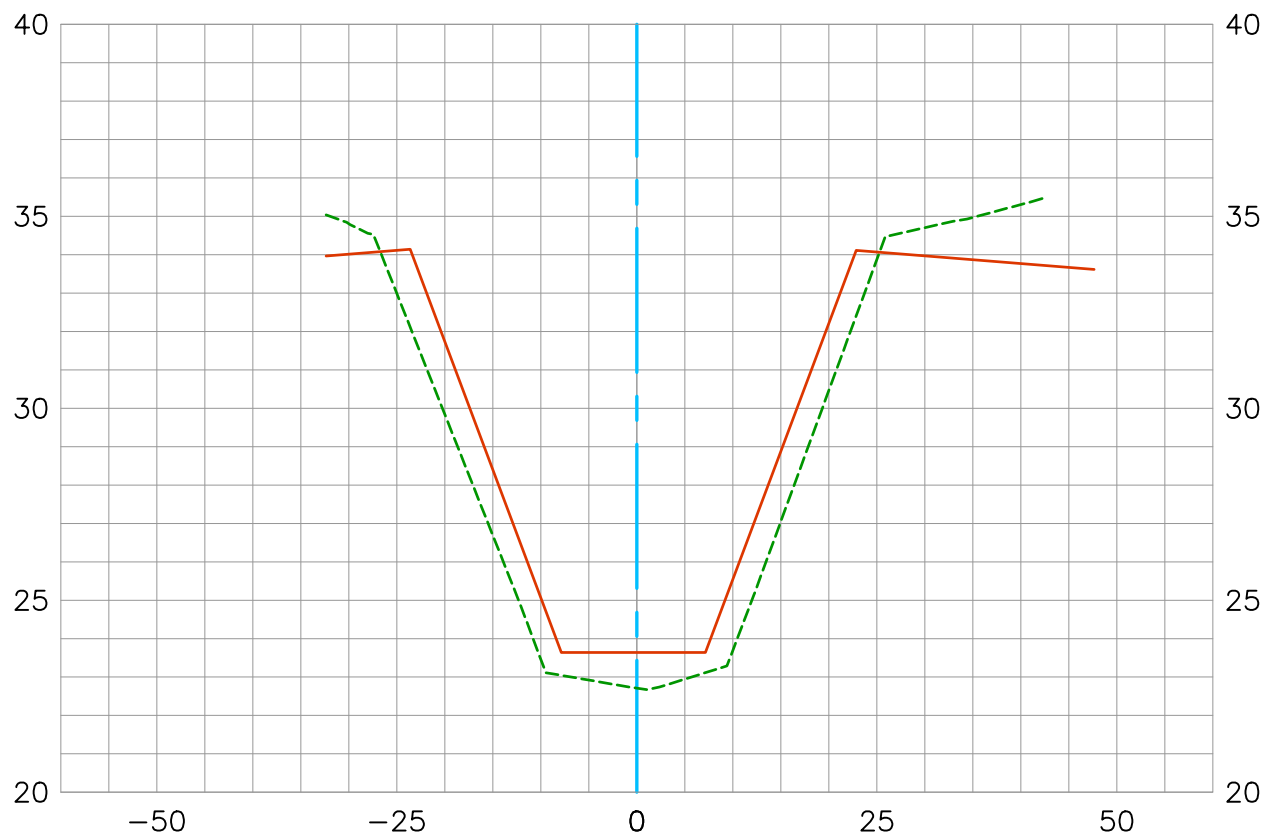

Existing Condition 2019 ---
Record As-Built Plan (1959) ---
Construction Centerline ---

Horizontal Scale 1"=20'
Vertical Scale 1"=5'

DATE PREPARED: 11/12/2019


U.S. Survey Foot

OC Public Works/Engineering Services
OC Survey/Field Services
Boundary Analysis & Mapping

BOLSA CHICA CHANNEL (C02)

350+50.00

CL

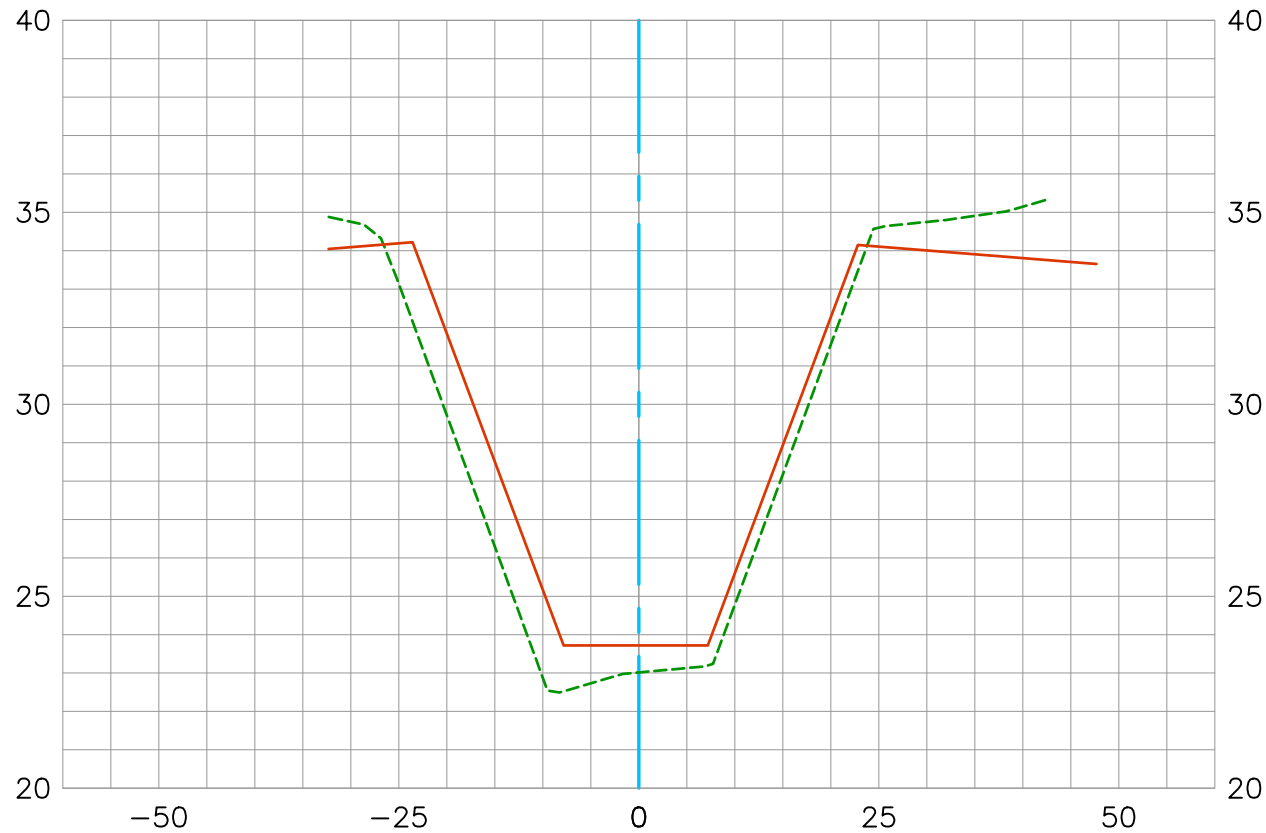

Existing Condition 2019 ---
Record As-Built Plan (1959) ---
Construction Centerline ---

Horizontal Scale 1"=20'
Vertical Scale 1"=5'


DATE PREPARED: 11/12/2019

U.S. Survey Foot

OC Public Works/Engineering Services
OC Survey/Field Services
Boundary Analysis & Mapping

BOLSA CHICA CHANNEL (C02)

351+00.00
CL

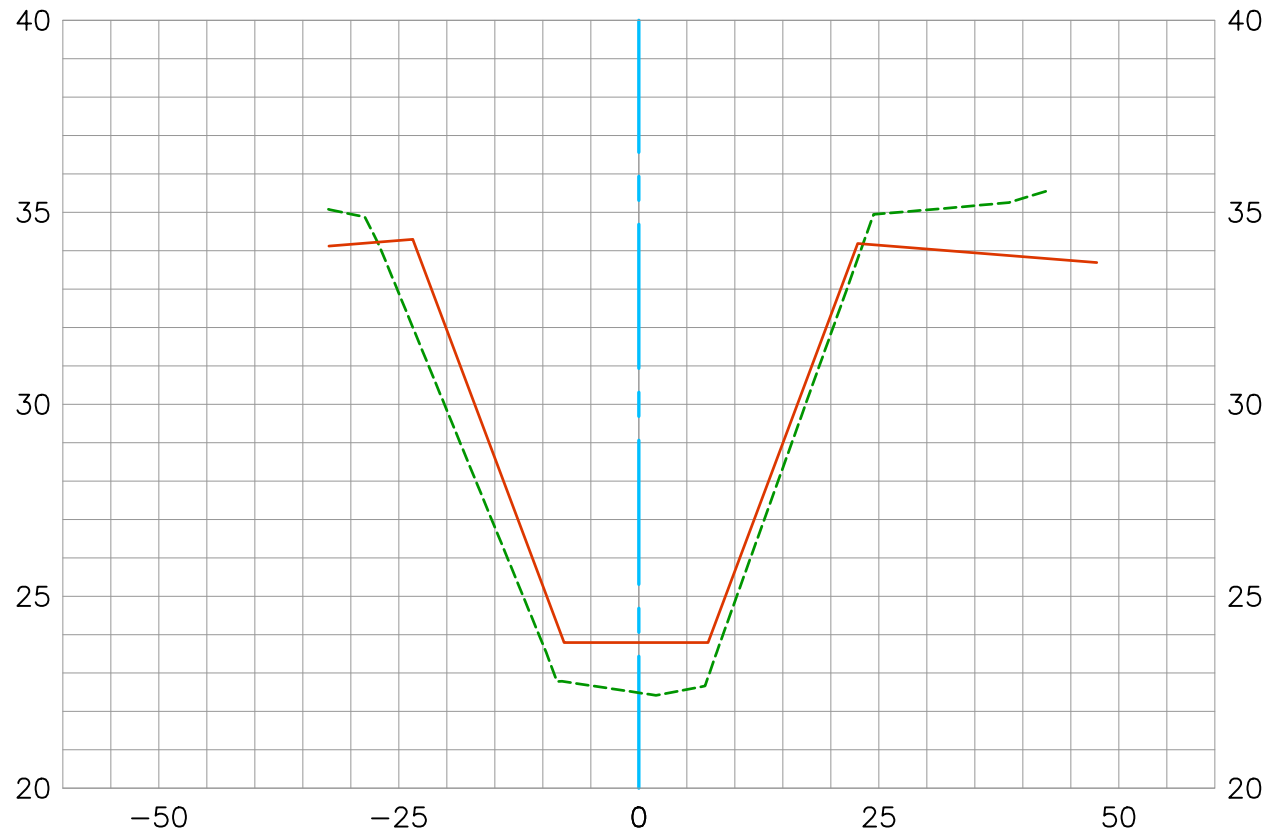

Existing Condition 2019 ---
Record As-Built Plan (1959) ---
Construction Centerline ---

Horizontal Scale 1"=20'
Vertical Scale 1"=5'

DATE PREPARED: 11/12/2019


U.S. Survey Foot

OC Public Works/Engineering Services
OC Survey/Field Services
Boundary Analysis & Mapping



BOLSA CHICA CHANNEL (C02)

351+50.00
CL

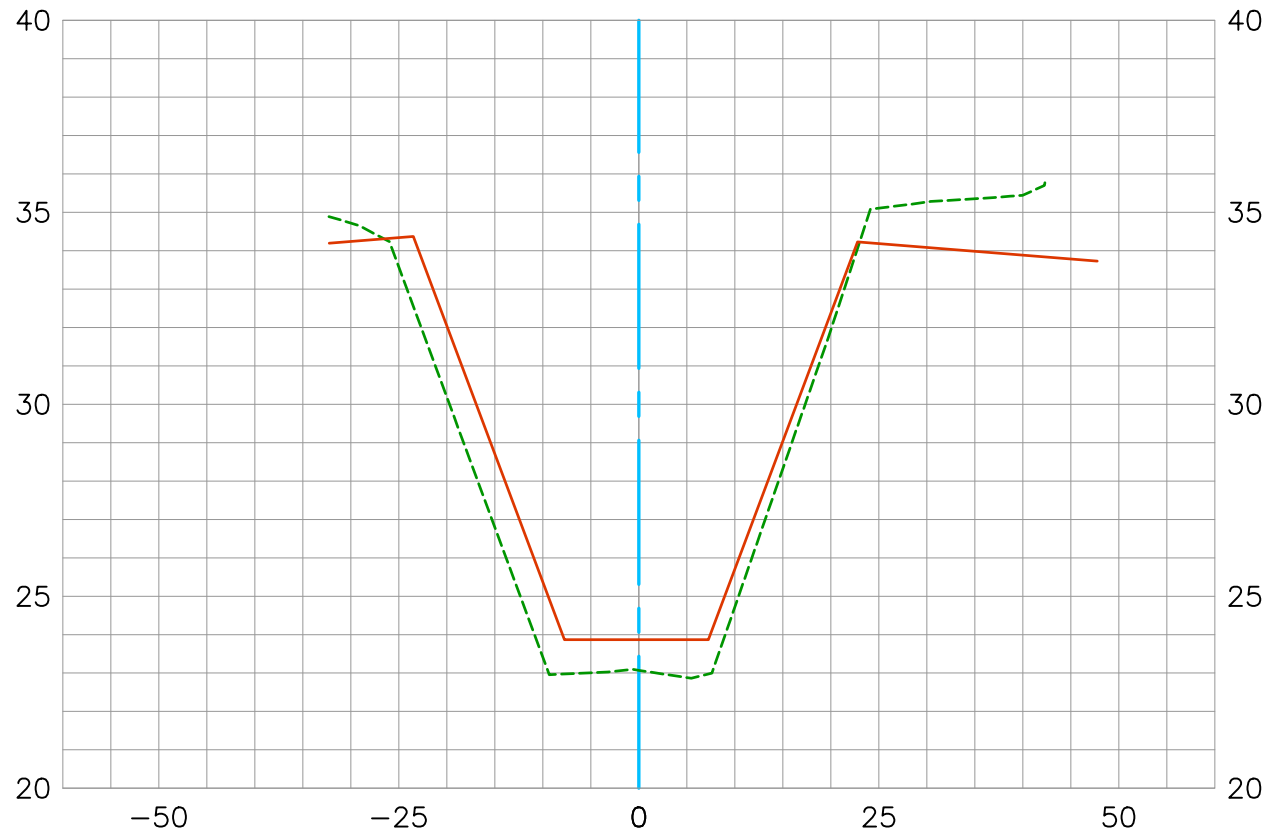

Existing Condition 2019 ---
Record As-Built Plan (1959) ---
Construction Centerline ---

Horizontal Scale 1"=20'
Vertical Scale 1"=5'

DATE PREPARED: 11/12/2019


U.S. *Survey
Foot*

OC Public Works/Engineering Services
OC Survey/Field Services
Boundary Analysis & Mapping

BOLSA CHICA CHANNEL (C02)

352+00.00

CL

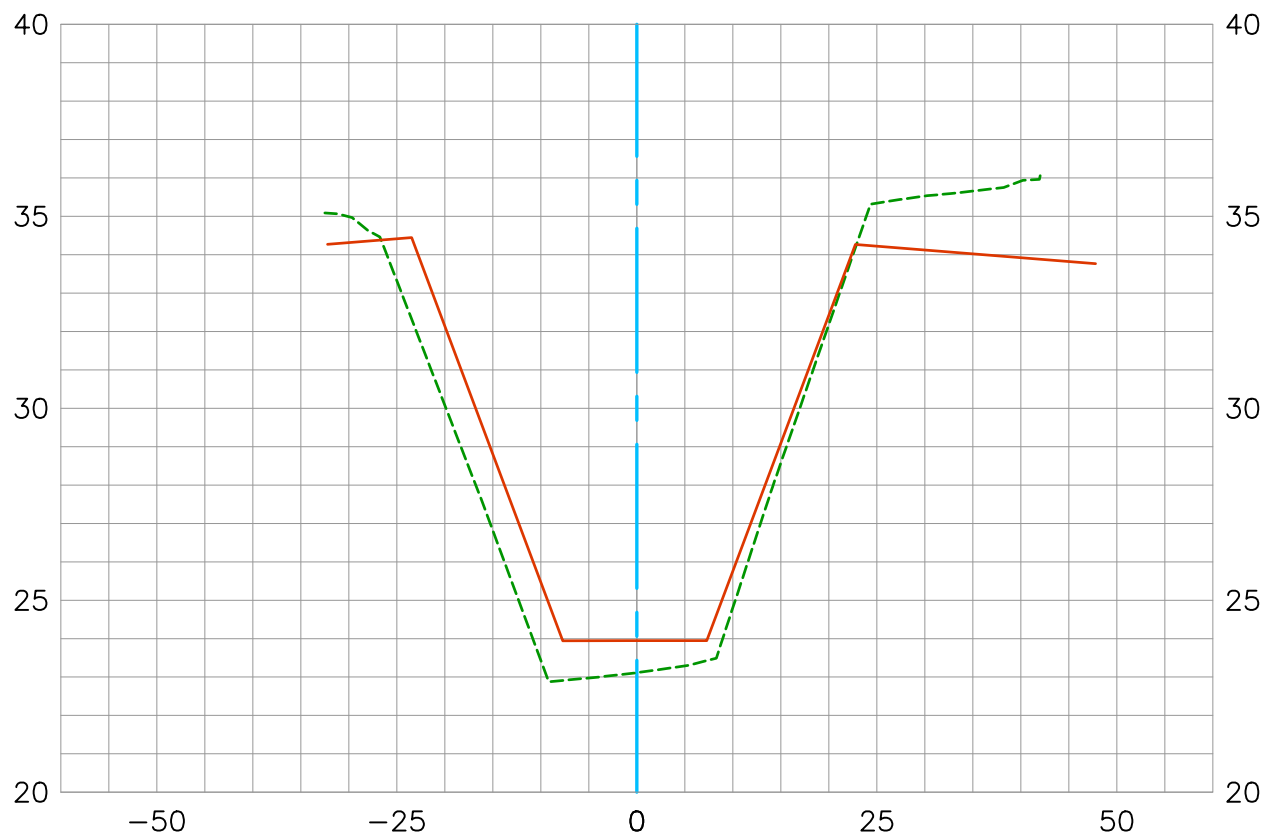

Existing Condition 2019 ---
Record As-Built Plan (1959) ---
Construction Centerline ---


Horizontal Scale 1"=20'
Vertical Scale 1"=5'

DATE PREPARED: 11/12/2019



BOLSA CHICA CHANNEL (C02)

352+50.00
CL

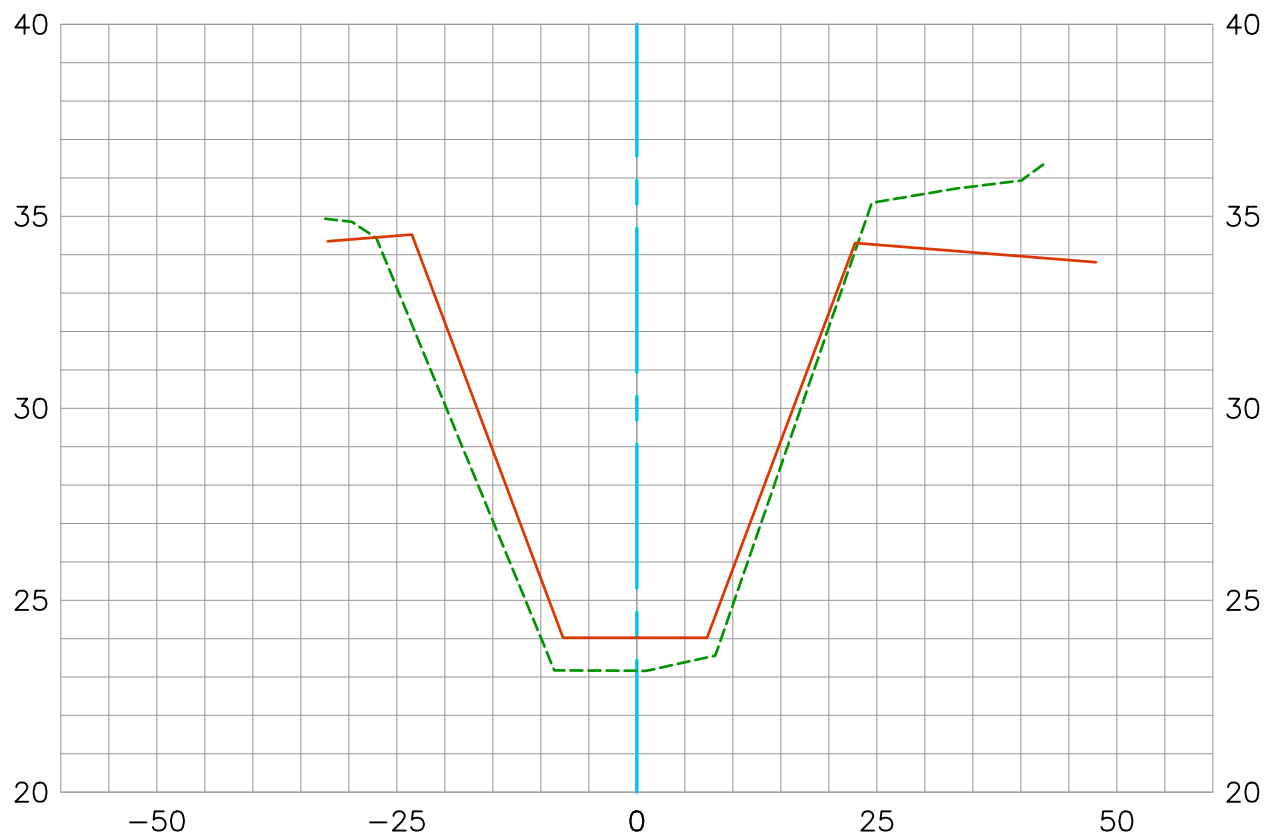

Existing Condition 2019 ----
Record As-Built Plan (1959) ————
Construction Centerline ————

Horizontal Scale 1"=20'
Vertical Scale 1"=5'

DATE PREPARED: 11/12/2019


U.S. Survey Foot

OC Public Works/Engineering Services
OC Survey/Field Services
Boundary Analysis & Mapping



BOLSA CHICA CHANNEL (C02)

353+00.00
CL

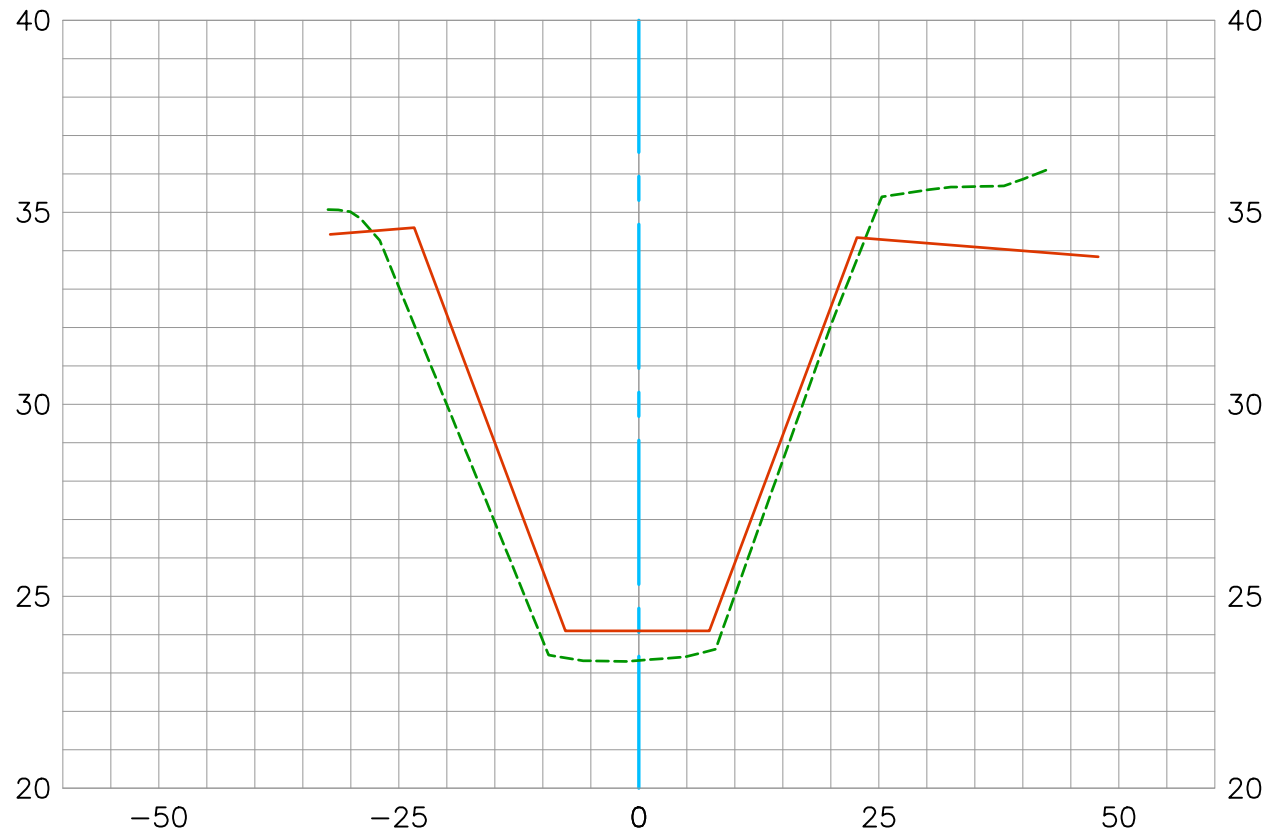

Existing Condition 2019 ---
Record As-Built Plan (1959) ---
Construction Centerline ---

Horizontal Scale 1"=20'
Vertical Scale 1"=5'


DATE PREPARED: 11/12/2019



BOLSA CHICA CHANNEL (C02)

353+50.00

CL

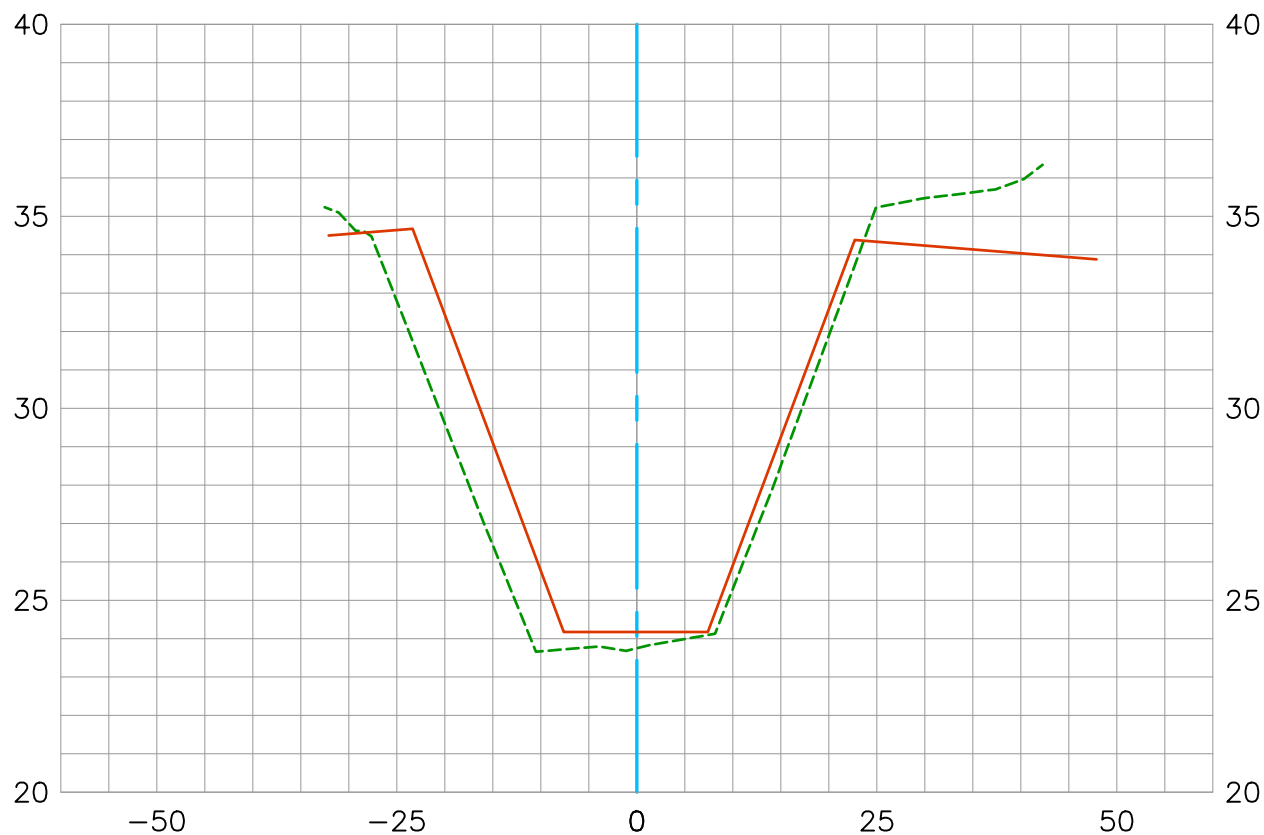

Existing Condition 2019 ---
 Record As-Built Plan (1959) ---
 Construction Centerline ---

Horizontal Scale 1"=20'
 Vertical Scale 1"=5'

DATE PREPARED: 11/12/2019


U.S. Survey Foot

OC Public Works/Engineering Services
OC Survey/Field Services
Boundary Analysis & Mapping



BOLSA CHICA CHANNEL (C02)

354+00.00
CL

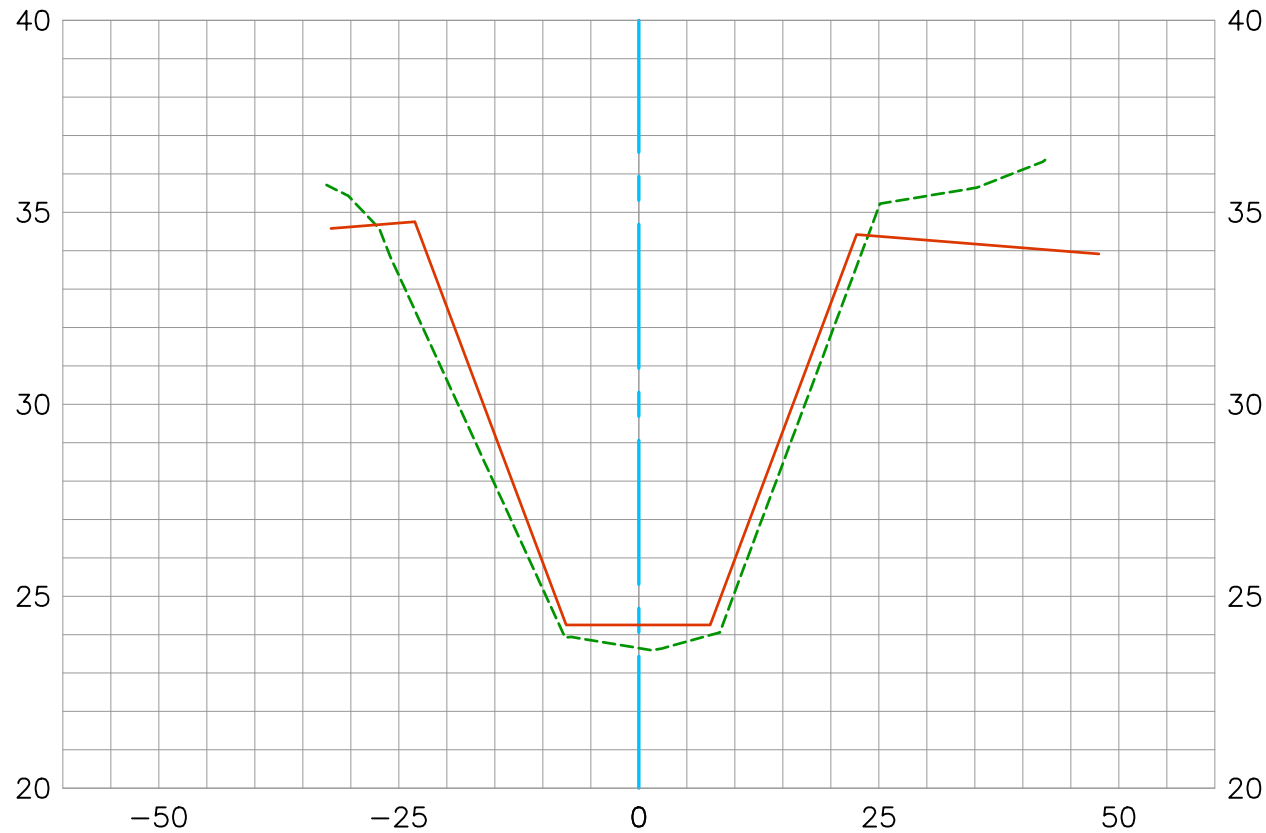

Existing Condition 2019 ---
Record As-Built Plan (1959) ---
Construction Centerline ---

Horizontal Scale 1"=20'
Vertical Scale 1"=5'


DATE PREPARED: 11/12/2019

U.S. *Survey
Foot*

OC Public Works/Engineering Services
OC Survey/Field Services
Boundary Analysis & Mapping

BOLSA CHICA CHANNEL (C02)

354+50.00
CL

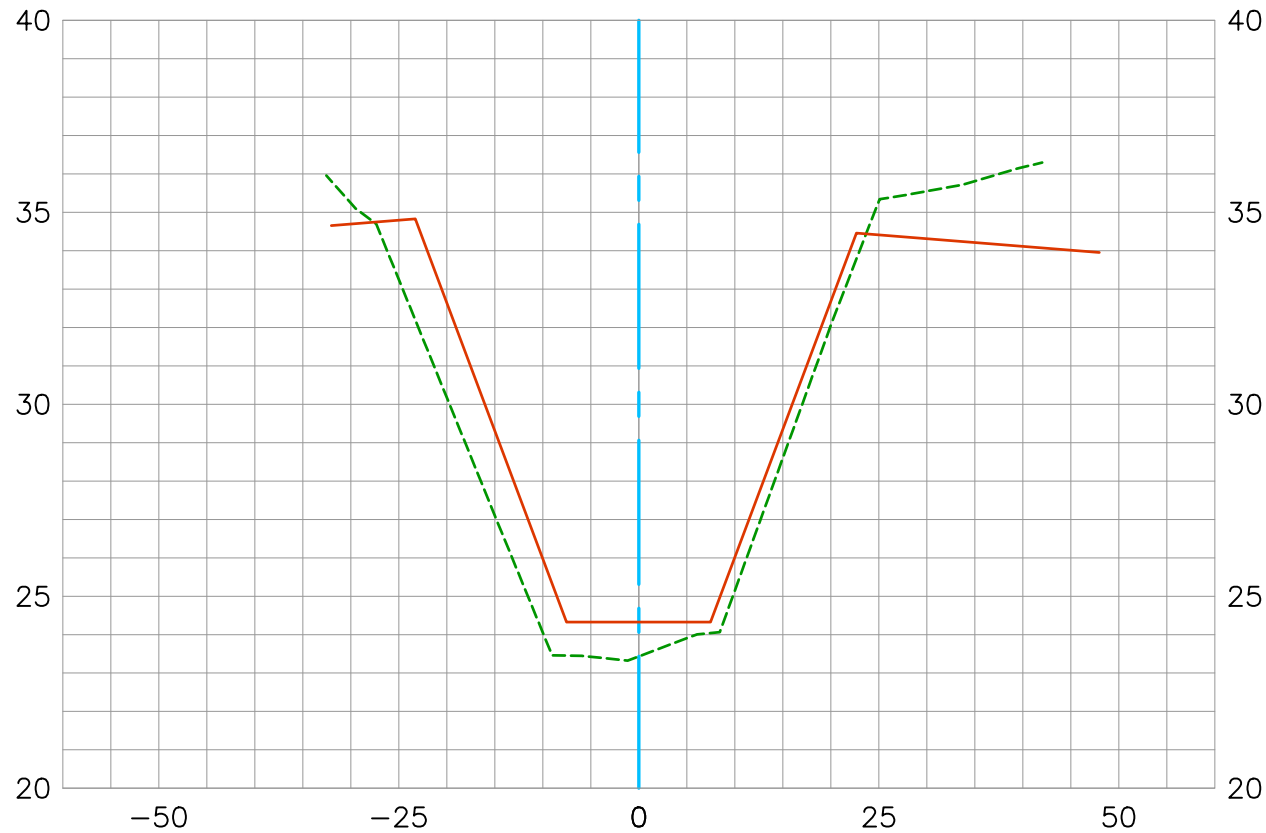

Existing Condition 2019 - - - - -
Record As-Built Plan (1959) —————
Construction Centerline —————

Horizontal Scale 1"=20'
Vertical Scale 1"=5'


DATE PREPARED: 11/12/2019

U.S. Survey Foot

OC Public Works/Engineering Services
OC Survey/Field Services
Boundary Analysis & Mapping

BOLSA CHICA CHANNEL (C02)

355+00.00
CL

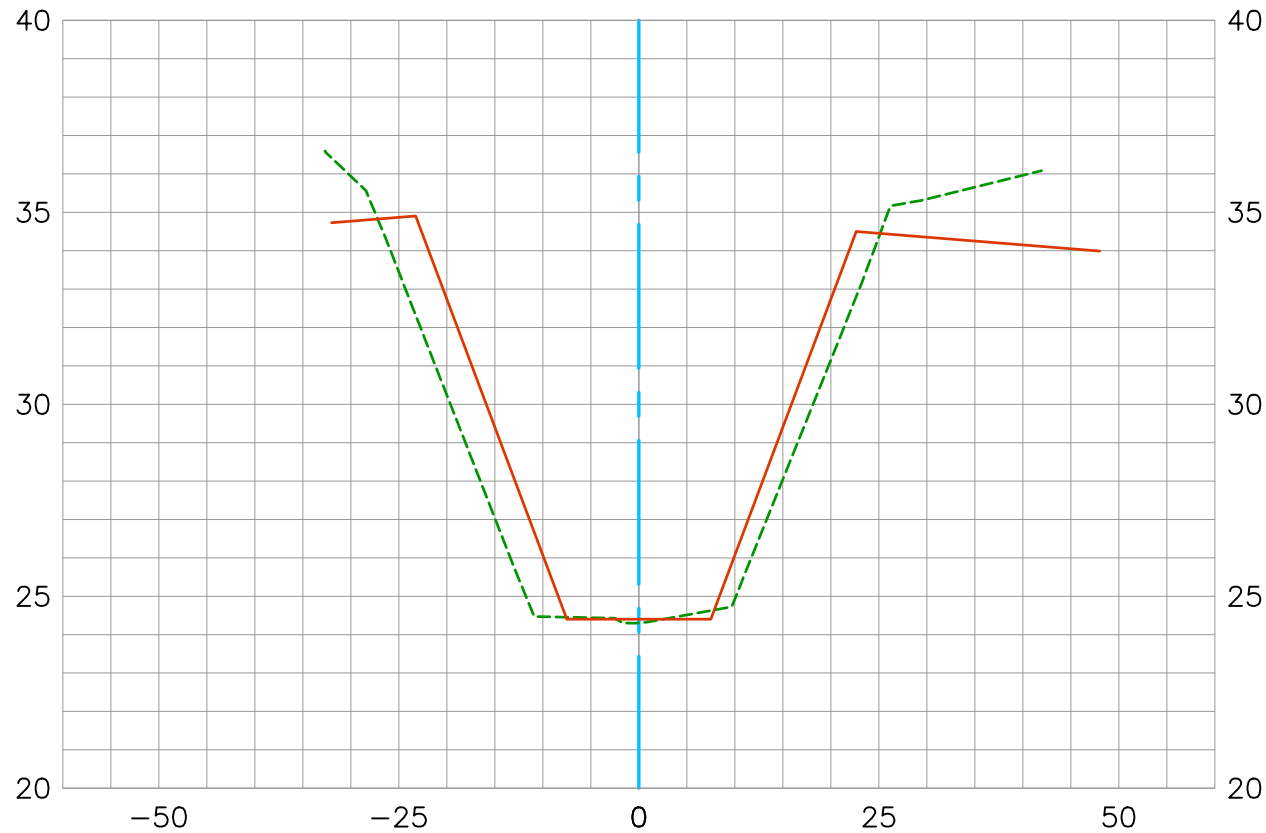

Existing Condition 2019 ---
Record As-Built Plan (1959) ---
Construction Centerline ---


Horizontal Scale 1"=20'
Vertical Scale 1"=5'

DATE PREPARED: 11/12/2019

U.S. *Survey
Foot*

OC Public Works/Engineering Services
OC Survey/Field Services
Boundary Analysis & Mapping

BOLSA CHICA CHANNEL (C02)
355+04.88
@ CONCRETE STRUCTURE
CL

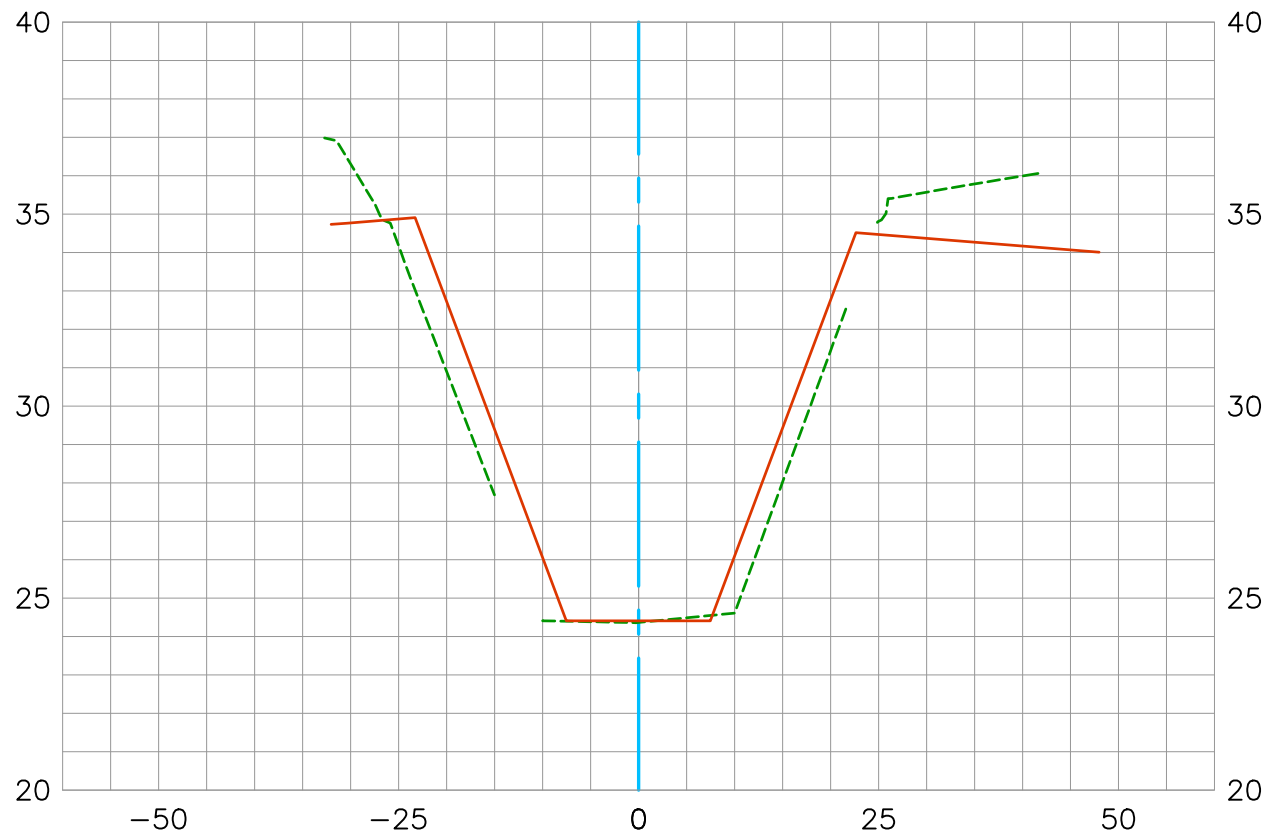

Existing Condition 2019 ---
Record As-Built Plan (1959) ---
Construction Centerline ---


Horizontal Scale 1"=20'
Vertical Scale 1"=5'

DATE PREPARED: 11/12/2019

U.S. *Survey
Foot*

OC Public Works/Engineering Services
OC Survey/Field Services
Boundary Analysis & Mapping

BOLSA CHICA CHANNEL (C02)
356+04.85
@ CONCRETE STRUCTURE
CL

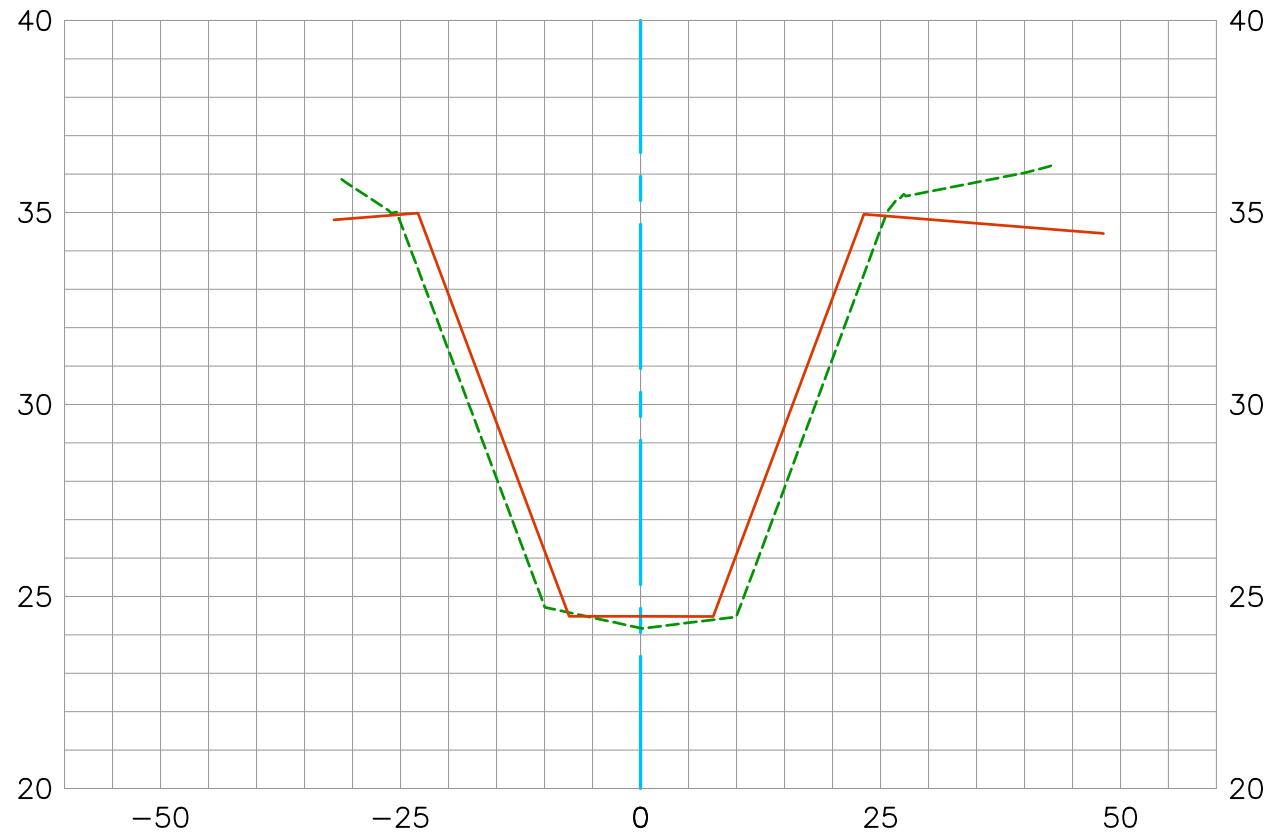

Existing Condition 2019 ---
Record As-Built Plan (1959) —
Construction Centerline ---

Horizontal Scale 1"=20'
Vertical Scale 1"=5'

DATE PREPARED: 11/12/2019

U.S. Survey Foot


OC Public Works/Engineering Services
OC Survey/Field Services
Boundary Analysis & Mapping



BOLSA CHICA CHANNEL (C02)

356+50.00

CL

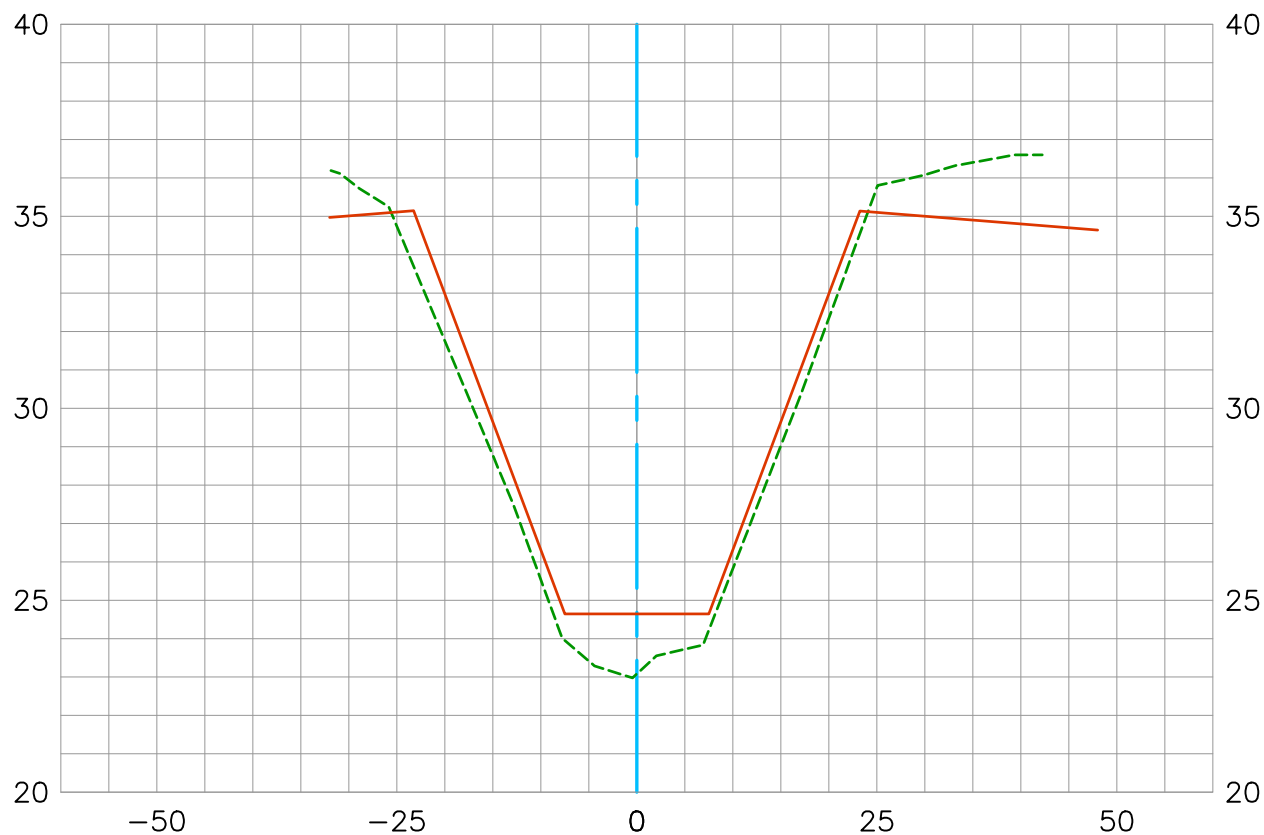

Existing Condition 2019 ---
Record As-Built Plan (1959) ---
Construction Centerline ---


Horizontal Scale 1"=20'
Vertical Scale 1"=5'

DATE PREPARED: 11/12/2019



BOLSA CHICA CHANNEL (C02)

357+00.00
CL

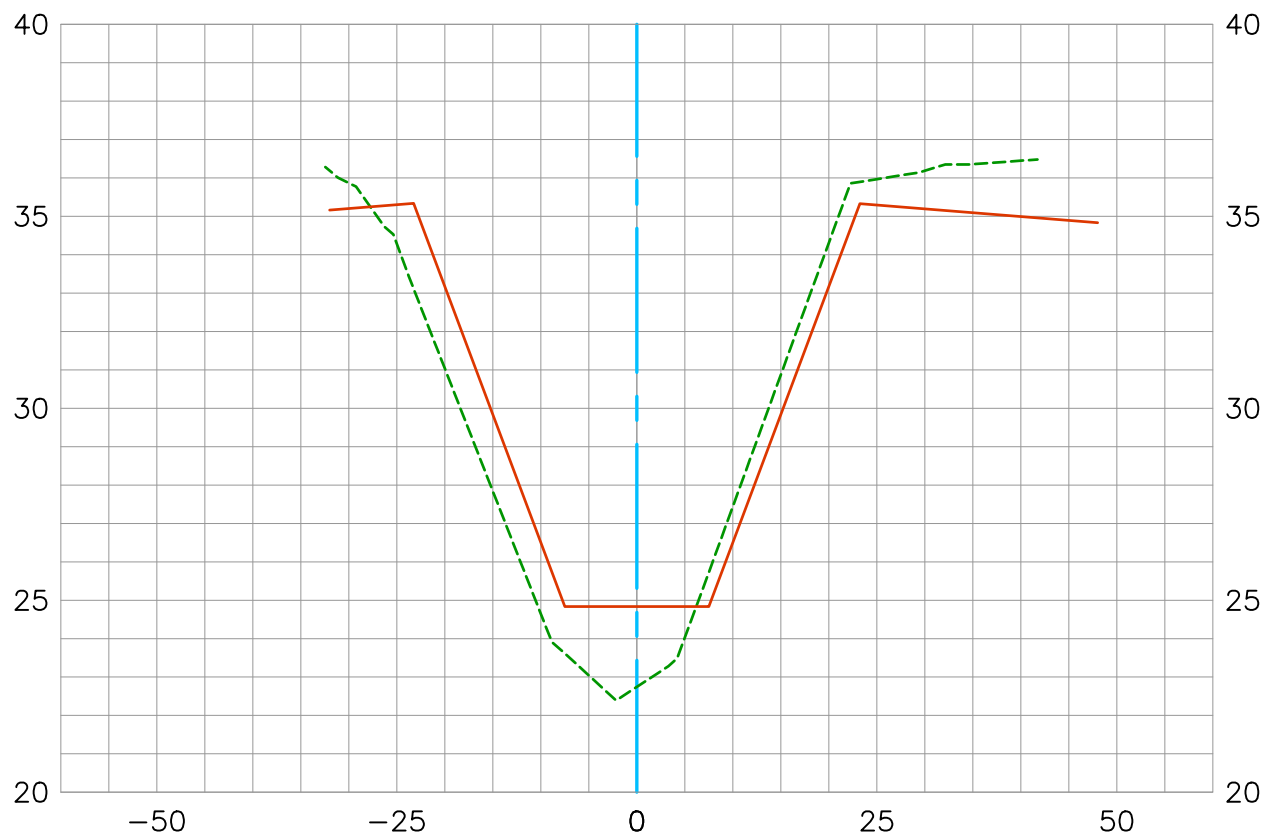

Existing Condition 2019 ---
Record As-Built Plan (1959) ---
Construction Centerline ---

Horizontal Scale 1"=20'
Vertical Scale 1"=5'


DATE PREPARED: 11/12/2019

U.S. Survey Foot

OC Public Works/Engineering Services
OC Survey/Field Services
Boundary Analysis & Mapping

BOLSA CHICA CHANNEL (C02)

357+50.00
CL

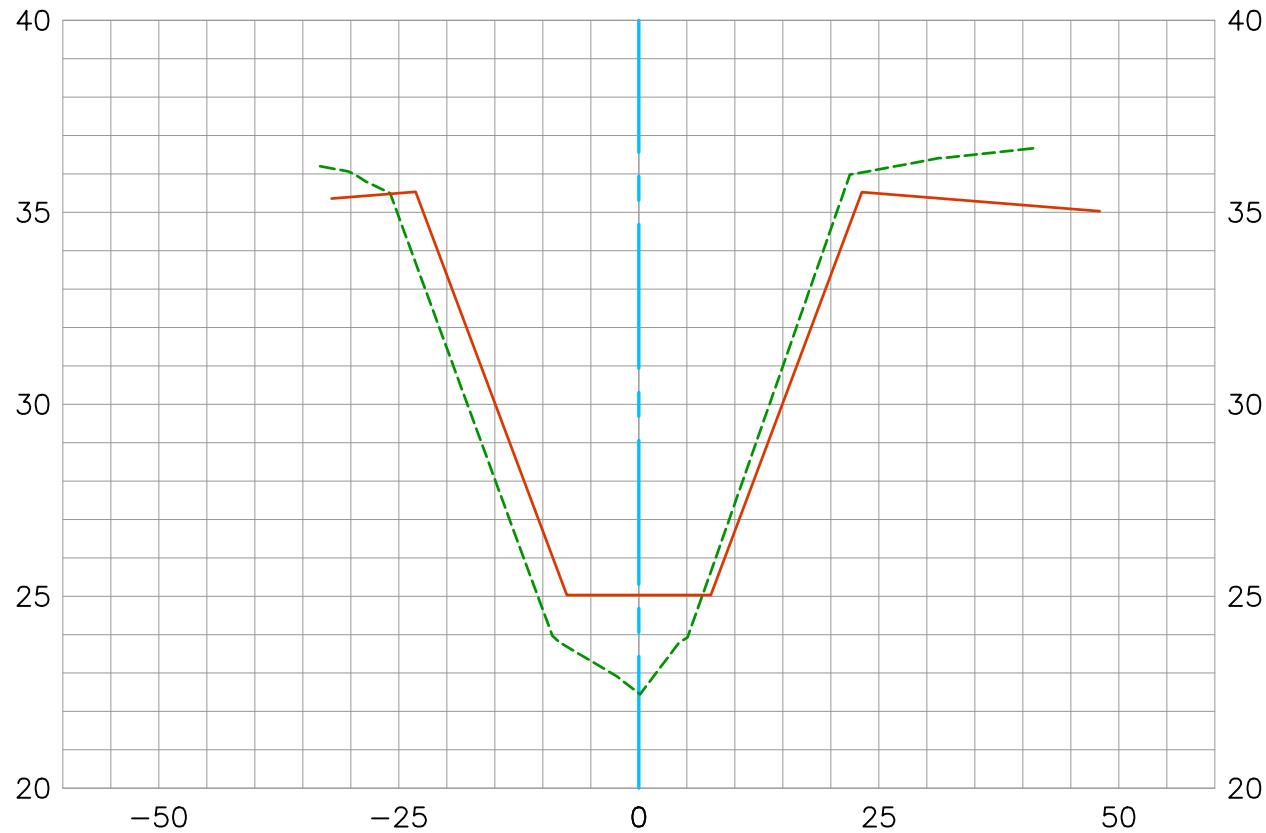

Existing Condition 2019 ---
Record As-Built Plan (1959) ---
Construction Centerline ---

Horizontal Scale 1"=20'
Vertical Scale 1"=5'

DATE PREPARED: 11/12/2019


U.S. Survey Foot

OC Public Works/Engineering Services
OC Survey/Field Services
Boundary Analysis & Mapping



BOLSA CHICA CHANNEL (C02)

358+00.00
CL

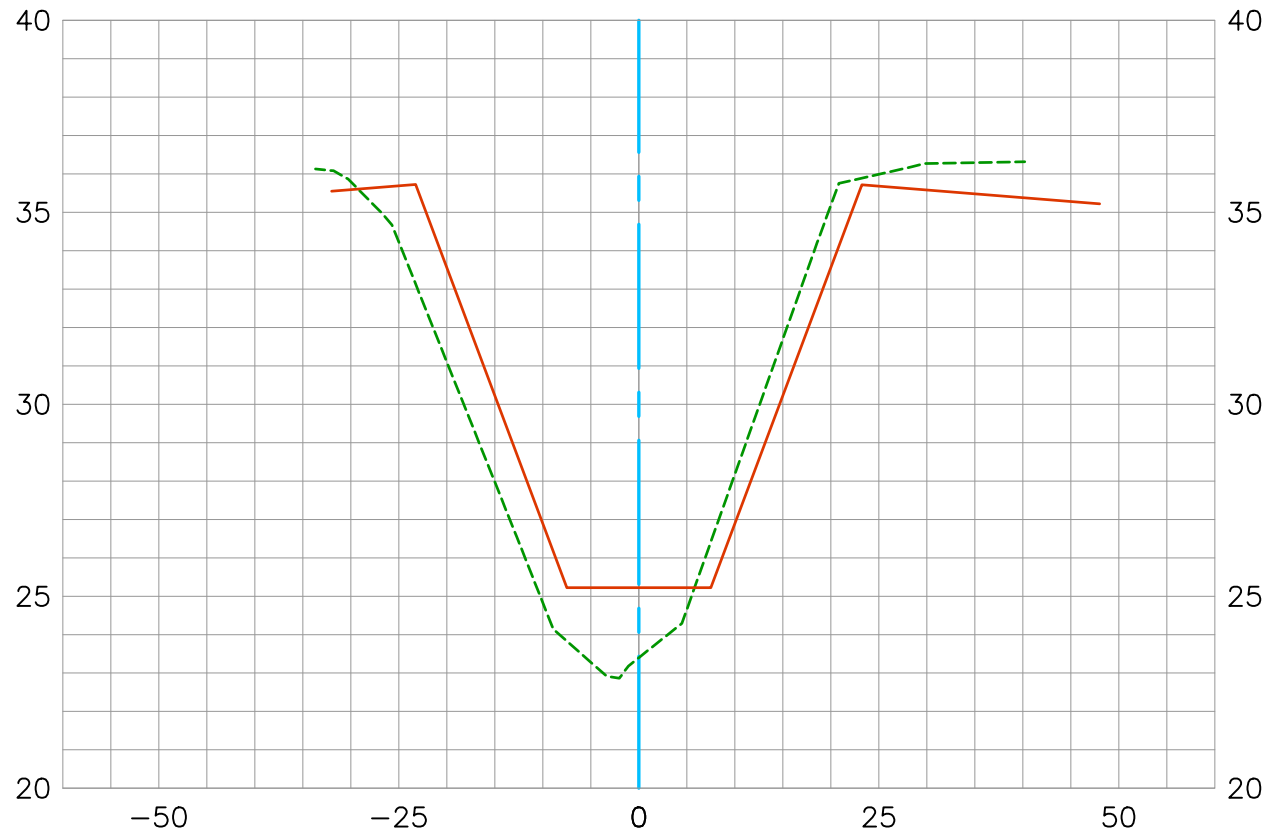

Existing Condition 2019 ---
Record As-Built Plan (1959) ---
Construction Centerline ---


Horizontal Scale 1"=20'
Vertical Scale 1"=5'

DATE PREPARED: 11/12/2019



BOLSA CHICA CHANNEL (C02)

358+50.00
CL

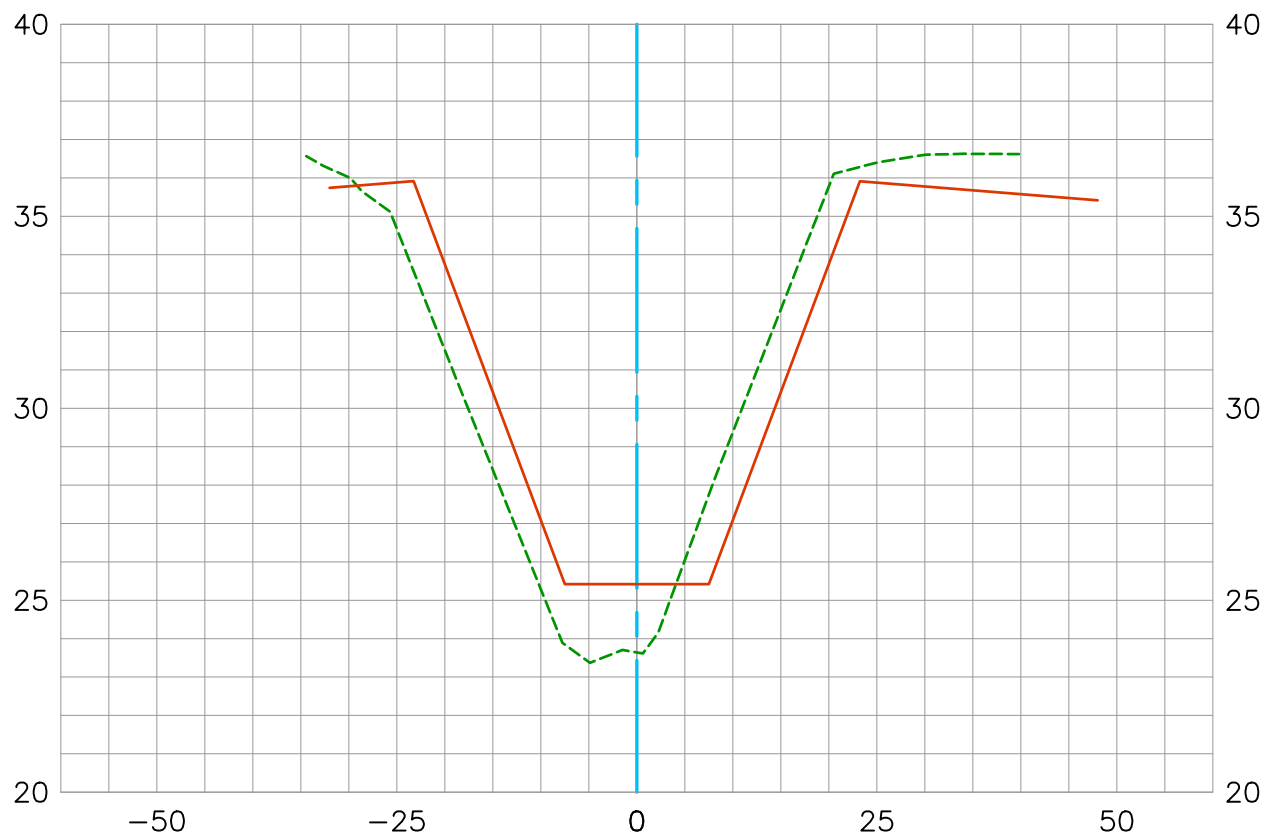

Existing Condition 2019 ---
Record As-Built Plan (1959) ---
Construction Centerline ---

Horizontal Scale 1"=20'
Vertical Scale 1"=5'

DATE PREPARED: 11/12/2019


U.S. Survey Foot

OC Public Works/Engineering Services
OC Survey/Field Services
Boundary Analysis & Mapping



BOLSA CHICA CHANNEL (C02)

359+00.00
CL

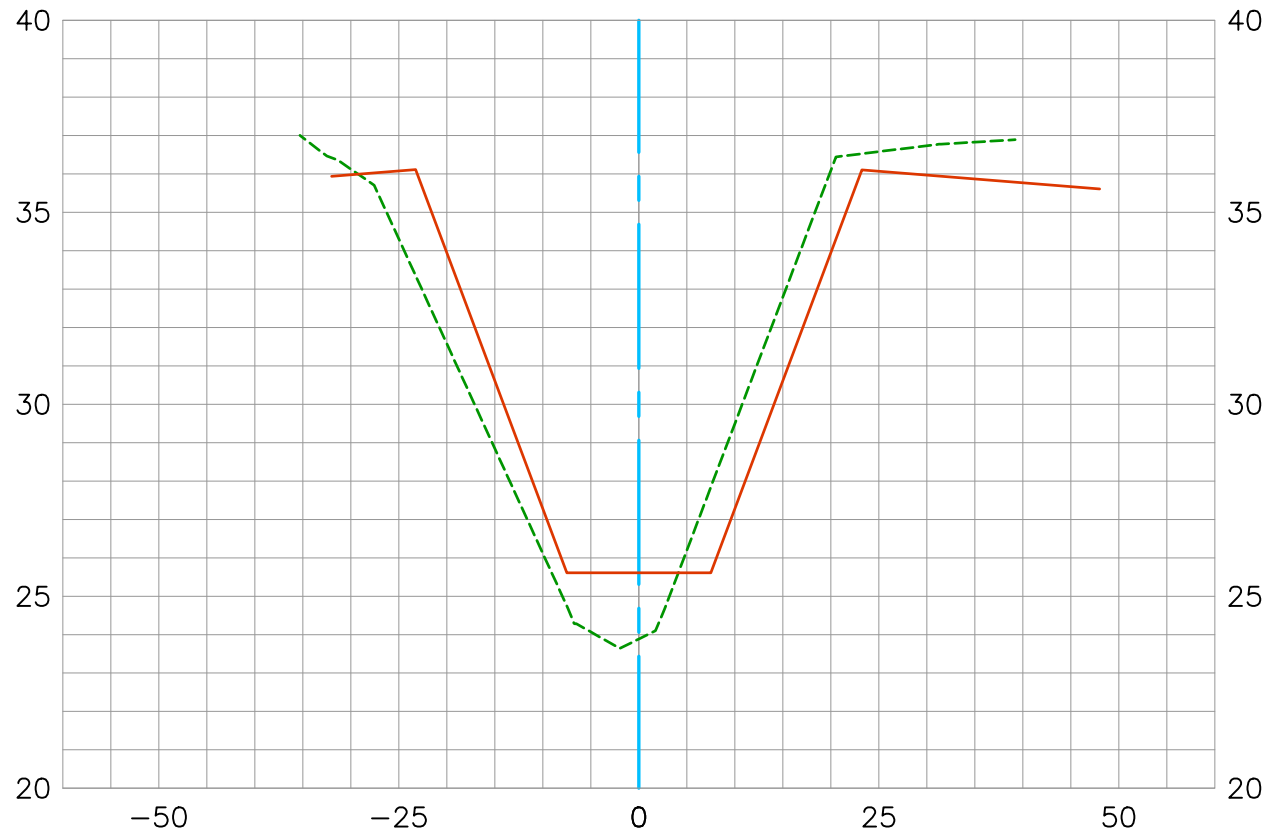

Existing Condition 2019 ---
Record As-Built Plan (1959) ---
Construction Centerline ---

Horizontal Scale 1"=20'
Vertical Scale 1"=5'

DATE PREPARED: 11/12/2019


U.S. Survey Foot

OC Public Works/Engineering Services
OC Survey/Field Services
Boundary Analysis & Mapping



BOLSA CHICA CHANNEL (C02)

359+50.00
CL

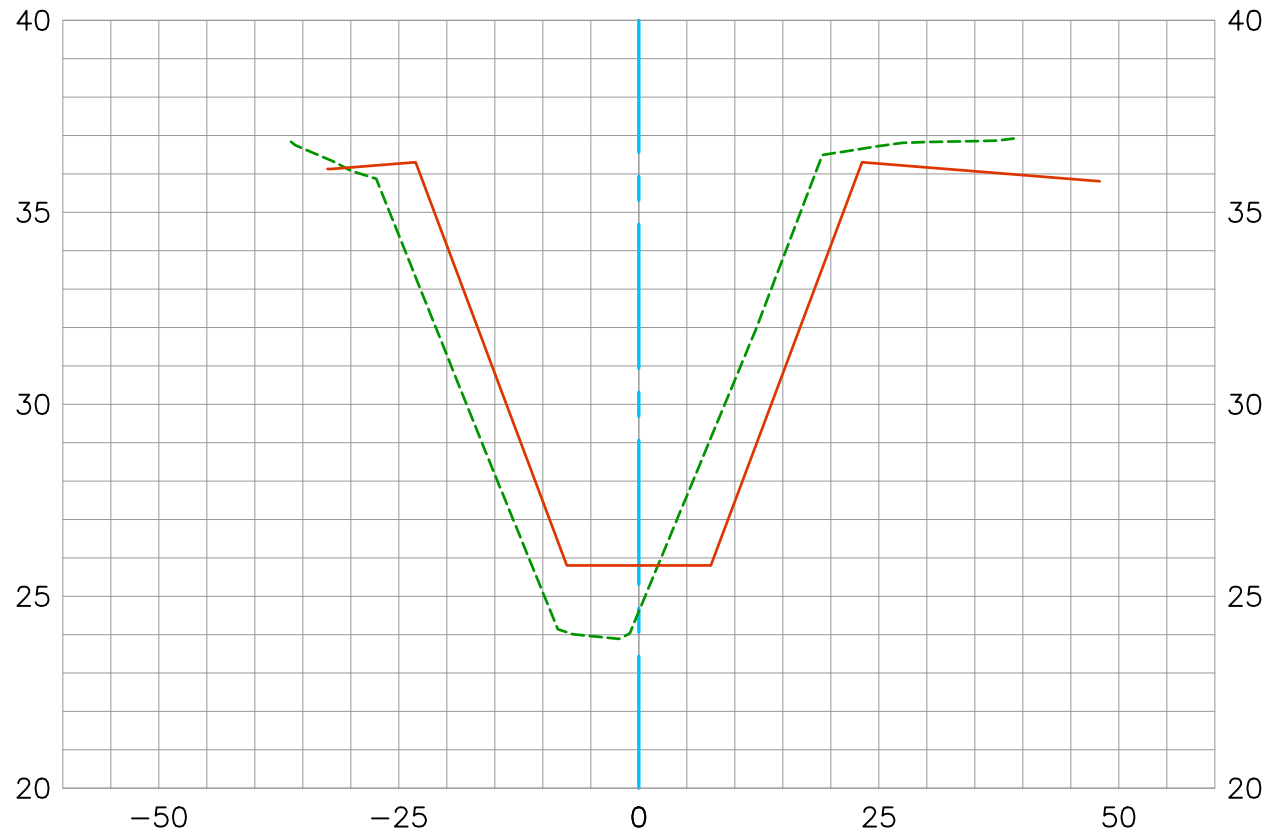

Existing Condition 2019 ---
Record As-Built Plan (1959) ---
Construction Centerline ---

Horizontal Scale 1"=20'
Vertical Scale 1"=5'

DATE PREPARED: 11/12/2019


U.S. *Survey
Foot*

OC Public Works/Engineering Services
OC Survey/Field Services
Boundary Analysis & Mapping

BOLSA CHICA CHANNEL (C02)

360+00.00

CL

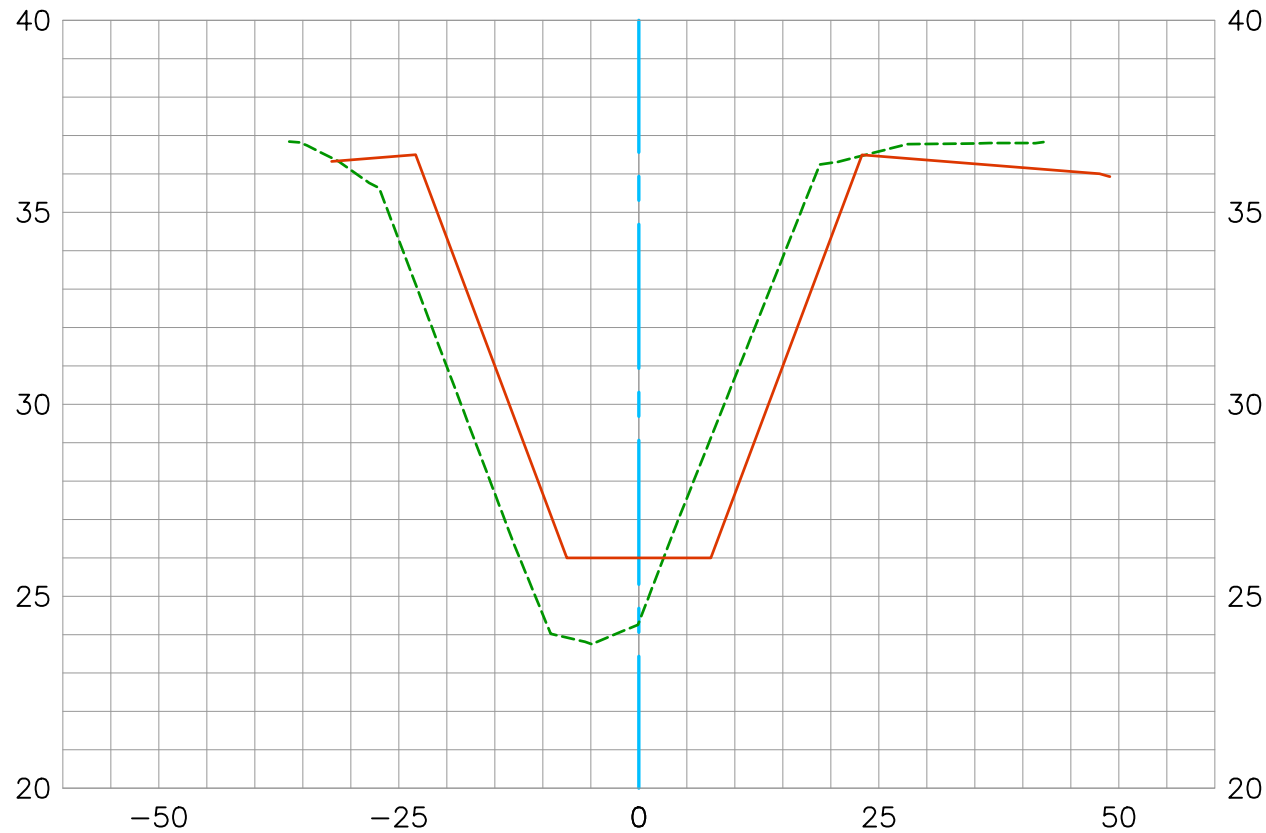

Existing Condition 2019 ---
Record As-Built Plan (1959) ---
Construction Centerline ---

Horizontal Scale 1"=20'
Vertical Scale 1"=5'


DATE PREPARED: 11/12/2019

U.S. *Survey
Foot*

OC Public Works/Engineering Services
OC Survey/Field Services
Boundary Analysis & Mapping

BOLSA CHICA CHANNEL (C02)

360+50.00
CL

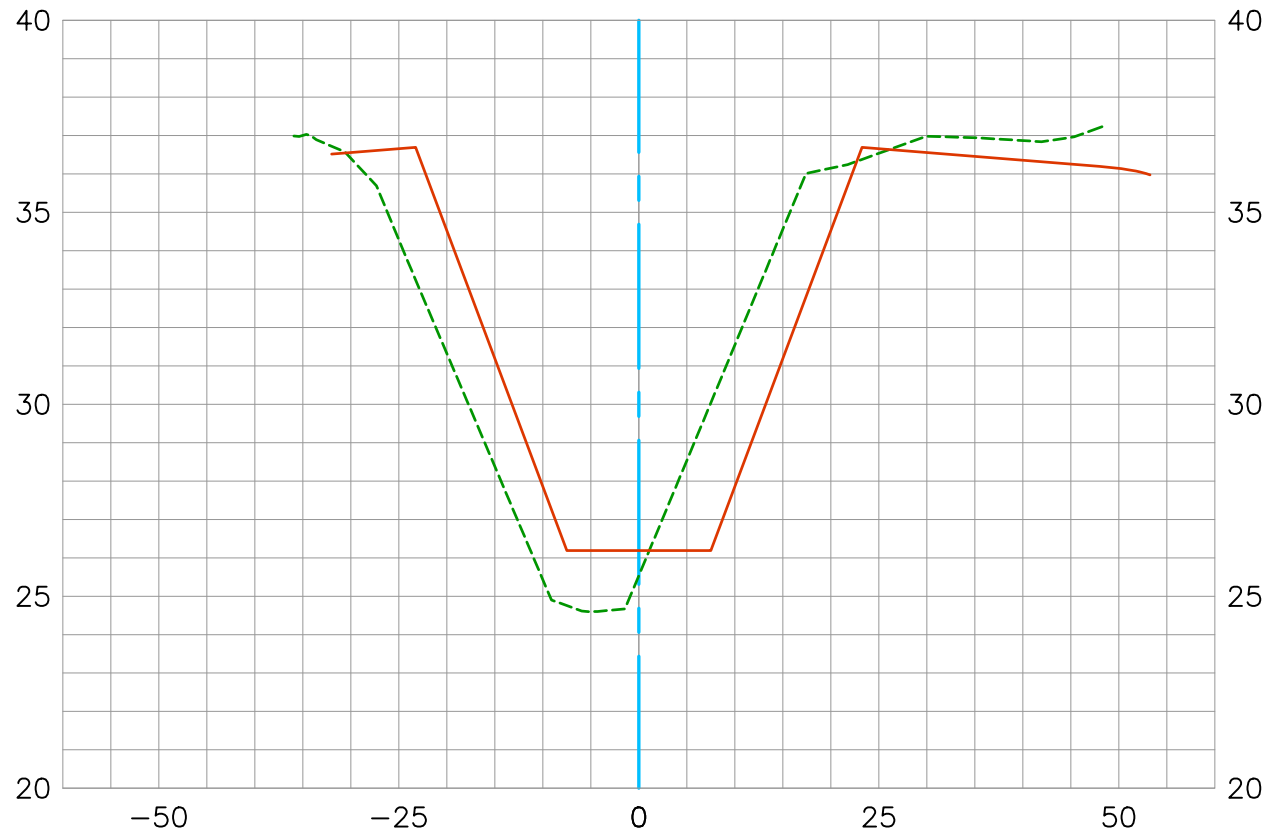

Existing Condition 2019 ---
Record As-Built Plan (1959) ---
Construction Centerline ---

Horizontal Scale 1"=20'
Vertical Scale 1"=5'


DATE PREPARED: 11/12/2019

U.S. *Survey
Foot*

OC Public Works/Engineering Services
OC Survey/Field Services
Boundary Analysis & Mapping



BOLSA CHICA CHANNEL (C02) 361+00.00 CL

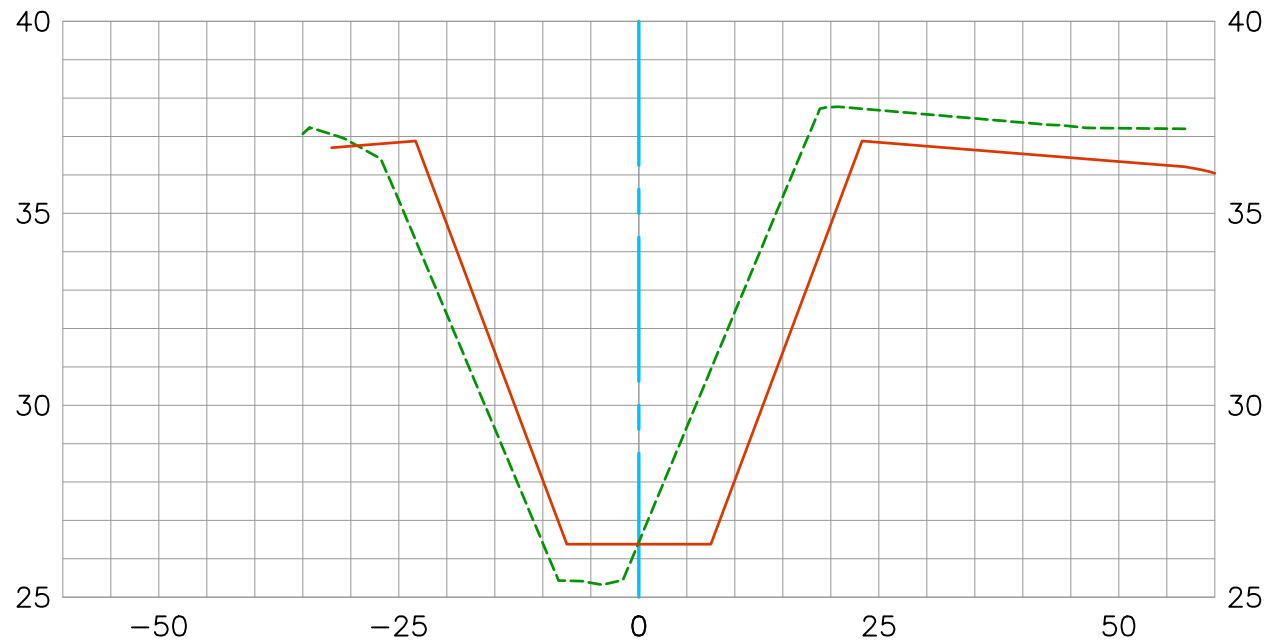

Existing Condition 2019 ---
Record As-Built Plan (1959) —
Construction Centerline ---

Horizontal Scale 1"=20'
Vertical Scale 1"=5'


DATE PREPARED: 11/12/2019

U.S. Survey Foot

OC Public Works/Engineering Services
OC Survey/Field Services
Boundary Analysis & Mapping



BOLSA CHICA CHANNEL (C02) 361+50.00 CL

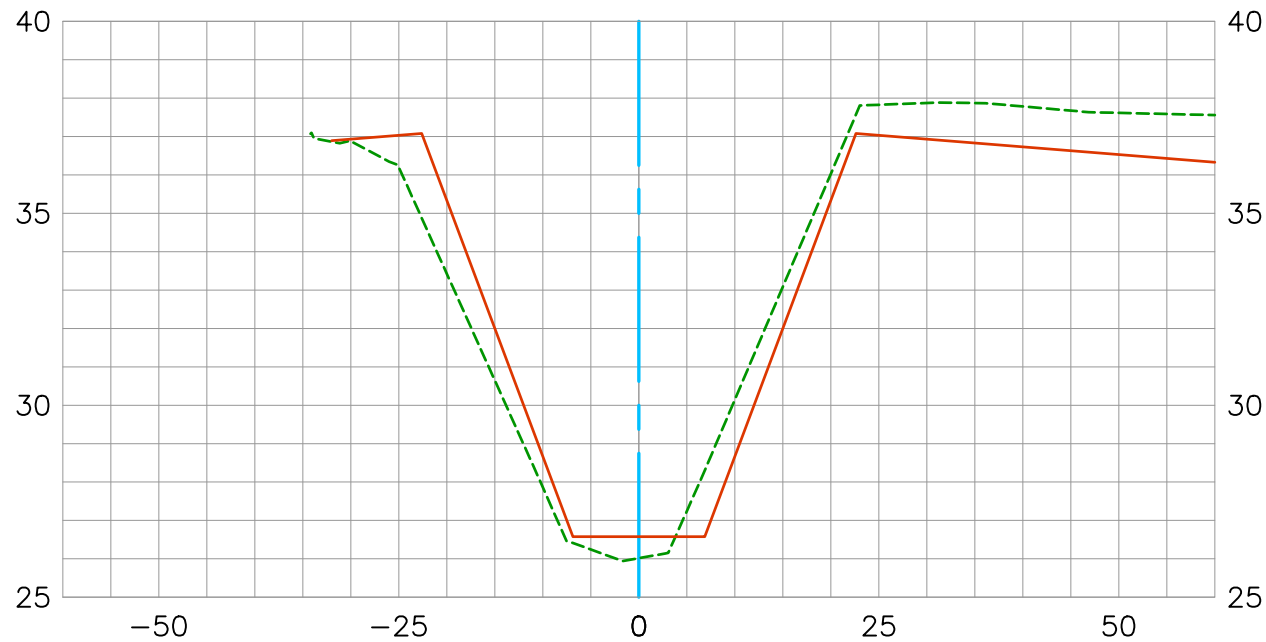

Existing Condition 2019 ---
Record As-Built Plan (1959) ---
Construction Centerline ---

Horizontal Scale 1"=20'
Vertical Scale 1"=5'


DATE PREPARED: 11/12/2019

U.S. *Survey
Foot*

OC Public Works/Engineering Services
OC Survey/Field Services
Boundary Analysis & Mapping



BOLSA CHICA CHANNEL (C02)
361+87.25
@ CONCRETE STRUCTURE
CL

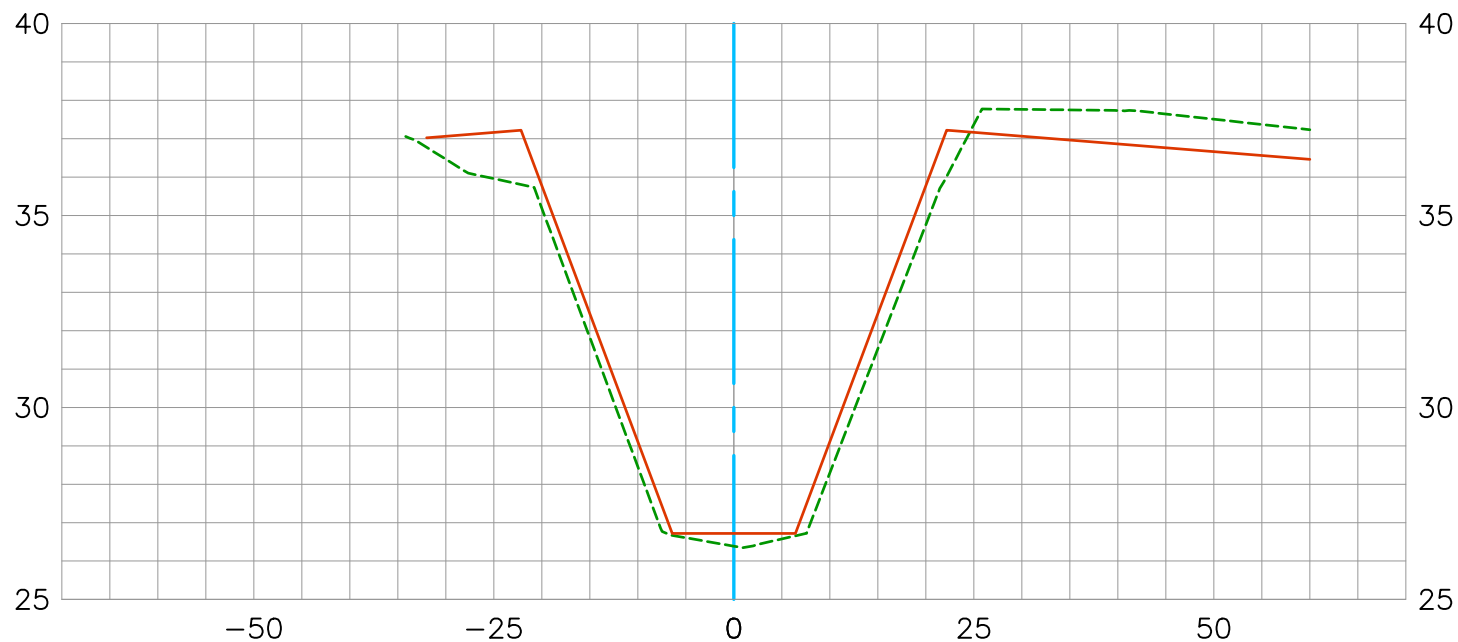

Existing Condition 2019 - - - - -
Record As-Built Plan (1959) —————
Construction Centerline —————

Horizontal Scale 1"=20'
Vertical Scale 1"=5'

DATE PREPARED: 11/12/2019