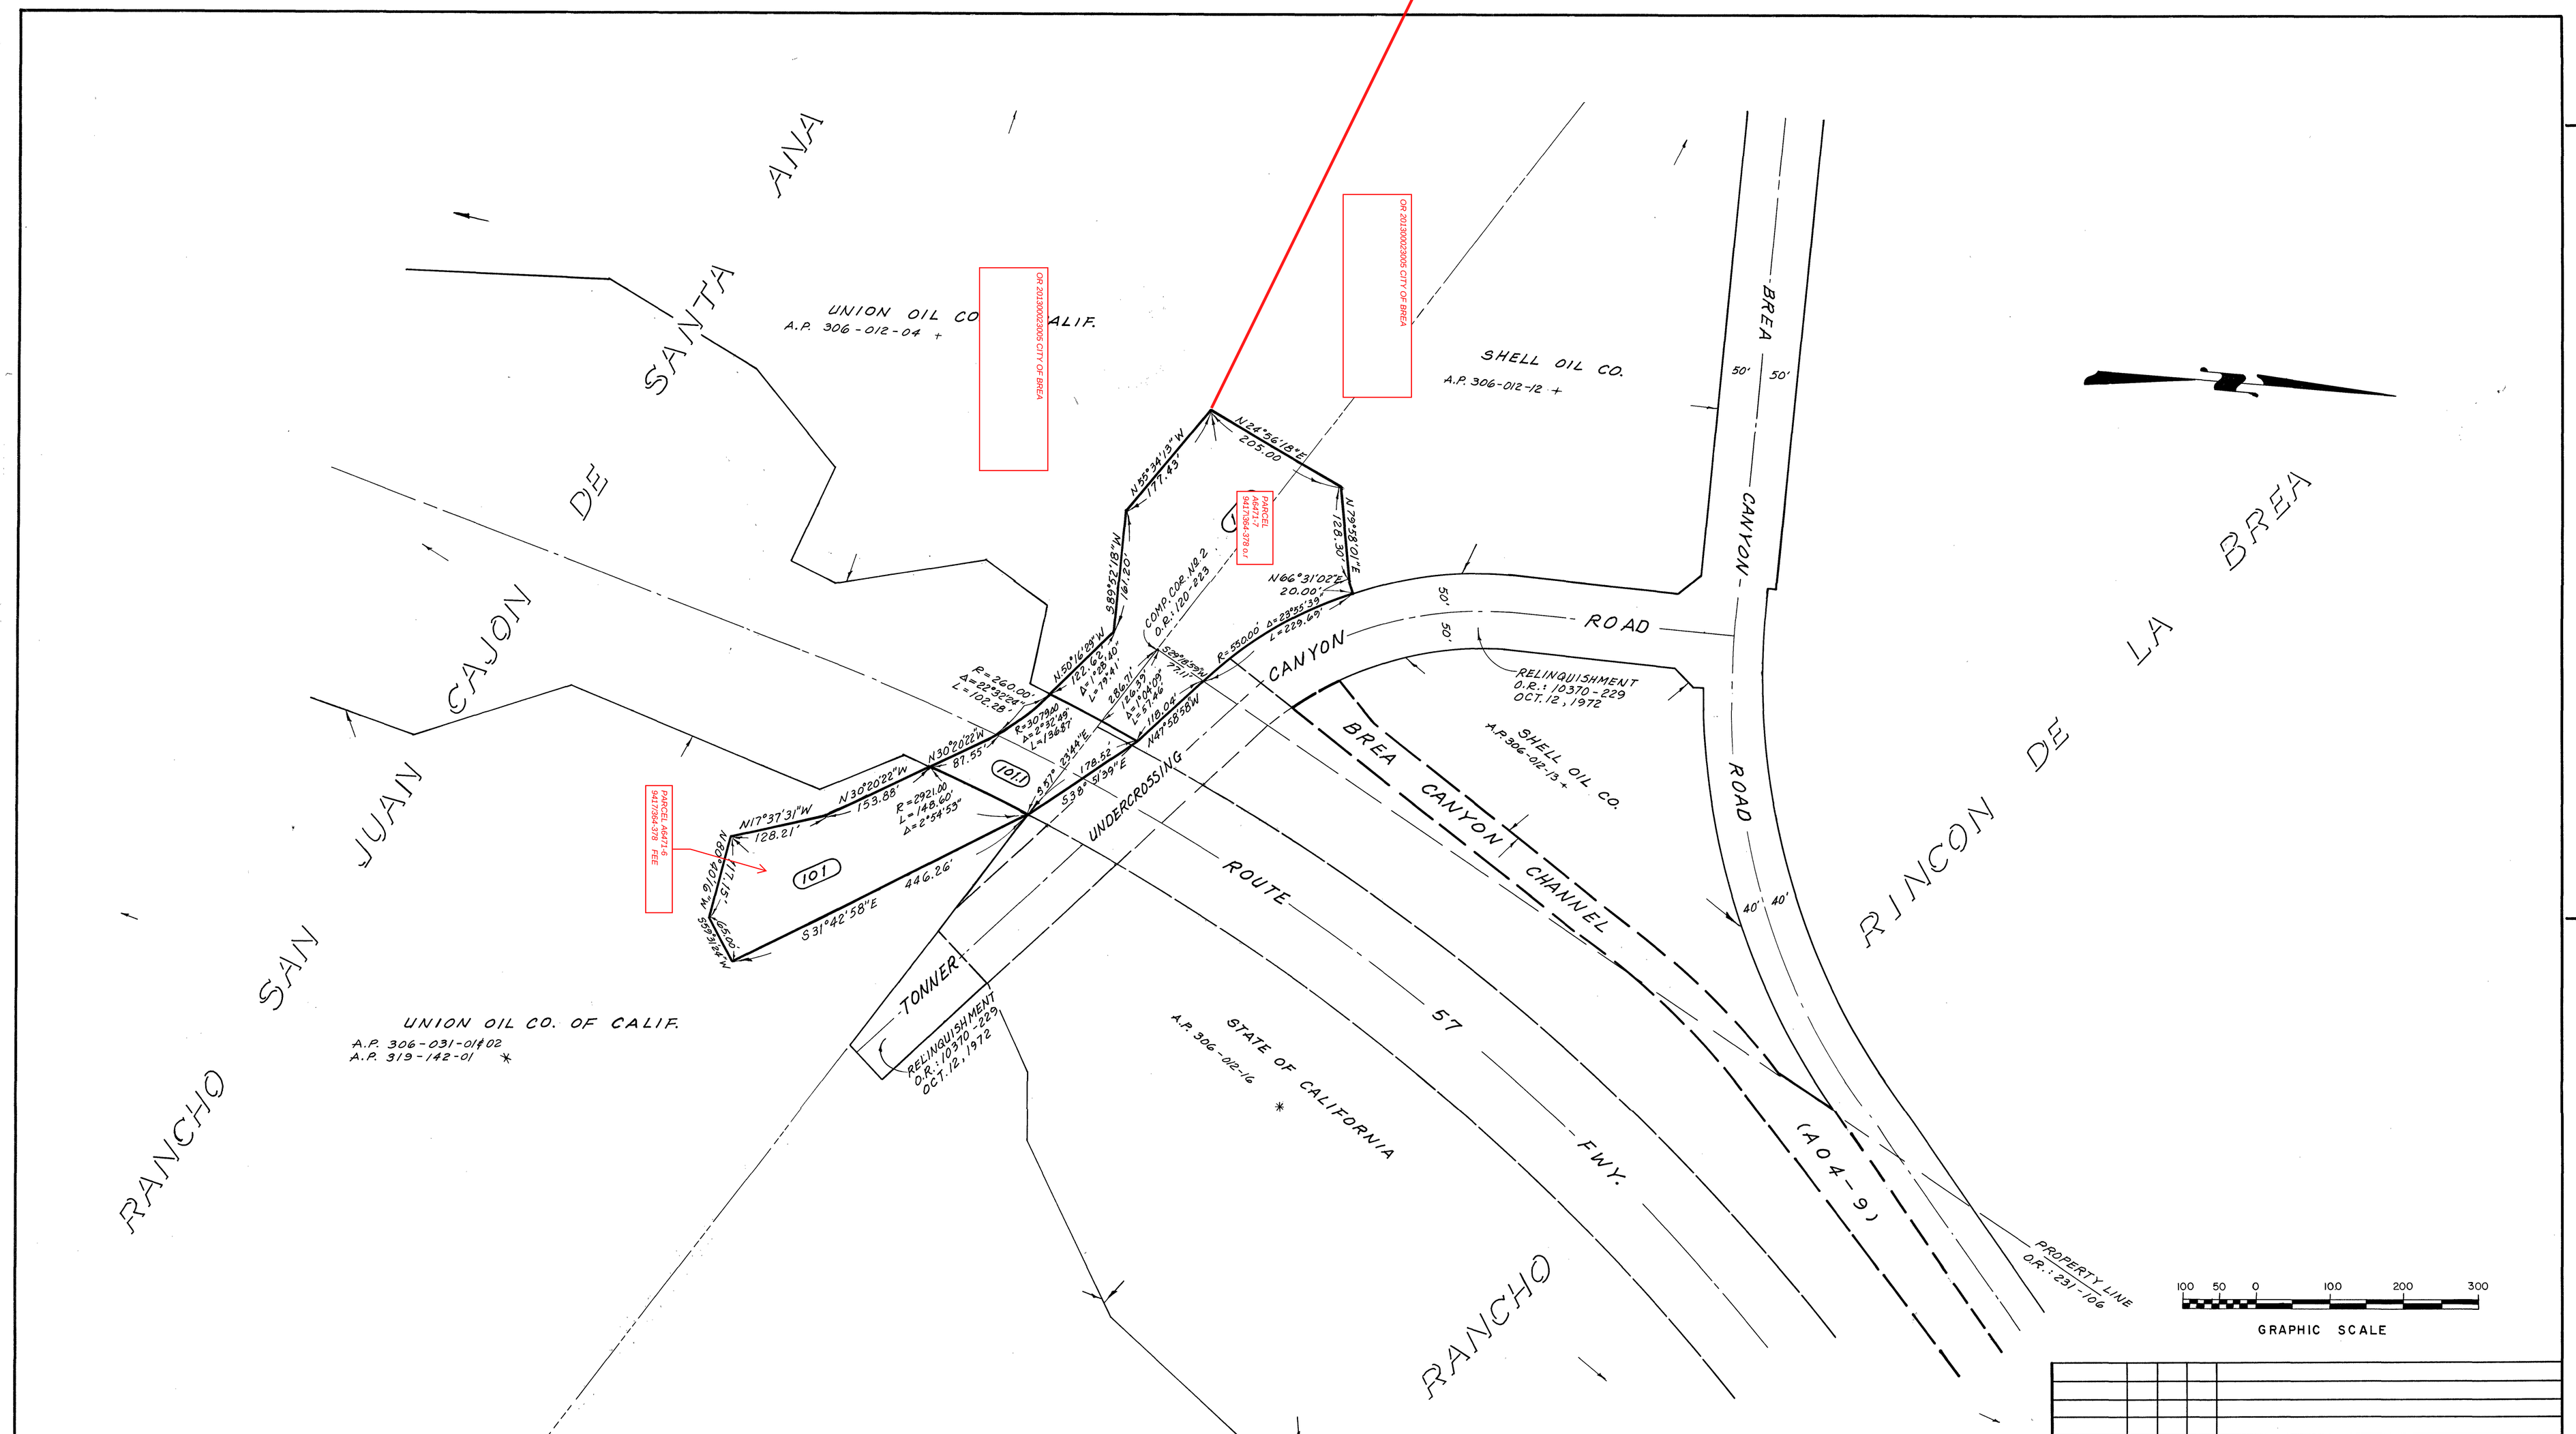

DATE	BY	CK'D.	APP.	REVISIONS

ORANGE COUNTY ENVIRONMENTAL MANAGEMENT AGENCY

PREPARED BY RIGHT OF WAY ENGINEERING SECTION

RIGHT OF WAY MAP

TONNER CANYON CHANNEL

PARCEL NO.	GRANTOR	GRANTEE	PARCEL AREA (NET)	OFFICIAL RECORDS	O.R. DATE	ESTATE	REMARKS
101.1	CAL TRANS					E	
101	CAL TRANS					F	

PREPARED	CHECKED	SCALE	DATE	
R.S.W.		1" = 100'	JULY, 1982	A09-1