

AOR057E

BLK

6450

6550

ORA-

LA7

FORM 10-64

2

0019

STATE OF CALIFORNIA
DEPARTMENT OF PUBLIC WORKS
DIVISION OF HIGHWAYS
DISTRICT 07

PAGE 1 OF 2

INDEX

PRELIMINARY SURVEY NOTE TITLE SHEET

66-146

Co. RTE. PM. ORA 57 19.8/22.6 SURVEY REQ. No. 66-0146

DATE BEGIN SURVEY 5-24-66

EXPEND. AUTH. 032201 COMPLETE 6-22-66

CHARGE UNIT 07208 FIELD SUPR. Mastro

SURVEY REQ. BY Shiga Naga (Des B) CHIEF OF PARTY McCullough

TYPE OF SURVEY ALIGNMENT

LOCATION OF SURVEY along Brea Cyn. Rd. from Tonner Rd.
to L.A. Co. lineSURVEY DESCRIPTION AND PURPOSE ALIGNMENT for X-sections
and design purposes

PRECISION OF SURVEY 1:10000

REFERENCE MATERIAL PARTY-COR McCullough

CCM 54.2 NOTES McCullough - Gray

AS4.001-16, 17 INSTMAN Pizzo

CHAIN Todorovich

ROD McLelland

INSTRUMENTS

TAPE No. &

CALIBRATION

NOTES REVIEWED BY C. Mastro (SUPERVISOR) (OFFICE)

CROSS REFERENCES

INFORMATION PUT ON C.C.M. OR BENCH SUMMARY

ADDITIONAL INFORMATION

SURVEY NOTES

ORA 57
Brea Cyn Rd.
032201

Alignment

ORA → BLK 6450 MOD 96.97,
BLK 6550 MOD 07.08.
JUN 66
McGulough & Ray McGulough

A	B	C				
			1.	2.	3.	4.
1. 43-00-00	1. 0-28-00	1. 1-17-00				
3. 128-50-50	3. 1-22-40	3. 3-50-00				
6. 257-57-30	6. 2-45-00	6. 7-39-50				
M. 42-59-35	M. 0-27-30	M. 1-16-38				

Nothing Fd
Set CN Beg.
X-Section at
Sta 602

B.C. Assumed
Sta. 62+24.19
Nothing Fd
Set sg. spk per
record dist.

719+6750 "P" POT =
69+7463 Ec. Ora. Sta.
Fd RR Spk dno-
Per AS4.001-17

722+8901 "P" PI #43 =
7249623 ORA SHIT
Fd Na. 1 IN 2" IP
dno- Per AS4.001-17

734+5028 "P" PI #44
= 84+5750 Brea Cyn
Fd C. Spk 7' dno-
Per AS4.001-17

Set C. Na. 1
Sta 85+50
END X-Section.

PI #45 END
of "P" line
Fd 2" I.P.W. Th
Wood plug
Q Nd Na. 1 dno- 12

718+8988 "P" PI #42
Fd RR Spk dno-
ON Semi-tan. Brea
CYN Rd. Per AS4.001-17

PI
Fd Bolt in old point
Per CCM 542

AOR 057E

0020

5

SURVEY NOTES

City
County
Date

BLK
O.R.O. BLK 8450
L.A. BLK 0932
6550

ORA - 57-24⁵/28³
(BREA CANYON RD.)

ALIGNMENT NOTES (MONUMENTATION)
(5 PAGES)

SUPPLEMENTARY TO A53.001-1 to 12
Ties Before Resurfacing

W.O.
170013

JULY 1966

CAMP & PARTY

D. BURT

J. KETCHUM

J. GUISINGER

R. WILCOX

AOR057E

0021

3

1


2

TIES TO BREA CANYON
ROAD.

BLK 6450 MOD 82

7/26/66
DWD
J. L. D. & P. T. V.

Willcox 26

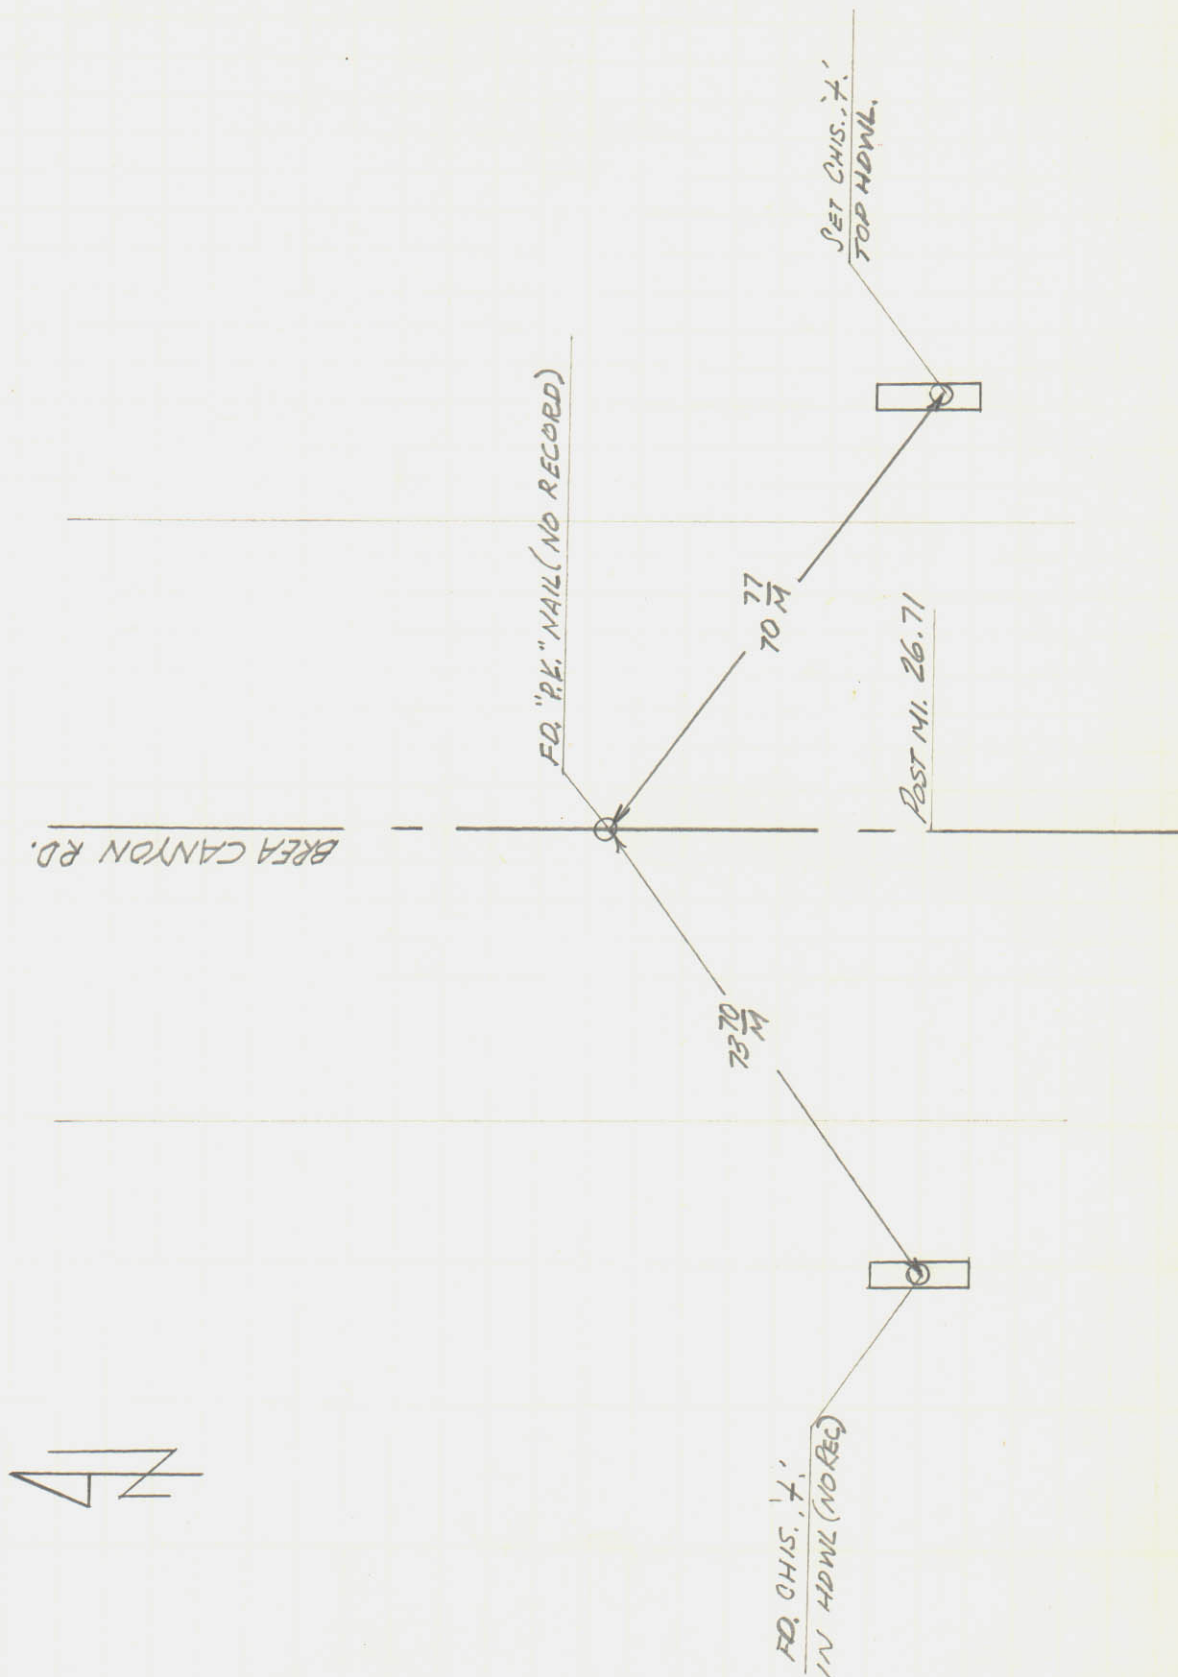

②

TIES TO BREA CANYON


ROAD

7/66
Adrian

46

11/20/04

Blk 6450 Mod 97

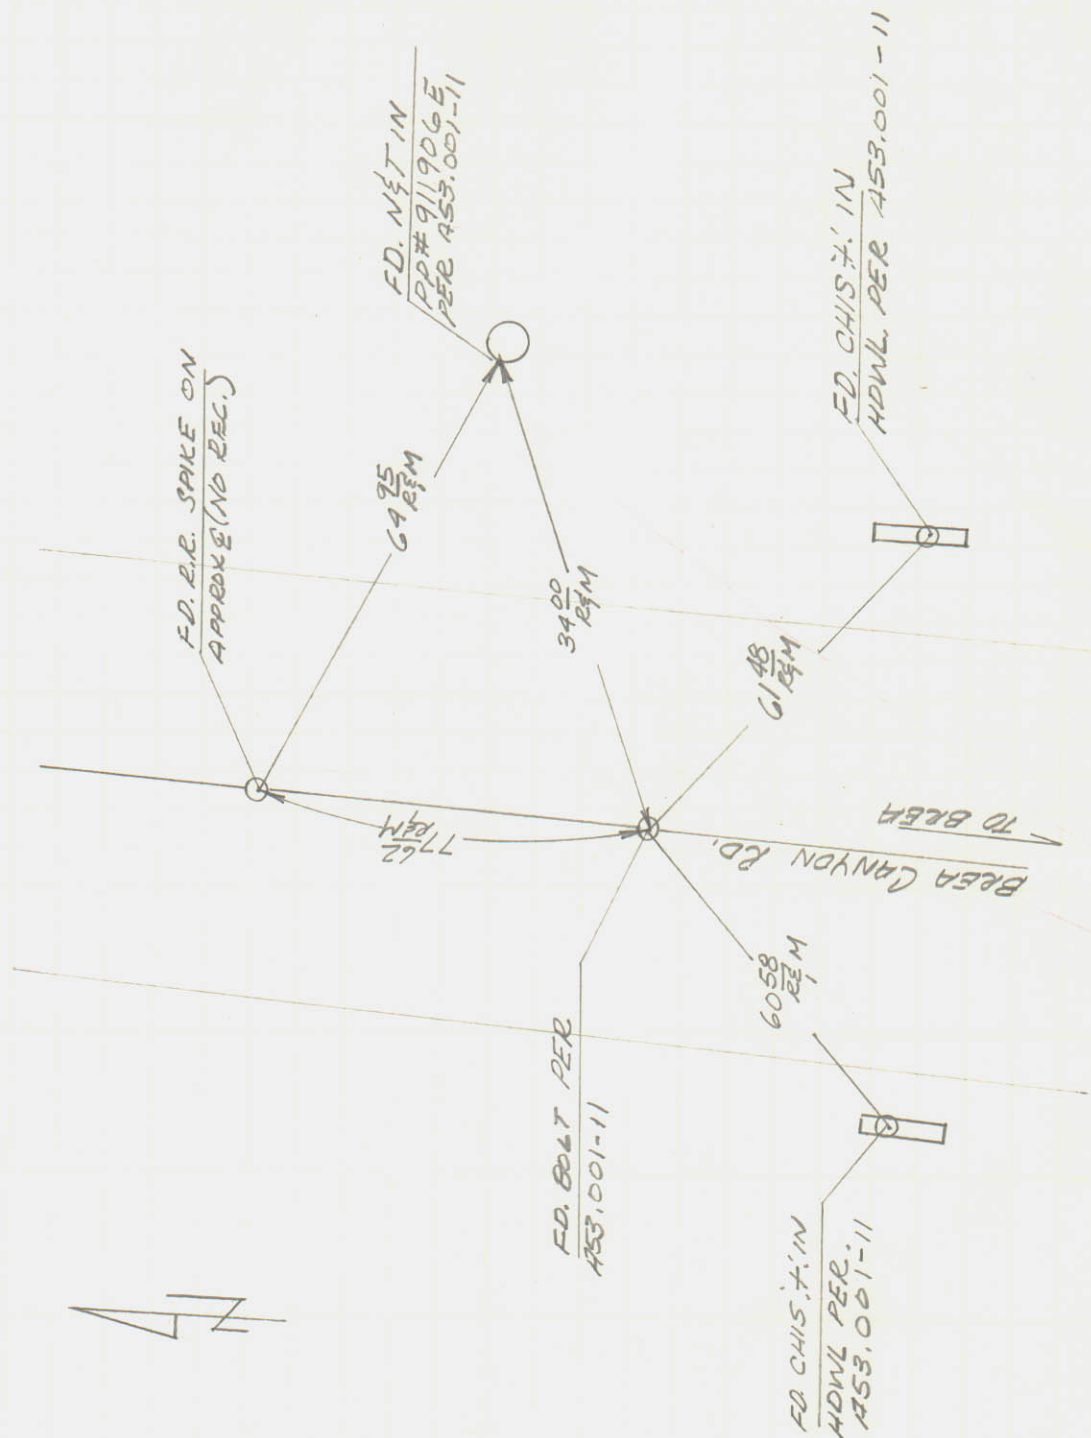

②

SURVEY NOTES

CRA 57


TIES TO BREA CANYON ROAD

BLK 6450 MOD 96

7/66 CAMP & PTY.

WILCOX 3 6

(2)

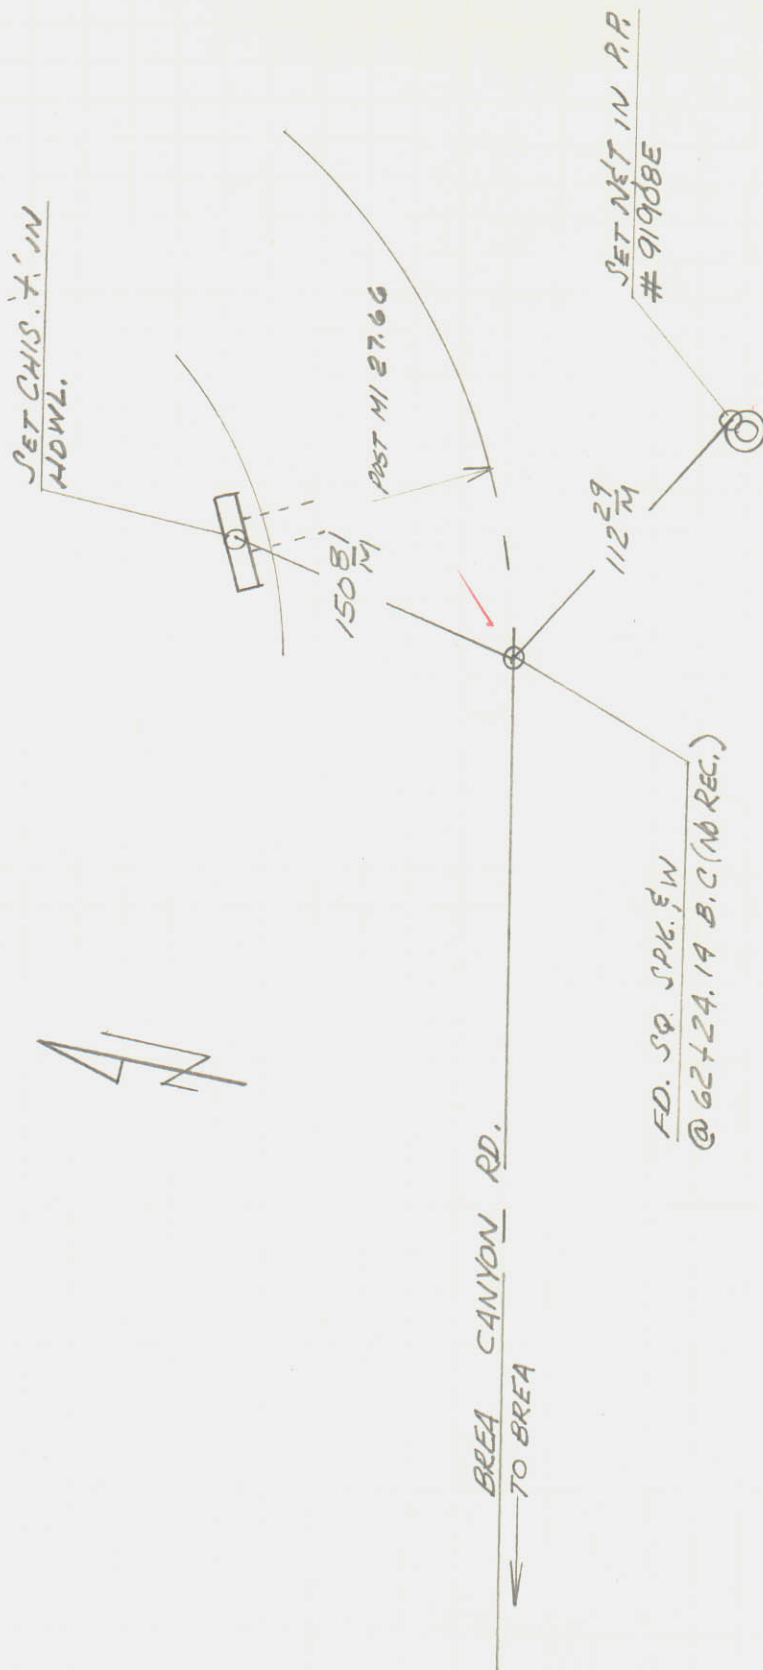

AOR057E

0023.

(7)

SURVEY NOTES

ORA 57

TIES TO BREA CANYON

ROAD

BLK 6550 MOD 68

7-66

CAMP PTY


WILCOX

5 6

(2)

AOR057E

0025.

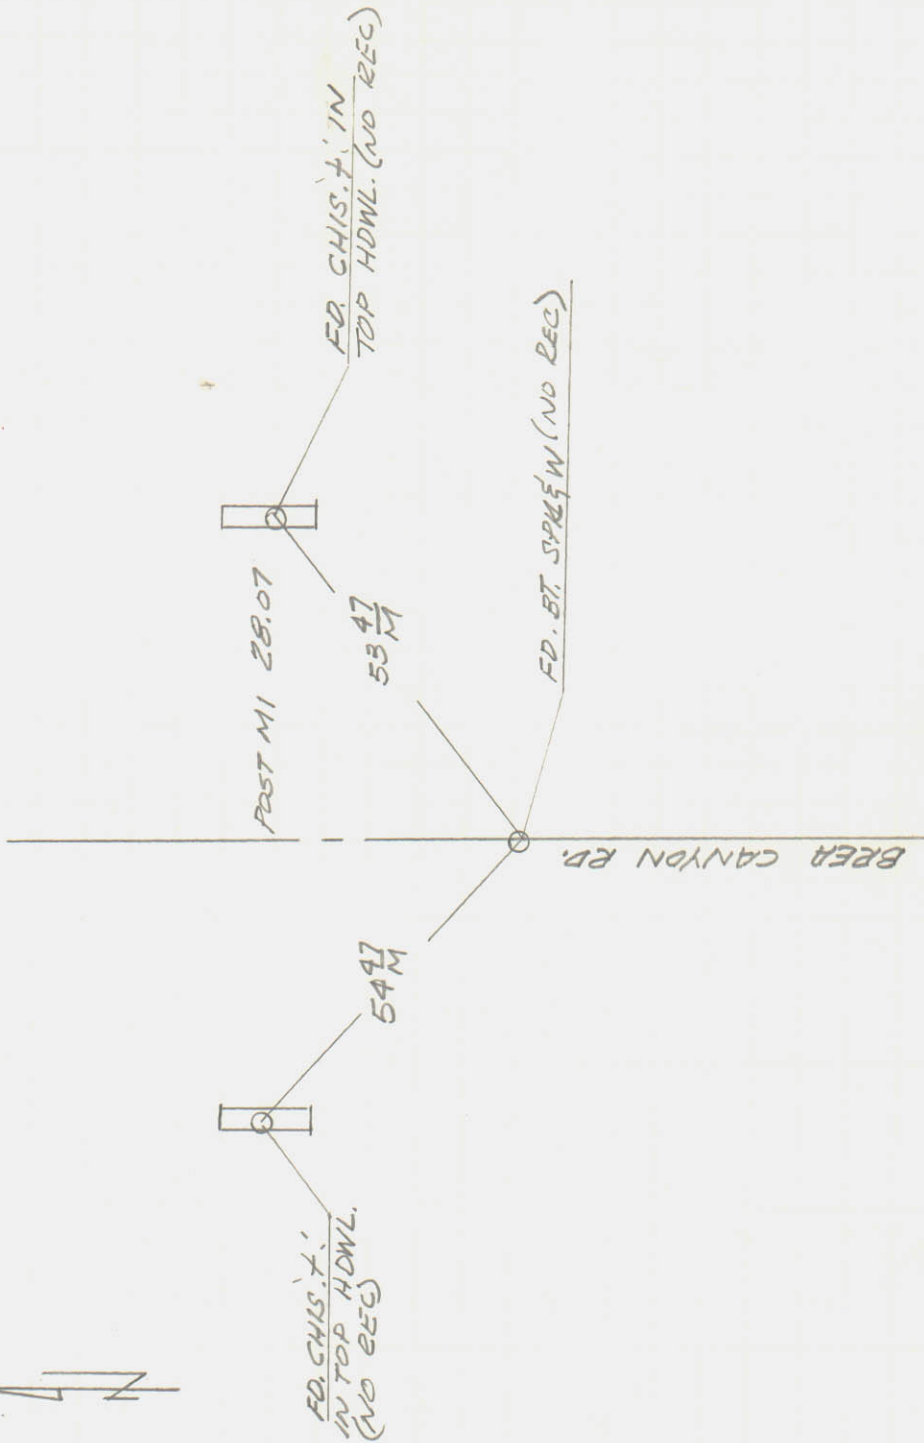

(2)

SURVEY NOTES

ORA 57 sec 14

TIES TO BREA CANYON

ROAD

LA → BLK 0932 MOD 37

ORA → BLK 6550 MOD 08, 18

7-66

CAMP PTY

6 6

WILCOX

(2)

AOR 057E

0026

(1)

