
CORN	ER RE	COR	Agency In Documen			022-3403
City of UNINC	ORPORATED TER	RITORY	County of		-	, California
Brief Legal Descript			-			+/- 1006' NE'LY OF
Die Zegal Zeeenpt		ANYON RD CORNER	TYPE			IATES (Optional)
	Governmen	nt Corner 🔲		levation		
	Meander		Property U	nits	Metric	U.S. Survey Foot 🔀
	Rancho		Other	orizontal Datu		
	Date of Survey	11-03-2022				Date
			□ c	omplies with P	ublic Resou	urces Code §§8801-8819 urces Code §§8890-8902
PLS Act Ref: 🔲 8	3765(d)	⊠ 8771	8773			Other:
	eft as found ound and tagged	☐ Establishe ☐ Reestablis		uilt renced		Pre-Construction Post-Construction
MEASURED DISTANCI REDUNDANT LEAST PER CHAPTERS 5 & BY 1.00000607. RECORD DISTANCES	EREON ARE ASSUME ES SHOWN HEREON S SQUARES NETWORK 11 OF THE OC SUR	ARE GRID DISTAN ADJUSTMENT. AL RVEY STANDARDS E AS THEY APPE	NCES, DERIVED BY LL POINTS WERE EI S MANUAL.TO OBTA EAR ON THE DOCU	INVERSE FRO THER TRAVER IN A GROUND MENT OF REC	M POSITION SED THROU DISTANCE ORD. DISTA	NS ESTABLISHED BY A FUI JGH OR DOUBLE DETERMIN , MULTIPLY A GRID DISTAI ANCES MAY BE EITHER GR TANCE
	SURV	EYOR'S STATE	EMENT			SED LAND SUPLED OF THE SET OF THE
	ecord was prepared al Land Surveyors'.	-	r my direction in c 11-15-202		with	امرا)
Signed	Milital		P.L.S.)or R.C.E			NO. 8036 NO.
	COUNTY S	URVEYOR'S S	TATEMENT			- ANG
This Corner Re	ecord was received.		11-15-2022			SED LAND SUPLA
and examined			2-24-2023			SED LAND SUPPLED AND SUPPLED A
Signed	Michael to Fon	taine	P.L.S.)or R.C.E	. No. <u>8970</u>		
Title	DEPUTY COUNTY	SURVEYOR	-			NO. 8970 NO. 8970 NO. 8970
County Survey	vor's Comment					

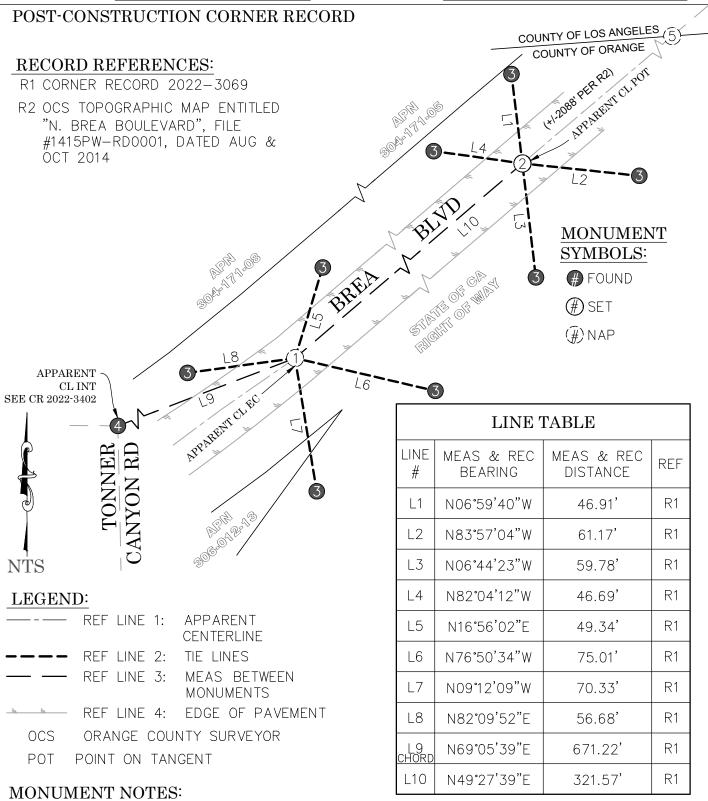

- (1) SFN; MONUMENT WILL NOT BE RESET; TIES SHOWN ARE TO COMPUTED POSITION OF MONUMENT AS FD PRE-CONST, SAID MONUMENT BEING A PK NAIL WITH NO VALID REF
- 2 SFN; SET SPIKE & 1-1/2" WSHR STMPD "OCS", FLUSH IN AC, PER TIES AS SHOWN HEREON
- 3 FD 1"IP & 3/4" TAG STMPD "OCS TIE", PER R1, DN 0.3' IN DIRT
- 4 FD MONUMENT AS DESCRIBED ON ADJACENT CORNER RECORD
- (5) APPARENT INT WITH COUNTY LINE: NOT SEARCHED FOR, NOT A PART OF THIS SURVEY (NAP)