


113 FD CHIS. 'X' IN CONC. V-GUTTER NO REF.

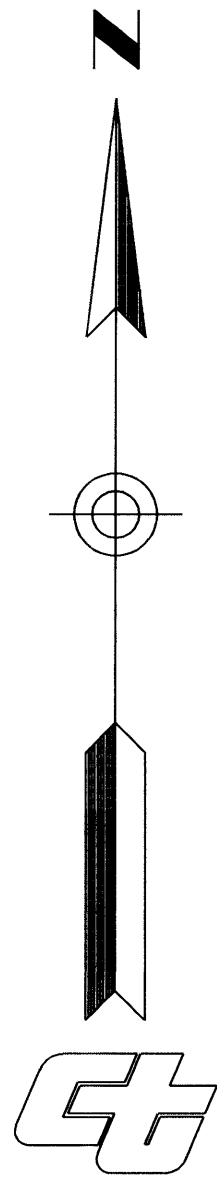

112 FD PUNCHED SPIKE W/WASHER STAMPED "LS 2304" DN 0.12M PER PMB 207/45-46

CORNER OF TR. 5446
FD 2" I.P., TACK AND TAG STAMPED
"RCE 8793", DN 0.7M PER MM 206/7-10

N'LY LINE S.W.1/4 N.E.1/4
FRAC. SEC. 12, T35, R10W, SBW

SM0677

© = DIRECTOR'S DEED DD16471-05-01
INST. NO. 84-453159

- ▲ = FOUND MONUMENT AS NOTED
- = SET 2" I.P. TACK WITH BRASS TAG, PER SR 03-019 DN. 0.15M
- = SET LEAD, TACK, AND TAG STAMPED "CALTRANS" PER SR 03-019
- = SET MONUMENT AS NOTED PER SR 03-019

PT. #	DESCRIPTION	NORTH	EASTING
57 FREEWAY

STATE R/W

STATE R/W

SCALE = 1:5000:1

VICINITY MAP
CITY OF BREA

UNINCORPORATED COUNTY
OF ORANGE

NO SCALE

TRACT NO. 8820
MM 454/19-24

PARCEL 2
PMB 68/18

FD 6" I.P. W/BRASS DISC
STAMPED "U. O. CO STEARNS
NO. 5 LS1968" FLUSH PER
RSB 91-1007 RSB 133/41-46

FD 3" I.P. W/IRON CAP STAMPED
"UNION OIL CO. OF CA." UP 0.1M
PER RSB 12/40

107

SM0677

FD 3" I.P. W/IRON CAP STAMPED
"UNION OIL CO. OF CA." UP 0.15M
PER RSB 12/40

Ⓐ = DIRECTOR'S DEED DD16471-01-01
PAR. 2, 10953/742 O.R.

STATE PARCEL A6471-4
9417/364 O.R.


Ⓑ = DIRECTOR'S DEED DD16471-01-01
PAR. 1, 10953/742 O.R.

STATE PARCEL A6471-6
9417/364 O.R.

THE PURPOSE OF THIS SURVEY IS TO SHOW THE
LOCATION OF MONUMENTS FOUND AND SET ALONG
THE RIGHT OF WAY OF SR 057 BETWEEN THE NORTH
LINE OF TR 5446 AND TONNER CANYON
PER SURVEY REQUEST 03-019.

THE COORDINATES SHOWN HEREON ARE BASED ON
THE NAD 83 DATUM. THE COORDINATES SHOWN
HEREON ARE BASED ON THE NAD 83 DATUM. THE
DIMENSIONS SHOWN HEREON ARE GRID DISTANCES. TO OBTAIN
GROUND DISTANCES MULTIPLY THE DISTANCES SHOWN BY 1.00000651.

DISTRICT	COUNTY	ROUTE	POST MILES/KILOPOST	SHEET No.	OF
12	ORA	057	21.5-22.5/34.6-36.2	1	1

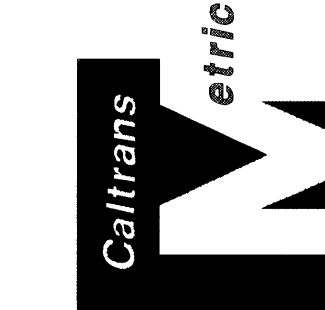

MONUMENTATION MAP MM ORA 057 22.0

FIELD CREW: M. GILBERT, R. RINELLA	DATE 10/03/2003
CALC. & COMPILED BY: W. APPLETON	
VISUALLY CK'D BY: D. FRANCIS	DELINEATED BY G. SCHENK
SENIOR: J. AYER	

102 6" CASTING W/NAIL STAMPED
"U. O. CO-8" L.O.C." UP 0.25M