

ORANGE COUNTY SURVEYOR

BROOKHURST STREET & BROADWAY

COUNTY SURVEY NO 6187

DATE

SURVEY BY

To both page 3

Ed. 4" 3pk an
line per T.B.
116-30. 5ft 3/4
I.P. 10" deep

1320.17

29.81

Ed. 3/4" I.P. 10" deep

West Broadway

1314.69 M
1320.99 T.B. 116-30

1 = 88° 52' 00"
3 = 266° 36' 10"
6 = 173° 13' 20"

Set standard County
Surveyor Mark in well

88° 52' 10" M

91° 07' 50" Lnk

1408.24 M
1410.8.30 T.B. 108-10

1333.69 M
1333.35 T.B. 108-10

Ed. NAT

To both Lincoln
per T.B. 108-47


Brookhurst

5 ft

ORANGE COUNTY SURVEYOR

SURVEY BY Rayburn DATE Aug 1973

SM 9-56

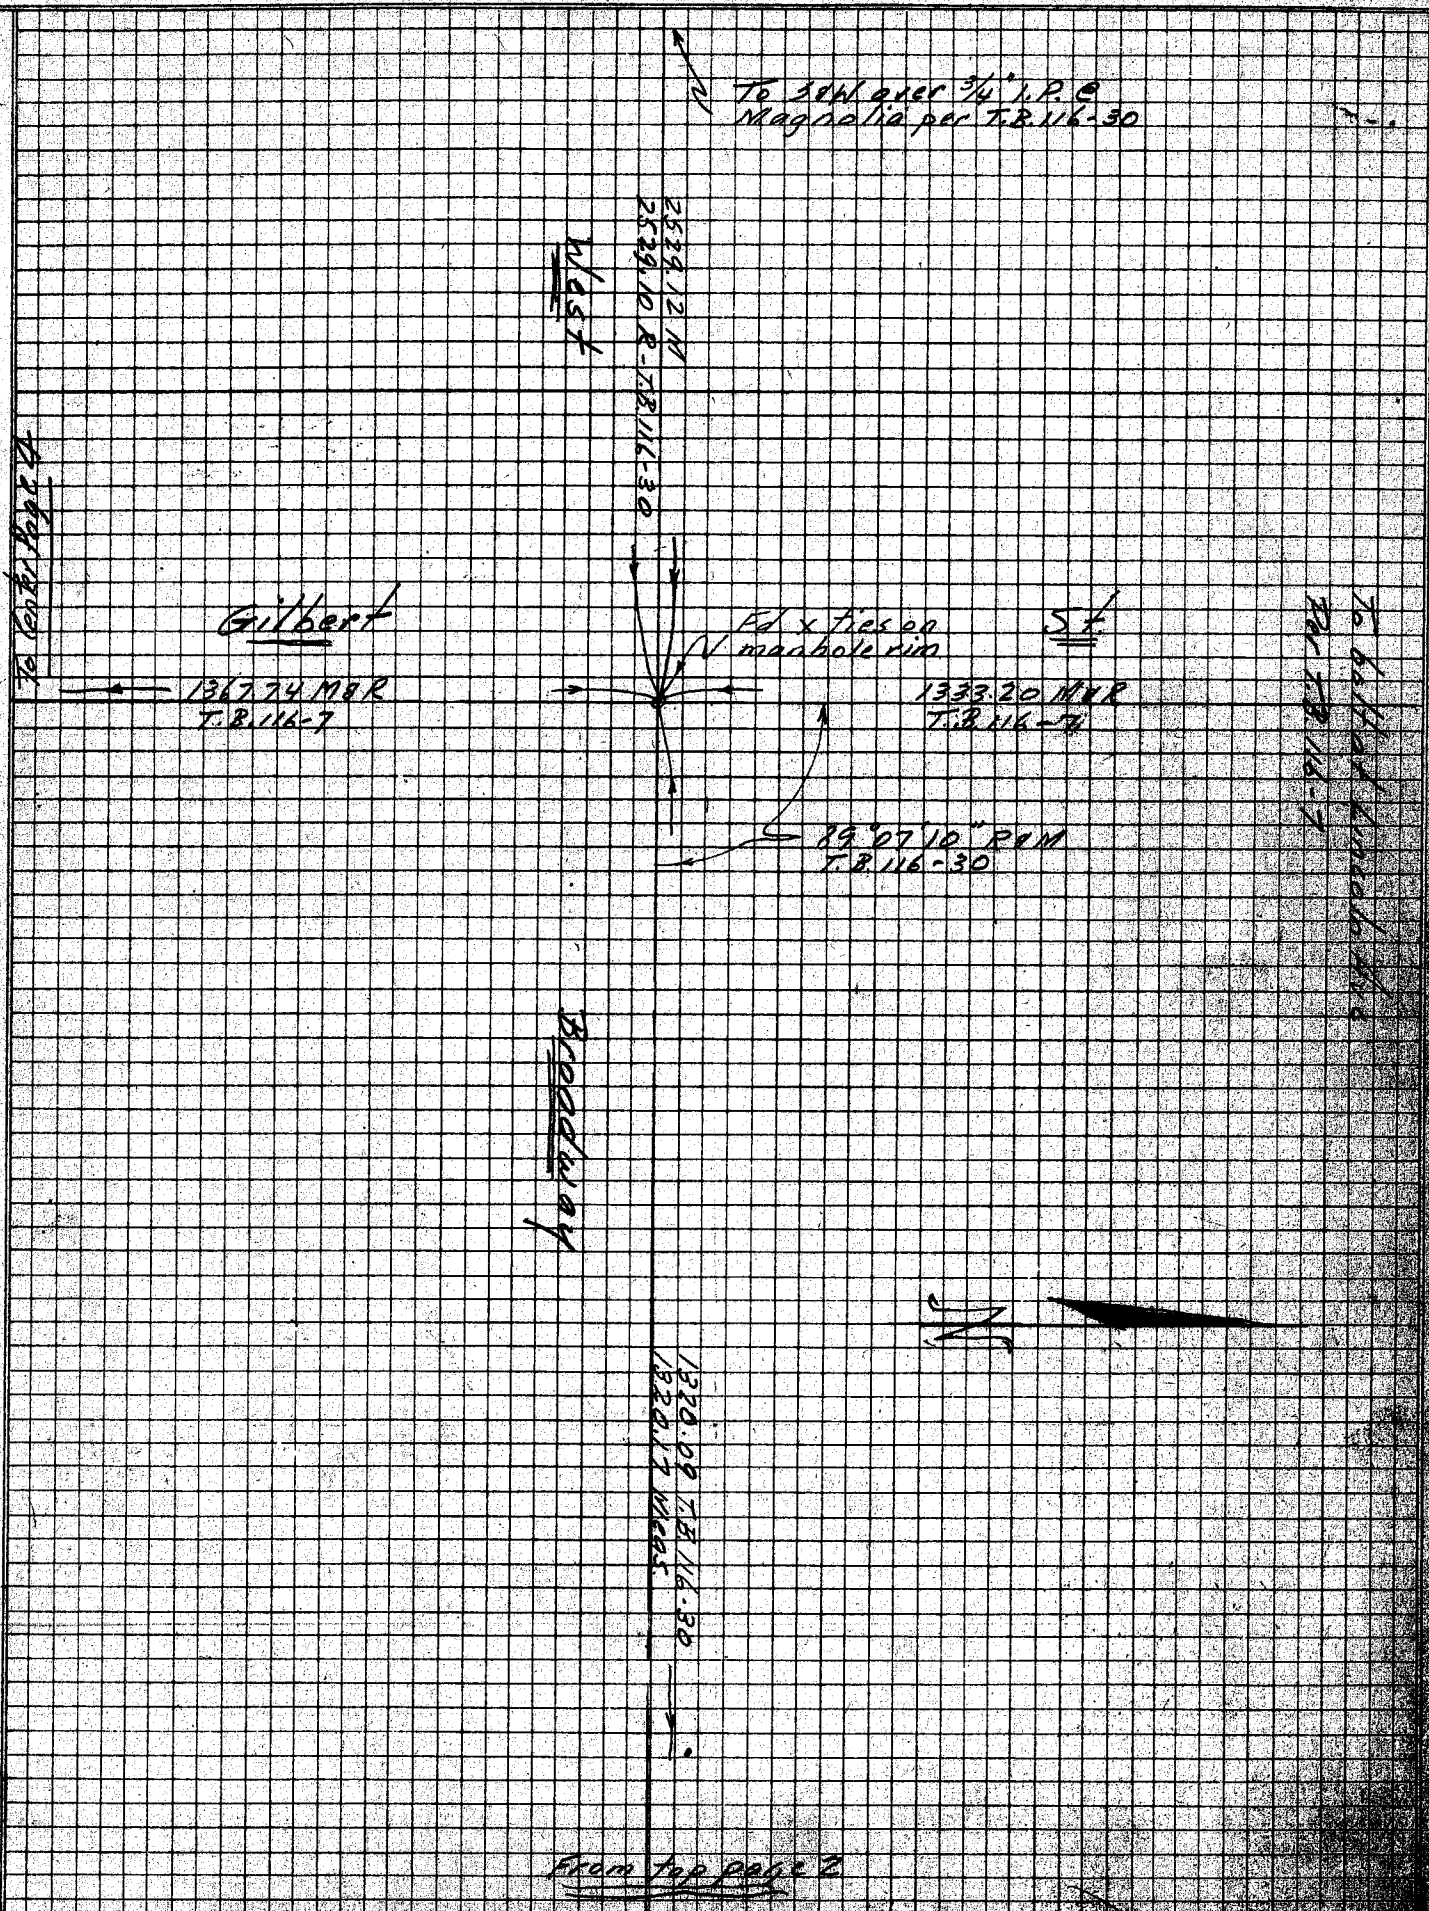

From top page 2

Magnolia

See T.B. 108-5

2670-36 Rec.

Fe 2x4-10" deep

0.27 E. of line

Set 3pk. 9W on line

1931-39 Rec. T.B. 108-5

1331-14

90°00'50" MGR

Fe T.B. 116-7

2514.19 Meas.
2516.14 Rec. T.B. 116-7

Gilbert

See T.B. 116-7

2657-14 Rec.

Set x ties on N. 41.1m

2' NRT surface ties

(See Page A/4-10-10A)

90°30'50" R.M.

1367.74

ORANGE AVE

2639.30 Rec. T.B. 116-7

1 = 90-14-20"

3 = 270-43-40

6 = 181-27-30

Brookhurst

T.B. 108-10

90°14'35" Meas.

5f

1408.24 Meas.

4408.30 T.B. 108-10

Set bolt

74.14 N.W. to So.
end curb ref.

71.51 N.W. to No.
end curb ref.

58.69 N.E. to N.T.
in power pole

See T.B. 116-11-2

to Broadway

From 14 pages

From both 14 pages


ORANGE COUNTY SURVEYOR

SURVEY BY DATE

ORANGE COUNTY SURVEYOR

DATE

SURVEY BY

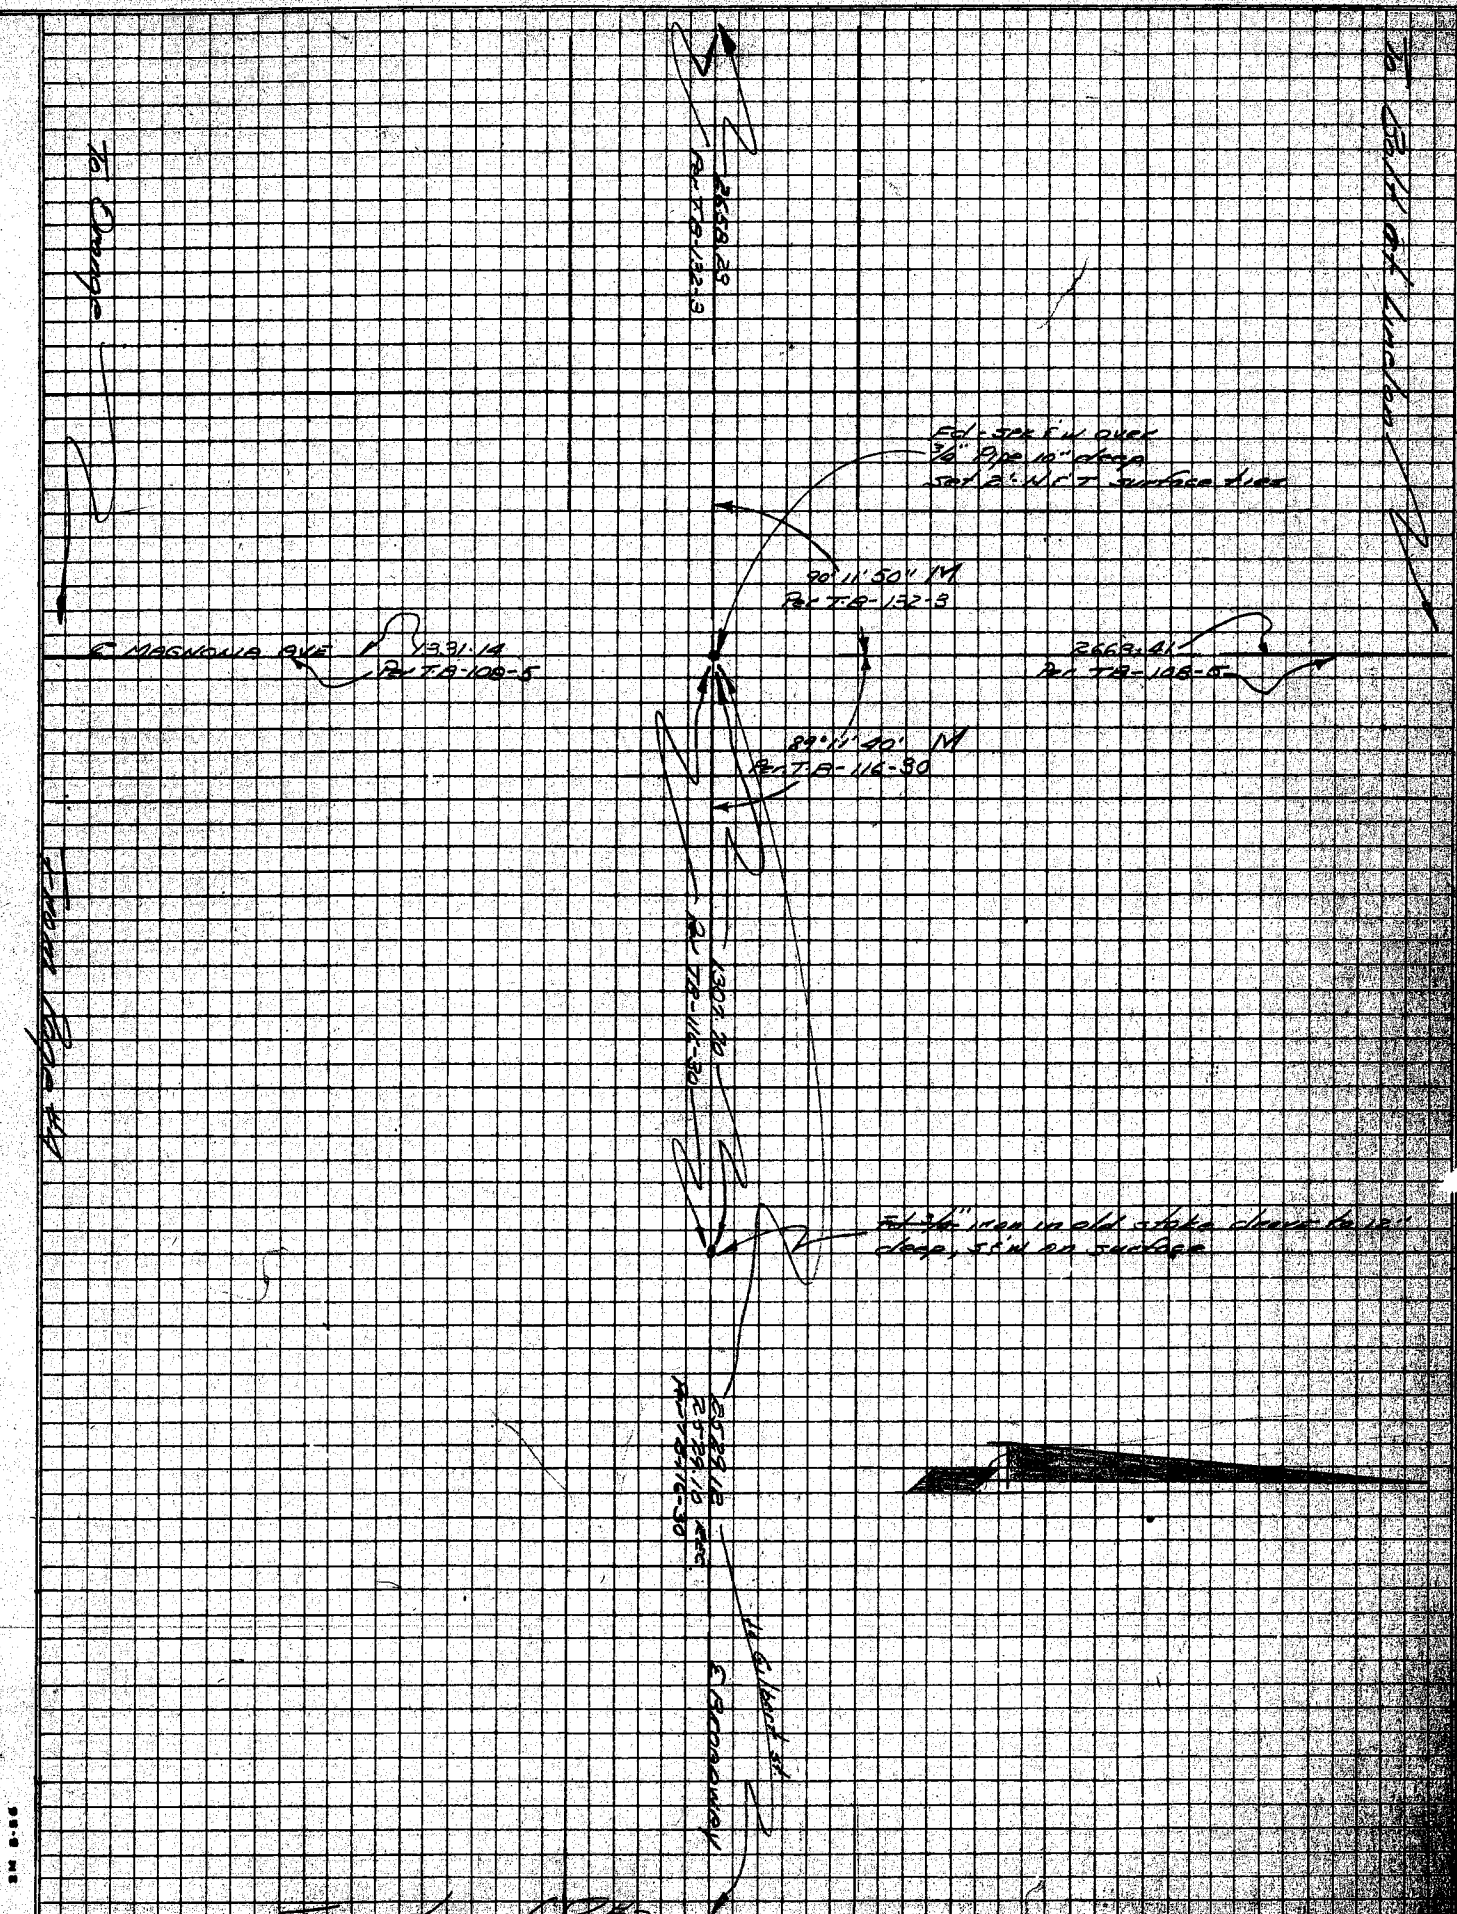

To Page 47

90°39'56"
Per page 9

E. Gilbert


T.B.-108-44
Set back on surface
7022-N.E.-to lead & back
and curb return
61.48-N.E.-to lead & back &
and curb return
43.40-N.W.-to lead & back
T.R.# 419972 H
63.60-S.W.-to lead & back
in guy R.R. # 200203 H

1921.10
Per 1320.44

1336.62
Per 1336.30

FE/36" IP

To Orange

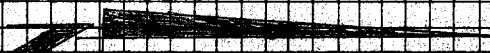

To south of page 47

90°42'30"
Per page 9

To Orange

E. Brookhurst

E. Ball St

T.B.-108-9-43

Set back on surface
51.00-S.E.-to T on SP
79.16-S.W.-to lead & back in center curb
return
66.21-N.W.-to lead & back in center curb
return

55.31

ORANGE COUNTY SURVEYOR

DATE

SURVEY BY

SM 8-56

E MARSHALL AVE

Ed 5th
T12-108-A
Old for old stake
Old and find - Set
R-107 surface line

~~see page 9~~

Ed 11th - appears
line from 11th to
To Broadway

To Orange


E. 4-10 10

- (1) Brookhurst & Ball - N.W. Quad.
- (2) Gilbert & Ball - N.W. Quad.
- (3) Magnolia & Ball - N.E. Quad.
- (4) Orange & Brookhurst S.W. Quad.

Weather: Warm & Calm
 Visibility: Slight Haze
 Temperature: 85°

11-23-56 W.H.R.

① 89° 38' 40"
 ② 268° 55' 50"
 ③ 177° 51' 40"

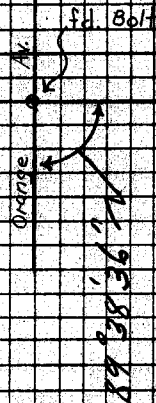

Brookhurst
 Brookhurst St

fd. Bolt

① 90° 42' 40"
 ② 72° 08' 40"
 ③ 184° 15' 40"

90° 42' 30"

Road

Gilbert

Gilbert St

fd. Bolt

① 90° 39' 40"
 ② 71° 29' 50"
 ③ 183° 59' 40"

90° 39' 56"

11-89° 43' 27"

Ball

Magnolia

Magnolia Av.

Av.