

OC PUBLIC WORKS DEPARTMENT

SHANE SILSBY, DIRECTOR

KEVIN HILLS, COUNTY SURVEYOR

CARBON CANYON CHANNEL (B01)



THE CONSTRUCTION CENTERLINE ALIGNMENT SHOWN HEREON WAS
ESTABLISHED BY HOLDING 311+82.32' PER DWG. NO. B01-701-2-A
DATED JULY, 1959 AT THE CENTERLINE INTERSECTION OF MAGNOLIA AVE.
AND THE DESCRIBED LINE OF BOOK 5175 PAGE 274 O.R. INCREASING IN
STATION UPSTREAM TO GILBERT ST.

EXISTING CONDITION 2020 
RIGHT OF WAY  R/W 
DATE PREPARED: 02/11/2020

PROJECT CROSS SECTIONS

U.S. Survey Foot


OC Public Works
OC Survey/Field Services
Boundary Analysis & Mapping



CARBON CANYON CHANNEL

312+50.00

CL

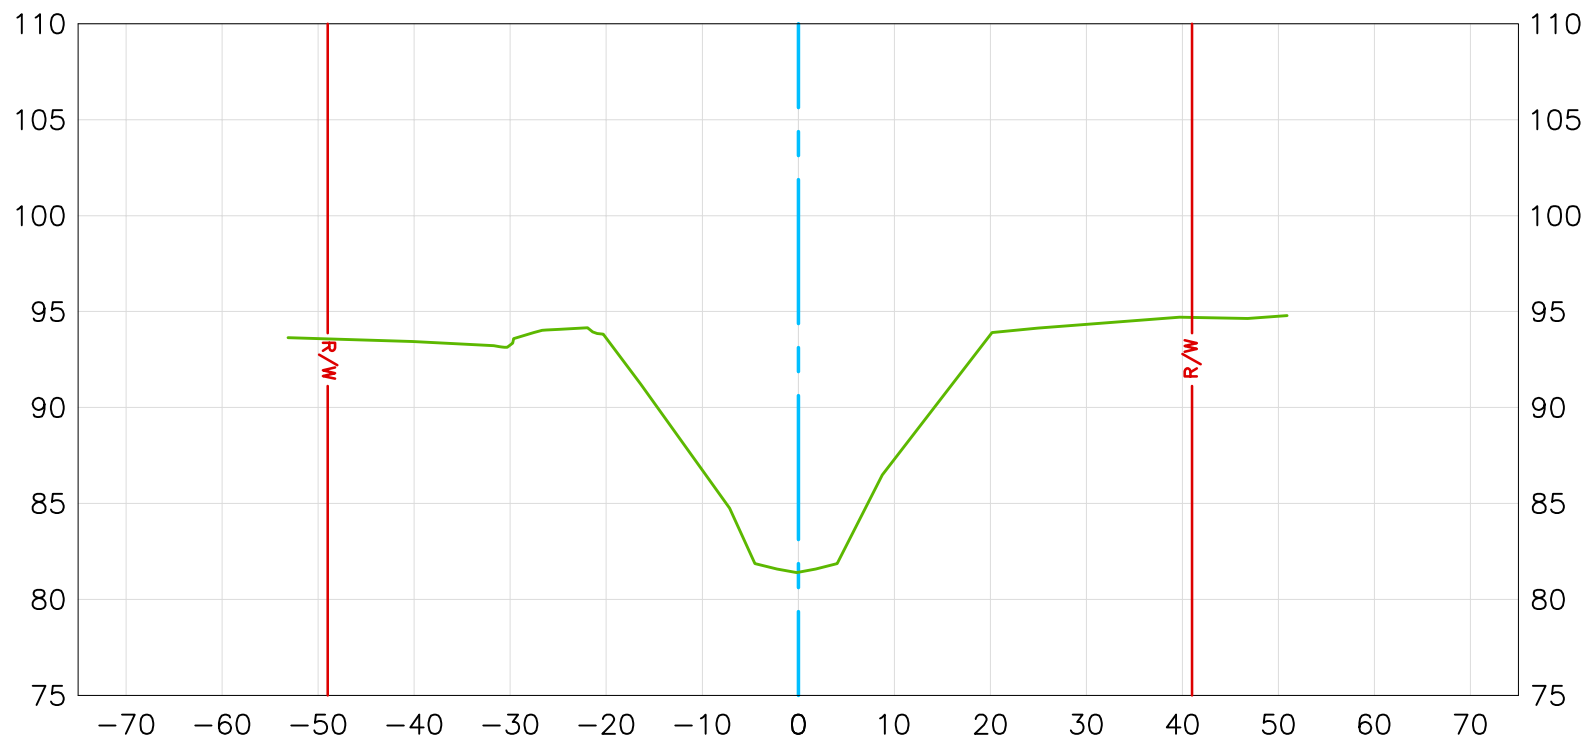

Vert. Scale 1"=10
Horiz. Scale 1"=20

EXISTING CONDITION 2020 
RIGHT OF WAY 

DATE PREPARED: 02/11/2020

U.S. Survey Foot


OC Public Works
OC Survey/Field Services
Boundary Analysis & Mapping



CARBON CANYON CHANNEL

313+00.00

CL

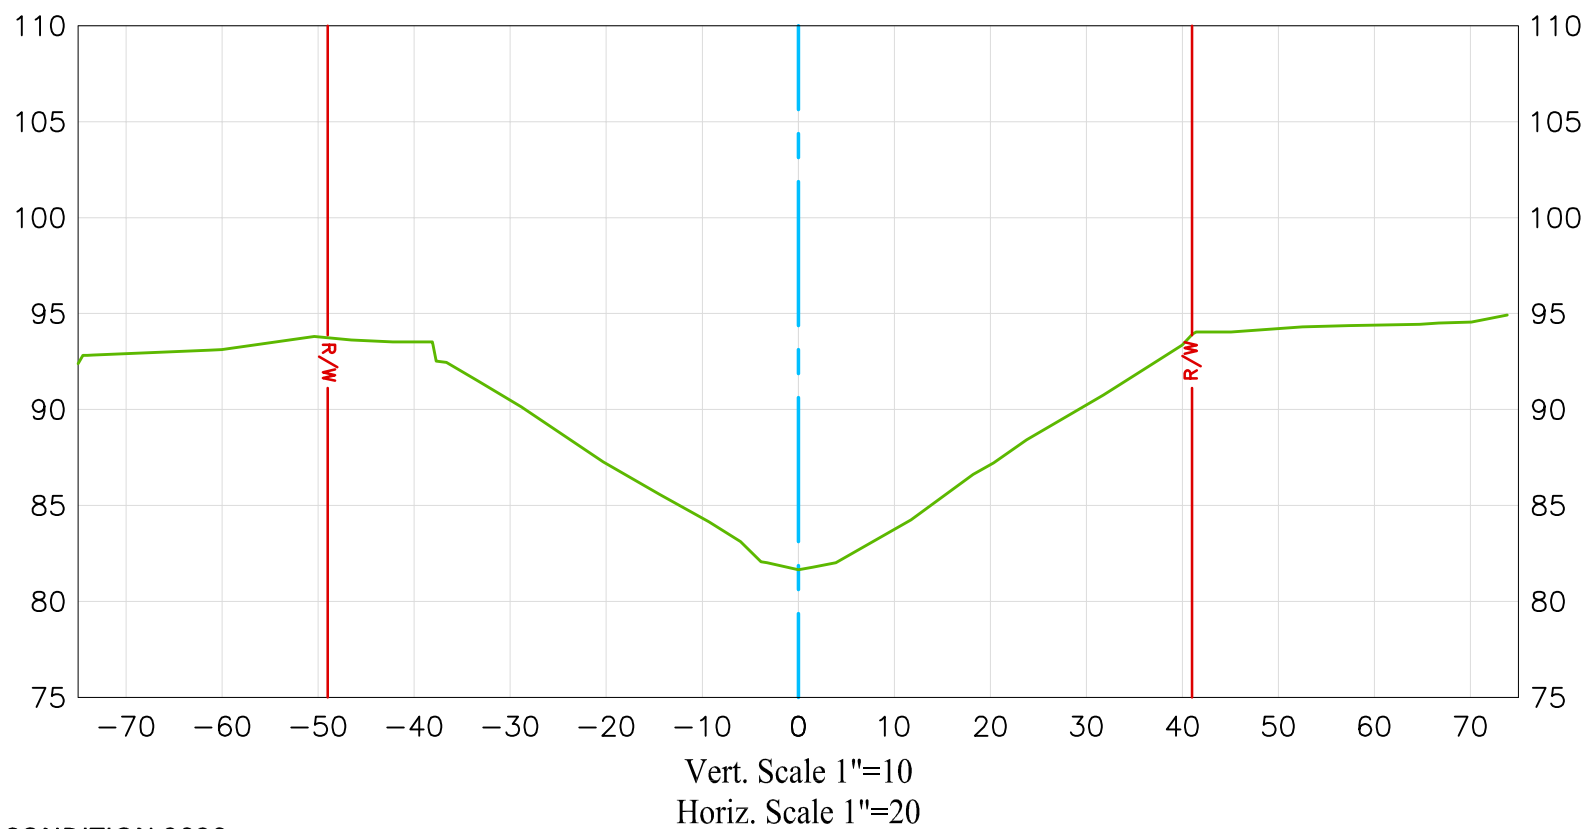

EXISTING CONDITION 2020

RIGHT OF WAY

DATE PREPARED: 02/11/2020

U.S. Survey Foot


OC Public Works
OC Survey/Field Services
Boundary Analysis & Mapping



CARBON CANYON CHANNEL

313+03.64

CL

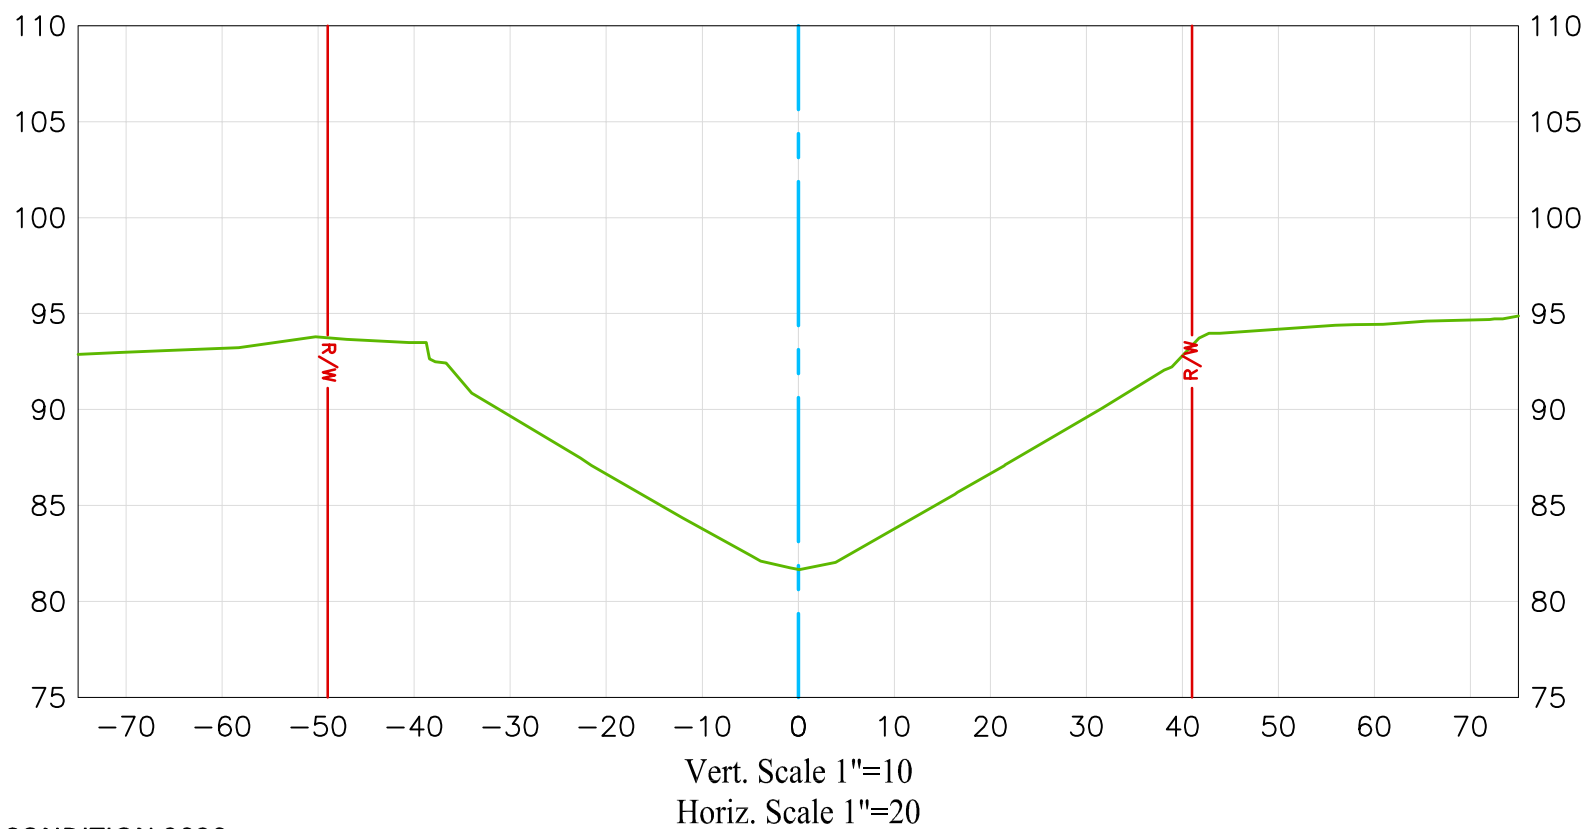

EXISTING CONDITION 2020

RIGHT OF WAY

DATE PREPARED: 02/11/2020

U.S. Survey Foot


OC Public Works
OC Survey/Field Services
Boundary Analysis & Mapping



CARBON CANYON CHANNEL

313+50.00

CL

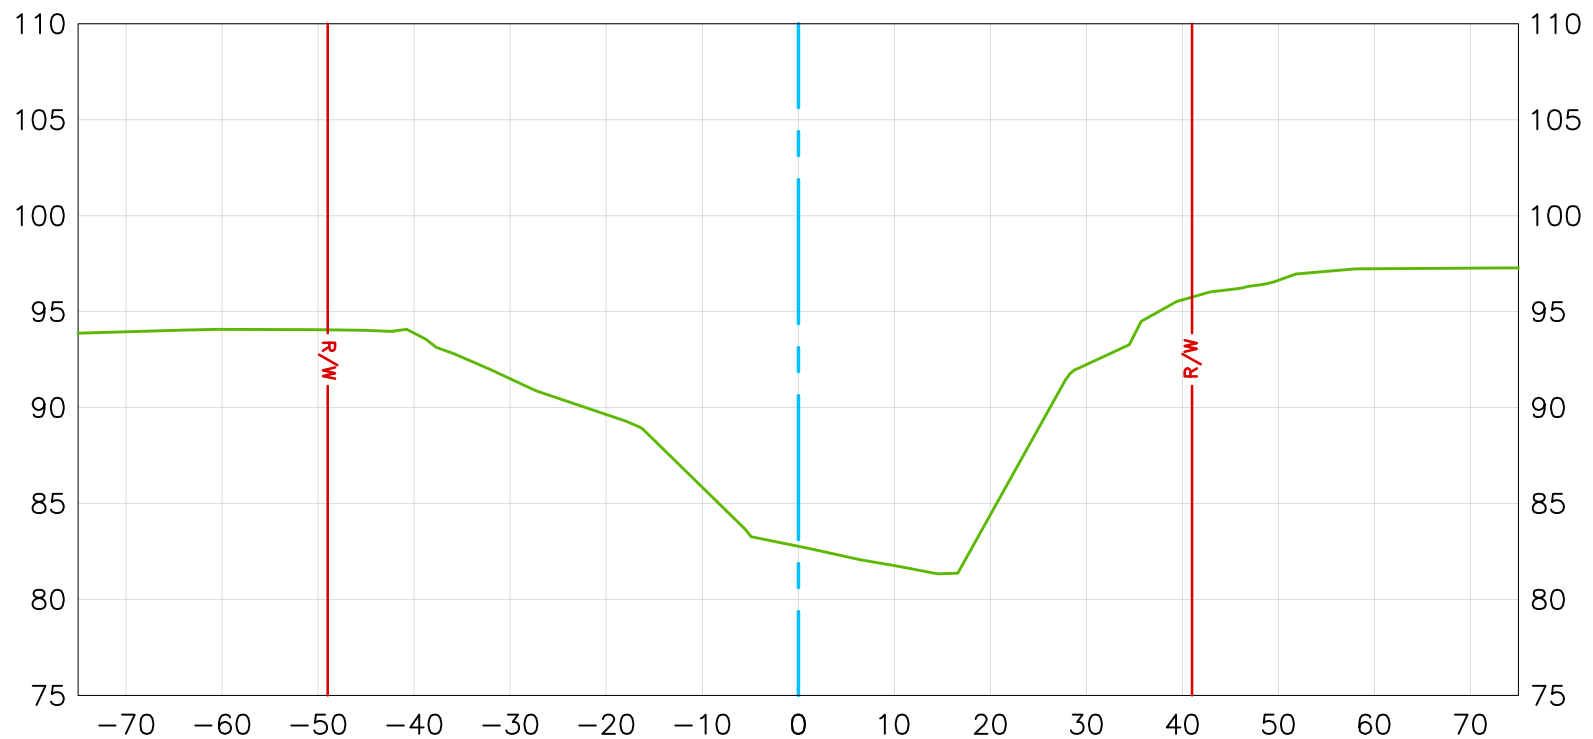

Vert. Scale 1"=10
Horiz. Scale 1"=20

EXISTING CONDITION 2020 
RIGHT OF WAY 

DATE PREPARED: 02/11/2020

**U.S. Survey
Foot**


OC Public Works
OC Survey/Field Services
Boundary Analysis & Mapping



CARBON CANYON CHANNEL

314+00.00

CL

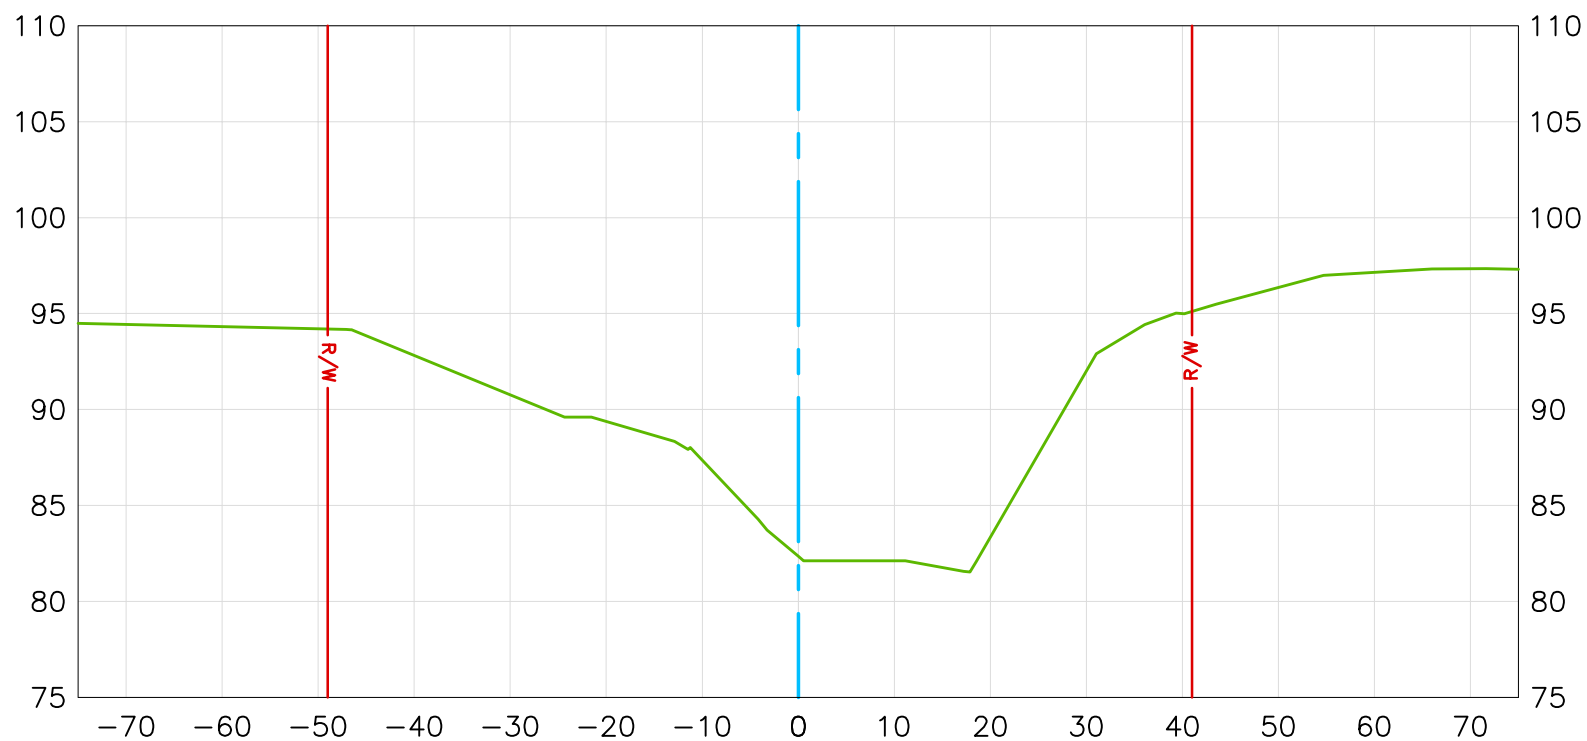

Vert. Scale 1"=10
Horiz. Scale 1"=20

EXISTING CONDITION 2020 —————

RIGHT OF WAY ——— R/W ———

DATE PREPARED: 02/11/2020

**U.S. Survey
Foot**


OC Public Works
OC Survey/Field Services
Boundary Analysis & Mapping



CARBON CANYON CHANNEL

314+50.00

CL

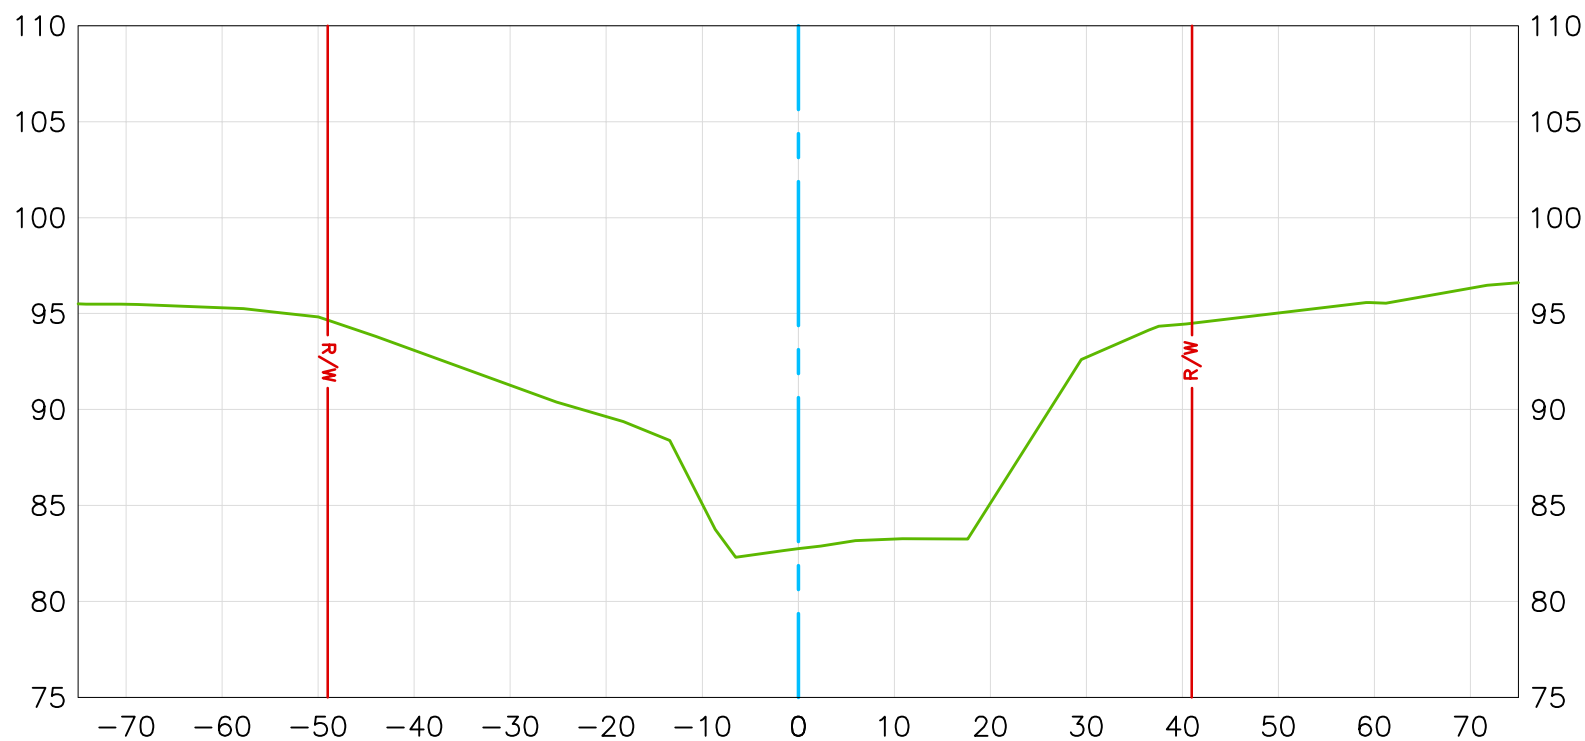

Vert. Scale 1"=10
Horiz. Scale 1"=20

EXISTING CONDITION 2020 —————

RIGHT OF WAY ——— R/W ———

DATE PREPARED: 02/11/2020

U.S. Survey Foot


OC Public Works
OC Survey/Field Services
Boundary Analysis & Mapping



CARBON CANYON CHANNEL

315+00.00

CL

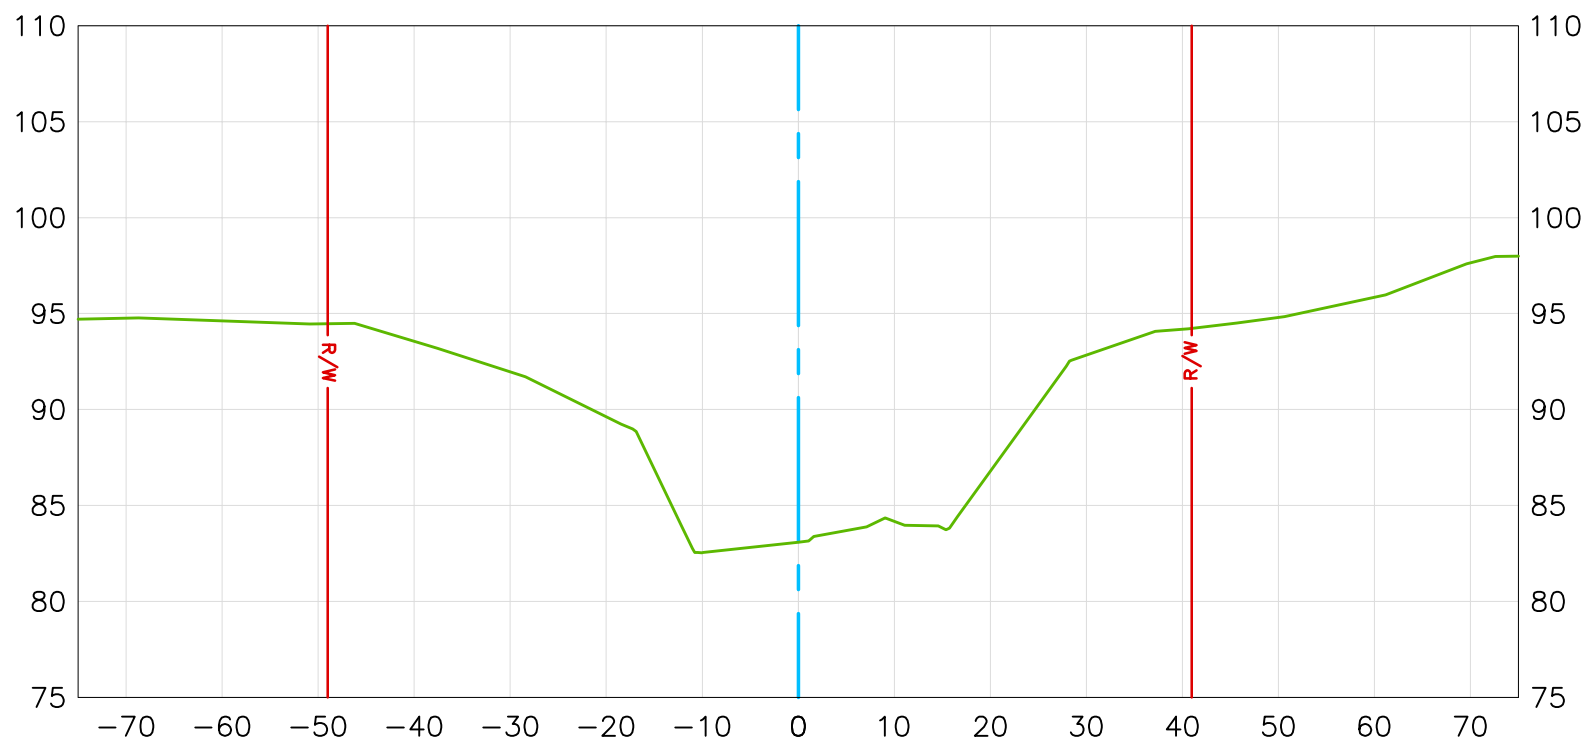

Vert. Scale 1"=10
Horiz. Scale 1"=20

EXISTING CONDITION 2020 
RIGHT OF WAY 

DATE PREPARED: 02/11/2020

U.S. Survey Foot


OC Public Works
OC Survey/Field Services
Boundary Analysis & Mapping



CARBON CANYON CHANNEL

315+50.00

CL

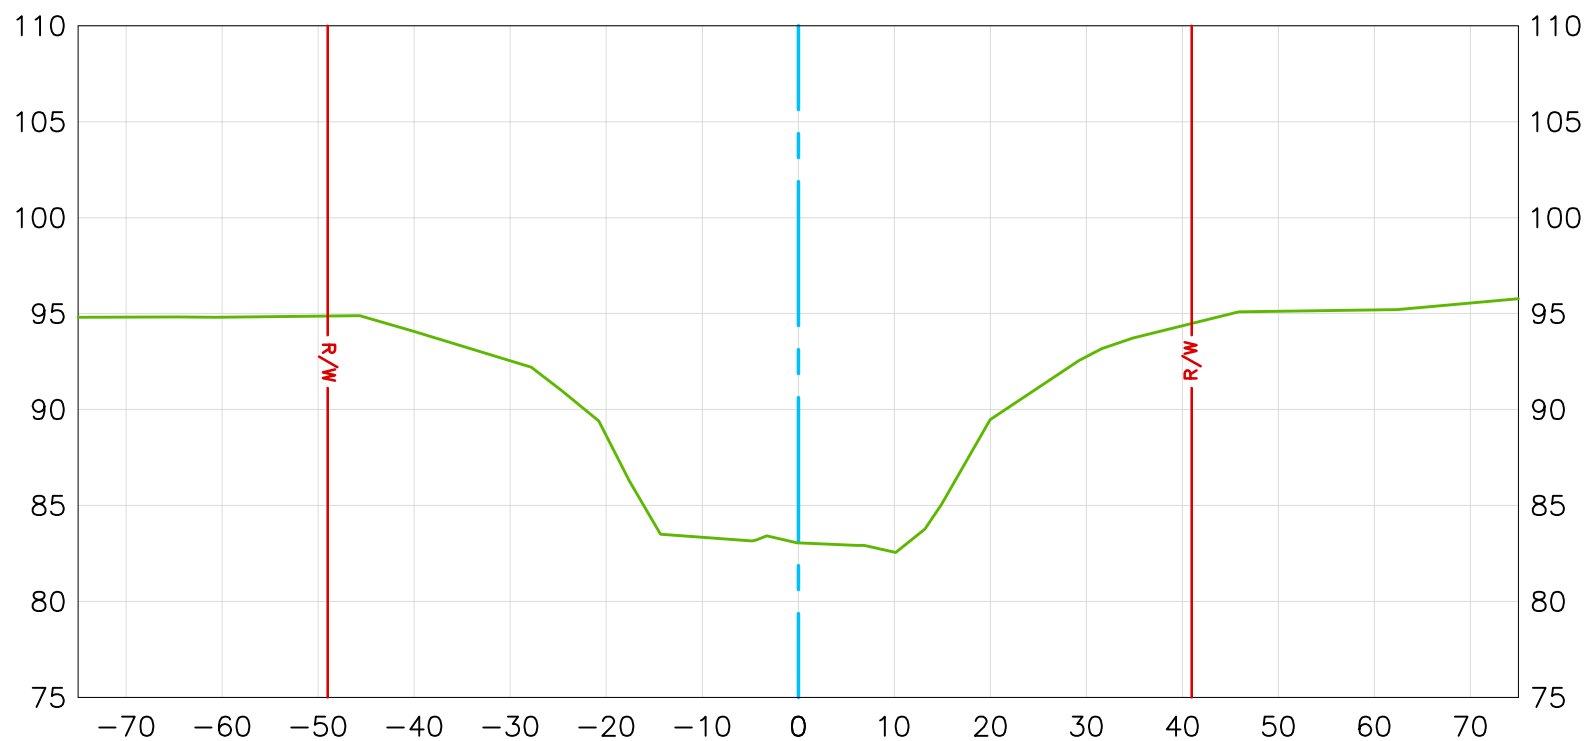

Vert. Scale 1"=10
Horiz. Scale 1"=20

EXISTING CONDITION 2020 
RIGHT OF WAY  R/W

DATE PREPARED: 02/11/2020

U.S. Survey Foot


OC Public Works
OC Survey/Field Services
Boundary Analysis & Mapping



CARBON CANYON CHANNEL

316+00.00

CL

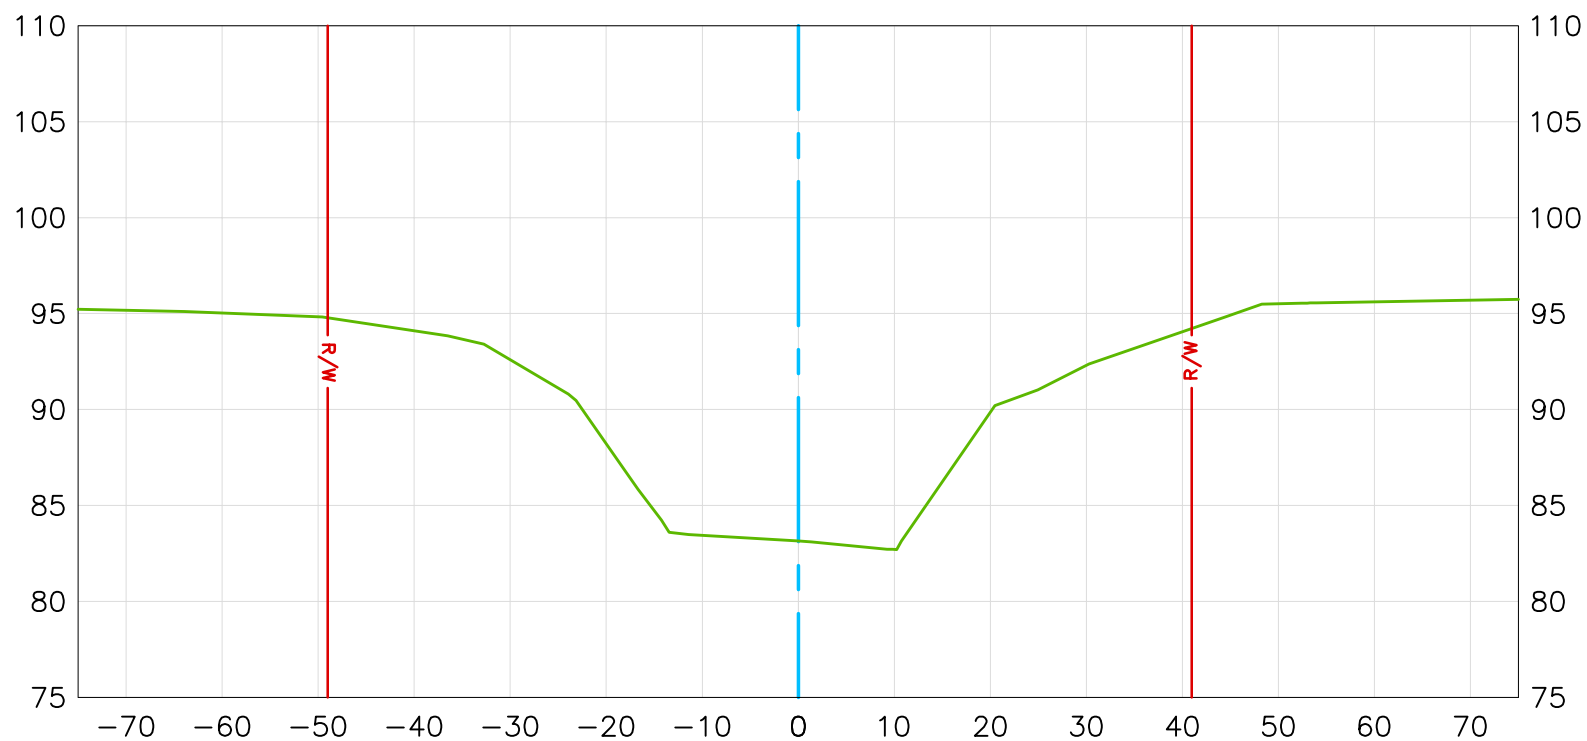

Vert. Scale 1"=10
Horiz. Scale 1"=20

EXISTING CONDITION 2020 —————

RIGHT OF WAY ——— R/W ———

DATE PREPARED: 02/11/2020

U.S. Survey Foot


OC Public Works
OC Survey/Field Services
Boundary Analysis & Mapping



CARBON CANYON CHANNEL

316+50.00

CL

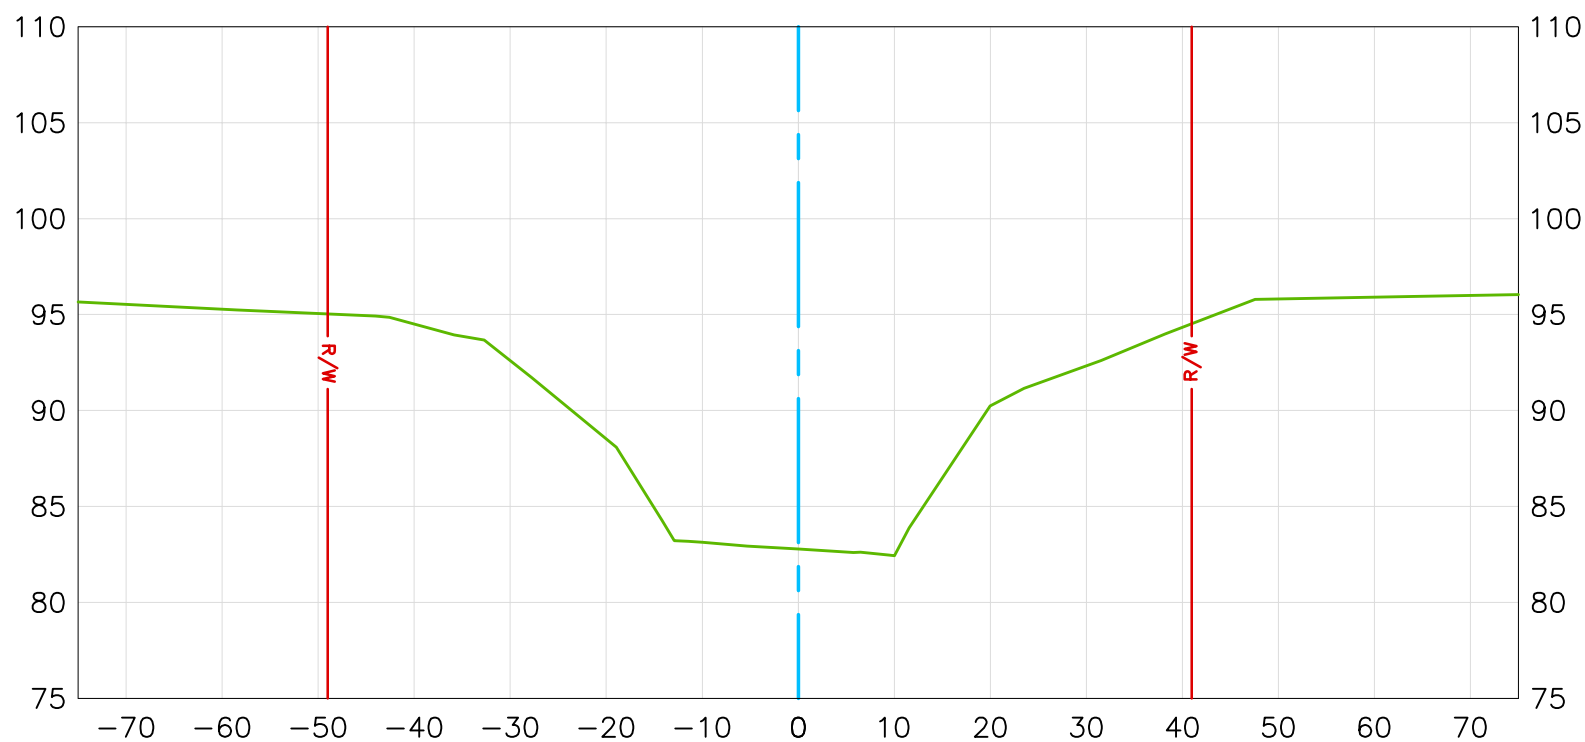

Vert. Scale 1"=10
Horiz. Scale 1"=20

EXISTING CONDITION 2020 —————

RIGHT OF WAY ——— R/W ———

DATE PREPARED: 02/11/2020

U.S. Survey Foot


OC Public Works
OC Survey/Field Services
Boundary Analysis & Mapping



CARBON CANYON CHANNEL

317+00.00

CL

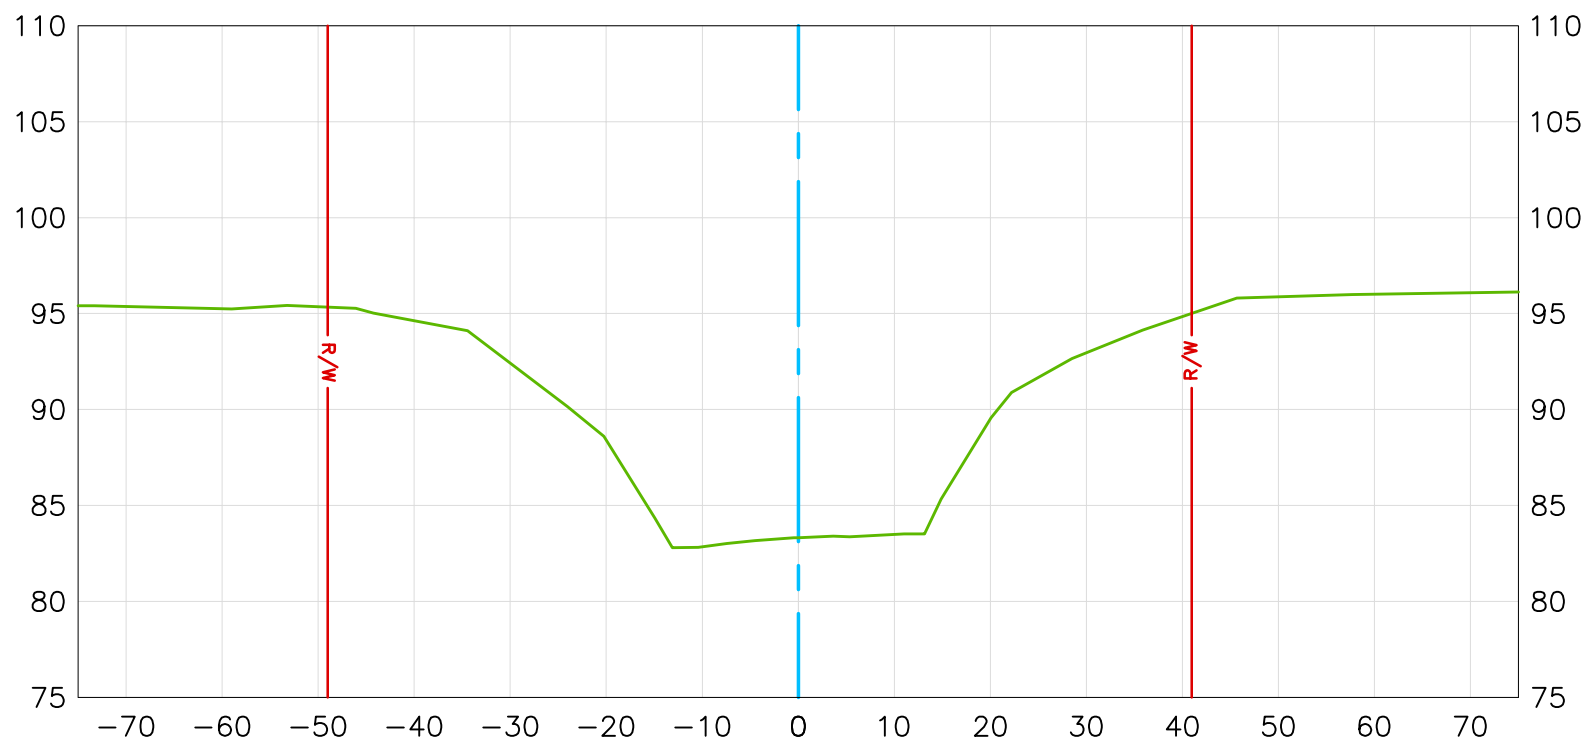

Vert. Scale 1"=10
Horiz. Scale 1"=20

EXISTING CONDITION 2020 
RIGHT OF WAY 

DATE PREPARED: 02/11/2020

U.S. Survey Foot


OC Public Works
OC Survey/Field Services
Boundary Analysis & Mapping



CARBON CANYON CHANNEL

317+50.00

CL

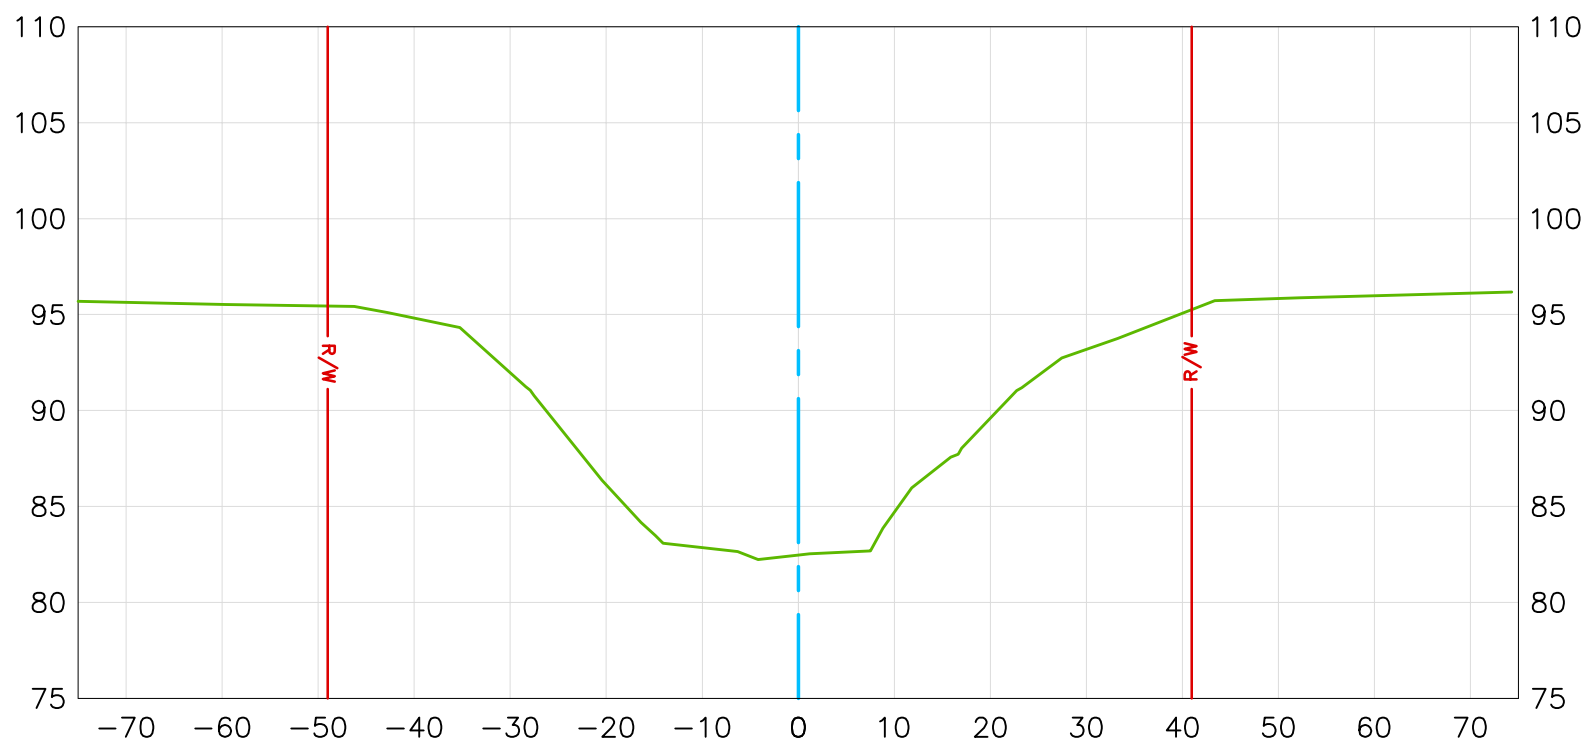

Vert. Scale 1"=10
Horiz. Scale 1"=20

EXISTING CONDITION 2020 —————

RIGHT OF WAY ——— R/W ———

DATE PREPARED: 02/11/2020

U.S. Survey Foot


OC Public Works
OC Survey/Field Services
Boundary Analysis & Mapping



CARBON CANYON CHANNEL

318+00.00

CL

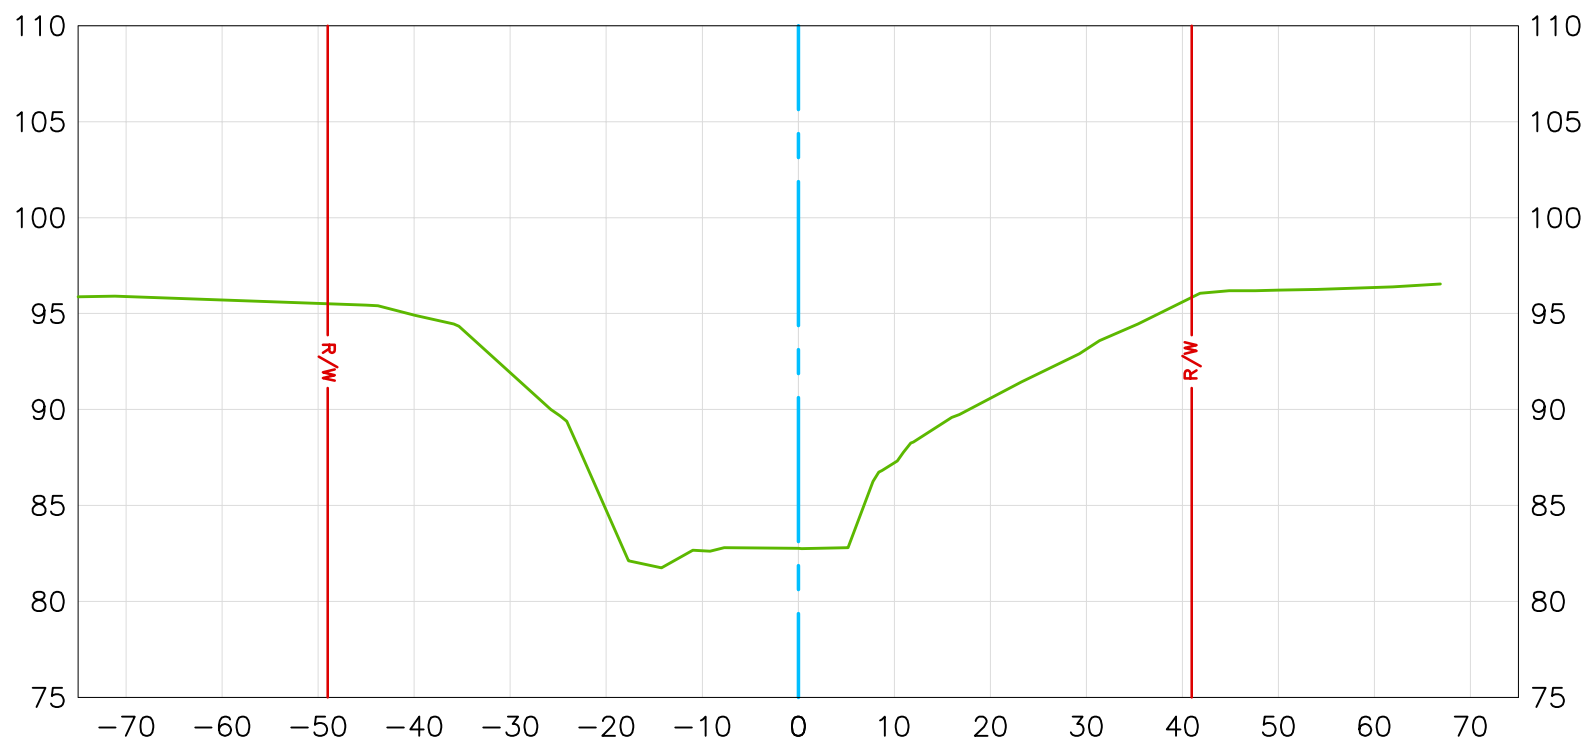

Vert. Scale 1"=10
Horiz. Scale 1"=20

EXISTING CONDITION 2020 
RIGHT OF WAY 

DATE PREPARED: 02/11/2020

U.S. Survey Foot


OC Public Works
OC Survey/Field Services
Boundary Analysis & Mapping



CARBON CANYON CHANNEL

318+50.00

CL

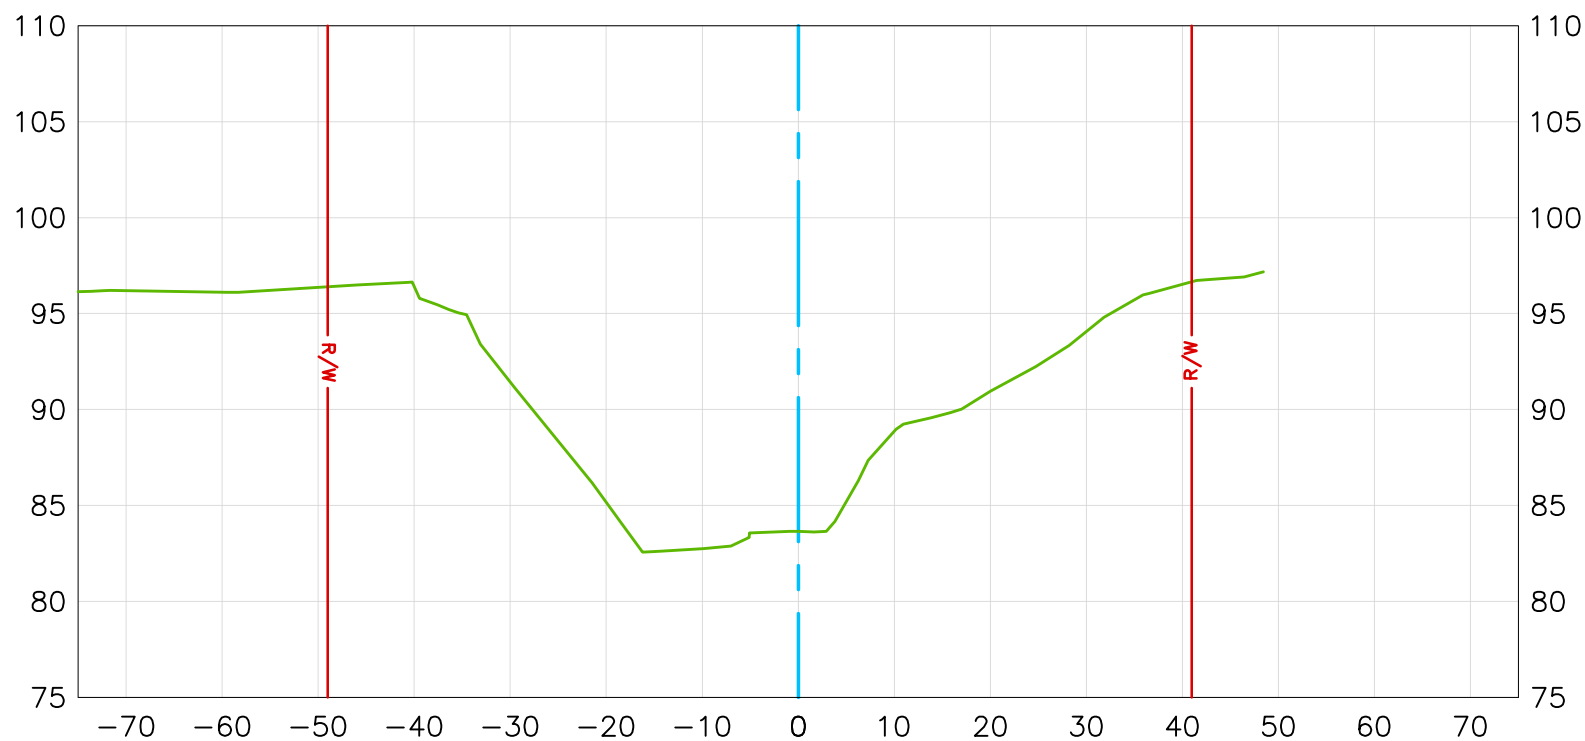

Vert. Scale 1"=10
Horiz. Scale 1"=20

EXISTING CONDITION 2020 
RIGHT OF WAY 

DATE PREPARED: 02/11/2020

U.S. Survey Foot


OC Public Works
OC Survey/Field Services
Boundary Analysis & Mapping



CARBON CANYON CHANNEL

319+00.00

CL

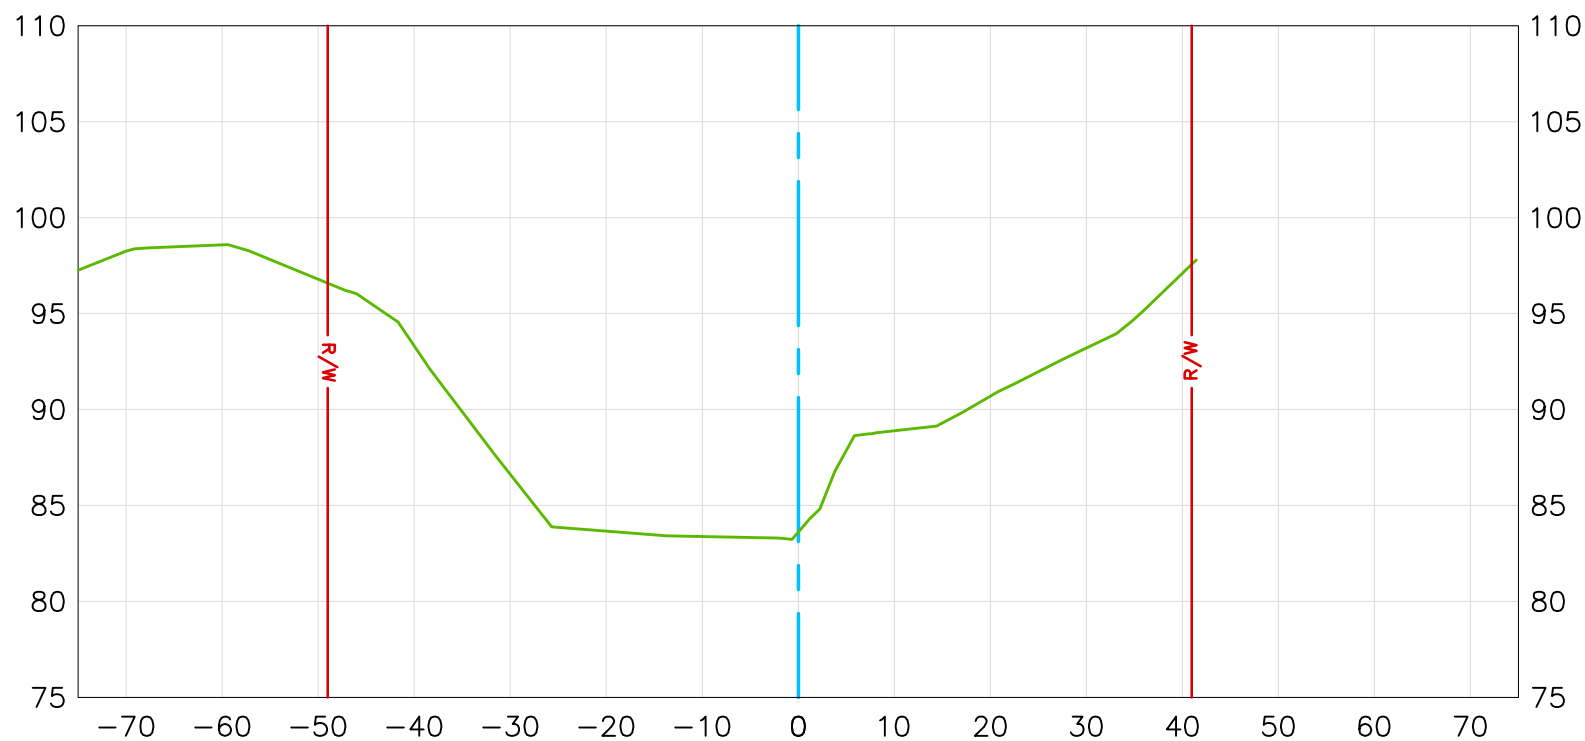

Vert. Scale 1"=10
Horiz. Scale 1"=20

EXISTING CONDITION 2020 
RIGHT OF WAY 

DATE PREPARED: 02/11/2020

U.S. Survey Foot


OC Public Works
OC Survey/Field Services
Boundary Analysis & Mapping



CARBON CANYON CHANNEL

319+50.00

CL

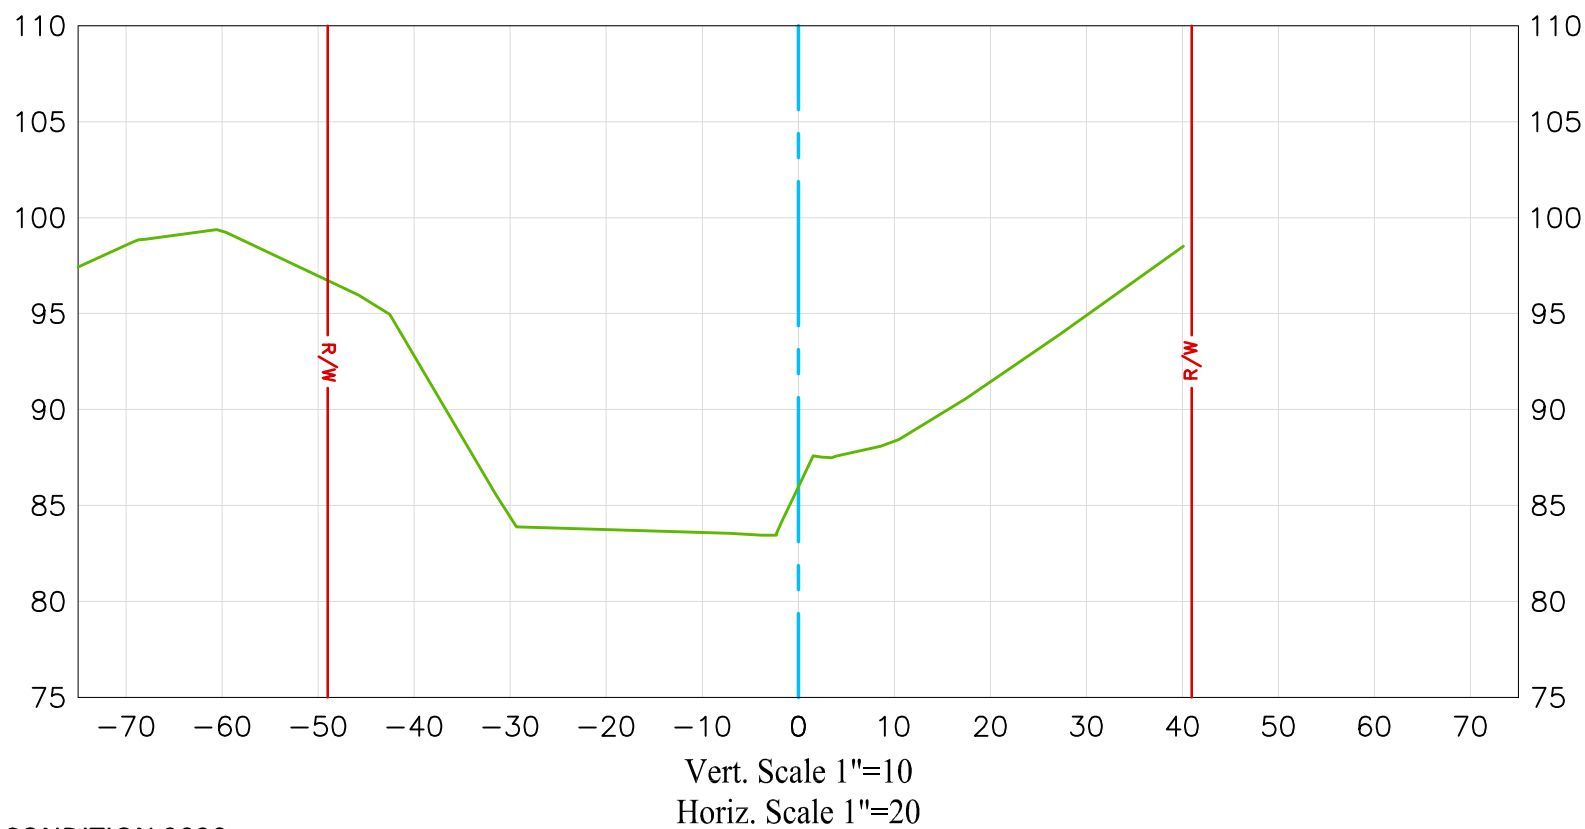

EXISTING CONDITION 2020

RIGHT OF WAY

DATE PREPARED: 02/11/2020

U.S. Survey Foot


OC Public Works
OC Survey/Field Services
Boundary Analysis & Mapping



CARBON CANYON CHANNEL

320+00.00

CL

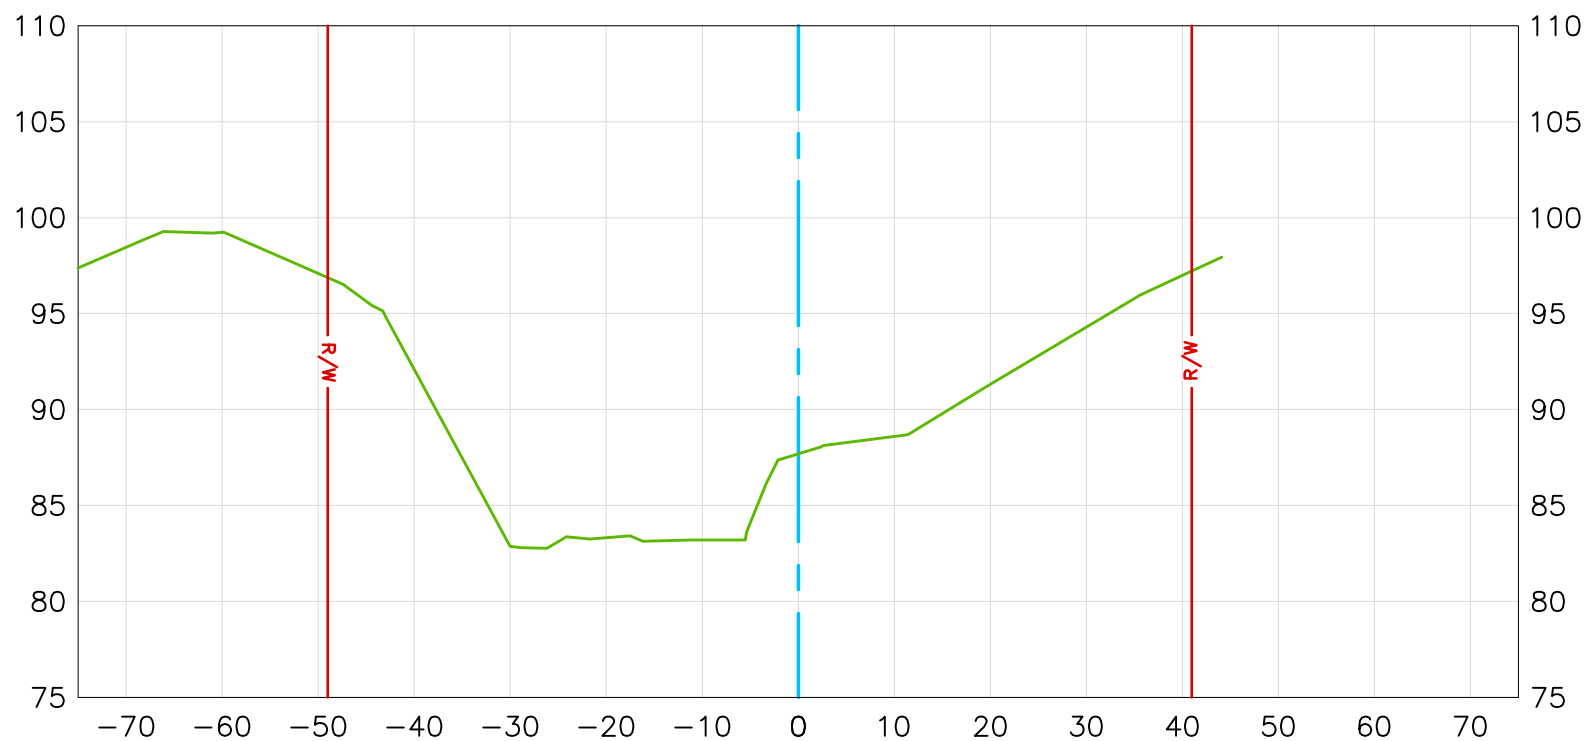

Vert. Scale 1"=10
Horiz. Scale 1"=20

EXISTING CONDITION 2020 
RIGHT OF WAY 

DATE PREPARED: 02/11/2020

U.S. Survey Foot


OC Public Works
OC Survey/Field Services
Boundary Analysis & Mapping



CARBON CANYON CHANNEL

320+50.00

CL

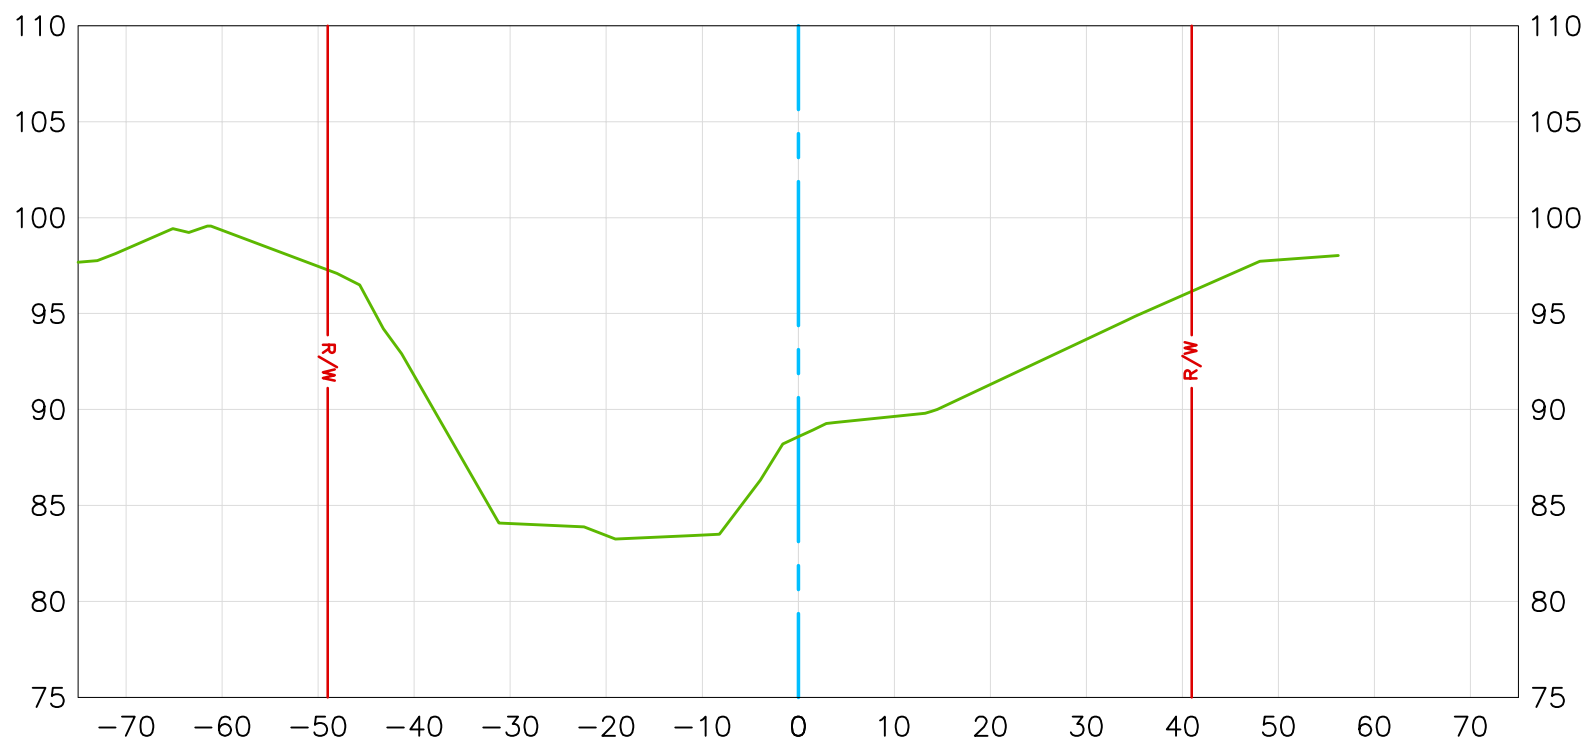

Vert. Scale 1"=10
Horiz. Scale 1"=20

EXISTING CONDITION 2020 
RIGHT OF WAY  R/W

DATE PREPARED: 02/11/2020

U.S. Survey Foot


OC Public Works
OC Survey/Field Services
Boundary Analysis & Mapping



CARBON CANYON CHANNEL

321+00.00

CL

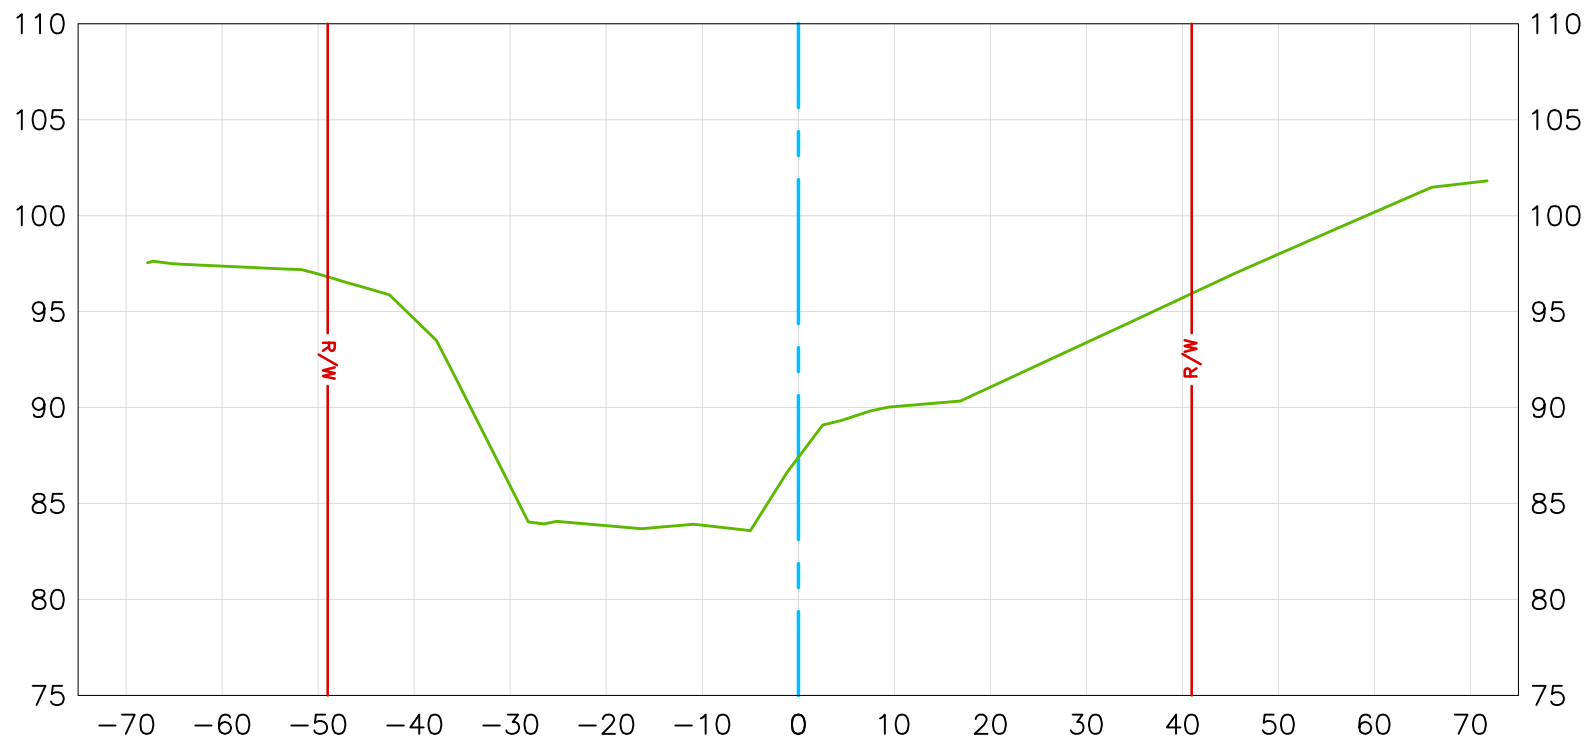

Vert. Scale 1"=10
Horiz. Scale 1"=20

EXISTING CONDITION 2020 
RIGHT OF WAY 

DATE PREPARED: 02/11/2020

U.S. Survey Foot


OC Public Works
OC Survey/Field Services
Boundary Analysis & Mapping



CARBON CANYON CHANNEL

321+50.00

CL

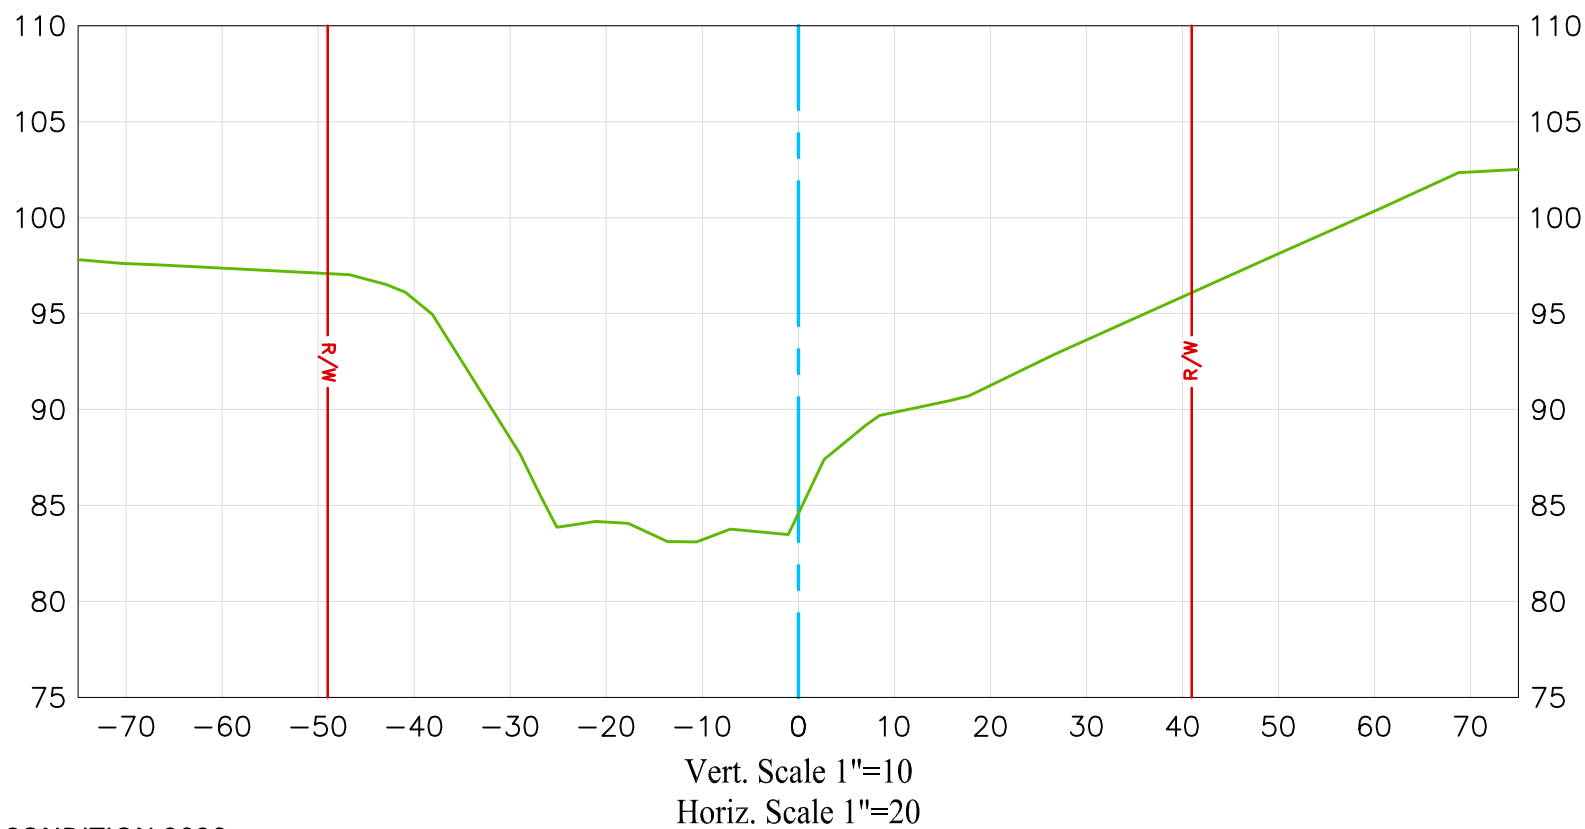

EXISTING CONDITION 2020

RIGHT OF WAY

DATE PREPARED: 02/11/2020

**U.S. Survey
Foot**


OC Public Works
OC Survey/Field Services
Boundary Analysis & Mapping



CARBON CANYON CHANNEL

322+00.00

CL

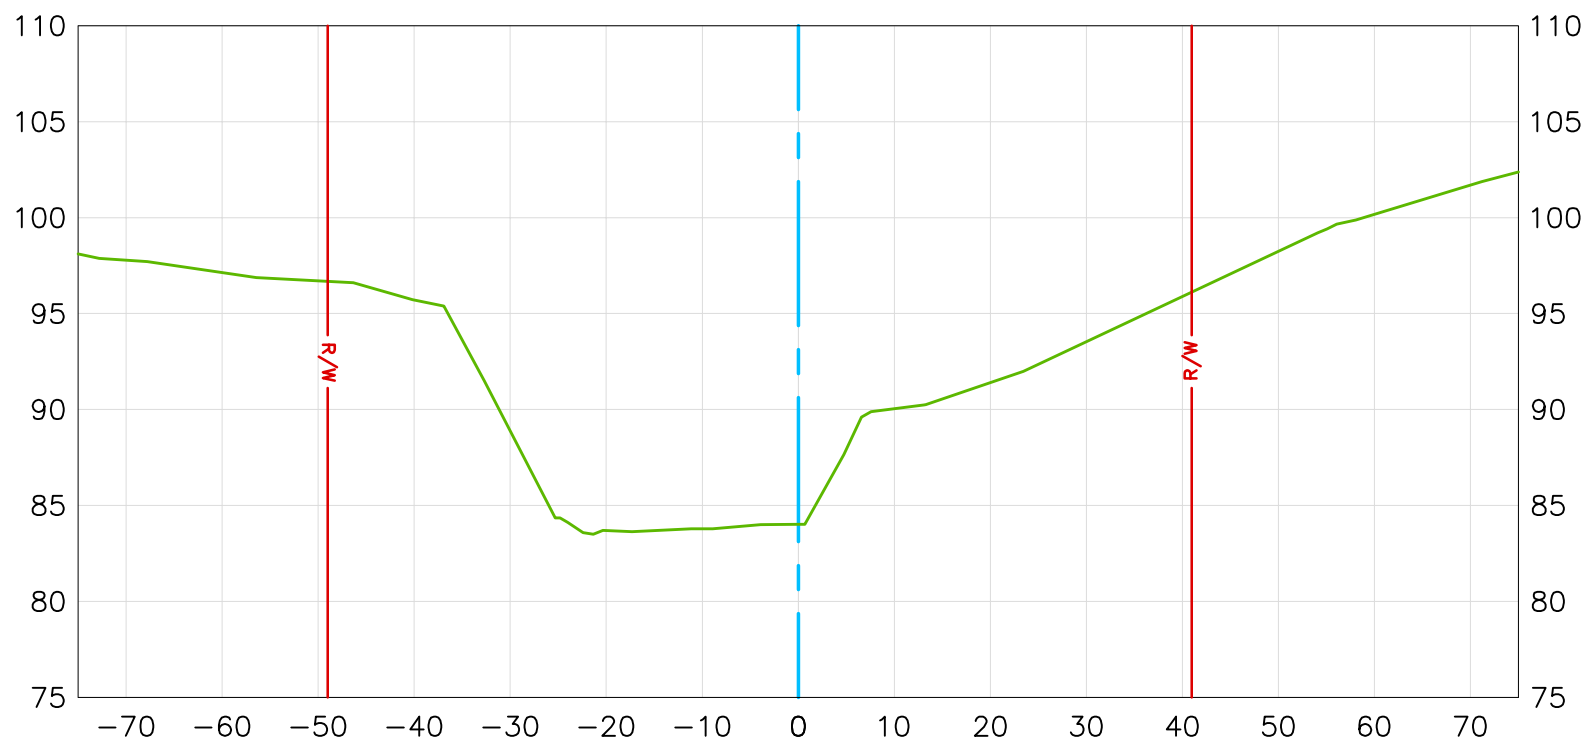

Vert. Scale 1"=10
Horiz. Scale 1"=20

EXISTING CONDITION 2020 
RIGHT OF WAY 

DATE PREPARED: 02/11/2020

U.S. Survey Foot


OC Public Works
OC Survey/Field Services
Boundary Analysis & Mapping



CARBON CANYON CHANNEL

322+50.00

CL

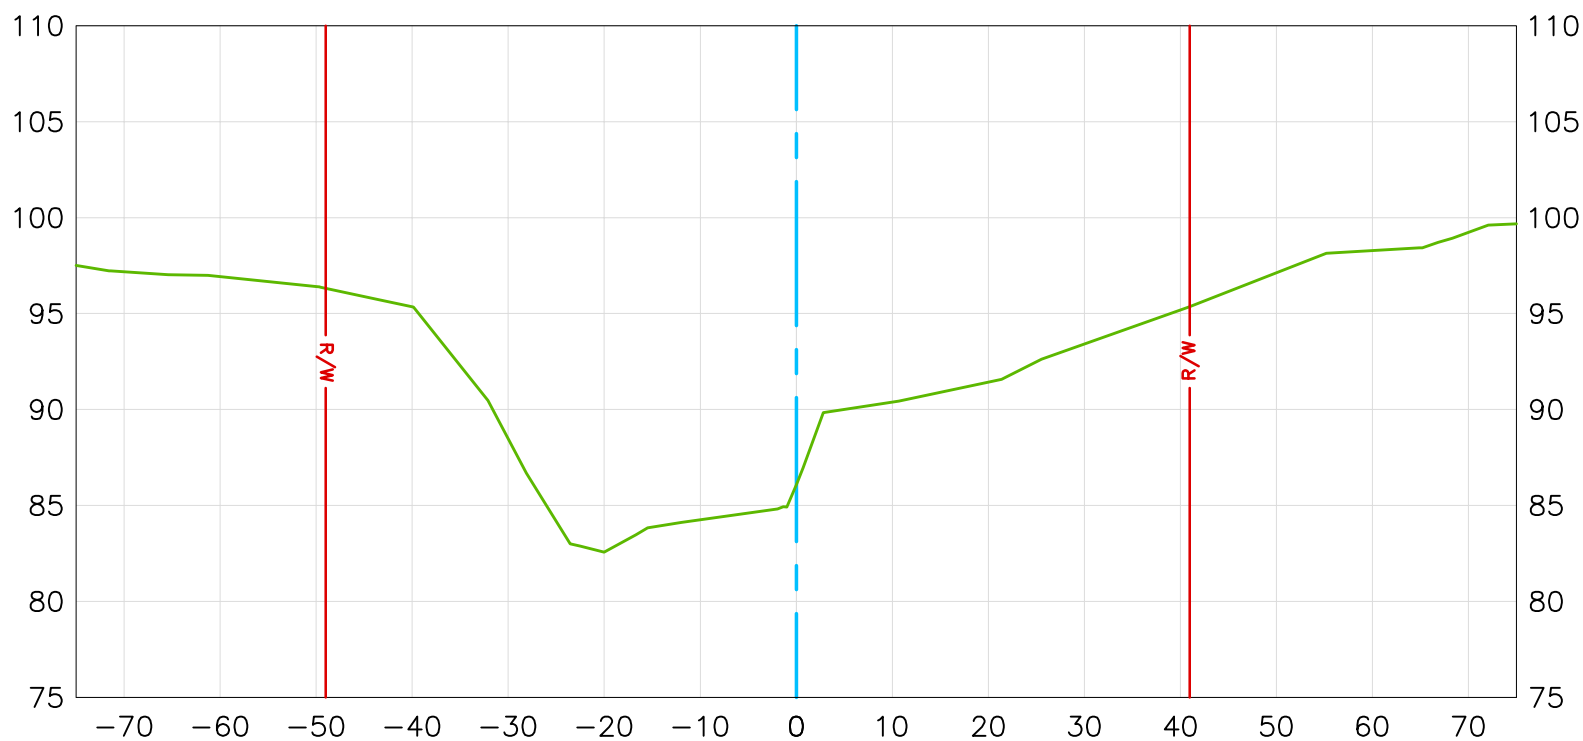

Vert. Scale 1"=10
Horiz. Scale 1"=20

EXISTING CONDITION 2020 
RIGHT OF WAY 

DATE PREPARED: 02/11/2020

U.S. Survey Foot


OC Public Works
OC Survey/Field Services
Boundary Analysis & Mapping



CARBON CANYON CHANNEL

323+00.00

CL

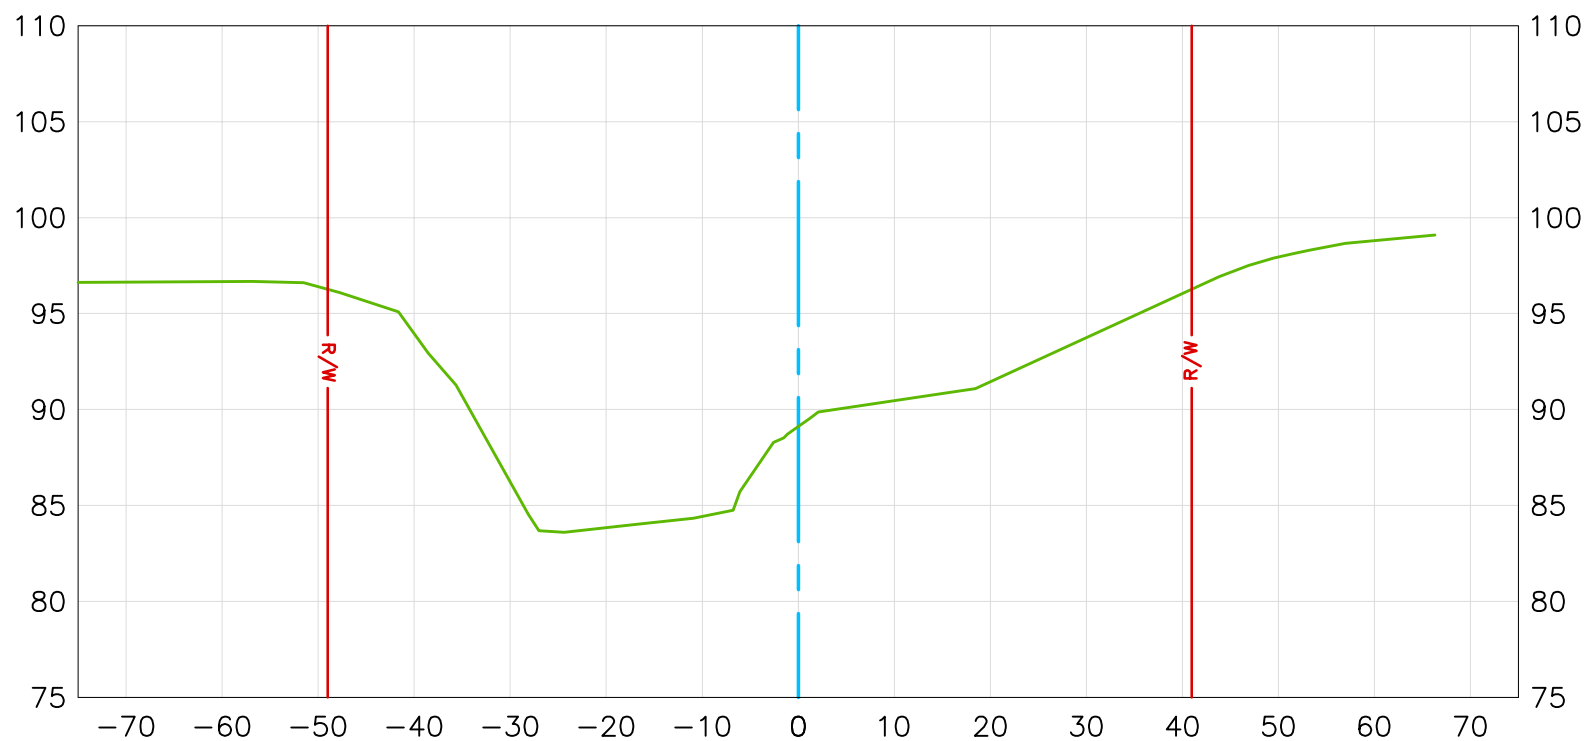

Vert. Scale 1"=10
Horiz. Scale 1"=20

EXISTING CONDITION 2020 
RIGHT OF WAY 

DATE PREPARED: 02/11/2020

U.S. Survey Foot


OC Public Works
OC Survey/Field Services
Boundary Analysis & Mapping



CARBON CANYON CHANNEL

323+50.00

CL

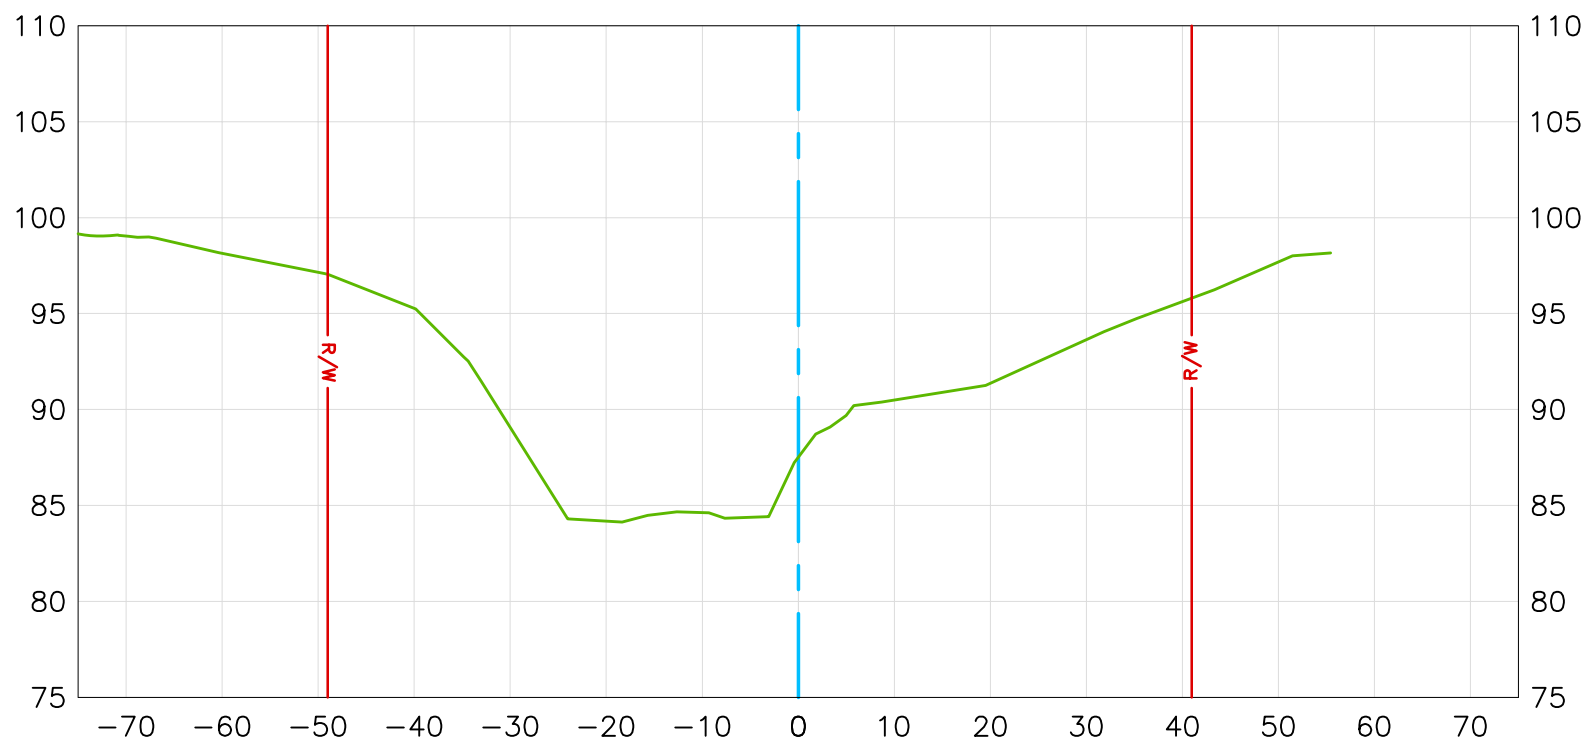

Vert. Scale 1"=10
Horiz. Scale 1"=20

EXISTING CONDITION 2020 
RIGHT OF WAY 

DATE PREPARED: 02/11/2020

**U.S. Survey
Foot**


OC Public Works
OC Survey/Field Services
Boundary Analysis & Mapping



CARBON CANYON CHANNEL

324+00.00

CL

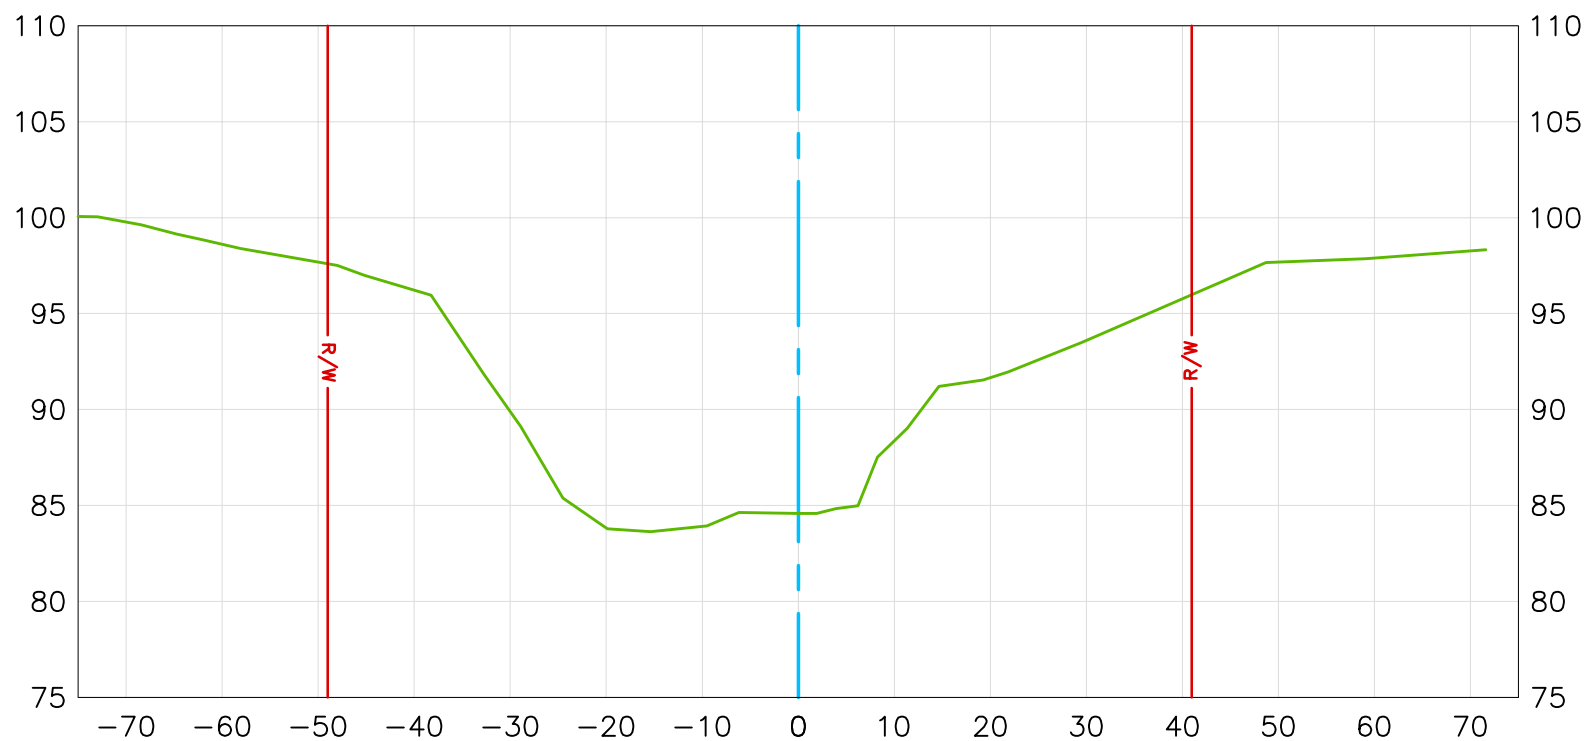

Vert. Scale 1"=10
Horiz. Scale 1"=20

EXISTING CONDITION 2020 —————

RIGHT OF WAY ——— R/W ———

DATE PREPARED: 02/11/2020

U.S. Survey Foot


OC Public Works
OC Survey/Field Services
Boundary Analysis & Mapping



CARBON CANYON CHANNEL

324+50.00

CL

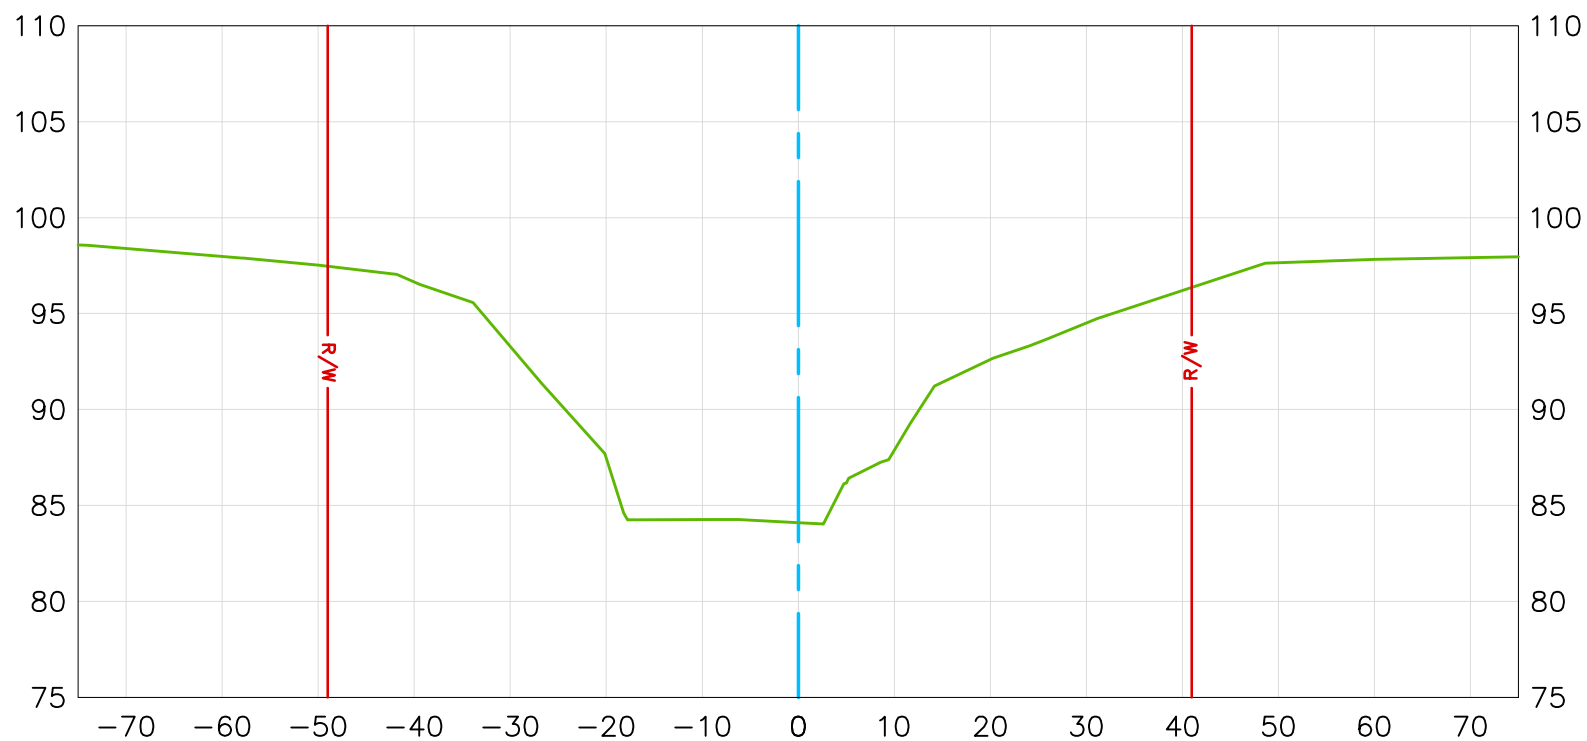

Vert. Scale 1"=10
Horiz. Scale 1"=20

EXISTING CONDITION 2020 

RIGHT OF WAY  R/W

DATE PREPARED: 02/11/2020

**U.S. Survey
Foot**


OC Public Works
OC Survey/Field Services
Boundary Analysis & Mapping



CARBON CANYON CHANNEL

325+00.00

CL

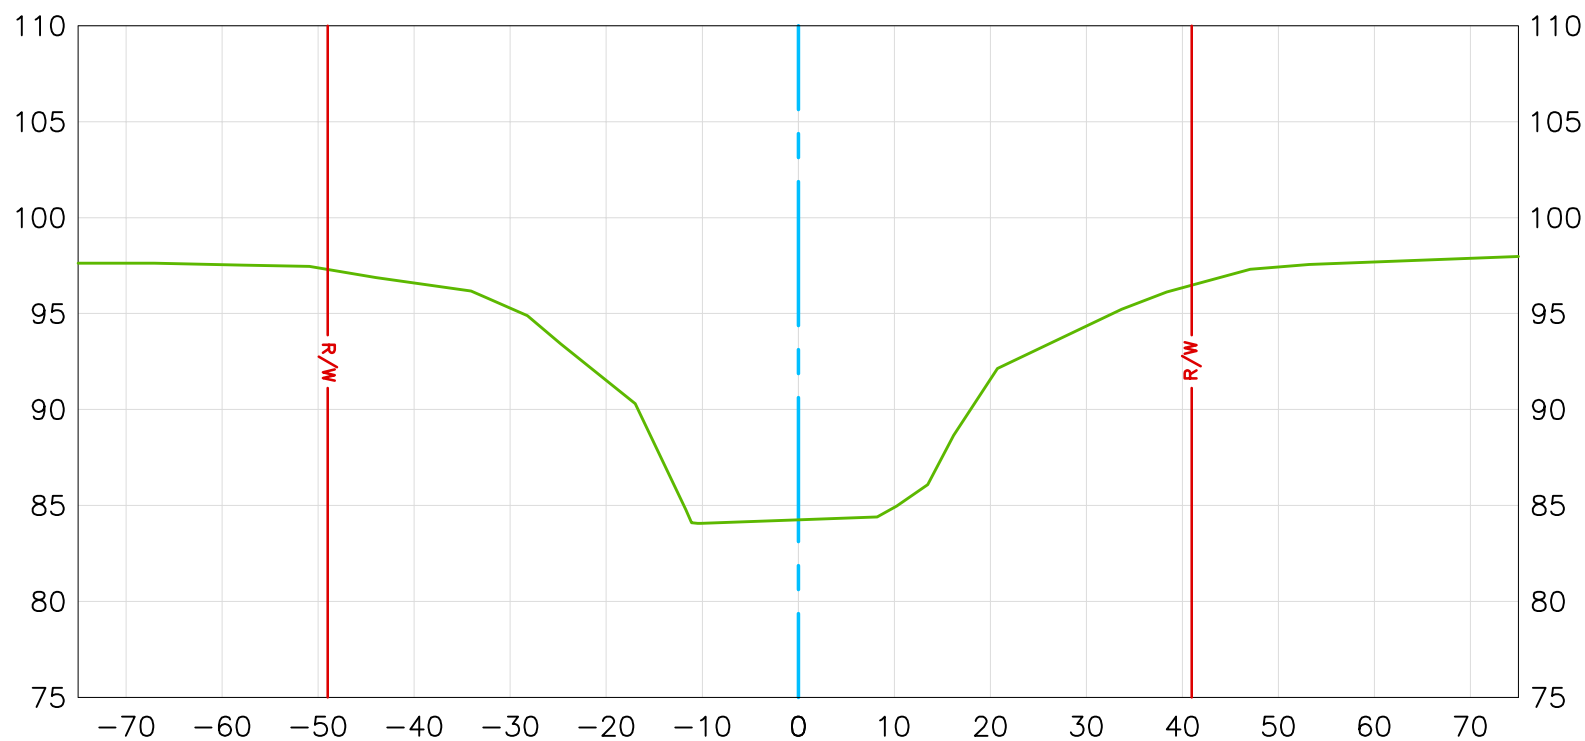

Vert. Scale 1"=10
Horiz. Scale 1"=20

EXISTING CONDITION 2020 —————

RIGHT OF WAY ——— R/W ———

DATE PREPARED: 02/11/2020

**U.S. Survey
Foot**


OC Public Works
OC Survey/Field Services
Boundary Analysis & Mapping



CARBON CANYON CHANNEL

325+50.00

CL

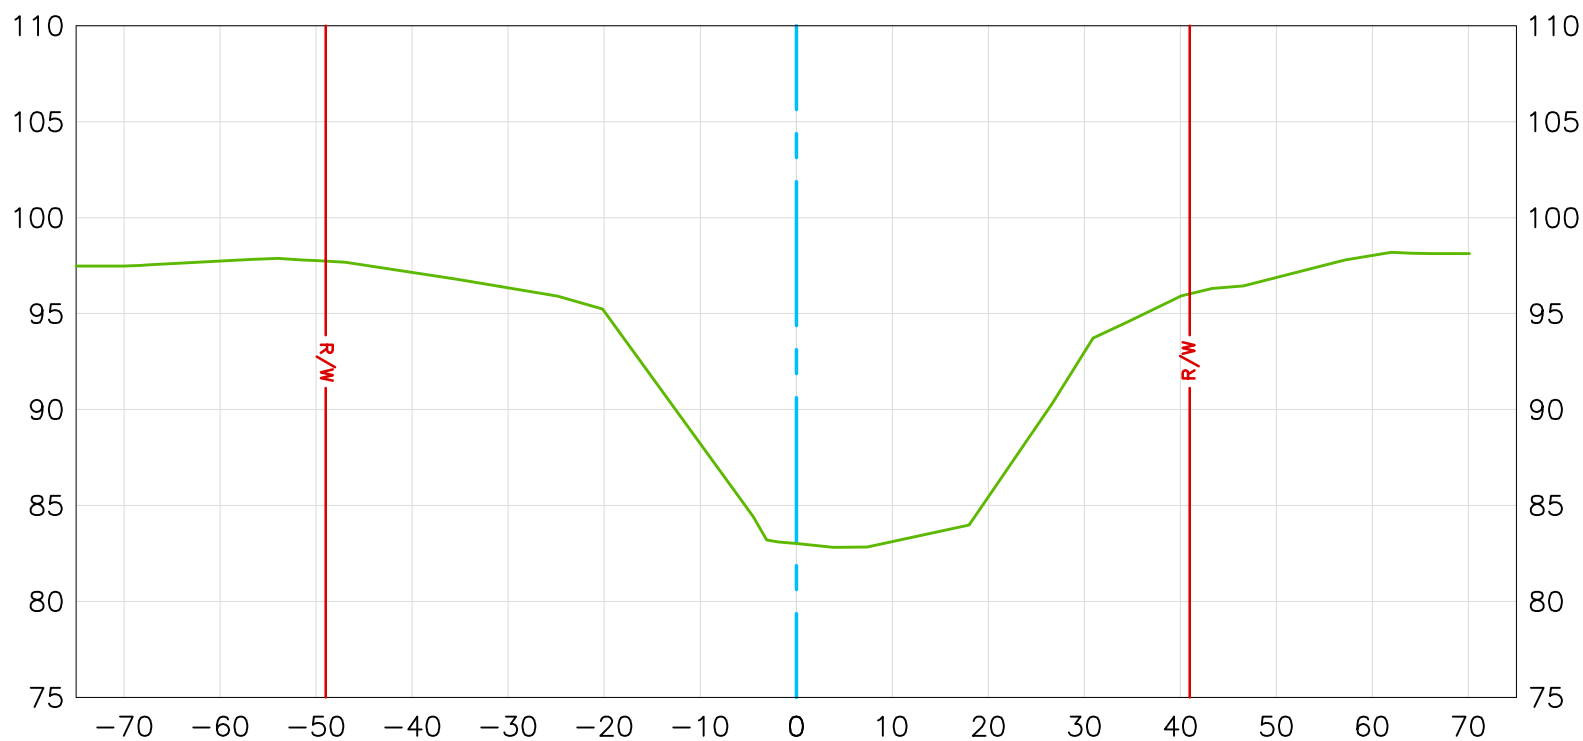

Vert. Scale 1"=10
Horiz. Scale 1"=20

EXISTING CONDITION 2020 
RIGHT OF WAY 

DATE PREPARED: 02/11/2020

U.S. Survey Foot


OC Public Works
OC Survey/Field Services
Boundary Analysis & Mapping



CARBON CANYON CHANNEL

326+00.00

CL

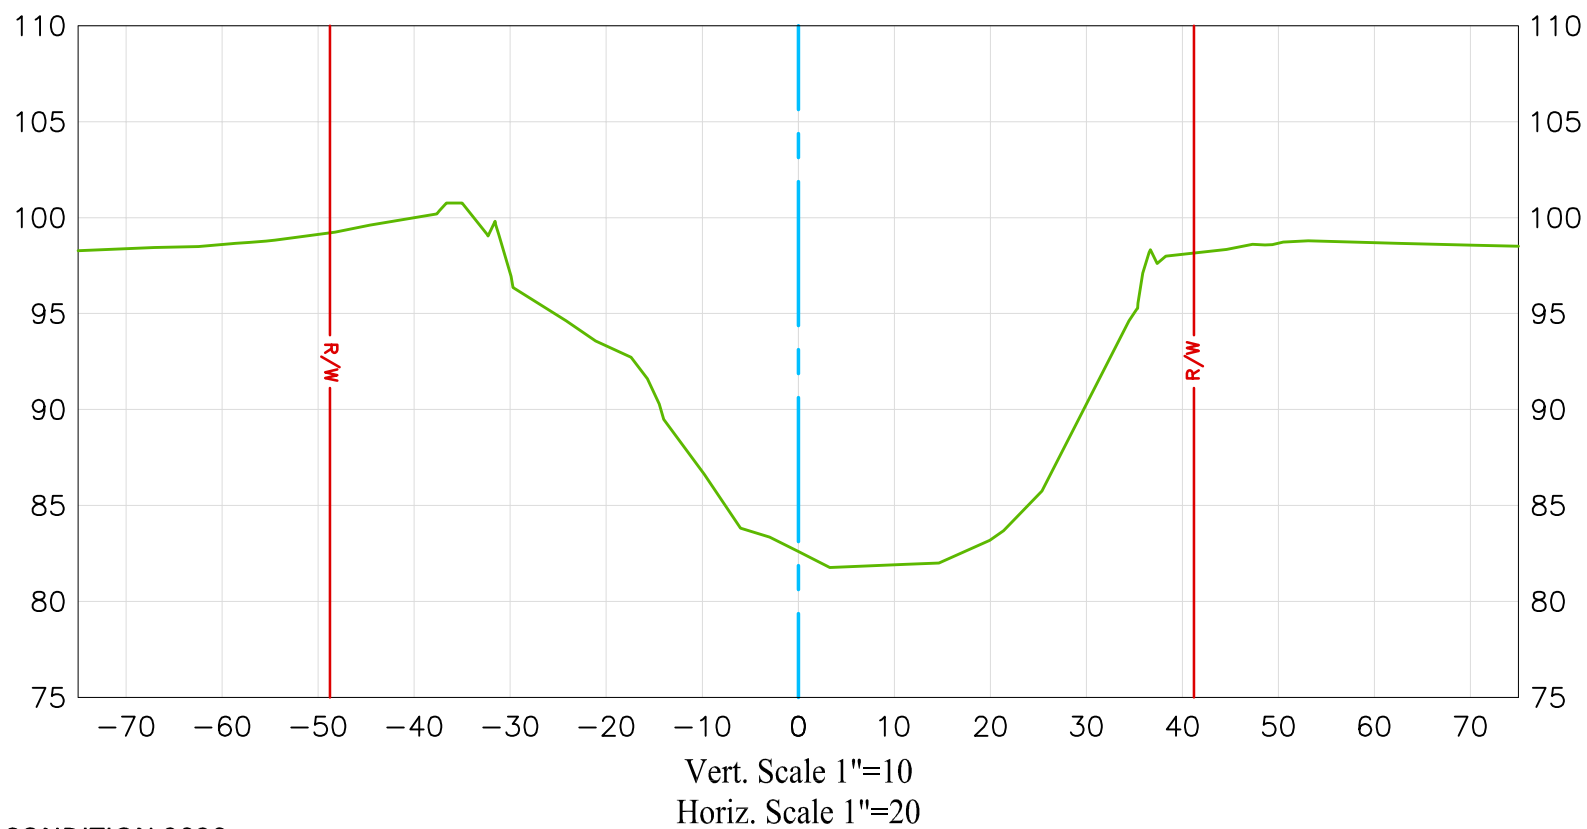

EXISTING CONDITION 2020

RIGHT OF WAY

DATE PREPARED: 02/11/2020

U.S. Survey Foot


OC Public Works
OC Survey/Field Services
Boundary Analysis & Mapping



CARBON CANYON CHANNEL

326+50.00

CL

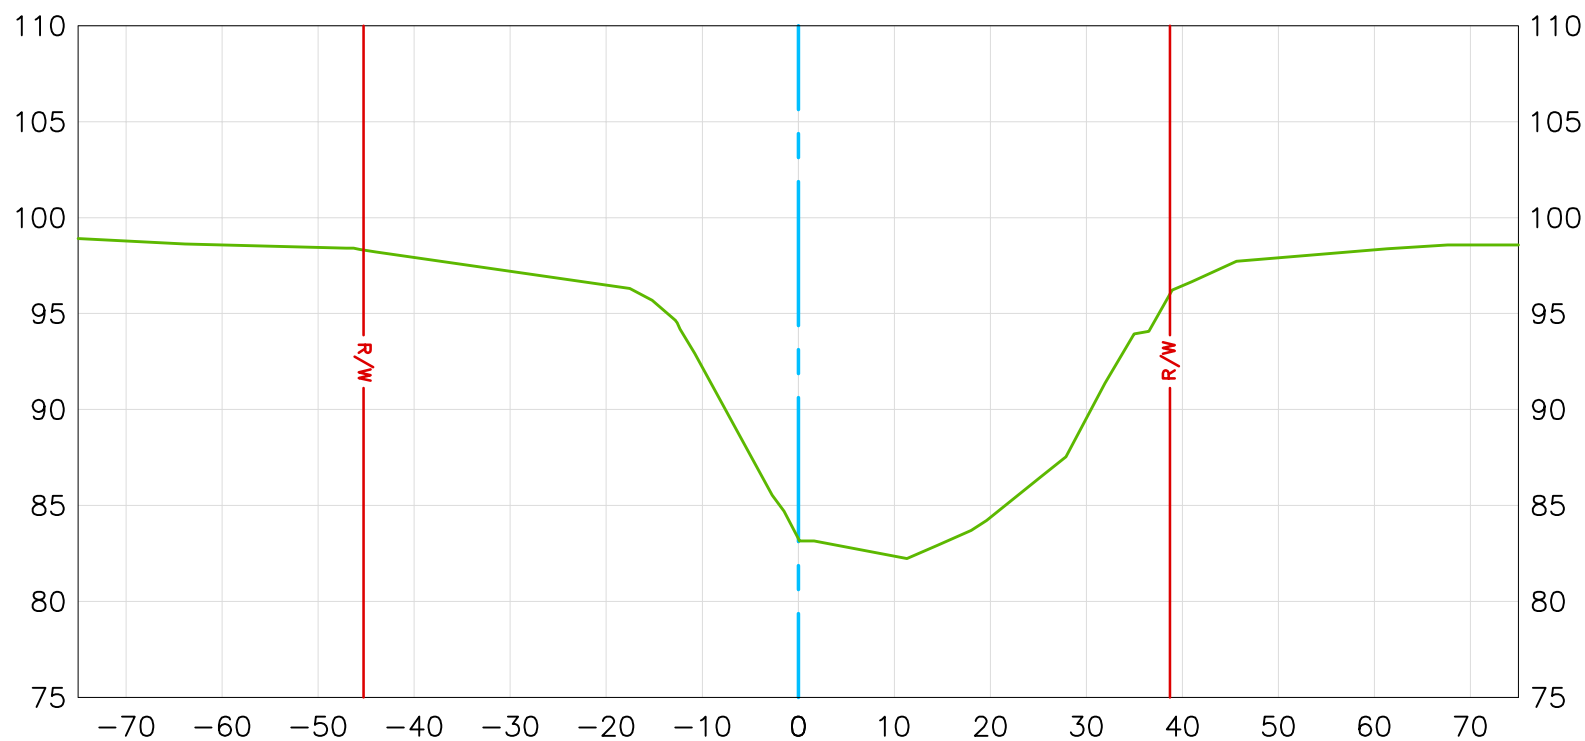

Vert. Scale 1"=10
Horiz. Scale 1"=20

EXISTING CONDITION 2020 

RIGHT OF WAY  R/W 

DATE PREPARED: 02/11/2020

**U.S. Survey
Foot**


OC Public Works
OC Survey/Field Services
Boundary Analysis & Mapping



CARBON CANYON CHANNEL

327+00.00

CL

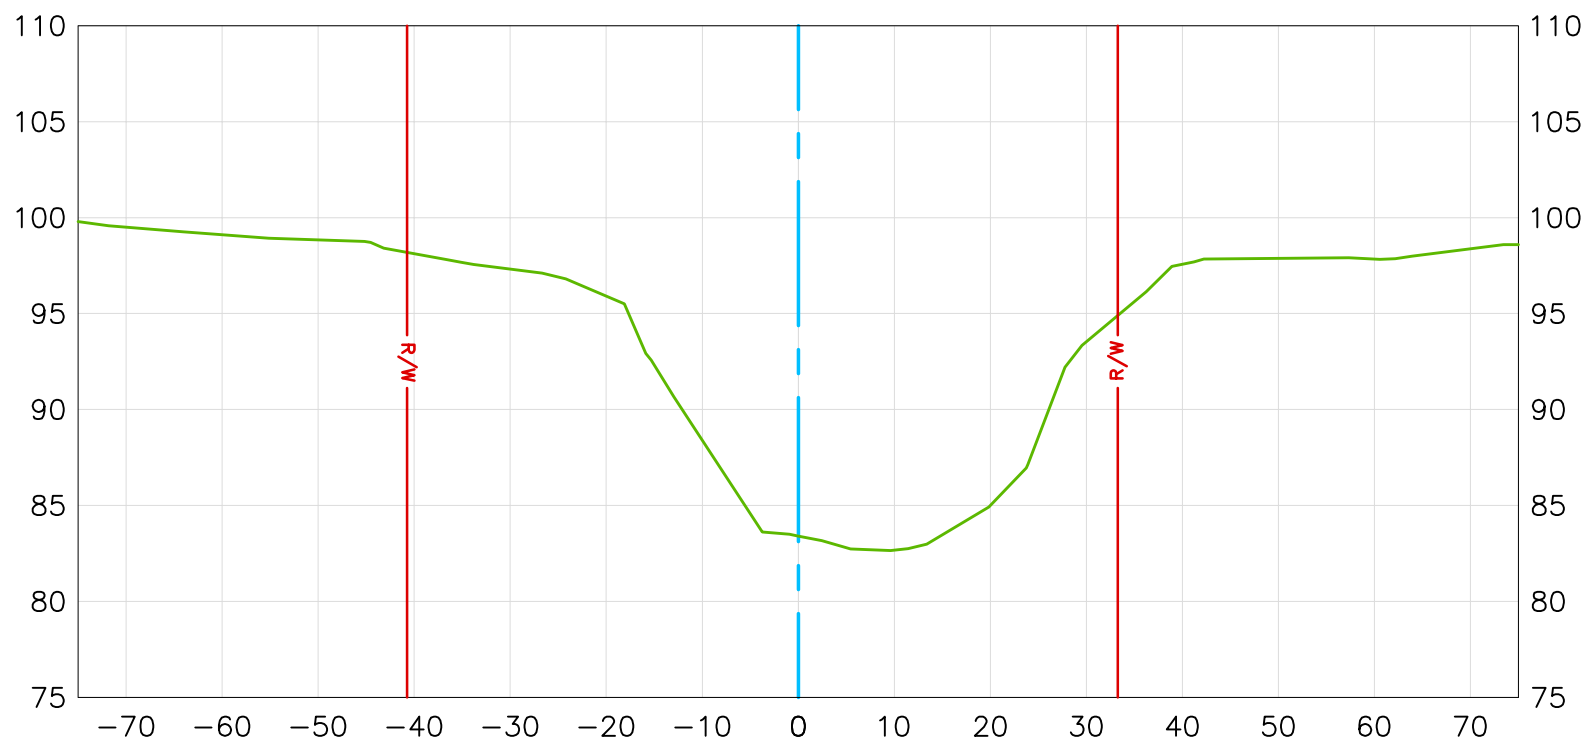

Vert. Scale 1"=10
Horiz. Scale 1"=20

EXISTING CONDITION 2020 
RIGHT OF WAY 

DATE PREPARED: 02/11/2020

**U.S. Survey
Foot**


OC Public Works
OC Survey/Field Services
Boundary Analysis & Mapping



CARBON CANYON CHANNEL

327+50.00

CL

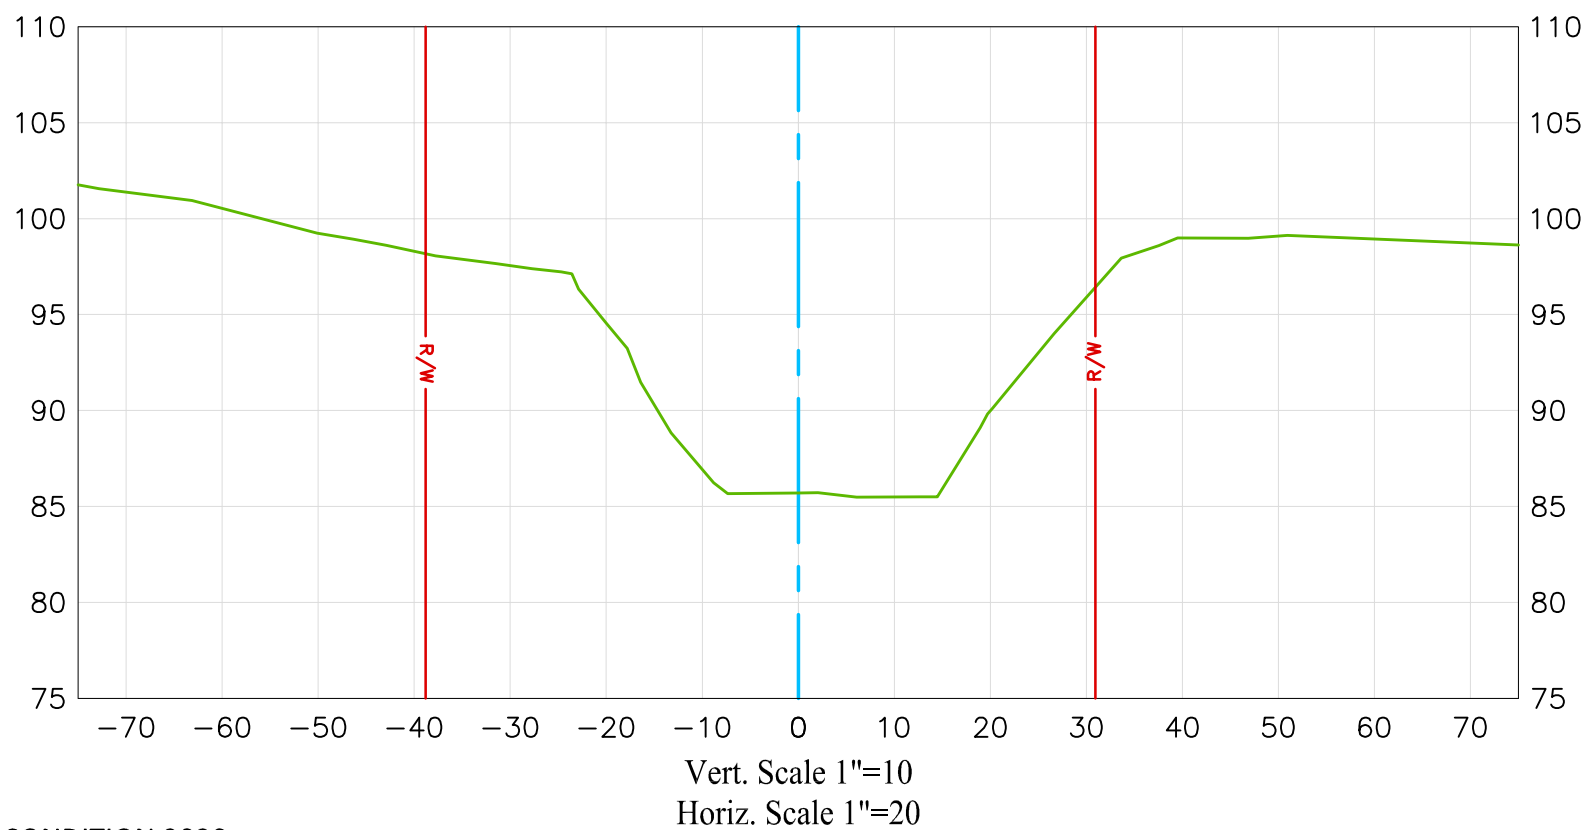

EXISTING CONDITION 2020 —————

RIGHT OF WAY ——— R/W ———

DATE PREPARED: 02/11/2020

U.S. Survey Foot


OC Public Works
OC Survey/Field Services
Boundary Analysis & Mapping



CARBON CANYON CHANNEL

328+00.00

CL

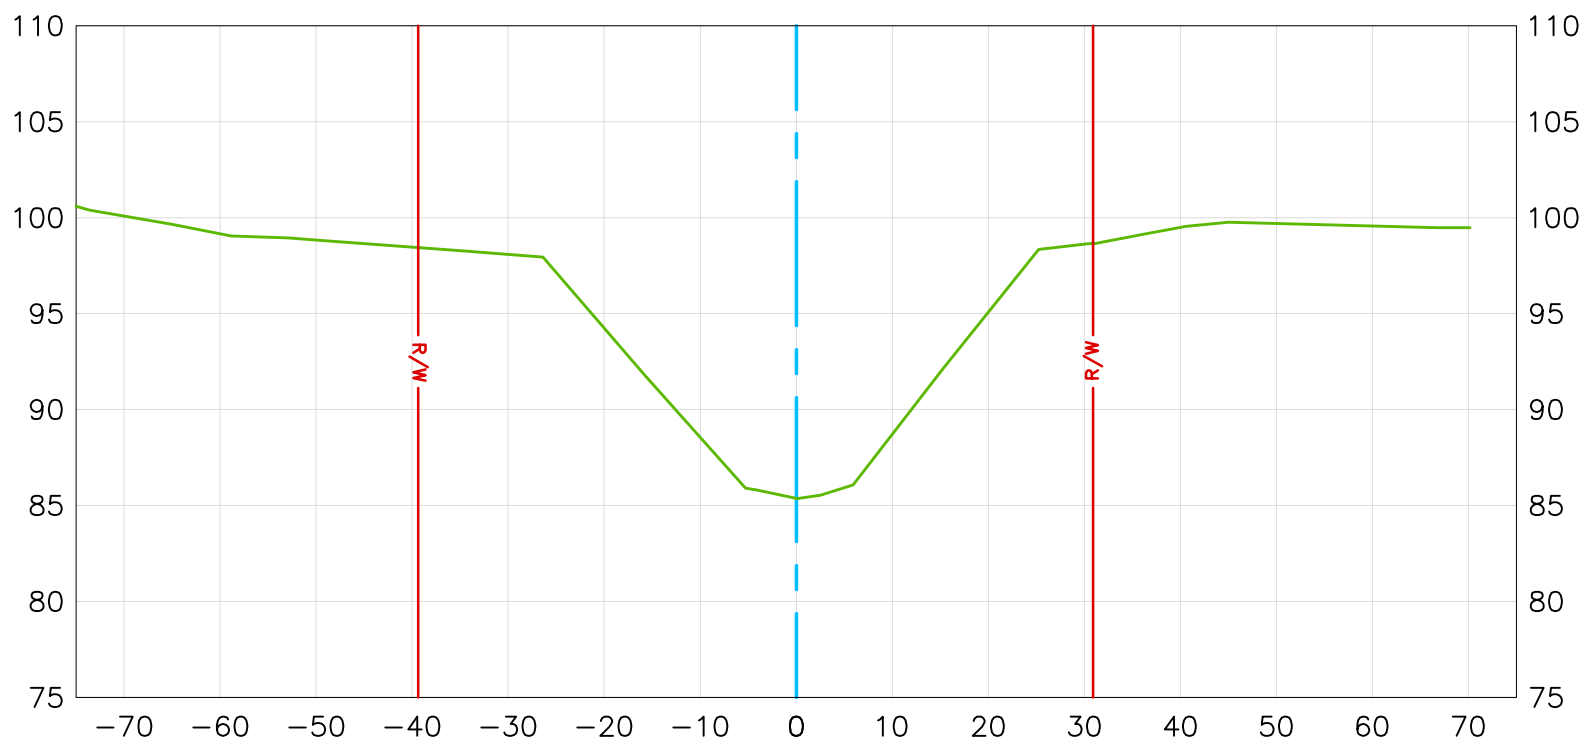

Vert. Scale 1"=10
Horiz. Scale 1"=20

EXISTING CONDITION 2020

RIGHT OF WAY

DATE PREPARED: 02/11/2020

**U.S. Survey
Foot**


OC Public Works
OC Survey/Field Services
Boundary Analysis & Mapping



CARBON CANYON CHANNEL

328+50.00

CL

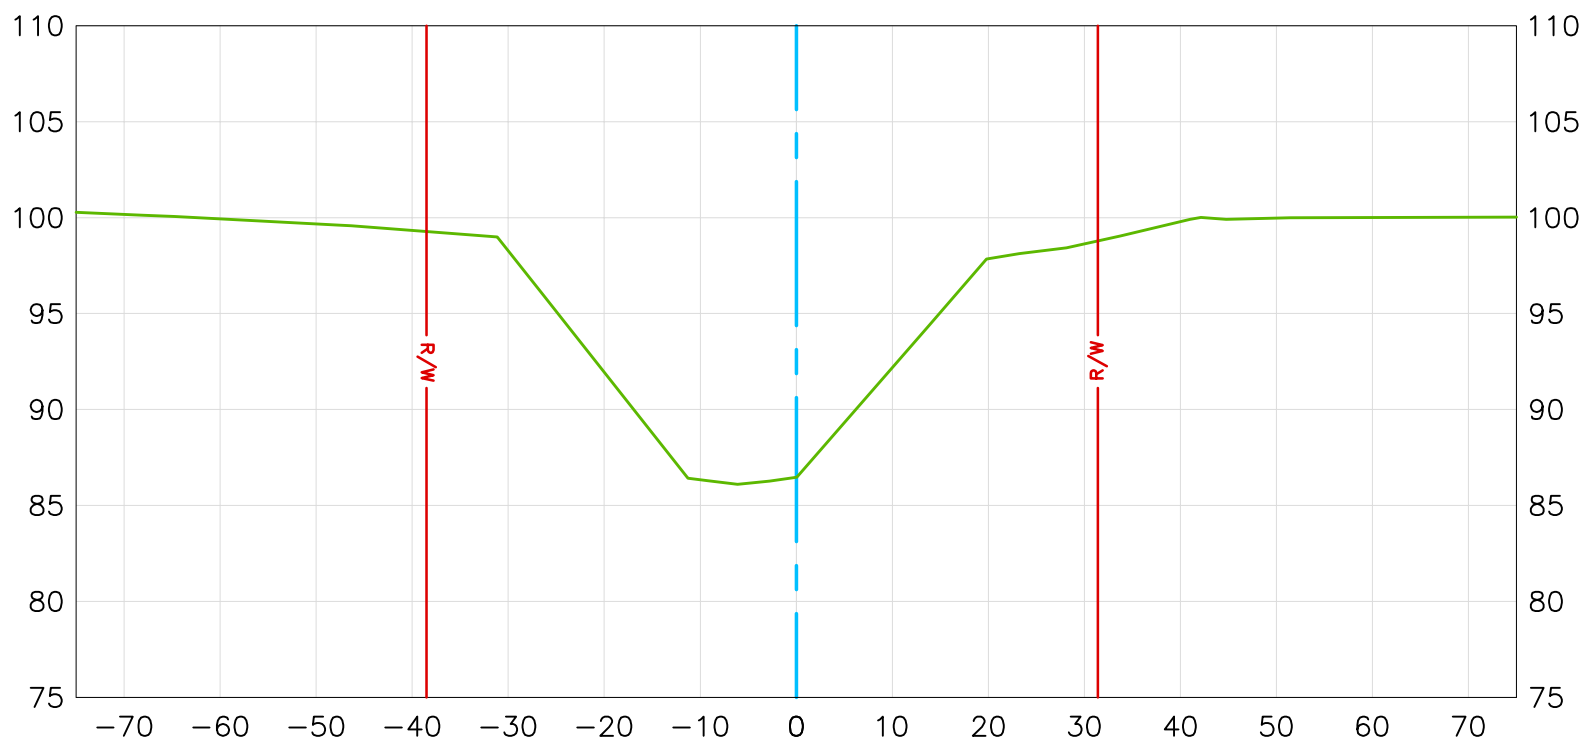

Vert. Scale 1"=10
Horiz. Scale 1"=20

EXISTING CONDITION 2020 —————

RIGHT OF WAY ——— R/W ———

DATE PREPARED: 02/11/2020

**U.S. Survey
Foot**


OC Public Works
OC Survey/Field Services
Boundary Analysis & Mapping



CARBON CANYON CHANNEL

329+00.00

CL

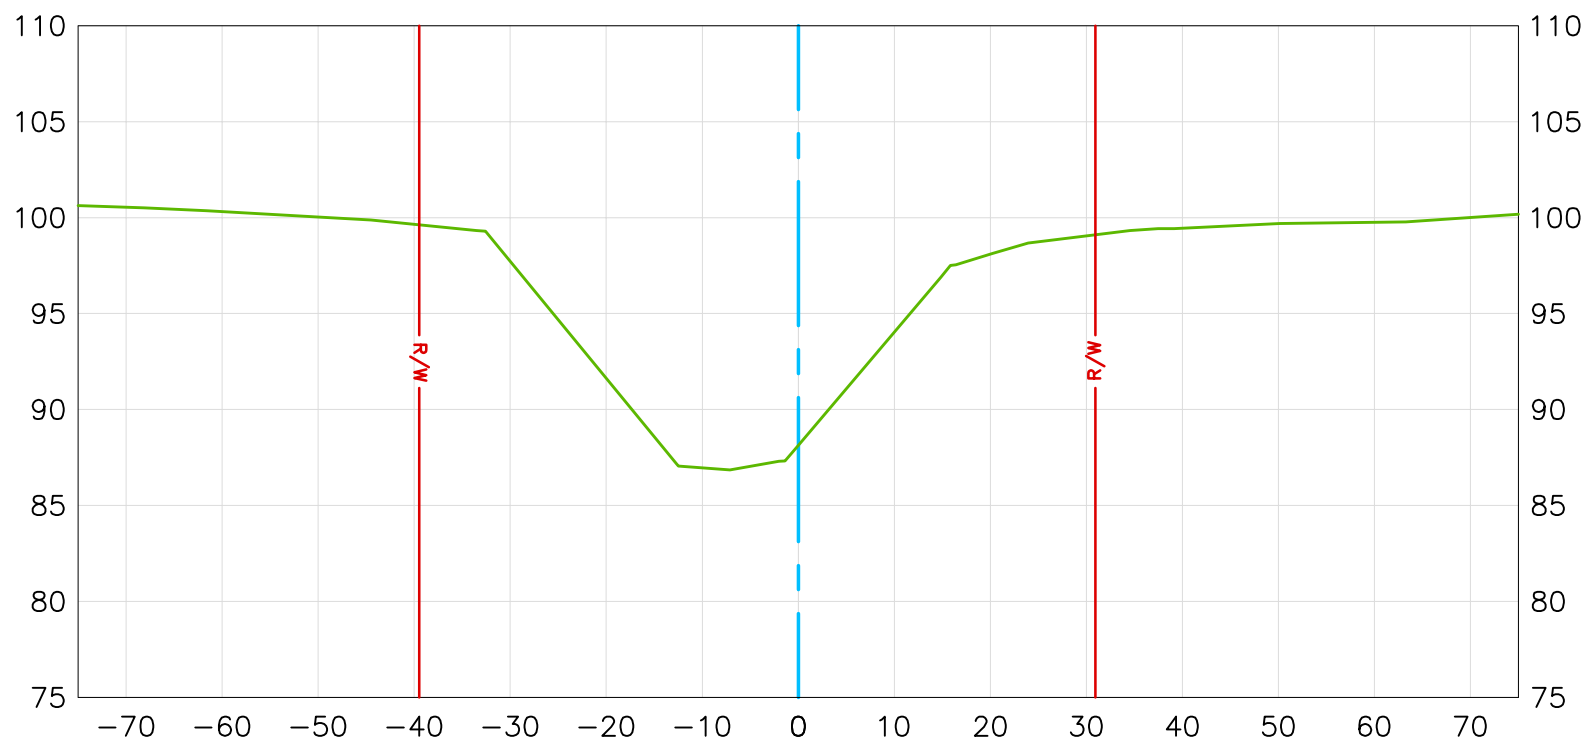

Vert. Scale 1"=10
Horiz. Scale 1"=20

EXISTING CONDITION 2020

RIGHT OF WAY

DATE PREPARED: 02/11/2020

**U.S. Survey
Foot**


OC Public Works
OC Survey/Field Services
Boundary Analysis & Mapping



CARBON CANYON CHANNEL

329+50.00

CL

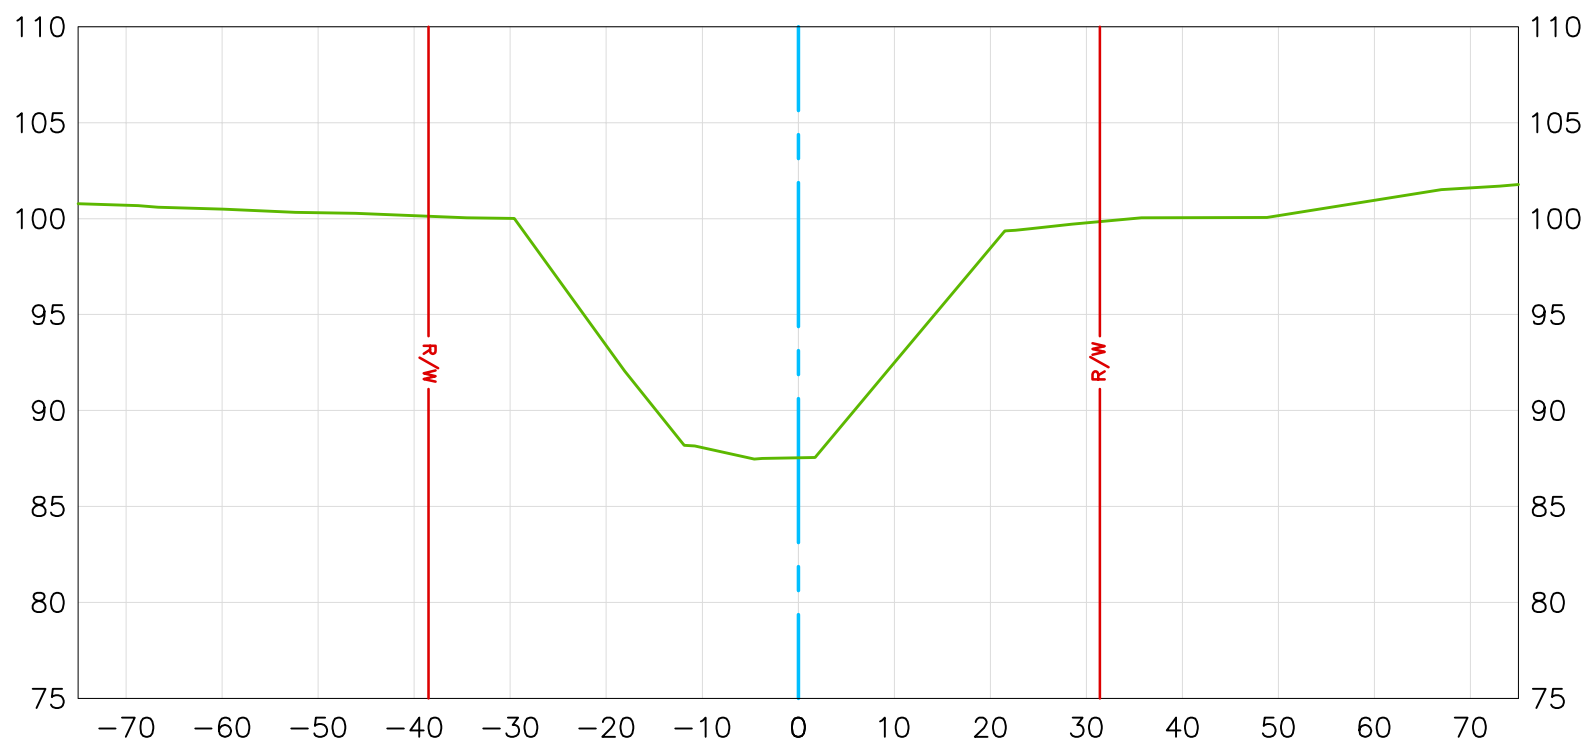

Vert. Scale 1"=10
Horiz. Scale 1"=20

EXISTING CONDITION 2020 —————

RIGHT OF WAY ——— R/W ———

DATE PREPARED: 02/11/2020

U.S. Survey Foot


OC Public Works
OC Survey/Field Services
Boundary Analysis & Mapping



CARBON CANYON CHANNEL

330+00.00

CL

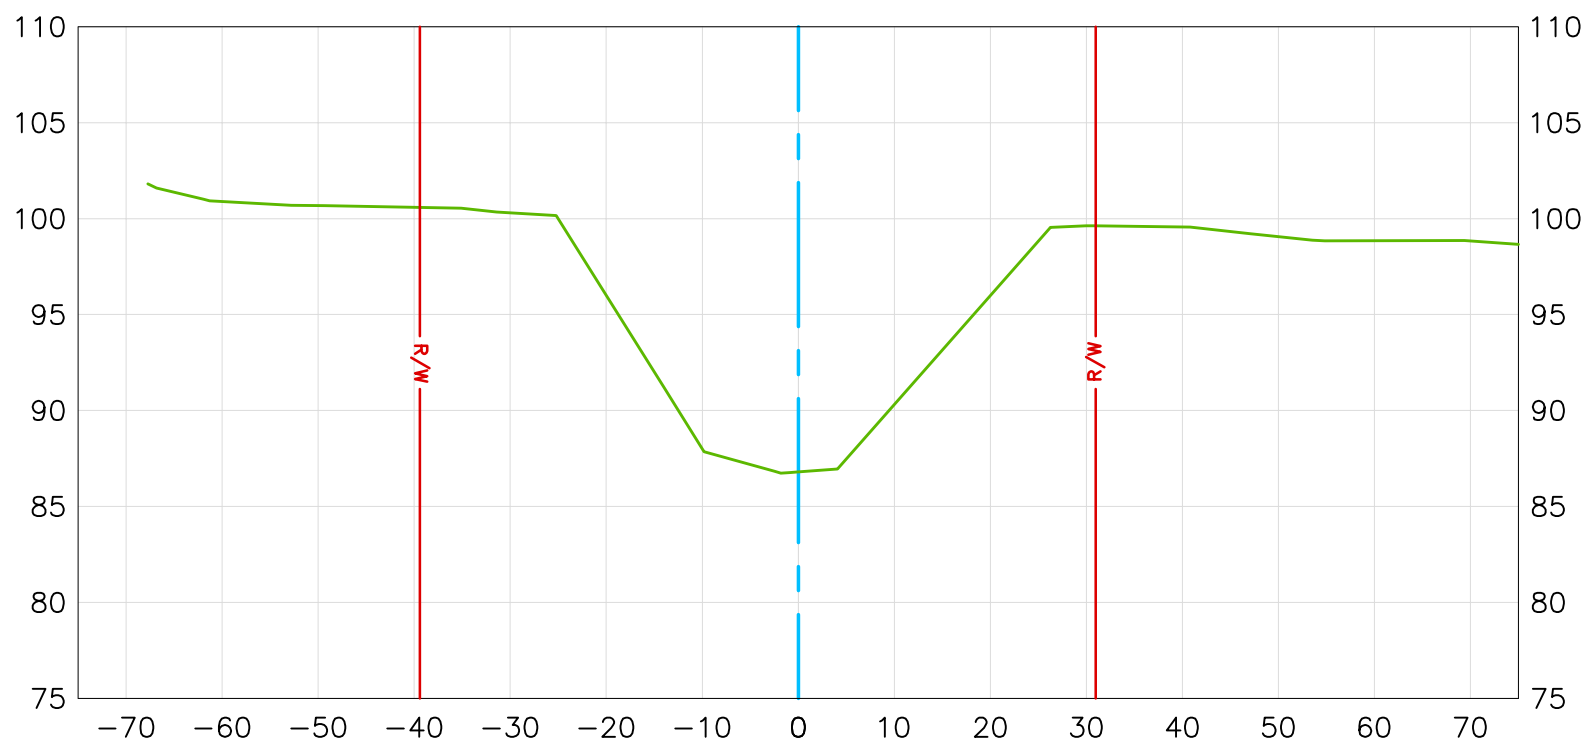

Vert. Scale 1"=10
Horiz. Scale 1"=20

EXISTING CONDITION 2020 

RIGHT OF WAY  R/W

DATE PREPARED: 02/11/2020

U.S. Survey Foot


OC Public Works
OC Survey/Field Services
Boundary Analysis & Mapping



CARBON CANYON CHANNEL

330+50.00

CL

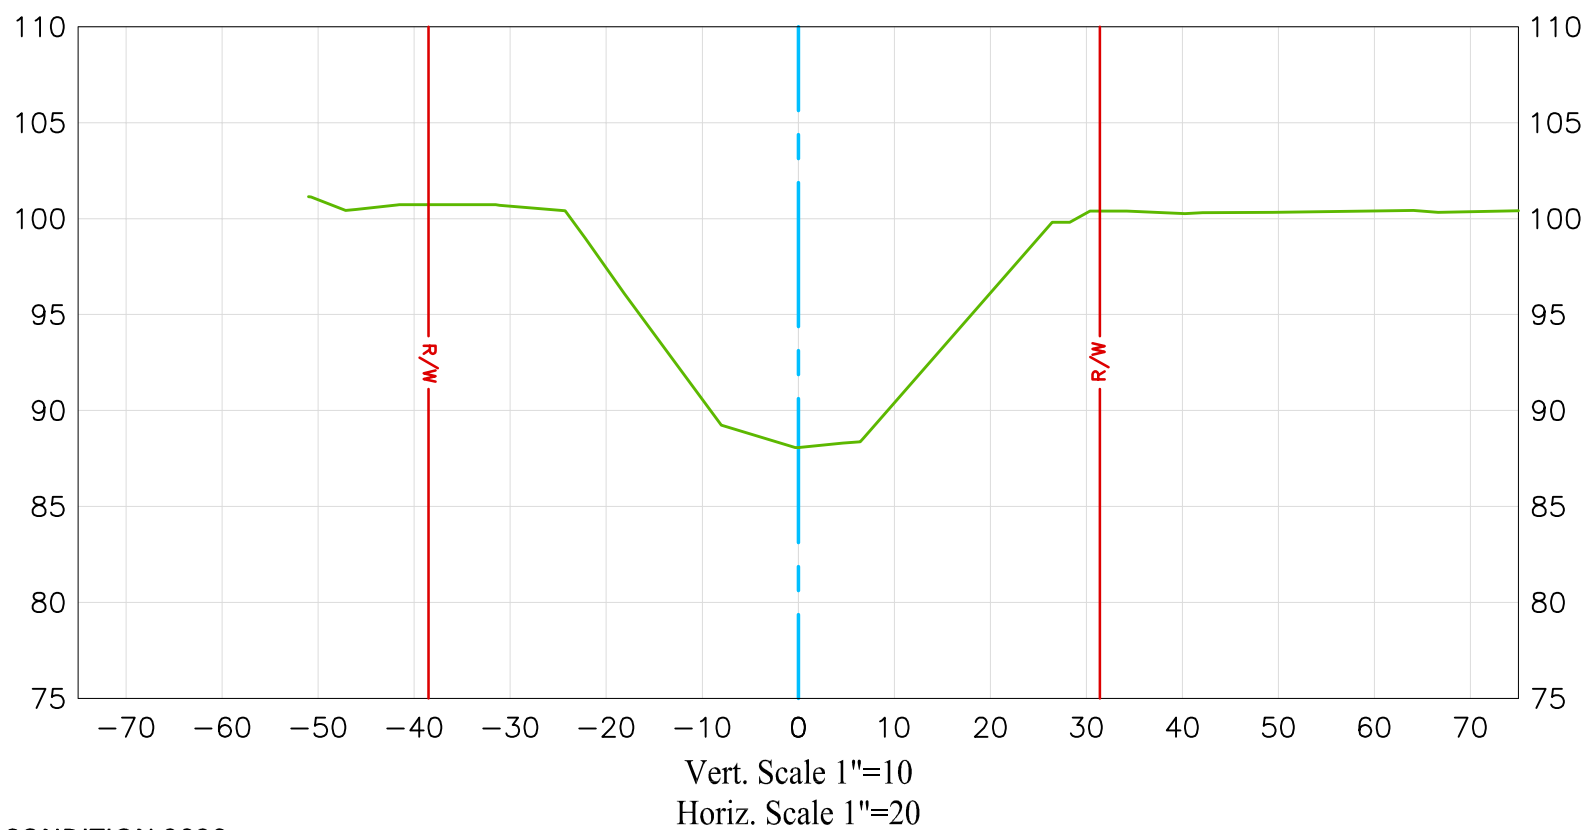

EXISTING CONDITION 2020

RIGHT OF WAY

DATE PREPARED: 02/11/2020

U.S. Survey Foot


OC Public Works
OC Survey/Field Services
Boundary Analysis & Mapping



CARBON CANYON CHANNEL

331+00.00

CL

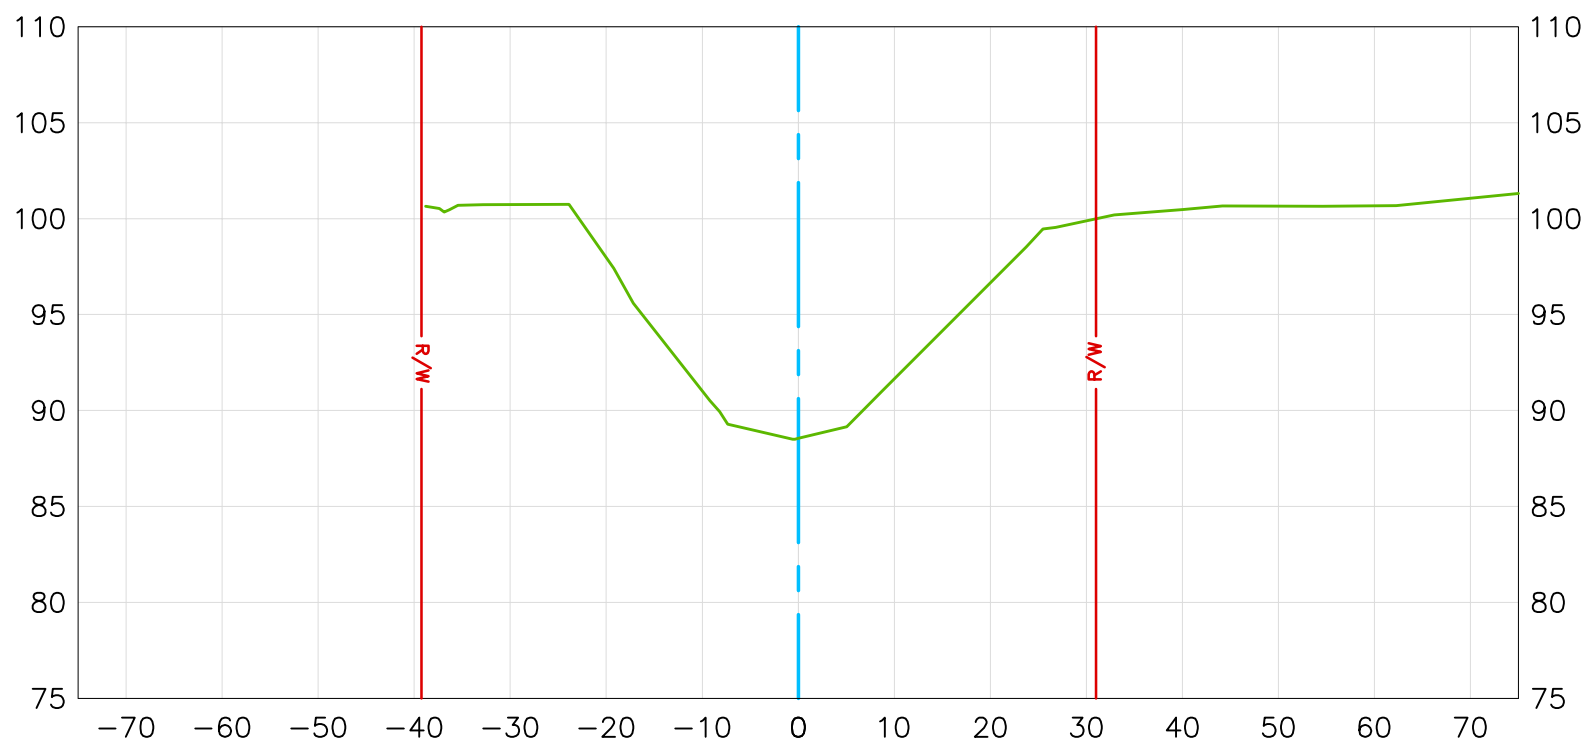

Vert. Scale 1"=10
Horiz. Scale 1"=20

EXISTING CONDITION 2020 
RIGHT OF WAY  R/W

DATE PREPARED: 02/11/2020

**U.S. Survey
Foot**


OC Public Works
OC Survey/Field Services
Boundary Analysis & Mapping



CARBON CANYON CHANNEL

331+50.00

CL

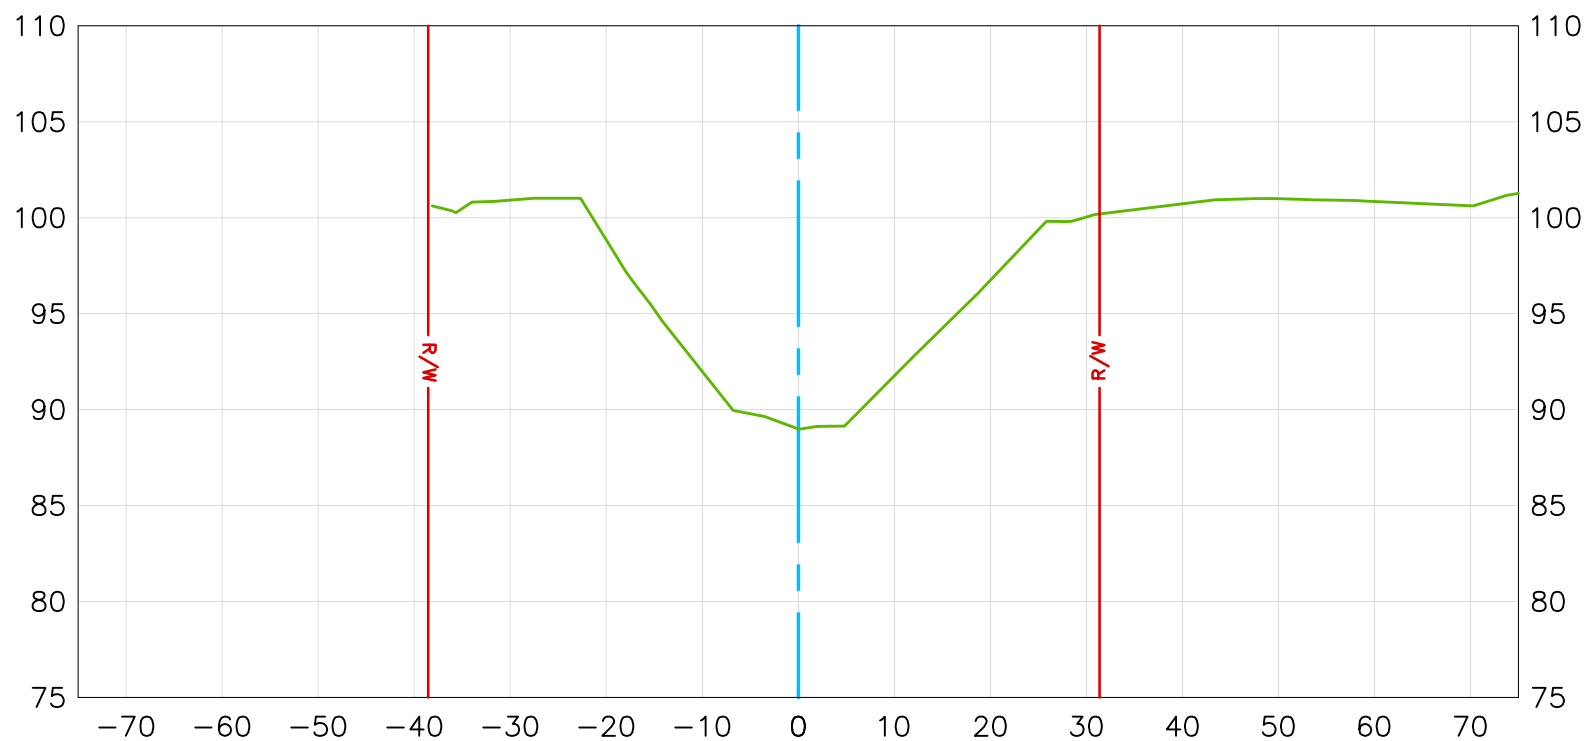

Vert. Scale 1"=10
Horiz. Scale 1"=20

EXISTING CONDITION 2020 
RIGHT OF WAY  R/W

DATE PREPARED: 02/11/2020

U.S. Survey Foot


OC Public Works
OC Survey/Field Services
Boundary Analysis & Mapping



CARBON CANYON CHANNEL

332+00.00

CL

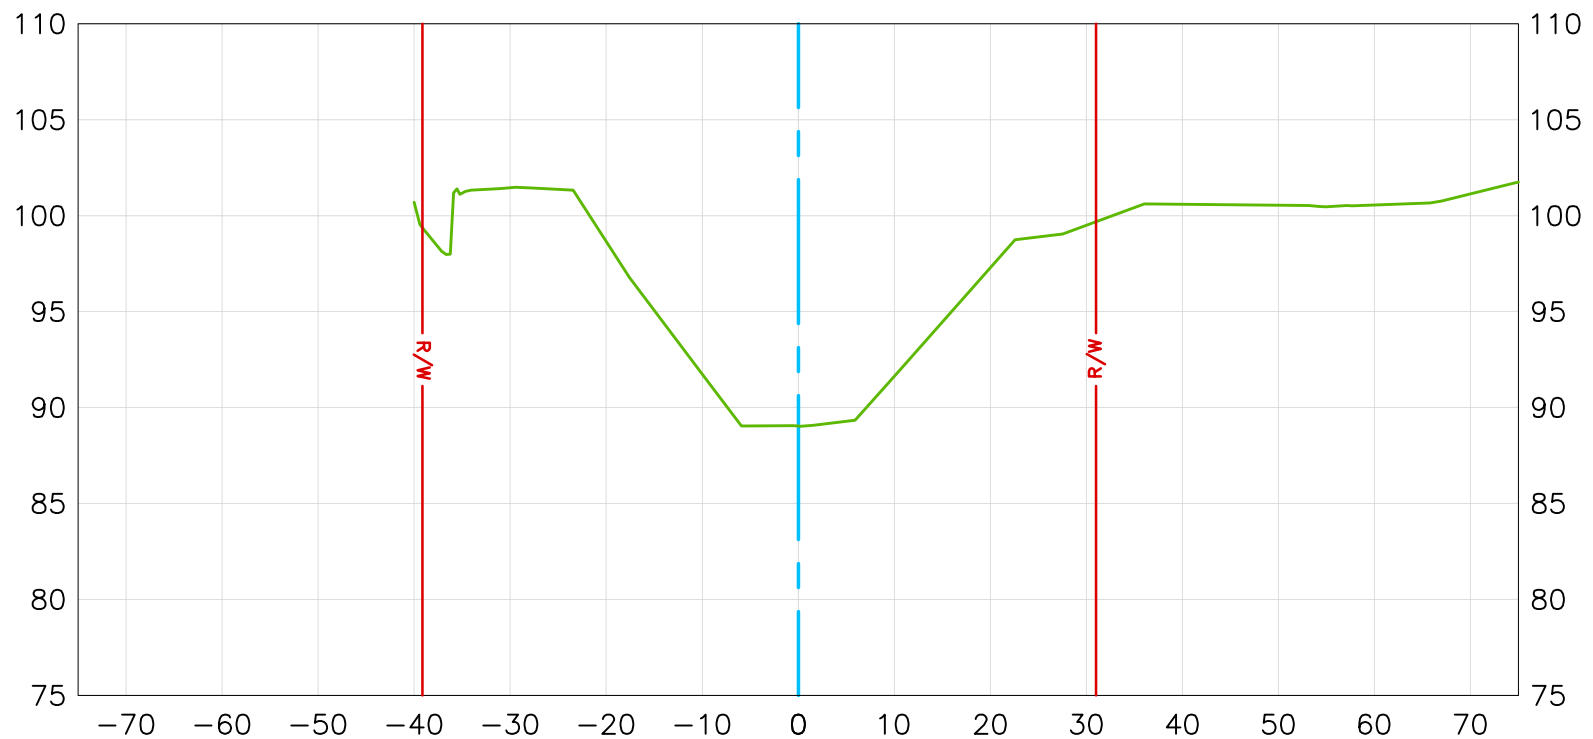

Vert. Scale 1"=10
Horiz. Scale 1"=20

EXISTING CONDITION 2020 

RIGHT OF WAY 

DATE PREPARED: 02/11/2020

**U.S. Survey
Foot**


OC Public Works
OC Survey/Field Services
Boundary Analysis & Mapping



CARBON CANYON CHANNEL

332+50.00

CL

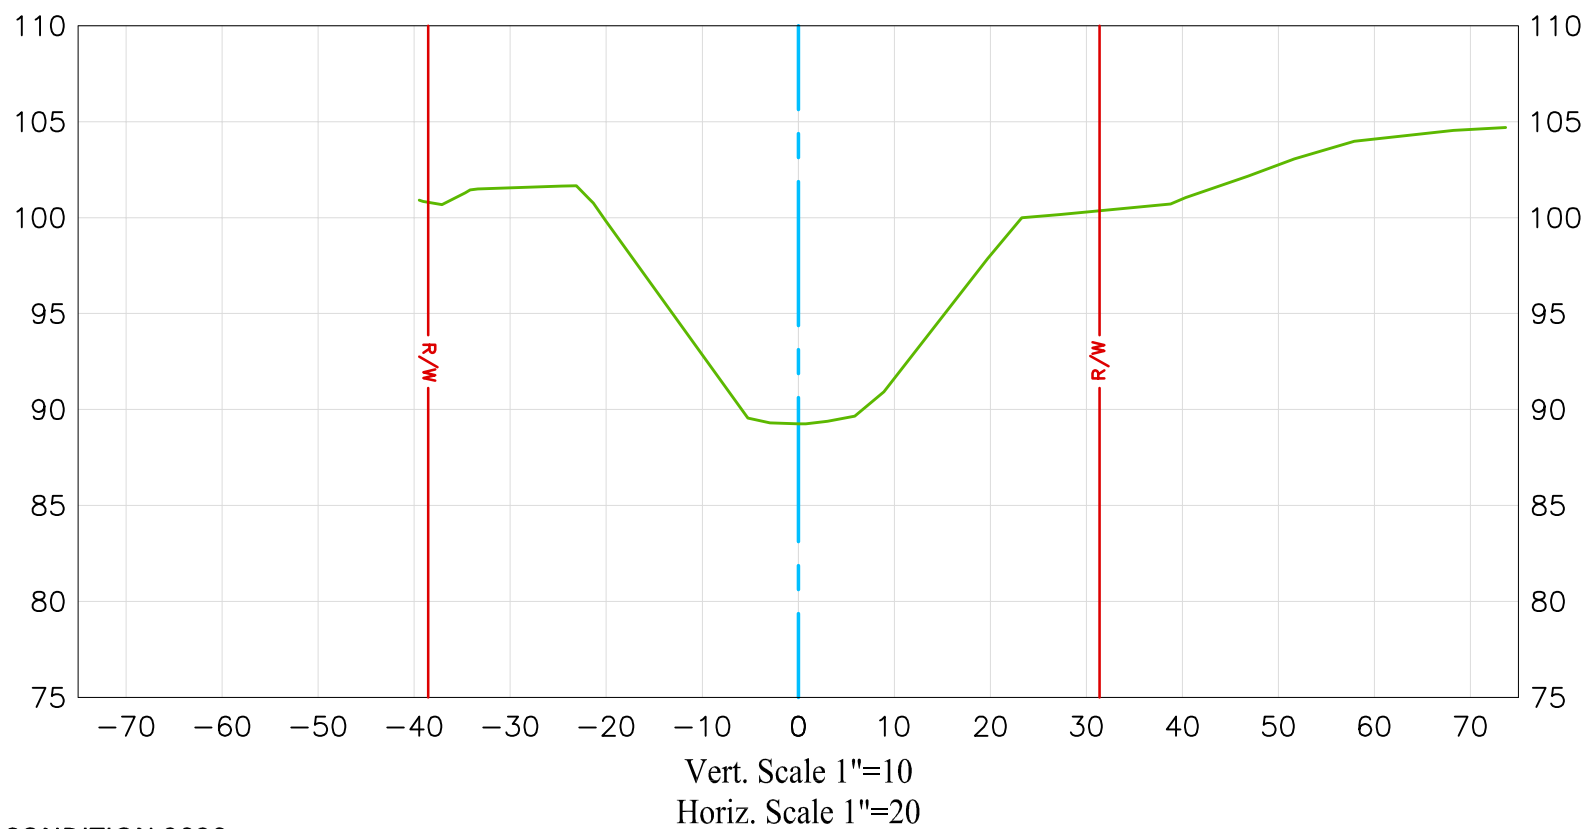

EXISTING CONDITION 2020

RIGHT OF WAY

DATE PREPARED: 02/11/2020

U.S. Survey Foot


OC Public Works
OC Survey/Field Services
Boundary Analysis & Mapping



CARBON CANYON CHANNEL

333+00.00

CL

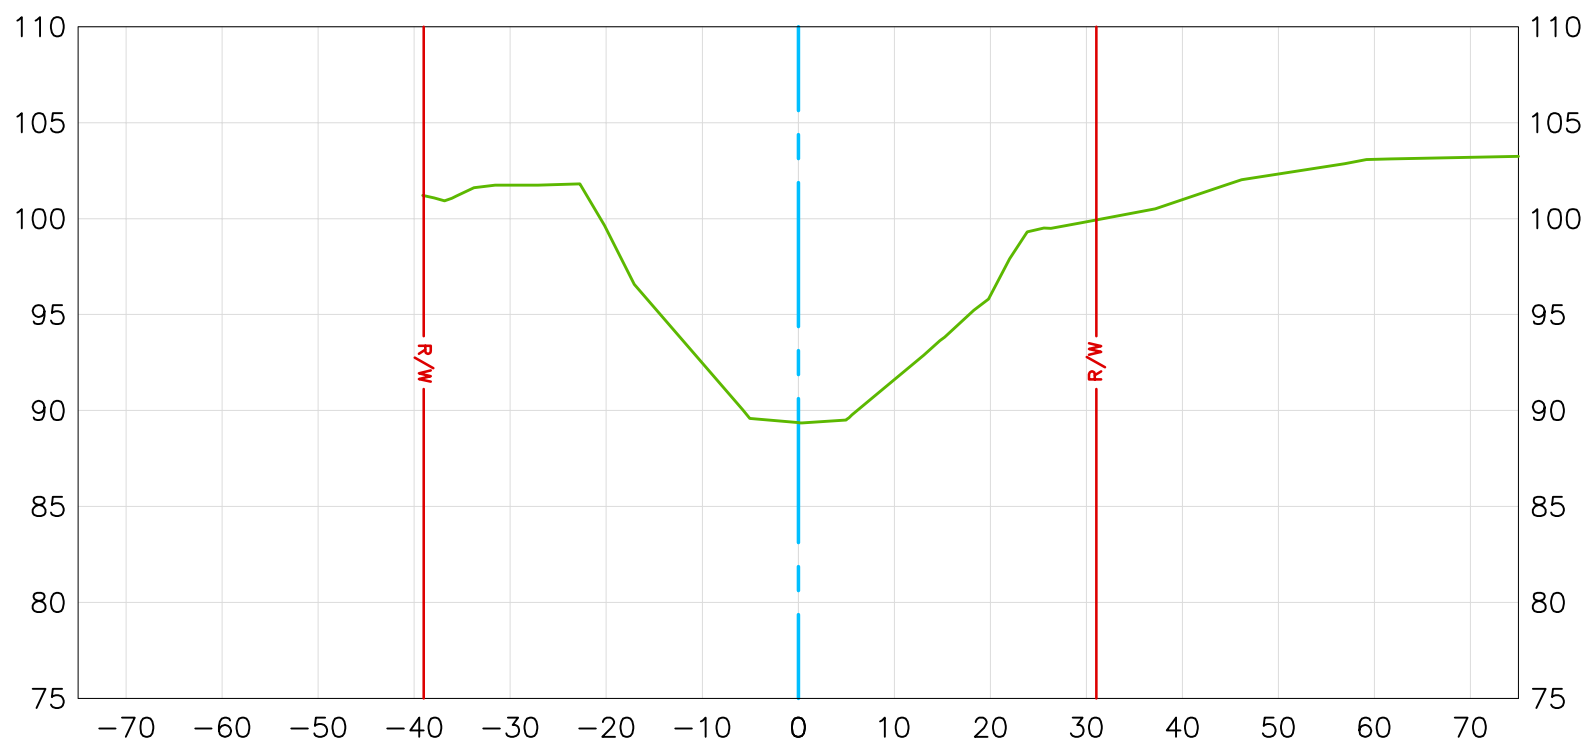

Vert. Scale 1"=10
Horiz. Scale 1"=20

EXISTING CONDITION 2020 

RIGHT OF WAY 

DATE PREPARED: 02/11/2020

U.S. Survey Foot


OC Public Works
OC Survey/Field Services
Boundary Analysis & Mapping



CARBON CANYON CHANNEL

333+50.00

CL

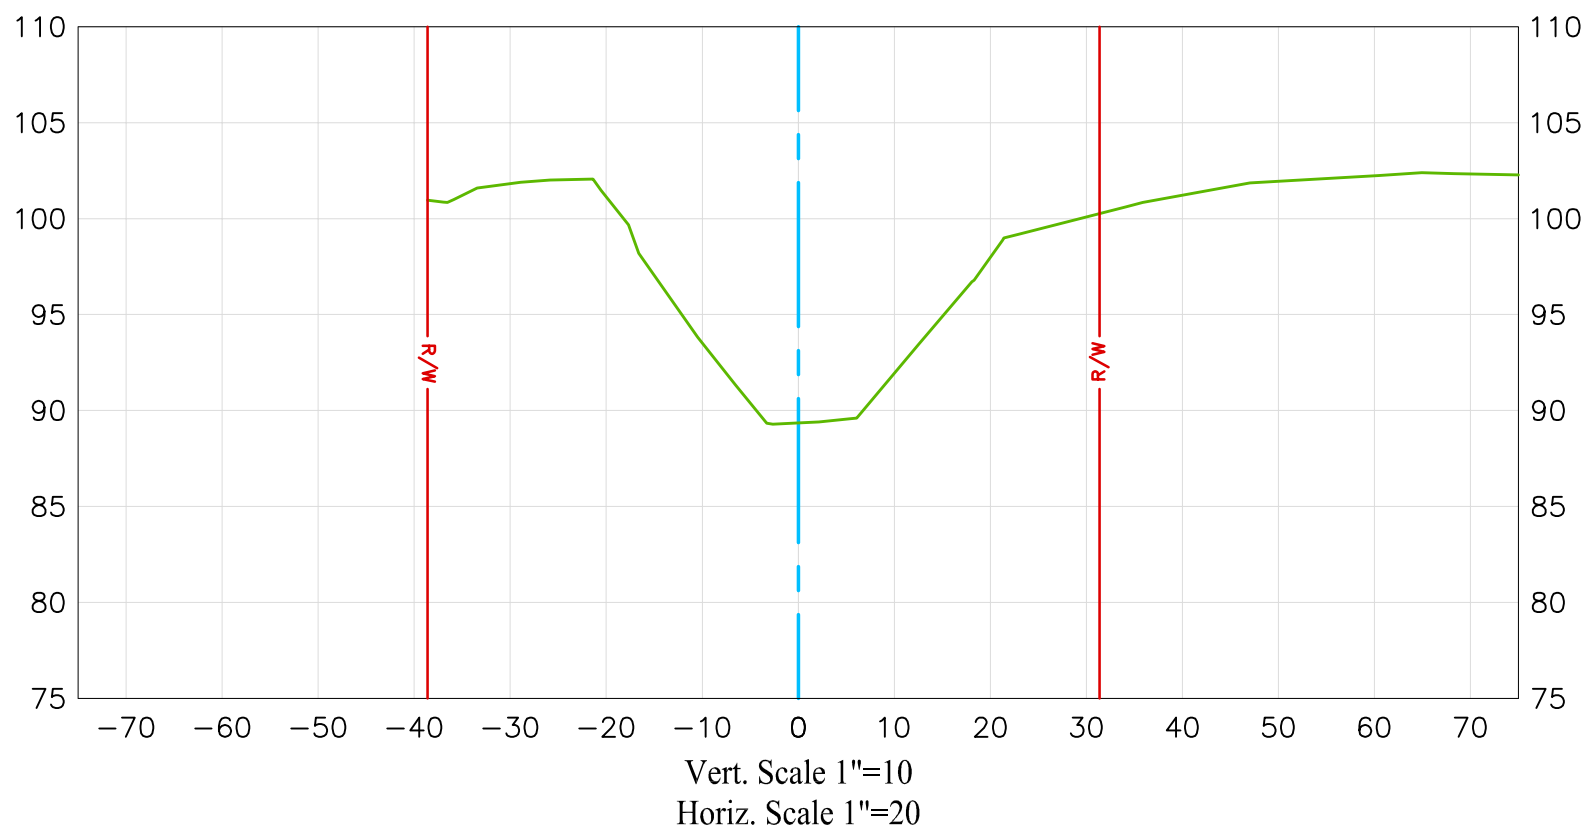

EXISTING CONDITION 2020

RIGHT OF WAY

DATE PREPARED: 02/11/2020

U.S. Survey Foot


OC Public Works
OC Survey/Field Services
Boundary Analysis & Mapping



CARBON CANYON CHANNEL

334+00.00

CL

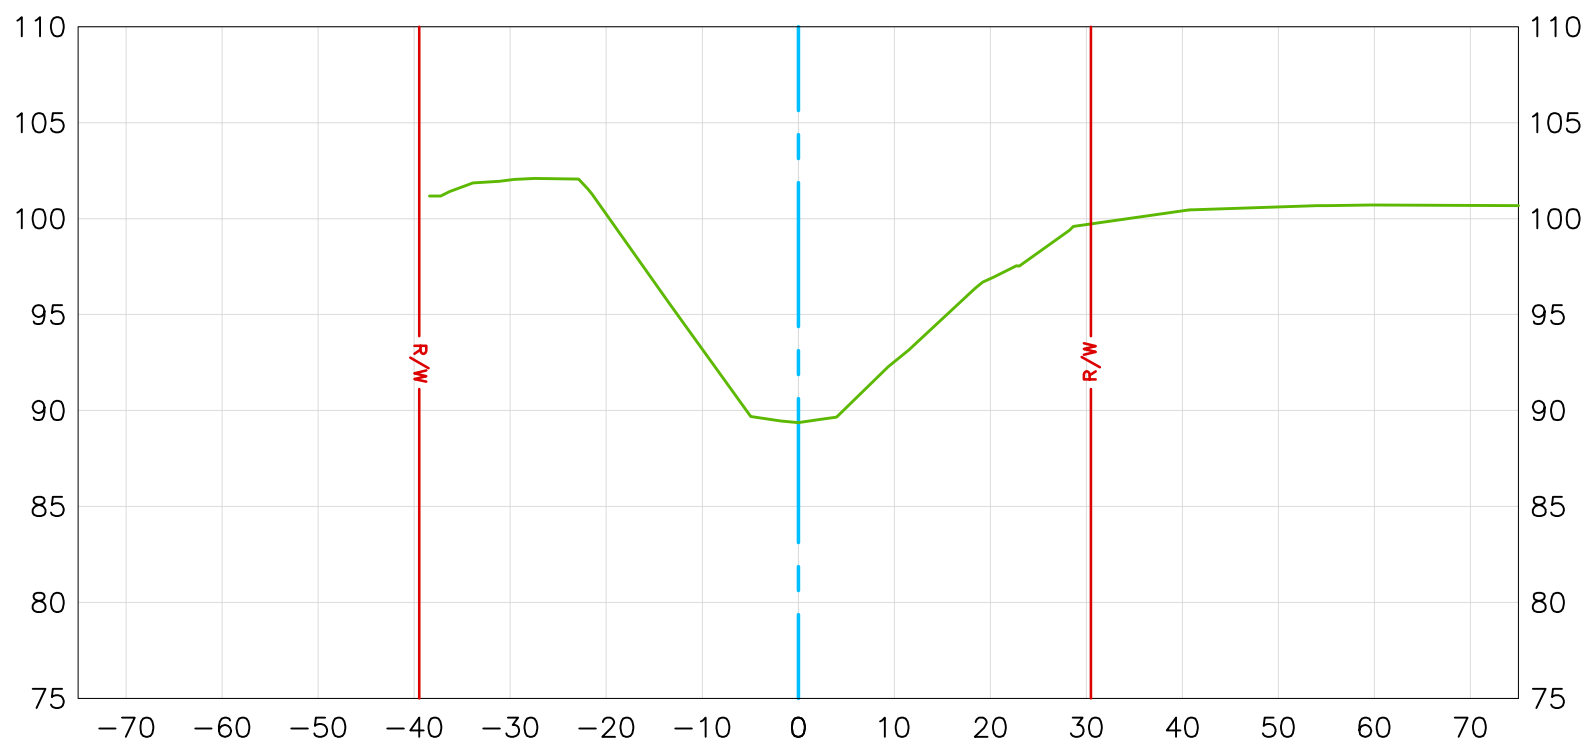

Vert. Scale 1"=10
Horiz. Scale 1"=20

EXISTING CONDITION 2020 

RIGHT OF WAY 

DATE PREPARED: 02/11/2020

U.S. Survey Foot


OC Public Works
OC Survey/Field Services
Boundary Analysis & Mapping



CARBON CANYON CHANNEL

334+50.00

CL

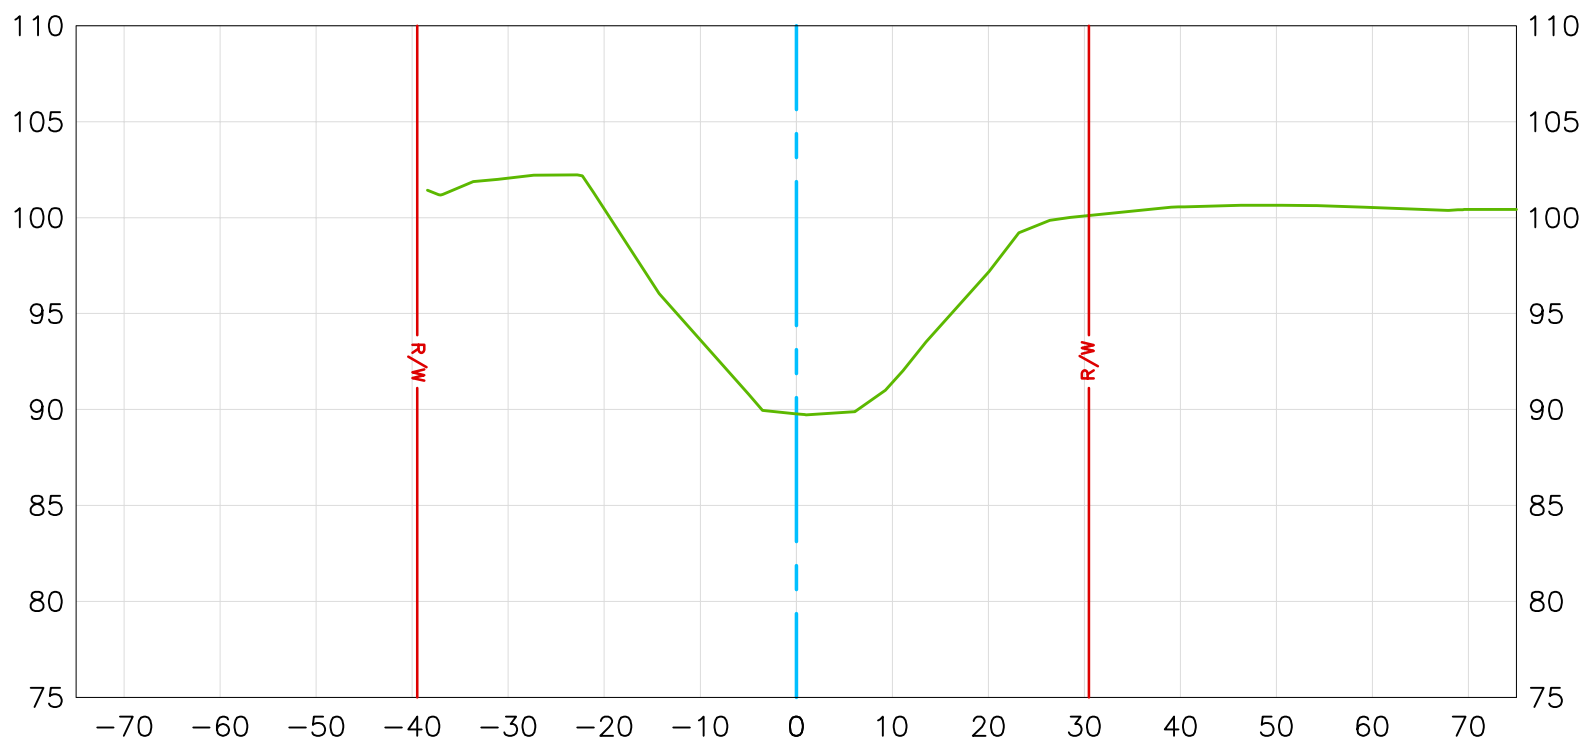

Vert. Scale 1"=10
Horiz. Scale 1"=20

EXISTING CONDITION 2020 

RIGHT OF WAY 

DATE PREPARED: 02/11/2020

U.S. Survey Foot


OC Public Works
OC Survey/Field Services
Boundary Analysis & Mapping



CARBON CANYON CHANNEL

335+00.00

CL

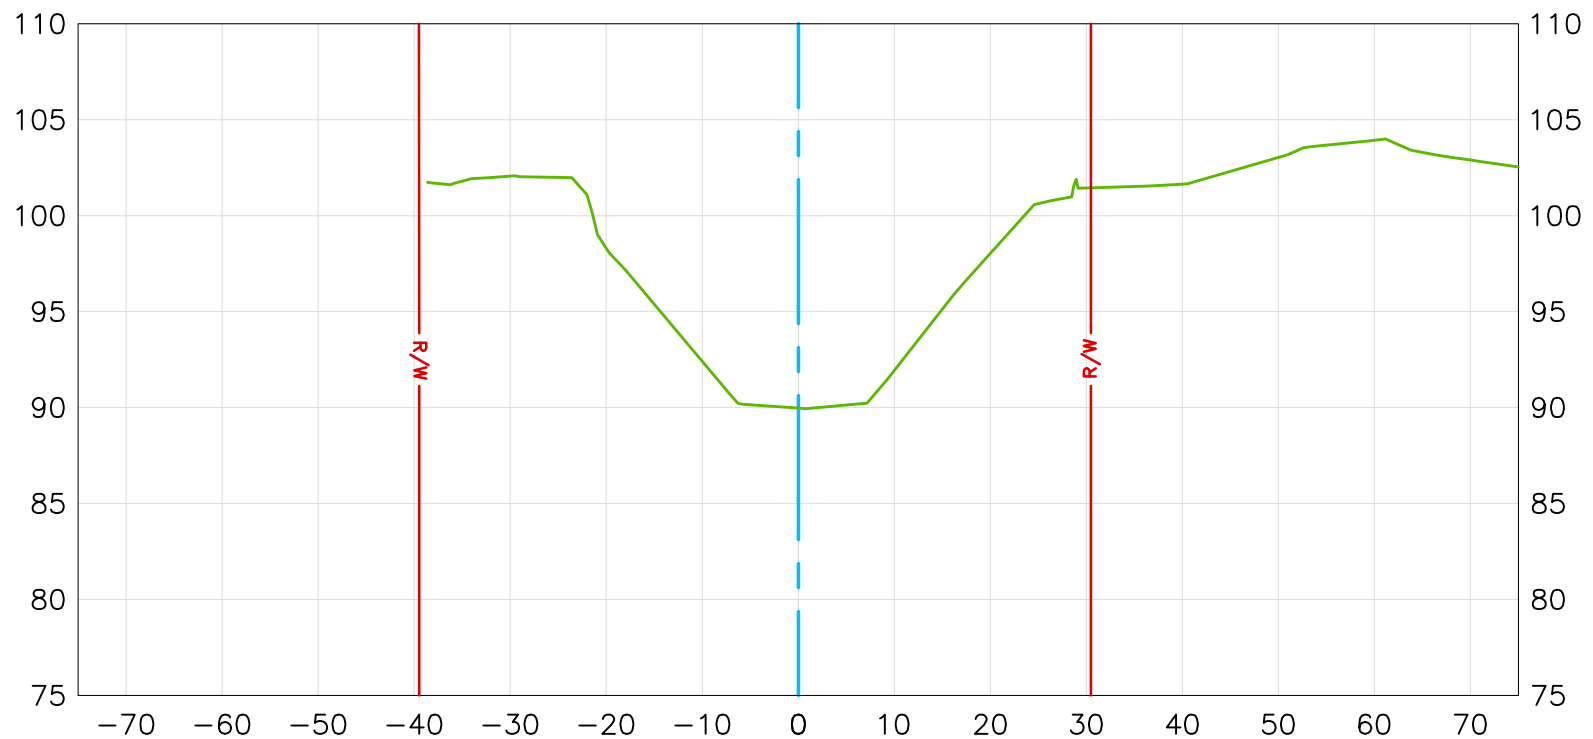

Vert. Scale 1"=10
Horiz. Scale 1"=20

EXISTING CONDITION 2020 

RIGHT OF WAY 

DATE PREPARED: 02/11/2020

**U.S. Survey
Foot**


OC Public Works
OC Survey/Field Services
Boundary Analysis & Mapping



CARBON CANYON CHANNEL

335+50.00

CL

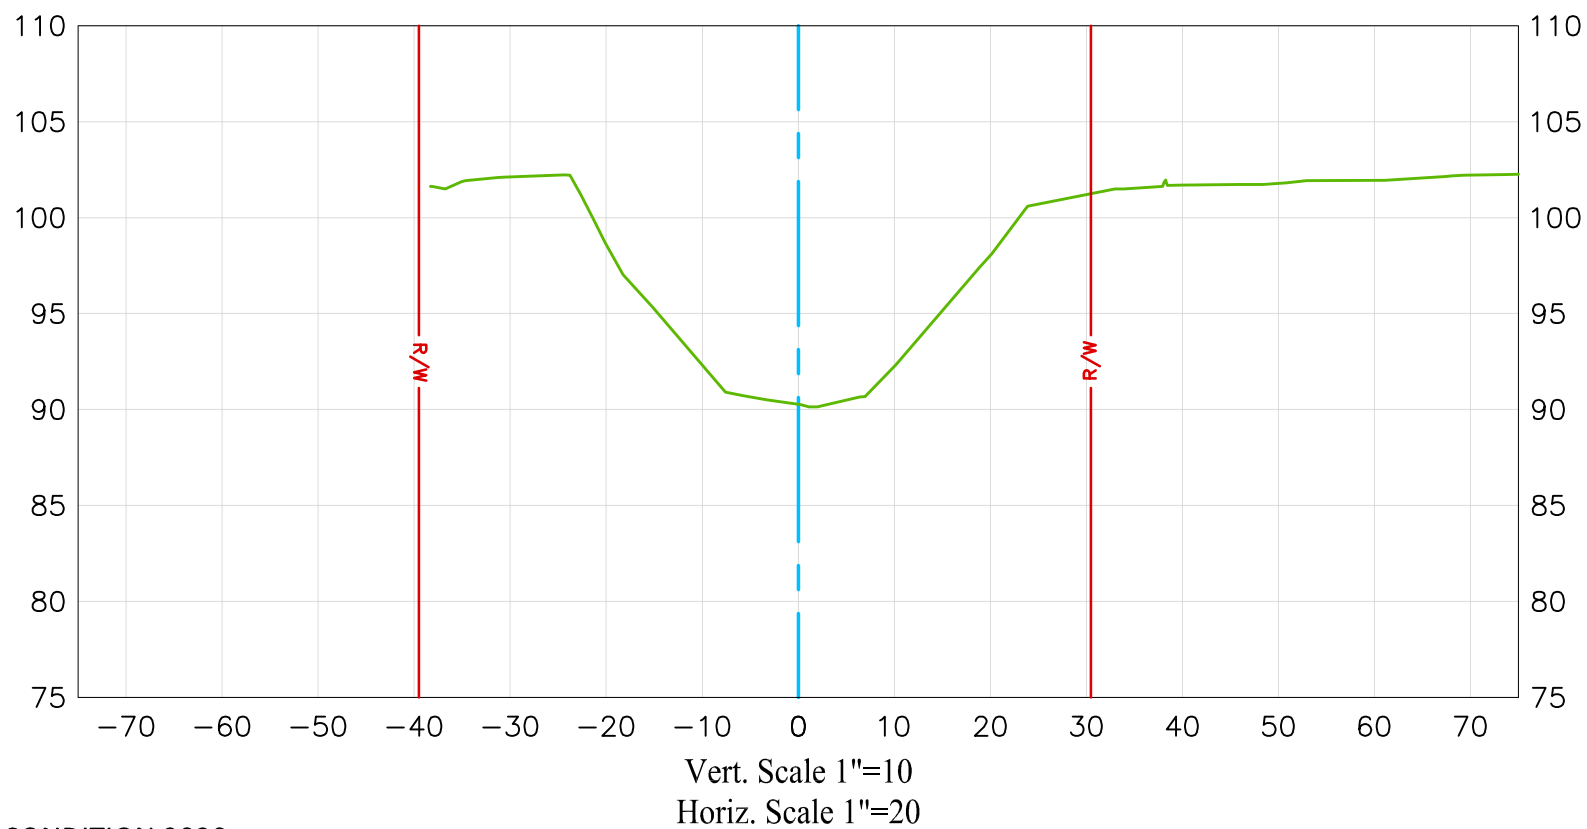

EXISTING CONDITION 2020

RIGHT OF WAY

DATE PREPARED: 02/11/2020

**U.S. Survey
Foot**


OC Public Works
OC Survey/Field Services
Boundary Analysis & Mapping



CARBON CANYON CHANNEL

336+00.00

CL

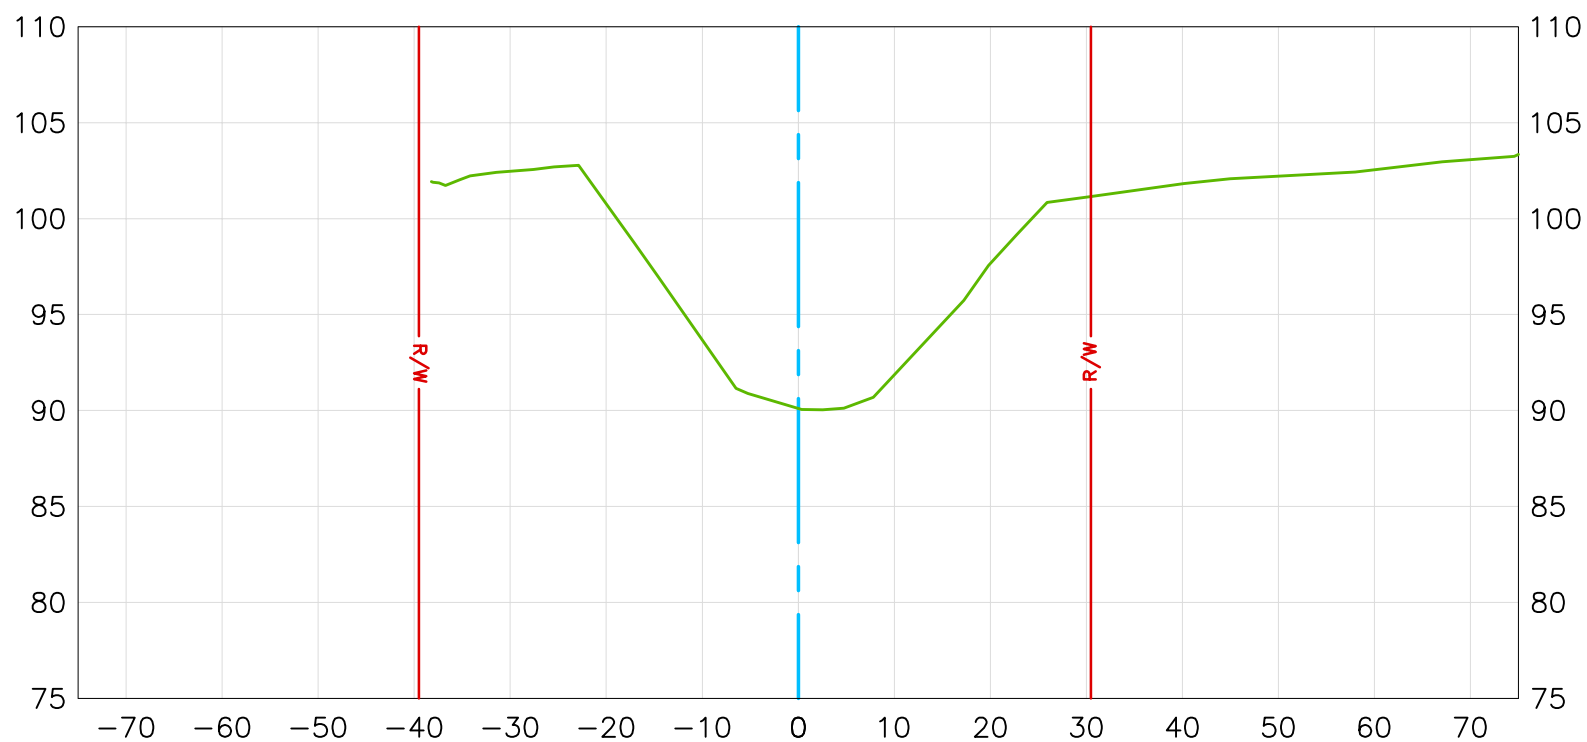

Vert. Scale 1"=10
Horiz. Scale 1"=20

EXISTING CONDITION 2020

RIGHT OF WAY

DATE PREPARED: 02/11/2020

U.S. Survey Foot


OC Public Works
OC Survey/Field Services
Boundary Analysis & Mapping



CARBON CANYON CHANNEL

336+50.00

CL

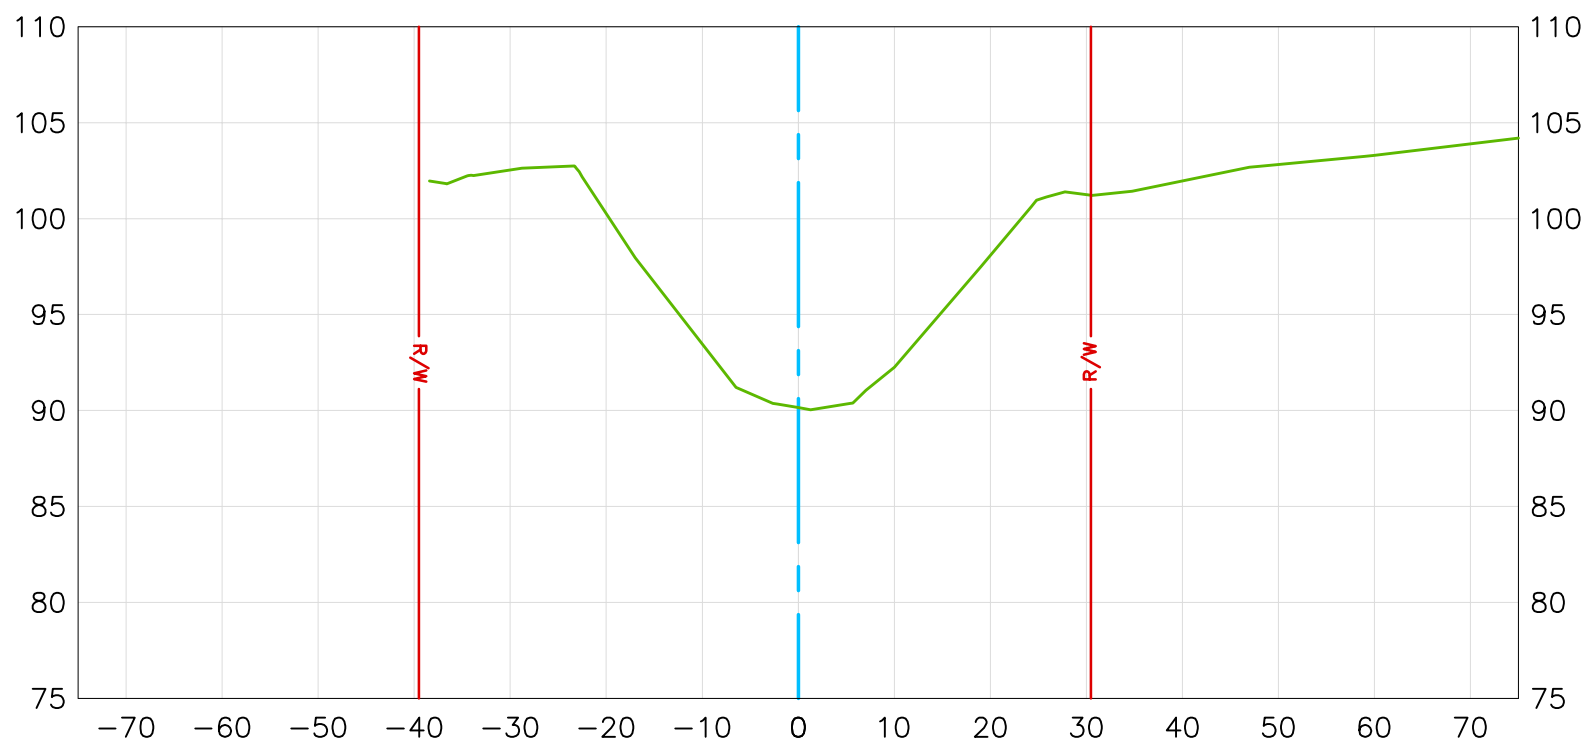

Vert. Scale 1"=10
Horiz. Scale 1"=20

EXISTING CONDITION 2020 

RIGHT OF WAY 

DATE PREPARED: 02/11/2020

U.S. Survey Foot


OC Public Works
OC Survey/Field Services
Boundary Analysis & Mapping



CARBON CANYON CHANNEL

337+00.00

CL

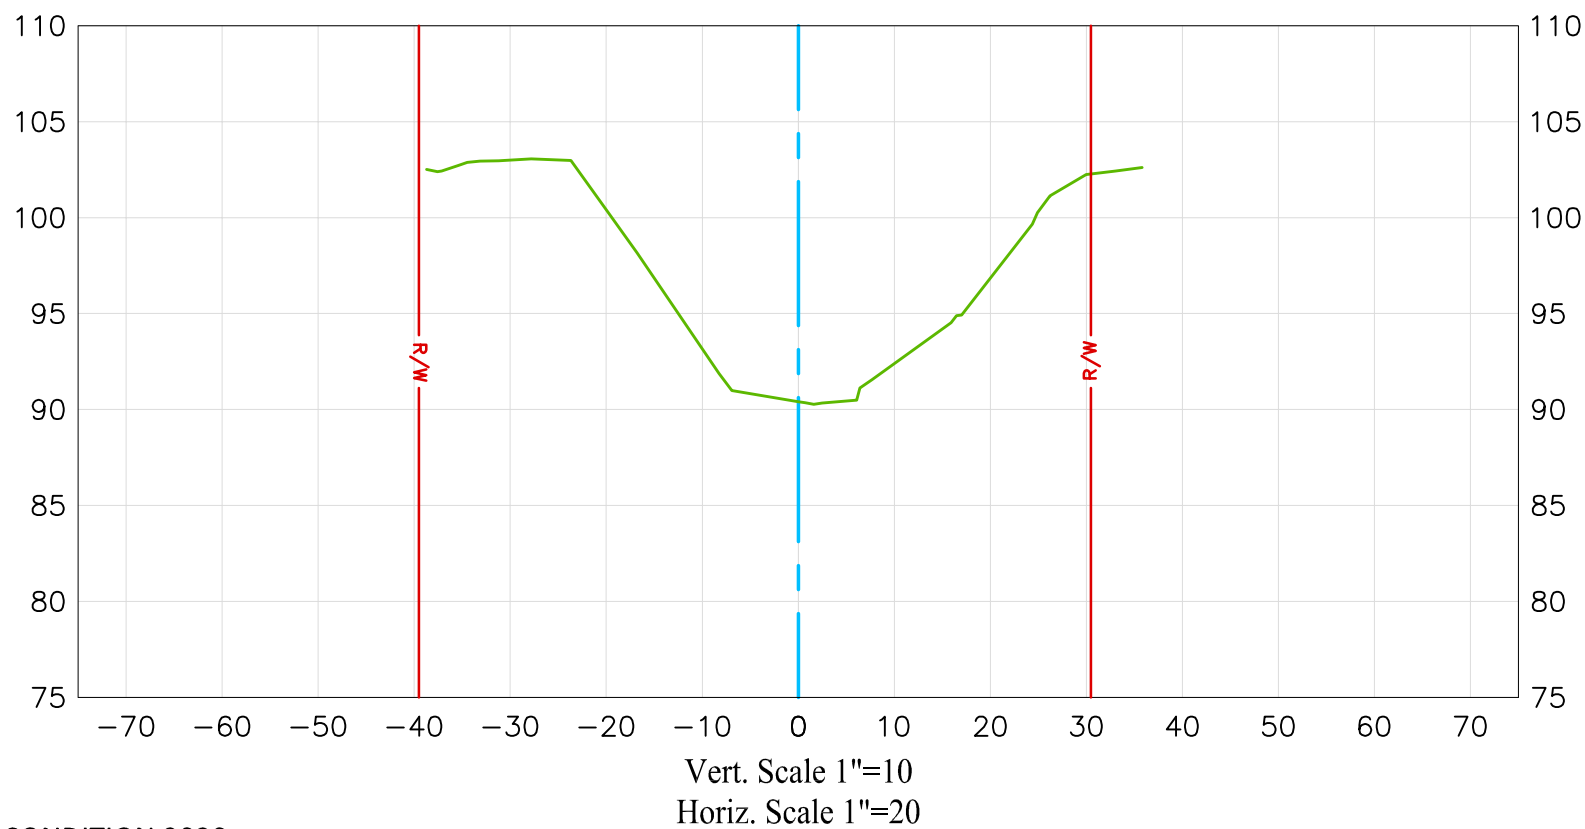

EXISTING CONDITION 2020

RIGHT OF WAY

DATE PREPARED: 02/11/2020

U.S. Survey Foot


OC Public Works
OC Survey/Field Services
Boundary Analysis & Mapping



CARBON CANYON CHANNEL

337+50.00

CL

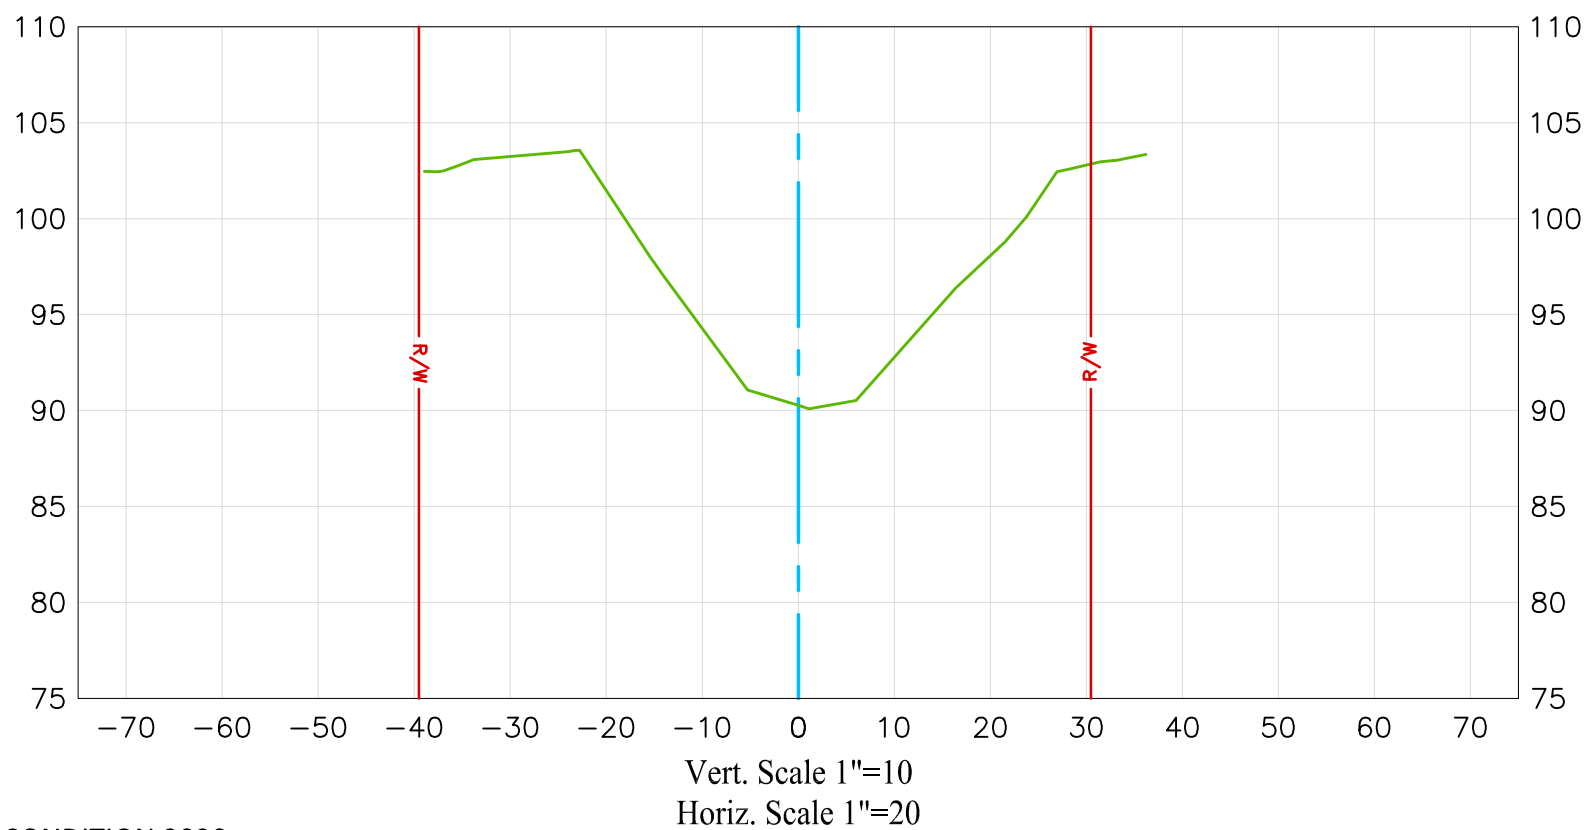

EXISTING CONDITION 2020

RIGHT OF WAY

DATE PREPARED: 02/11/2020

U.S. Survey Foot


OC Public Works
OC Survey/Field Services
Boundary Analysis & Mapping



CARBON CANYON CHANNEL

338+00.00

CL

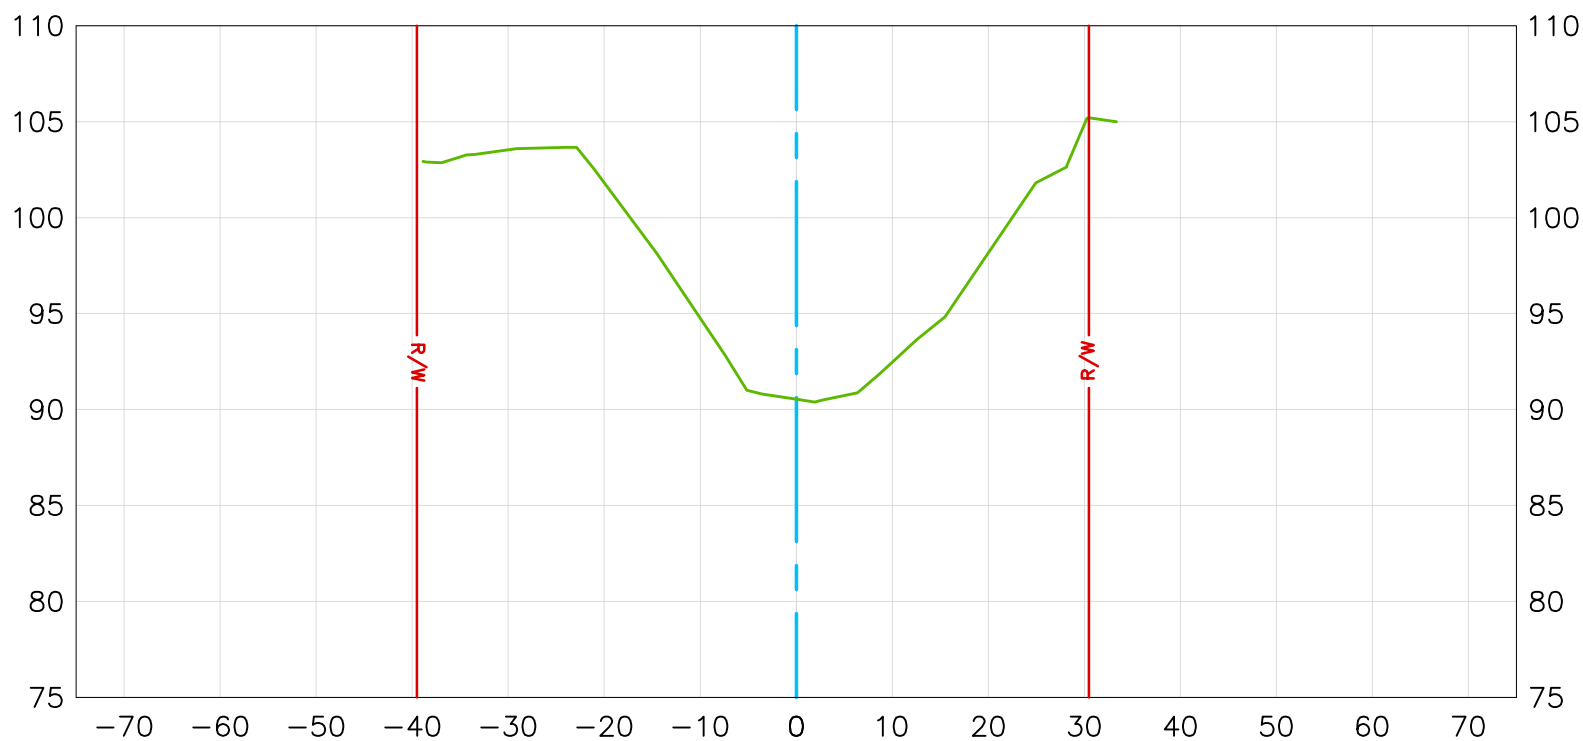

Vert. Scale 1"=10
Horiz. Scale 1"=20

EXISTING CONDITION 2020 

RIGHT OF WAY 

DATE PREPARED: 02/11/2020

U.S. Survey Foot


OC Public Works
OC Survey/Field Services
Boundary Analysis & Mapping



CARBON CANYON CHANNEL

338+50.00

CL

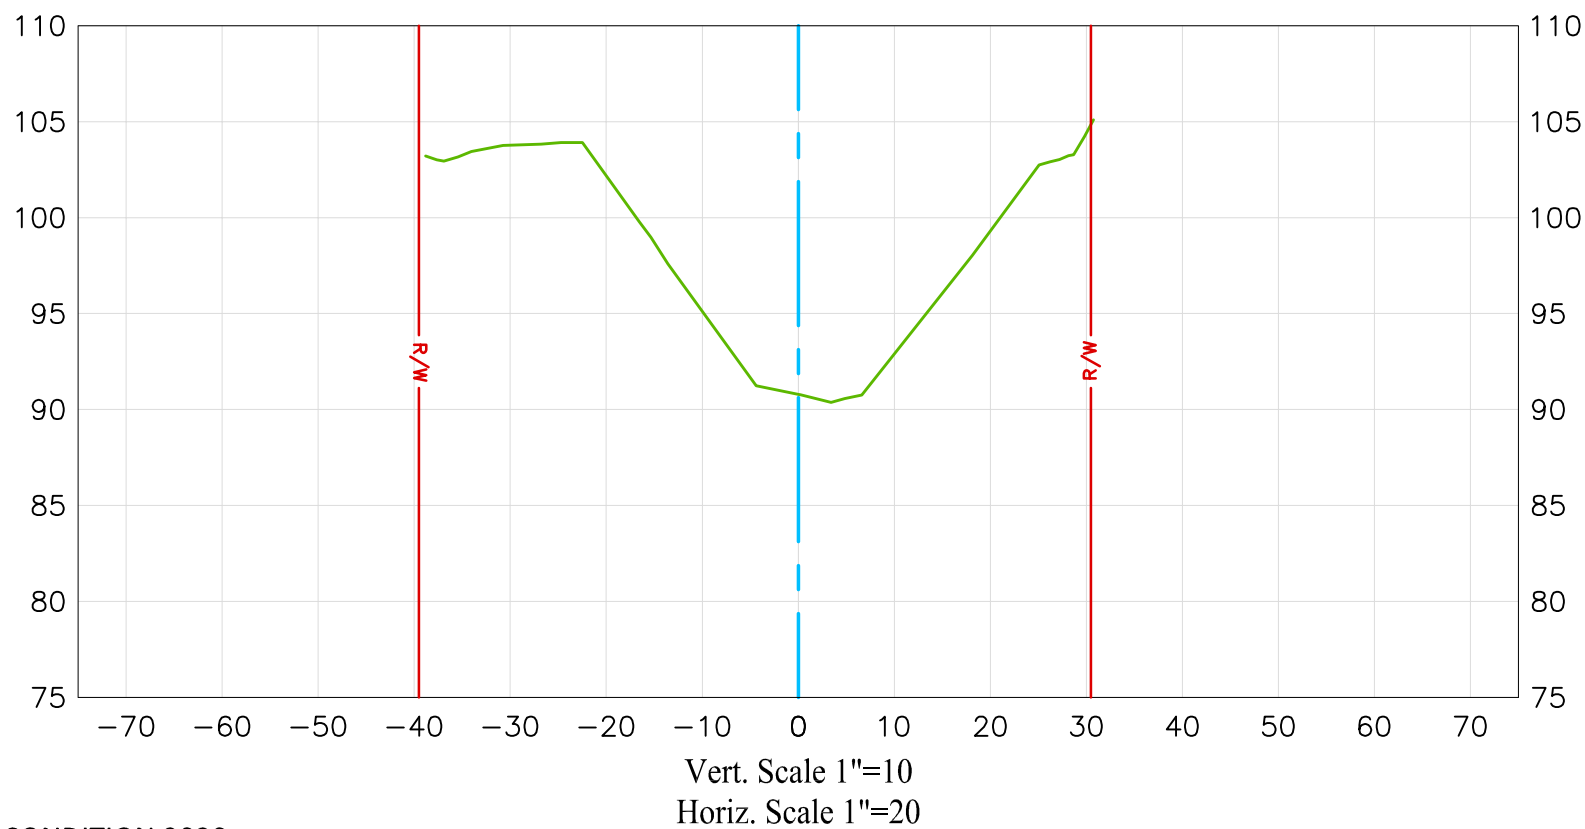

EXISTING CONDITION 2020

RIGHT OF WAY

DATE PREPARED: 02/11/2020

U.S. Survey Foot


OC Public Works
OC Survey/Field Services
Boundary Analysis & Mapping



CARBON CANYON CHANNEL

339+00.00

CL

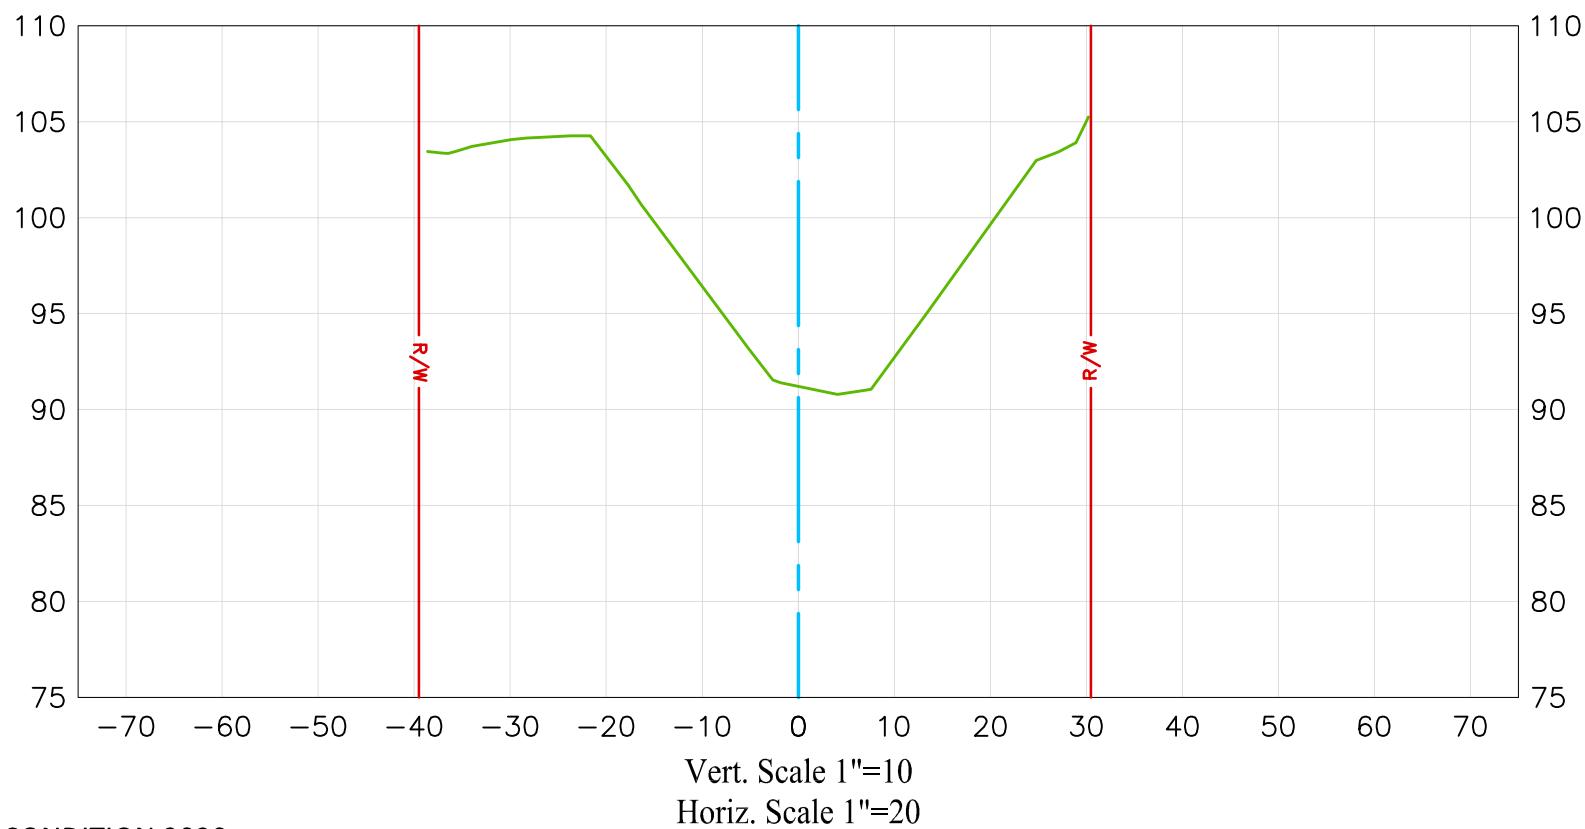

EXISTING CONDITION 2020

RIGHT OF WAY

DATE PREPARED: 02/11/2020

U.S. Survey Foot


OC Public Works
OC Survey/Field Services
Boundary Analysis & Mapping



CARBON CANYON CHANNEL

339+50.00

CL

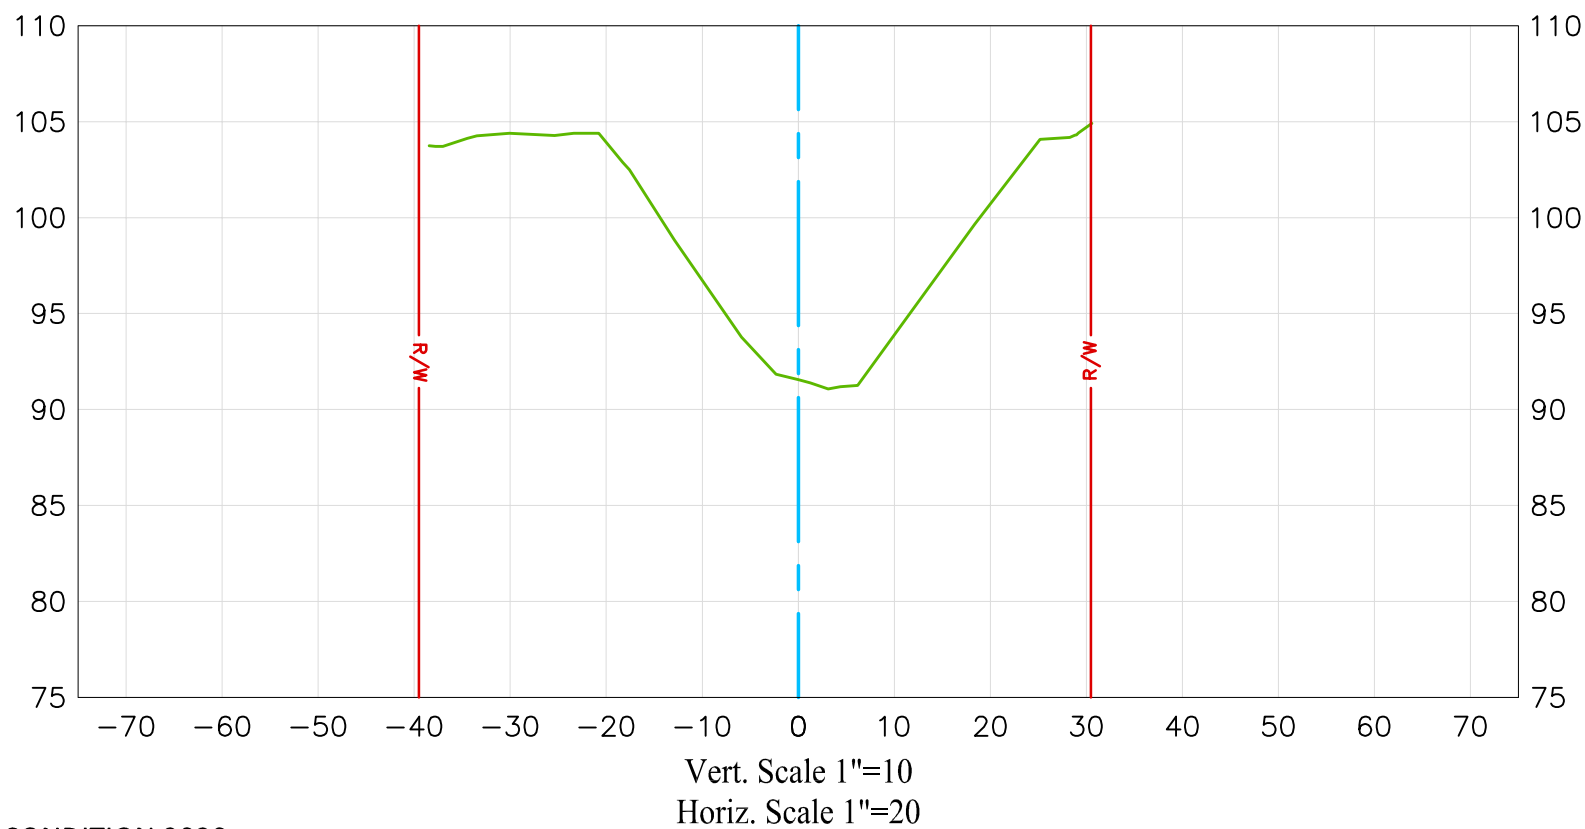

EXISTING CONDITION 2020

RIGHT OF WAY

DATE PREPARED: 02/11/2020

U.S. Survey Foot


OC Public Works
OC Survey/Field Services
Boundary Analysis & Mapping



CARBON CANYON CHANNEL

340+00.00

CL

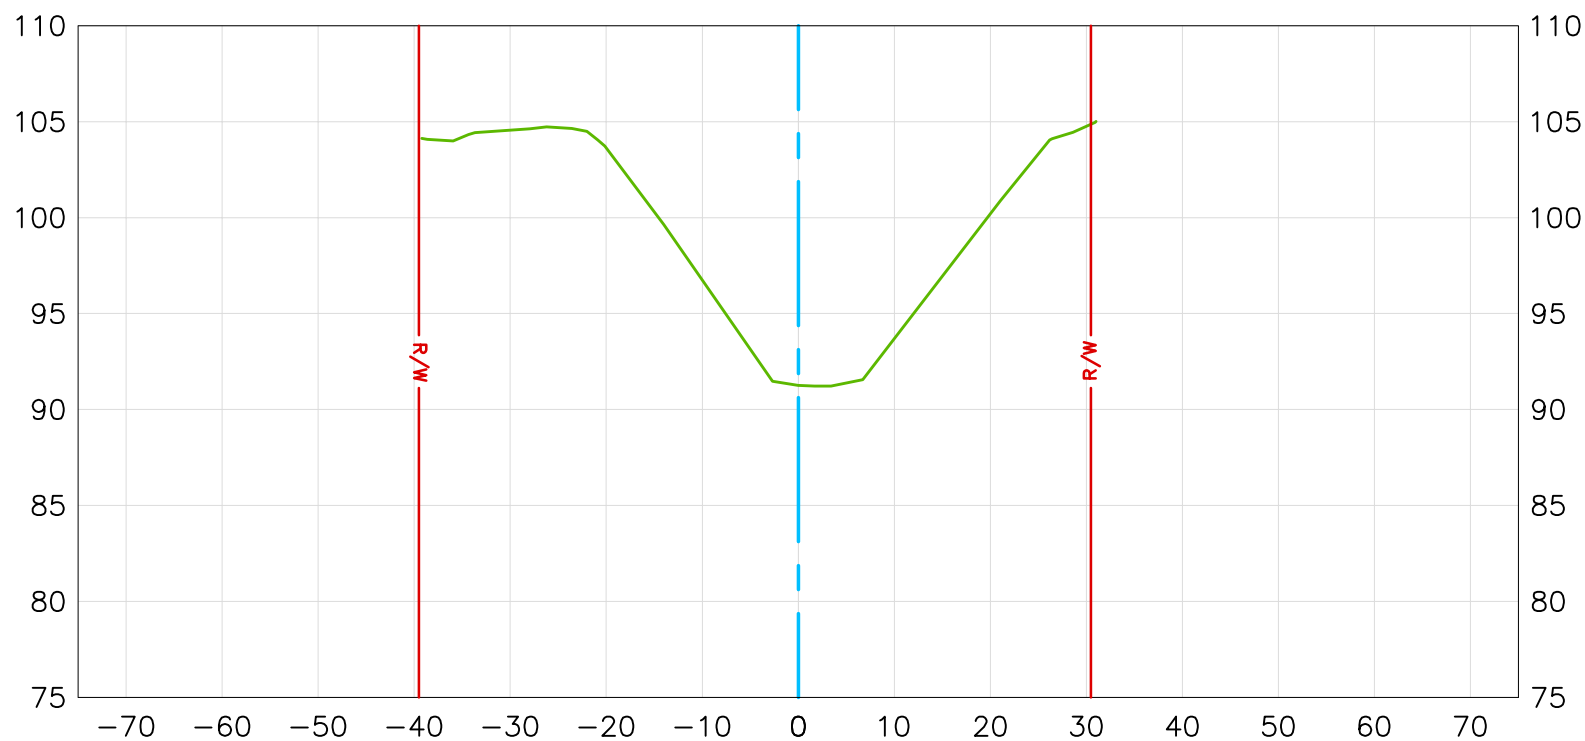

Vert. Scale 1"=10
Horiz. Scale 1"=20

EXISTING CONDITION 2020 

RIGHT OF WAY 

DATE PREPARED: 02/11/2020

U.S. Survey Foot


OC Public Works
OC Survey/Field Services
Boundary Analysis & Mapping



CARBON CANYON CHANNEL

340+34.49

CL

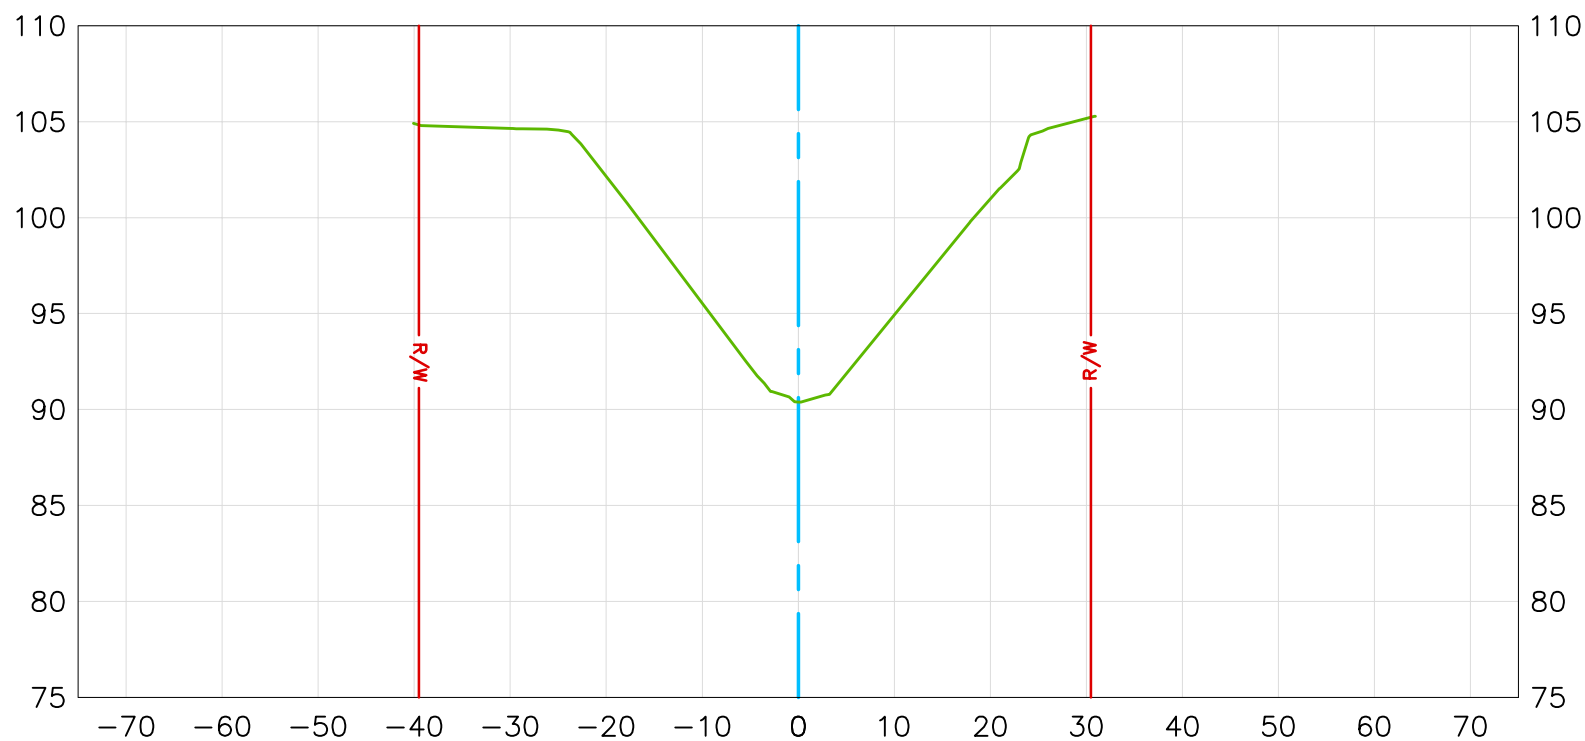

Vert. Scale 1"=10
Horiz. Scale 1"=20

EXISTING CONDITION 2020

RIGHT OF WAY

DATE PREPARED: 02/11/2020

U.S. Survey Foot


OC Public Works
OC Survey/Field Services
Boundary Analysis & Mapping



CARBON CANYON CHANNEL

340+50.00

CL

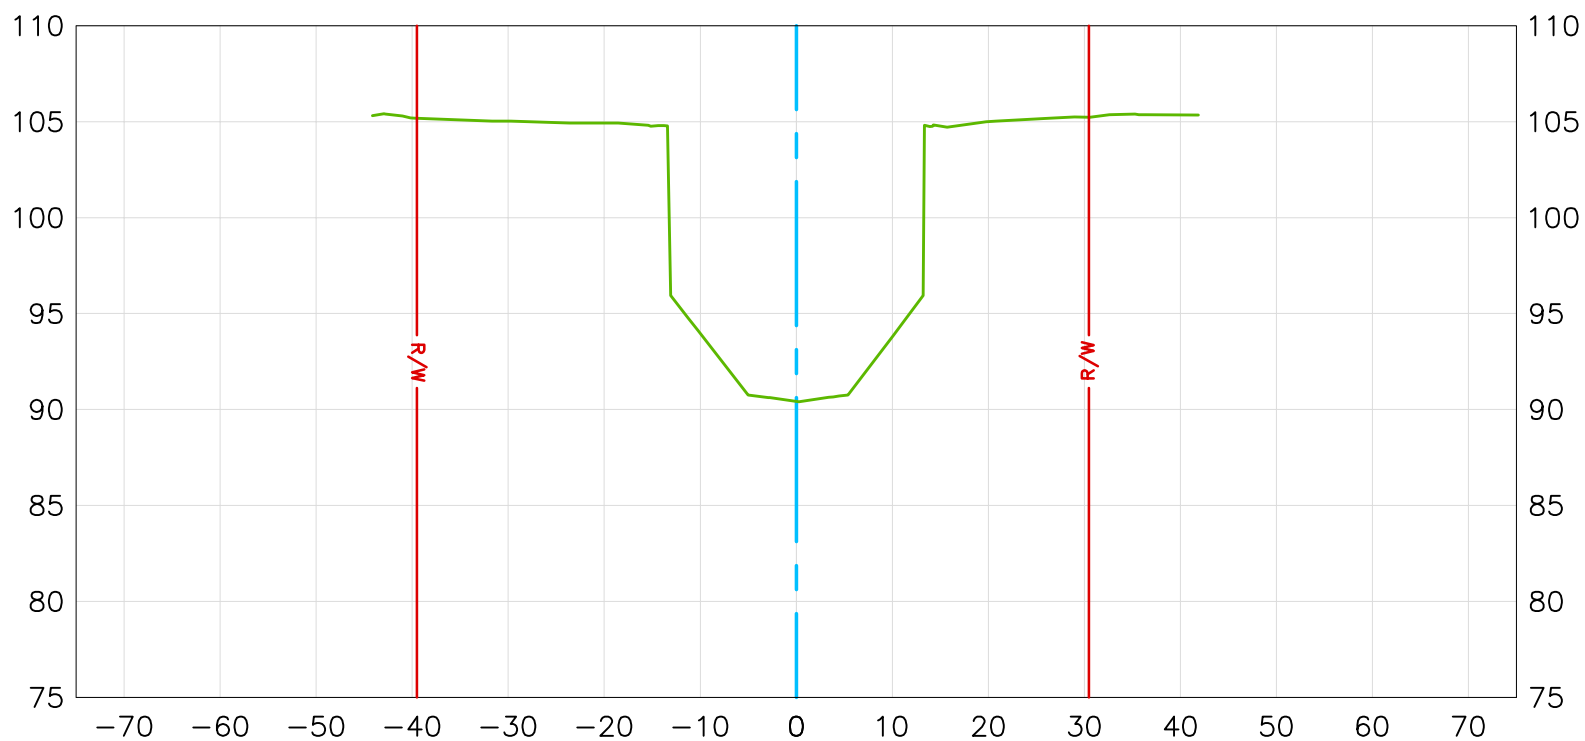

Vert. Scale 1"=10
Horiz. Scale 1"=20

EXISTING CONDITION 2020 

RIGHT OF WAY  R/W

DATE PREPARED: 02/11/2020

**U.S. Survey
Foot**


OC Public Works
OC Survey/Field Services
Boundary Analysis & Mapping



CARBON CANYON CHANNEL

340+91.49

CL

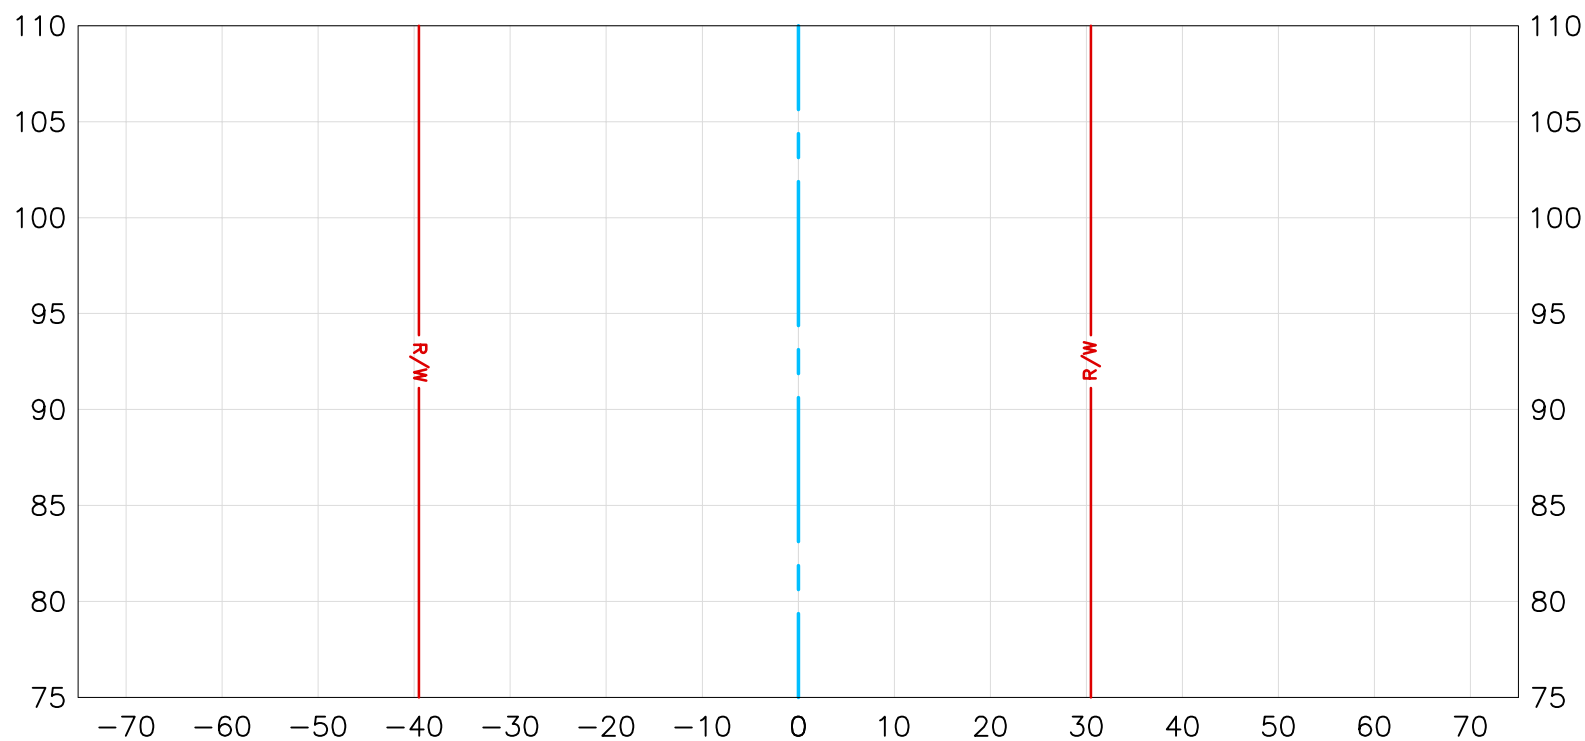

Vert. Scale 1"=10
Horiz. Scale 1"=20

EXISTING CONDITION 2020 

RIGHT OF WAY 

DATE PREPARED: 02/11/2020