

ROSS STREET & CIVIC CENTER DRIVE

CITY OF SANTA ANA

TIE


BK / PG 9/45

DATE 1/29/2003

CREW BS BH MP

HISTORY

- SET LEAD, TACK, & CSA TAG ON PCC COLLAR PER CSATB 9/45 TIES DATED 6/27/2001, AFTER SEWER LINE RECONSTRUCTION.
- FD NOTHING, SET LEAD, TACK & CSA TAG ON PCC MANHOLE COLLAR 1/29/03 PER CR 2001-1677B.
- Ⓐ FD 5' OFFSET CSA WELL MONUMENT (7/68); RECOVERED SAME (7/87), (1/99), AND (6/2001). WELL MONUMENT DESTROYED 9/2001 DUE TO SEWER LINE RECONSTRUCTION.

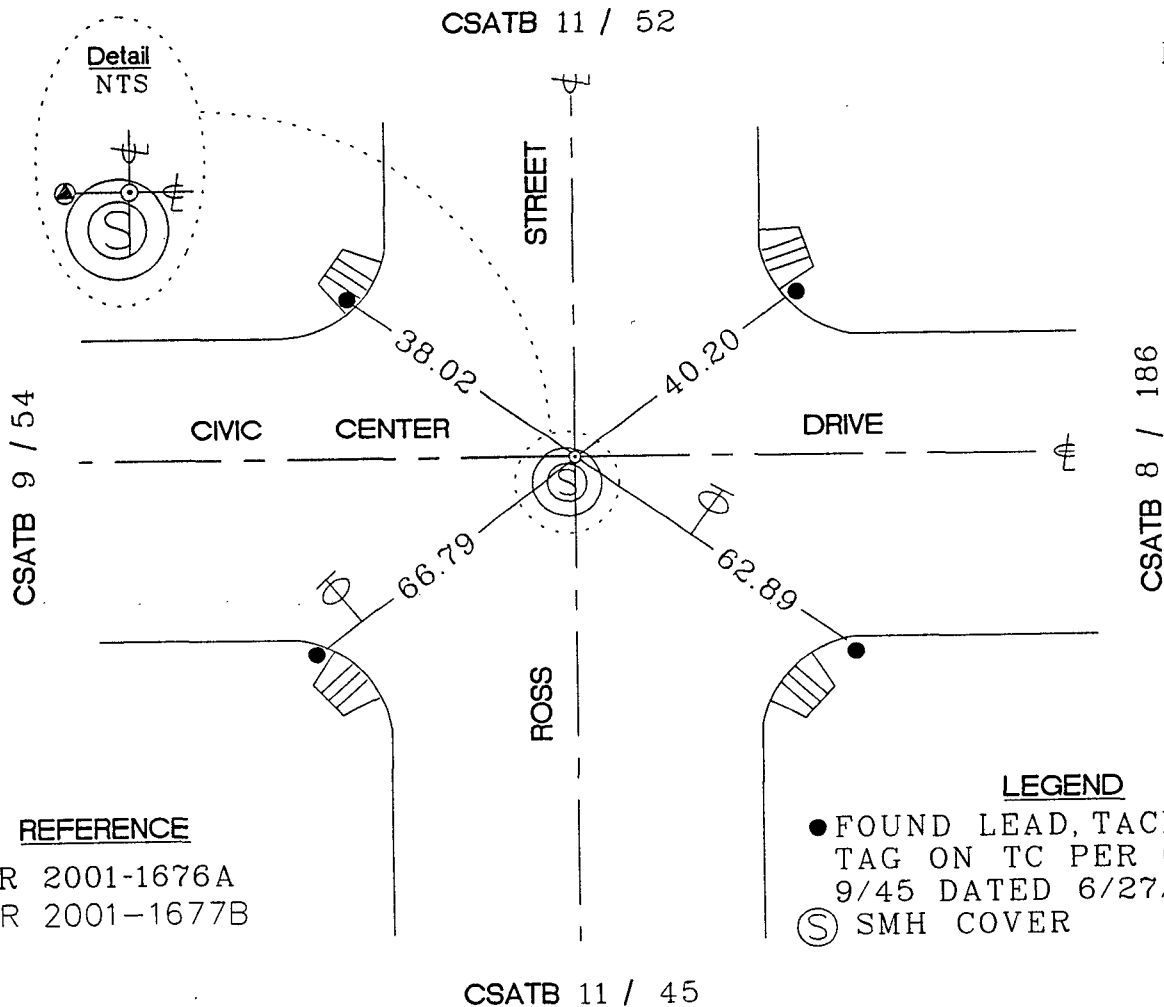

NOTE: THESE TIES ARE FOR THE PURPOSE OF PERPETUATING THE FOUND MONUMENTATION. NO CLAIM IS MADE AS TO THE RELATIONSHIP OF THE POINTS OR LINES SHOWN HEREON TO THE TRUE BOUNDARY LOCATIONS.