



SURVEYED BY

OBESTER

DATE

4-13-94

ORANGE COUNTY SURVEYOR

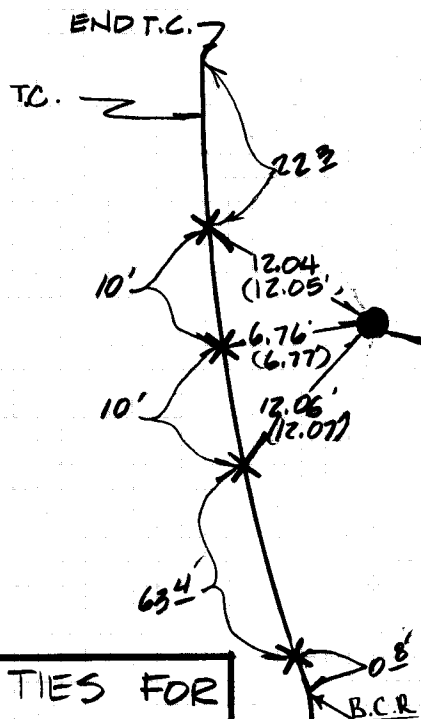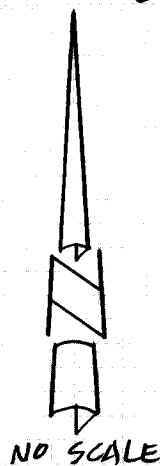ALIGN. PG. 16 OF 27
SURVEY PG. 16 OF 80

LOCATION TIES FOR
P.I. 1 & TRAV. 3

P.I. 1 <111>
FD. PLN. SPK. #
1" IN. DN. 0.3 IN
A.C. PER ()

CRAWFORD

CYN.

RD.


BRAE GLEN

NOTES:

- X = CHIS "+" IN TOP OF CONCRETE CURB
- () = PER O.C.S. FILE NO. R 92-60 NOTES DATED 9-22-92 BY OBESTER
- <> = BY MON. NAME IS NUMBER ASSIGNED BY OFFICE

TRAV. 3 <300>

SET L & T 1/4" O.C.S.
PR. TAG "TRAV 3"
1994" ON TOP OF CURB

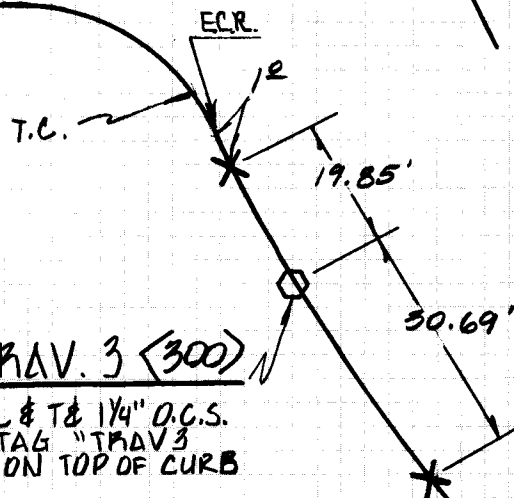

DATE _____

4-13-94

ORANGE COUNTY SURVEYOR

LOCATION TIES FOR
TRAV. II P.I. 3

ALIGN. PG. 18 OF 27
SURVEY PG. 18 OF 80

PANORAMA ELEMENTARY
SCHOOL 10512



NO SCALE

-GUY POLE

TRAV. II <11>

7 SET LEAD & TACK &
1 1/4" BRASS O.C.S. TAG
STMPD. "TRAVI 1994"
FLUSH ON CONC. WAX

POINER POLE
1643019E

15 5'


Willis, L.

P. I 3 (3)

FD. PUN. SPK # 1"
W. ON 1 1/2" W.
DN. 04
PER ACS FILE NO.
R92-60 NOTES DATED
9-22-92 BY OBESTER
PER ()

CRAWFORD

CYN.

RD

NOTES:

() = PER A/4-9/989
< > = BY MON. NAME IS
NUMBER ASSIGNED
BY OFFICE WHEN
CALCULATING COORDINATE
VALUES.
X = FD CHIS "4" PER ()


SURVEYED BY **OBESTER**

DATE **4-13-94**

ORANGE COUNTY SURVEYOR

**LOCATION TIES FOR
TRAV 4 P.I. 4**

**ALIGN. PG. 20 OF 27
SURVEY PG. 20 OF 80**

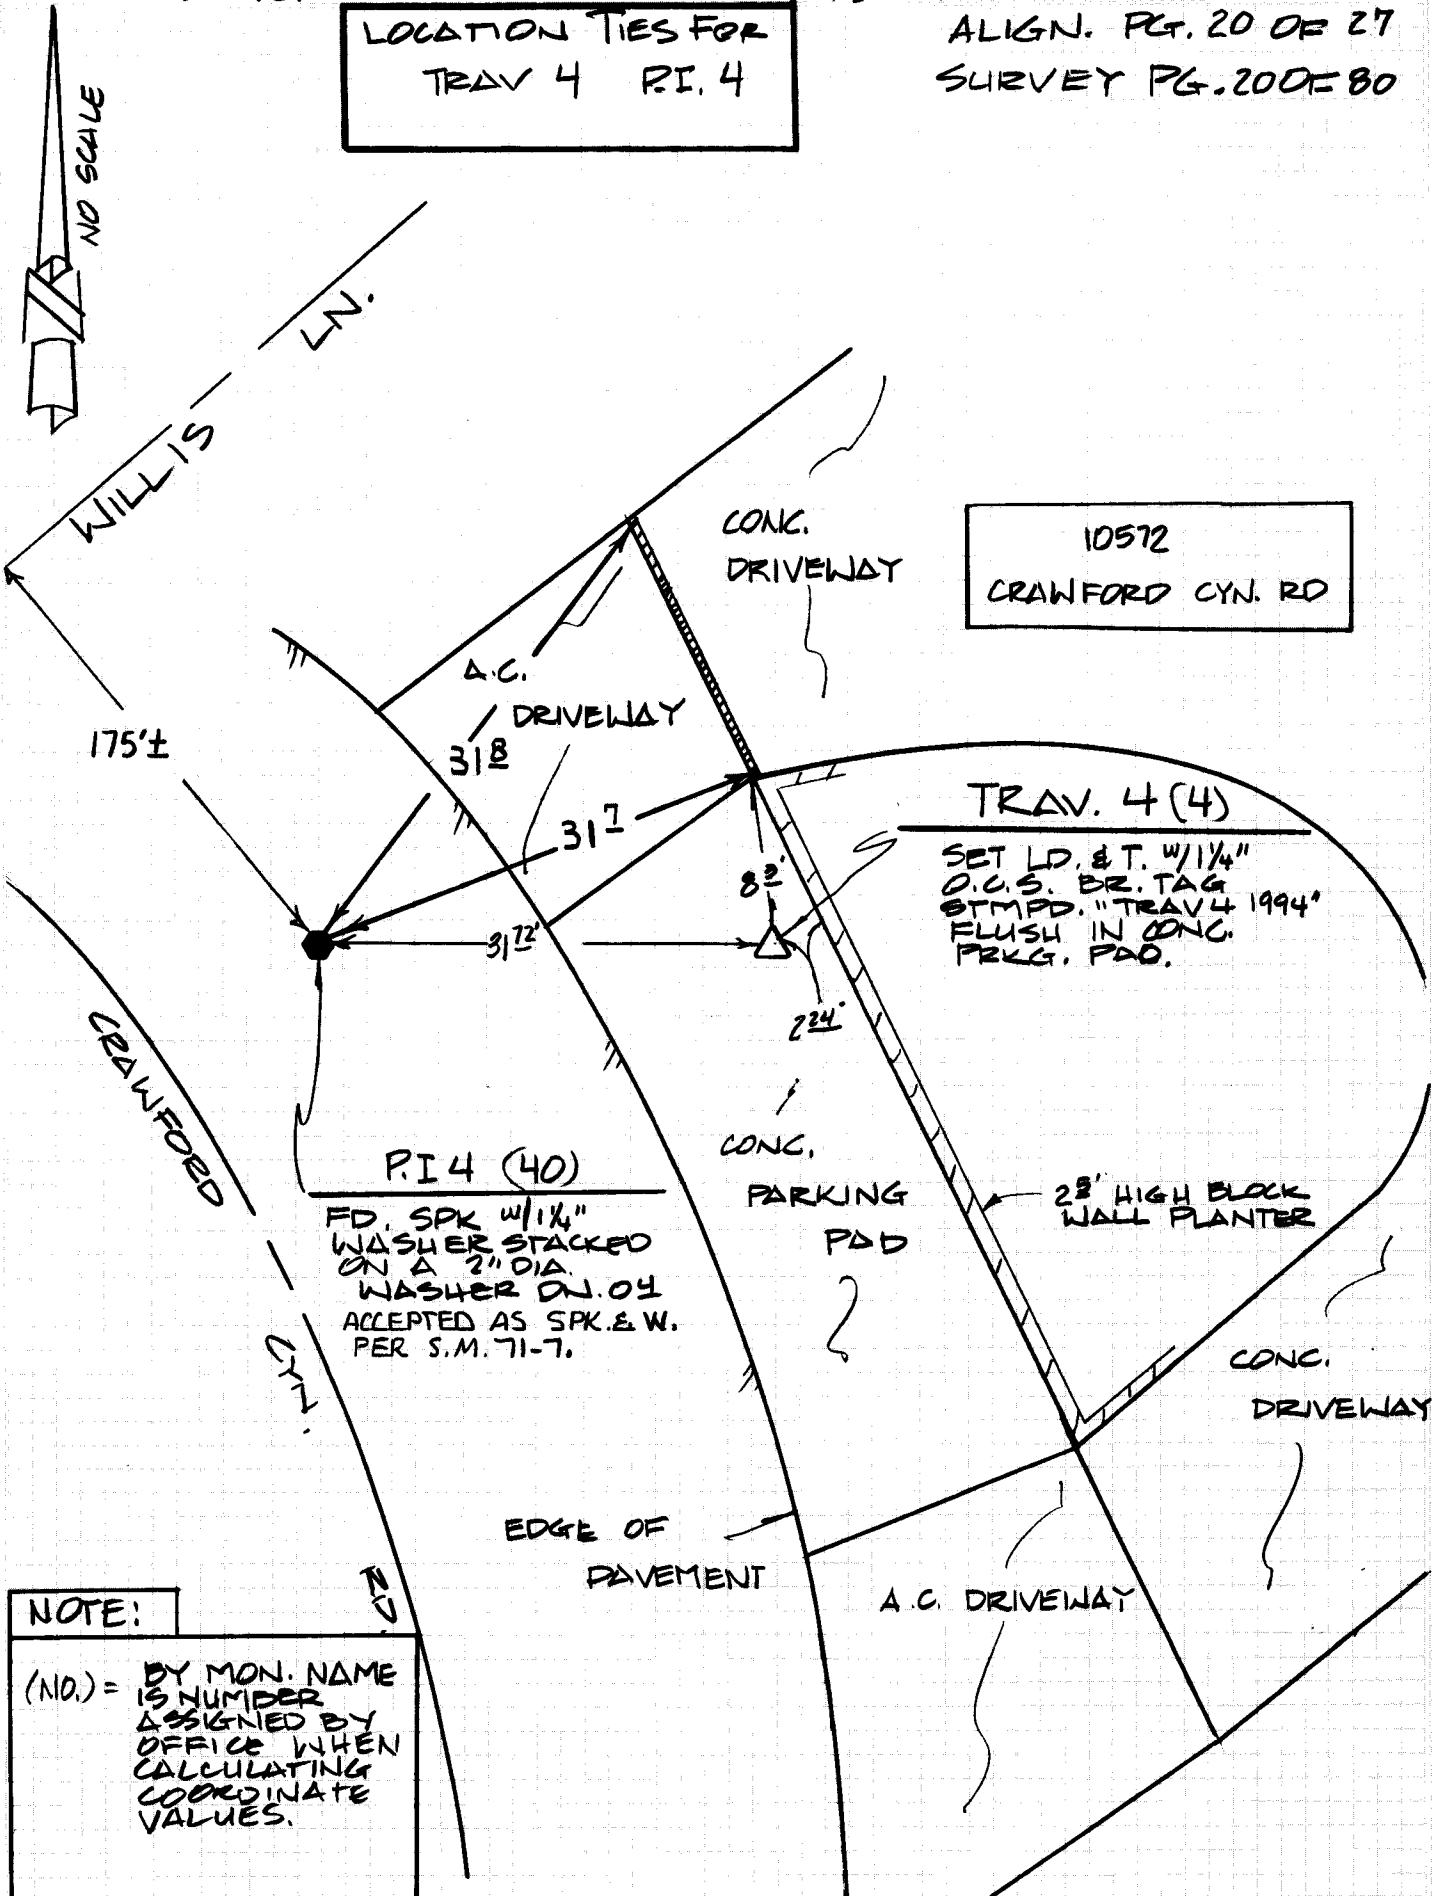

SURVEYED BY

O B E S T E R


DATE

4-13-94

ORANGE COUNTY SURVEYOR

ALIGN. PG. 22 OF 27


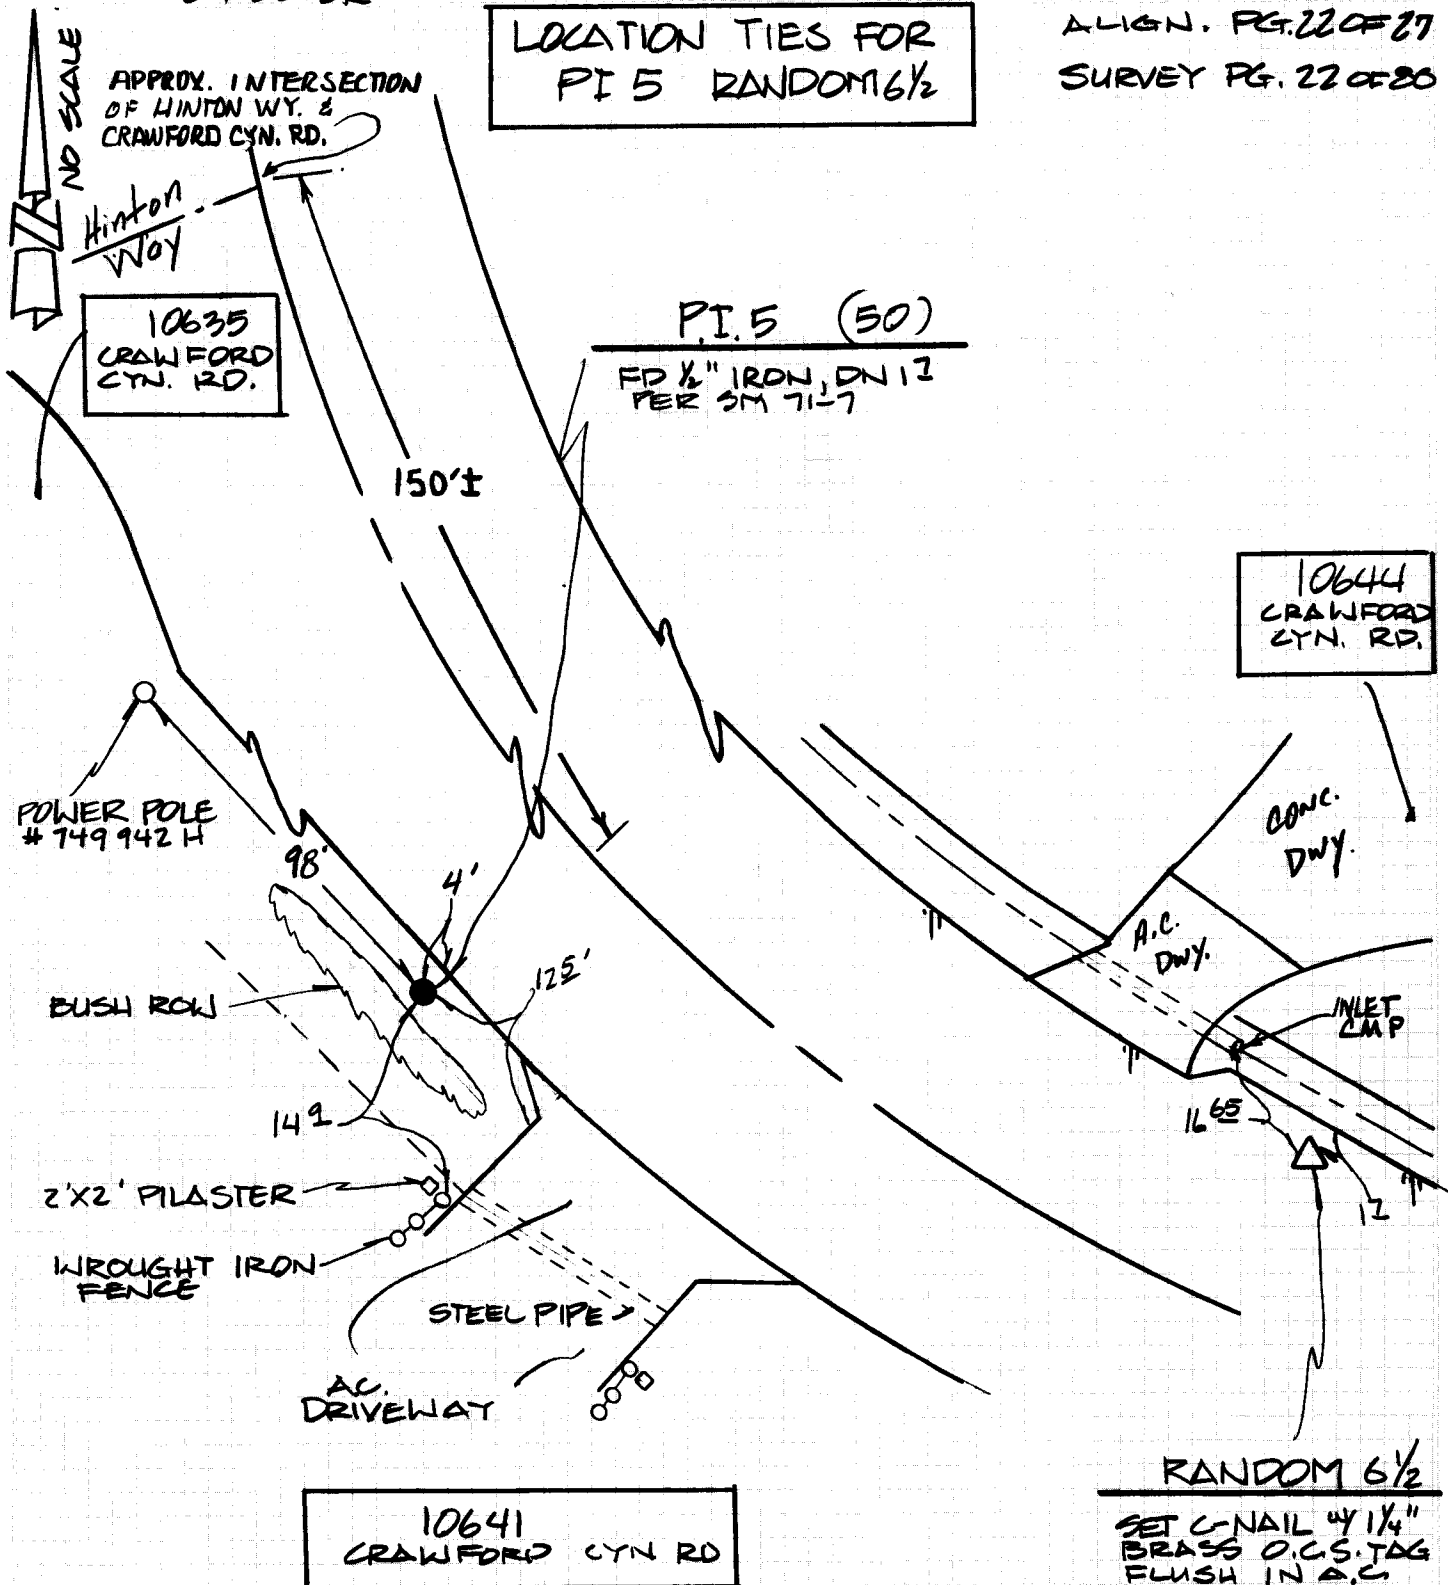

NOTE:

(No.) BY MON. NAME IS NUMBER ASSIGNED BY OFFICE WHEN CALCULATING COORDINATE VALUES.

SURVEYED BY

OBESTER

DATE

4-13-94


ORANGE COUNTY SURVEYOR

LOCATION TIES FOR
P.I. 6(6) AND RANDOM 9 1/2

ALIGN. PG. 24 OF 27
SURVEY. PG. 24 OF 80

NOTE.

NO. BY MON. NAME IS
NUMBER ASSIGNED
BY OFFICE WHEN CALCULATING
COORDINATE
VALUES.

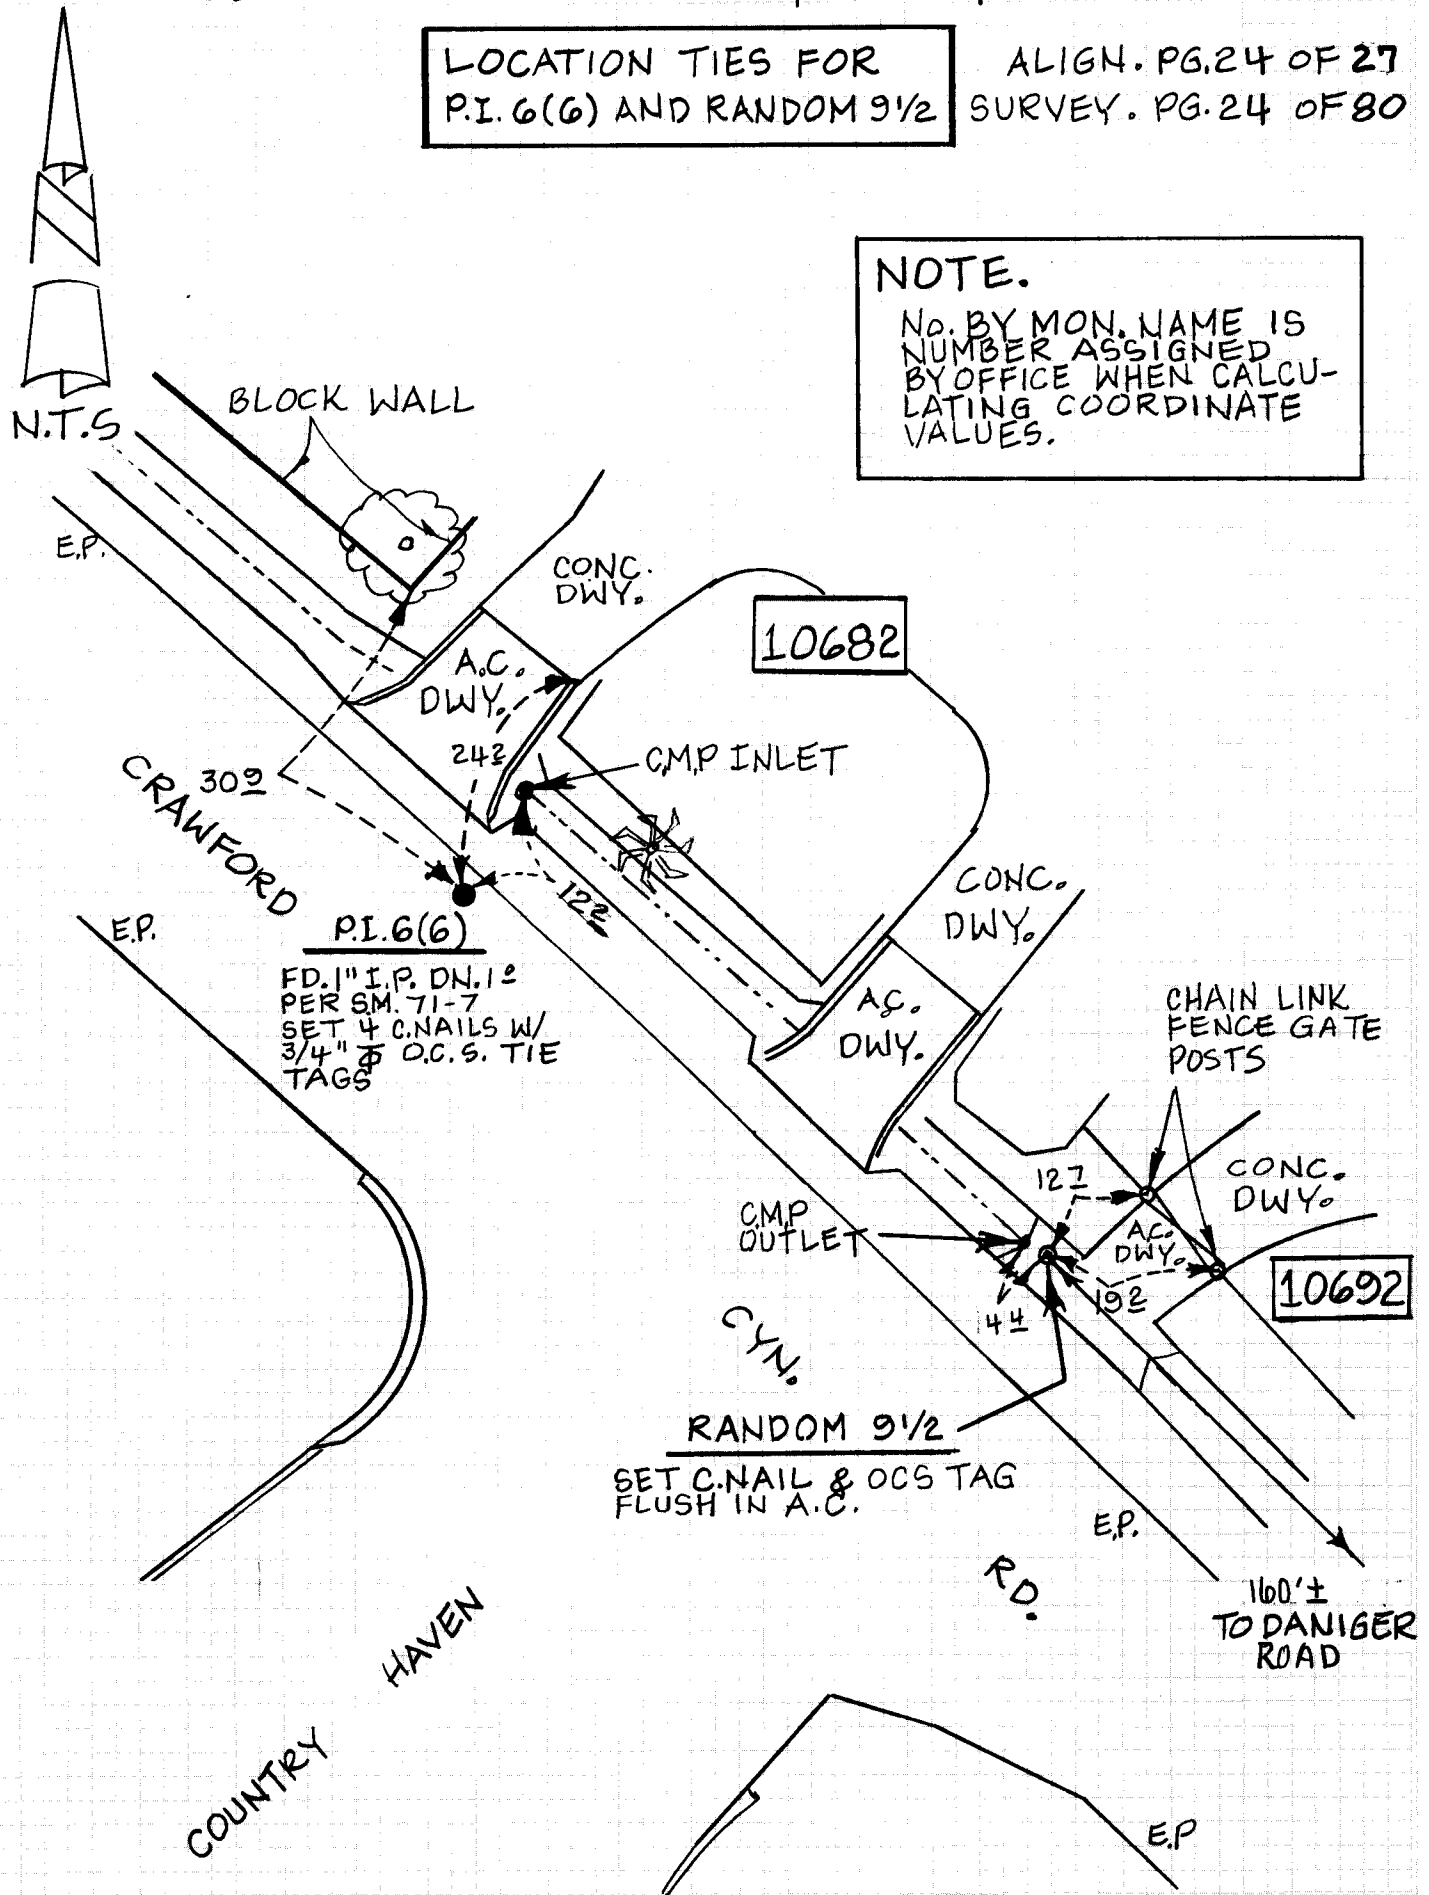


SURVEYED BY OBESTER

DATE 4-13-94

ORANGE COUNTY SURVEYOR

ALIGN. PG. 26 OF 27
SURVEY PG. 26 OF 80

LOCATION TIES FOR
P.I. 10 (27)

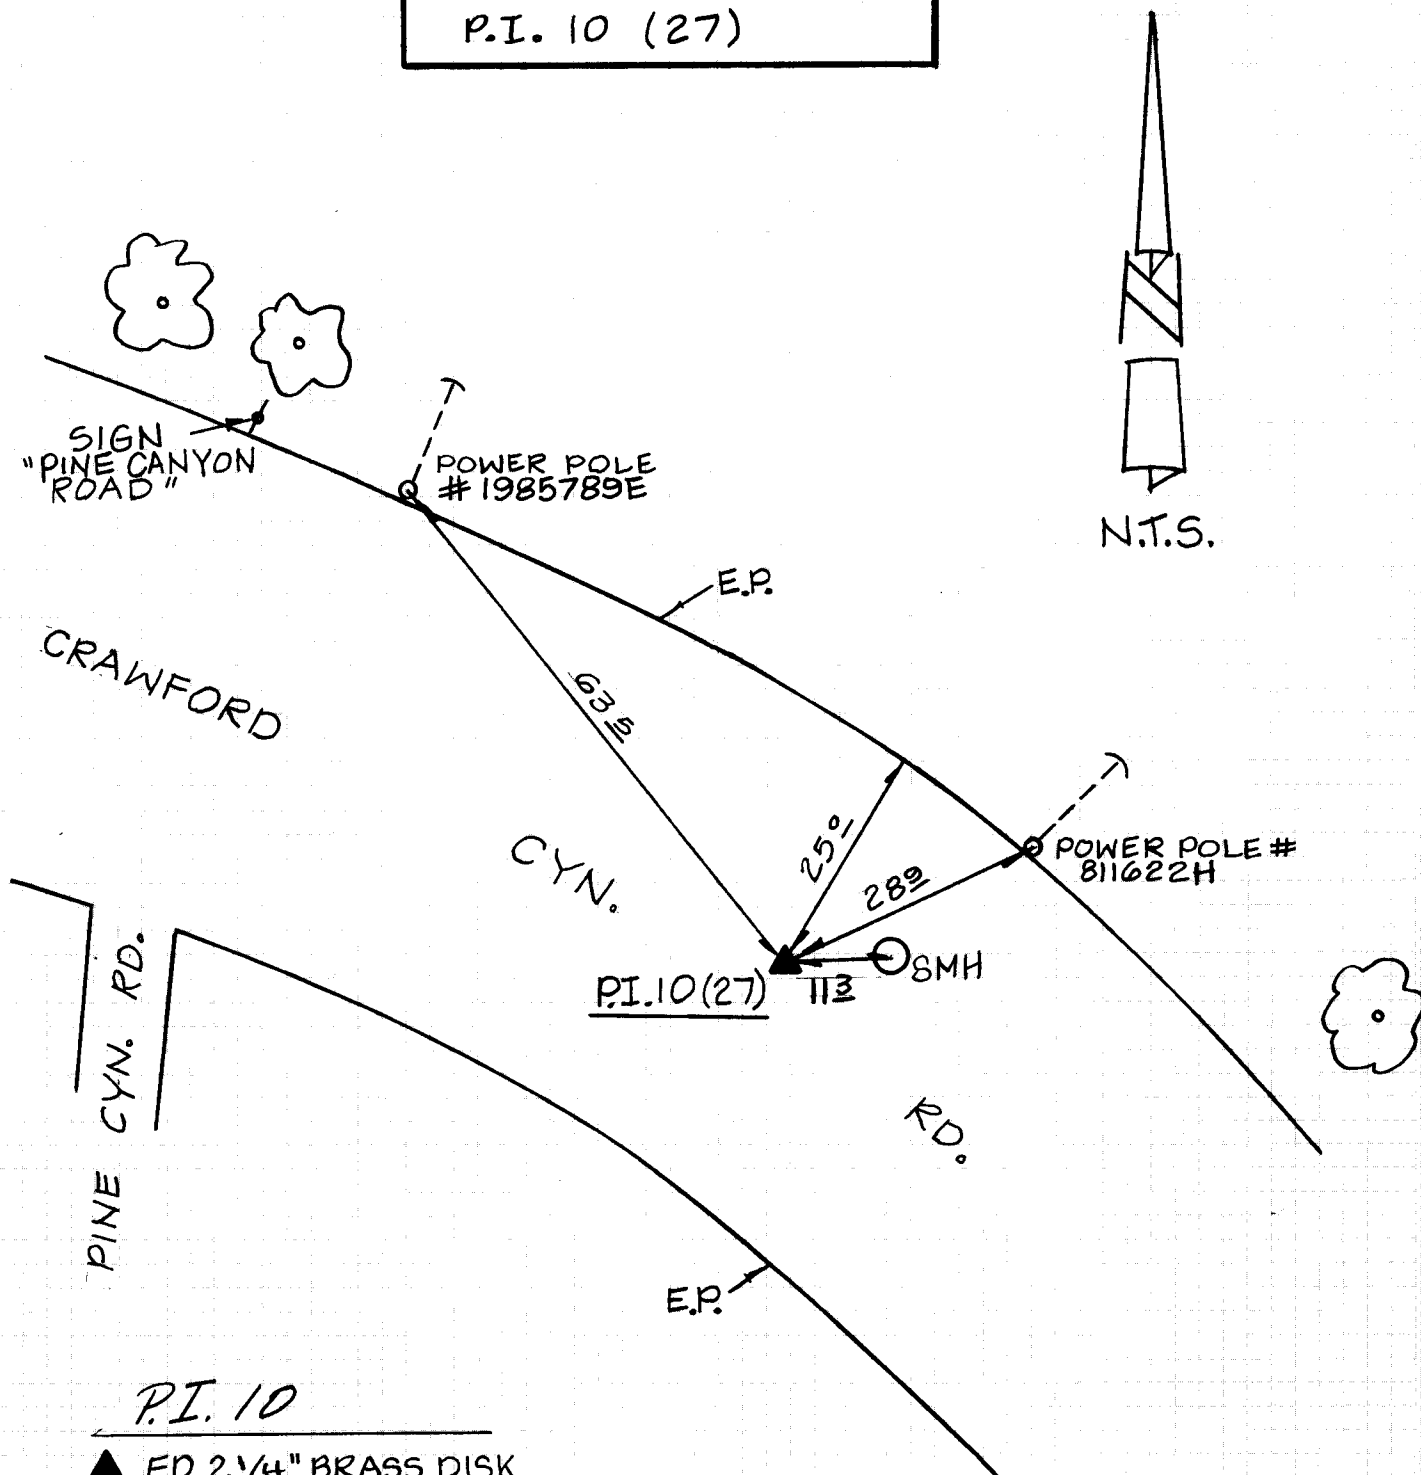

P.I. 10

▲ FD 2 1/4" BRASS DISK
STMPD. "RCE 20106"
IN WELL MON. DN. 10
PER O.C.S. FILE NO.
R93-37 OF NEWPORT
BLVD. SURVEY NOTES
DATED 6-9-93 BY
SEHER, NEEDS TO BE
RAISED FLUSH WITH SURFACE.
ALSO PER O.C.S. A/NE-ZRV/1219.

NOTE. No. BY MON. NAME
IS NUMBER ASSIGNED
BY OFFICE WHEN
CALCULATING COORD.
VALUES.