

RECORD OF SURVEY

PARCELS SHOWN BELOW, GIVING OWNERS NAME, LOCATION, SCALE AND DATE.

I, John M. Hoy, hereby certify that I am a Licensed Land Surveyor in the State of California, No. 2326; that these maps represent surveys made under my supervision at the request of the owners; that all monuments shown actually existed at the time of the surveys and their positions are correctly shown.

John M. Hoy
Licensed Surveyor.

Examined and Approved this 11 day of Sept 1956.

Owen Vineyard
Deputy County Surveyor.

SURVEY OF A PORTION OF LOT 13,
EL MODENA CITRUS LANDS, AS
PER MISCELLANEOUS MAPS, BOOK G,
PAGE 32, ORANGE COUNTY, CALIF.



SCALE: 1" = 60'

AUGUST, 1956.

OWNER: DIANE WAIT

A 3/4" Iron Pipe, bearing copper tag marked
L.S. 2326, set at all corners unless otherwise
noted.

Bearings are based on NEWPORT B'L'V'D.
as being S50°53'00"E as shown on M.M.G-32.

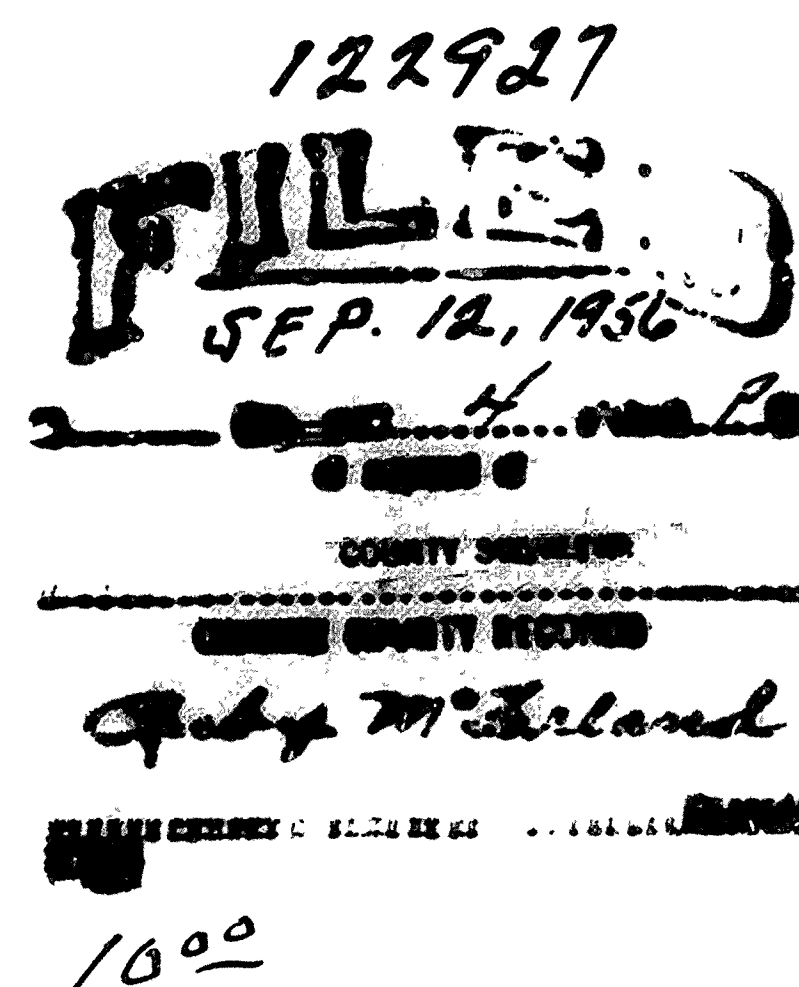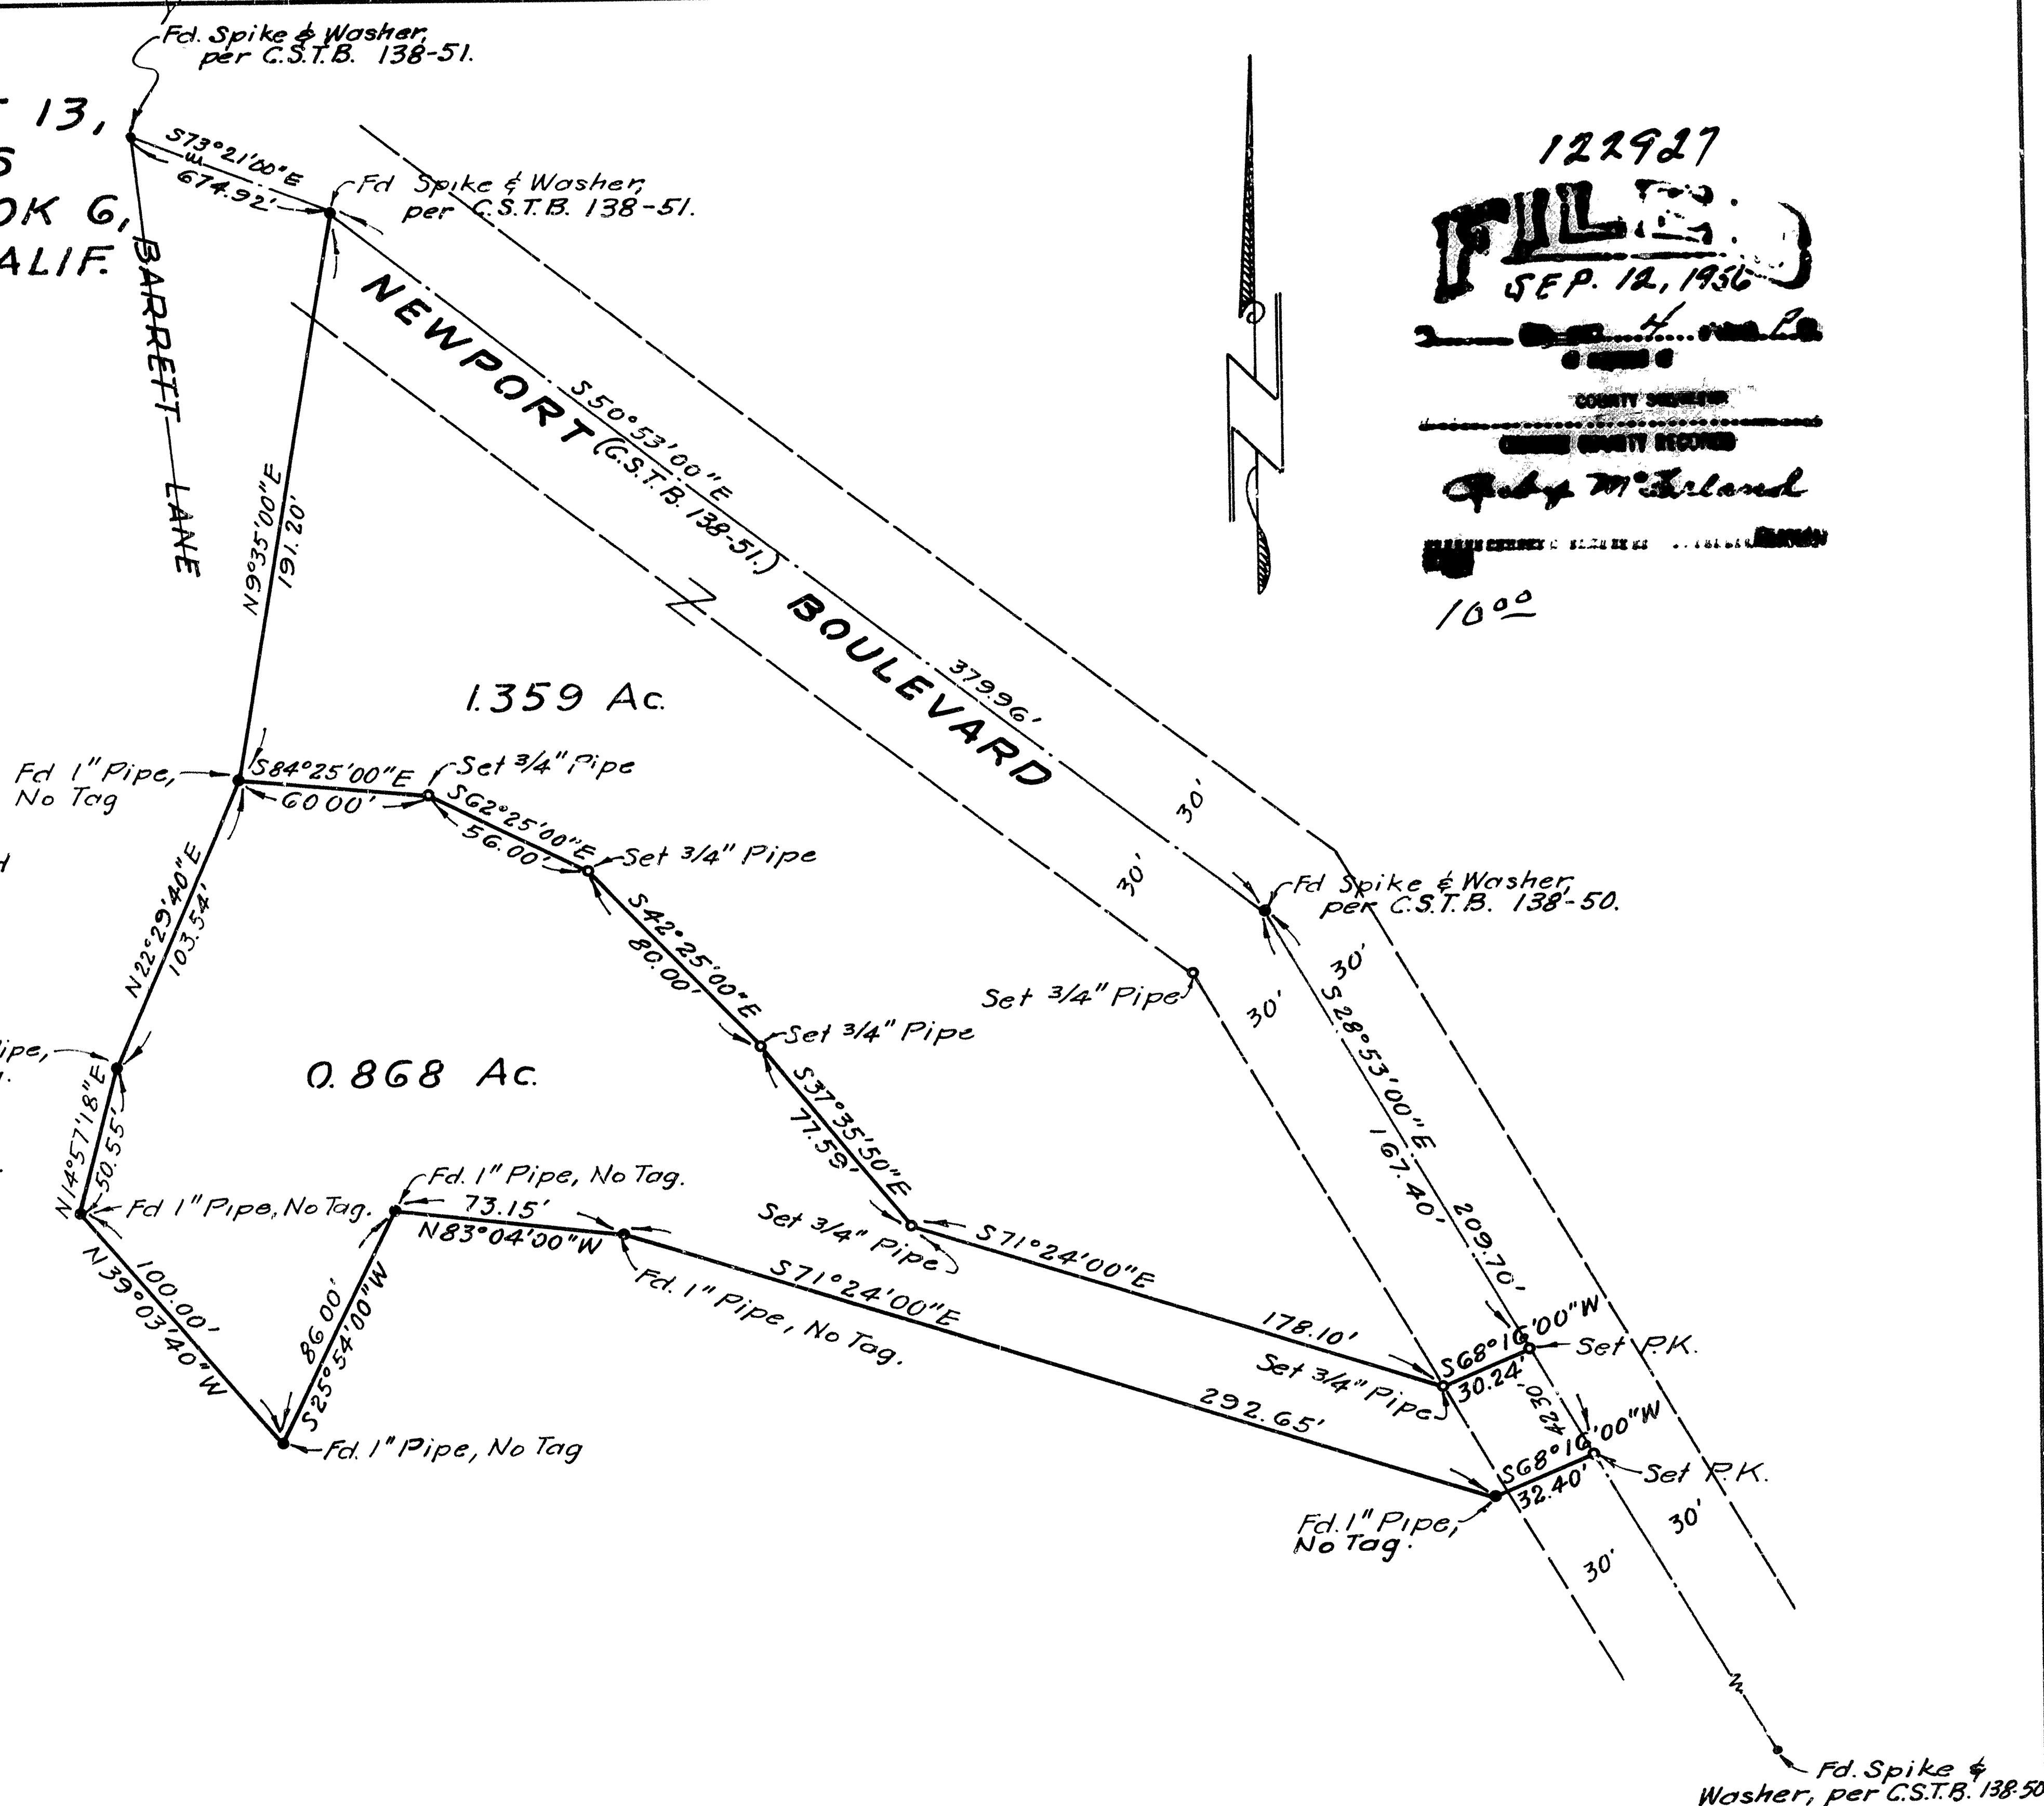

SURVEY OF A PORTION OF THE
SOUTH ONE-HALF OF THE NORTH-
EAST ONE-QUARTER OF THE SOUTH-
WEST ONE-QUARTER OF SECTION 36,
T5S, R.11W, S.B.B. & M.

SCALE: 1" = 100'

AUGUST, 1956.


OWNER: T. L. DUGGER

A 1" Iron Pipe, bearing copper tag marked
L.S. 2326, set at all corners unless otherwise
noted.

Bearings are based on the South line NE 1/4.
SW 1/4 being N89°28'45"W as per R/S 18-19.

THE COUNTY SURVEYORS OFFICE
DOES NOT AGREE WITH THE
POSITIONS OF ANY OF THE
THREE 1/4-1/4 CORNERS ON
THIS MAP.

Owen Vineyard
DEPUTY COUNTY SURVEYOR

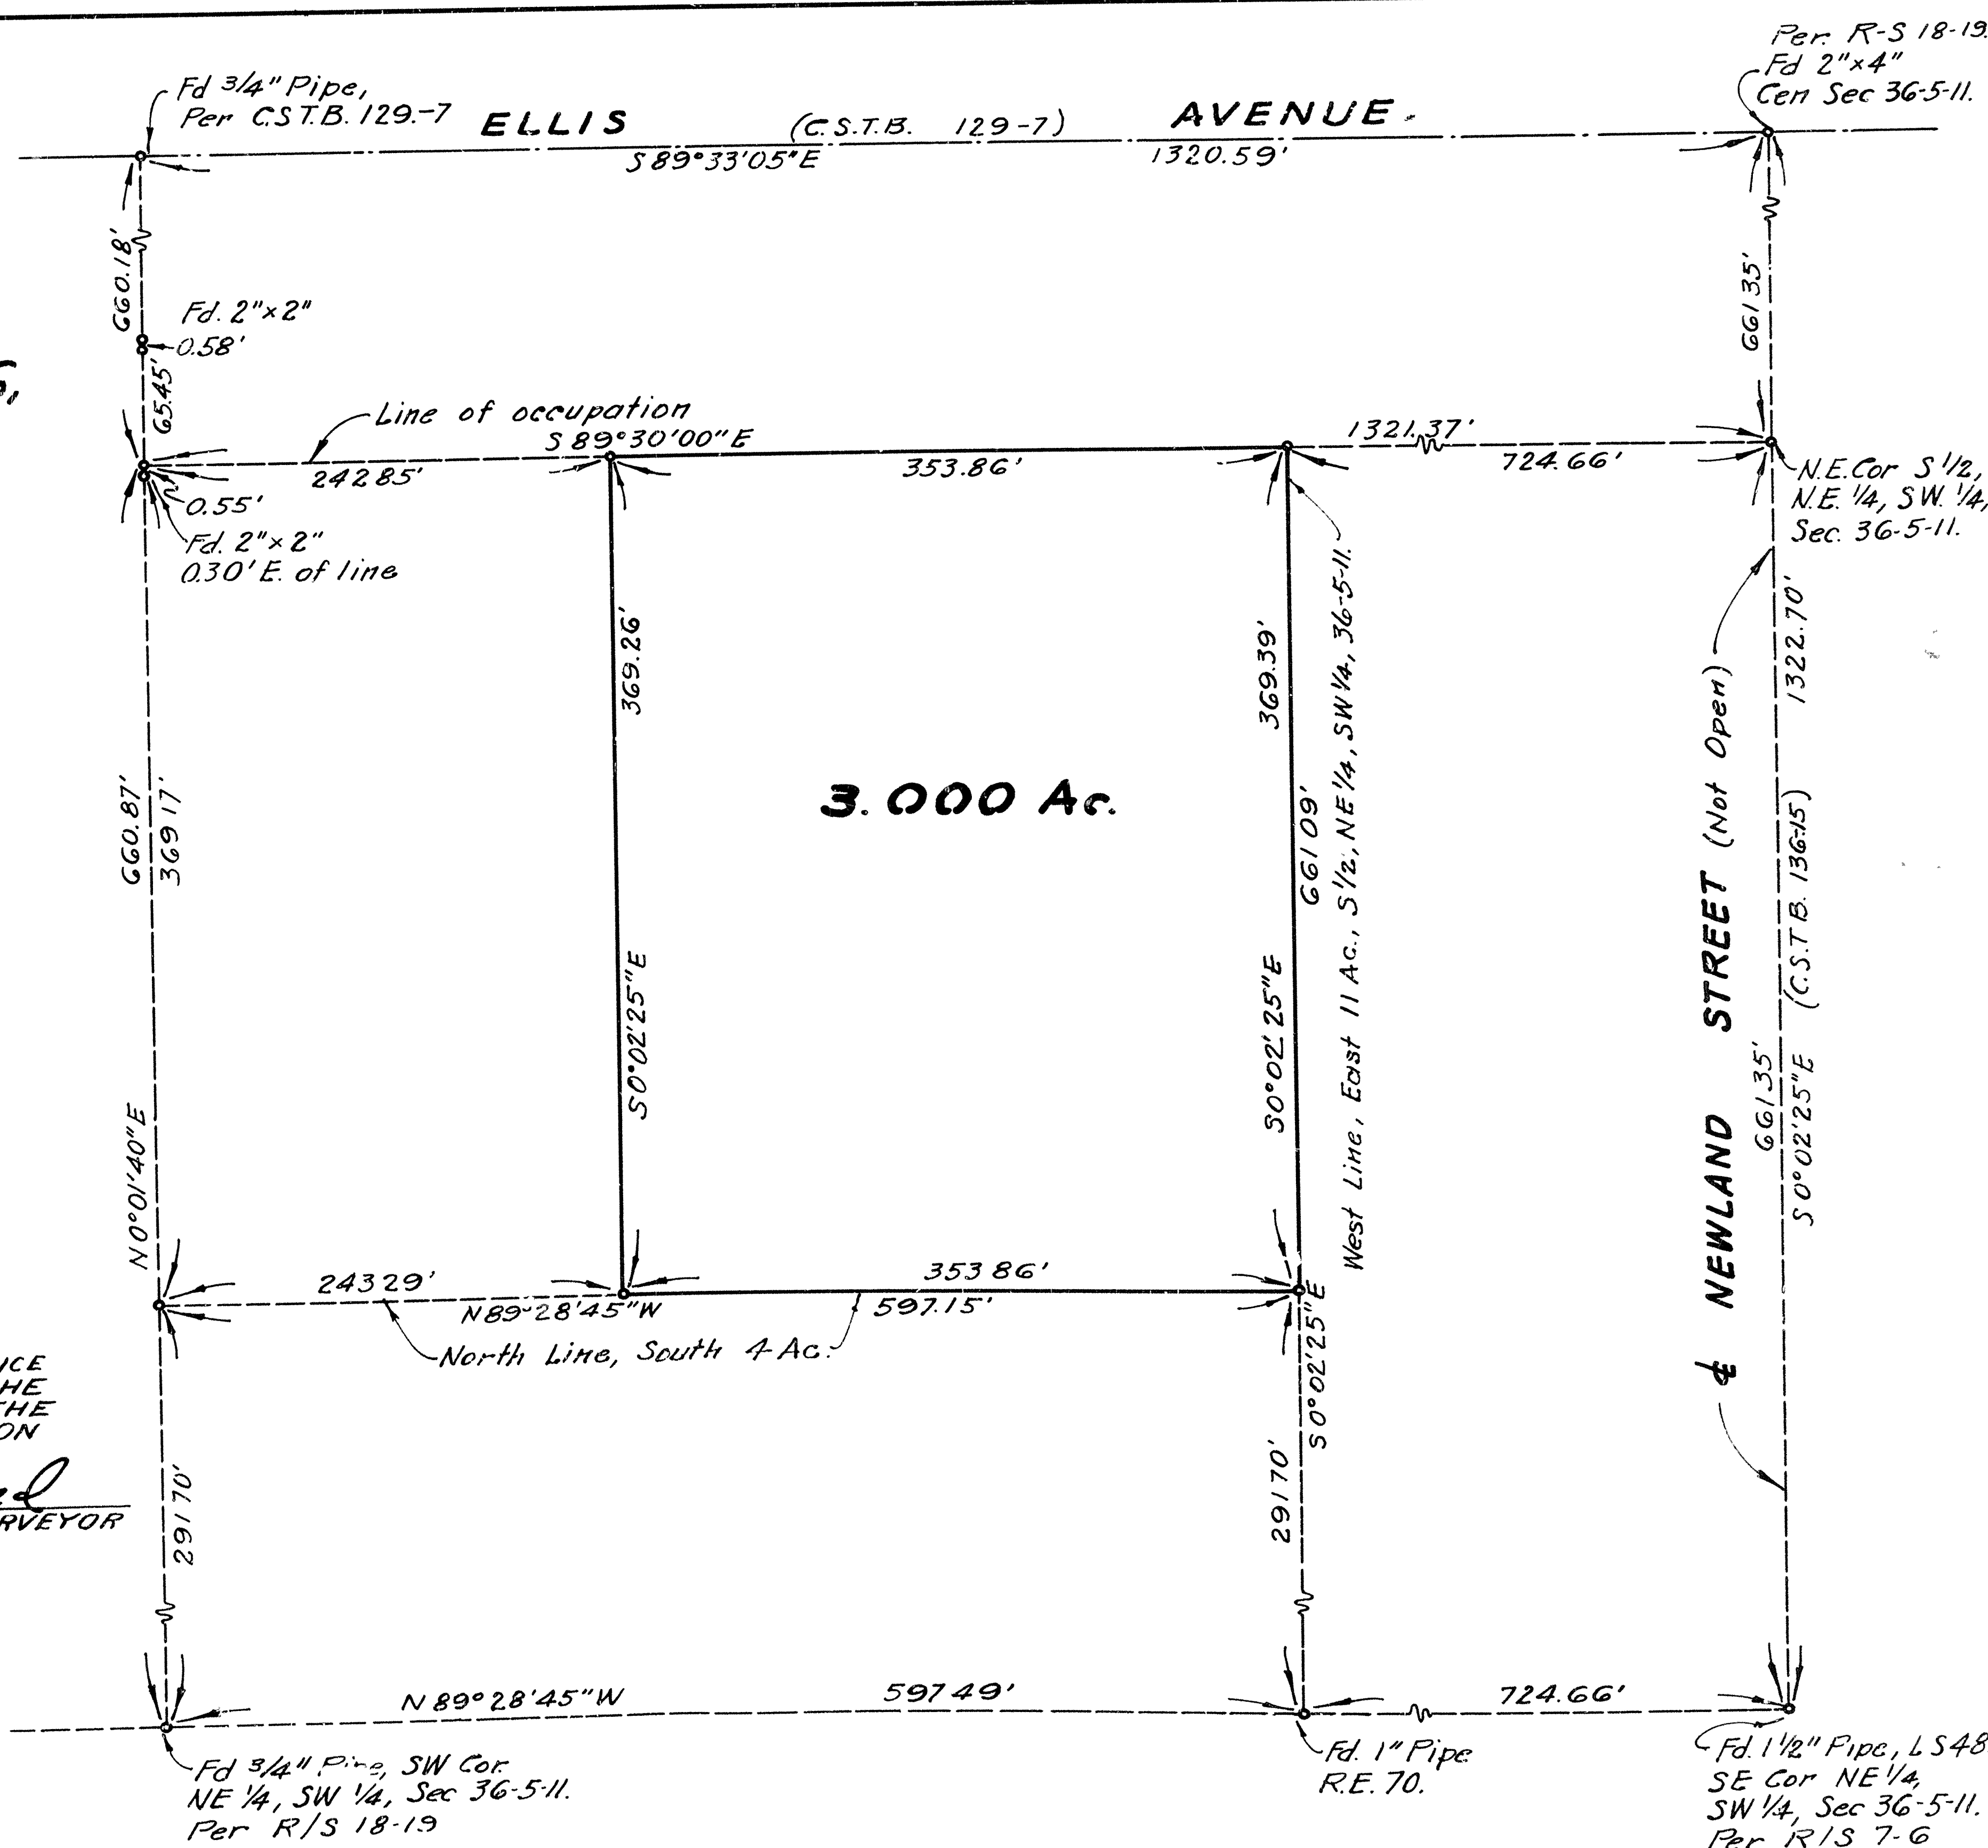

Fd. 1 1/2" Pipe, L.S. 485
SE Cor. NE 1/4,
SW 1/4, Sec 36-5-11.
Per R/S 7-6