

RECORD OF SURVEY

This map has been examined for conformance with the requirements of Chapter 15, Division 3 of the Business and Professions Code.

This map correctly represents a survey made under my direction in conformance with the requirements of Chapter 15, Division 3 of the Business and Professions Code, at the request of the respective owners in February, 1962.

Dated this 22nd day of May 1962

CR Estalman
Deputy County Surveyor

John H. Siegel
R.C.E. 10770

OWNER:
KENNETH ULRICH


DESCRIPTION:

Lot 36, Tract No 670, as shown on a map thereof recorded in Book 20, pages 40 and 41, of Miscellaneous Maps, Records of Orange County, California. IN UNINCORPORATED TERRITORY, ORANGE COUNTY, CALIFORNIA.

BASIS OF BEARINGS:

Bearings herein are based on that portion of the centerline of SKYLINE DRIVE between angle points designated "A-11" and "A-12" (N17°34'40"E) on a map of Tract No 670, M. M. 20: 40, 41.

RST No. 1468

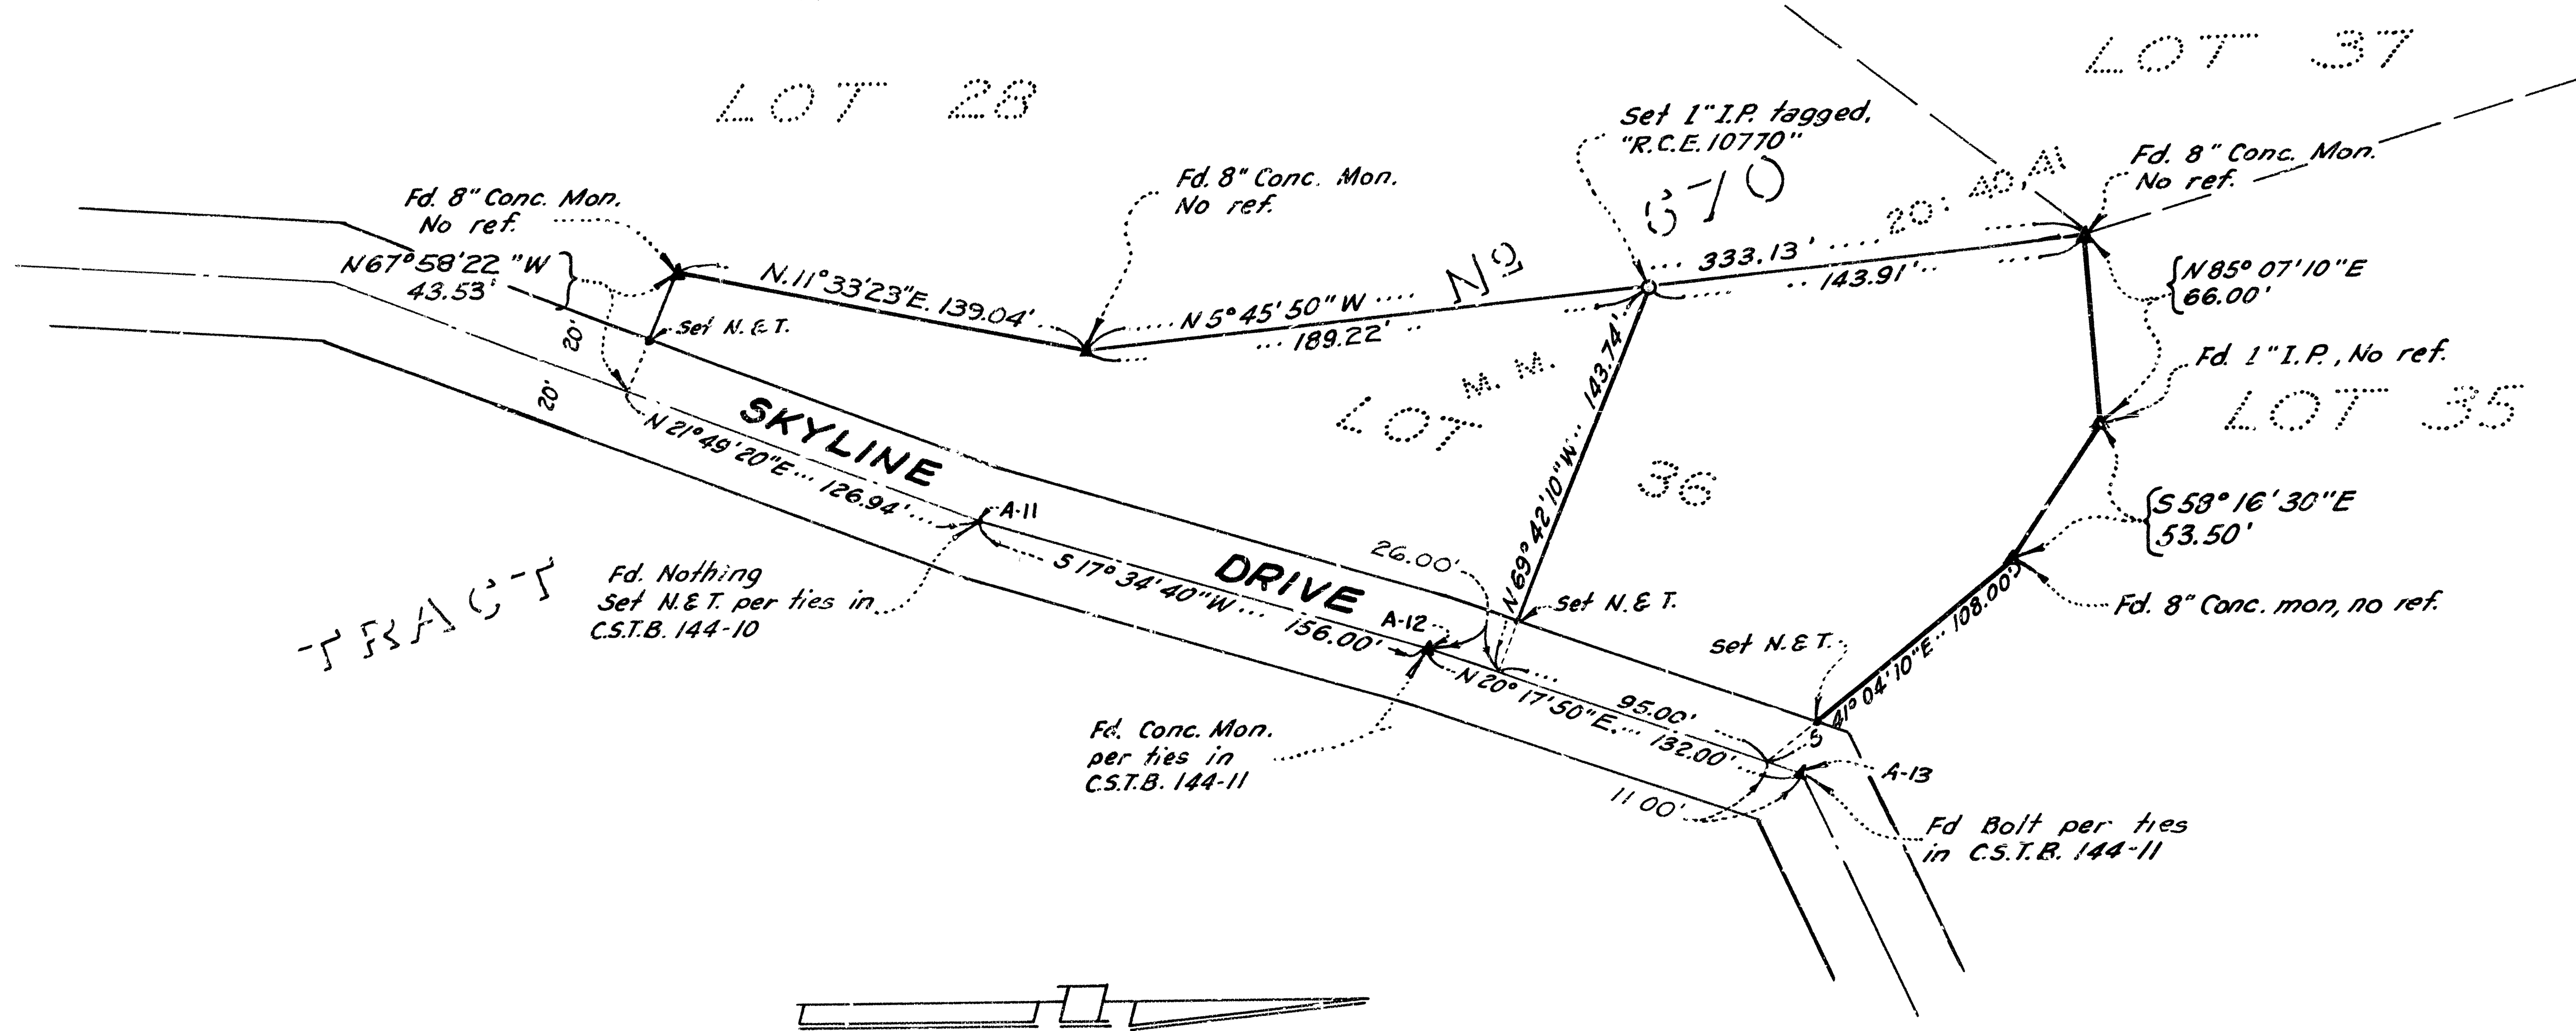

SCALE: 1" = 60'

OWNER:
HANS HANSON

10412 INDEXED MAY 24 1962

RECORDED IN BOOK 20, PAGE 40
BY 1:25 P.M. in Book
at Request of COUNTY SURVEYOR
JAMES McFARLAND, County Recorder

\$5.00

DESCRIPTION

A portion of Lot 9 of El Modena Citrus Lands, as shown on a map thereof recorded in Book 6, page 32 of Miscellaneous Maps, Records of Orange County, California. IN UNINCORPORATED TERRITORY, ORANGE COUNTY, CALIFORNIA.

BASIS OF BEARINGS

Bearings herein are based on the centerline of NEWPORT AVENUE (N 50° 47' 00" W), as shown on R.S. 54-46, Records of Orange County, California.

RST No. 1469

