

24-13

FULL

MAY 20 1901

IN COMPANY OF

W. H. KELLYARD

CITY RECORDS

Jessie M. S. S. S.

RECEIVED

200

RECORD OF SURVEY

PARCELS SHOWN BELOW, GIVING OWNER'S
NAME, LOCATION AND DATE.

I, John M. Hoy, do hereby certify that I am a Licensed Surveyor in the State of California, No 2326, and that this map correctly represents surveys made under my direction at the request of the respective owners, and that all monuments shown actually exist, and their positions are correctly shown.

John M. Hoy

Licensed Surveyor

Examined and approved this 28th day of May, 1951.


W. R. Killgore
County Surveyor

A SURVEY OF A PORTION OF LOT 13, EL MODENA
CITRUS LANDS, AS PER MAP THEREOF RECORDED
IN BOOK 6, PAGE 32, MISC. MAPS, RECORDS OF
ORANGE COUNTY, CALIF.

SCALE: 1" = 60'

MAY, 1951.

Owner: ROSCOE WILSON

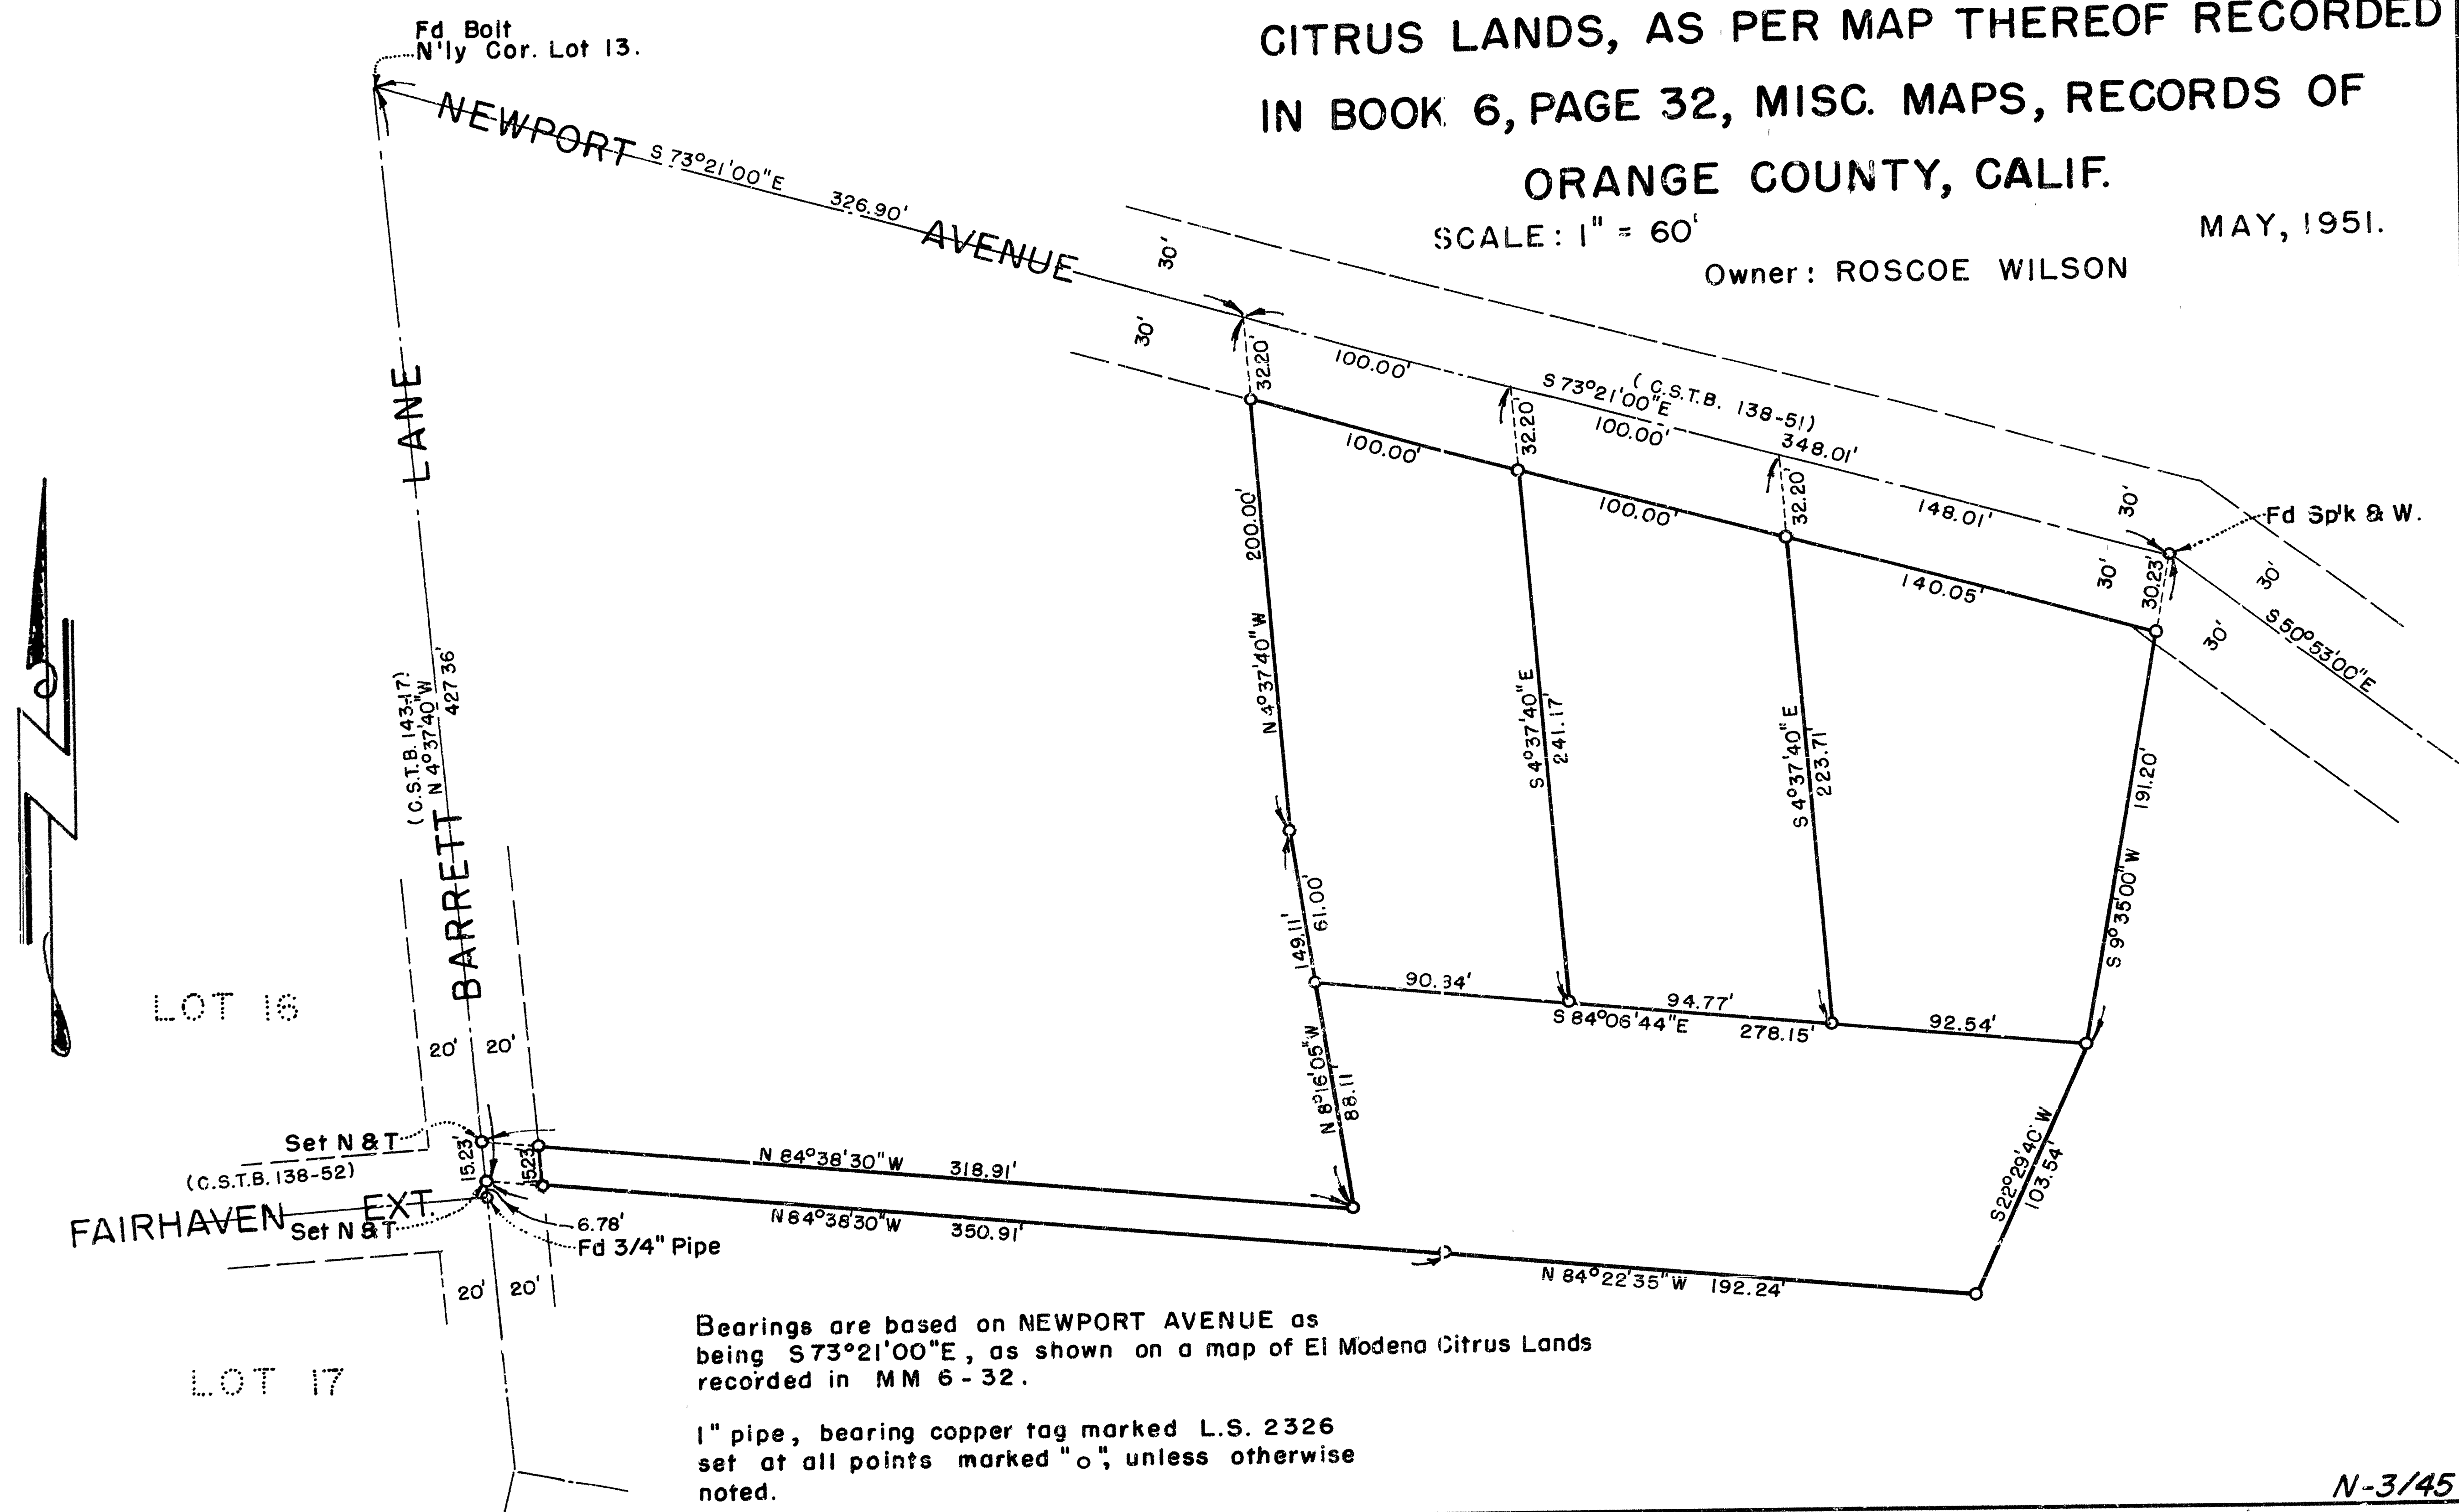


N-3/45

A SURVEY OF A PORTION OF THE NORTH ONE-HALF OF THE NORTHWEST
ONE-QUARTER OF THE NORTHEAST ONE-QUARTER OF SEC. 21, T5S, R10W,
S.B.B. & M., ORANGE COUNTY, CALIF.

SCALE: 1" = 100'

MAY, 1951.

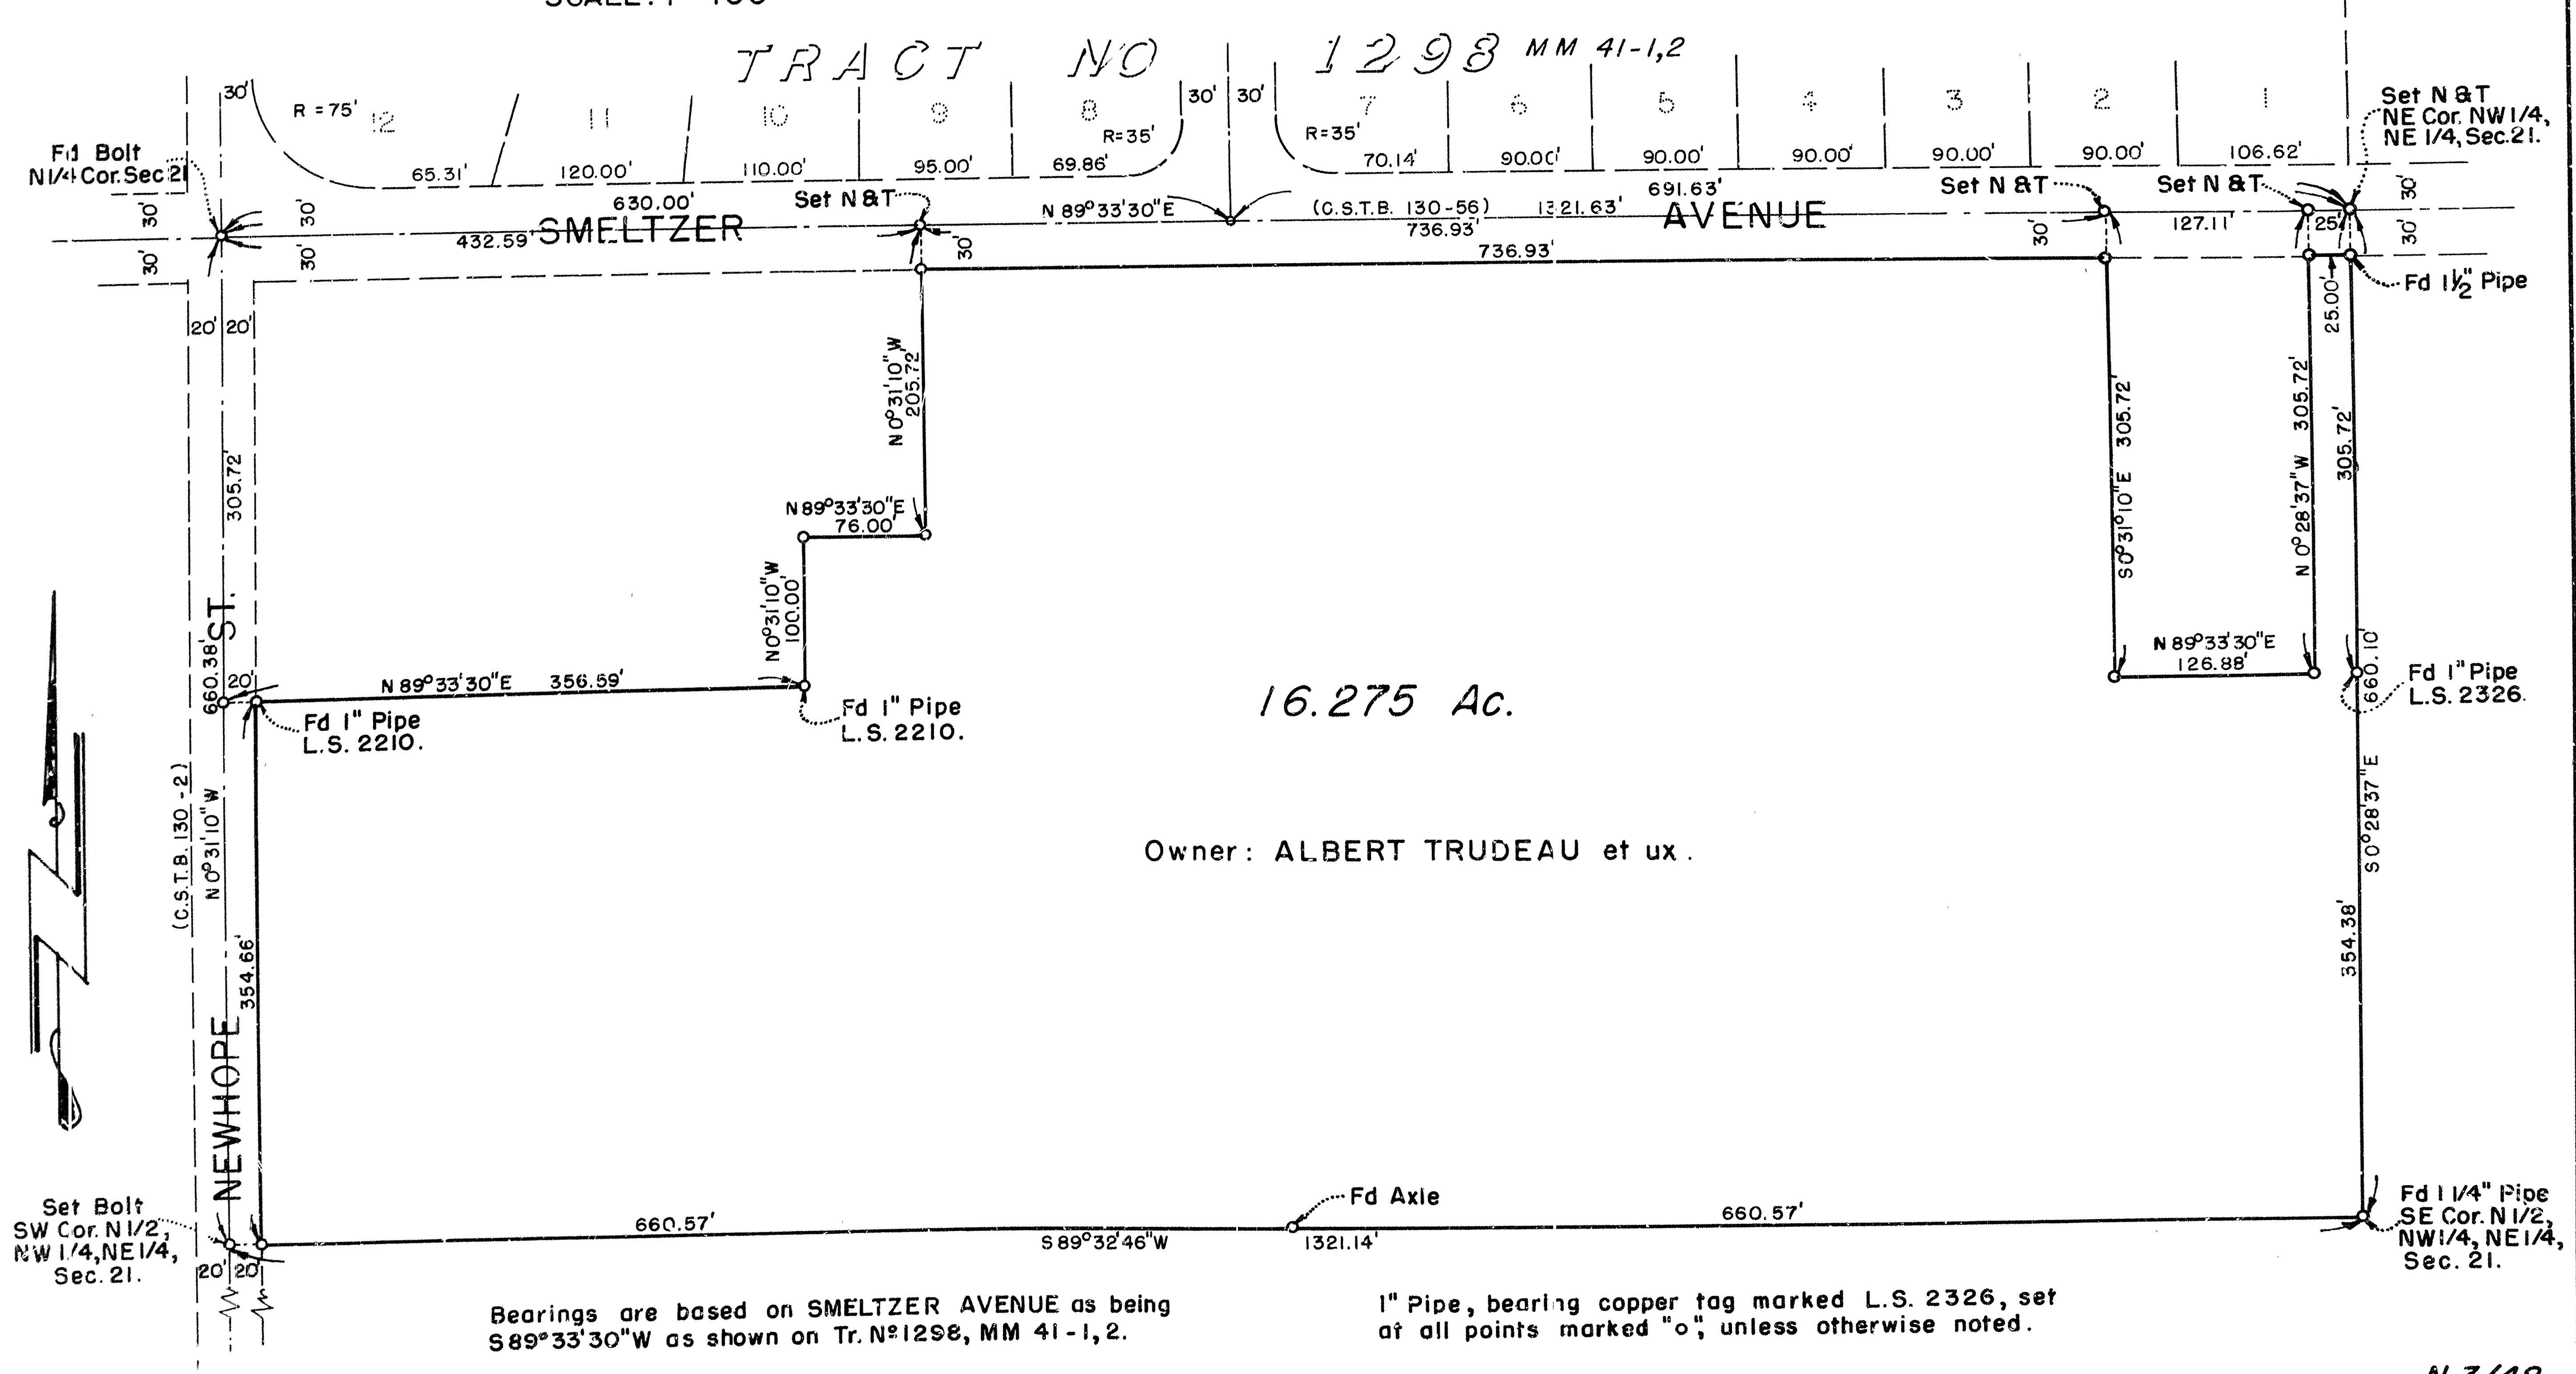

N-3/48

24-13