

DL 728

RST 3135

PARCEL MAP

IN THE UNINCORPORATED TERRITORY OF ORANGE COUNTY, CALIF.
A PORTION OF LOT 7, EL MODENA CITRUS LANDS, BOOK
6, PAGE 32, MISCELLANEOUS MAPS, RECORDS OF ORANGE
COUNTY, CALIFORNIA

2936

MAY 4 1968

PAID FOR RECORD THIS _____ DAY OF _____
 AT 4:22 P.M. IN BOOK 2 PAGE 37
 OF PARCEL MAPS COUNTY OF ORANGE, CALIFORNIA
 AT REQUEST OF COUNTY SURVEYOR
 \$5.00 J. WYLLIE CARLYLE, County Recorder

SCALE: 1"=40'

FEB. 1966

JOHN M. HOY RCE 11537

This map was prepared by me or under my direction and is based upon a field survey in conformance with the requirements of the Subdivision Map Act of the request of EMMON R. SMITH in February, 1997. I hereby certify that it conforms to the approved tentative map and the conditions of approval thereof; that all provisions of applicable state law and local ordinances have been complied with.


Bearings are based on the E. of Newport Ave. being N 73° 21' 00" W per R/S 76/2, Records of Orange County, California.

This map has been examined this 4th
day of May 1966, for conformance with
the requirements of Section 11575 of the Subdi-
vision Map Act.

DEPUTY COUNTY SURVEYOR

JOHN M. HOY - BCE 11537

R. S. 76 / 2

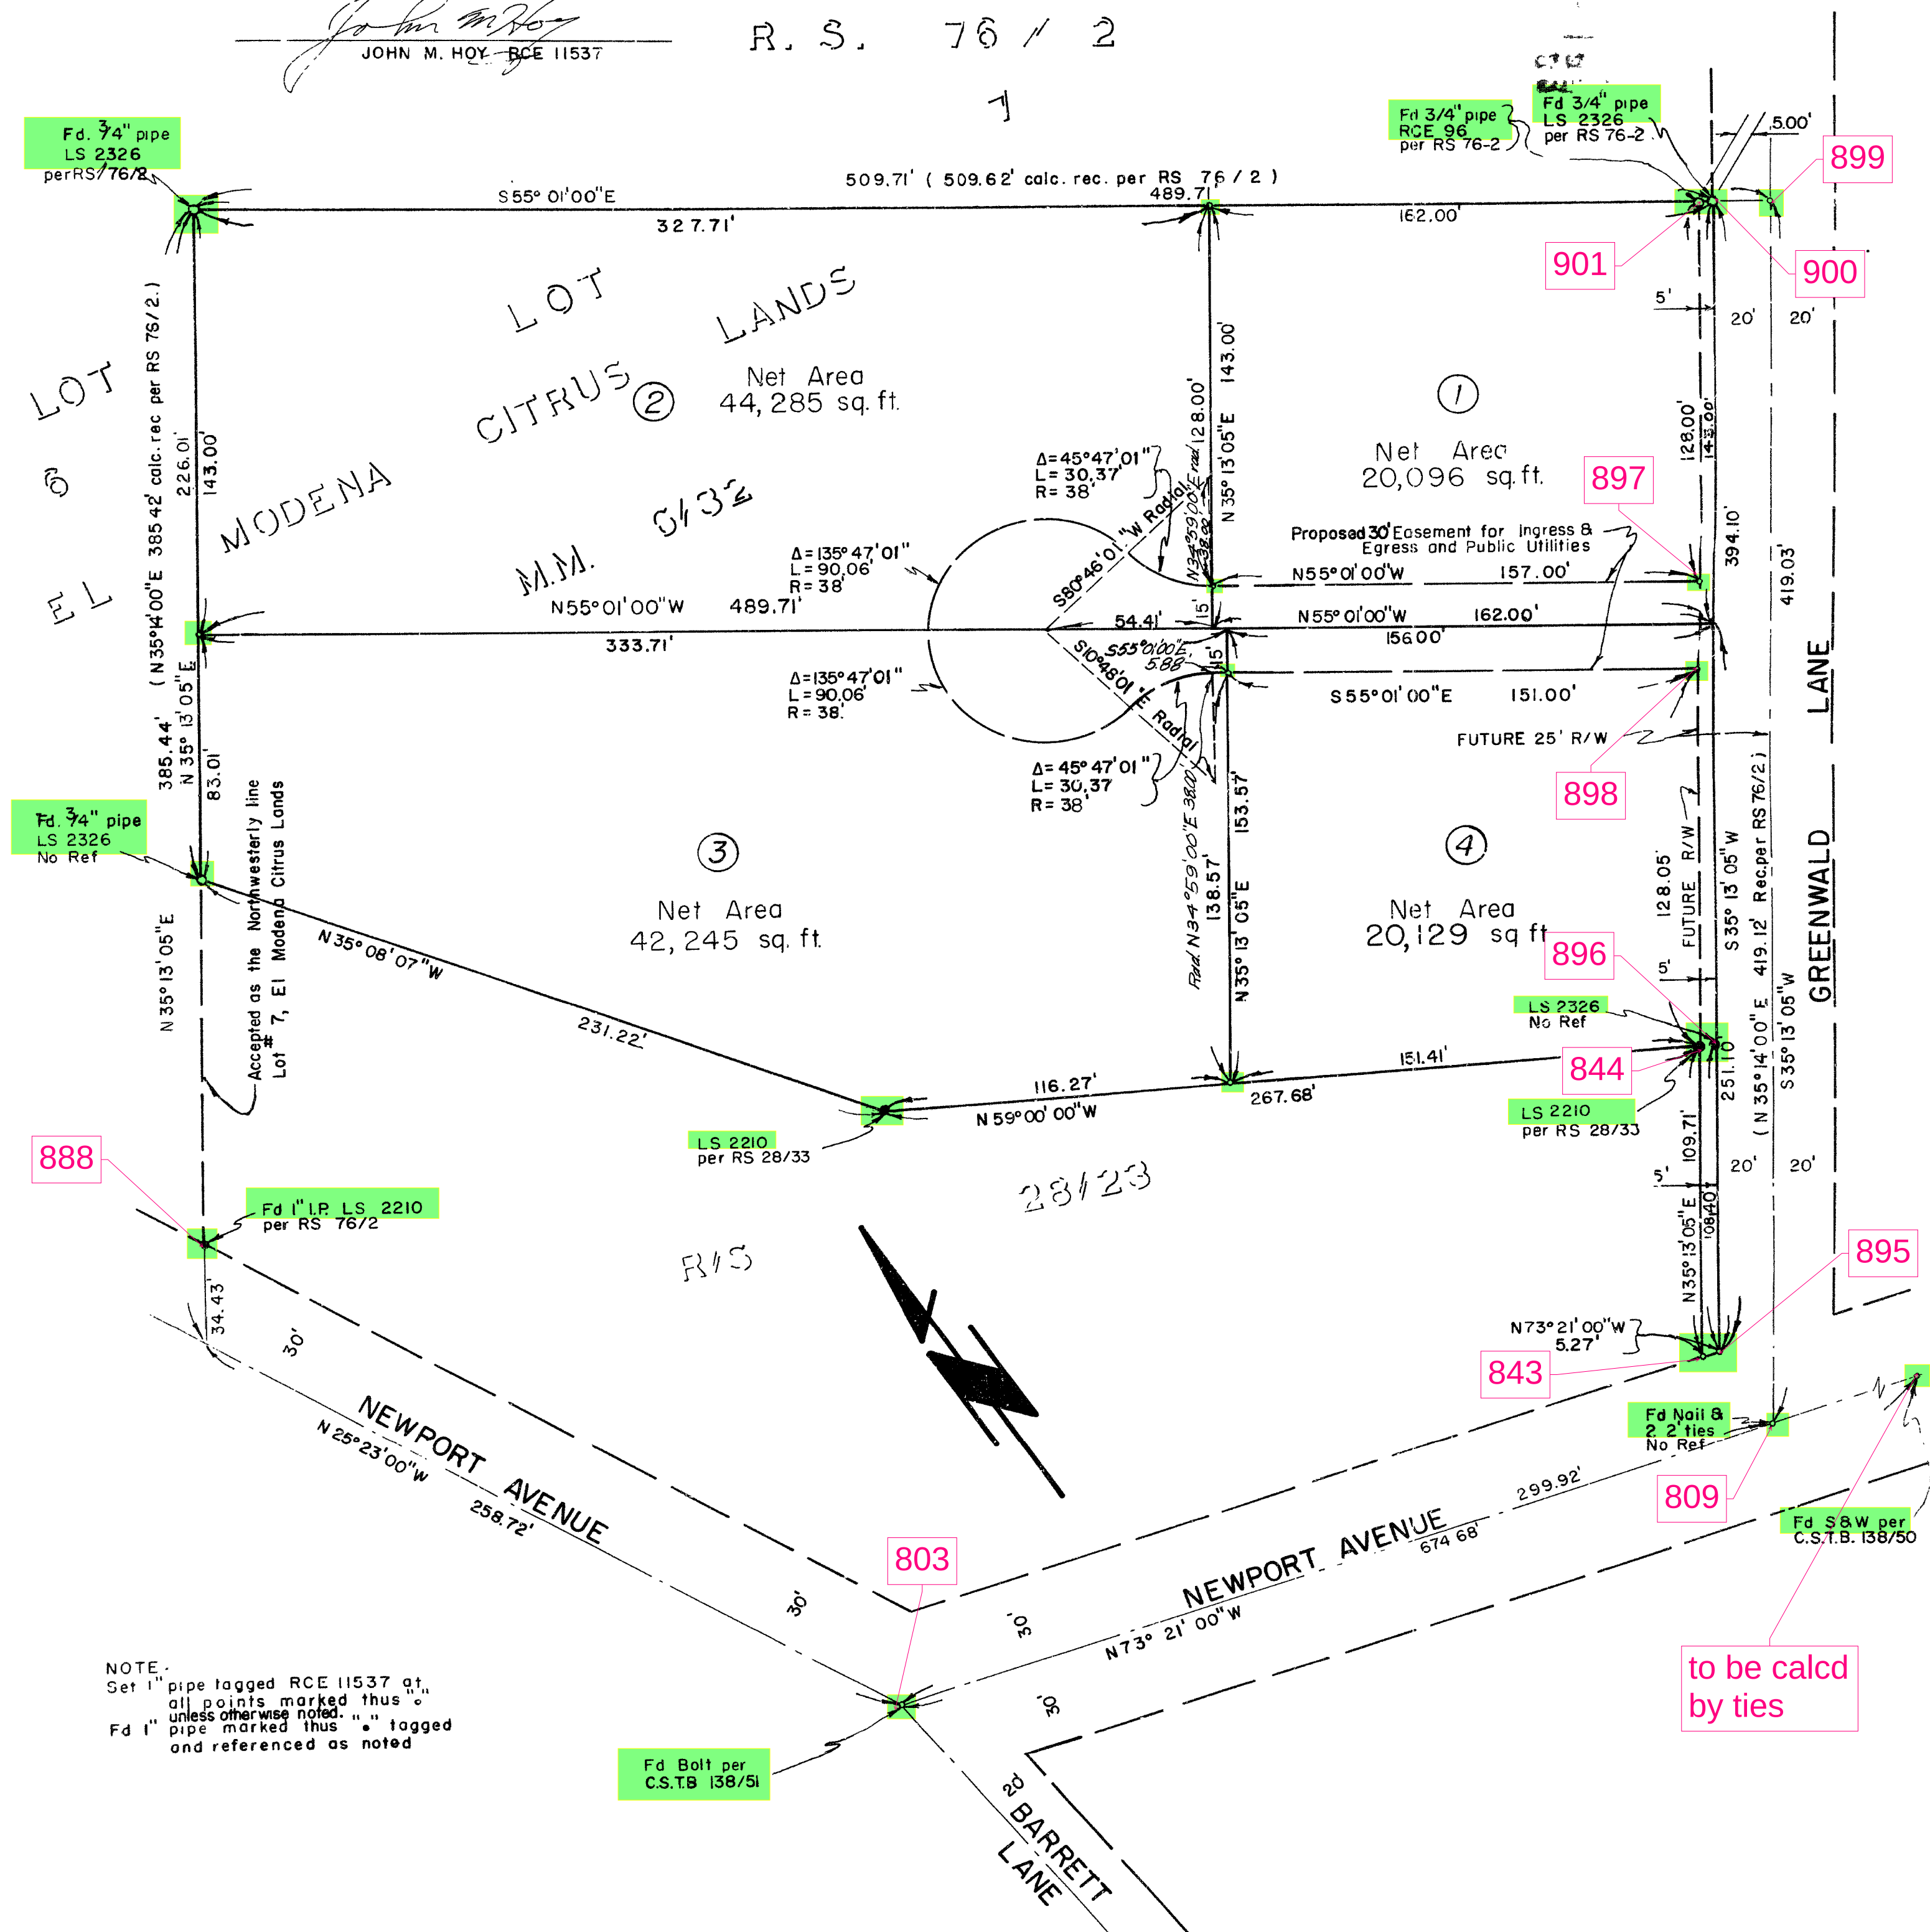

NOTE -
Set 1 " pipe tagged RCE 11537 at
all points marked thus " "
unless otherwise noted. " "
Fd 1 " pipe marked thus " " tagged
and referenced as noted

to be calcd
by ties