


RECORD OF SURVEY
OF PARCELS SHOWN BELOW, GIVING NAME OF OWNER,
DATE OF SURVEY, SCALE, AND OTHER DATA AS INDICATED

50676
APR 28, 1955
ALLEN S. KOSCH
Surveyor

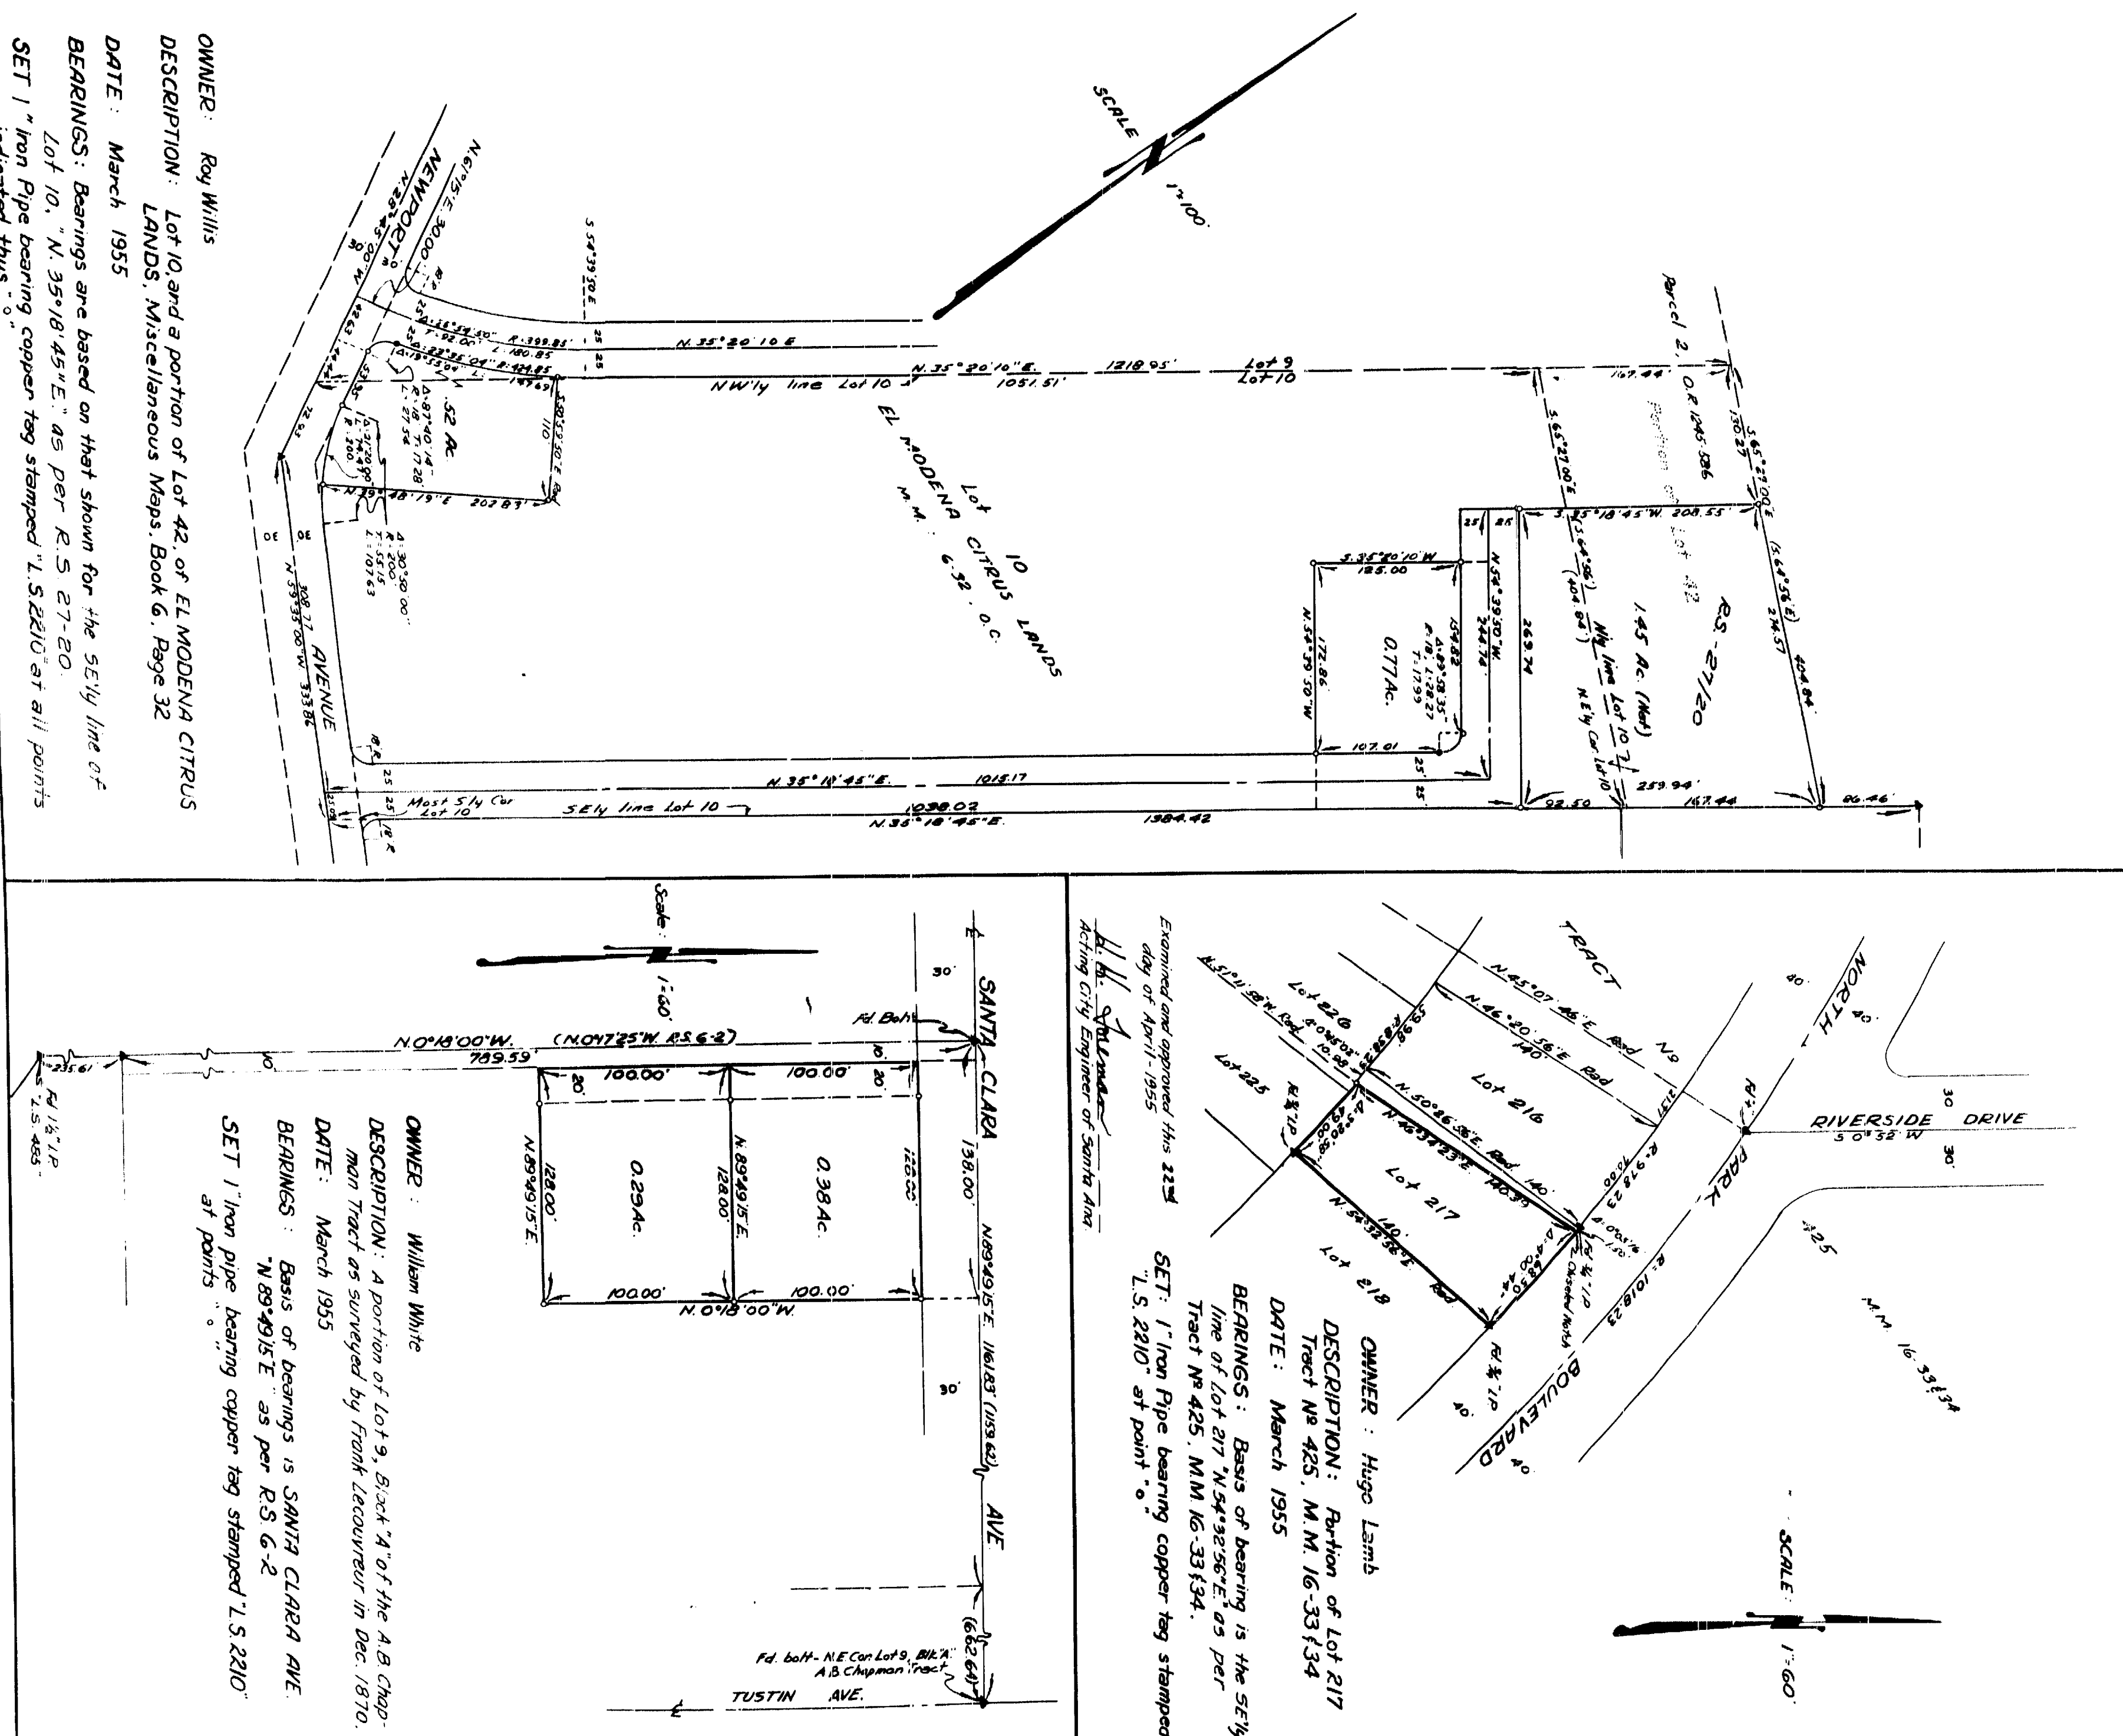

I, D.B. Hildbrand, Surveyor, certify that I am a Licensed Surveyor (No. 250) of the State of California; that this map, consisting of one sheet, was made by me or under my direct supervision, and that the same was made under my direct supervision at the time of the survey, and that the same is correctly shown.

A.B. Hildbrand
Licensed Surveyor

Examined and approved of: *April 1, 1955*
Allen S. Kosch
County Surveyor