

IN UNINCORPORATED TERRITORY, ORANGE COUNTY, CALIFORNIA.

R.S.T. 6539 T.P.M. 1403

THIS MAP WAS PREPARED BY ME OR UNDER MY DIRECTION
AND IS BASED UPON A FIELD SURVEY IN CONFORMANCE WITH
THE REQUIREMENTS OF THE SUBDIVISION MAP ACT AT THE RE-
QUEST OF J. O. HAGAR ON DECEMBER 21, 1972. I HERE-
BY CERTIFY THAT IT CONFORMS TO THE APPROVED TENTATIVE
CONDITIONS OF APPROVAL THEREOF; THAT ALL PRO-
VISIONS OF APPLICABLE STATE LAW AND LOCAL ORDINANCES
HAVE BEEN COMPLIED WITH.

A.R. McDANIEL RCE 9808

EXAMINED AND APPROVED THIS 18th DAY OF Dec. 1974

L. Mc CONVILLE
COUNTY SURVEYOR


BY Lawrence L. Bacon
DEPUTY COUNTY SURVEYOR

BEING A PORTION OF LOT 14 OF EL MODELA CITRUS LANDS,
M.M. 6 - 32, AND A PORTION OF LOTS 30 AND 31 OF TRACT
No 916, M.M. 29-2/4, BOTH RECORDS OF ORANGE COUNTY, CALIF.

THE CENTERLINE OF CRAWFORD CANYON ROAD, FORMERLY
NEWPORT AVENUE BEING N 0° 14' 46" E PER P.M. 34-33
RECORDS OF ORANGE COUNTY, CALIF.

- INDICATES SET 1" IRON PIPE WITH TAG MARKED RCE 9808
- INDICATES POINTS FOUND AS NOTED.

"R" INDICATES RECORD BEARINGS AND DISTANCES PER P.M. 34-33,
RECORDS OF ORANGE COUNTY, CALIF.

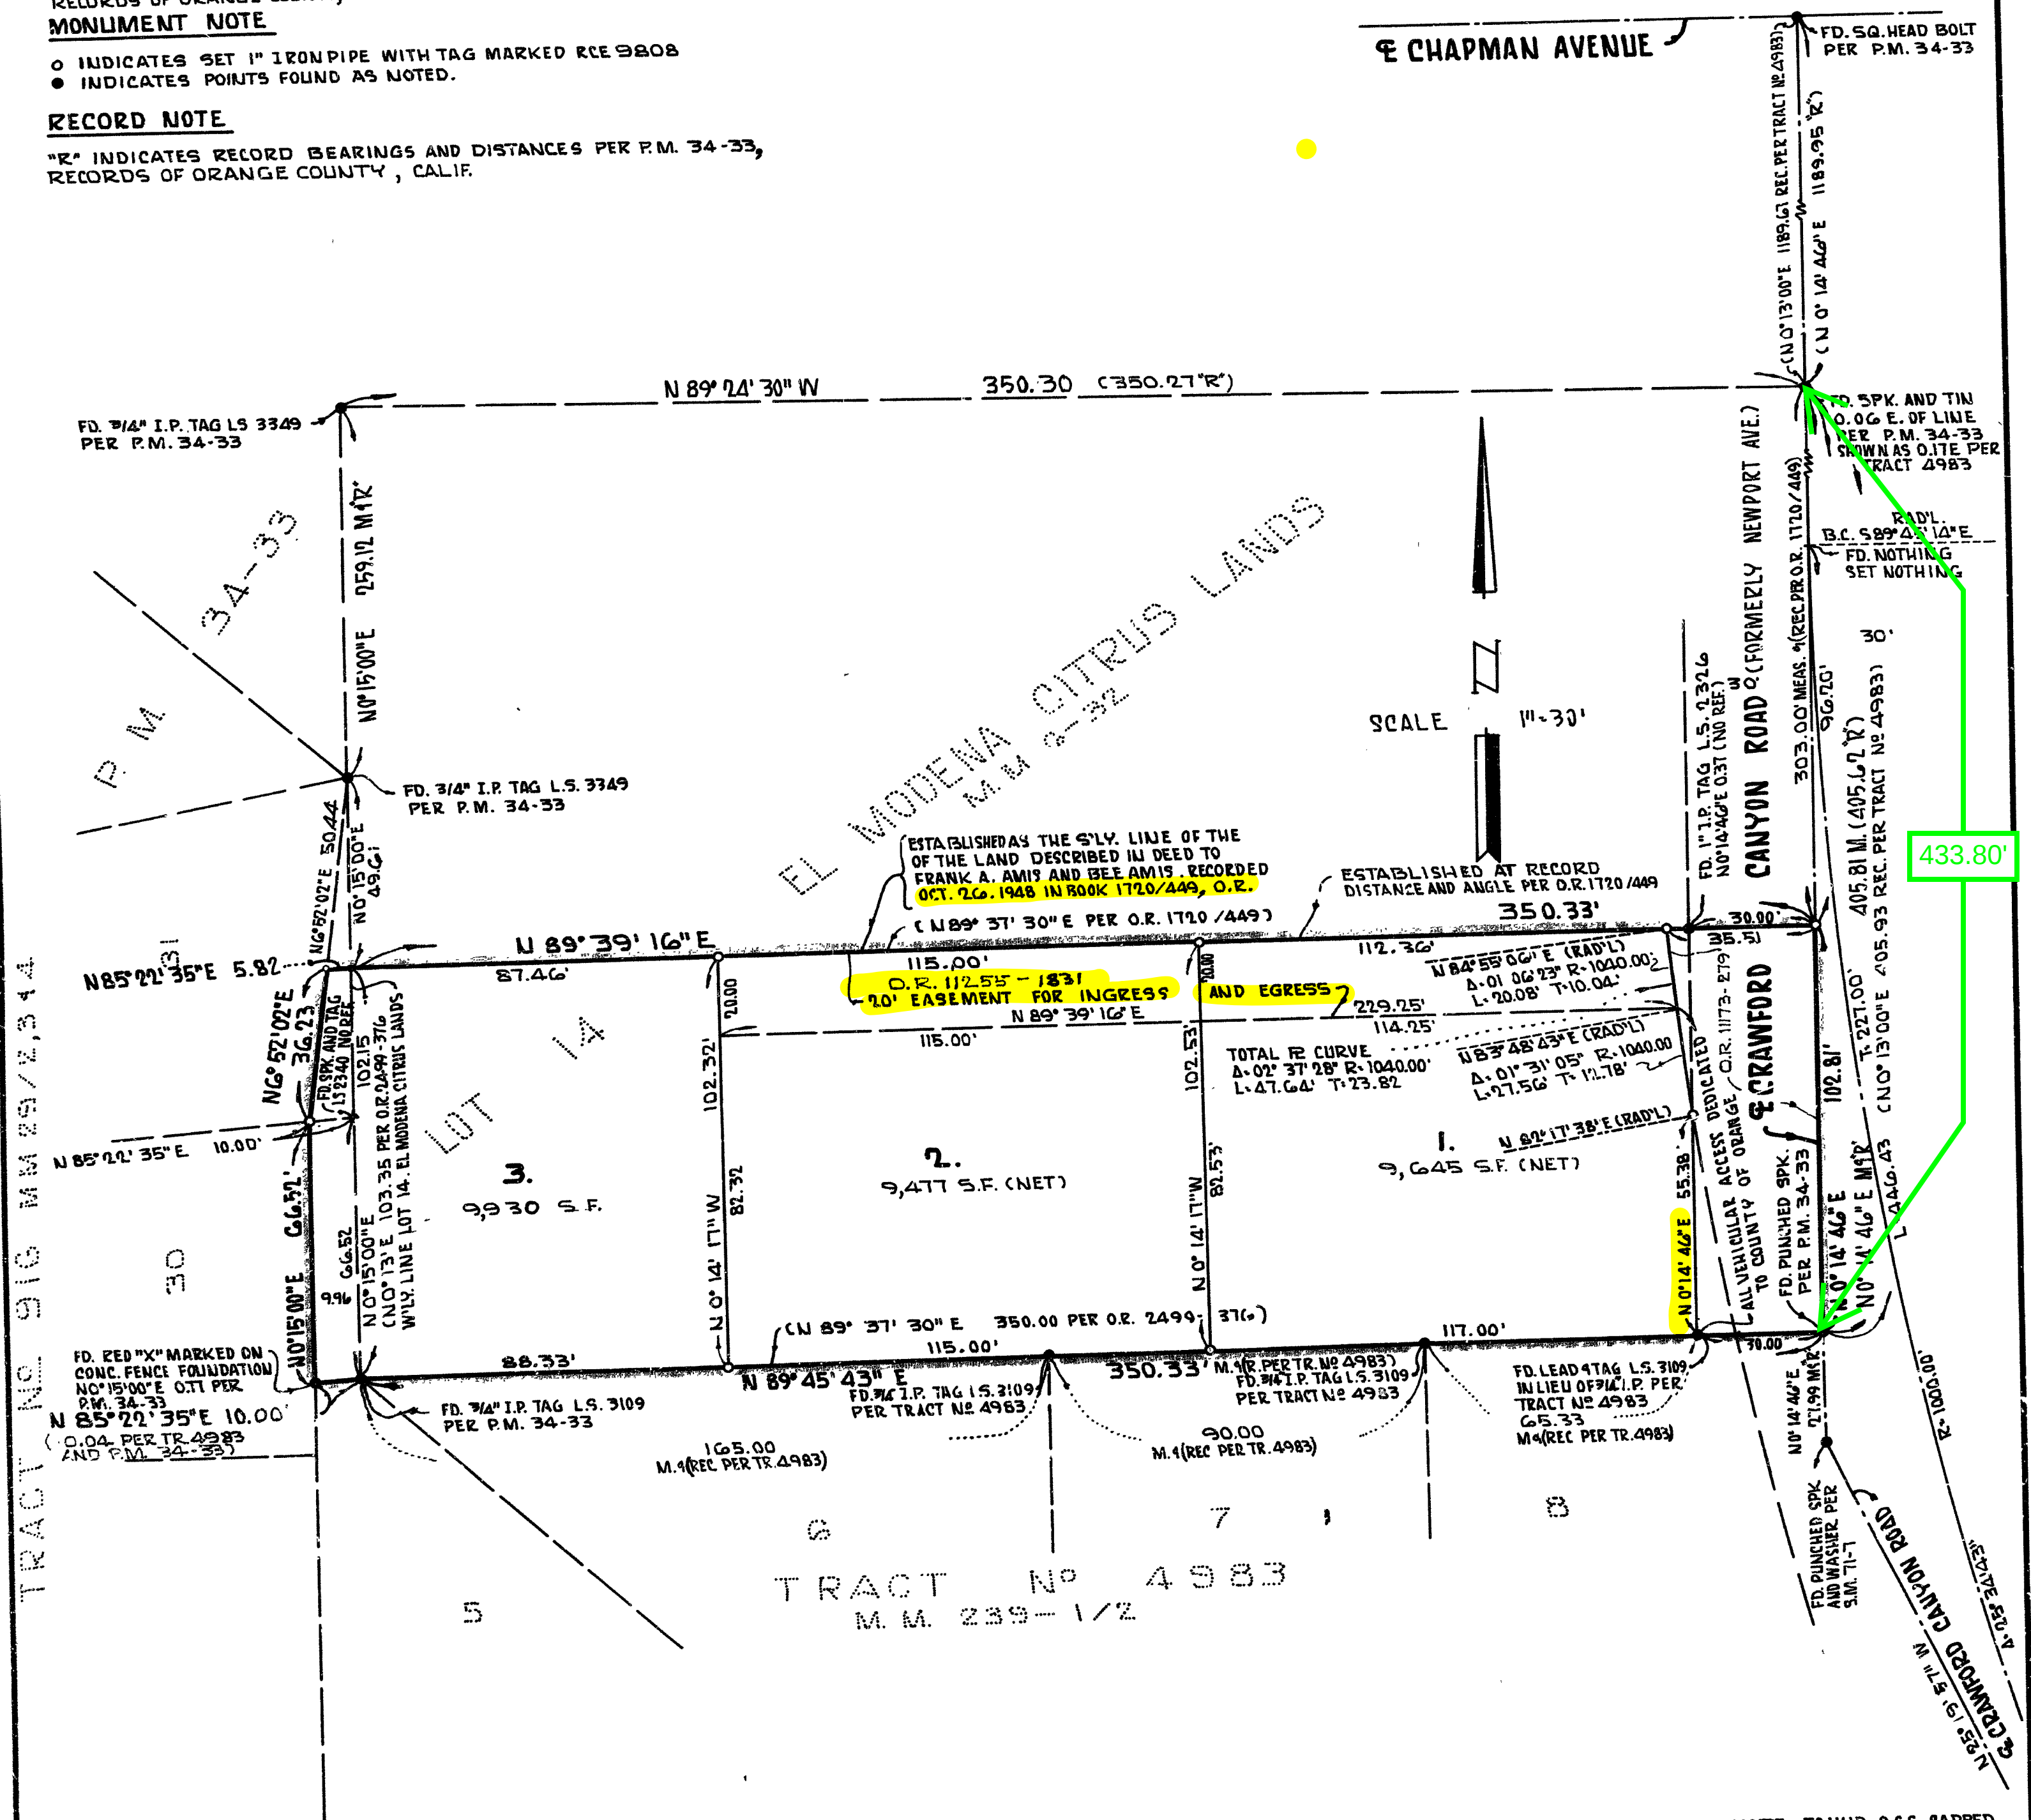

NOTE: FOUND O.C.S. CAPPED
WELL WITH 3/4" I.P. TAGGED
I.S. 3109 PER S.M. 71-7
AT END OF CURVE
(SE'LY ON LINE 0.07')
(PER S.M. 71-7.)