








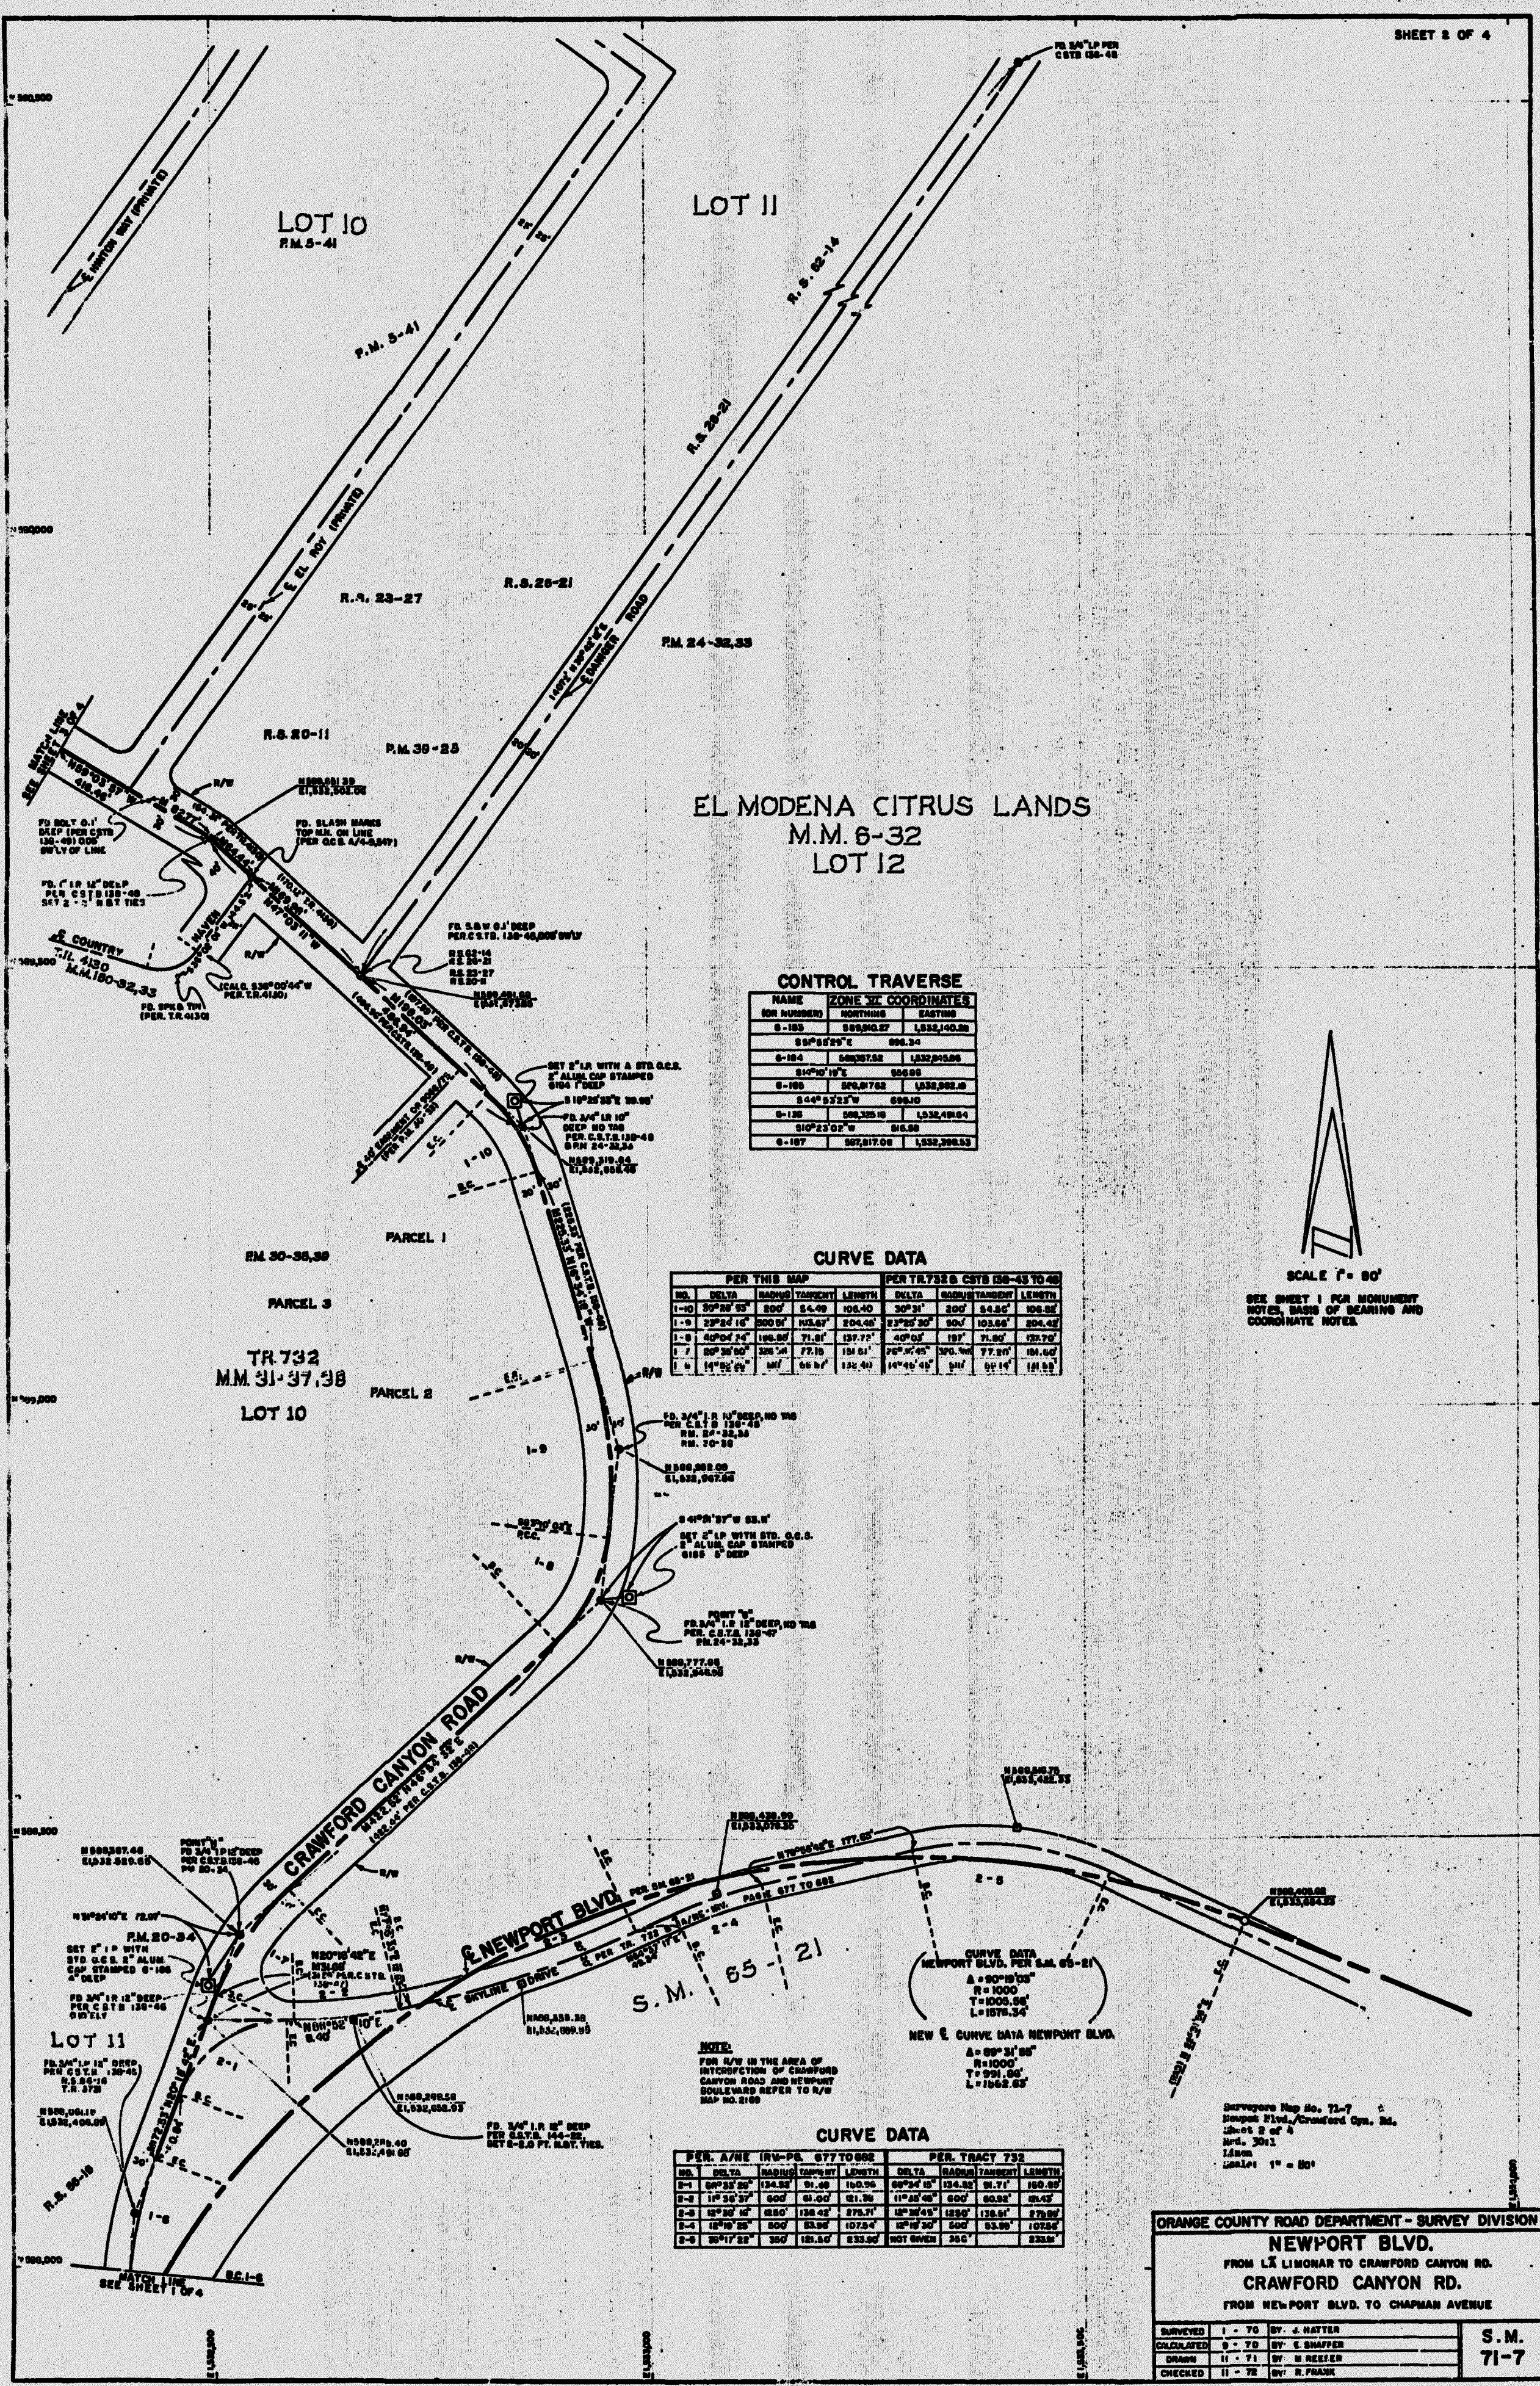

SM 71-7