

RECORD OF SURVEY


OF PARCELS SHOWN BELOW GIVING NAME OF OWNER, SCALE,
DATE OF SURVEY, AND OTHER DATA AS INDICATED.



W.D. Hilliard
Public Surveyor


40°

Set 1" Iron pipe bearing brass tag stamped "L.S. 2210" at points "o".

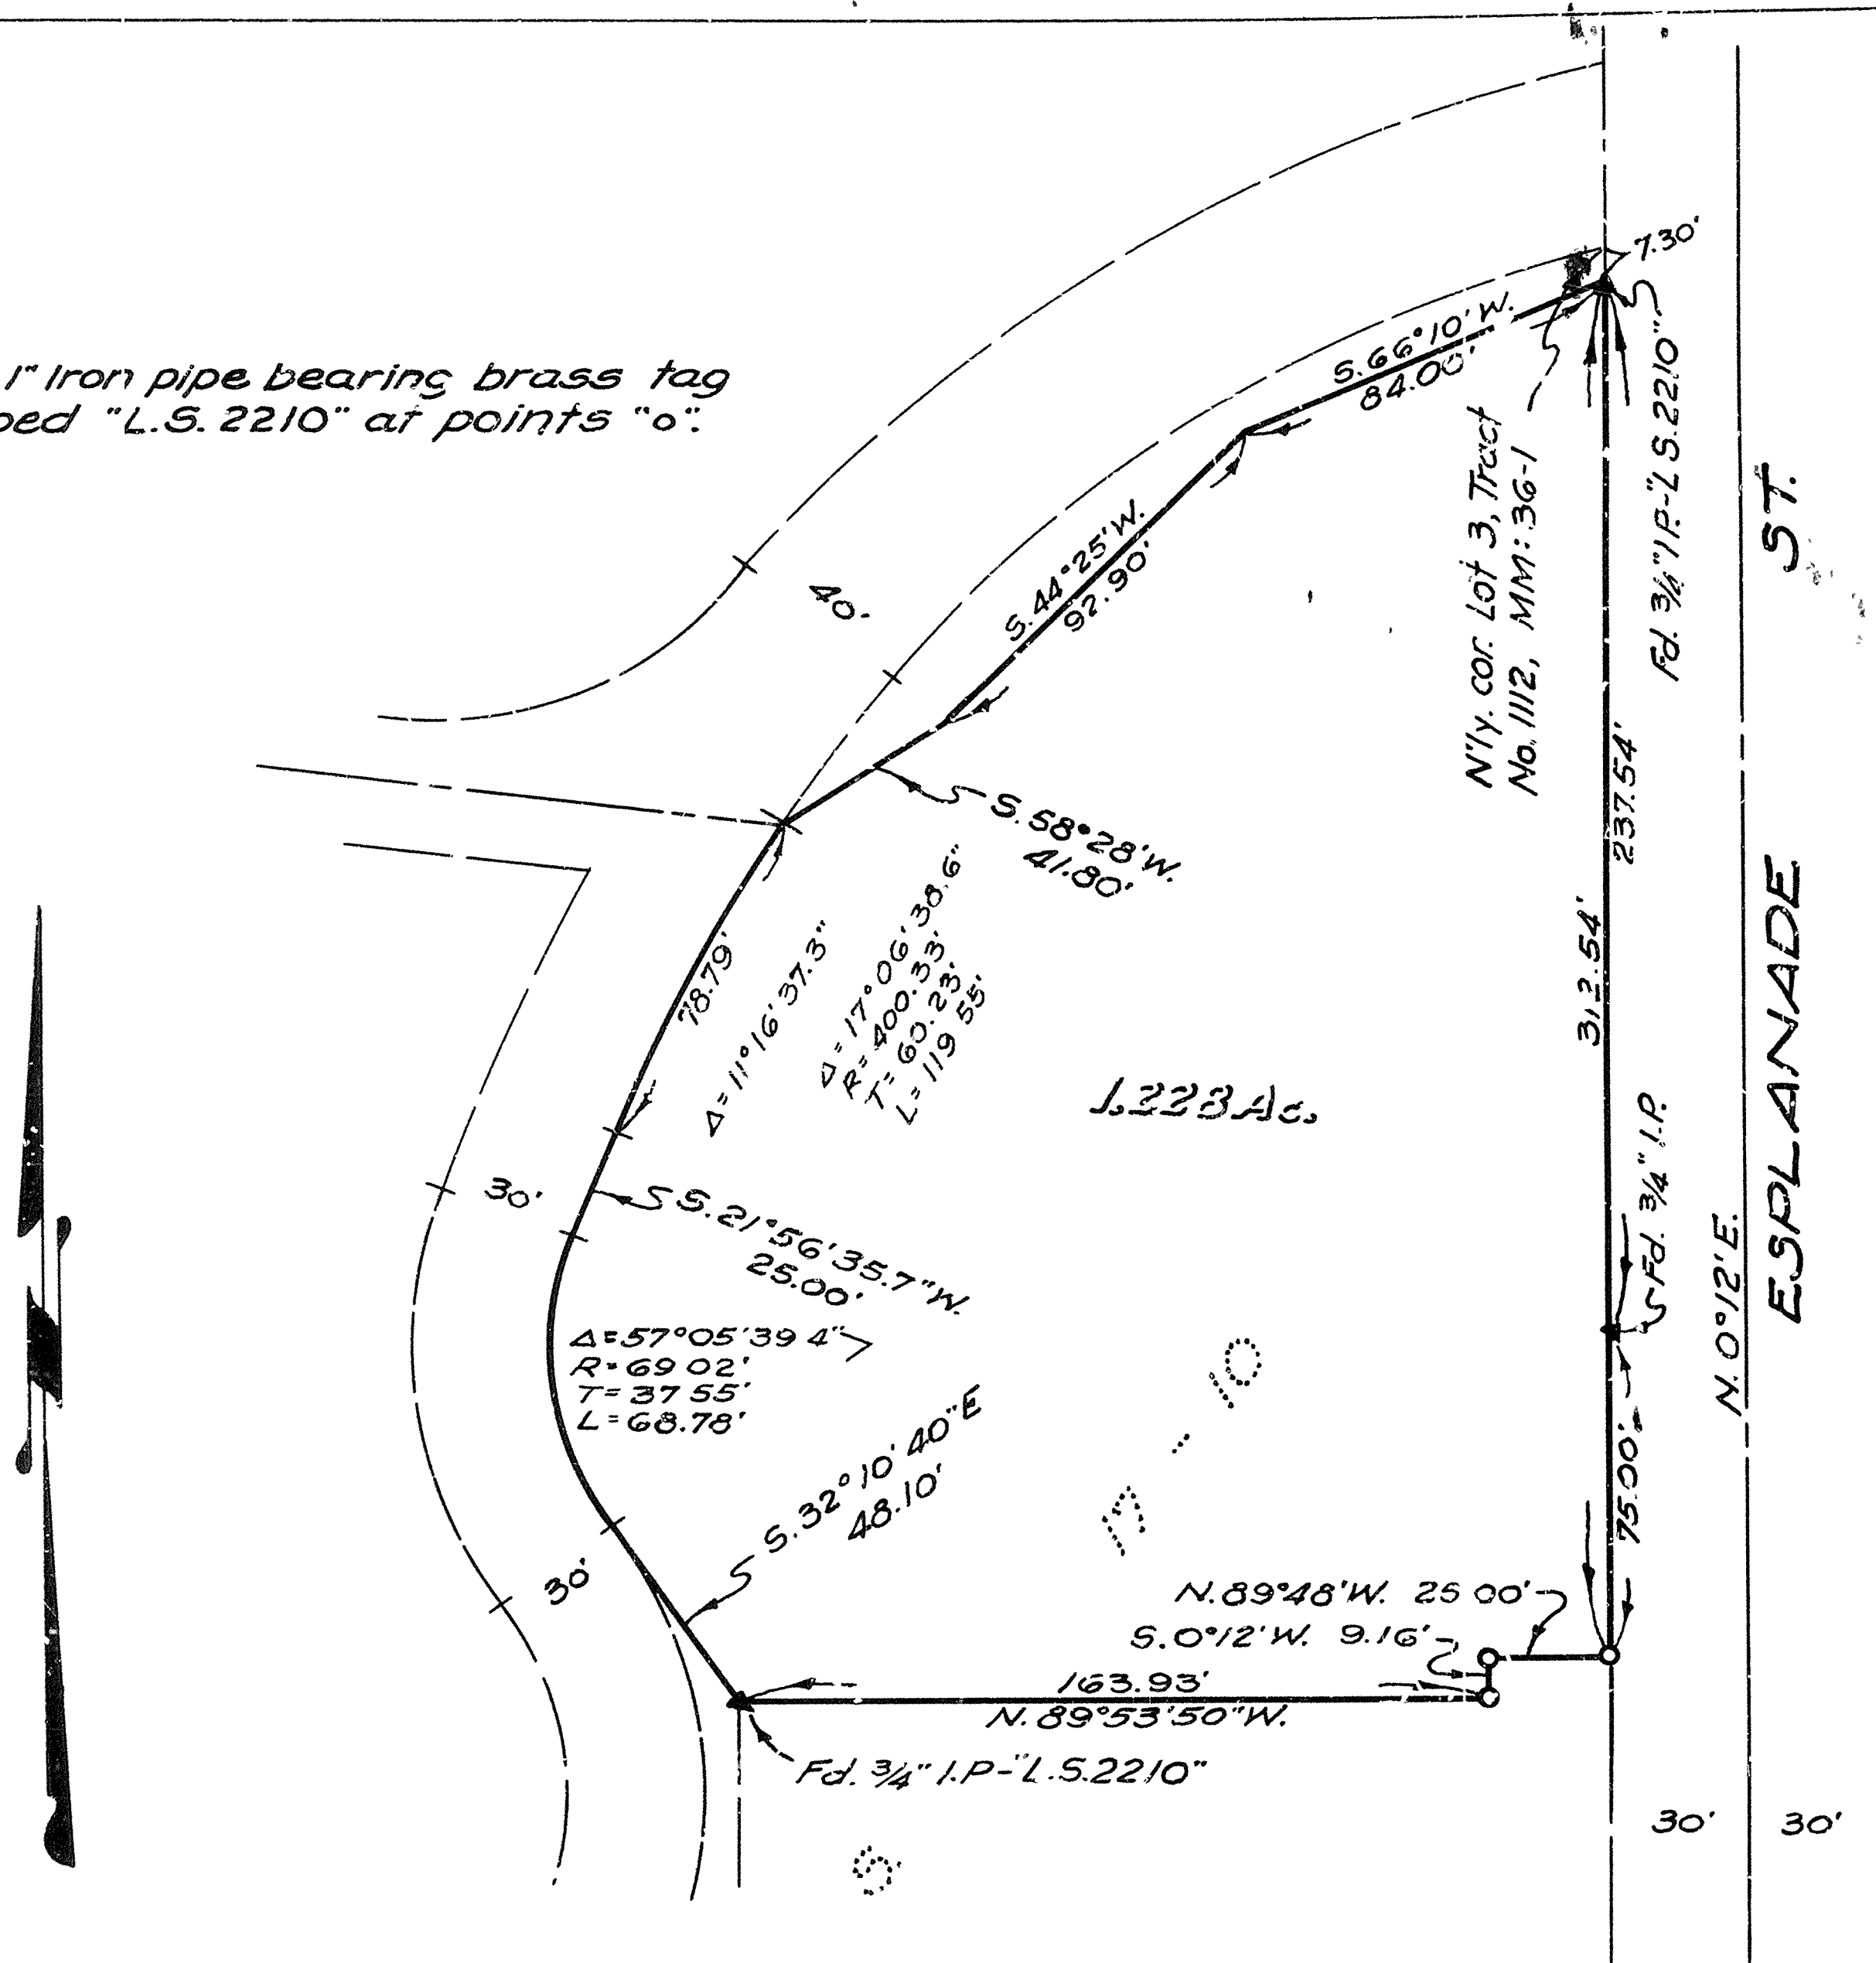

OWNER: D. M. W. Hollingsworth
DESCRIPTION: A portion of Lot 3, Tract No. 1112, MM: 36-1.
SCALE: 1" = 60'
DATE: July 13, 1954.
BASIS OF BEARINGS: Bearings are based on Esplanade Street "N. 0° 12' E." as per R.S. 17-10.


2485

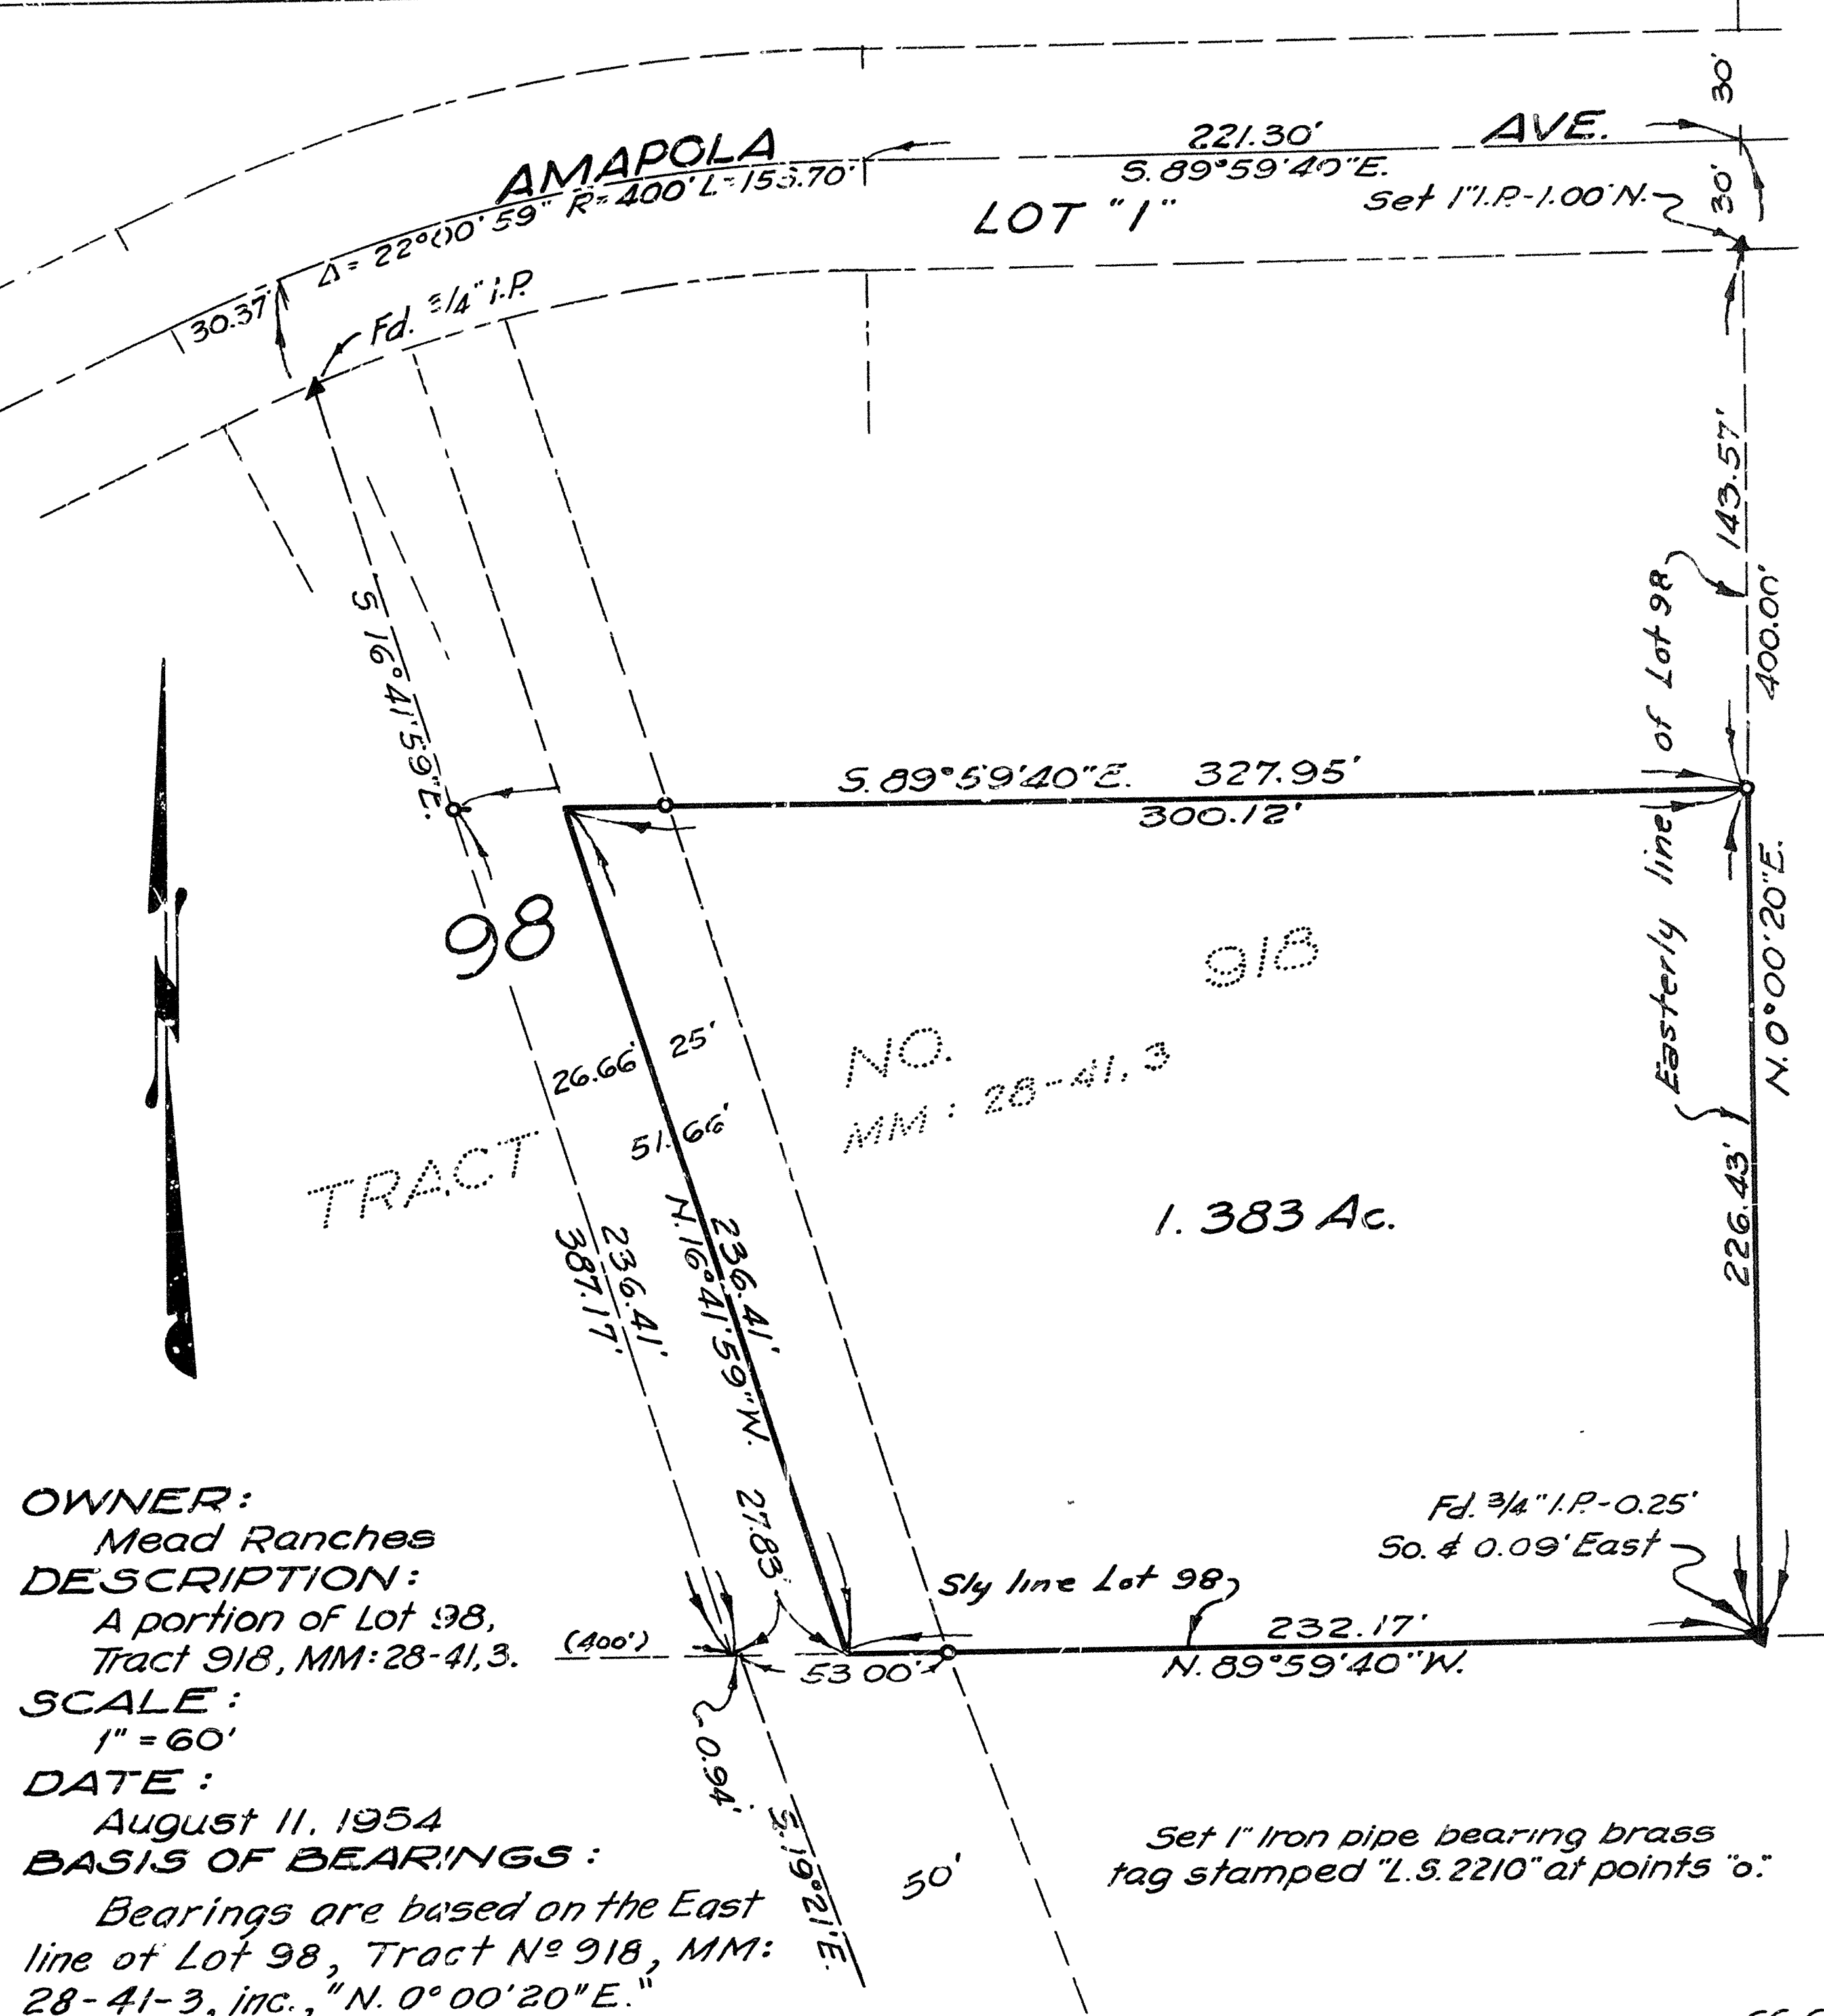

OWNER: Mead Ranches
DESCRIPTION: A portion of Lot 98, Tract 918, MM: 28-41, 3.
SCALE: 1" = 60'
DATE: August 11, 1954
BASIS OF BEARINGS: Bearings are based on the East line of Lot 98, Tract No. 918, MM: 28-41-3, inc., "N. 0° 00' 20" E."

Set 1" Iron pipe bearing brass tag stamped "L.S. 2210" at points "o".


66-69

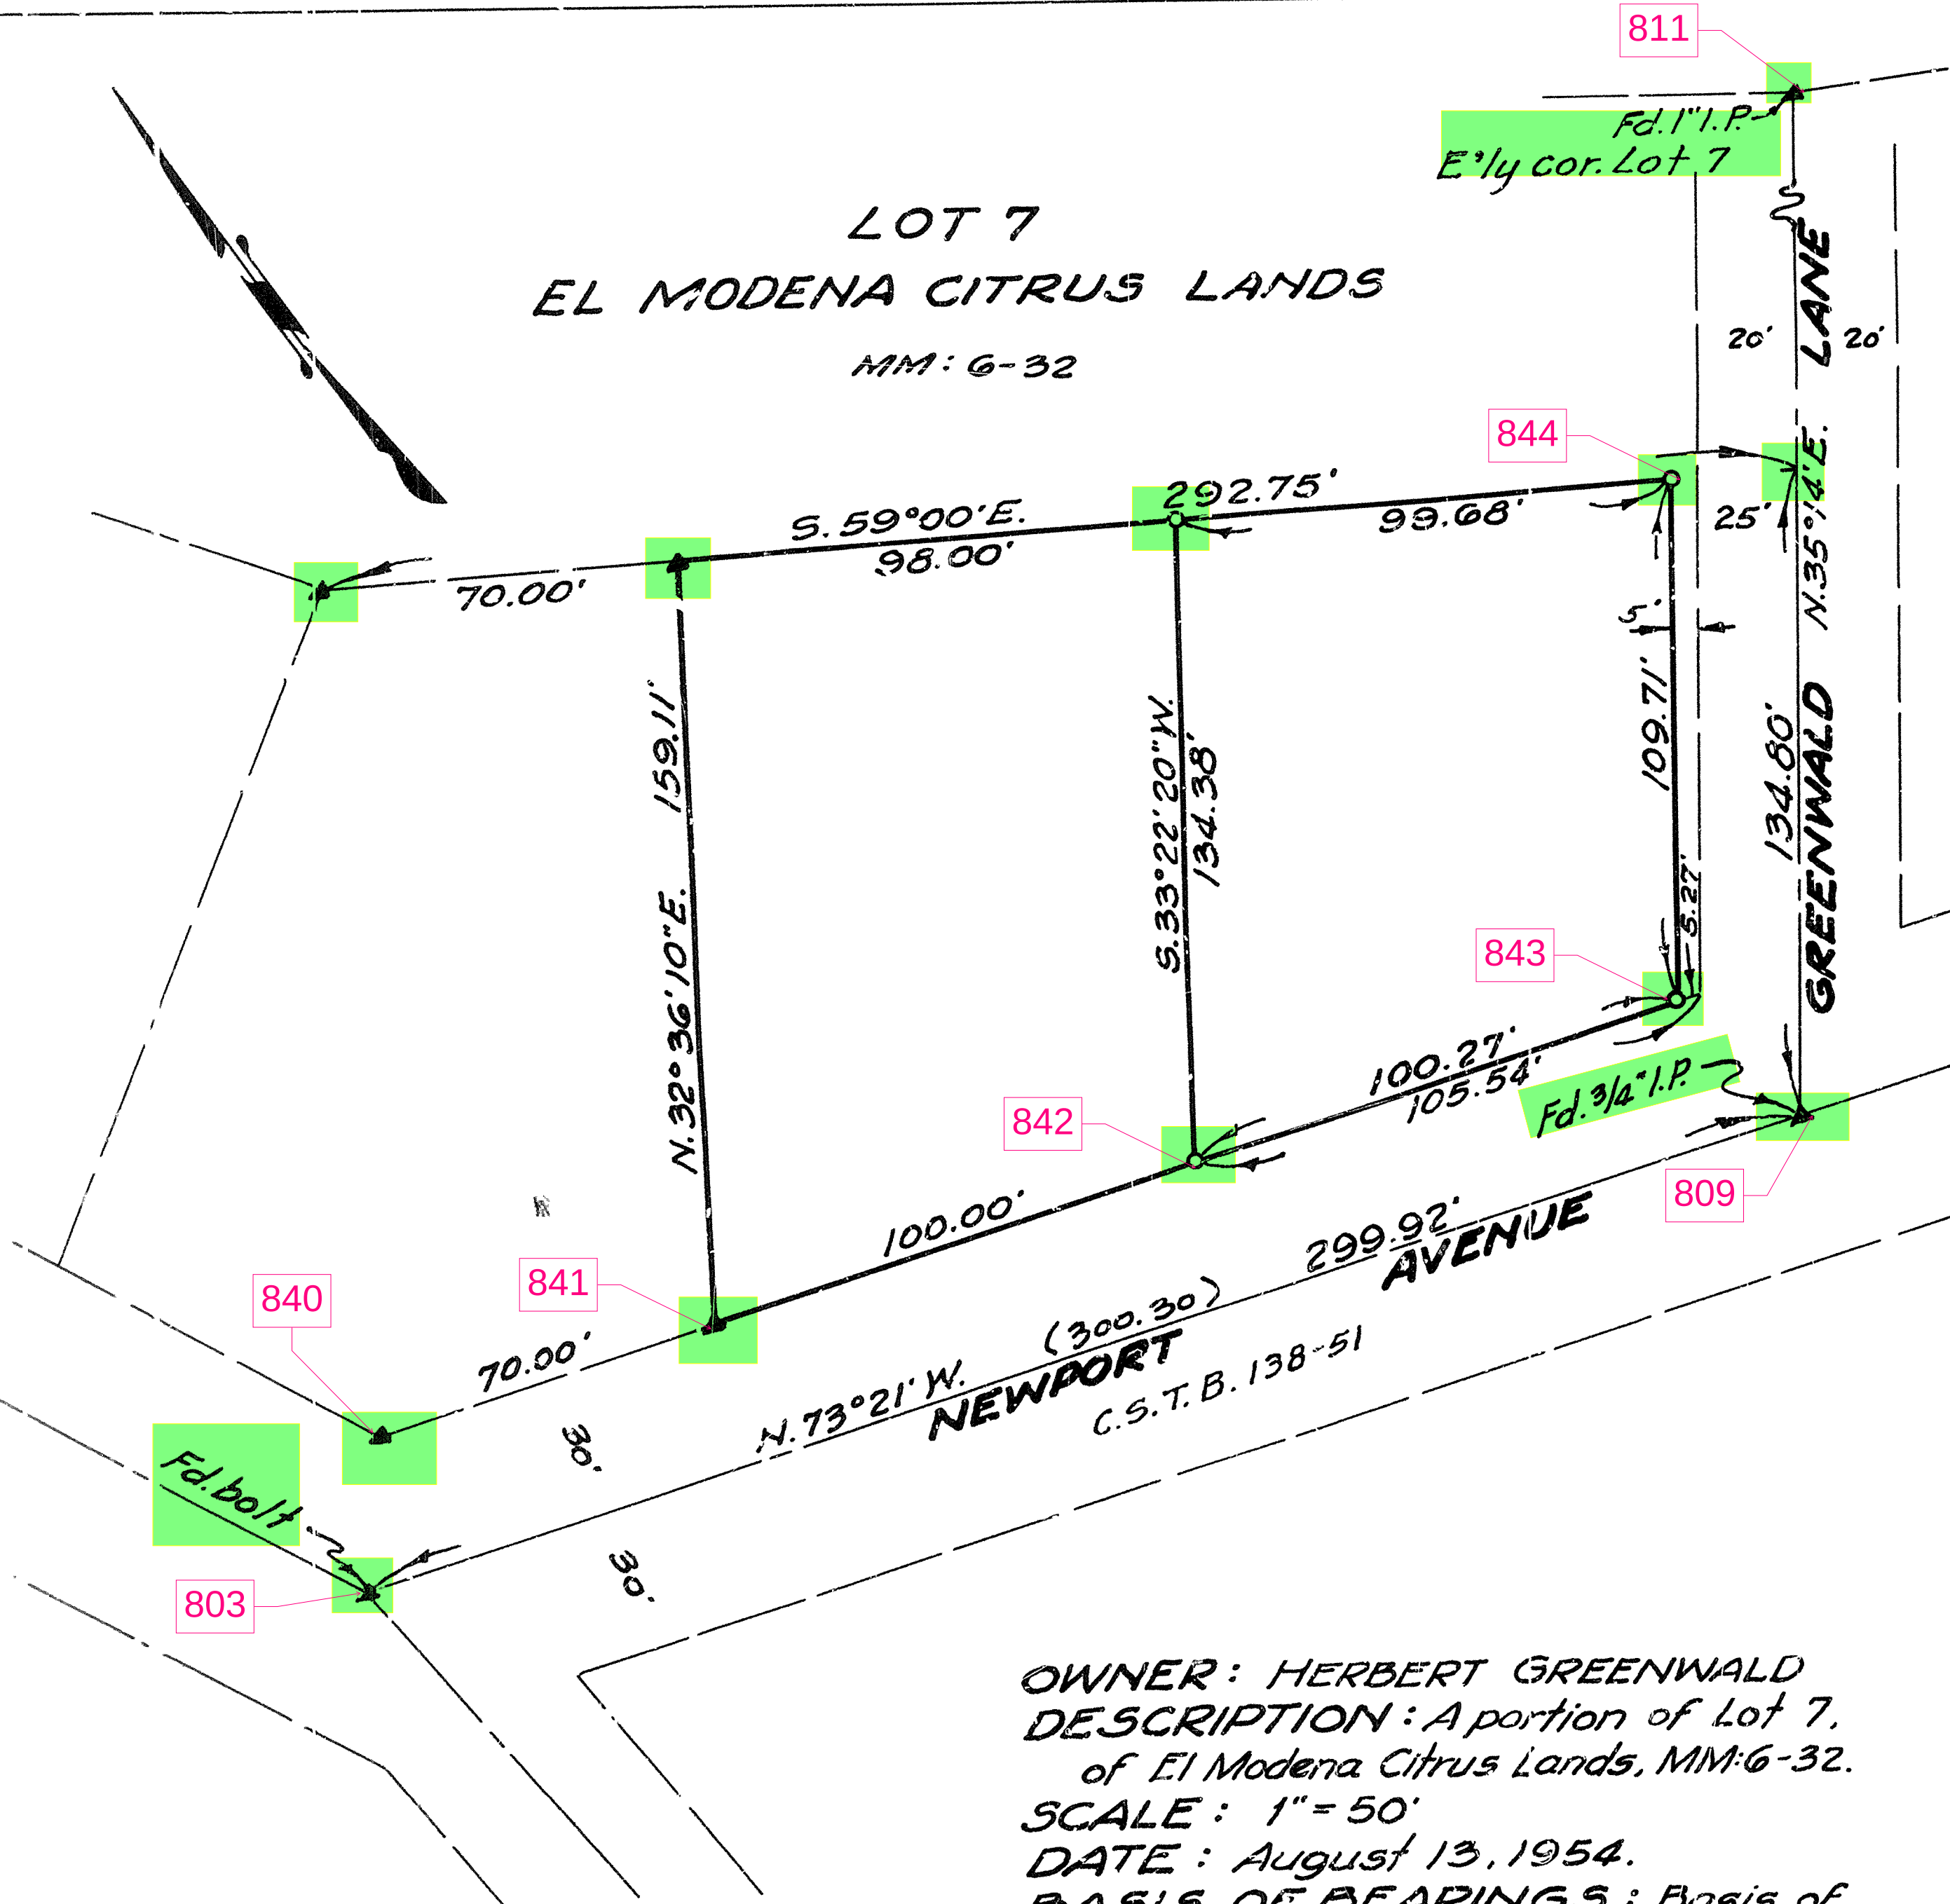

OWNER: HERBERT GREENWALD
DESCRIPTION: A portion of Lot 7, of El Modena Citrus Lands, MM: 6-32.
SCALE: 1" = 50'
DATE: August 13, 1954.
BASIS OF BEARINGS: Basis of bearings is Newport Ave. "N. 73° 21' W." as per El Modena Citrus Lands, MM: 6-32.

Set 1" Iron pipe bearing brass tag stamped "L.S. 2210" at points "o".
Fd. 1" Iron pipe - "L.S. 2210" at points "A".

67-32

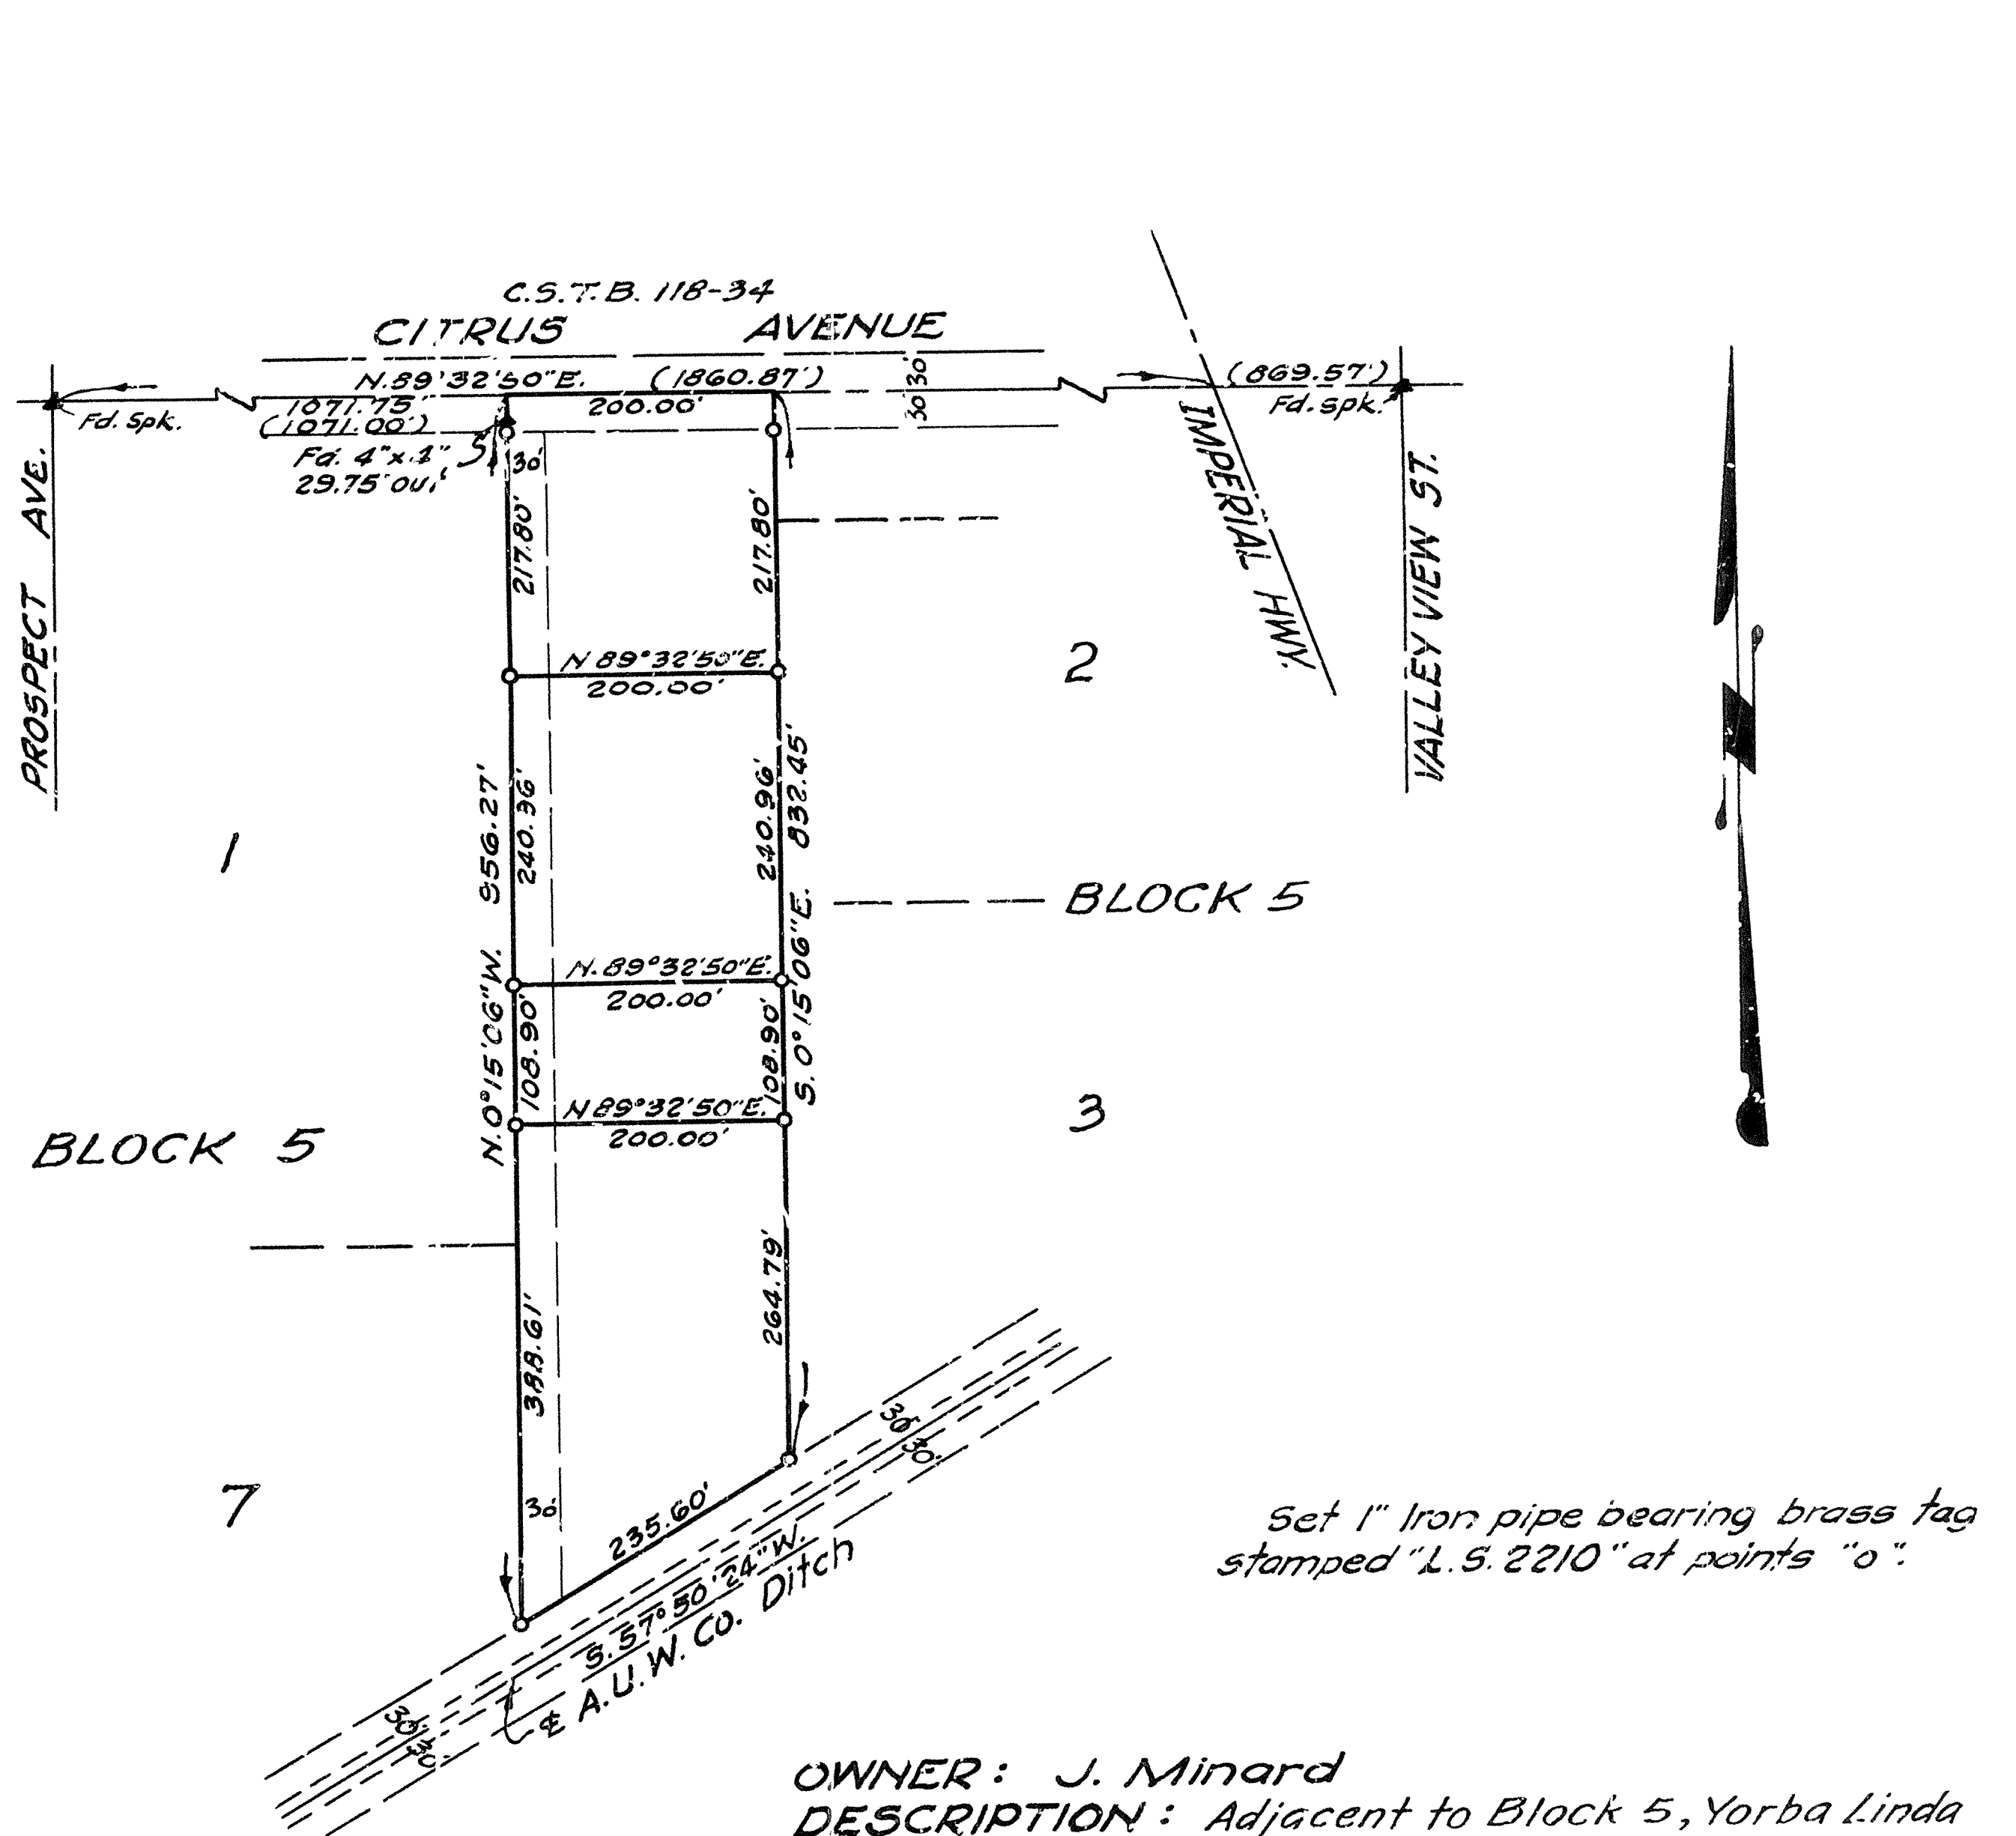

OWNER: J. Minard
DESCRIPTION: Adjacent to Block 5, Yorba Linda Tract, MM: 5-17 & 18.
SCALE: 1" = 200'
DATE: September 1954.
BASIS OF BEARINGS: Bearings are based on Citrus Ave. "N. 89° 32' 50" E." as per Janiss Re Survey.

Set 1" Iron pipe bearing brass tag stamped "L.S. 2210" at points "o".

67-35

I, D.D. Hilliard hereby certify that I am a Licensed Surveyor in the State of California, (No. 2210); that this map, consisting of one sheet represents surveys made under my supervision at the request of the owners; and that all monuments shown, actually existed at the time of the survey, and their position is correctly shown.

W.D. Hilliard
Licensed Surveyor

Examined and approved
this 18th day of Nov. 1954.

D. Southworth
Deputy County Surveyor

28-23