

RECORD OF SURVEY.

W.V. BRADY- RCE #96


All distances shown are measured.

AUGUST 1964

5449

OCT 8 1964

FILED FOR RECORD THIS DAY OF
AT 3:00 PM IN BOOK 76 PAGE 2
OF RECORDS OF SURVEYS COUNTY OF ORANGE
CALIFORNIA
COUNTY SURVEYOR
AT REQUEST OF J. WHITE CANTILE, County Recorder
\$5.00

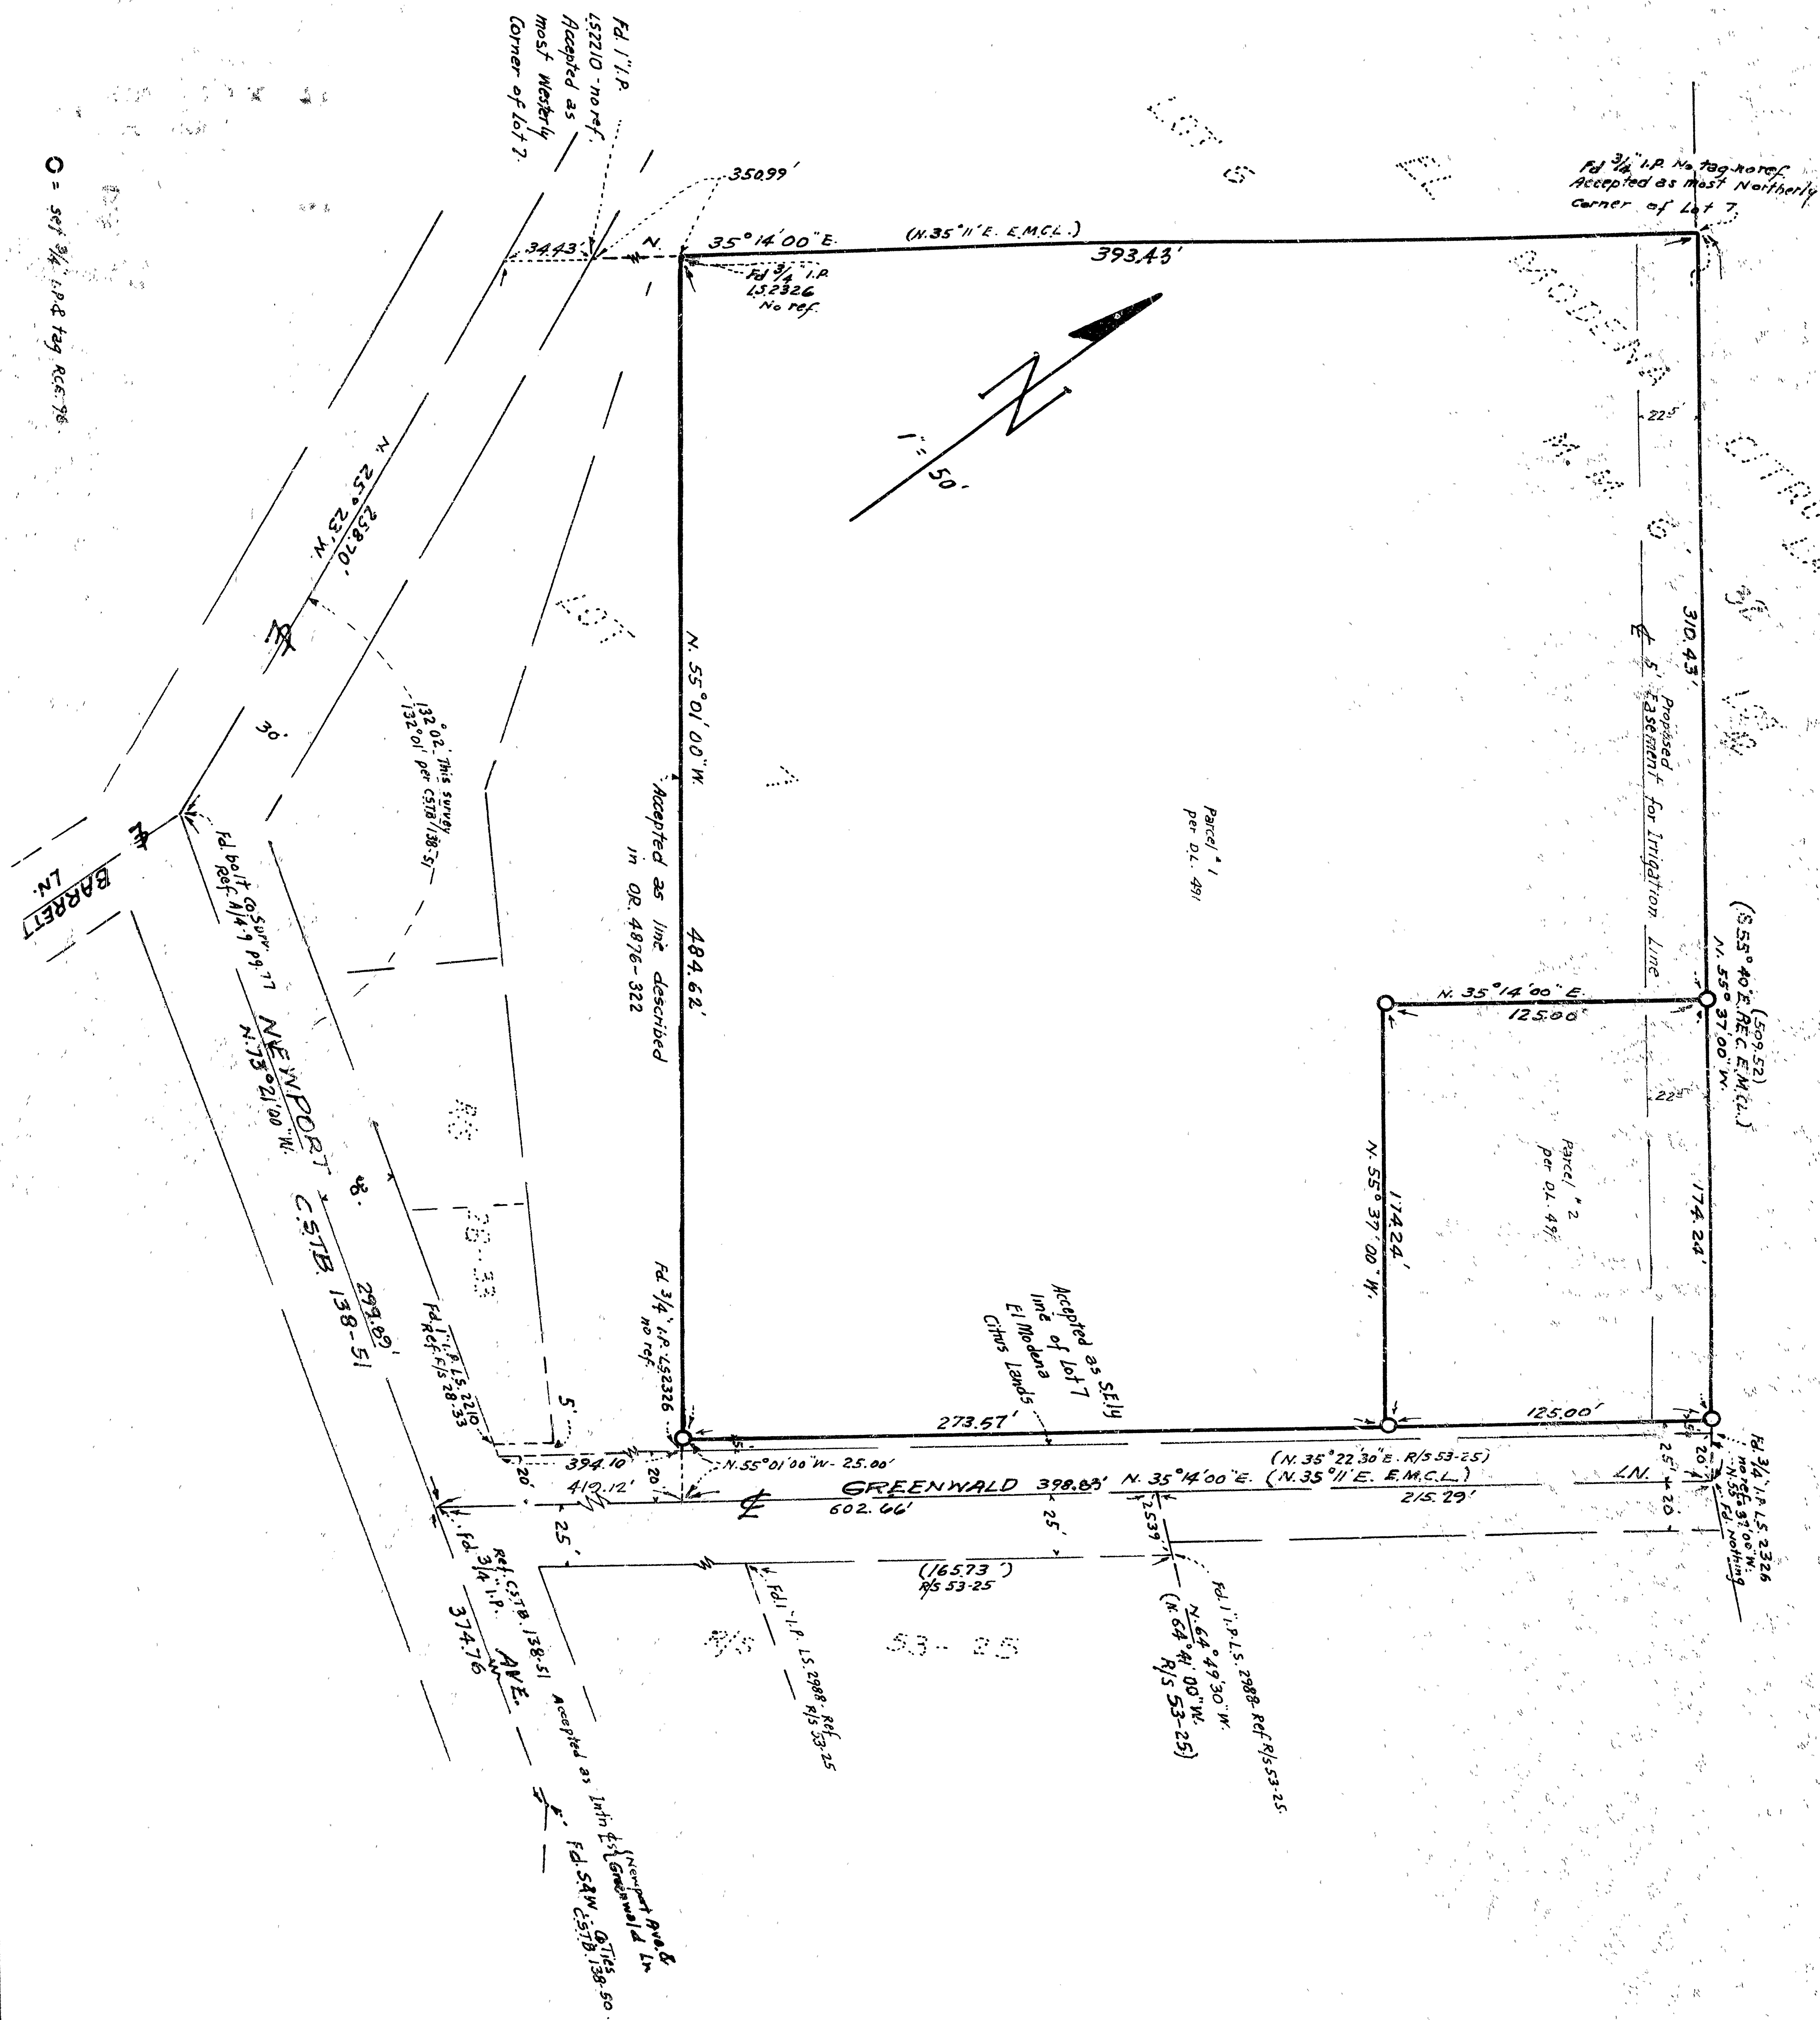

This map correctly represents a survey made by me in conformance with the requirements of the Land Surveyors Act at the request of the owner in June & August 1964.

W.V. Brady
RCE # 96.

This map has been examined for conformance with the requirements of the Land Surveyors Act this 6th day of Oct. 1964

Robert W. White
Deputy Orange County Surveyor

IN UNINCORPORATED TERRITORY,
ORANGE COUNTY,
CALIFORNIA.

DESCRIPTION: Portion of Lot 7, El Modena Citrus Lands
SCALE: 1"=50'
OWNER: L.E. ROGERS
DATE OF SURVEY: June 29 & August 24, 1964.
BASIS OF BEARINGS: \$ Newport Ave (N.73°21'00"W)
as per R/S 28-33

O = set 3/4" I.P. & tag RCE-96.