

RECORD OF SURVEY

4705

BEING A PORTION OF LOT 8 EL MODENA CITRUS
LANDS M.M. 6-32, RECORDS OF ORANGE COUNTY, CALIFORNIA
IN UNINCORPORATED TERRITORY.

FILED FOR RECORD this JUN 7 1961
at 9:07 A.M. in Book 53/25
of Record of Surveys, at Page
at request of COUNTY SURVEYOR
RUBY McFARLAND, County Recorder


\$5.00

This map correctly represents a survey made under my
direction in conformance with the requirements of Chapter
15 of Division 3 of the Business and Professions Code at
the request of W.C. Bryant in May, 1961.

C. J. Queyrel
C. J. QUEYREL L.S. 2988

This map has been examined for conformance with the
requirements of Chapter 15 Division 3 of the Business
and Professions Code this 5th Day of
June 1961.

C. R. Estabrook
DEPUTY COUNTY SURVEYOR

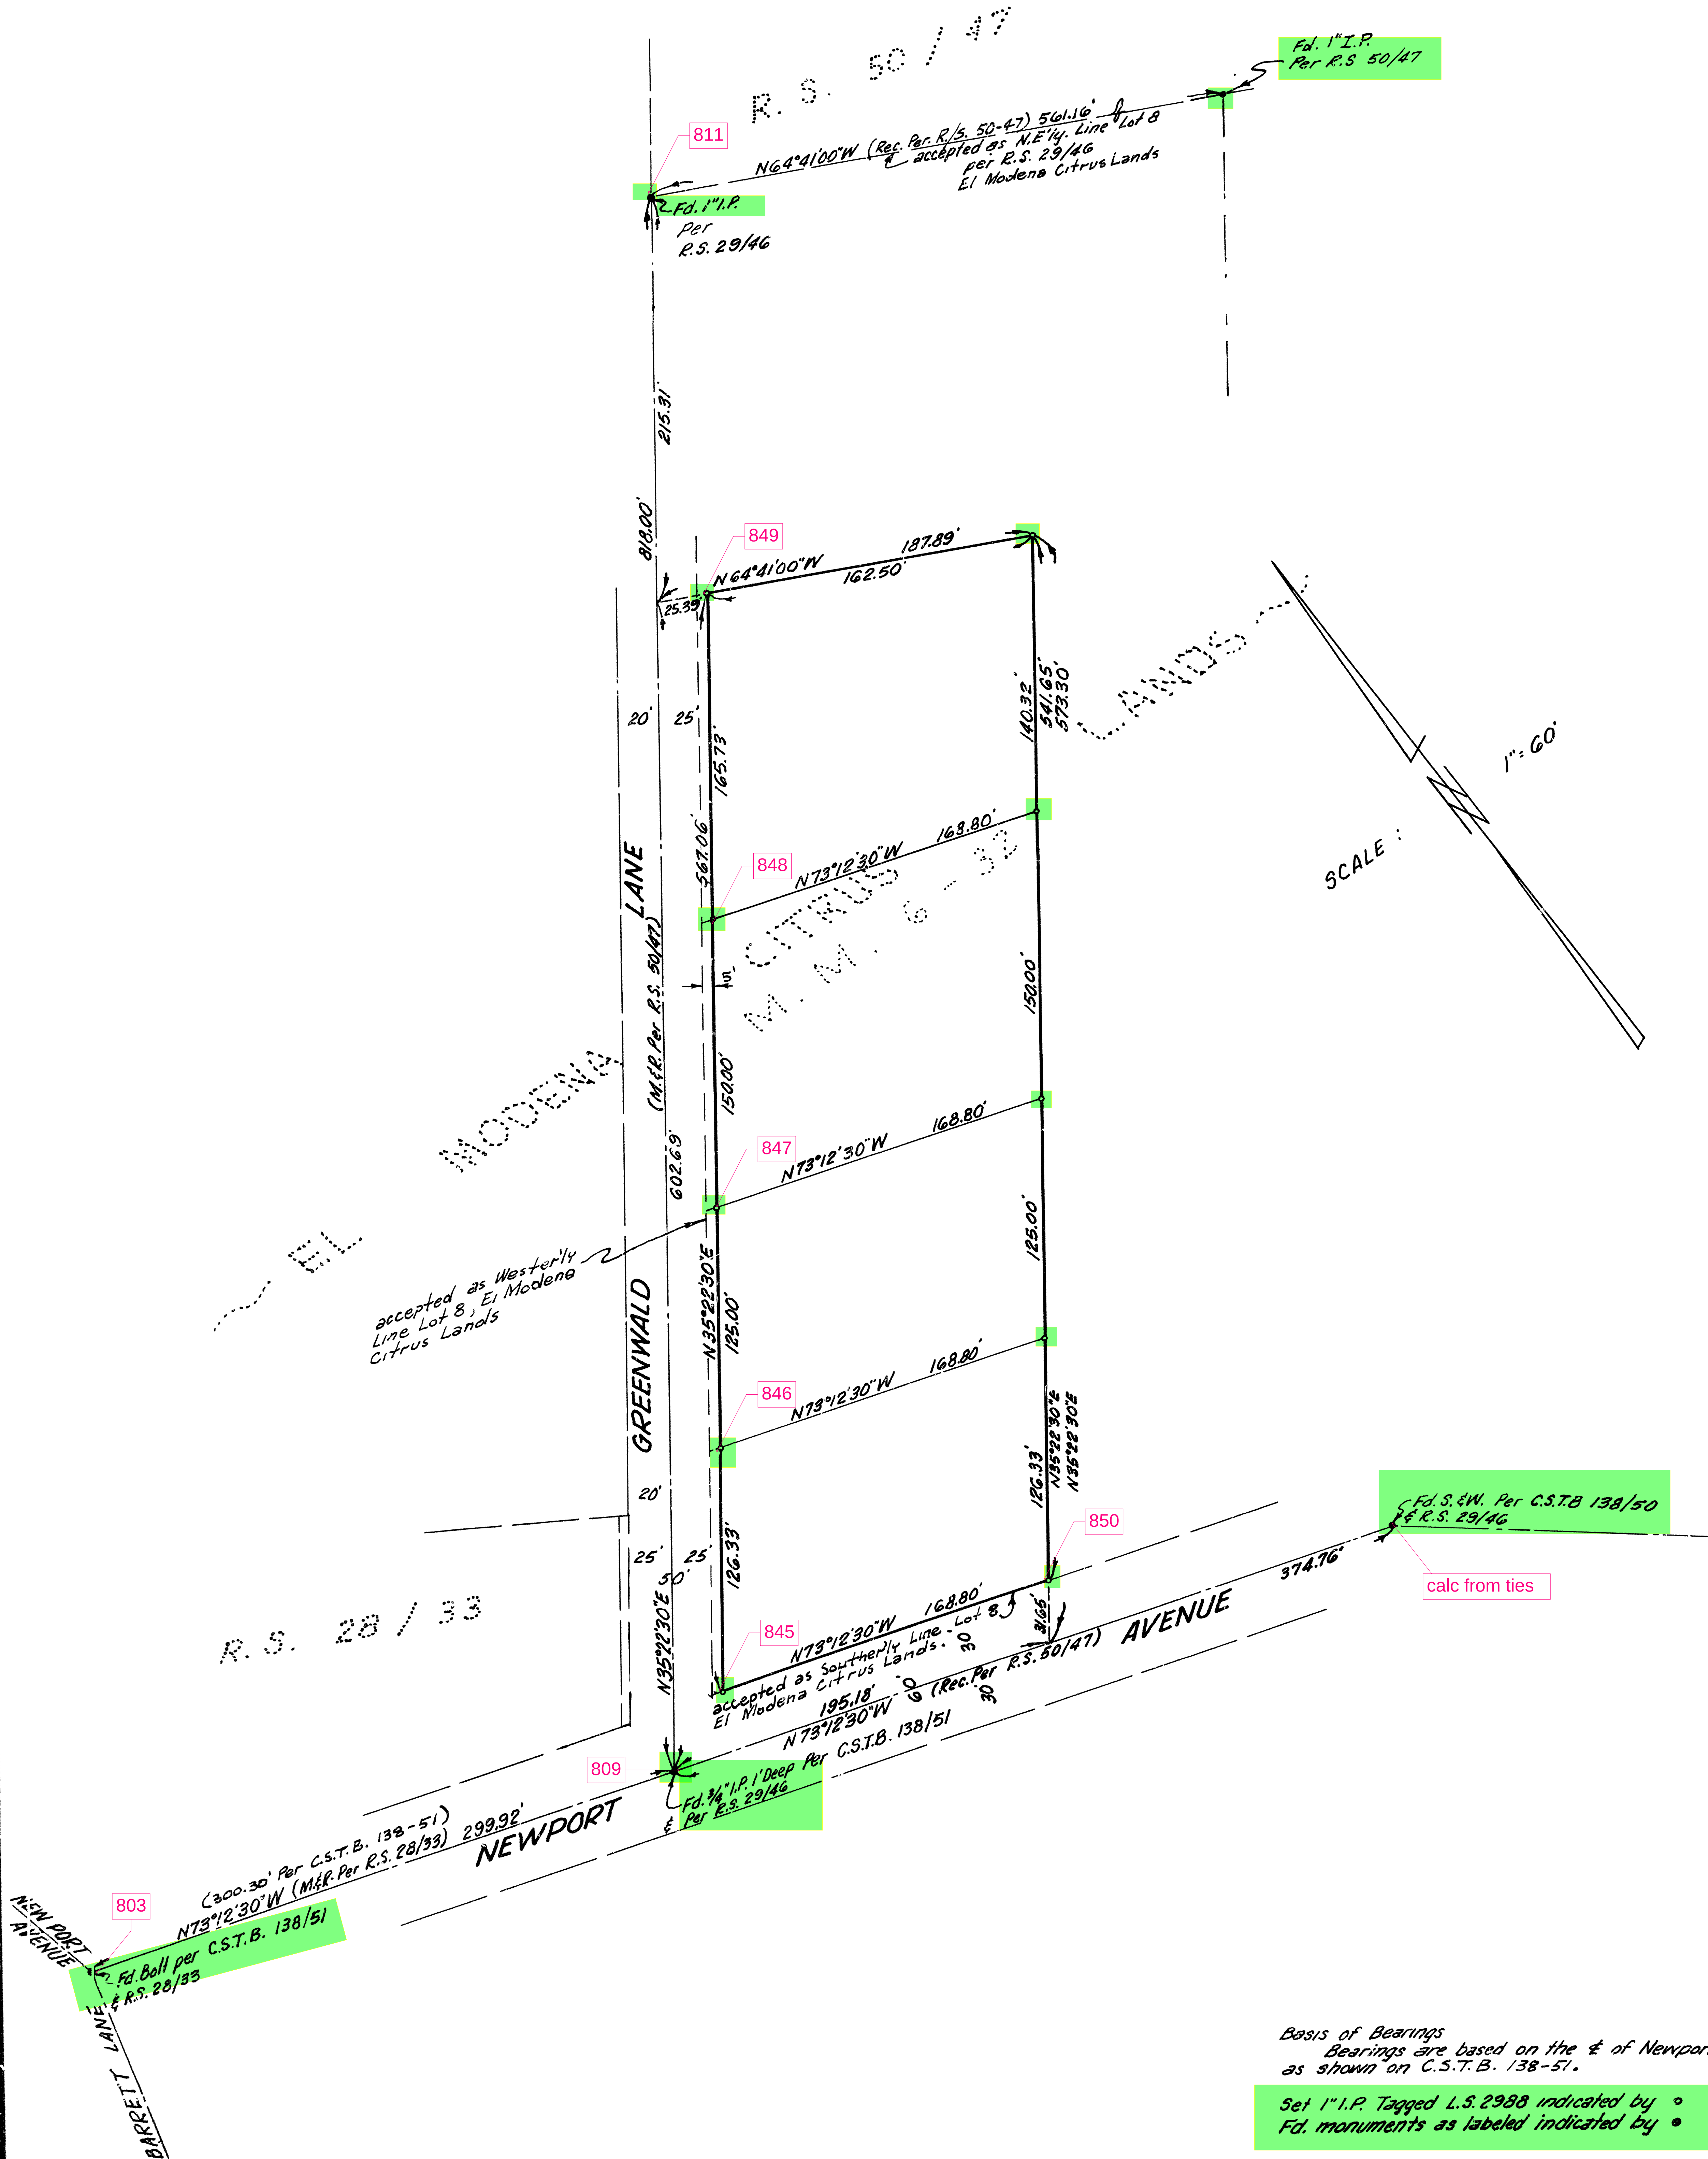

Basis of Bearings
Bearings are based on the E of Newport Avenue (N73°12'30\"/>

Set 1\"/>