

This map has been examined for conformance with the requirements of Chapter 15, Division 3 of the Business and Professions Code this 1st day of June, 1961.

G.R. Estabrook
Deputy County Surveyor
Orange County, California


RECORD OF SURVEY ORANGE COUNTY, CALIFORNIA

This map correctly represents a survey made under my direction in conformance with the requirements of Chapter 15, Division 3 of the Business and Professions Code at the request of the owners named below.

D.D. Hilliard
D.D. HILLIARD L.S. 2210

RST 1142

RST 1141

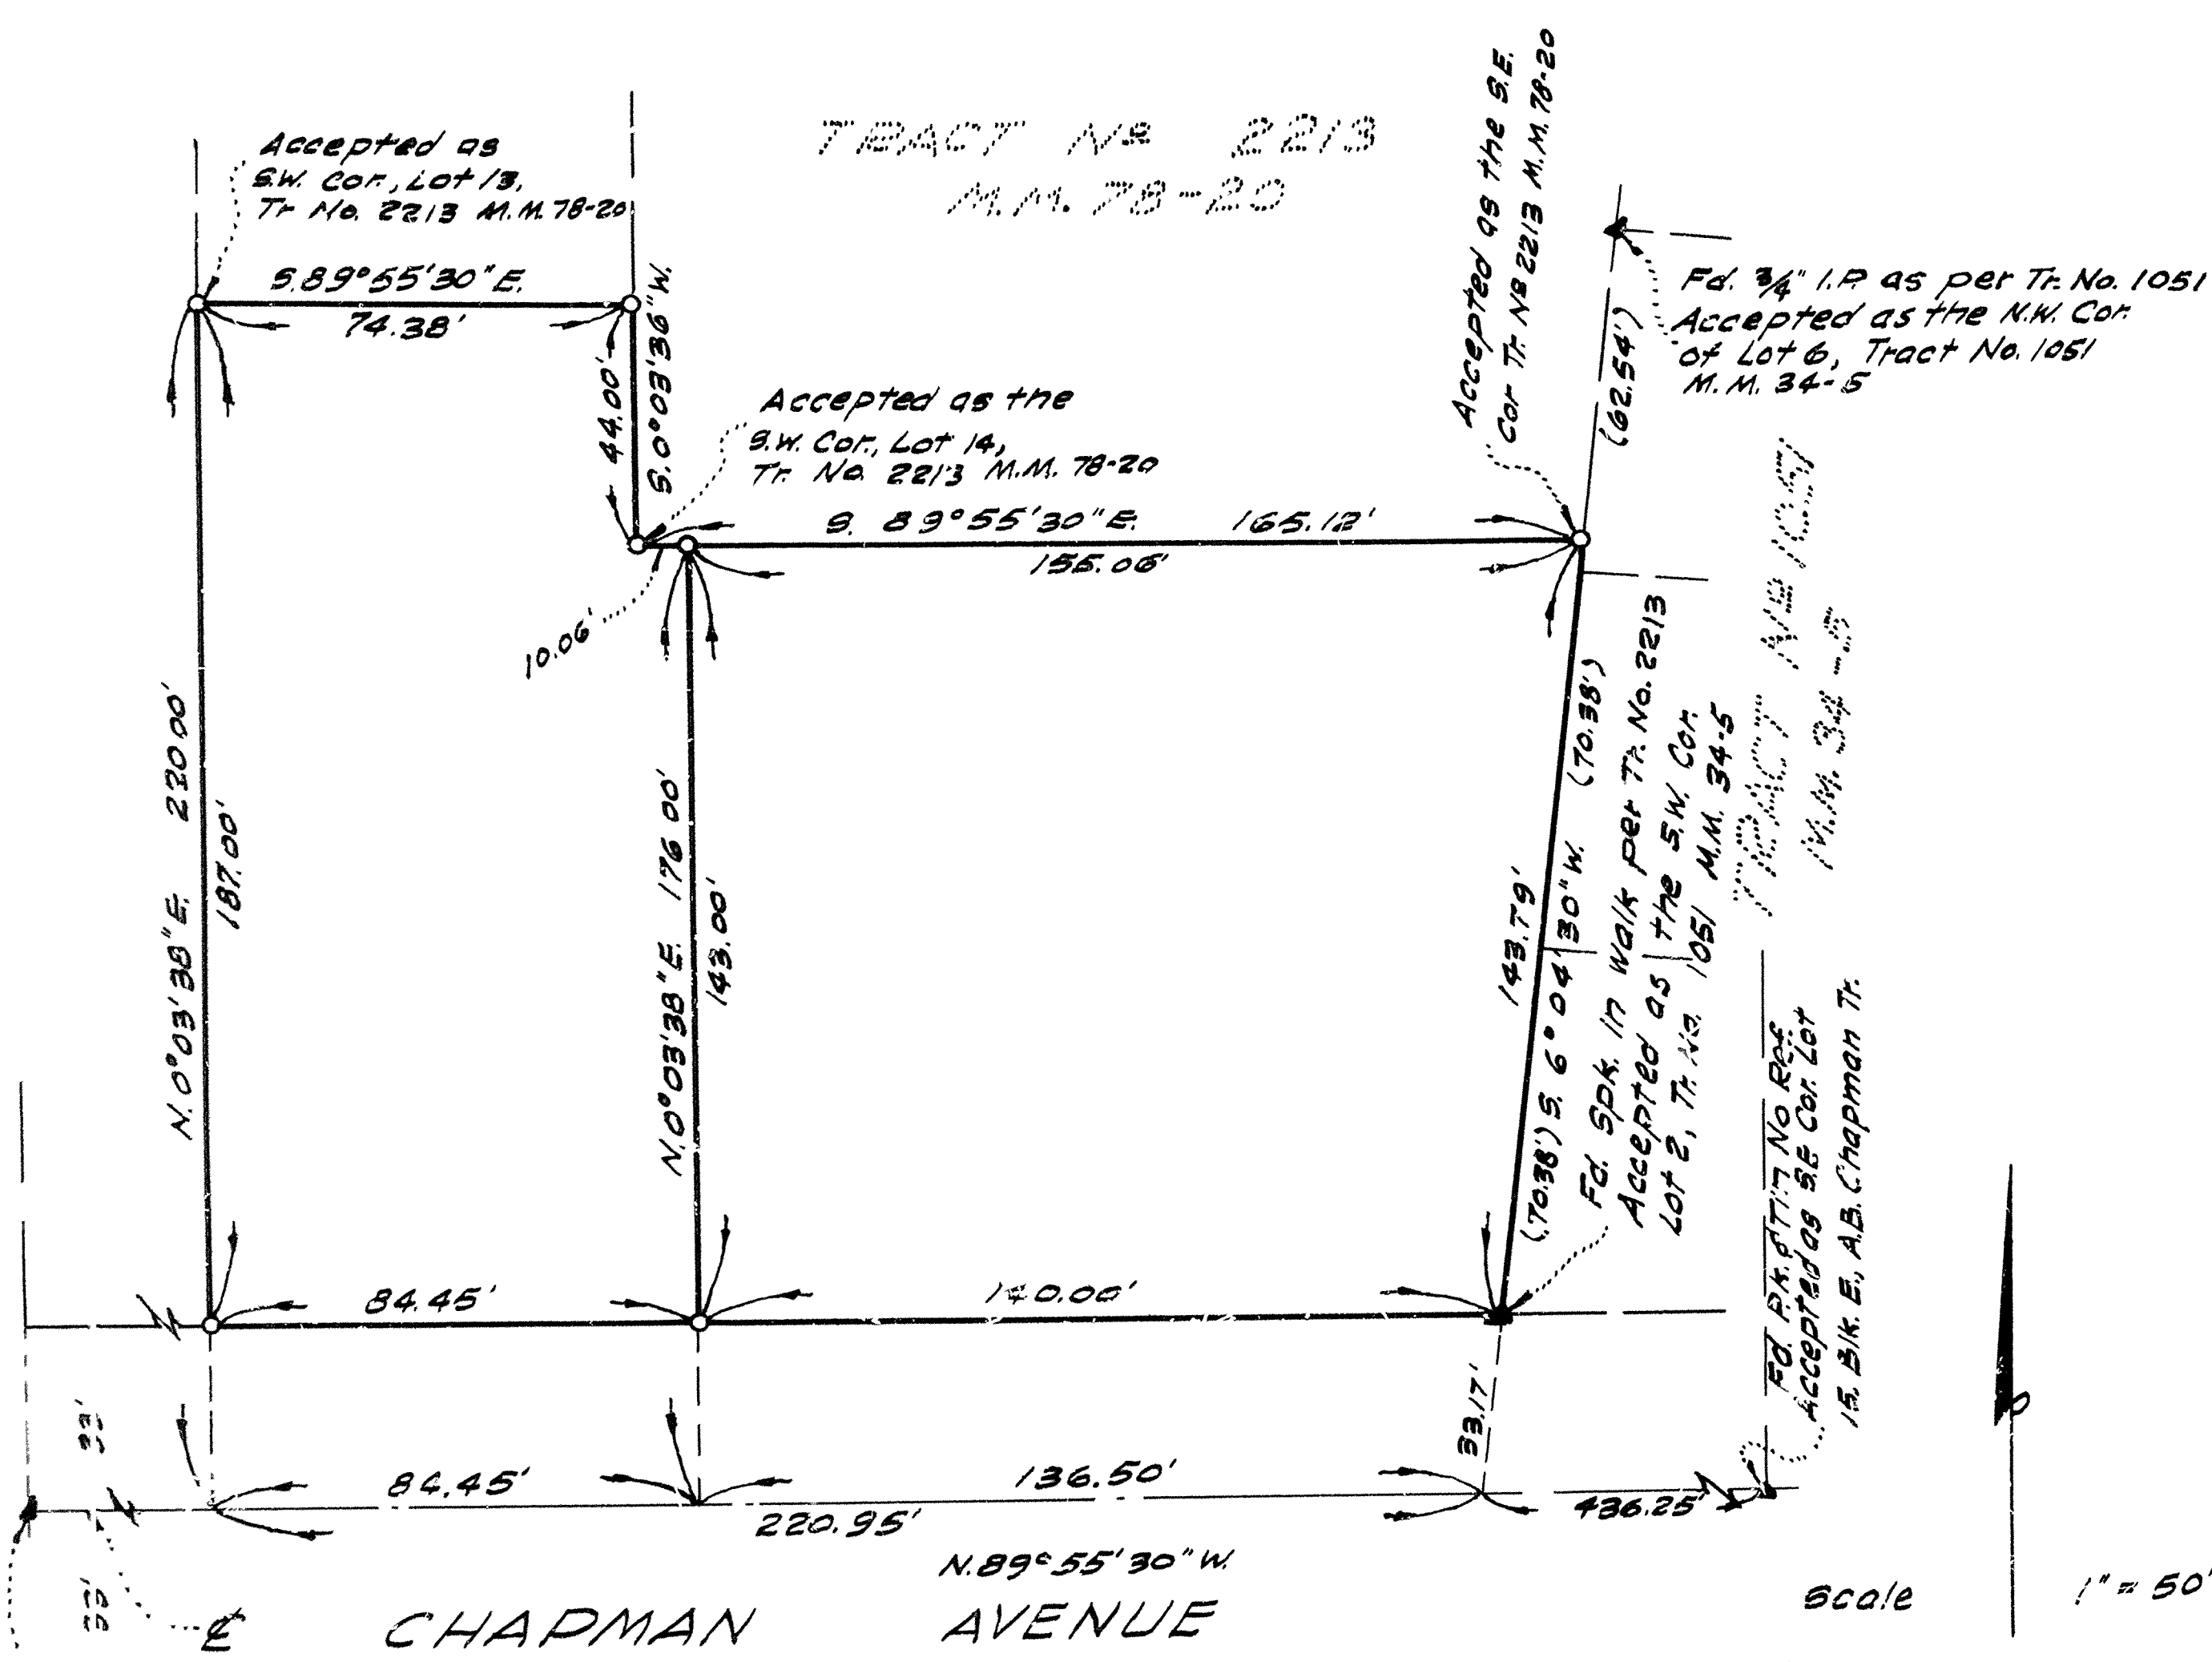

OWNER: A.W. DOWDEN

DESCRIPTION: In the City of Orange, a portion of Lot 15, Block E of the A.B. Chapman Tract


BASIS OF BEARINGS: Bearings are based on the W. line of Tract No. 1051, M.M. 34-5, being S 6° 04' 30" W, Rec. of Ora. Co., Calif.

NOTE: Set 1" Iron Pipe bearing tag stamped "L52210" at points shown "o".

Surveyed in February 1961

INDEXED
3147 JUN 5 1961
FILED FOR RECORD this day of
19 of 1961 P M in Book 53422
of Record of Surveys, at the
request of COUNTY SURVEYOR
RUBY McFARLAND, County Recorder

\$5.00

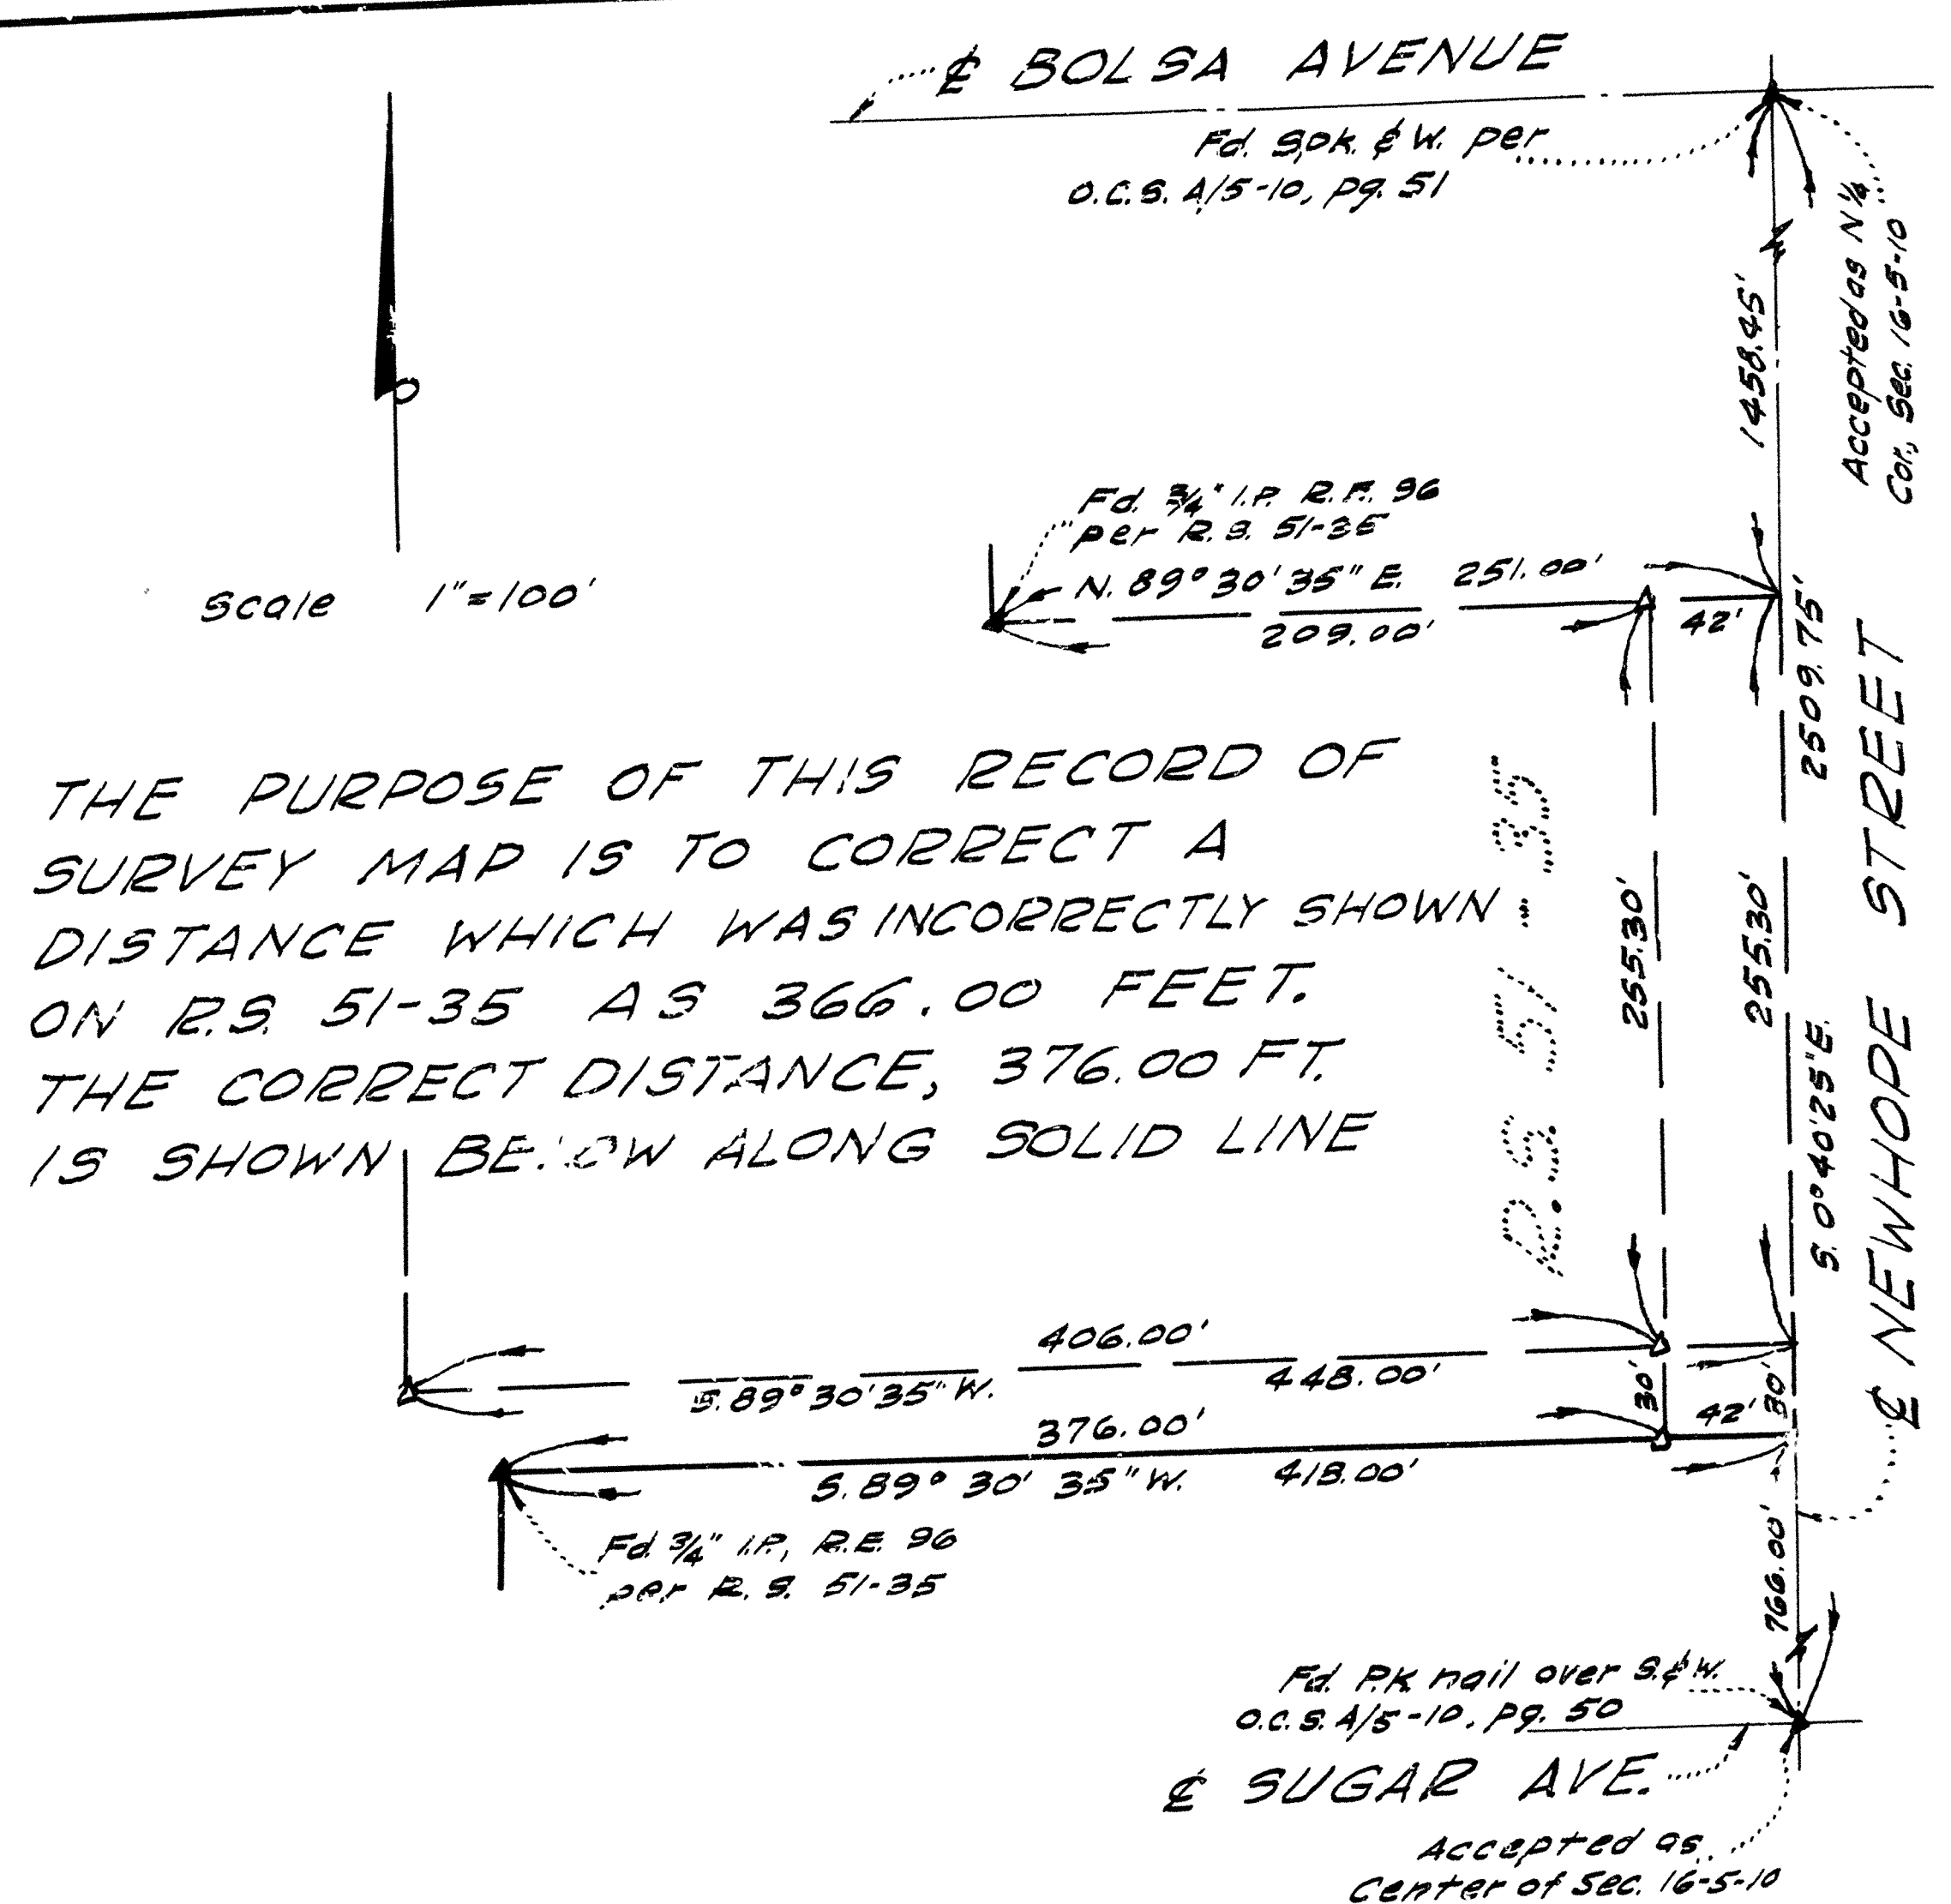

THE PURPOSE OF THIS RECORD OF SURVEY MAP IS TO CORRECT A DISTANCE WHICH WAS INCORRECTLY SHOWN ON R.S. 51-35 AS 366.00 FEET. THE CORRECT DISTANCE, 376.00 FT. IS SHOWN BELOW ALONG SOLID LINE

OWNERS: BOARD OF CHURCH EXTENSION AND HOME MISSIONS OF THE CHURCH OF GOD, CAL-COMPACT FOODS INC., IRENE C. TURNER

DESCRIPTION: A survey of a portion of the Northwest quarter of Section 16, Township 5 South, Range 10 West, per map recorded in Book 51, Page 12 of Miscellaneous Maps, Records of Orange County, California, in the Rancho Las Balsas. In the City of Santa Ana, Orange County, California.


BASIS OF BEARINGS: Bearings hereon are based on the E. of Newhope Street, being S 0° 40' 25" E, as per Tract No. 2905, M.M. 128-45, 46; Records of Orange County, California.

NOTE: Set 1" Iron Pipe bearing tag stamped "L52210" at points shown thus "a" per R.S. 51-35

Surveyed in November 1960

85-47

RST 1144

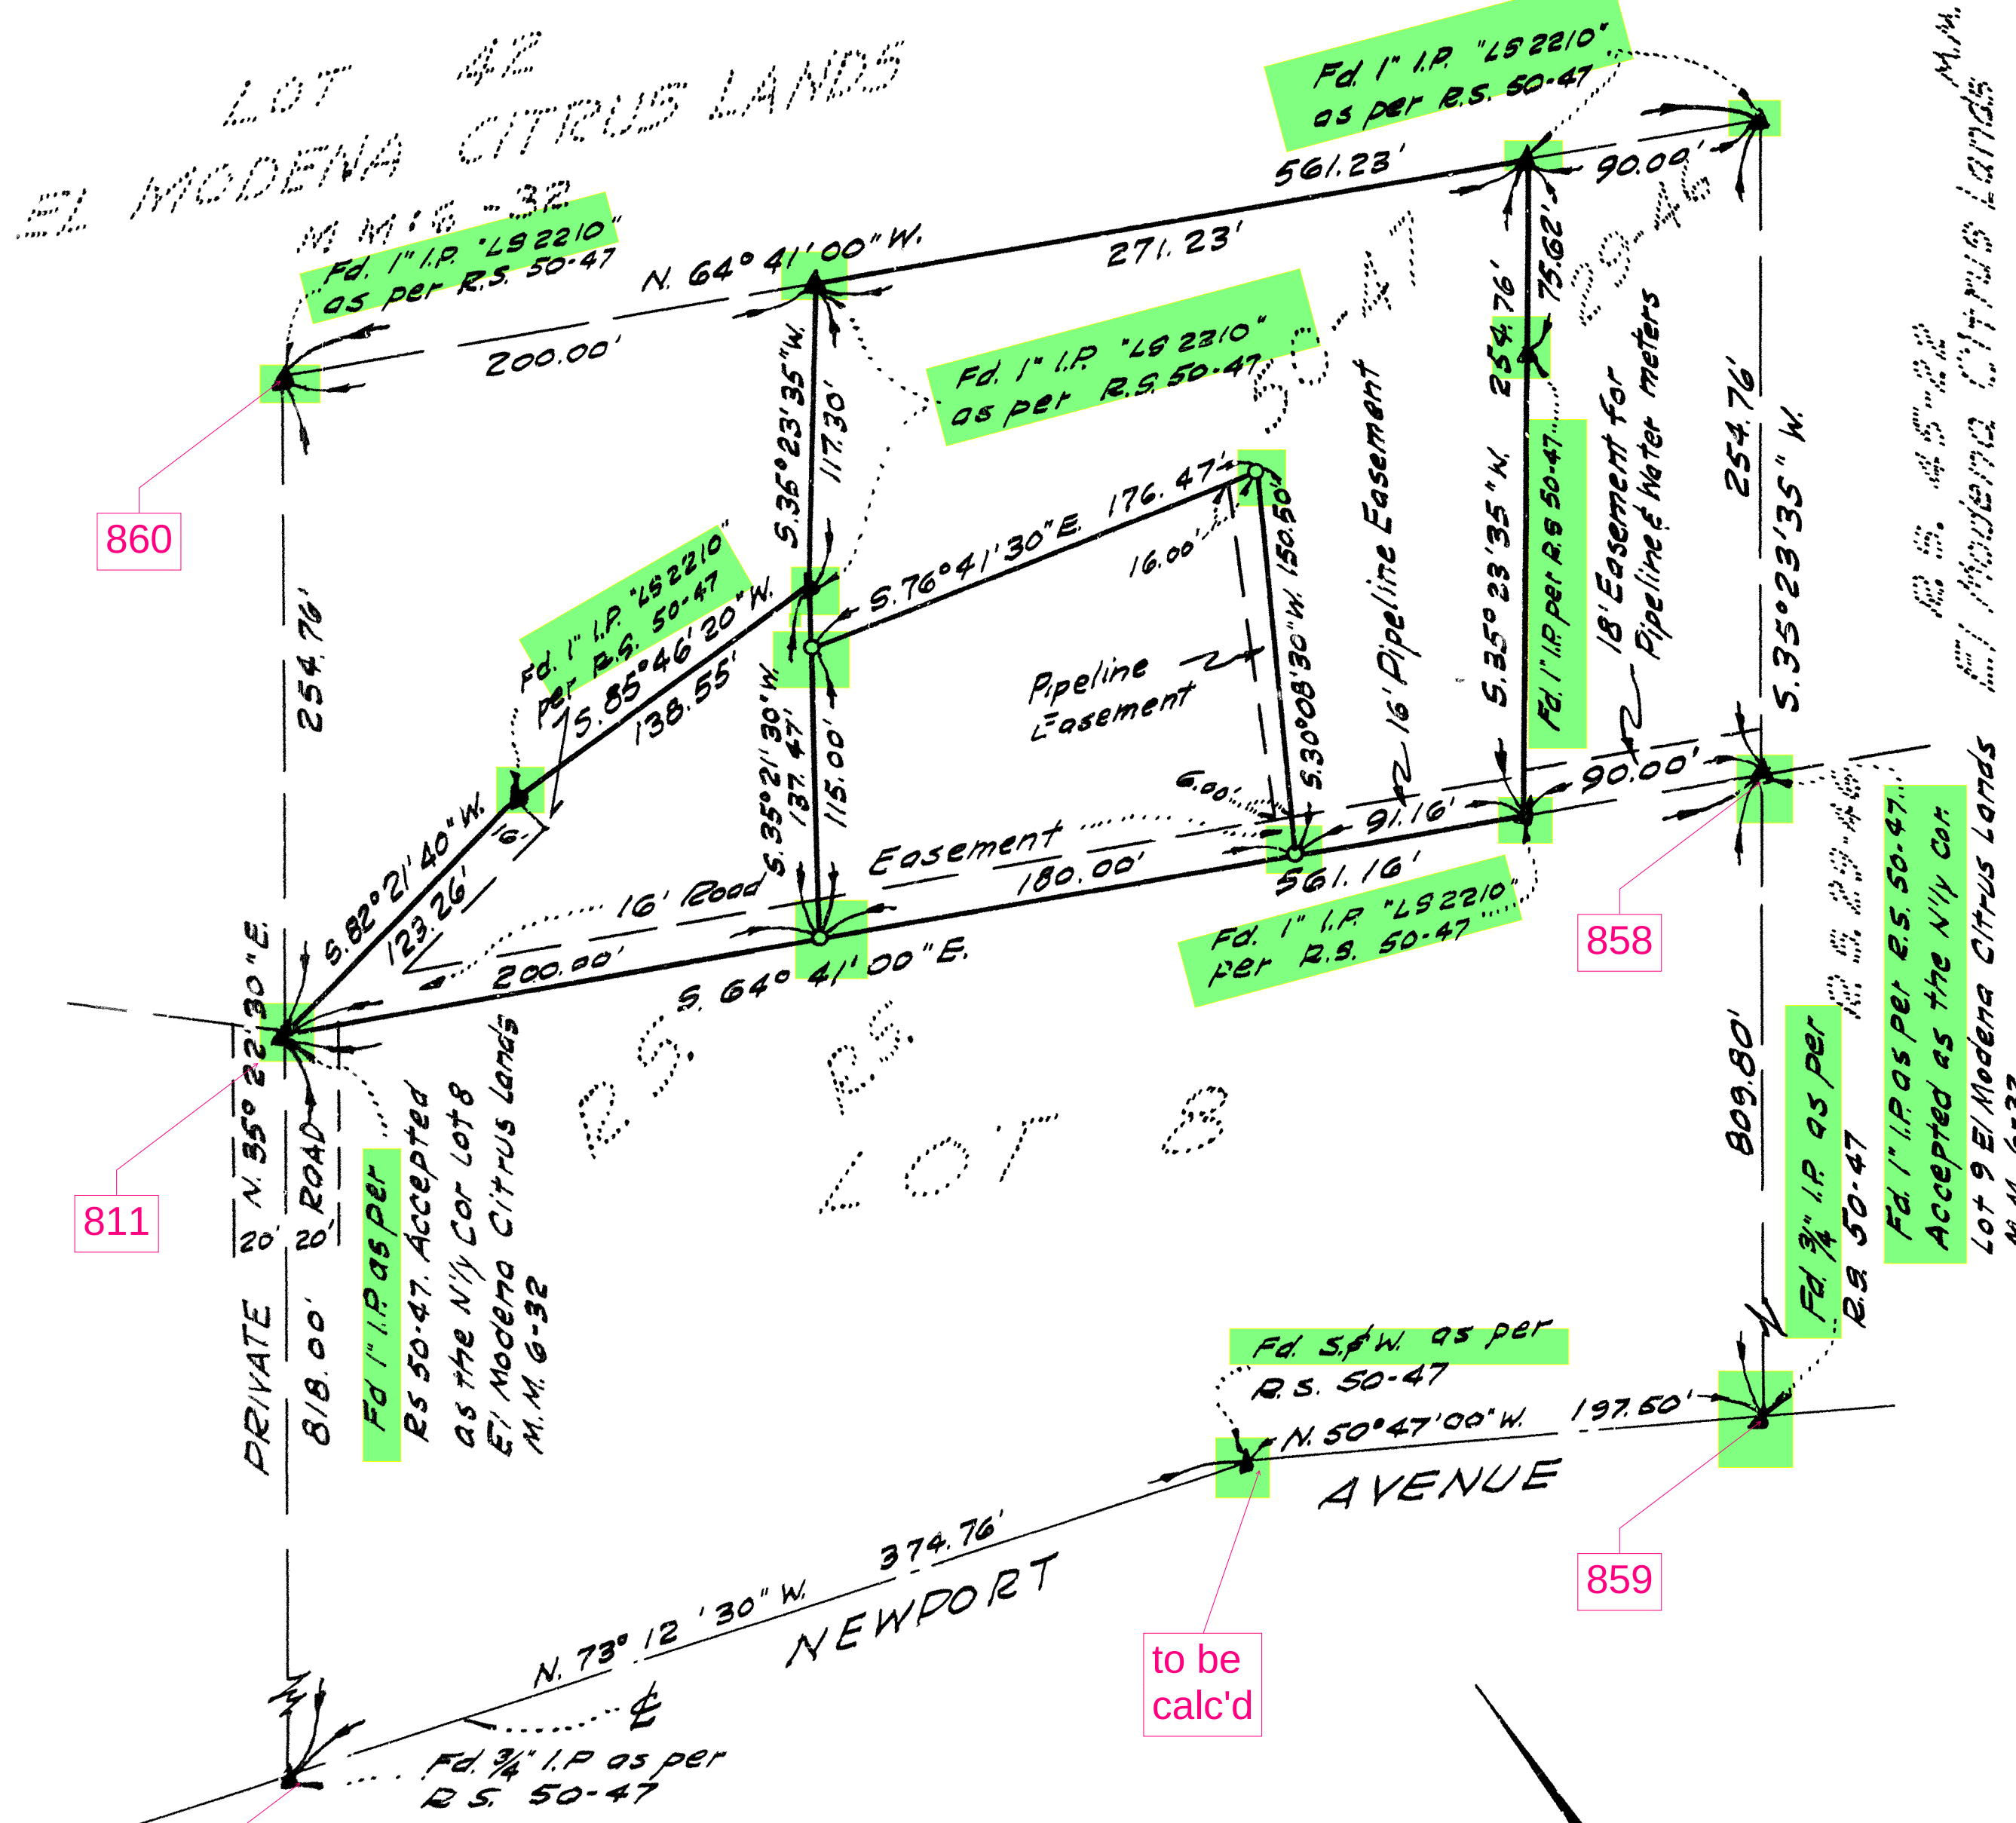

OWNER: EMIL MYREHN


DESCRIPTION: In Unincorporated Territory, a portion of Lot 42, El Modena Citrus Lands, M.M. 6-32, Rec. of Ora. Co., Cal.

BASIS OF BEARINGS: Bearings are based on the N 1/4 line of Lot 8, El Modena Citrus Lands, M.M. 6-32, being S 64° 41' 00" E, as per R.S. 29-46 & 50-47, Rec. of Ora. Co., Cal.

NOTE: Set 1" Iron Pipe bearing tag stamped "L52210" at points shown "o".

Surveyed in July 1960

Scale 1" = 100'

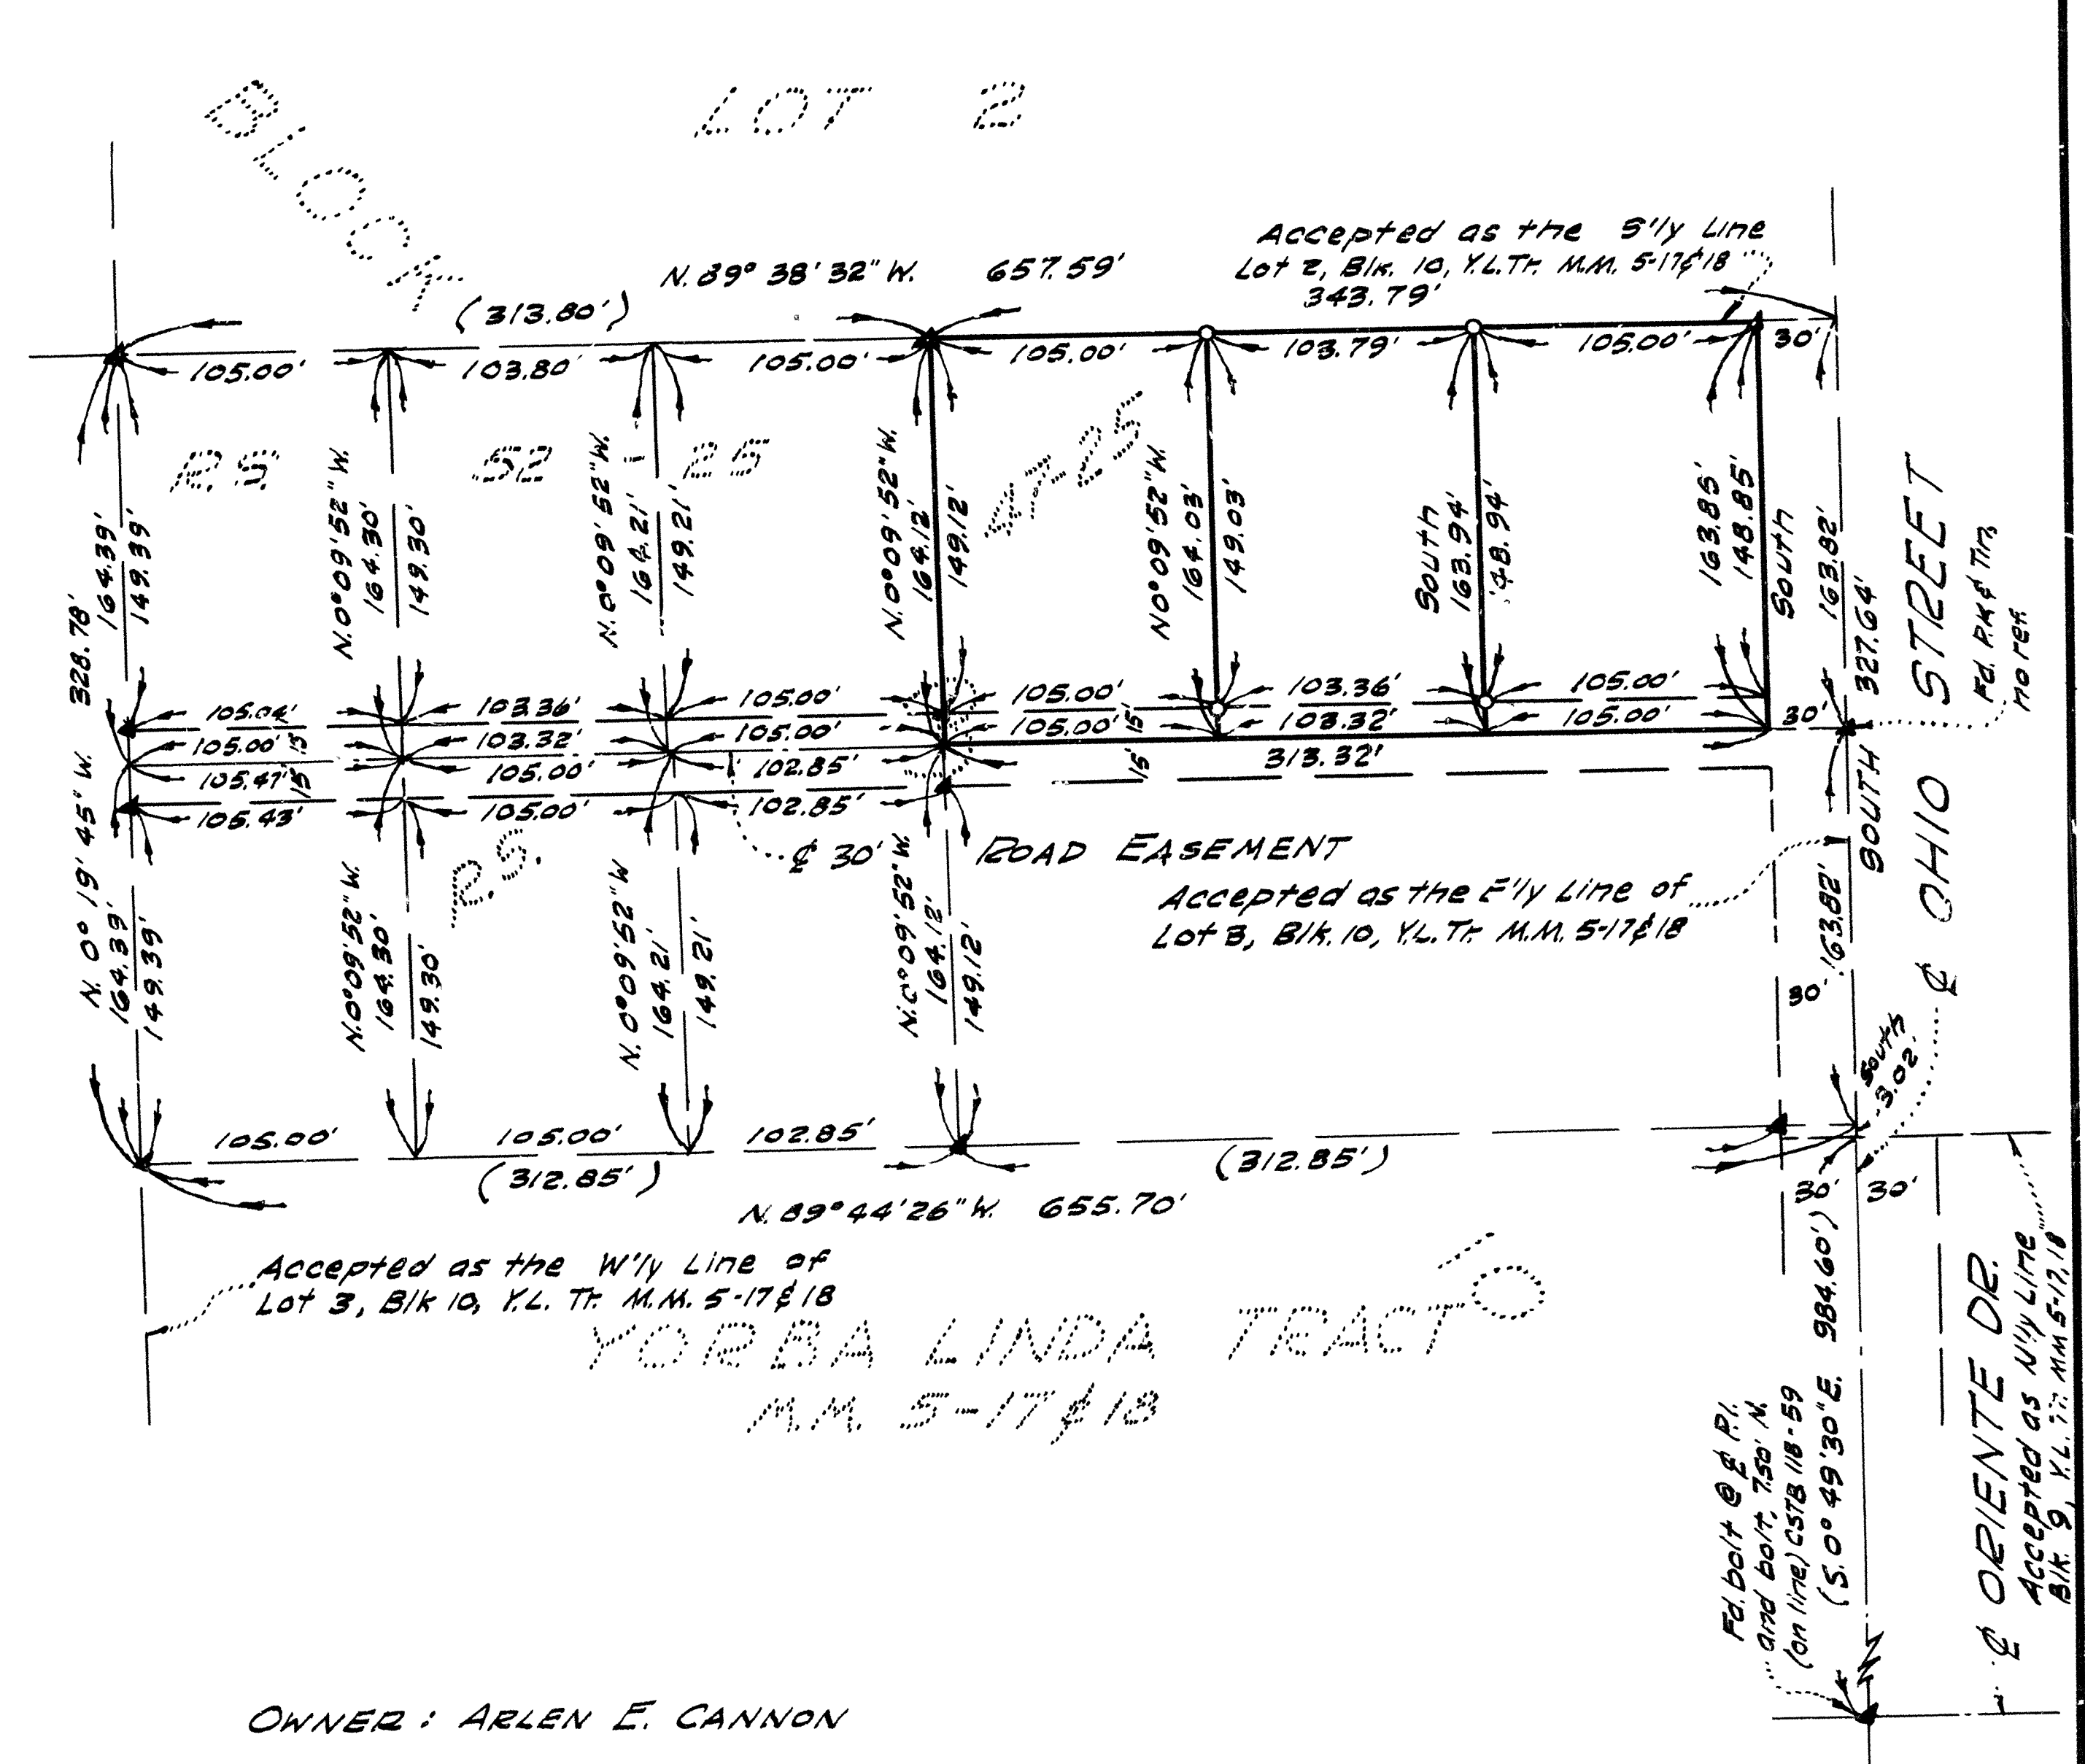

OWNER: ARLEN E. CANNON

DESCRIPTION: In Unincorporated Territory, a portion of Lot 3, Block 10, Yorba Linda Tract, M.M. 5-17 & 18, Rec. of Ora. Co., Cal.

BASIS OF BEARINGS: Bearings are based on the E. of Ohio Street, being S 0° 49' 30" E, as per R.S. 47-25, Rec. of Ora. Co., Cal.

NOTE: Set 1" Iron Pipe bearing tag stamped "L52210" at points shown "o".
Set 1" Iron Pipe bearing tag stamped "L52210" at points shown "a" per R.S. 47-25 except as noted.

Surveyed in March, 1961

Scale 1" = 100'