

RECORD OF SURVEY

August, 1961


This map has been examined for conformance with the requirements of Chapter 15, Division 3 of the Business and Professions Code this 22nd day of September, 1961.

C. R. Estabrook
Deputy County Surveyor
Orange County, California

This map correctly represents a survey made under my direction in conformance with the requirements of Chapter 15, Division 3 of the Business and Professions Code at the request of the owners shown below.

B. W. Kilgus

D.D. HILLYARD
Lic. Surv. No. 2210

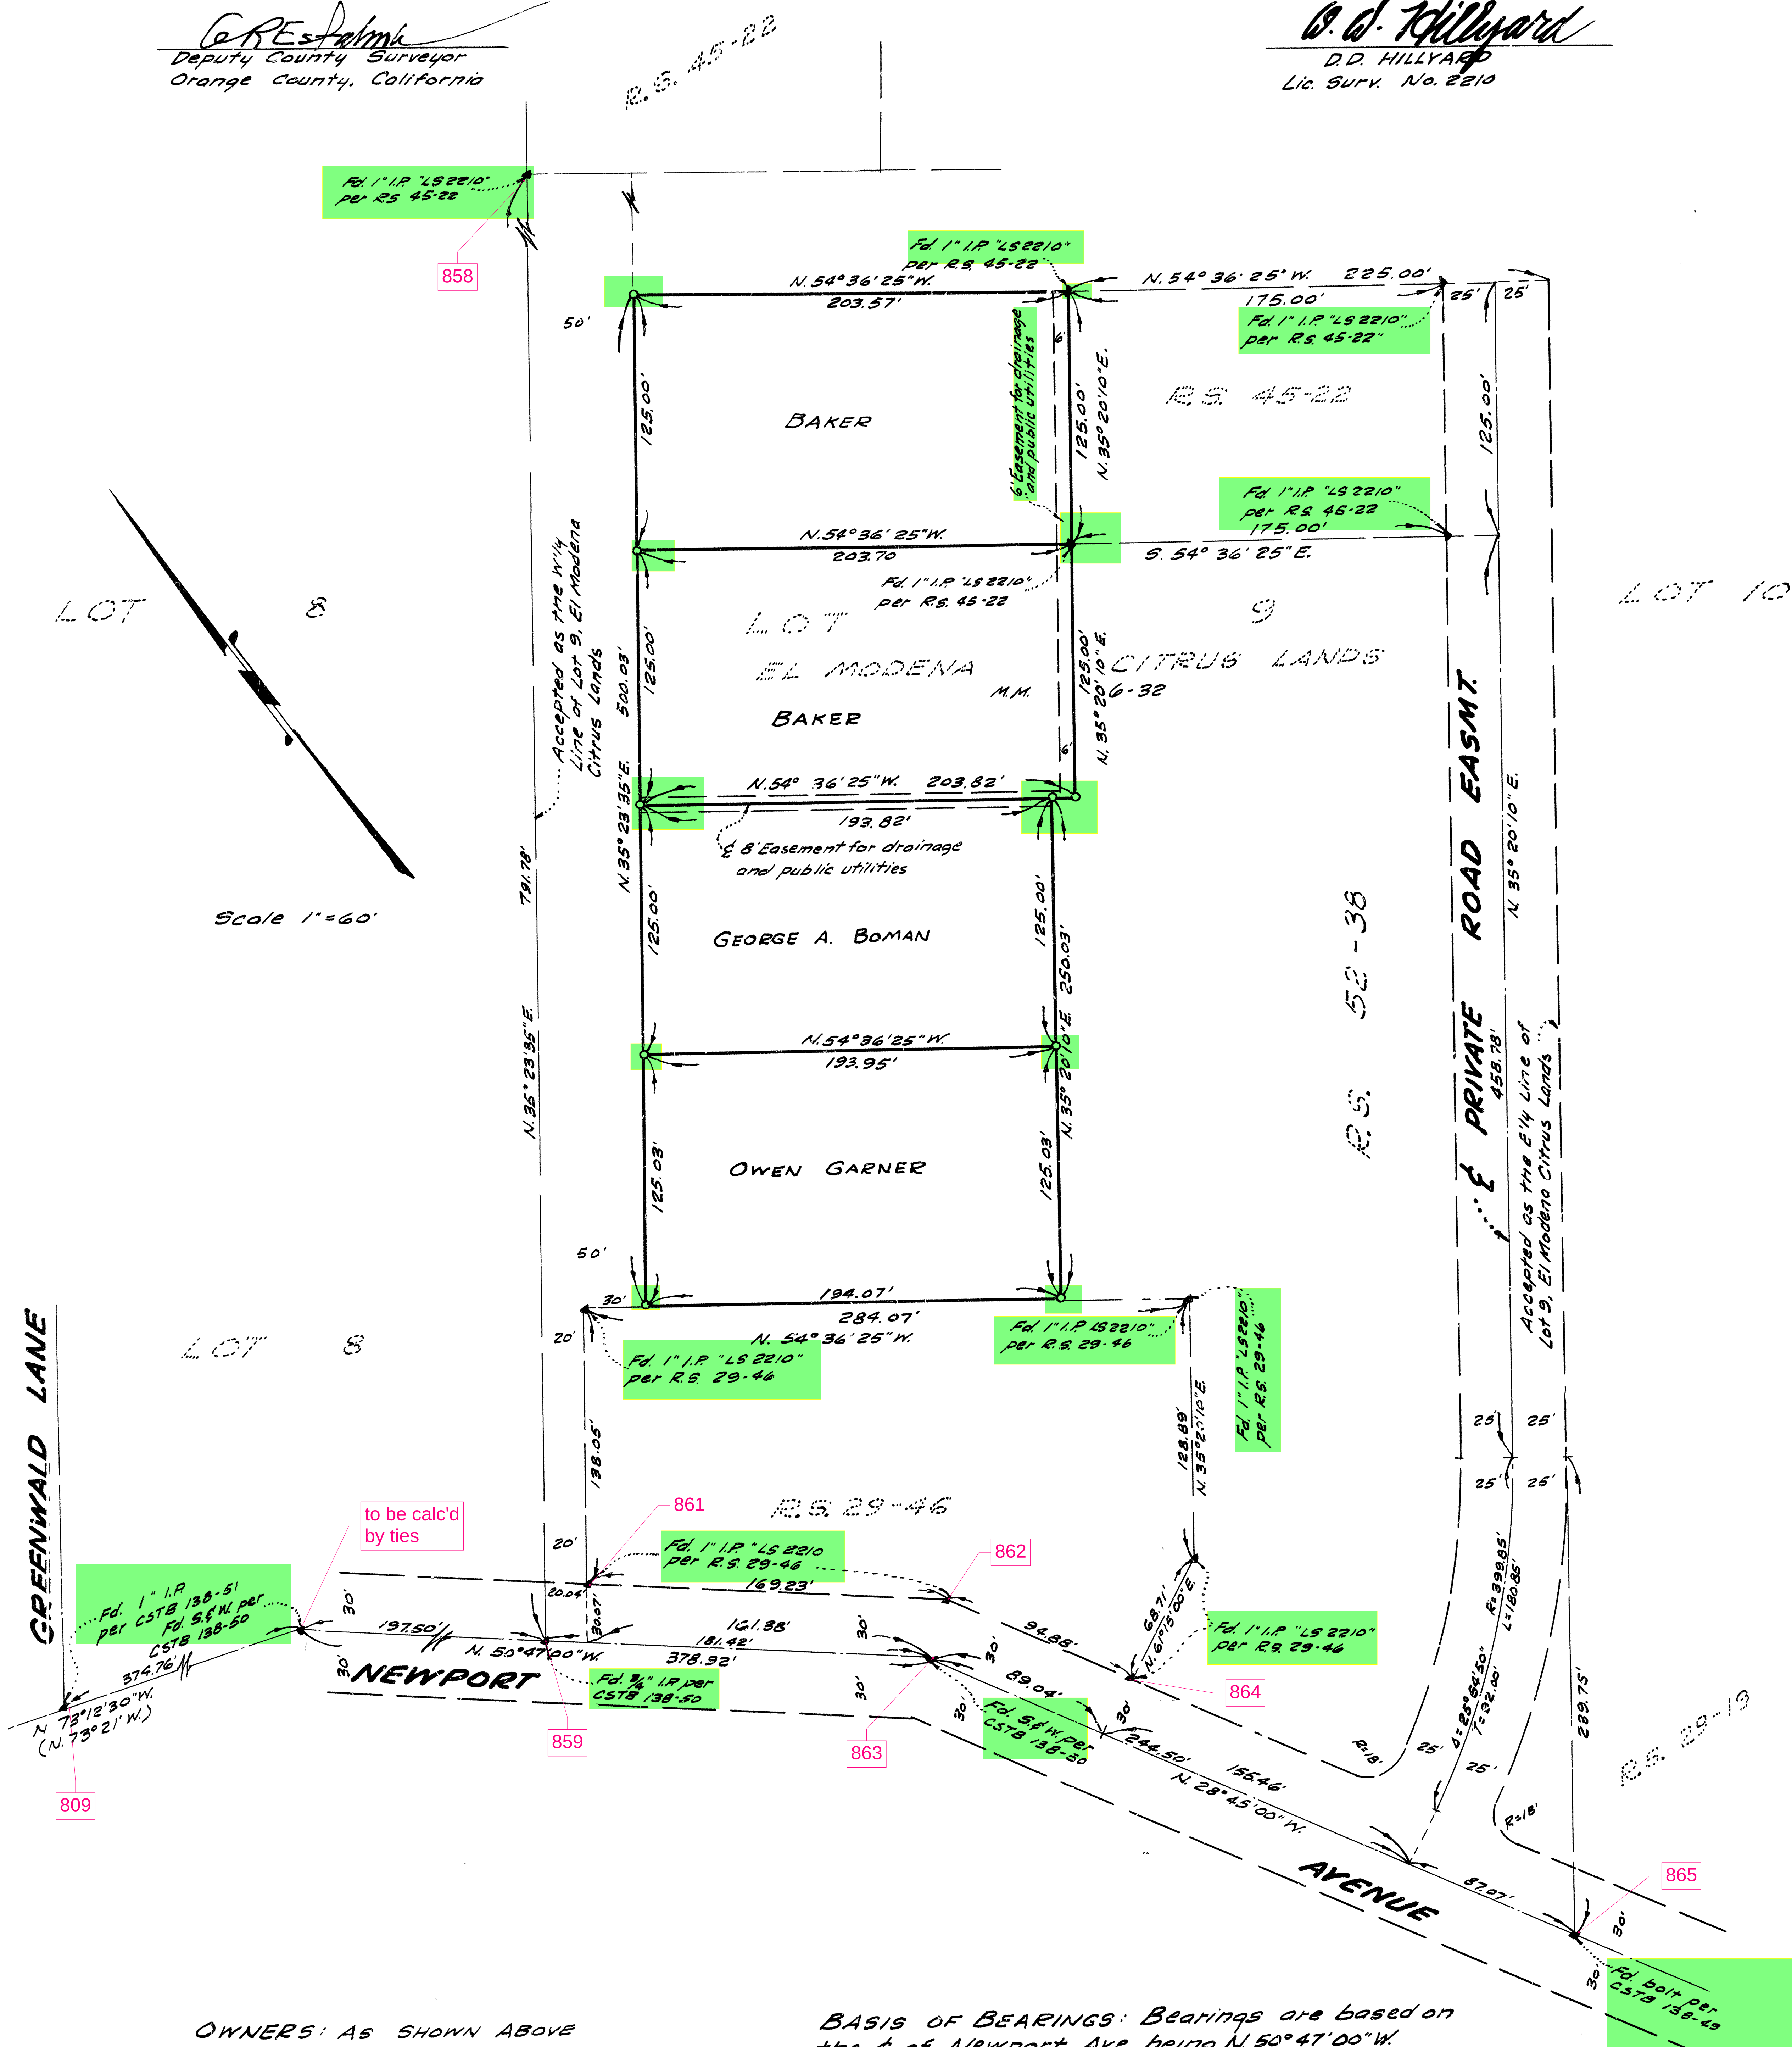

OWNERS: AS SHOWN ABOVE

DESCRIPTION: In Unincorporated Territory, a portion of Lot 9 El Modena Citrus Lands. M.M. 6-32, Rec. of Ora. Co Calif.

Date of Survey: July 1961

BASIS OF BEARINGS: Bearings are based on the E. of Newport Ave. being N. 50° 47' 00" W. as per R.S. 29-46, Rec. of Ora. Co., Calif.

NOTE: Set 1" Iron Pipe bearing tag stamped "L52210" at points shown "o".

17806 INDEXED SEP 26 1961

FILED FOR RECORD this _____ day of _____
 19____ at 10:25 AM, in Book _____ 54/46
 of Record of Surveys, at _____
 of _____ COUNTY SURVEYOR

 _____, County Recorder

\$5.00