

I, John M. Hoy, certify that I am a
Licensed Surveyor in the State of California
(No. 2326) that this map consisting of one sheet
represents a survey made under my direction
at the request of the owners in April 1957 and that the
measurements are of the character and occupy the positions indicated
and they are sufficient to enable the survey to be retraced.

John M. Hoy
Licensed Surveyor

RECORD OF SURVEY

A SURVEY OF LOTS 19 AND 20, TRACT 916, MM 29/2-4
AND A PART OF LOT 15, EL MODENA CITRUS LANDS
MM 6-32 IN ORANGE COUNTY CALIFORNIA

OWNERS SHOWN ON PARCELS


APRIL 1957

JOHN M. HOY LICENSED SURVEYOR

Scale $\frac{1}{4}$ " = 40'

Examined and Approved this 30 day of Aug. 1957

Charles H. Hays
Deputy County Surveyor

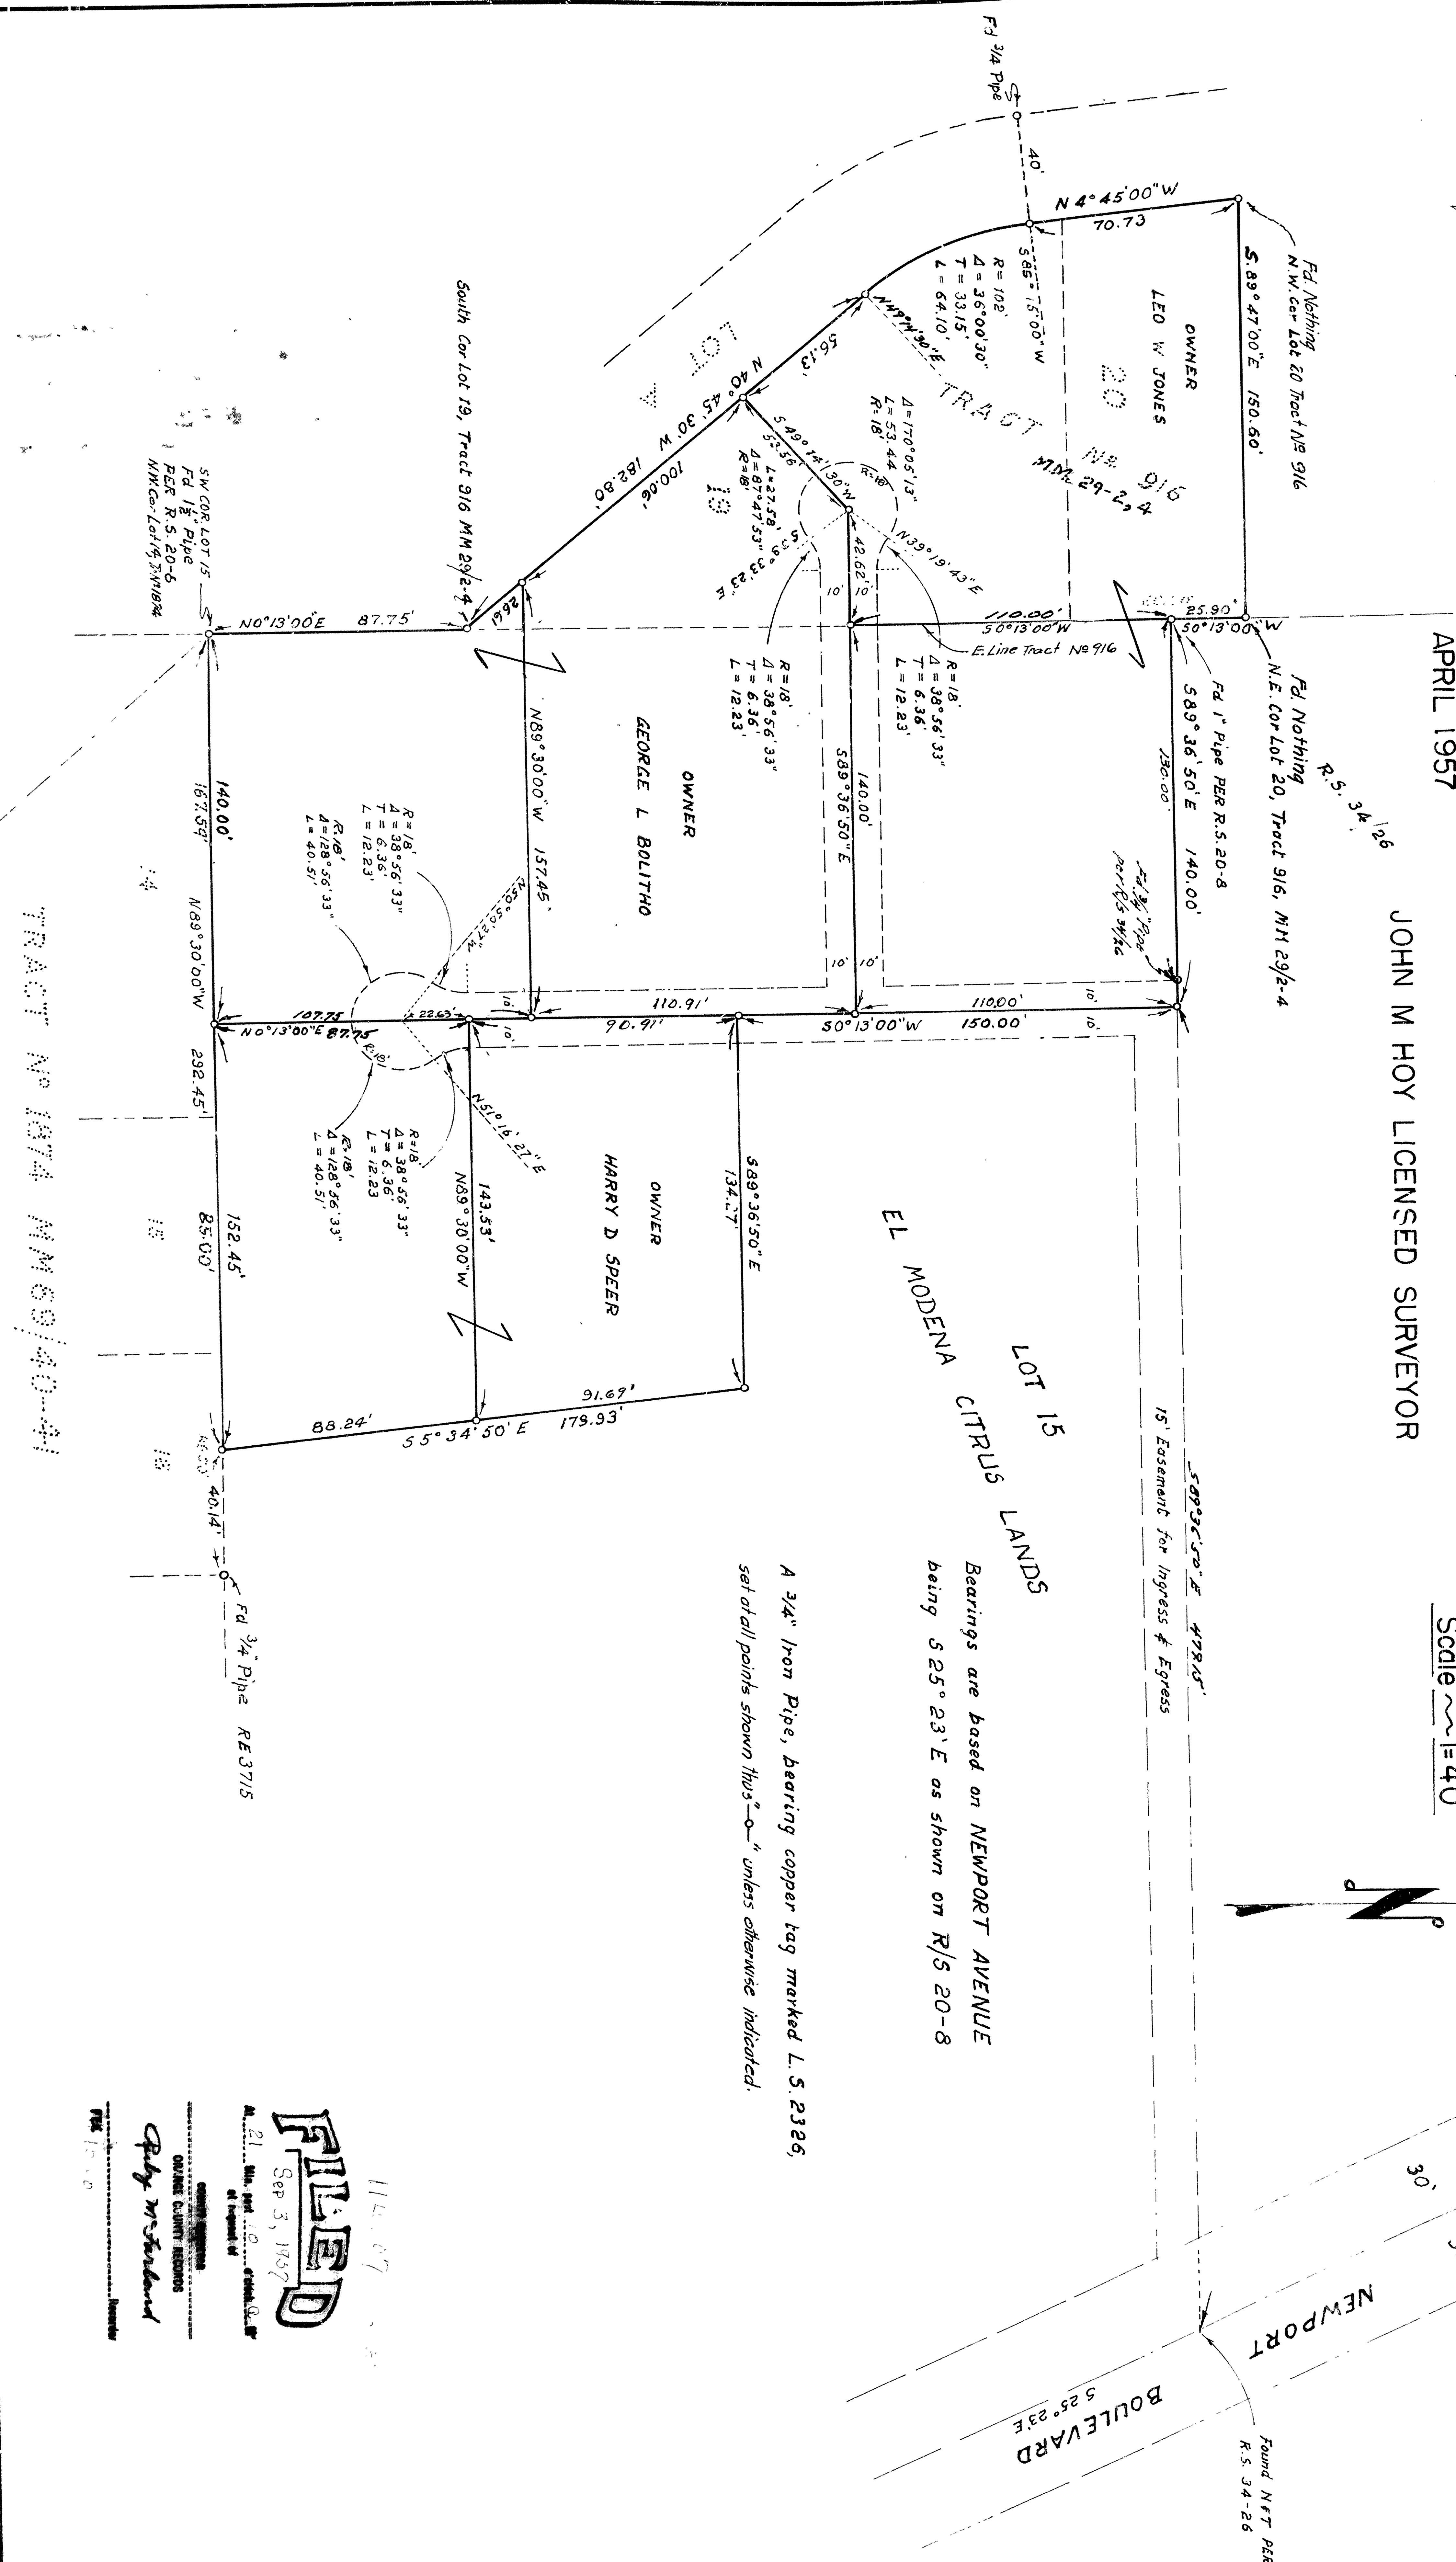

A 3/4" Iron Pipe, bearing copper tag marked L.S. 2326,
set at all points shown thus "o" unless otherwise indicated.

Bearings are based on NEWPORT AVENUE
being S 25° 23' E as shown on R/S 20-8