

SEE PAGE 14

& SURVEY
 OF
 NEWPORT AVE.
 FROM: LA LIMONAR
 TO: CRAWFORD CYN. RD.
 &
 CRAWFORD CYN. RD.
 FROM: NEWPORT AVE.
 TO: CHAPMAN AVE.

COUNTY SURVEY NO. 6955

Date: 4-11-73

FIELD PARTY

RC.: J. HATTER

T: L. TOOMEY

CH: R. VAN HOUTEN

" : R. PARSON

DATE:

JAN, 1970

EQUIPMENT

1) TRANSIT: T-1A #65966

2) TAPE: C.C. #23

a) 25' tension = 100.00' @ 50°F

NOTE: NEWPORT AVE

THIS SURVEY REPRESENTS
 A RETRACEMENT OF THE
 & PER C.S.T.B. 138, 42 to 32.
 THESE NOTES DO NOT SHOW
 THE NEW & OF NEWPORT AVE.
 SEE SM. 71-7 FOR THE NEW &


NEWPORT AVE CRAWFORD CYN
Hatter EPH

A/4-9


2 of 14

980

1/70

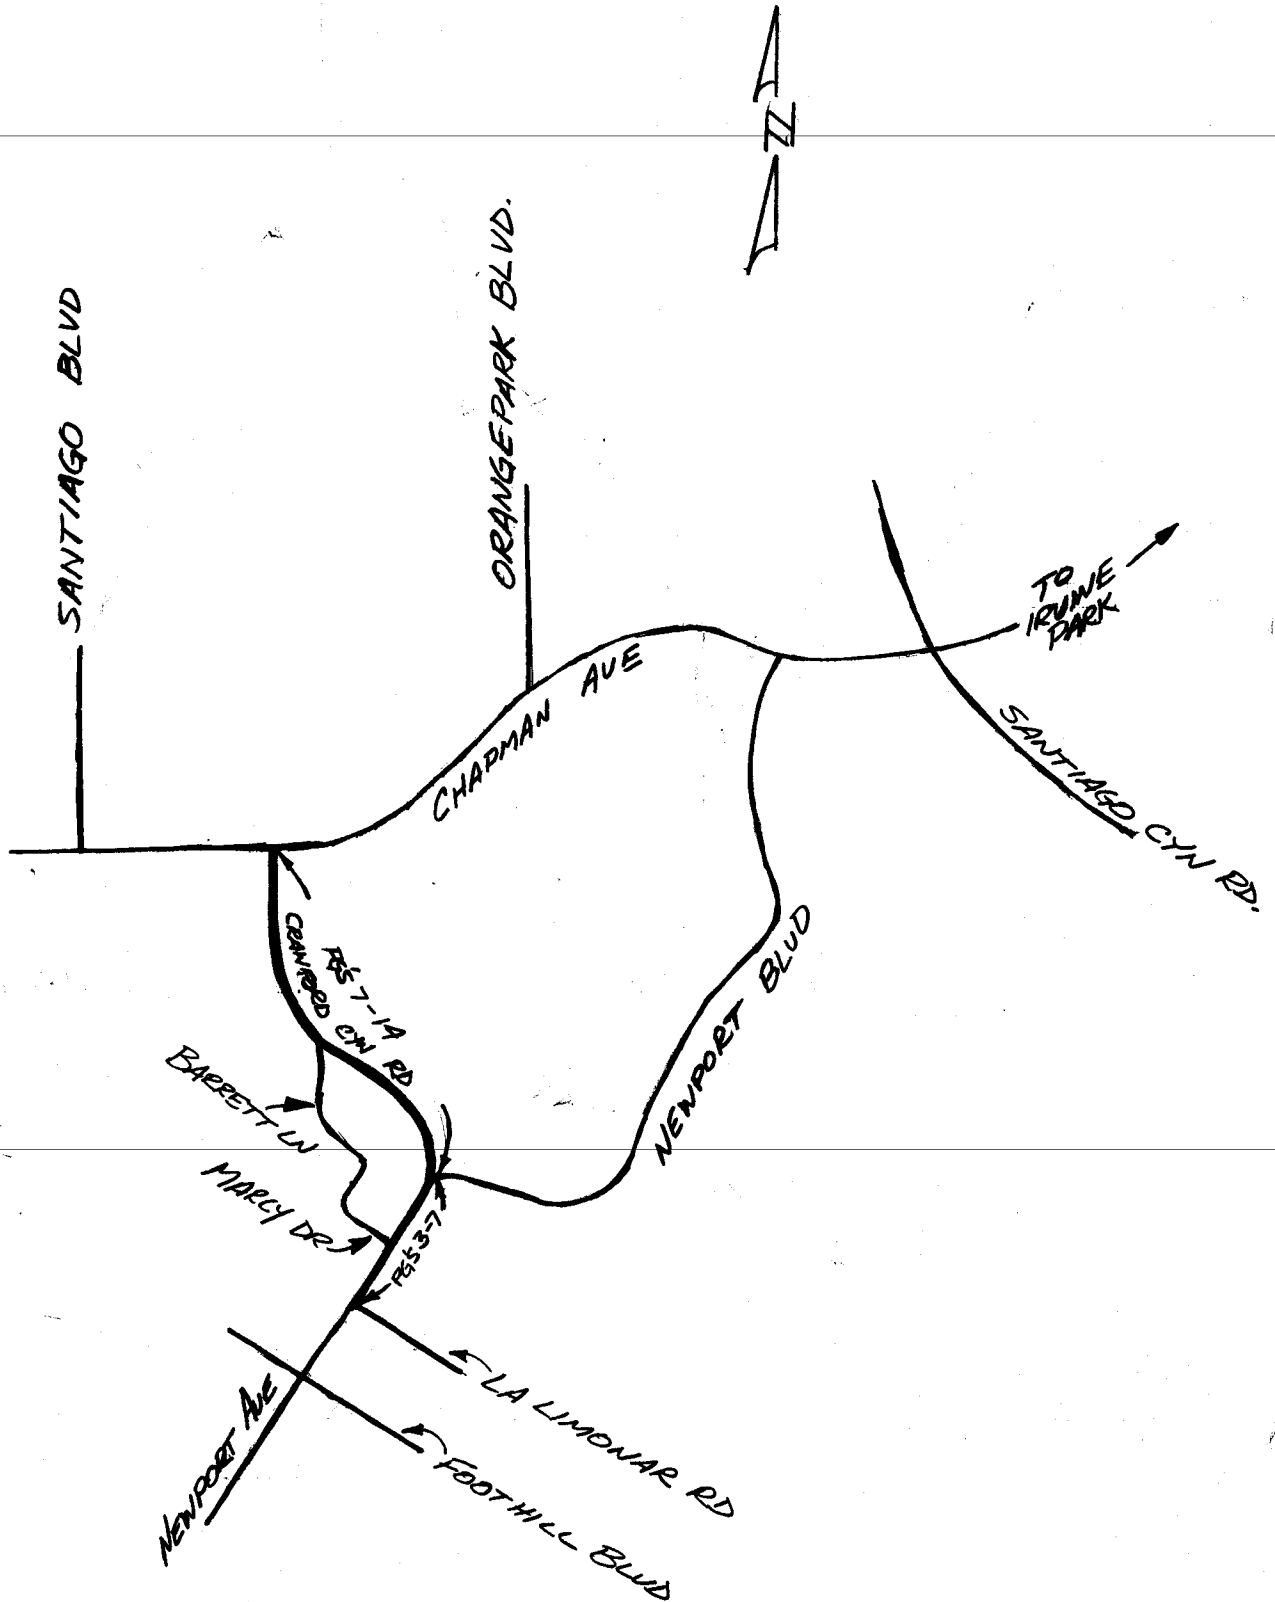

To Pl. P94

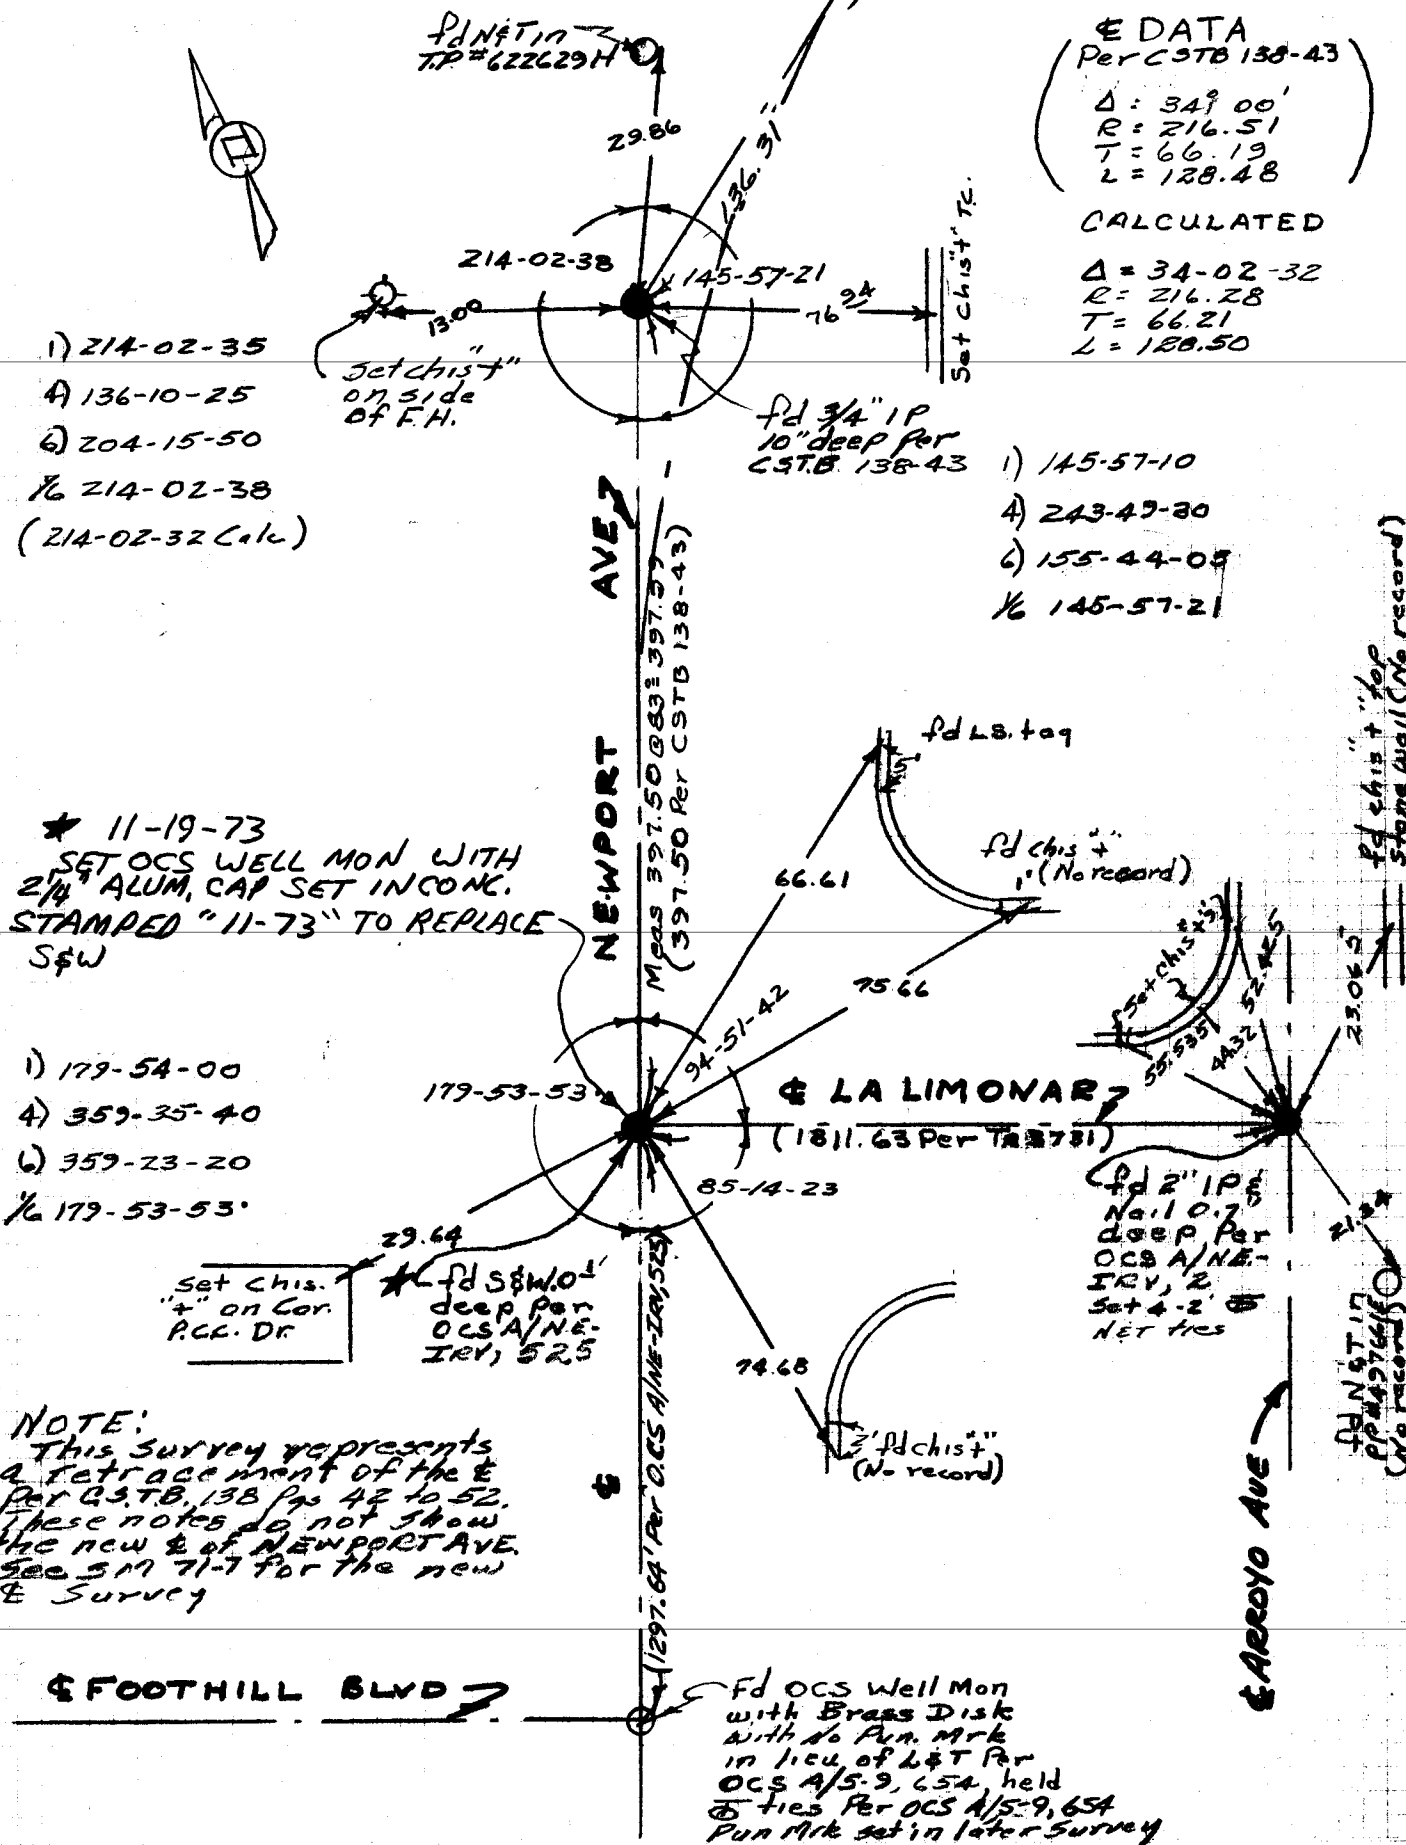

NEWPORT AVE Hatter & Pk

A/4-9


982

4 of 14



- 1) 194-31-40
- 4) 5B-06-40
- 6) 87-10-00
- 1/6 194-31-40
- (194-31-36 Calc)

fd 3/4" IP 8"
deep bc at N.W. ly
Per CSTB 138-44
Held top of pipe,
as is, set 2-2
NET ties

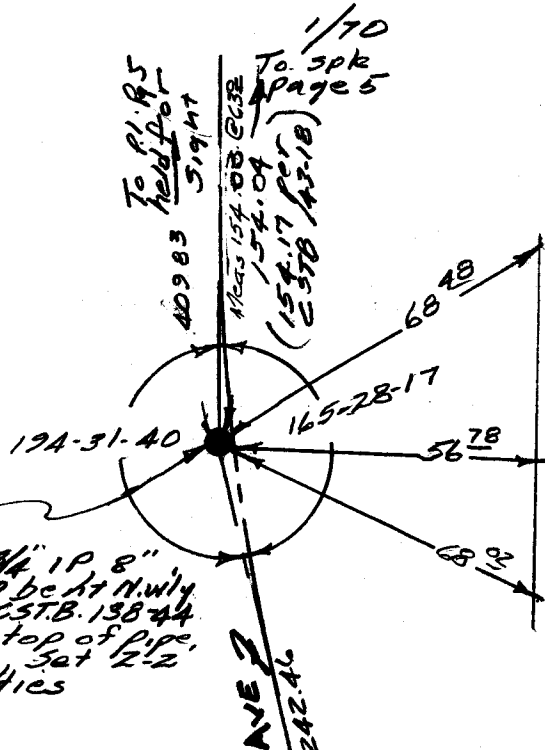

DATA

(Per CSTB 138-44)
 $\Delta = 14^{\circ} 29'$
 $R = 610'$
 $T = 77.51$
 $L = 54.20$

CALCULATED
 $\Delta = 14-31-36$
 $R = 610'$
 $T = 77.75$
 $L = 154.66$

NOTE:
 Meas dists. shown
 on this page were
 with tape & 1/4 Calib C68°F


- 1) 217-17-35
- 4) 149-12-05
- 6) 223-48-00
- 1/6 217-18-00
- (217-17-51 Calc)

DATA

(Per CSTB 138-43)
 $\Delta = 37^{\circ} 20'$
 $R = 207.50$
 $T = 70.10$
 $L = 135.20$

CALCULATED
 $\Delta = 37-17-57$
 $R = 207.76$
 $T = 70.12$
 $L = 135.25$


- 1) 142-42-25
- 4) 210-48-35
- 6) 136-12-35
- 1/6 142-42-06

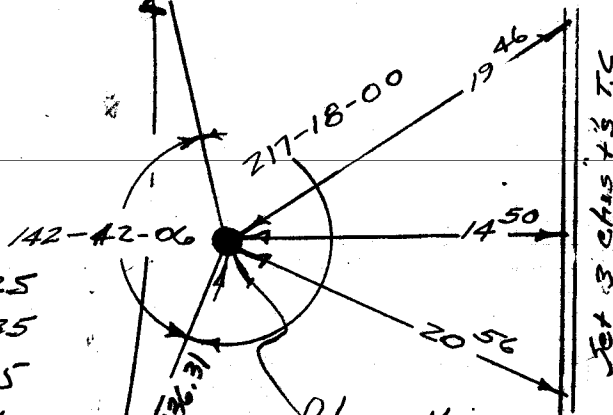


fd nothing
 set 1" x 2" H&T-O-
 deep by compass
 of ADJ. of
 record & dist.
 between 3/4" IP, shown
 N.E. 1/4 & S.W. 1/4 Per
 CSTB 134 pgs 43 & 44
 Replaced with 58 by
 RCE 6978 & 4-2 & C.S. ST
 ties

NOTE:
 This Survey represents
 a retracement of the &
 Per CSTB 138-42 to 52. These
 notes do not show the new
 & of Newport Ave. See SM 71-7
 for new &.

SEE PAGE 3

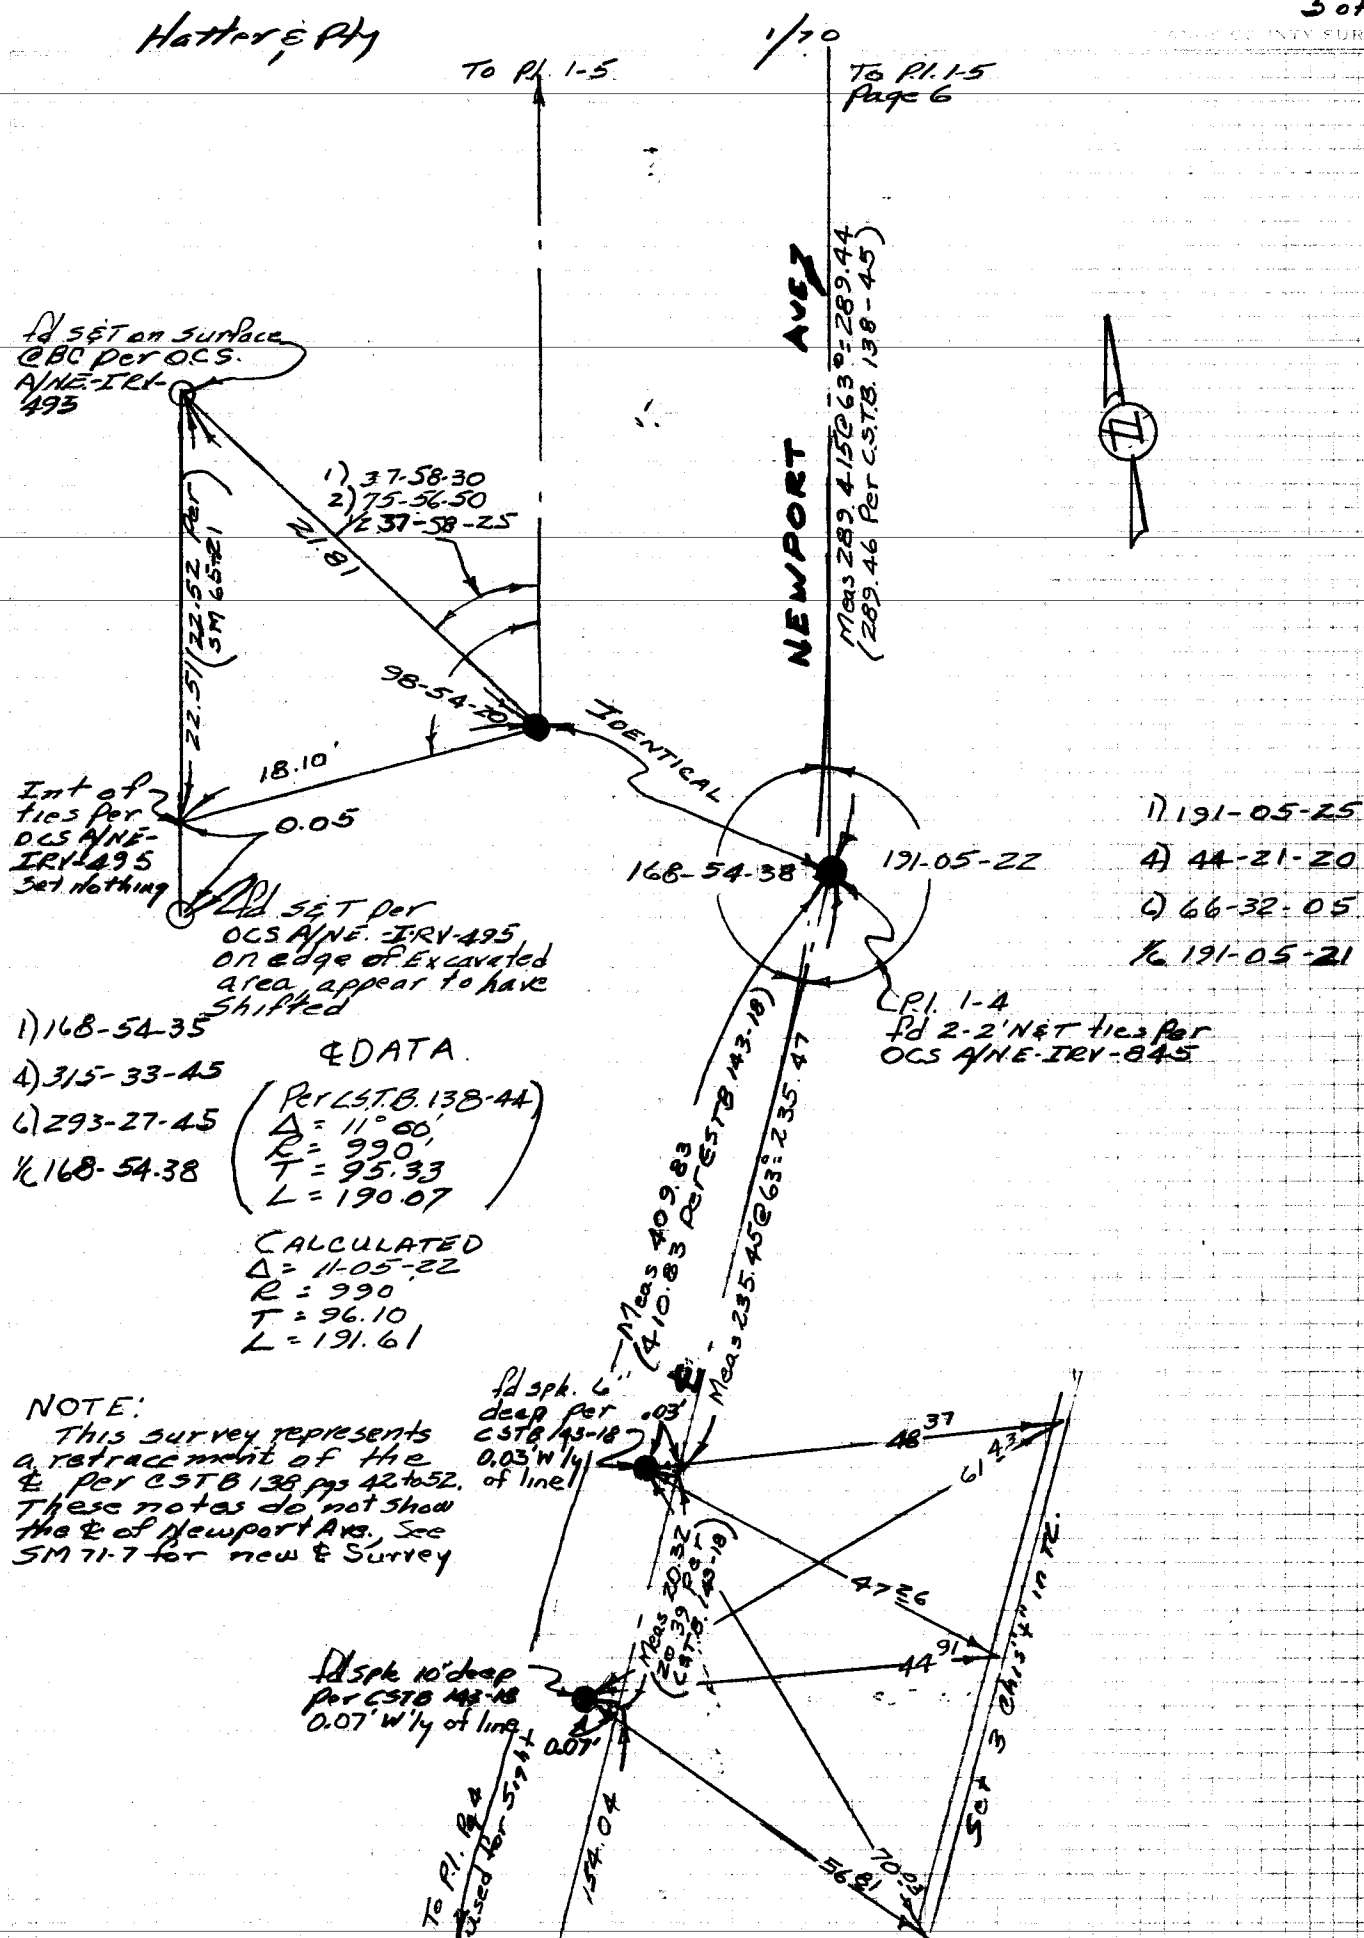

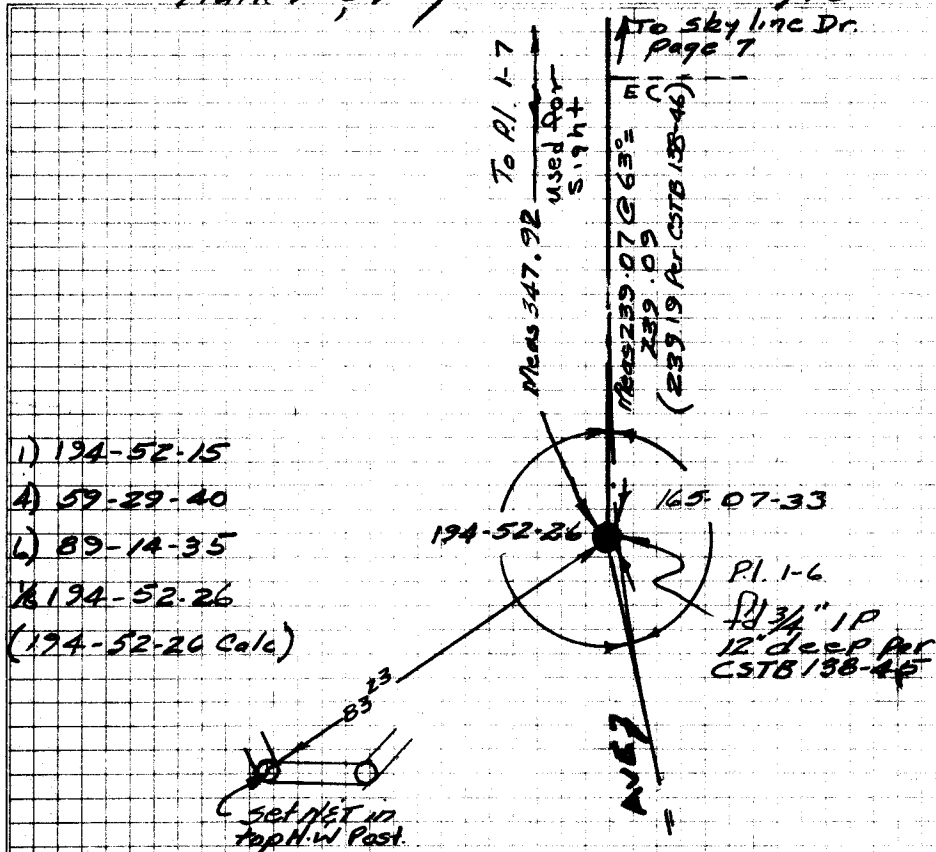

E DATA

(Per CSTB 138-45)
 $\Delta = 14-46-45$
 $R = 510.00'$
 $T = 66.14'$
 $L = 131.55'$

CALCULATED

$\Delta = 14-52-26$
 $R = 510'$
 $T = 66.57'$
 $L = 132.40'$

1) 165-07-35

A) 300-30-05

G) 270-45-15

X 165-07-33

1) 149-29-40

A) 237-59-10

G) 176-58-50

X 149-29-48

E DATA

(Per CSTB 138-45)
 $\Delta = 30-30-08$
 $R = 290'$
 $T = 79.06'$
 $L = 154.37'$

CALCULATED

$\Delta = 30-30-08$
 $R = 290'$
 $T = 79.07'$
 $L = 154.39'$

NOTE:

This survey represents a retracement of the E per CSTB 138 per 42 to 52. These notes do not show the new E of Newport Ave. See SM 71-7 for the new E.

Set Net in PP# 794998H

Setchist on M.H. rim

NEWPORT

246.05 @ 53°-24'06" (245.81 per CSTB 138-45)

Meas 246.05 @ 53°-24'06" (245.81 per CSTB 138-45)

245.81

149-29-48

210-30-11

PI. 1-5

12" deep per CSTB 138-45

Set 2-2 Net ties

289.44

To Pl. 1-4

PAGE 5

1) 210-30-10

A) 122-00-45

G) 183-01-05

X 210-30-11

(210-30-08 Calc)

Hatter & P₁Set Net in
TP # 532752H1/10
TO P11-8
Page 8Set Net in
PPR # 1643035E

1) 153-24-05

4) 253-36-45

6) 200-25-00

1/6 153-24-10

E DATA

For TR 732
 A = 26-36-45
 R = 326.38
 T = 77.20
 L = 151.60

CALCULATED
 A = 26-35-50
 R = 326.38
 T = 77.18
 L = 151.51

1) 206-35-50

4) 106-23-20

6) 153-35-25

1/6 206-35-54

(206-35-50 Calc)

206-35-54

ROZ
Meas 571.48P1 1-7
Pd 3/4" IP, 12"
deep per
CSTB 138-46Set Net in
top 4" IP
Guard rail
Post
(No record)

Meas 347.92

CRAWFORD CYN.

Meas 108.82 @ 62° 10.83
(108.79 / 81 CSTB 158-47)

1) 68-33-10

4) 274-12-10

6) 51-18-15

1/6 68-33-02

1) 180-00-00

4) 0-00-00

6) 0-00-00

1/6 180-00-00

1/6 nothing
Set nothing

1/6 3/4" IP, 12" deep
 R = 257.8138-46
 0.08 Ely as shown
 0.06 Ely per OCS
 A/N.E. - IRV, 846

180-00-00

68-33-02

10.08

111-27-02

111-27-02

SKYLINE
 161.08 (160.99 per A/N.E. - IRV, 678)

1/6 3/4" IP, 12"
 deep per
 CSTB 144-22
 Set 2-2 Net
 IRV

1) 111-27-10

4) 85-48-05

6) 308-42-15

1/6 111-27-02

To R1. 1-6
 Held for Sight

BC TO SKYLINE


EC TO R1. 1-6 END NEWPORT AVE

Page 6

SURVEYED BY

Hatter & Pety

CHANCE COUNTY SURVEYOR

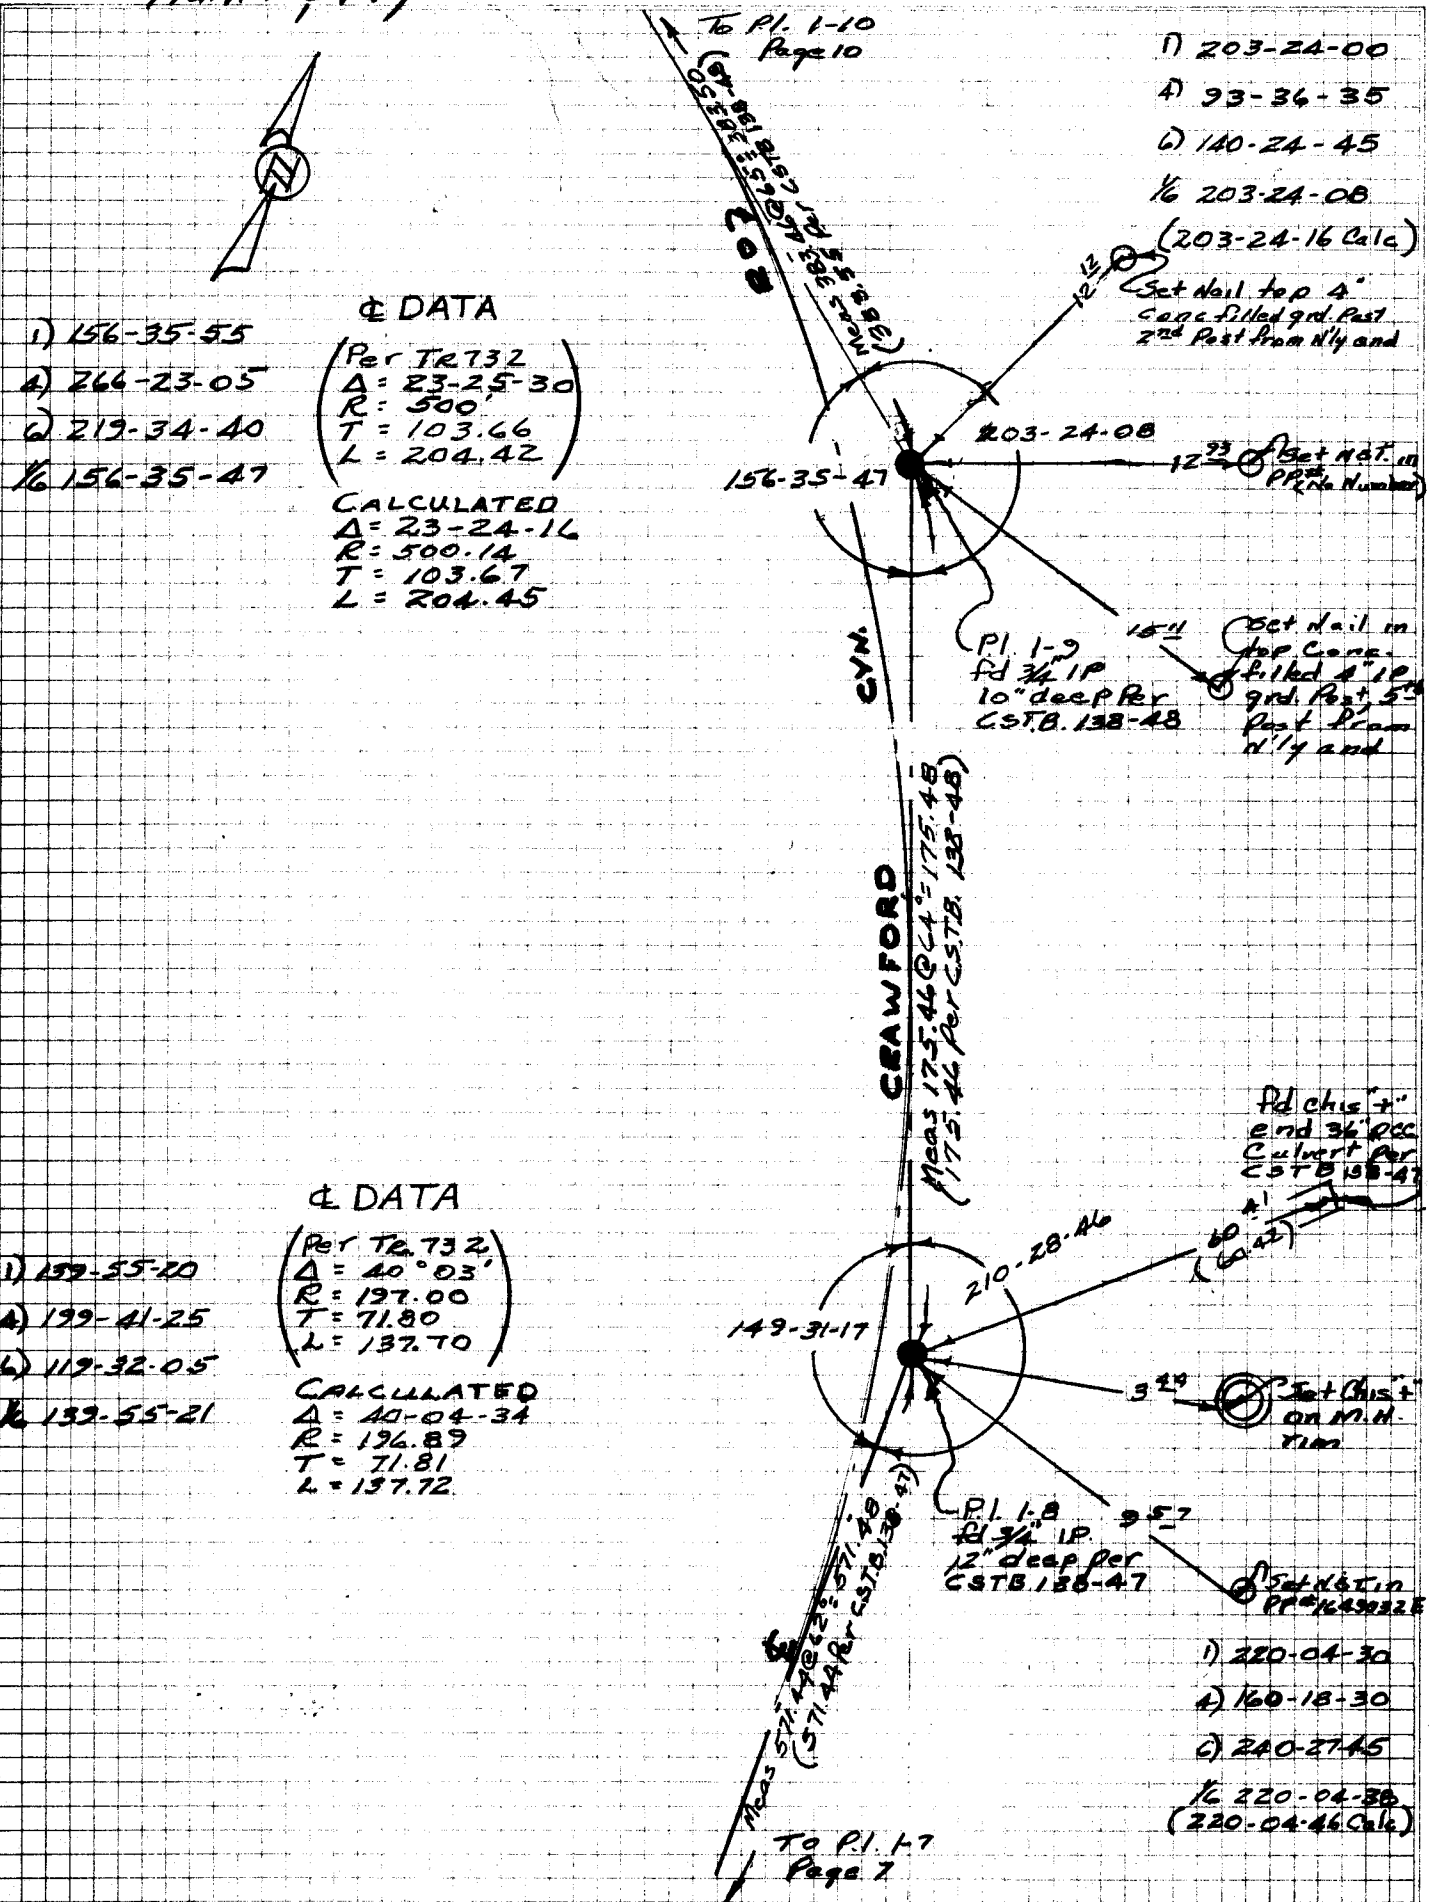

Hotter & PLY

TO P.I. Page 10

- 1) 180-00-00
- 4) 359-59-55
- 6) 359-59-45
- 1/6 179-59-58

Set NET
in 24"
Euc. TreeSet chis "+"
on Conc
Ret. Wallfd OCS BM
tag RCE 7872
top curbSet NET in
top 10" stump

DATA

(Per TR 732,
 $\Delta = 30^\circ 31'$
 $R = 200'$
 $T = 54.56'$
 $L = 106.52'$)

CALCULATED
 $\Delta = 30^\circ 28' 53"$
 $R = 200'$
 $T = 54.49'$
 $L = 106.40'$

- 1) 149-31-15
- 4) 238-05-10
- 6) 177-07-40
- 1/6 149-31-17

TO P.I. 1-9
Page 8To P.I. 1-10
Held for
line

Meas 234.50

C27

CRAWFORD CYN

Meas 252.43 $\pm$ 26.5 $\pm$ 252.46
(252.55 Per 138-48)fd P.K. nail
Per TR 4130

DANGER

(1407.10 Per CSTB 138-48)

fd Conc Nail &
Z-Z NET ties
(No Ref.)Set NET in
PP#1643027ESet NET in
PP#1643029ESet chis "+"
on M.H. rim

- 1) 82-45-10
- 4) 331-01-00
- 6) 136-31-30
- 1/6 82-45-15
- (82-45-23 Calc.)

fd 3/4" I.P. R.
CSTB 138-48

- 1) 97-14-50
- 4) 28-59-15
- 6) 223-29-00
- 1/6 97-14-58

- 1) 210-28-50
- 4) 121-55-00
- 6) 182-52-35
- 1/6 210-28-46
- (210-28-53 Calc.)

- 1) 210-50-20
 A) 123-21-05
 Q) 185-01-25
 1/2 210-50-14

To R.I.
 Pg 11
 Held for
 angle

To Bolt
 Pg 11

210-50-14 149-09-42

fd 1/2" iron, 16"
 deep in sh.
 of road per
 CSTB 138-49
 set 2-8' NET
 ties on edge
 paving

- 1) 149-09-35
 A) 236-38-55
 Q) 174-58-10
 1/2 149-09-42
 (149-10-00 per)
 CSTB 138-49

fd bolt oil
 deep per CSTB
 138-49, 4.05
 SWLY of line

EL ROY

CRAWFORD CYN
 Meas 333.82 per CSTB 138-49
 (333.82 per CSTB 138-49)
 Meas 46.48
 (82.70 per CSTB 138-49)

- 1) 192-00-55
 A) 48-03-30
 Q) 72-05-10
 1/2 192-00-52

167-59-09 192-00-52

fd 1" i.p. 12" deep
 per CSTB 138-49
 set 2-2' NET ties


- 1) 167-59-00
 A) 311-56-45
 Q) 287-54-55
 1/2 167-59-09
 (167-59-30 per)
 CSTB 138-49

COUNTRY HAVEN


fd PKETIN
 per DCS
 A/4-9, 549

fd nothing
 m.H. per TR 4130
 has been raised
 slash mks destroyed

To DANIGER Pg 9
 Meas 234.50
 (234.41 per CSTB 138-49)
 Meas 92.59 @ 66°-32.60
 To RM. nail Pg 9

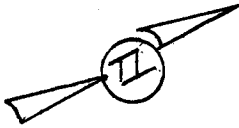Hottel & P₁₁To P₁ P₁₂
held for line


- 1) 157-34-15
- 4) 270-17-00
- 6) 225-25-40
- 1/6 157-34-17
- (157-34-30 per
CSTB 138-50)

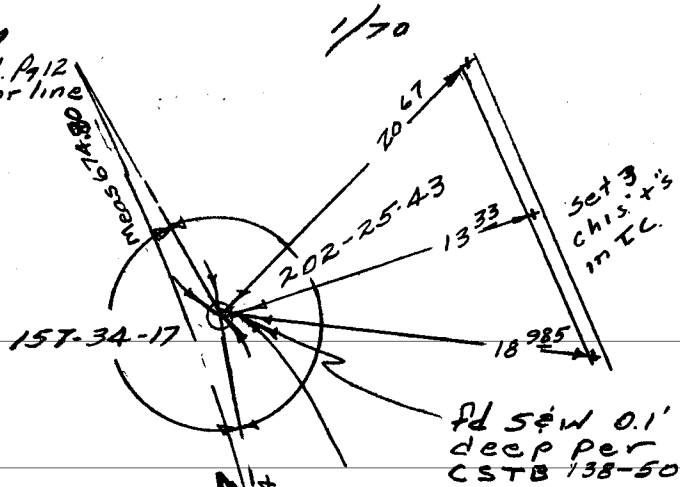


- 1) 202-25-45
- 4) 89-43-00
- 6) 134-34-15
- 1/6 202-25-43

fd 5' W (No Ref.)
accepted in lieu
of 3/4" 1 P per
CSTB 138-50
5' W ON LINE


- 1) 157-58-15
- 4) 271-53-25
- 6) 227-50-00
- 1/6 157-58-20

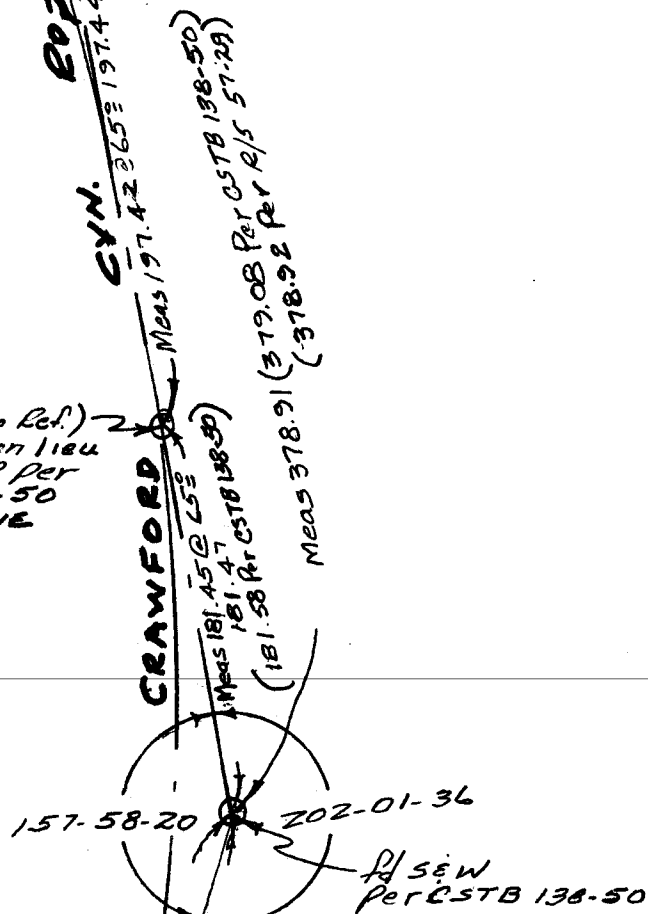

- 1) 202-01-35
- 4) 88-06-25
- 6) 132-09-35
- 1/6 202-01-36

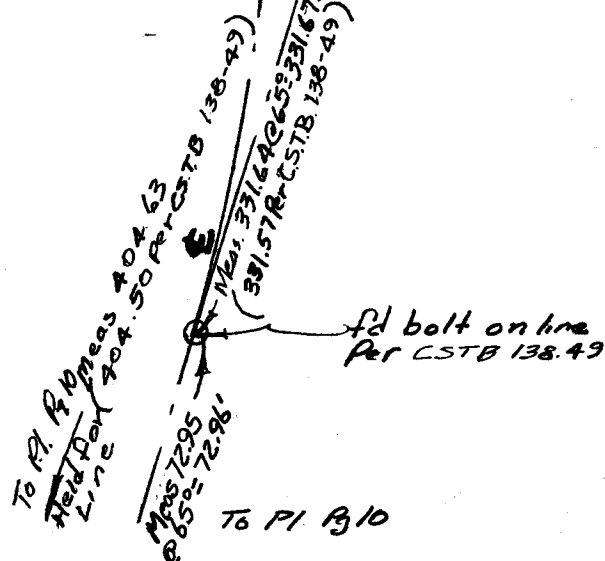

12 of 14

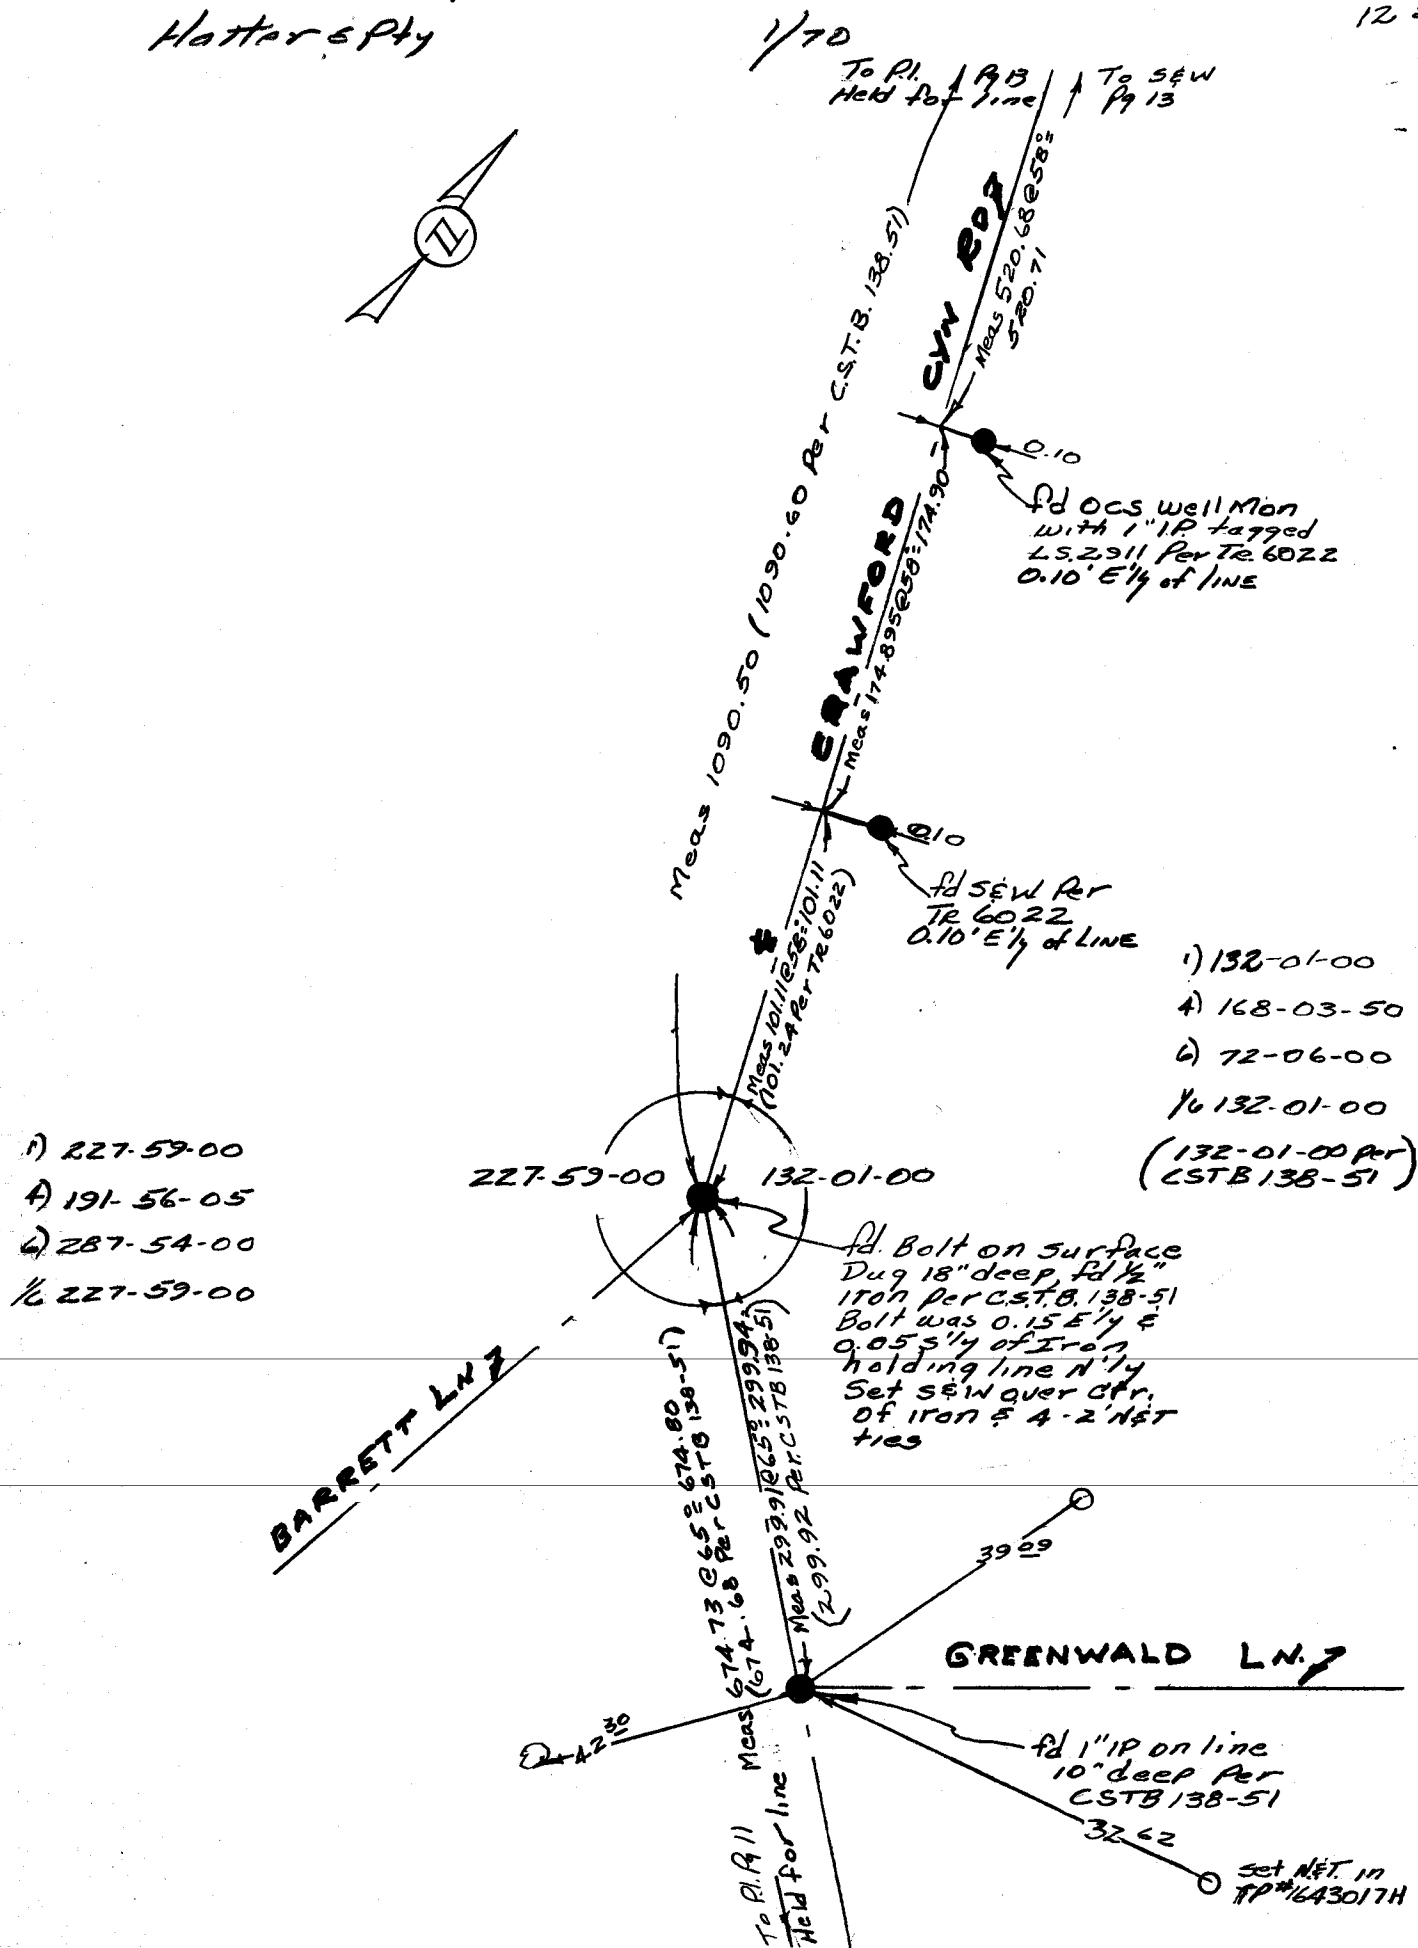

Hatter & Pty

To Random
Net P₁₄

1/70

To 5th hd Bolt
@ Chapman
Pg. 14fd 3 chis "+"
ties in IC. per
OCS N4-9, 875(12.28
(12.00)6.78
(6.77)

204-37-23

12.12
(12.12)SEW @
Pl. (No Ref)
Fits ties per
OCS A/4-9,
875

1) 155-22-30

4 261-30-20

6 212-15-25

1/6 155-22-34

1) 246-14-00

4) 264-56-25

1/4 246-14-06

DATA

Per TR 4983
 $\Delta = 25-30-00$
 $R = 1000$
 $T = 227.04$
 $L = 446.51$

CALCULATED
 $\Delta = 25-34-43$
 $R = 1000$
 $T = 227.08$
 $L = 446.43$

1) 204-37-25

4) 98-29-35

6) 147-44-15

1/6 204-37-23

1) 113-45-55

4) 95-03-20

1/4 113-45-50

1) 182-08-15

4) 8-33-15

1/4 182-08-19

1) 2-08-25

4) 8-34-00

1/4 2-08-30

1) 180-00-00

4) 0-00-00

6) 0-00-00

1/6 180-00-00

Meas 1090.51

182-08-19

180-00-00

fd OCS well mon
with 3/4" IP tagged
LS 3109 per TR 4983Meas 66.7158 58° 66.72
(66.73 per TR 4983)fd SEW on line per
TR 4983 AT
5th TR LineTo Pl. P₁₂
Held for line

Hatter & Pth

1/70

SE SANTIAGO BLVD

E CHAPMAN

6002

271-02-27

AVE 2

(1675.95 Per D. DeGroot,
10/67, 17 OCS Folder 67-21)Pl SEW per ★
OCS A/4-9 Pg 959

★ 11-19-73

← SET OCS WELL MON.
WITH 2" ALUM CAP
SET IN CONC. STAMPED
"11-73"

1) 88-57-30

4) 355-50-05

2) 173-44-55

1/2 88-57-29

(88-57-23 Per
D. DeGroot 10/67
in OCS Folder 67-21)Pl 5" Hd ★
8-12 Per
TR 4983

1-21-11 Calc

1) 271-02-25

4) 4-10-05

2) 186-14-45

1/2 271-02-27

1) 181-20-40

4) 5-22-25

2) 8-03-35

1/2 181-20-36

181-20-36

178-39-24

Pl Random N.T.
Per D. DeGroot
10/67 Filed in
OCS Folder 67-211) 181-20-20 per
D. DeGroot 10/67
Filed in OCS
Folder 67-21Meas 101.48'
6-39-22

RANDOM

Meas 419.97 @ 60° = 42000
(419.98 Per DeGroot 10/67
in OCS Folder 67-21)

179-01-56

180-58-01

1) 180-58-05

4) 3-52-10

2) 5-48-05

1/2 180-58-01
(No Ref.)Pl Random
SET Per
DeGroot 10/67
in OCS Folder
67-21Meas 5706.865 @ 58° = 70630
To SEW (No Ref.)
@ Pl Pg 13

CRAWFORD CYN RD

6900

Pl 3/4" I.P.E
Nail on line
Per Calc.,
2" deep
No Ref.

1) 6-39-20

2) 13-18-45

1/2 6-39-22

1) 179-01-50

4) 356-07-40

2) 354-11-35

1/2 179-01-56

To SEW Pl.
See Pg 13

To Pl. Pg 13