

SCALE 1" = 60'

RECORD OF SURVEY

OF PARCELS SHOWN BELOW

SHEET 1 OF 1 SHEETS


THIS MAP CORRECTLY REPRESENTS A SURVEY MADE UNDER MY DIRECTION IN CONFORMANCE WITH THE REQUIREMENTS OF THE BUSINESS AND PROFESSIONS CODE, CHAPTER 15, DIVISION 3 AT THE REQUEST OF THE CITY OF GARDEN GROVE AND COTTER CORP.

Frank W. Richardson
FRANK W. RICHARDSON, "L.S. 2921"

THIS MAP HAS BEEN EXAMINED FOR CONFORMANCE WITH THE REQUIREMENTS OF CHAPTER 15, DIVISION 3, OF THE BUSINESS AND PROFESSIONS CODE, THIS 7TH DAY OF JAN 1963, 1963


Robert V. Wise
DEPUTY COUNTY SURVEYOR

4674 INDEXED JAN 7 1963
FILED FOR RECORD TIME DAY OF
AT 3:40 P.M. IN BOOK 62 PAGE 5
OF RECORDS OF SURVEYS, COUNTY OF ORANGE,
CALIFORNIA
COUNTY SURVEYOR
AT REQUEST OF RUBY McFARLAND, County Recorder
\$5.00

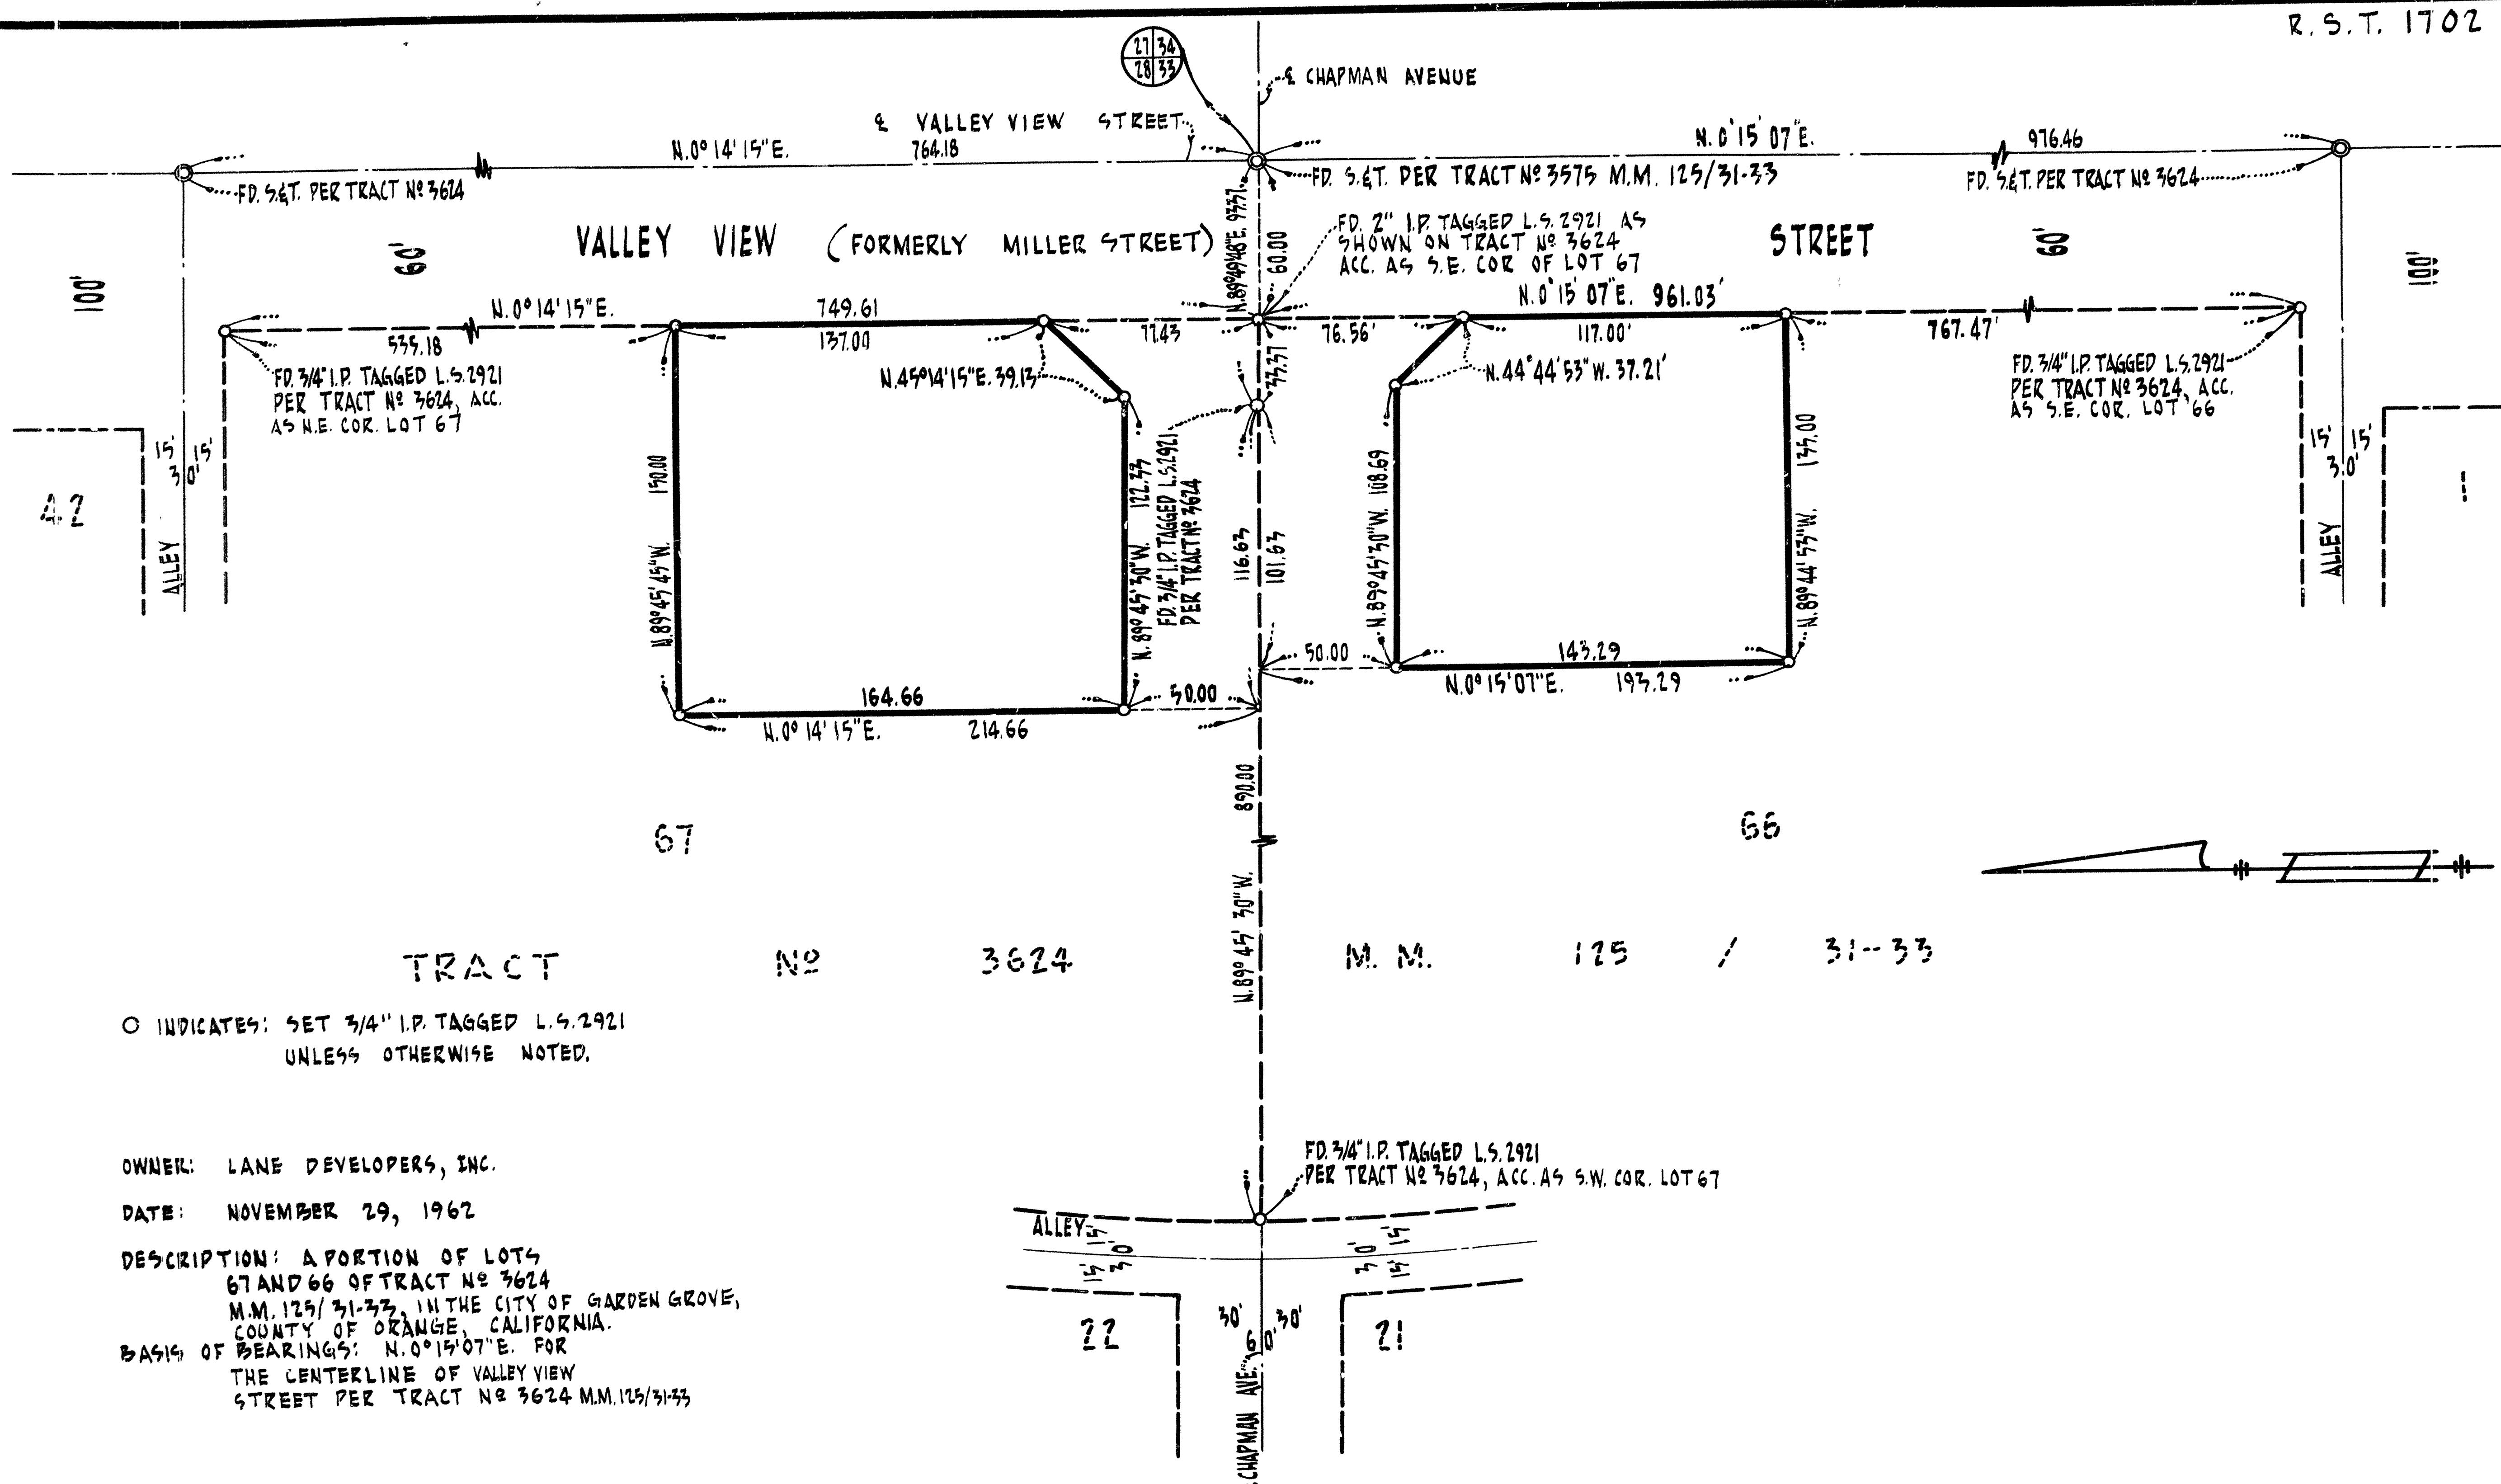

6-199

R. S. T. 1703

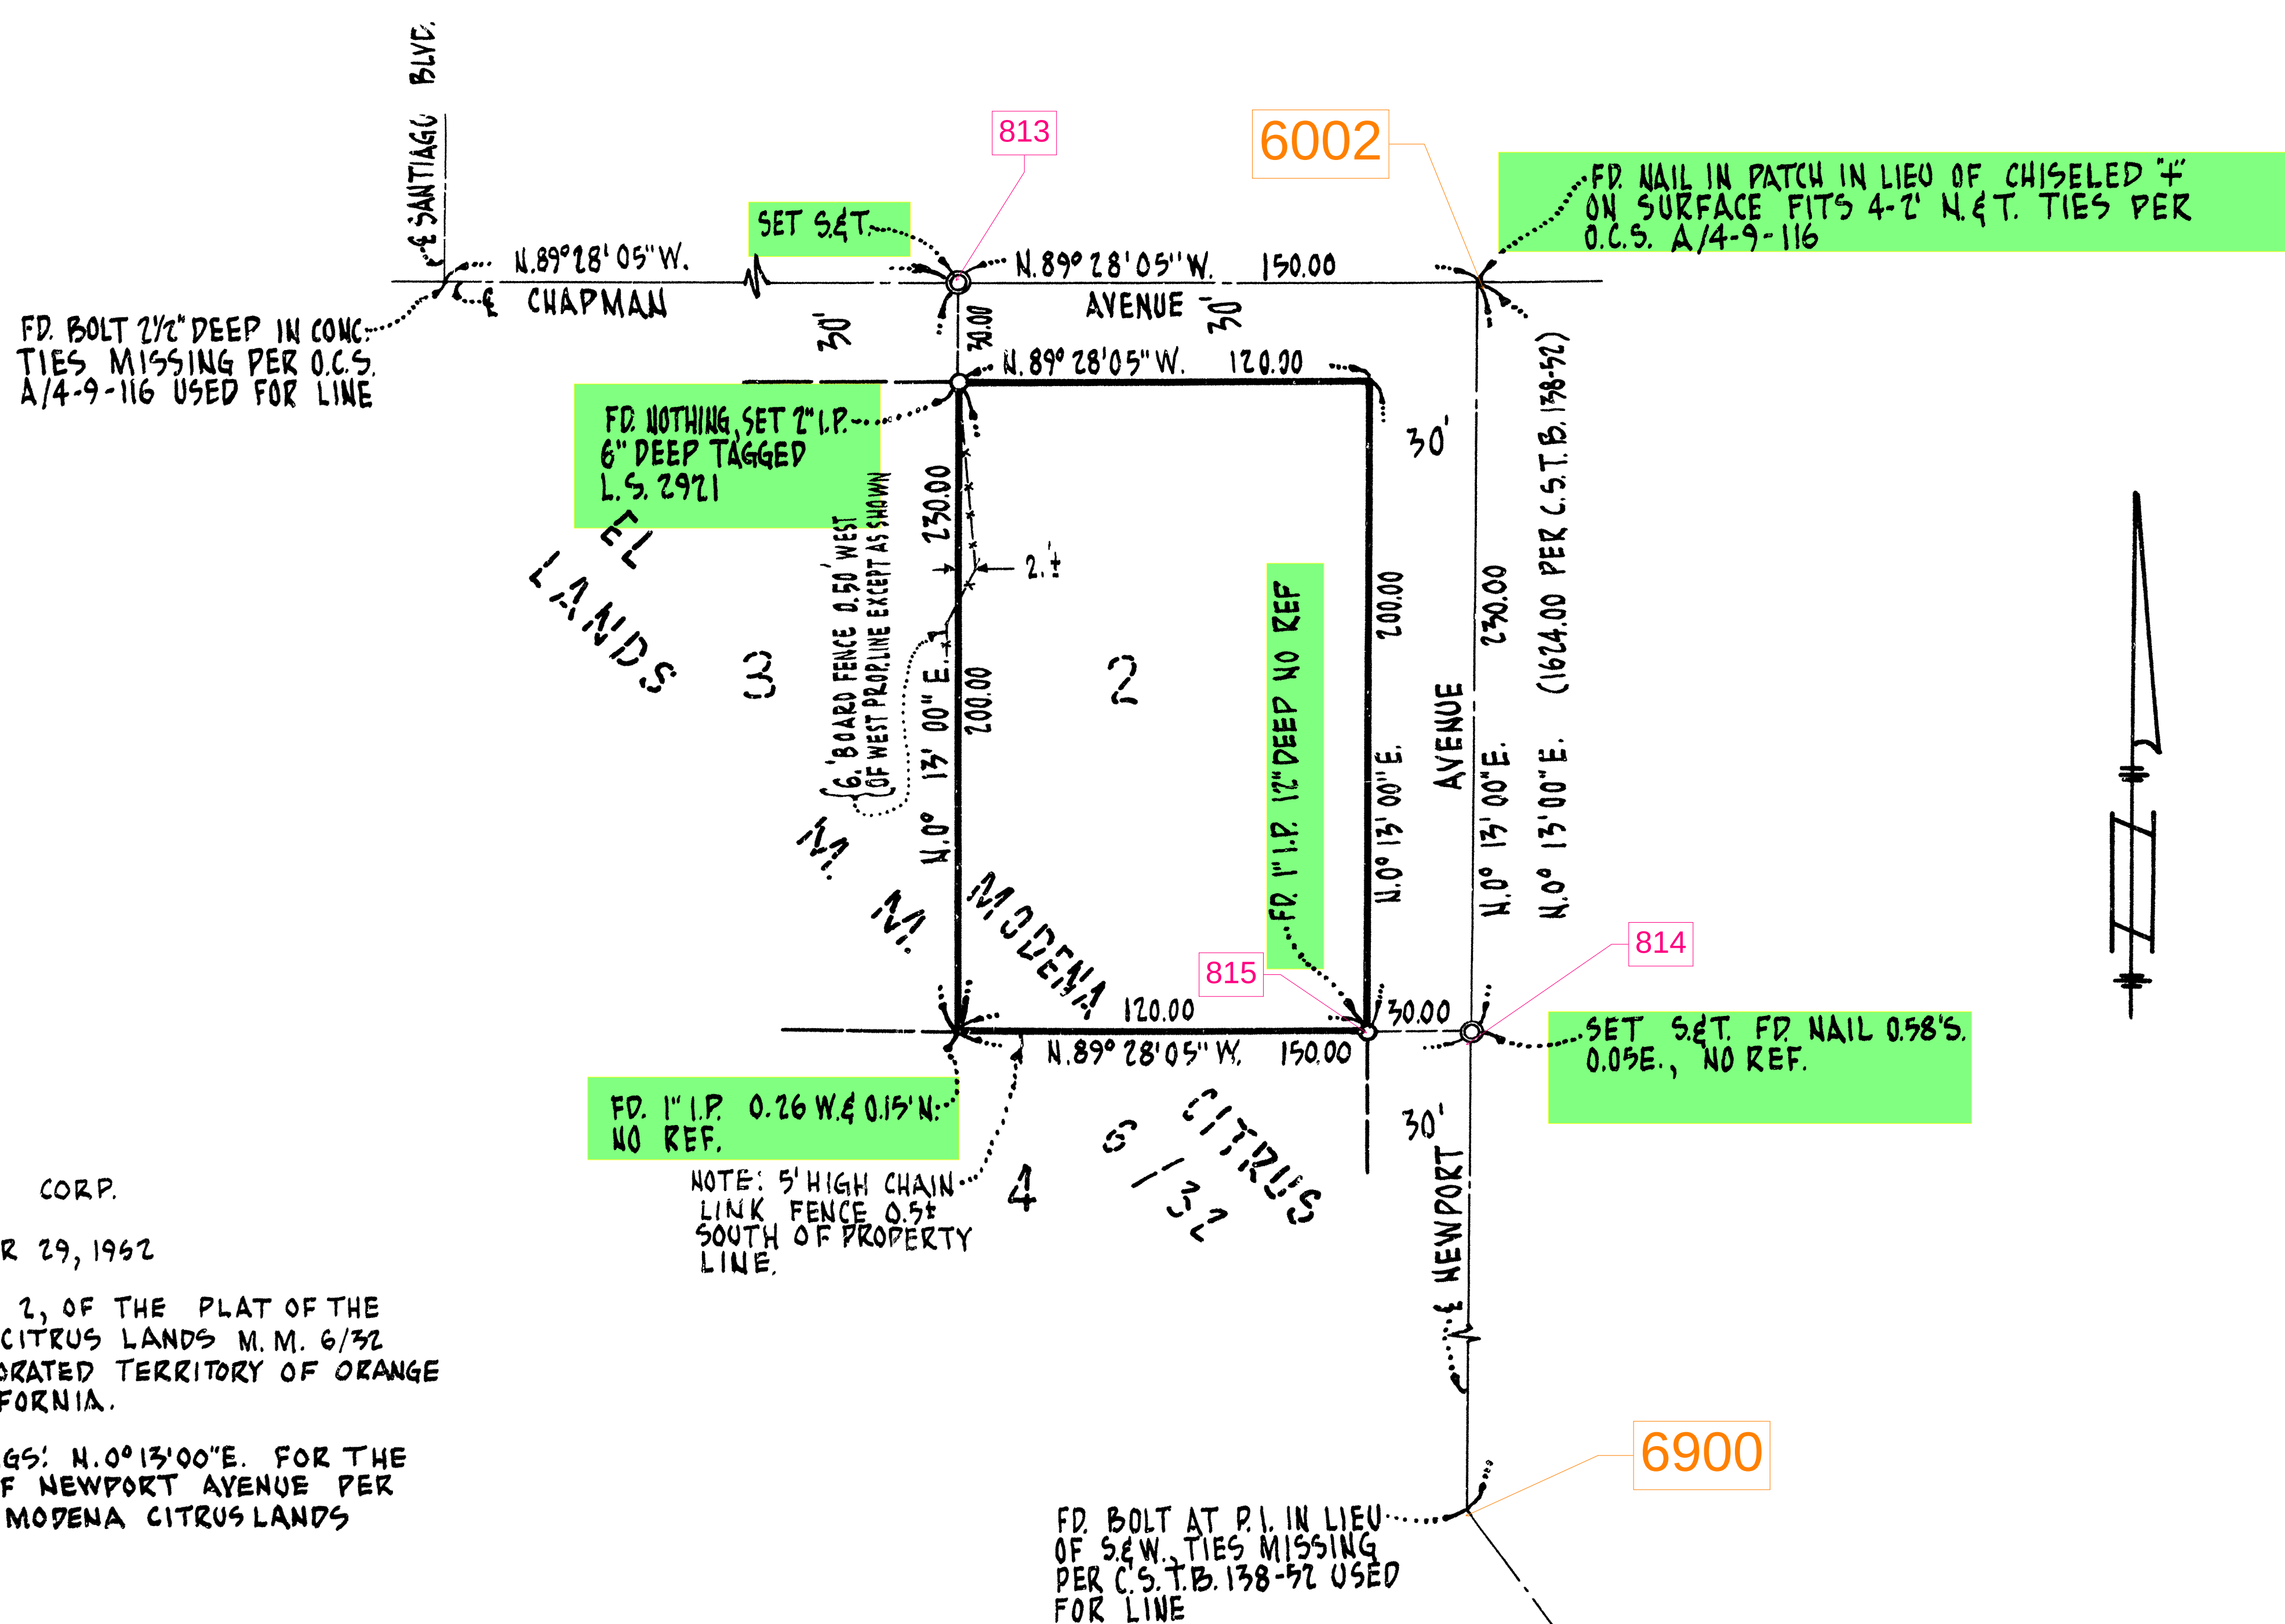

OWNER: COTTER CORP.

DATE: NOVEMBER 29, 1962

DESCRIPTION: LOT 2, OF THE PLAT OF THE EL MODENA CITRUS LANDS M.M. 6/32 IN UNINCORPORATED TERRITORY OF ORANGE COUNTY, CALIFORNIA.

BASIS OF BEARINGS: N.0°13'00\"/>

W.O. 1921