

RECORD OF SURVEY

PARCELS SHOWN BELOW, GIVING OWNERS NAME, LOCATION, SCALE AND DATE.

I, John M. Hoy, hereby certify that I am a Licensed Land Surveyor in the State of California, No 8326; that these maps represent surveys made under my supervision at the request of the owners; that all monuments shown actually existed at the time of the surveys and their positions are correctly shown.

John M. Hoy
Licensed Surveyor.

Examined and Approved this 24 day of Sept 1956.

Owen Vineyard
Deputy County Surveyor

SURVEY OF A PORTION OF LOT 15, EL MODENA CITRUS LANDS AS PER MAP RECORDED IN BOOK 6 PAGE 32 MISCELLANEOUS MAPS, RECORDS OF ORANGE COUNTY, CALIFORNIA.



OWNER: K. W. KOLL

DATE: AUGUST, 1956.

SCALE: 1" = 50'

Bearings are based on NEWPORT AVENUE being S25°23'E as shown on R/S 20-8.

A 3/4" Iron Pipe, bearing copper tag marked L.S. 2326, set at all corners, unless otherwise indicated

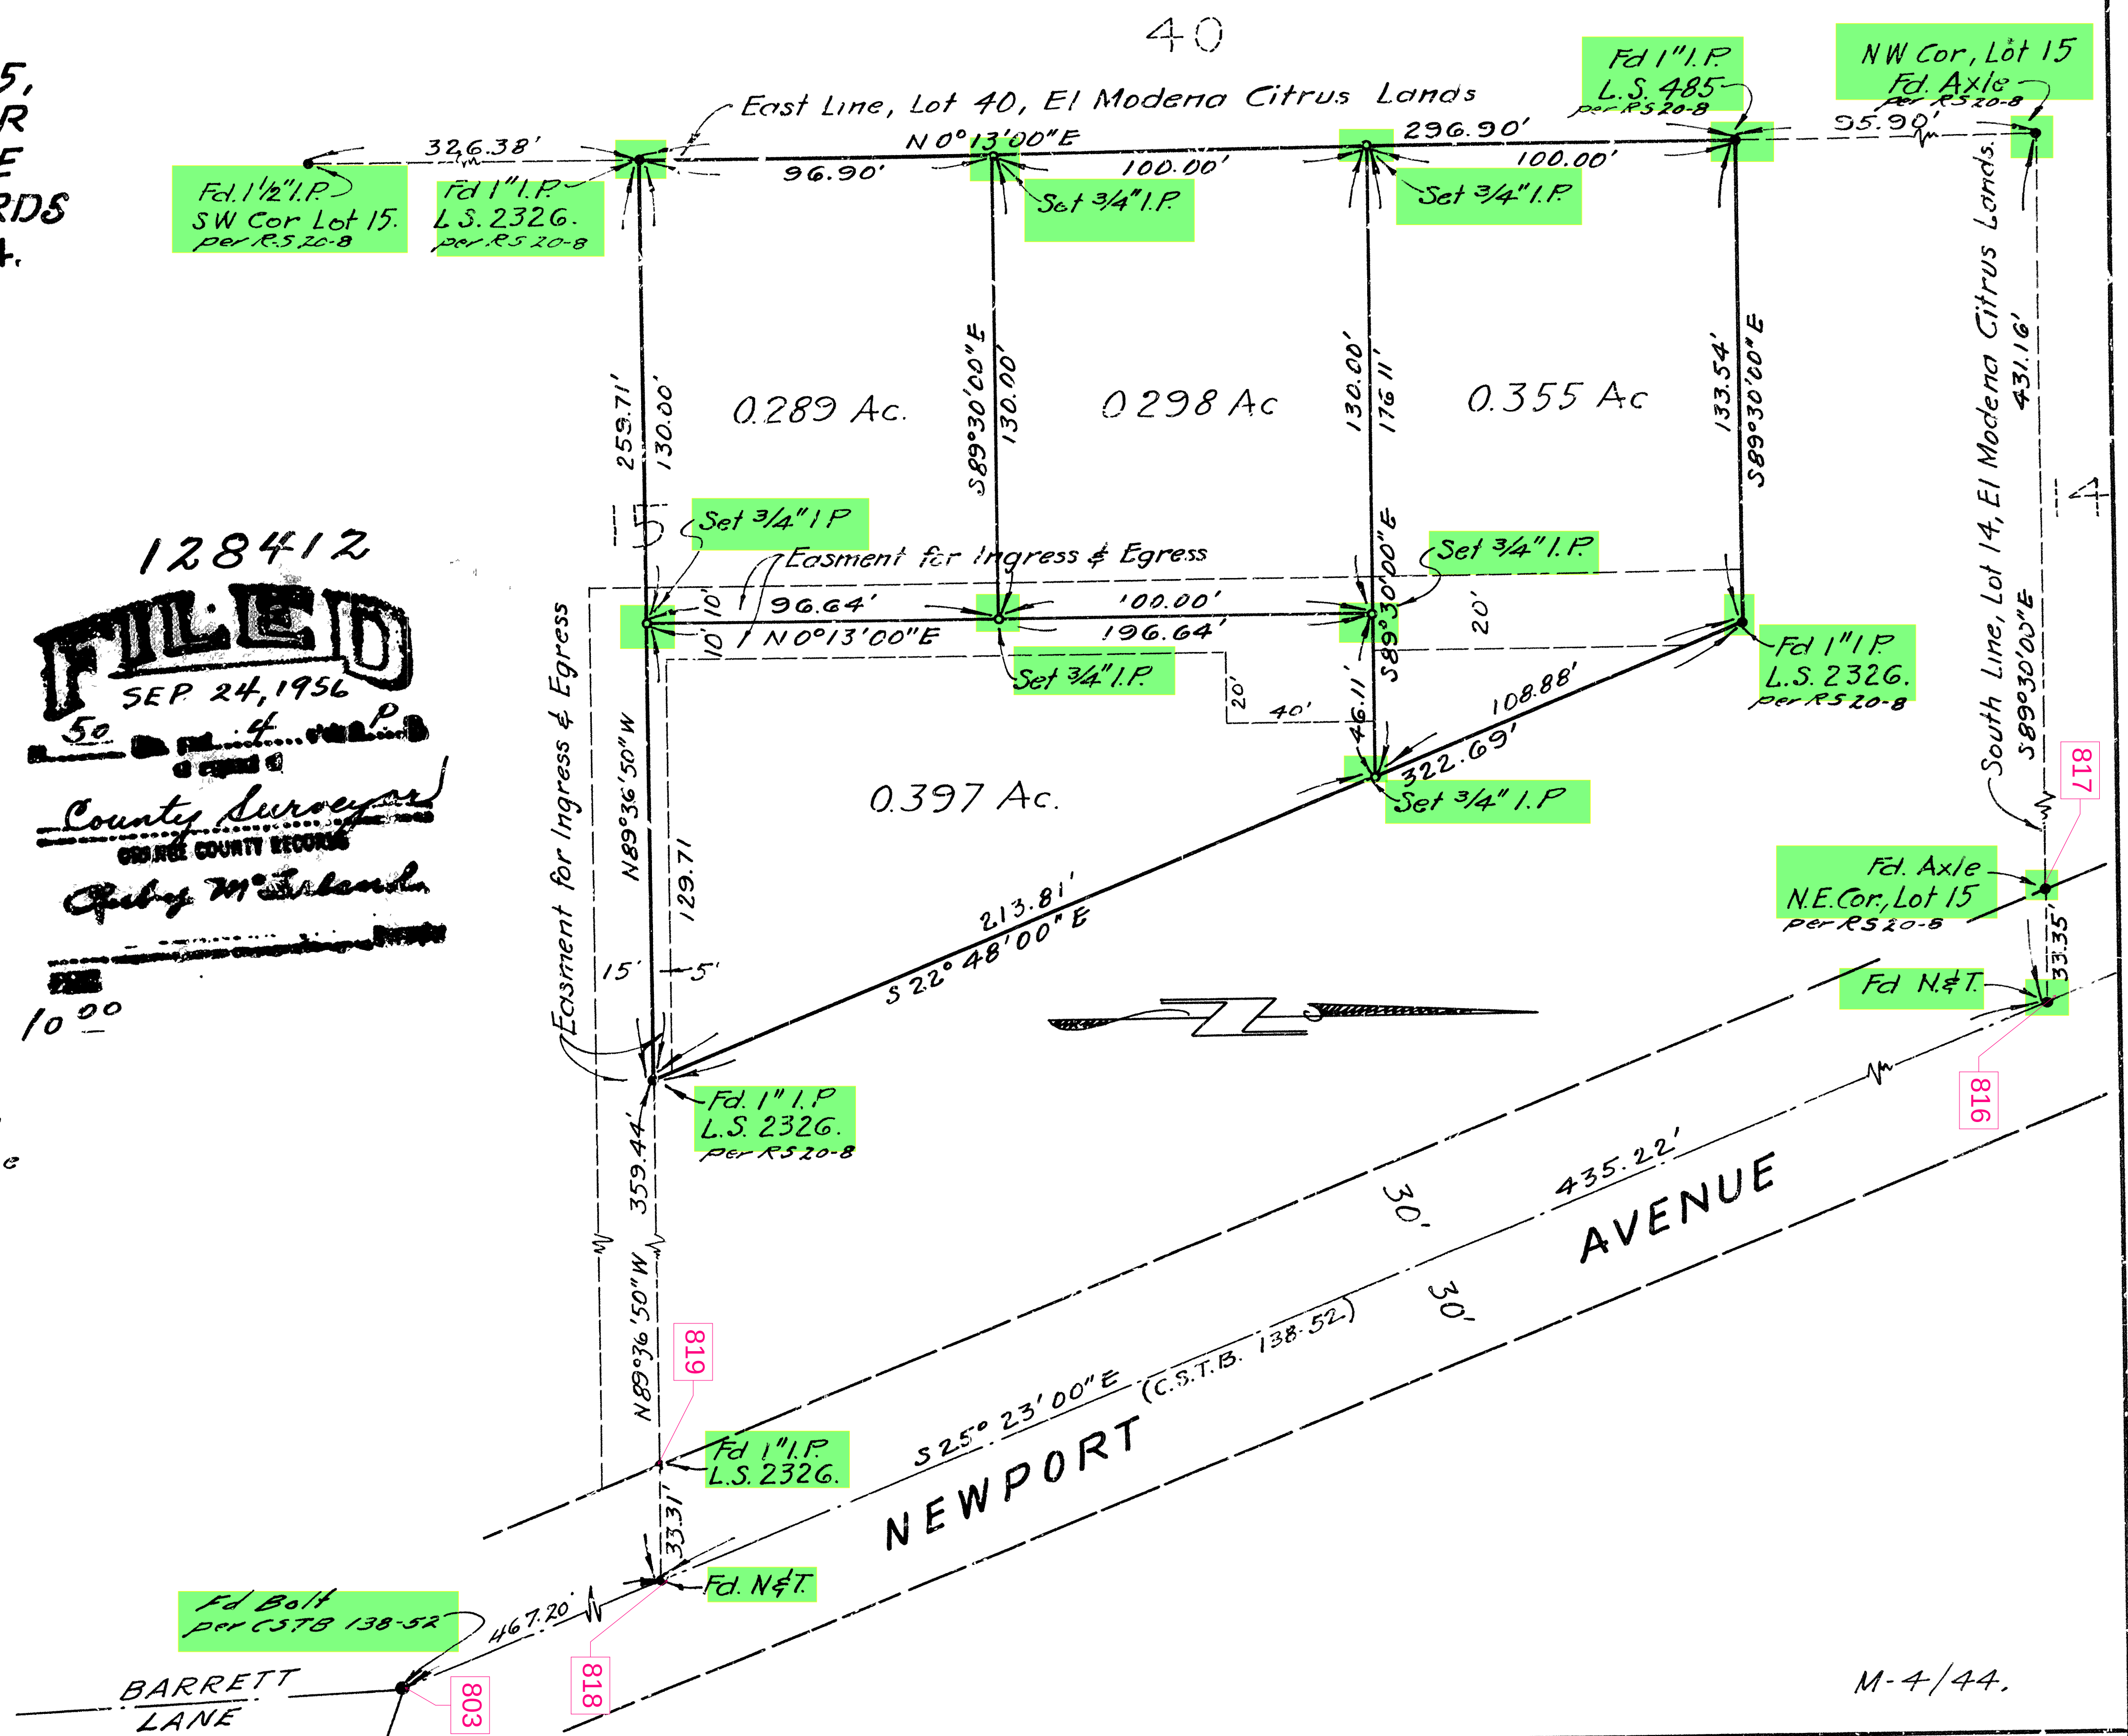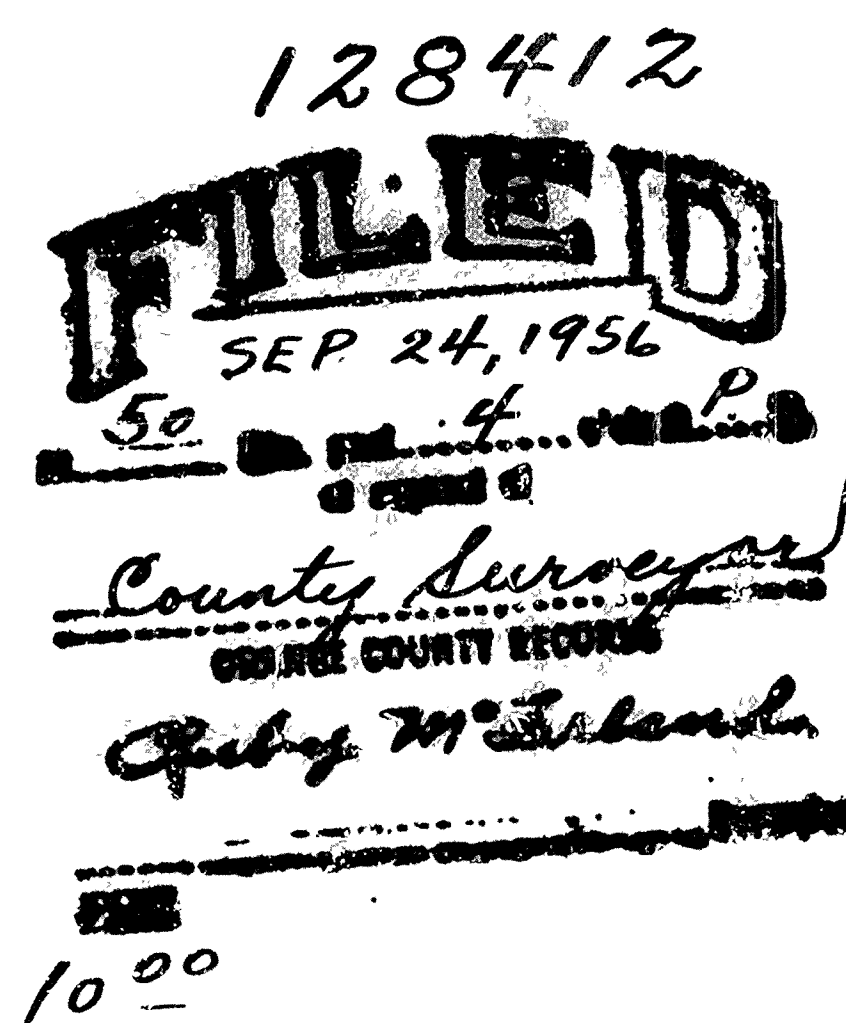

SURVEY OF A PORTION OF BLOCKS 86, 85, & 84 OF THE FIRST ADDITION TO FAIRVIEW, M.R. 29/95, L.A. CO. AND PORTION OF BLOCK A OF FAIRVIEW TRACT, M.R. 25/77, L.A. CO., IN ORANGE COUNTY, CALIFORNIA.

SCALE: 1" = 150'

AUGUST, 1956.

OWNER: C.J. SEGERSTROM & SONS.

