

20-8

26958

20-8

JUN 25 1948
15 Min. past 10 o'clock A.M.
at request of
W. H. Hillyard
ORANGE COUNTY RECORDS
Subscribed and sworn to before me
Recorder

RECORD OF SURVEY

PARCELS SHOWN BELOW GIVING NAME
OF OWNERS, LOCATION AND DATE.

I, John M. Hoy, do hereby certify that I am a Licensed Surveyor in the State of California, "No. 2326", and that these maps correctly represent surveys made under my direction at the request of the owners, and that all monuments shown thereon actually exist and their positions are correctly shown.

John M. Hoy
Licensed Surveyor

300
Examined and approved this 24th day of June, 1948.

W. H. Hillyard
County Surveyor

SURVEY OF A PORTION OF LOT 15, EL MODENA CITRUS LANDS AS PER MAP RECORDED IN BOOK 6 PAGE 32 MISCELLANEOUS MAPS, RECORDS OF ORANGE COUNTY, CALIFORNIA.


Owner - C. F. DURLING

April 2, 1948.

Bearings are based on the Easterly line of Lot 15 of El Modena Citrus Lands, Miscellaneous Maps 6-32.

Set 1" pipe at all corners marked "o" unless marked otherwise.

All monuments set have a copper disk marked L.S. 2326.

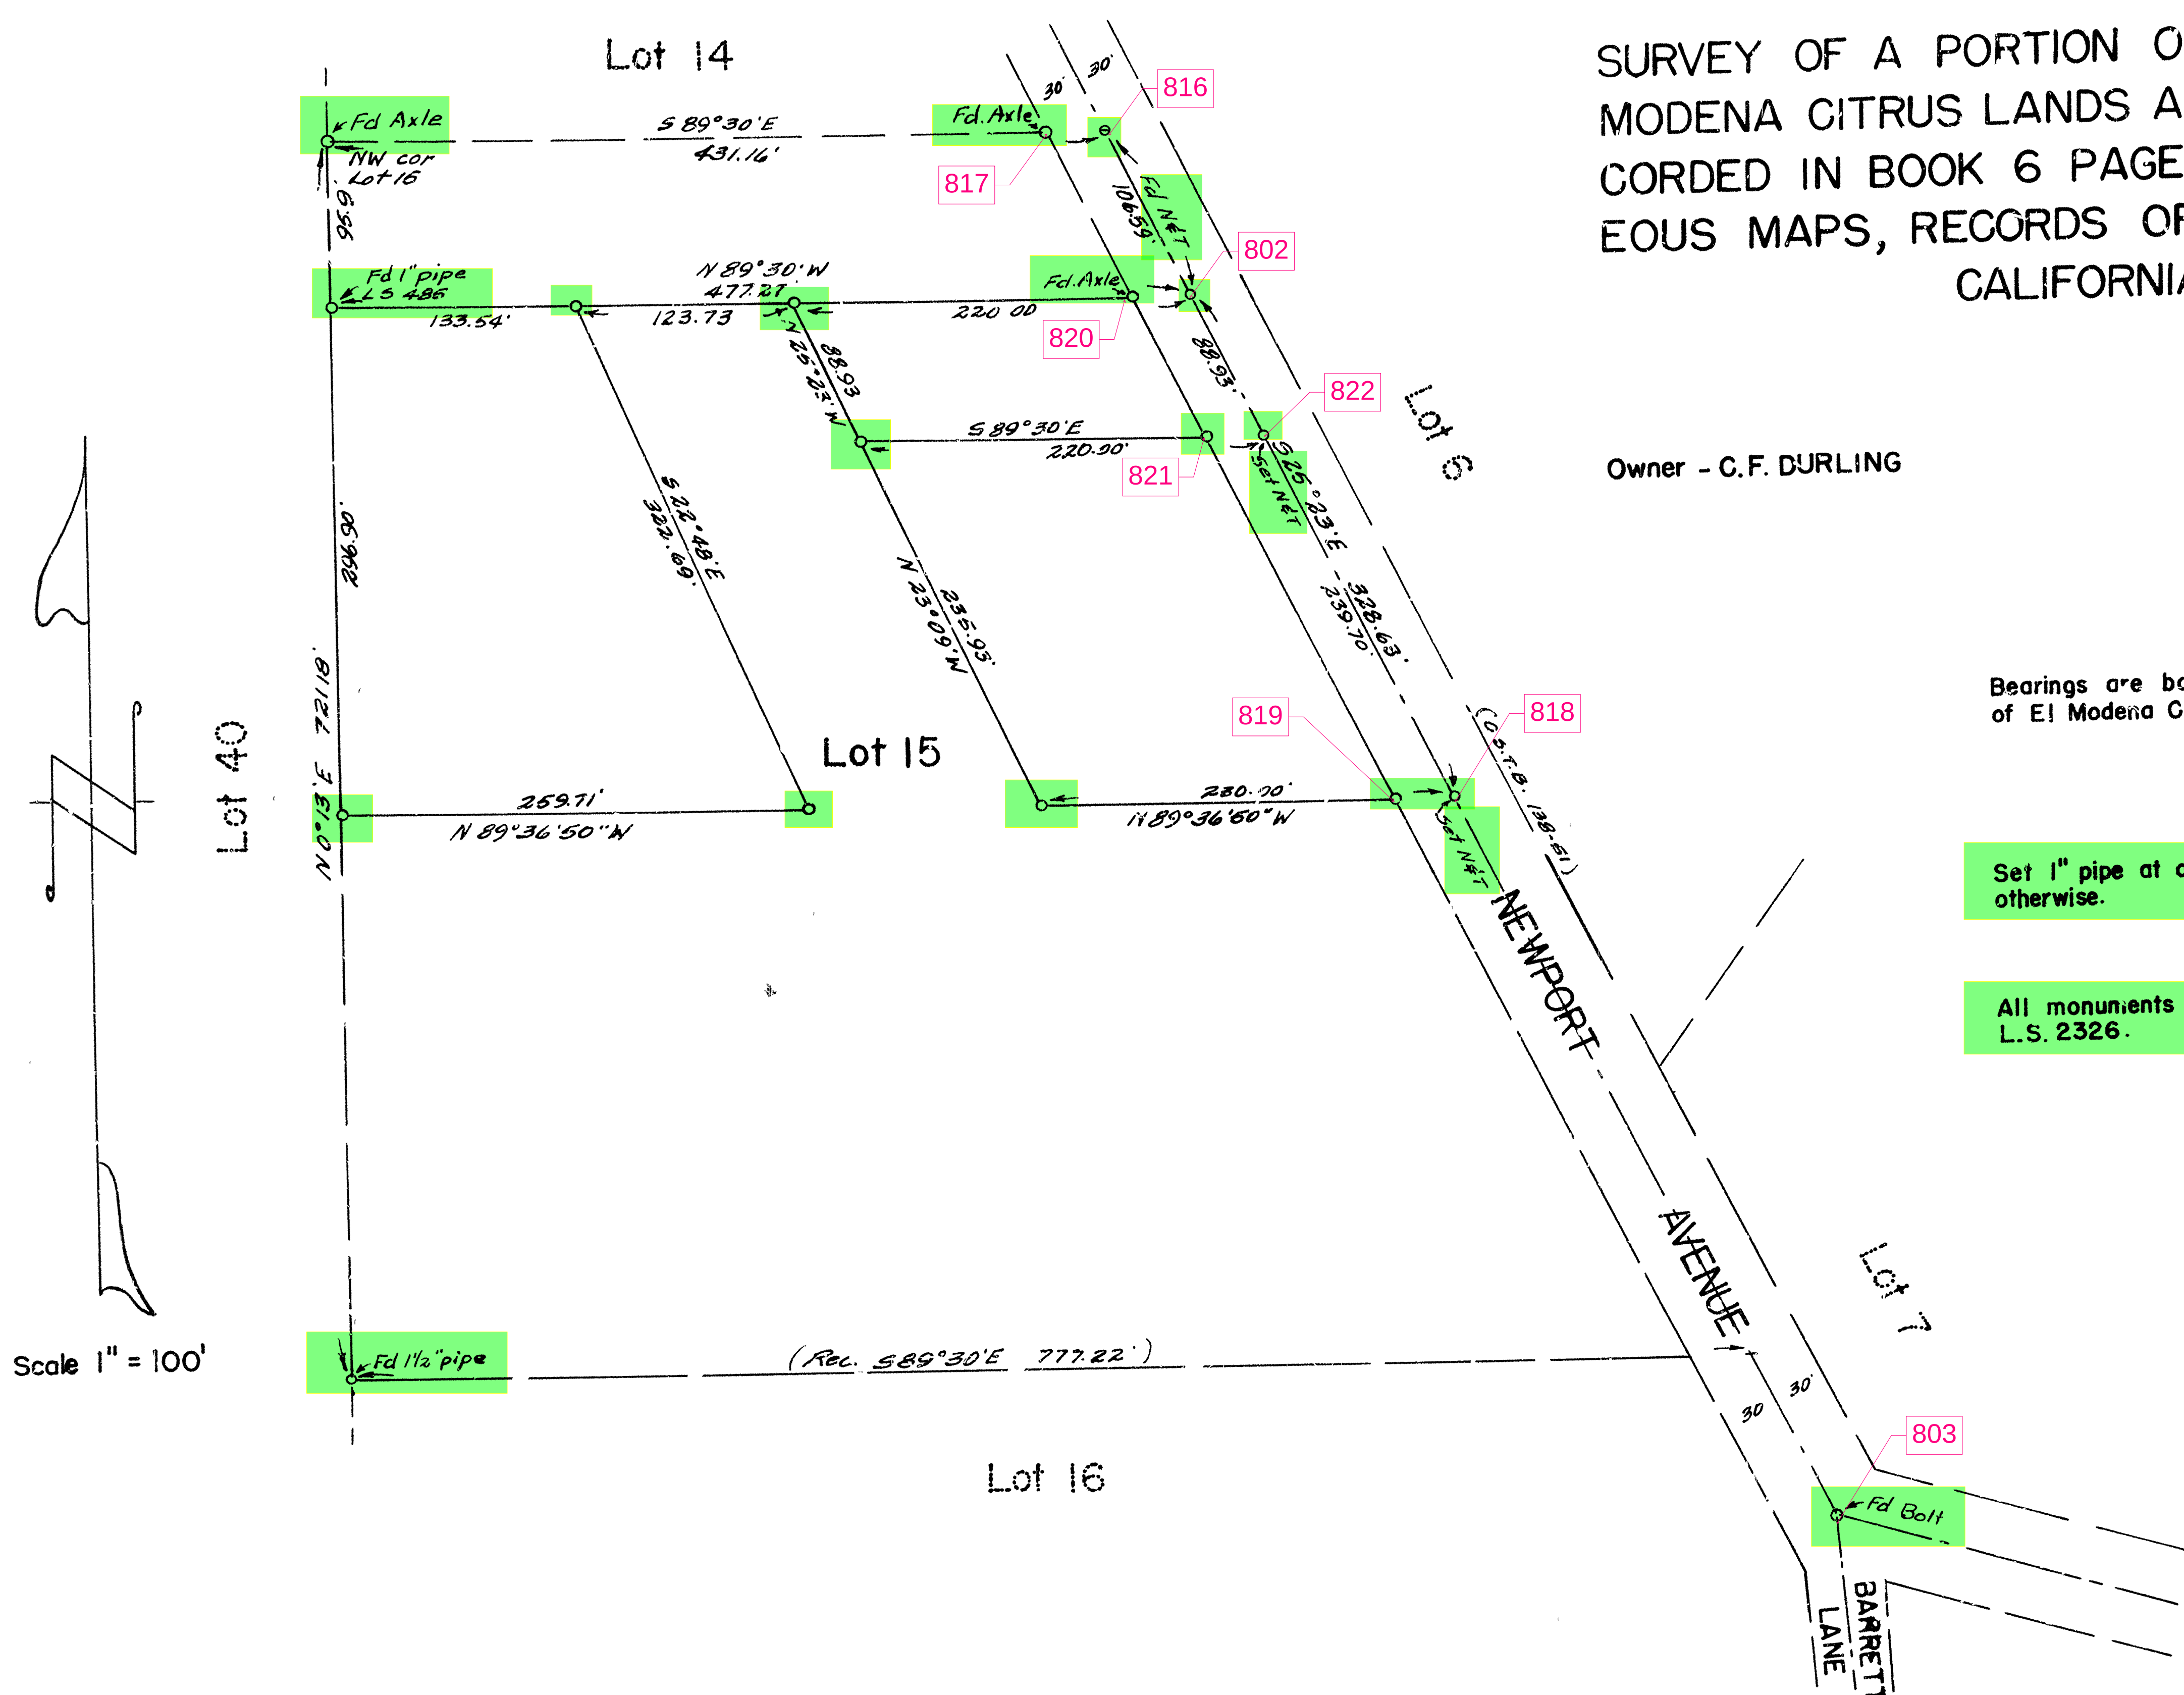

A3-5


SURVEY OF THE WEST ONE-HALF OF THE SOUTHEAST ONE-QUARTER OF THE SOUTHEAST ONE-QUARTER OF SECTION 19, T.5S., R.10W., S.B.B.&M.

Owner - S.L. Seward

April 28, 1948.

Bearings are based on Wintersburg Avenue being N 87° 34' 20" E as shown on R.S. 6-44.

All monuments set have a copper disk marked L.S. 2326.

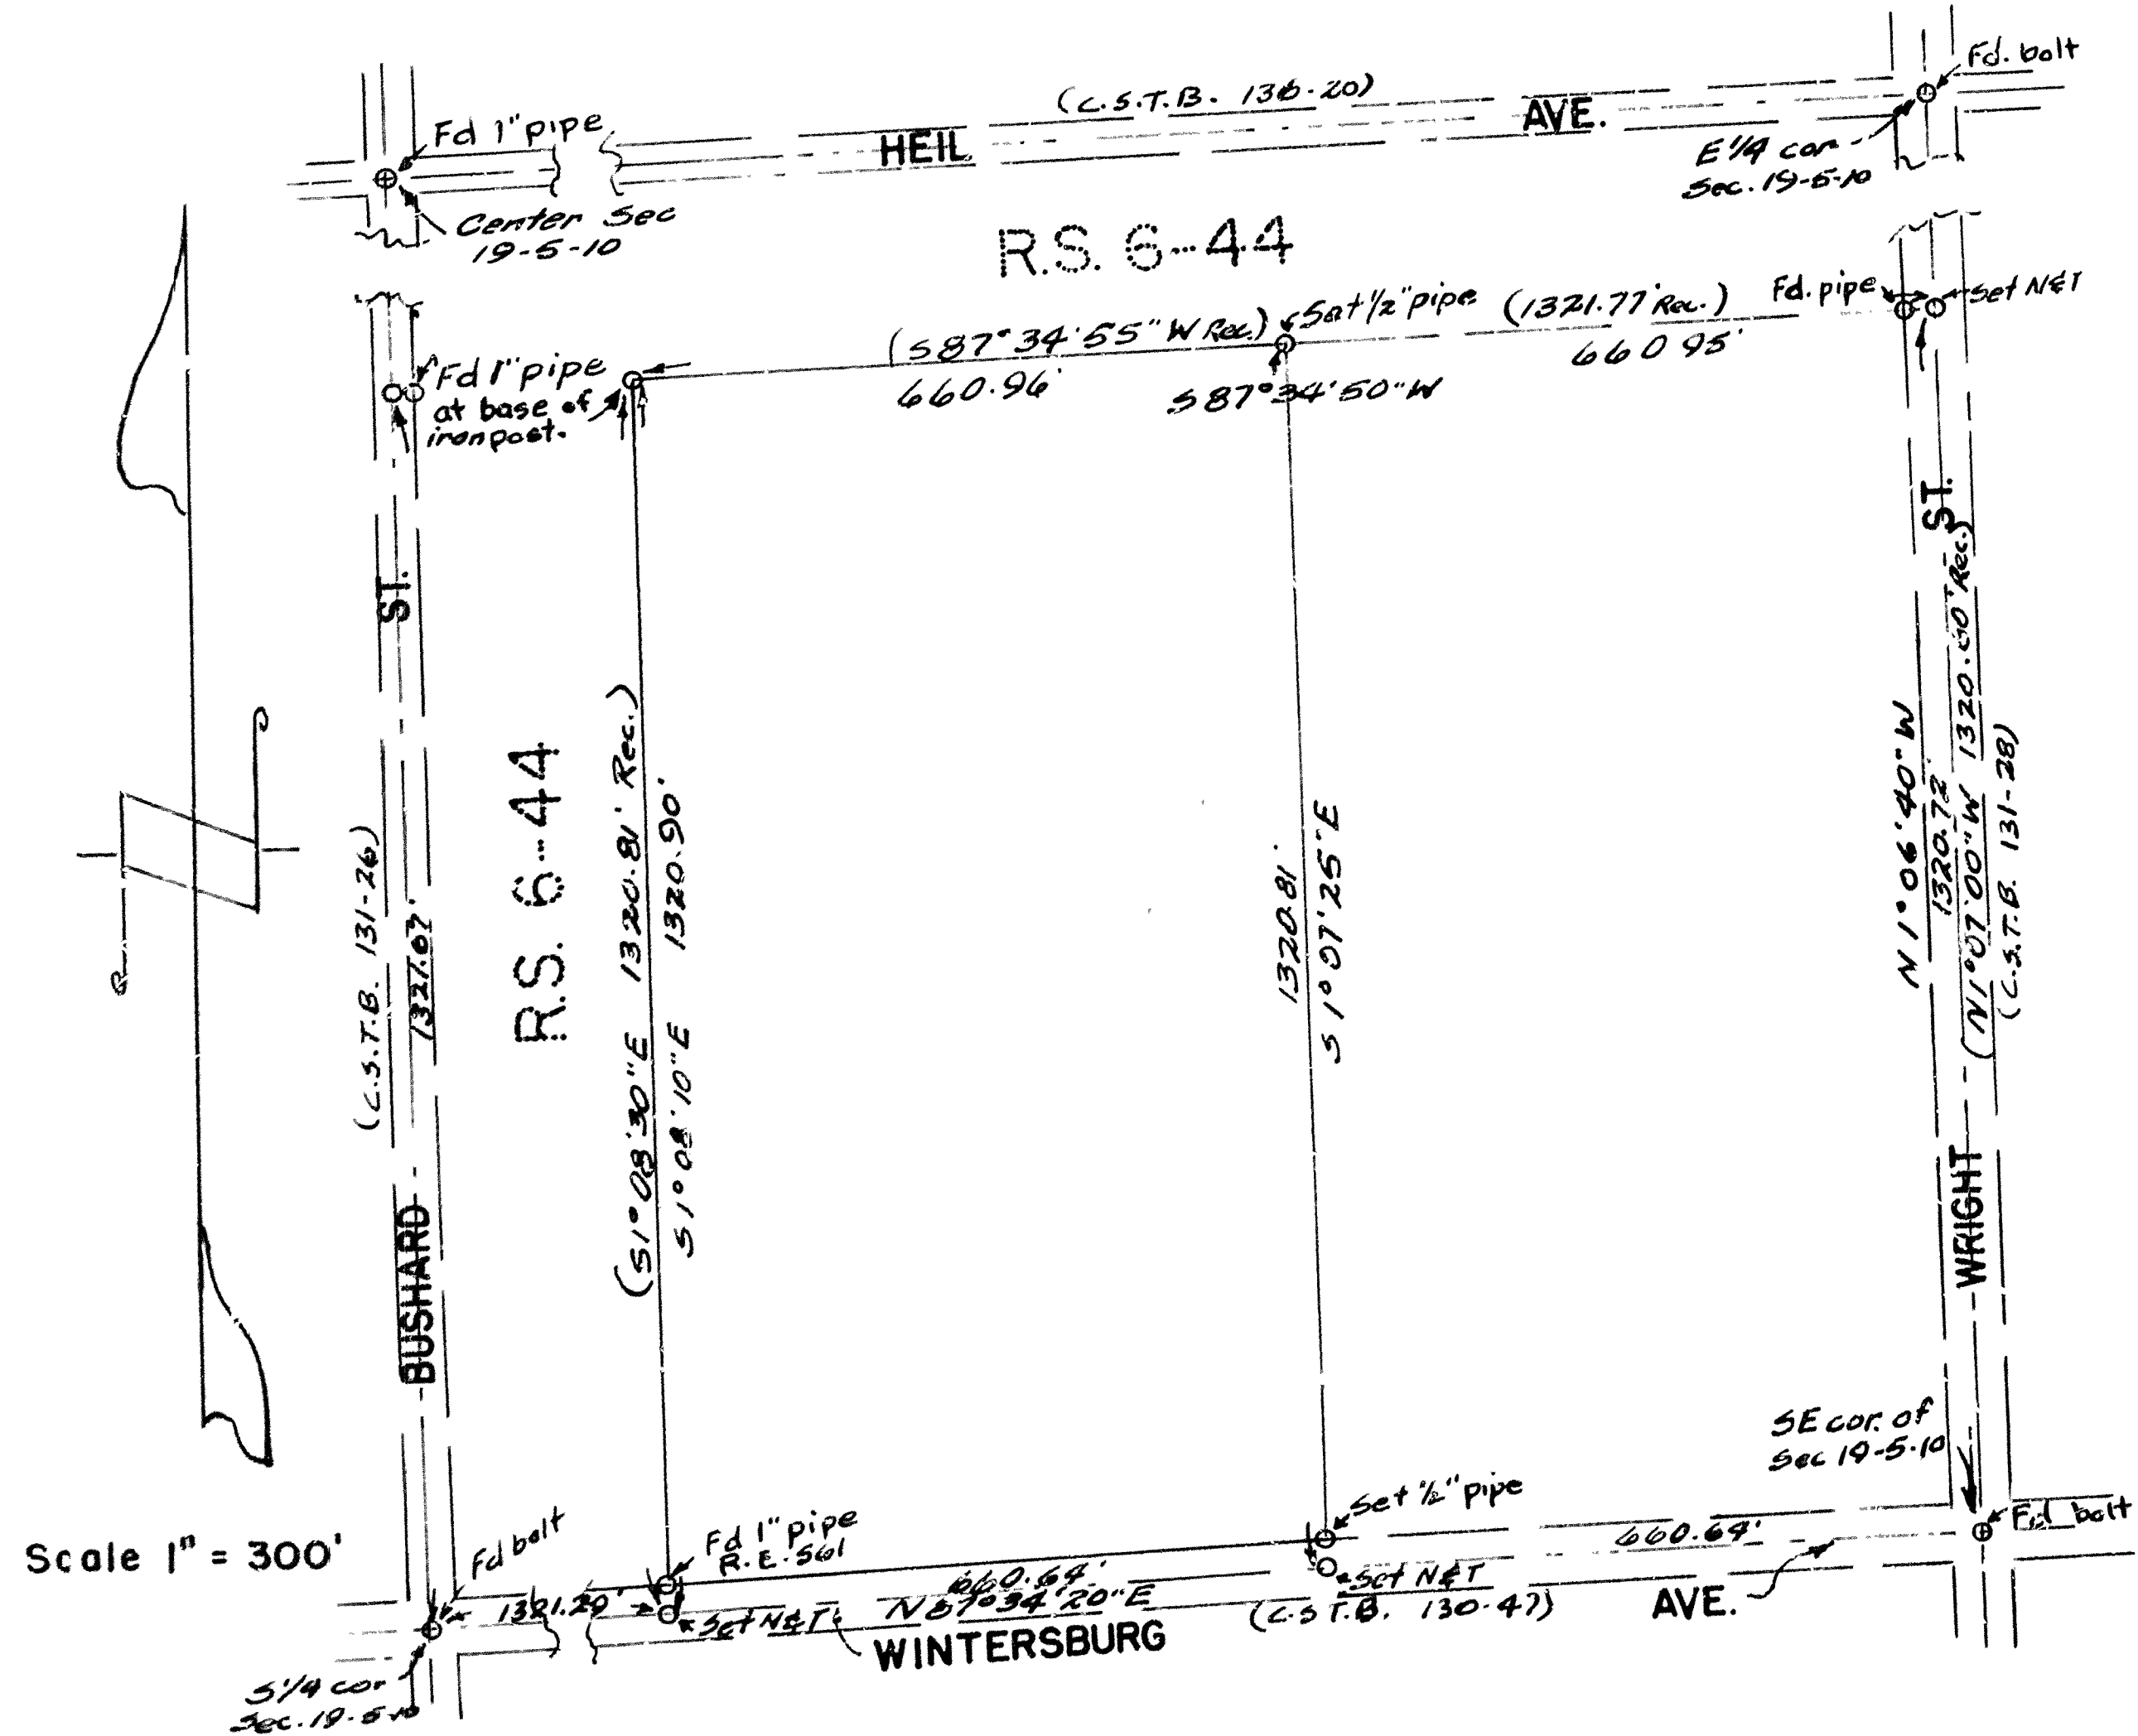

A3-18

SURVEY OF THE WEST 320.20 FEET OF THE SOUTH 10 ACRES OF THE WEST ONE-HALF OF THE NORTHWEST ONE-QUARTER OF THE SOUTHEAST ONE-QUARTER OF SECTION 31, T.4S., R.10W., S.B.B.&M.


Owner - T. E. Forney

March 25, 1948

Bearings are based on GILBERT AVENUE being N 0° 23' 30" W as shown on R.S. 13-II.

Set 1" pipe at all corners marked "o" unless marked otherwise.

All monuments set have a copper disk marked L.S. 2326.

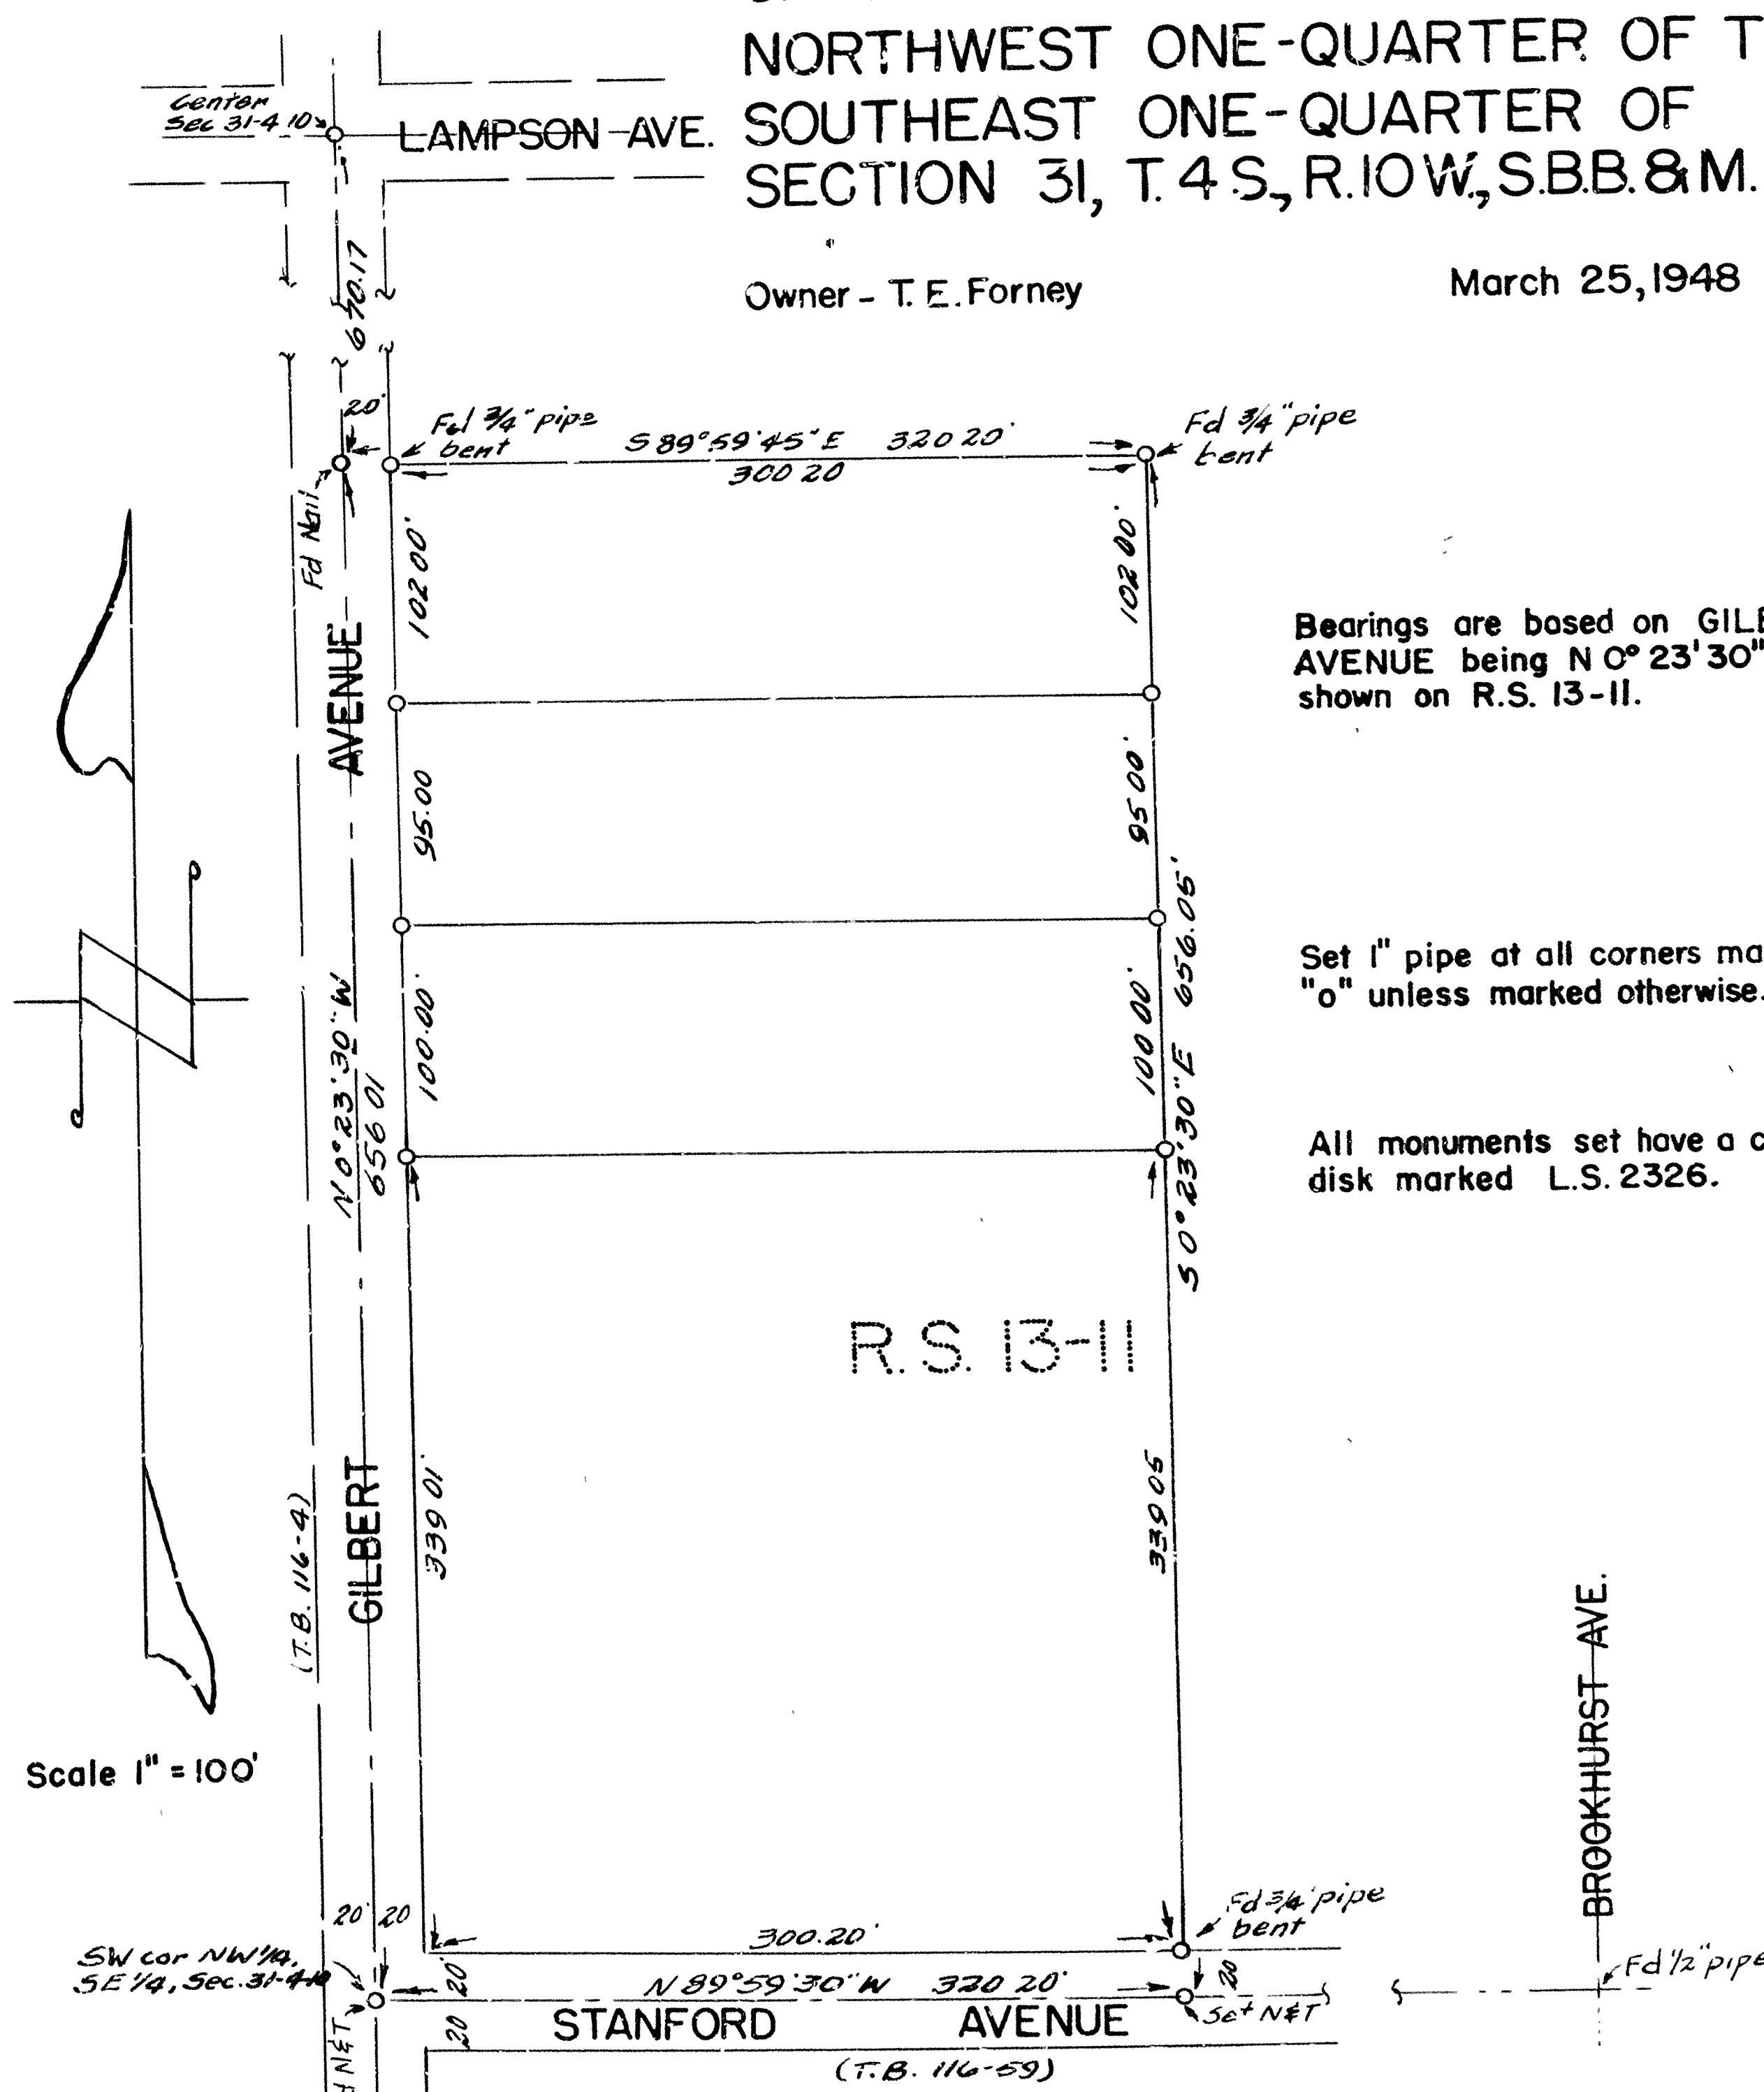

A3-2

20-8