

MANHOLE DETAIL:

JOB NO: EQ19810S

DATE: 5/24/2021

CREW: Russo/Cummins

STREET: Yorba



TIME: _____ AM / PM

MANHOLE TYPE: SD

LID POINT NO: 24131

PHOTO NO: _____

PIPE MATERIAL: RCP

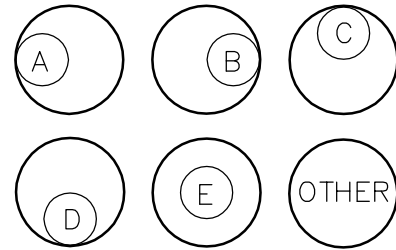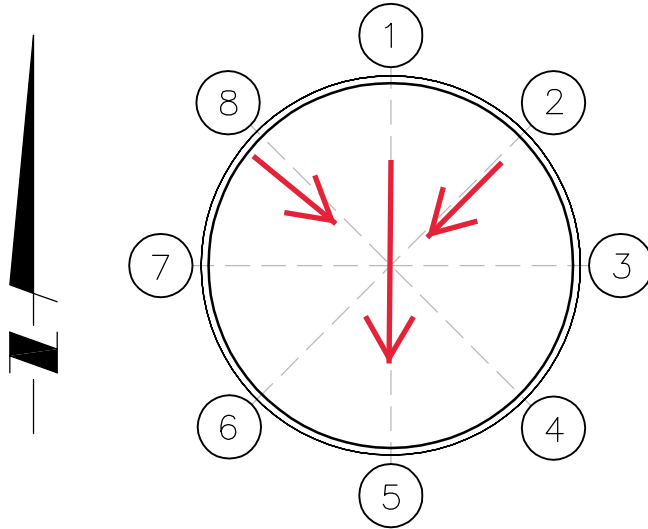

RIM OFFSET TYPE: B

POINT:	RIM ELEV:	INVERT:	F.L. ELEV:	PIPE DIA:	
1					WET / DRY
2		-8.99	180.67	36"	WET / DRY
3					WET / DRY
4					WET / DRY
5					WET / DRY
6					WET / DRY
7					WET / DRY
8		-8.90	180.76	36"	WET / DRY
CNTR:	189.66	-9.32	180.34	48"	WET / DRY