

MANHOLE DETAIL:

JOB NO: EQ19810S

DATE: 5/26/2021

CREW: Russo/Cummins

STREET: Prospect Ave.



TIME: _____ AM / PM

MANHOLE TYPE: SD

LID POINT NO: 24561

PHOTO NO: _____

PIPE MATERIAL: RCP

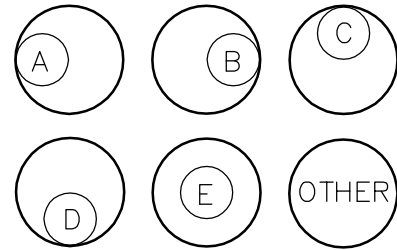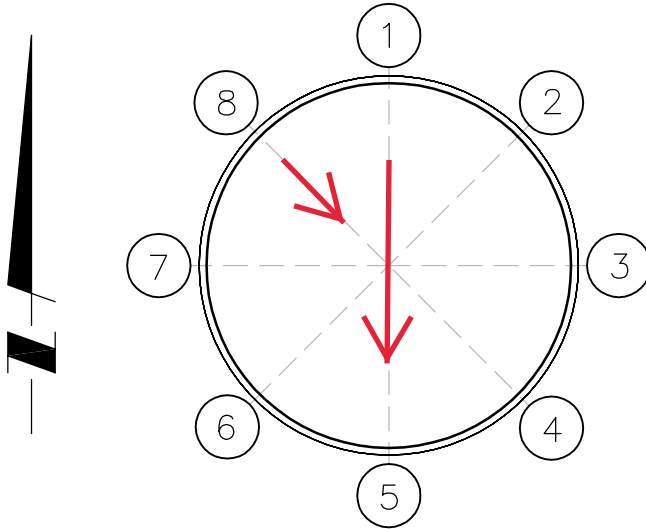

RIM OFFSET TYPE: A

POINT:	RIM ELEV:	INVERT:	F.L. ELEV:	PIPE DIA:	
1	_____	_____	_____	_____	WET / DRY
2	_____	_____	_____	_____	WET / DRY
3	_____	_____	_____	_____	WET / DRY
4	_____	_____	_____	_____	WET / DRY
5	_____	_____	_____	_____	WET / DRY
6	_____	_____	_____	_____	WET / DRY
7	_____	_____	_____	_____	WET / DRY
8	_____	-14.44	198.00	54"	WET / DRY
CNTR:	212.44	-14.64	197.80	60"	WET / DRY