



EL MODENA CHANNEL (F07) 225+99.83

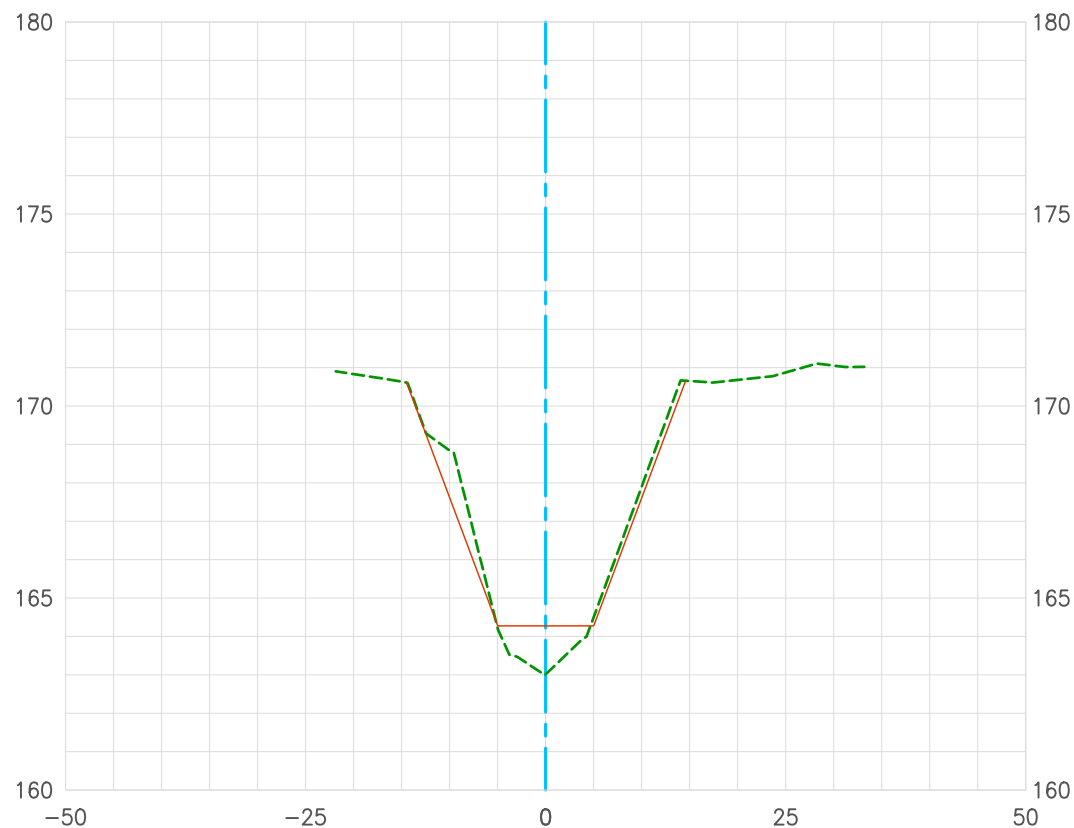

Topography Survey (2019)
Record As-Built Plan F07-101-4A (1960)
Construction Centerline
Date Prepared: 05/08/2019

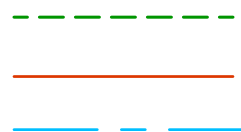


Horizontal Scale: 1"=20'
Vertical Scale: 1"=5'

**U.S. Survey
Foot**


OC Public Works/Engineering Services
OC Survey/Field Services
Boundary Analysis & Mapping



EL MODENA CHANNEL (F07) 226+50.00

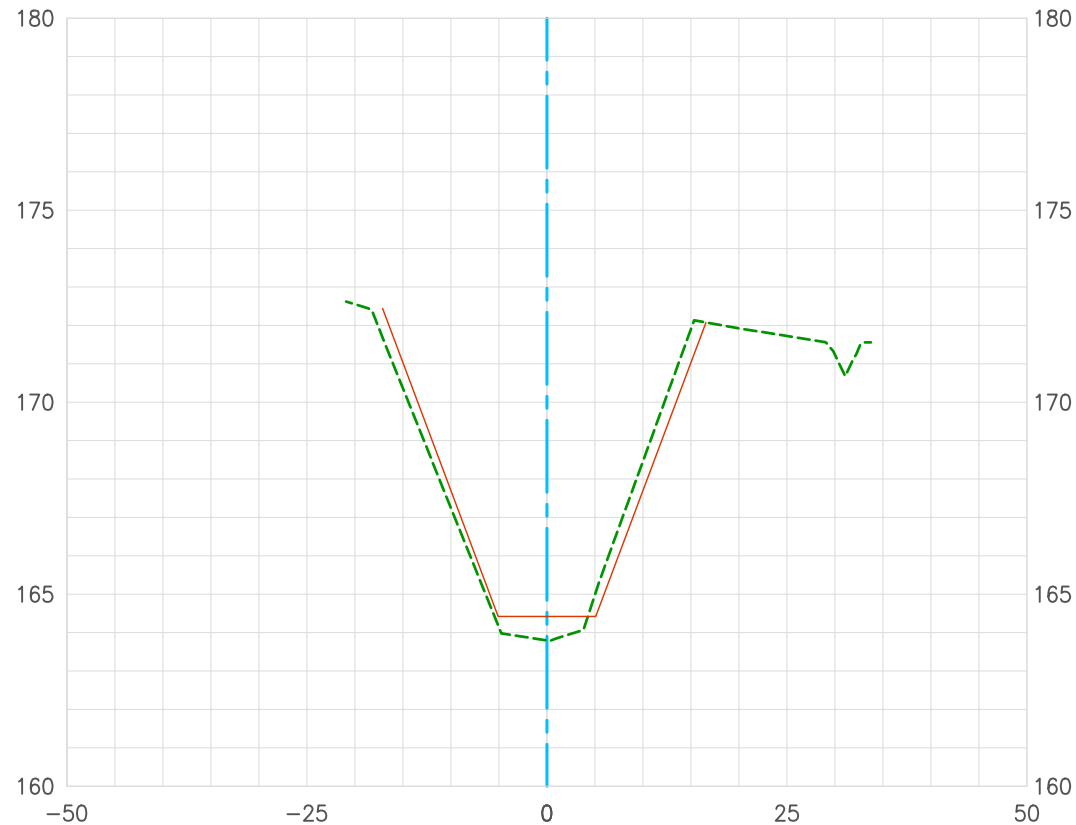

Topography Survey (2019)
Record As-Built Plan F07-101-4A (1960)
Construction Centerline
Date Prepared: 05/08/2019

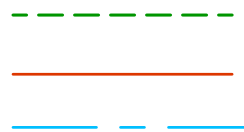


Horizontal Scale: 1"=20'
Vertical Scale: 1"=5'

**U.S. Survey
Foot**


OC Public Works/Engineering Services
OC Survey/Field Services
Boundary Analysis & Mapping



EL MODENA CHANNEL (F07) 227+00.00

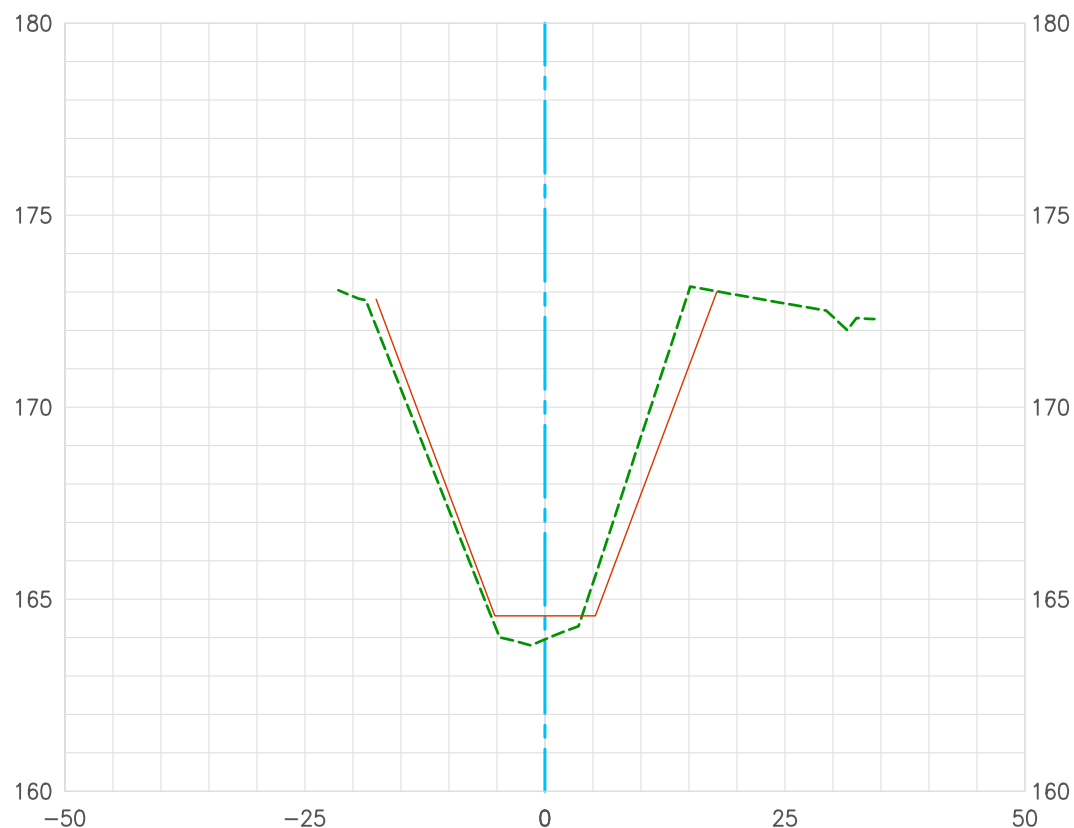

Topography Survey (2019)
Record As-Built Plan F07-101-4A (1960)
Construction Centerline
Date Prepared: 05/08/2019

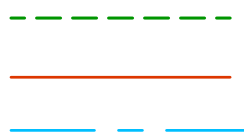


Horizontal Scale: 1"=20'
Vertical Scale: 1"=5'

**U.S. Survey
Foot**


OC Public Works/Engineering Services
OC Survey/Field Services
Boundary Analysis & Mapping



EL MODENA CHANNEL (F07) 227+50.00

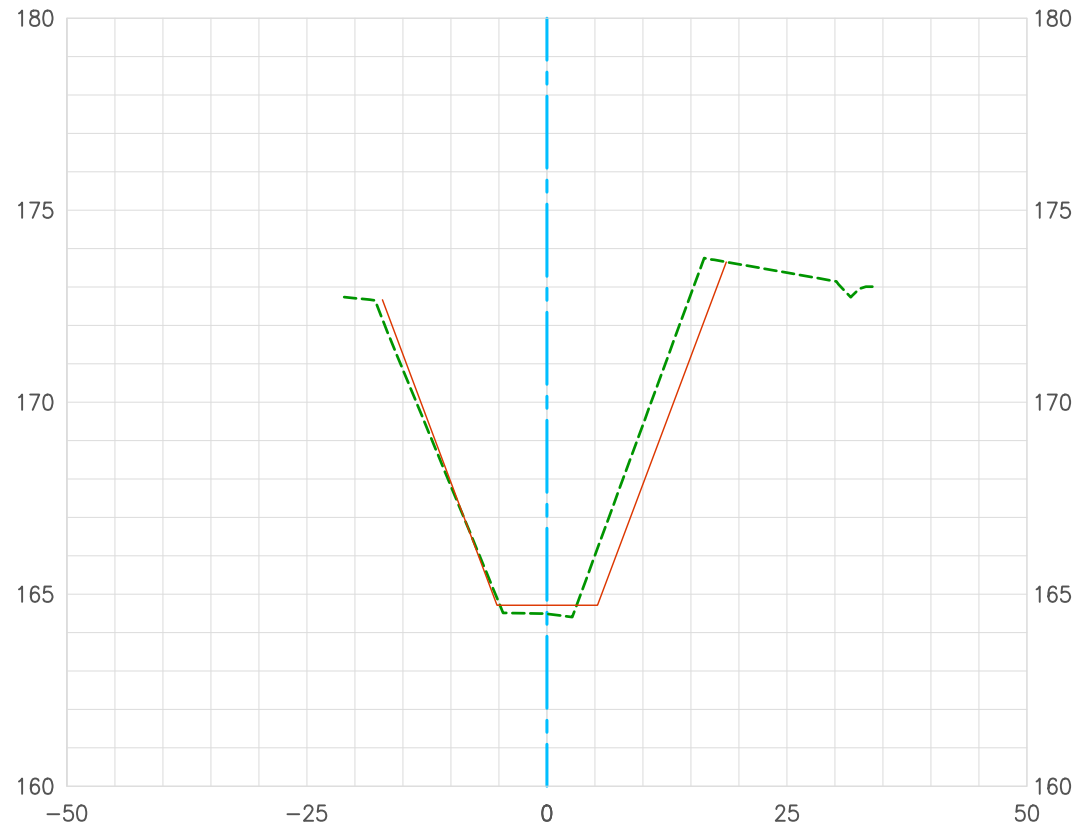

Topography Survey (2019)
Record As-Built Plan F07-101-4A (1960)
Construction Centerline
Date Prepared: 05/08/2019

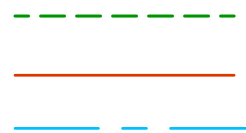


Horizontal Scale: 1"=20'
Vertical Scale: 1"=5'

**U.S. Survey
Foot**


OC Public Works/Engineering Services
OC Survey/Field Services
Boundary Analysis & Mapping



EL MODENA CHANNEL (F07) 228+00.00

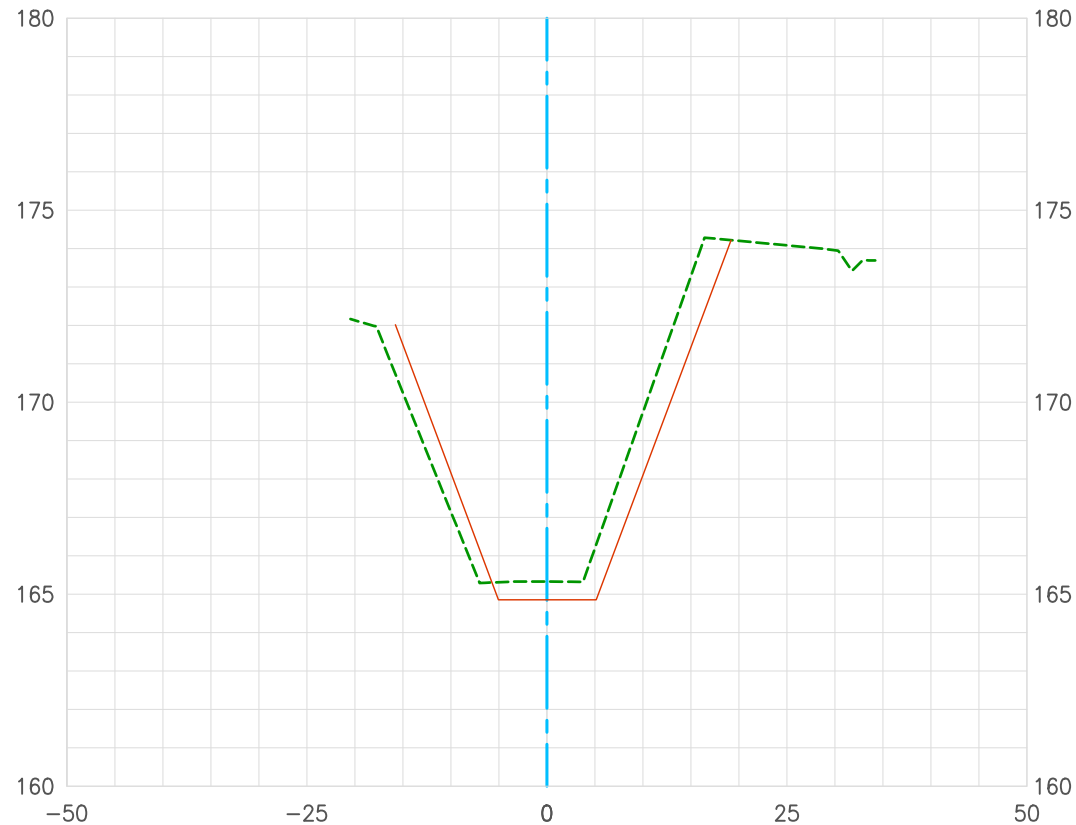

Topography Survey (2019)
Record As-Built Plan F07-101-4A (1960)
Construction Centerline
Date Prepared: 05/08/2019

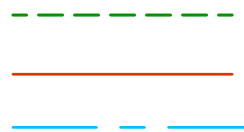


Horizontal Scale: 1"=20'
Vertical Scale: 1"=5'

**U.S. Survey
Foot**


OC Public Works/Engineering Services
OC Survey/Field Services
Boundary Analysis & Mapping



EL MODENA CHANNEL (F07) 228+50.00

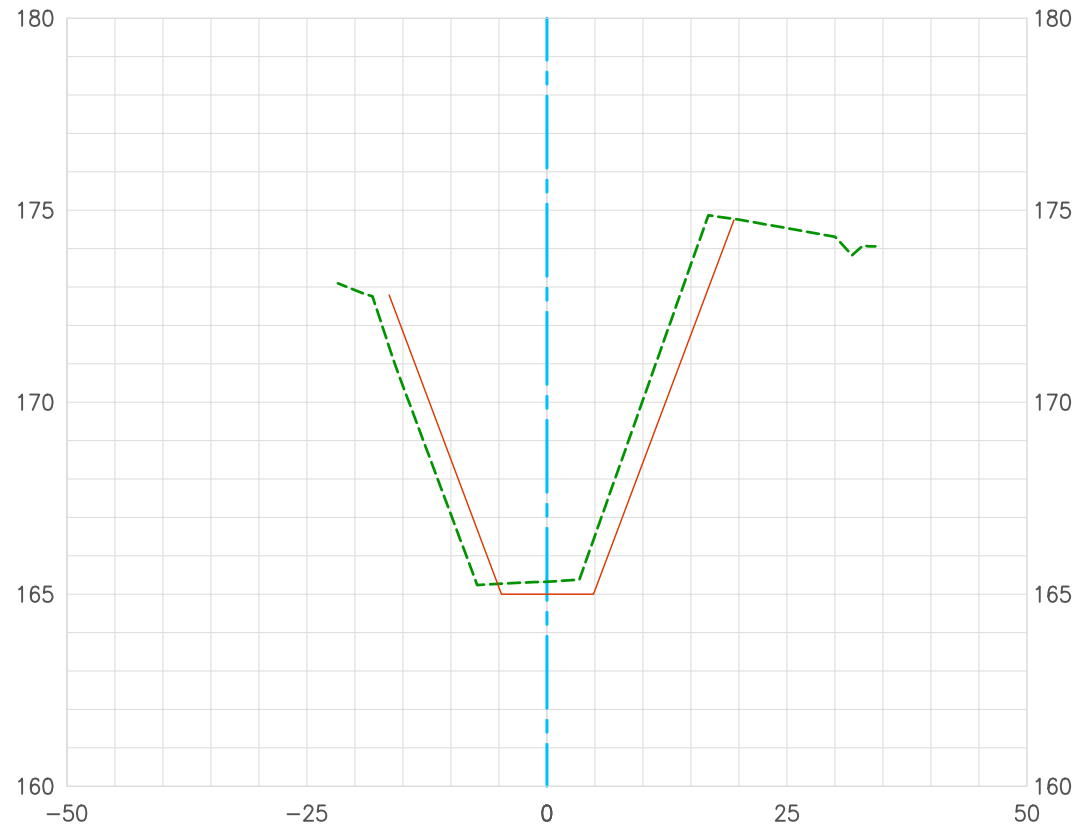

Topography Survey (2019)
Record As-Built Plan F07-101-4A (1960)
Construction Centerline
Date Prepared: 05/08/2019

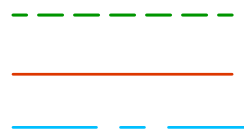


Horizontal Scale: 1"=20'
Vertical Scale: 1"=5'

U.S. Survey Foot


OC Public Works/Engineering Services
OC Survey/Field Services
Boundary Analysis & Mapping



EL MODENA CHANNEL (F07) 229+00.00

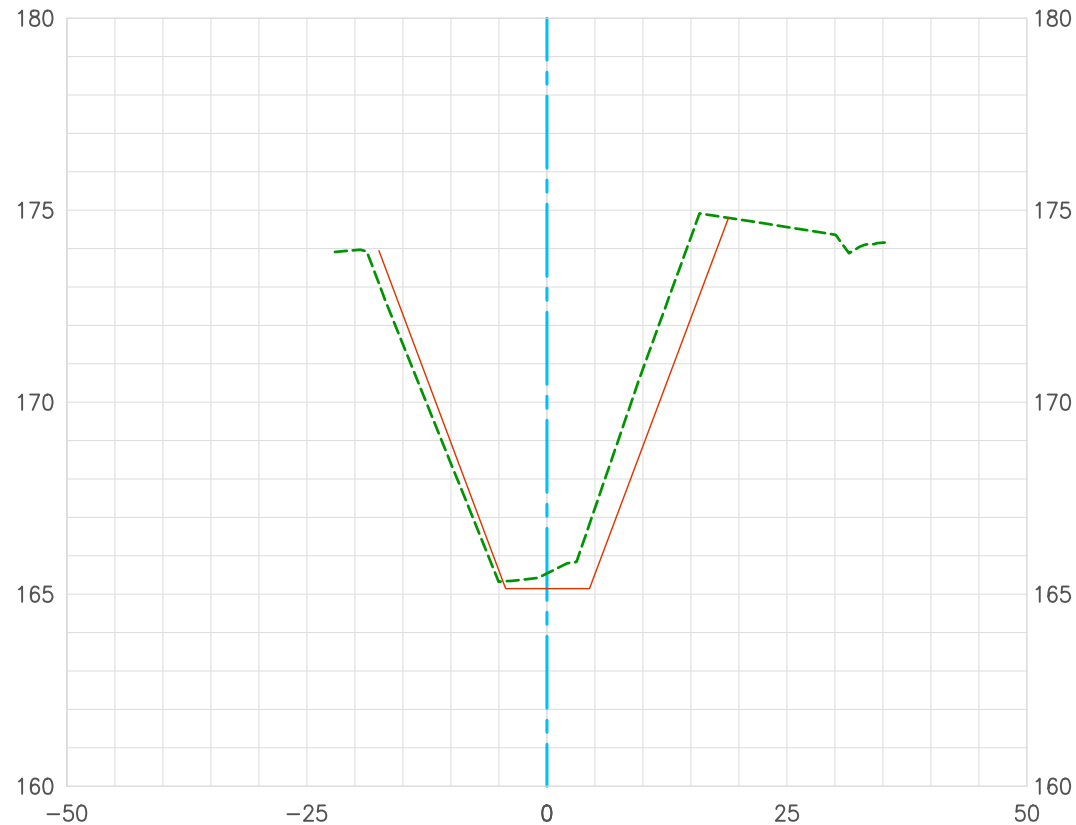

Topography Survey (2019)
Record As-Built Plan F07-101-4A (1960)
Construction Centerline
Date Prepared: 05/08/2019

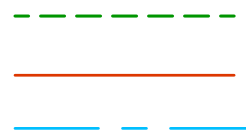


Horizontal Scale: 1"=20'
Vertical Scale: 1"=5'

**U.S. Survey
Foot**


OC Public Works/Engineering Services
OC Survey/Field Services
Boundary Analysis & Mapping



EL MODENA CHANNEL (F07) 229+50.00

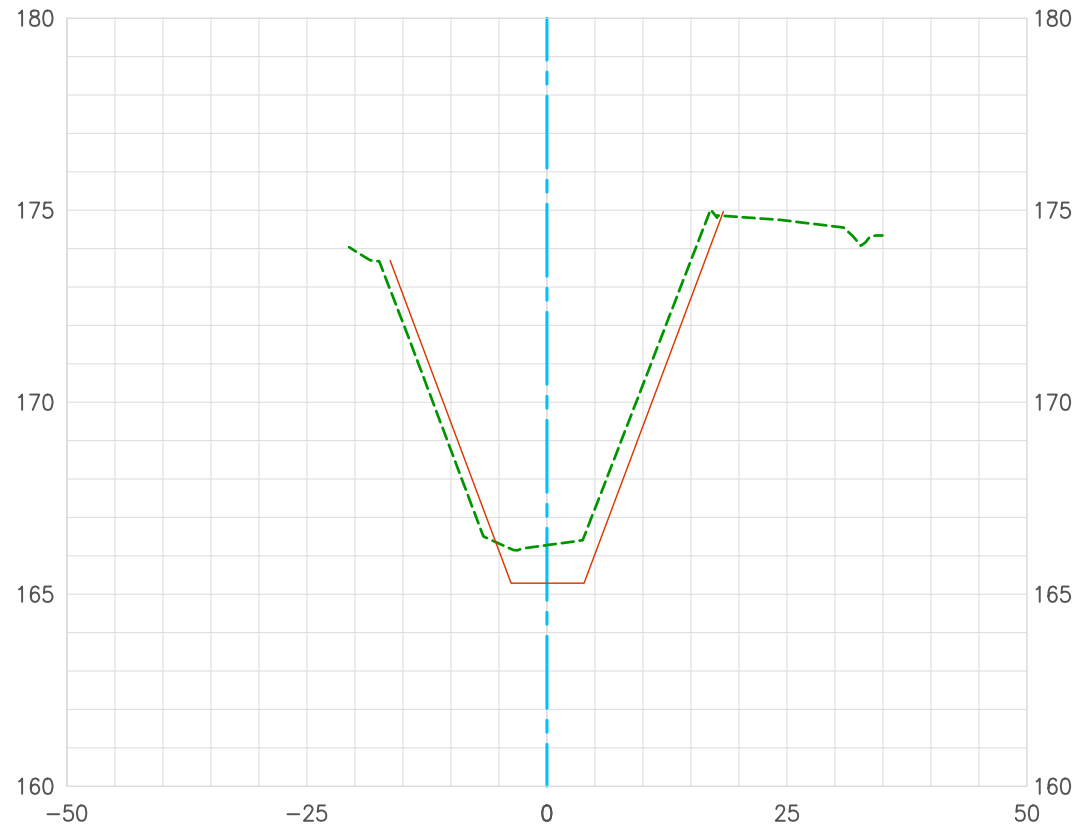


Topography Survey (2019)
Record As-Built Plan F07-101-4A (1960)
Construction Centerline
Date Prepared: 05/08/2019

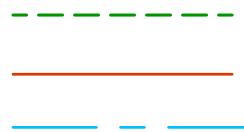


Horizontal Scale: 1"=20'
Vertical Scale: 1"=5'

EL MODENA CHANNEL (F07) 230+00.00

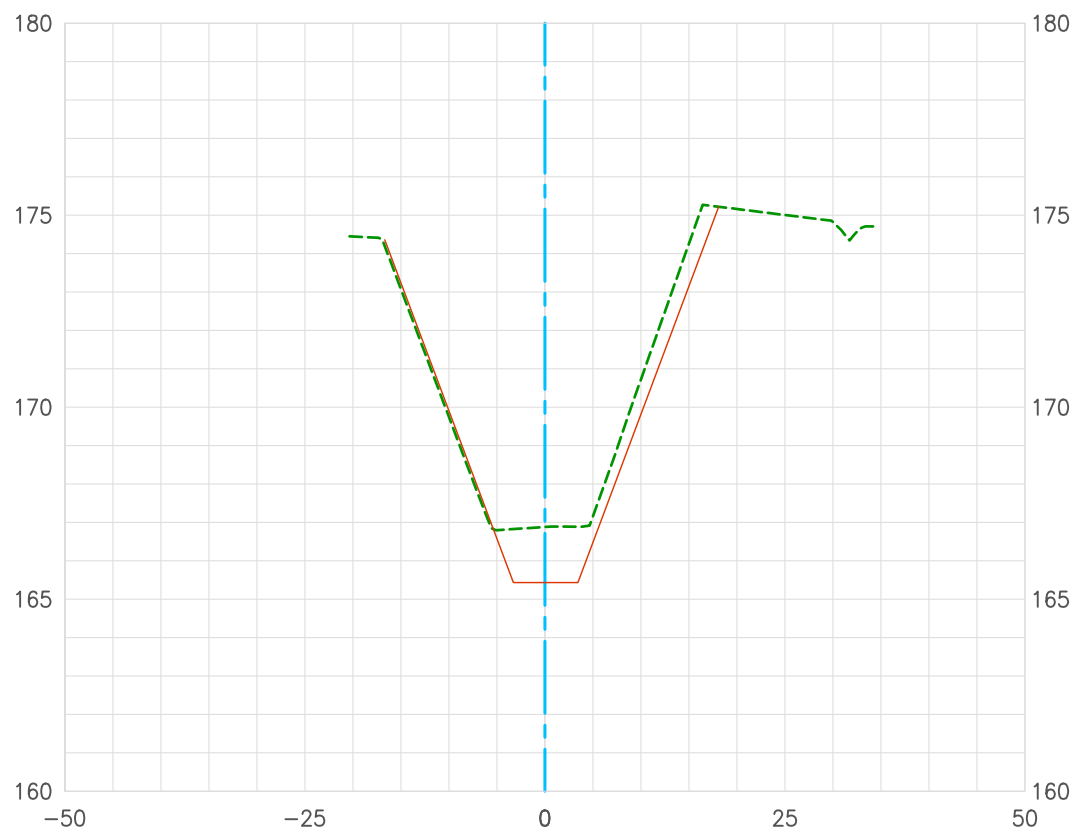

Topography Survey (2019)
 Record As-Built Plan F07-101-4A (1960)
 Construction Centerline
Date Prepared: 05/08/2019

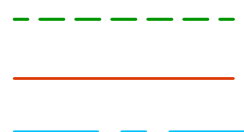


Horizontal Scale: 1"=20'
 Vertical Scale: 1"=5'

U.S. Survey Foot

OC Public Works/Engineering Services
OC Survey/Field Services
Boundary Analysis & Mapping



EL MODENA CHANNEL (F07) 230+93.68

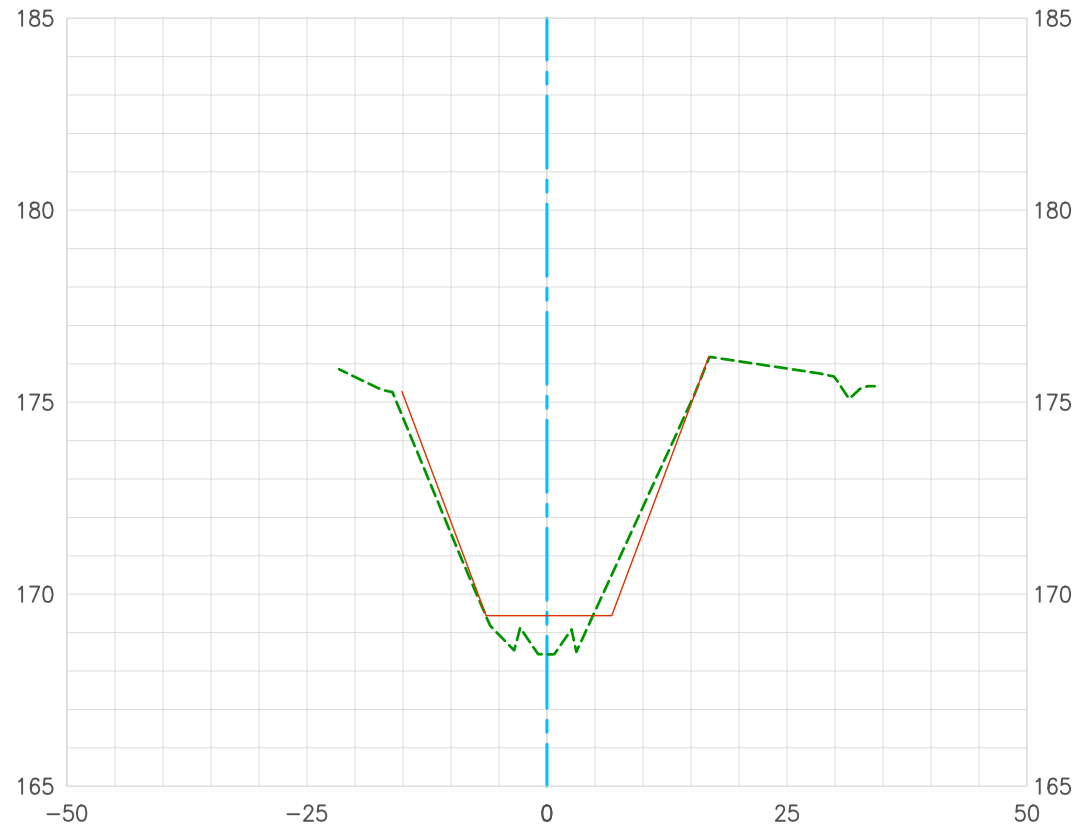

Topography Survey (2019)
Record As-Built Plan F07-101-4A (1960)
Construction Centerline
Date Prepared: 05/08/2019




Horizontal Scale: 1"=20'
Vertical Scale: 1"=5'

**U.S. Survey
Foot**


OC Public Works/Engineering Services
OC Survey/Field Services
Boundary Analysis & Mapping



EL MODENA CHANNEL (F07) 231+50.00

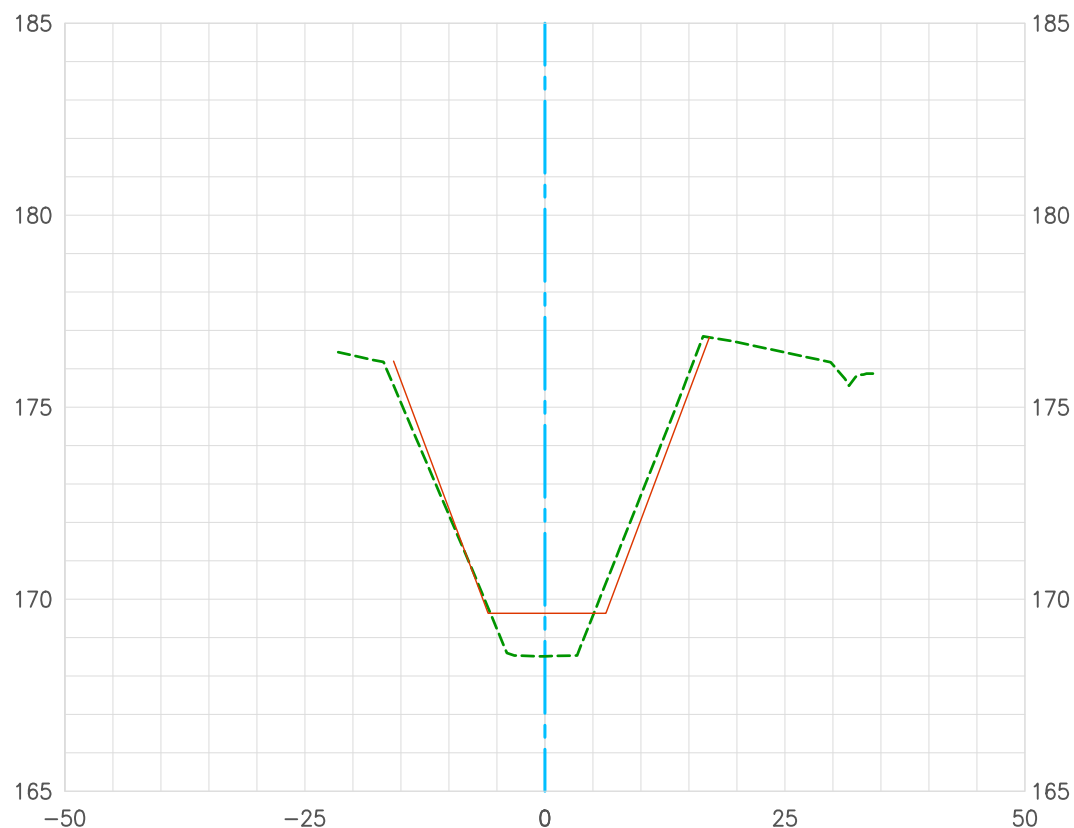

Topography Survey (2019)
Record As-Built Plan F07-101-4A (1960)
Construction Centerline
Date Prepared: 05/08/2019

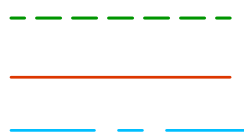


Horizontal Scale: 1"=20'
Vertical Scale: 1"=5'

**U.S. Survey
Foot**


OC Public Works/Engineering Services
OC Survey/Field Services
Boundary Analysis & Mapping



EL MODENA CHANNEL (F07) 232+00.00

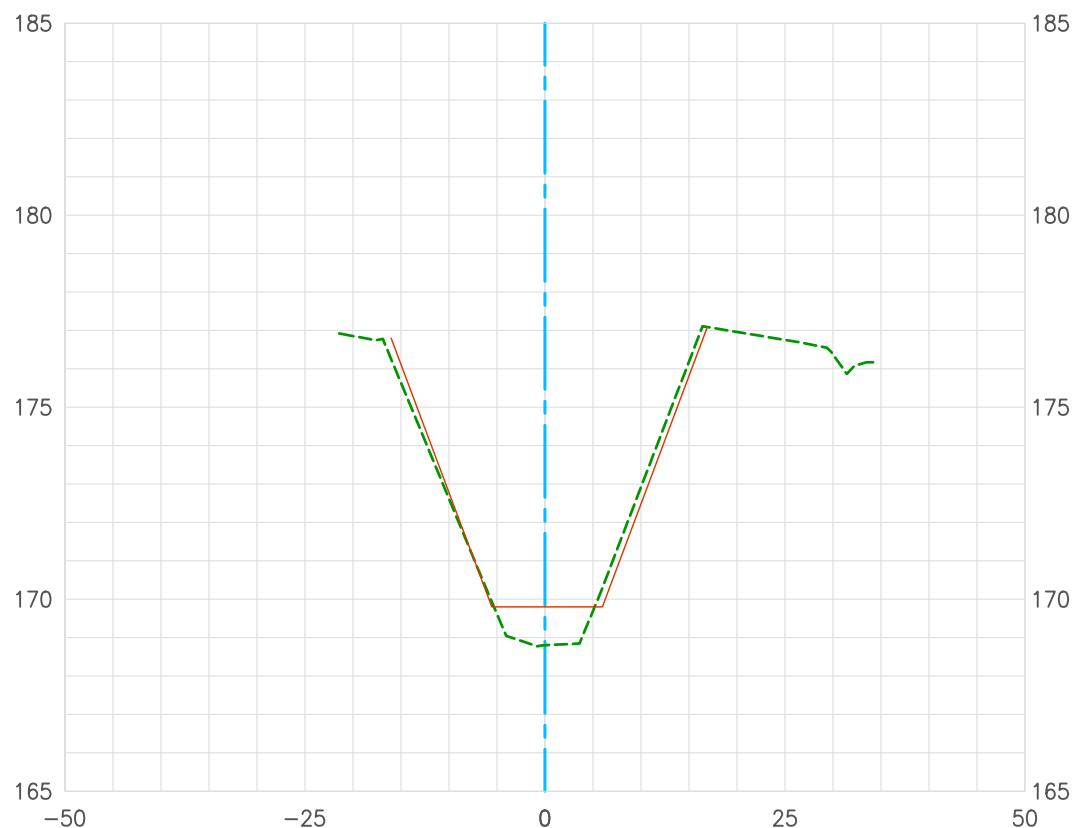

Topography Survey (2019)
Record As-Built Plan F07-101-4A (1960)
Construction Centerline
Date Prepared: 05/08/2019

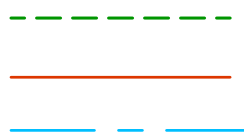


Horizontal Scale: 1"=20'
Vertical Scale: 1"=5'

**U.S. Survey
Foot**


OC Public Works/Engineering Services
OC Survey/Field Services
Boundary Analysis & Mapping



EL MODENA CHANNEL (F07) 232+50.00

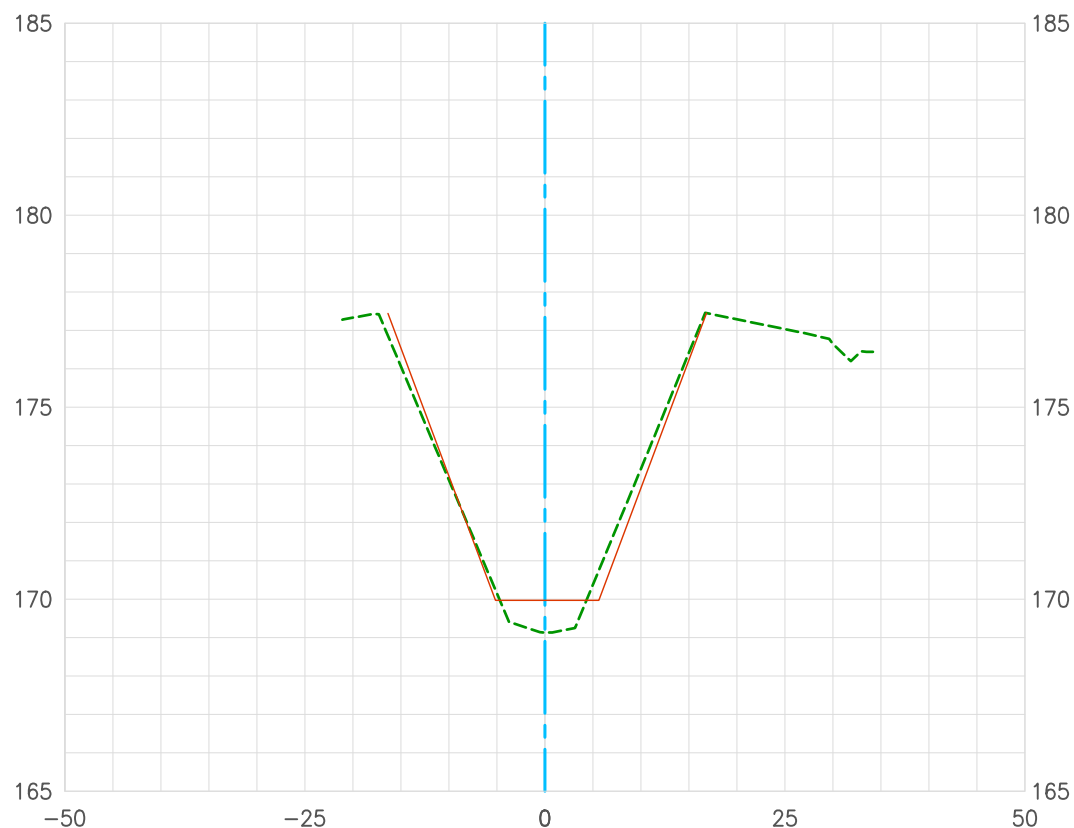

Topography Survey (2019)
Record As-Built Plan F07-101-4A (1960)
Construction Centerline
Date Prepared: 05/08/2019

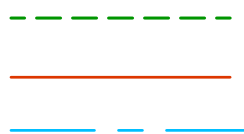


Horizontal Scale: 1"=20'
Vertical Scale: 1"=5'

**U.S. Survey
Foot**


OC Public Works/Engineering Services
OC Survey/Field Services
Boundary Analysis & Mapping



EL MODENA CHANNEL (F07) 233+00.00

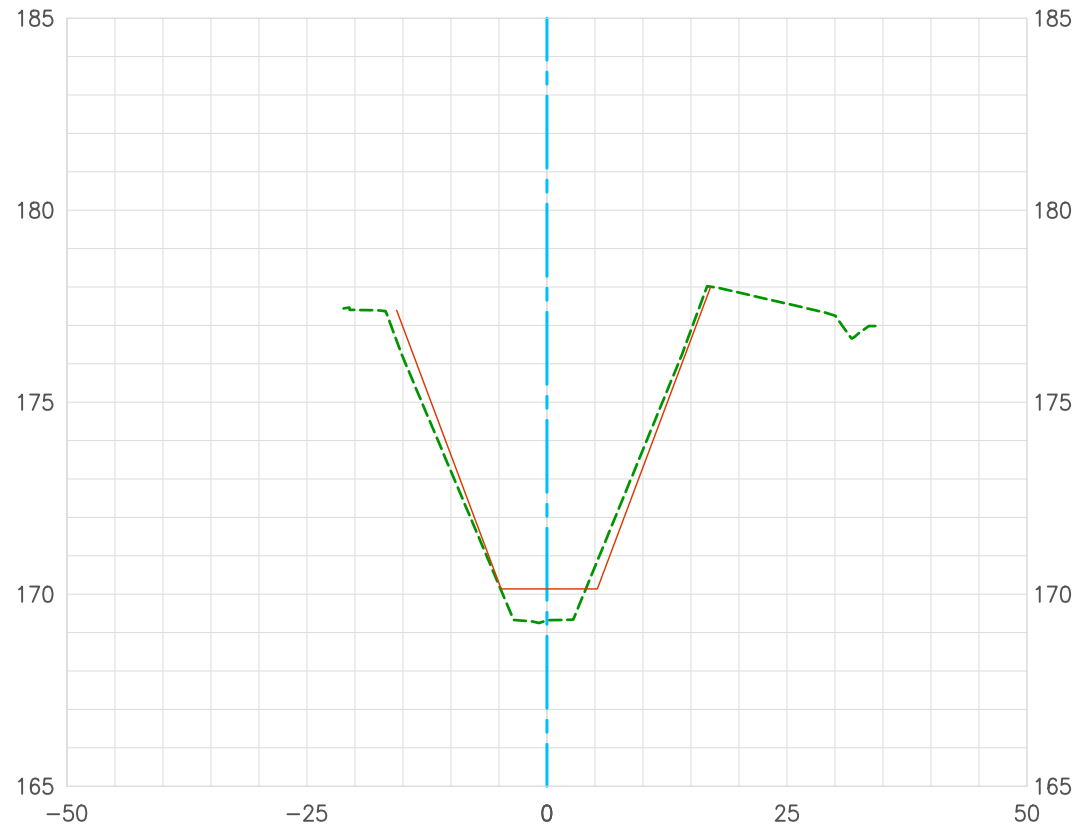


Topography Survey (2019)
Record As-Built Plan F07-101-4A (1960)
Construction Centerline
Date Prepared: 05/08/2019

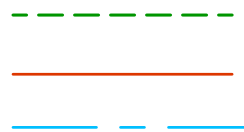


Horizontal Scale: 1"=20'
Vertical Scale: 1"=5'

EL MODENA CHANNEL (F07) 233+50.00

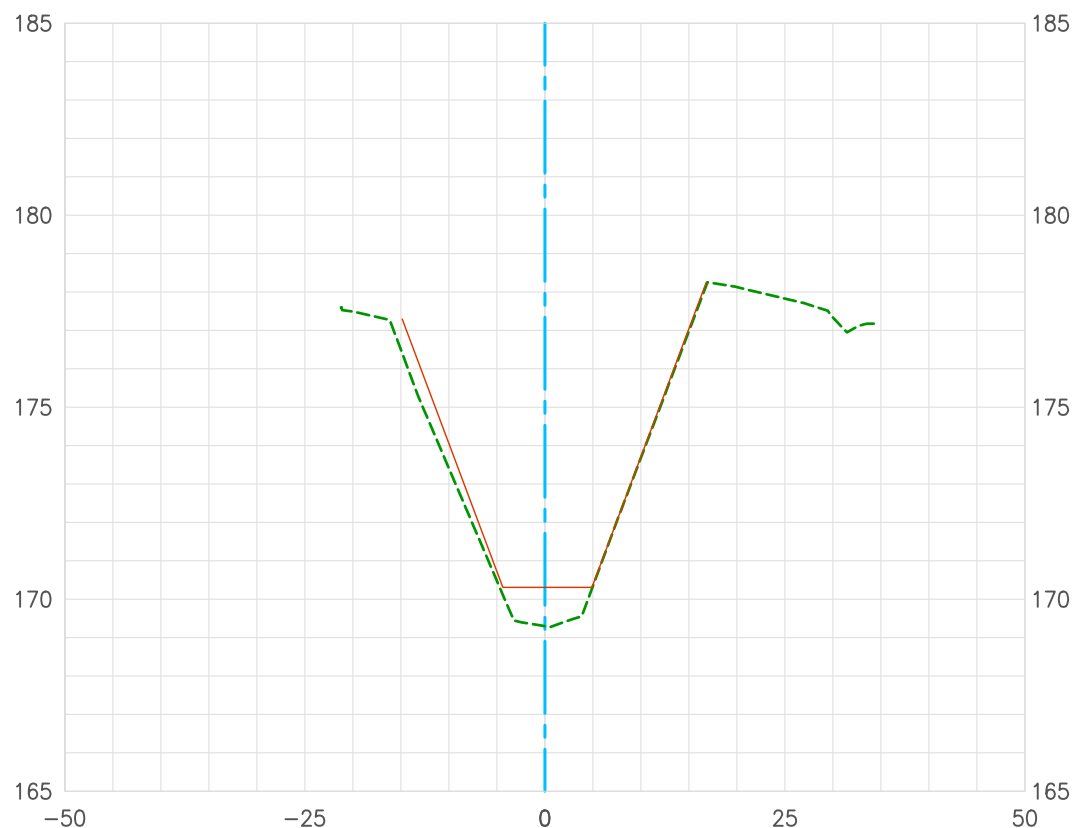

Topography Survey (2019)
Record As-Built Plan F07-101-4A (1960)
Construction Centerline
Date Prepared: 05/08/2019

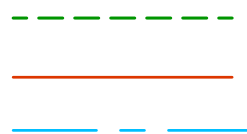


Horizontal Scale: 1"=20'
Vertical Scale: 1"=5'

**U.S. Survey
Foot**


OC Public Works/Engineering Services
OC Survey/Field Services
Boundary Analysis & Mapping



EL MODENA CHANNEL (F07) 234+00.00

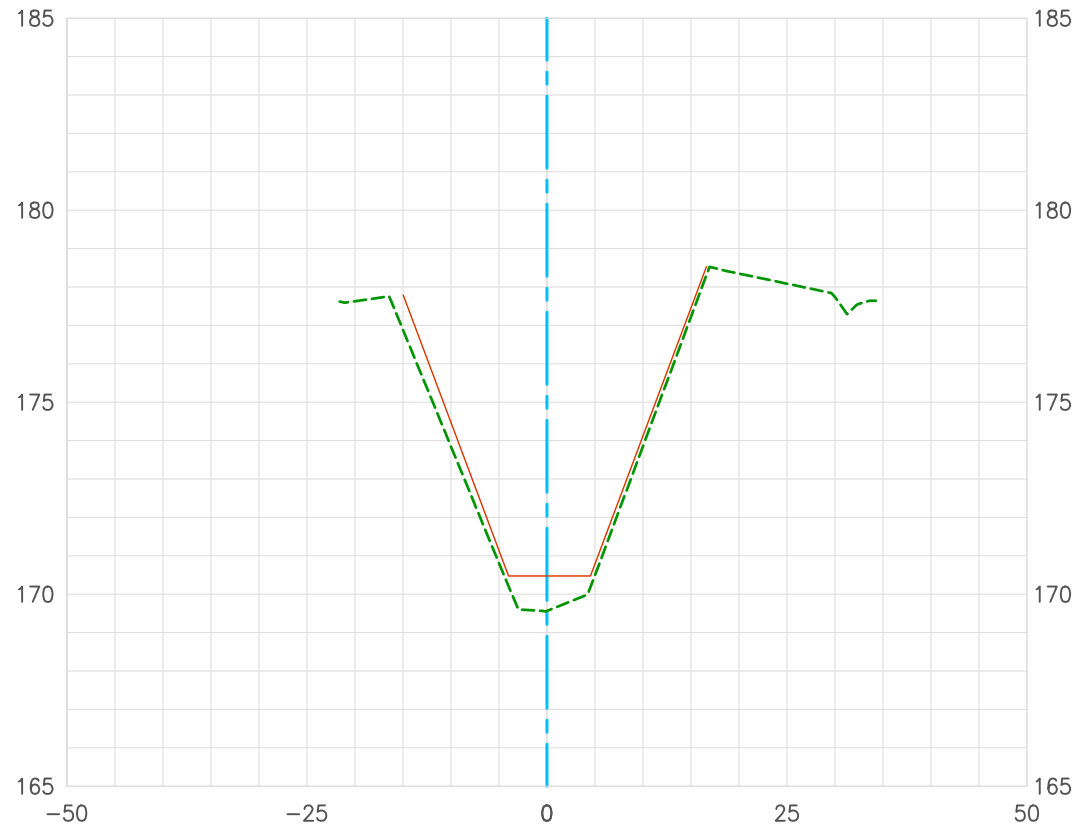

Topography Survey (2019)
Record As-Built Plan F07-101-4A (1960)
Construction Centerline
Date Prepared: 05/08/2019

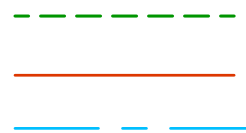


Horizontal Scale: 1"=20'
Vertical Scale: 1"=5'

**U.S. Survey
Foot**


OC Public Works/Engineering Services
OC Survey/Field Services
Boundary Analysis & Mapping



EL MODENA CHANNEL (F07) 234+50.00

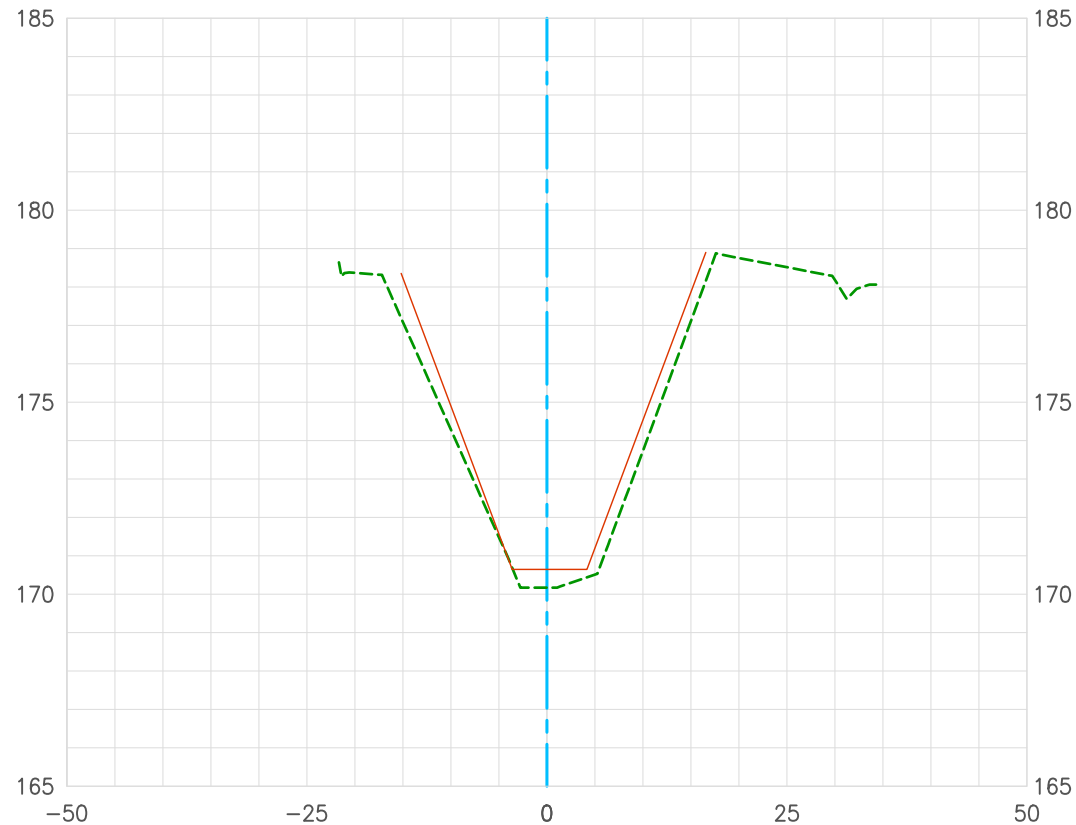

Topography Survey (2019)
Record As-Built Plan F07-101-4A (1960)
Construction Centerline
Date Prepared: 05/08/2019

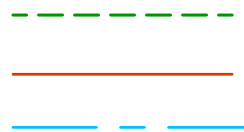


Horizontal Scale: 1"=20'
Vertical Scale: 1"=5'

**U.S. Survey
Foot**


OC Public Works/Engineering Services
OC Survey/Field Services
Boundary Analysis & Mapping



EL MODENA CHANNEL (F07) 235+00.00

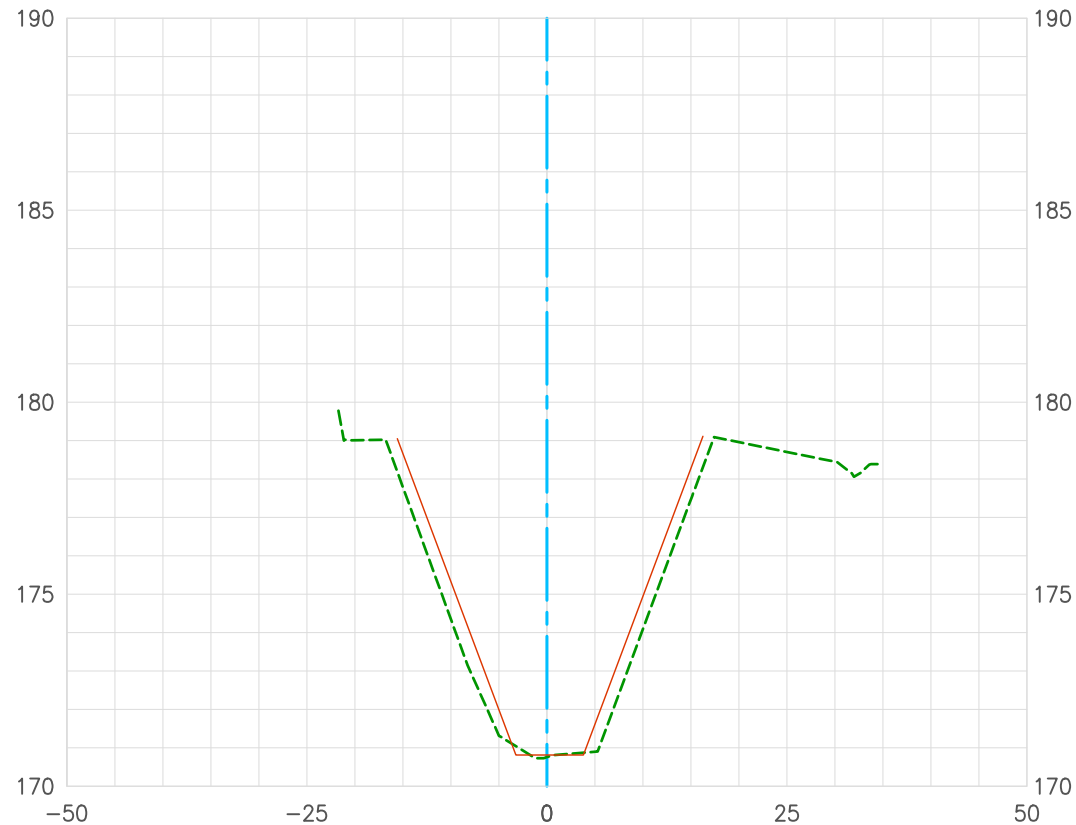

Topography Survey (2019)
Record As-Built Plan F07-101-4A (1960)
Construction Centerline
Date Prepared: 05/08/2019

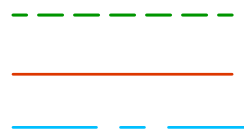


Horizontal Scale: 1"=20'
Vertical Scale: 1"=5'

**U.S. Survey
Foot**


OC Public Works/Engineering Services
OC Survey/Field Services
Boundary Analysis & Mapping



EL MODENA CHANNEL (F07) 235+50.00

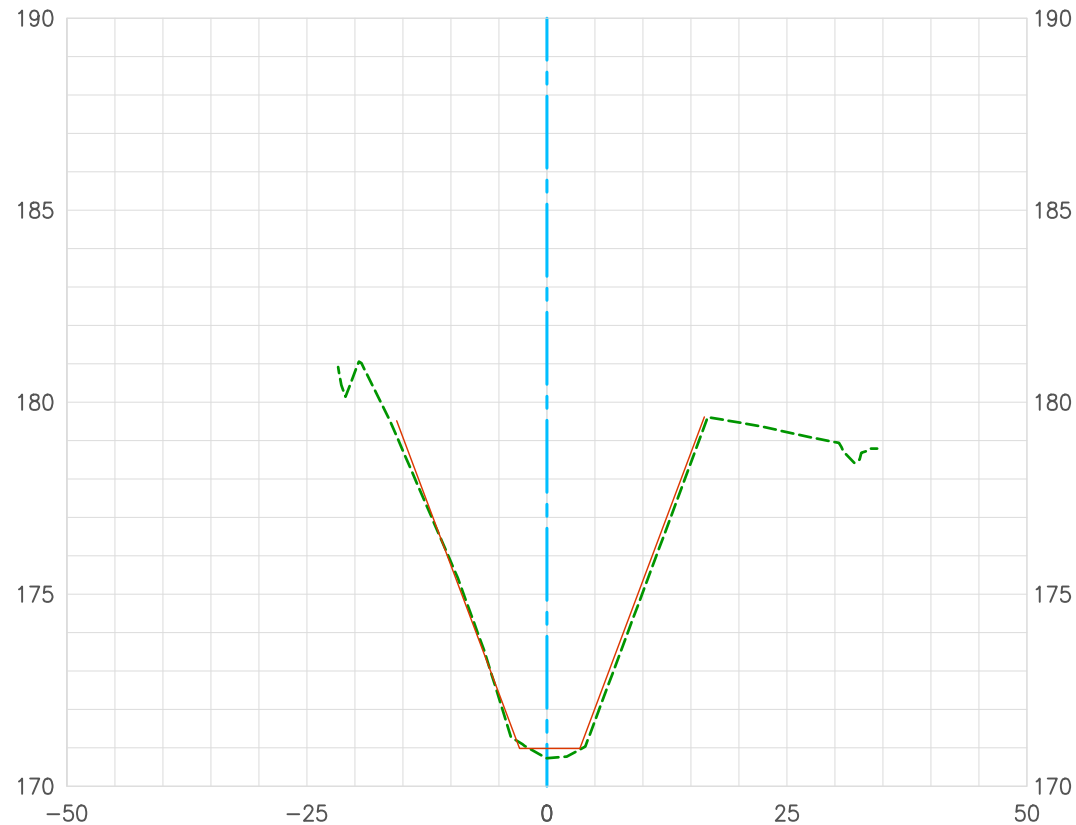

Topography Survey (2019)
Record As-Built Plan F07-101-4A (1960)
Construction Centerline
Date Prepared: 05/08/2019

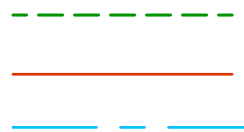


Horizontal Scale: 1"=20'
Vertical Scale: 1"=5'

U.S. Survey Foot


OC Public Works/Engineering Services
OC Survey/Field Services
Boundary Analysis & Mapping



EL MODENA CHANNEL (F07) 236+50.00

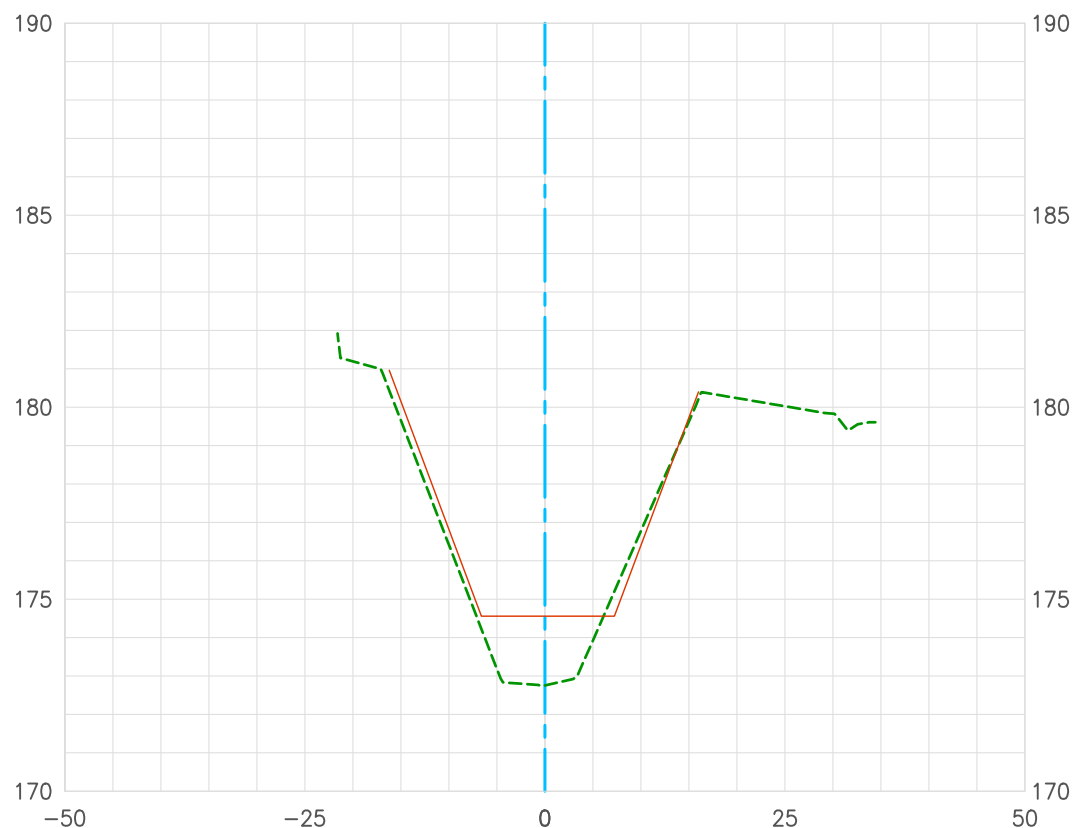

Topography Survey (2019)
Record As-Built Plan F07-101-4A (1960)
Construction Centerline
Date Prepared: 05/08/2019

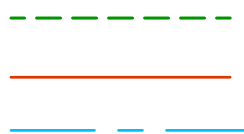


Horizontal Scale: 1"=20'
Vertical Scale: 1"=5'

**U.S. Survey
Foot**


OC Public Works/Engineering Services
OC Survey/Field Services
Boundary Analysis & Mapping



EL MODENA CHANNEL (F07) 237+00.00

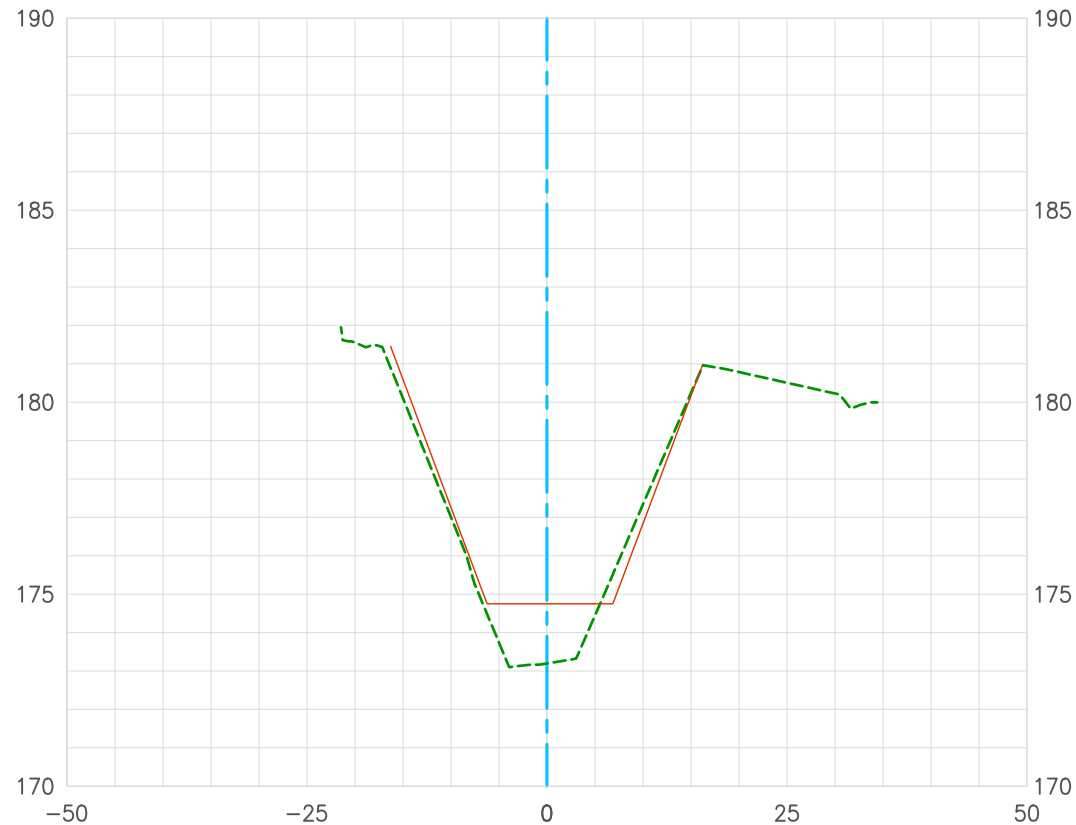

Topography Survey (2019)
Record As-Built Plan F07-101-4A (1960)
Construction Centerline
Date Prepared: 05/08/2019

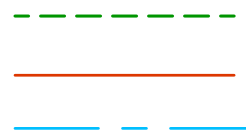


Horizontal Scale: 1"=20'
Vertical Scale: 1"=5'

**U.S. Survey
Foot**


OC Public Works/Engineering Services
OC Survey/Field Services
Boundary Analysis & Mapping



EL MODENA CHANNEL (F07) 237+50.00

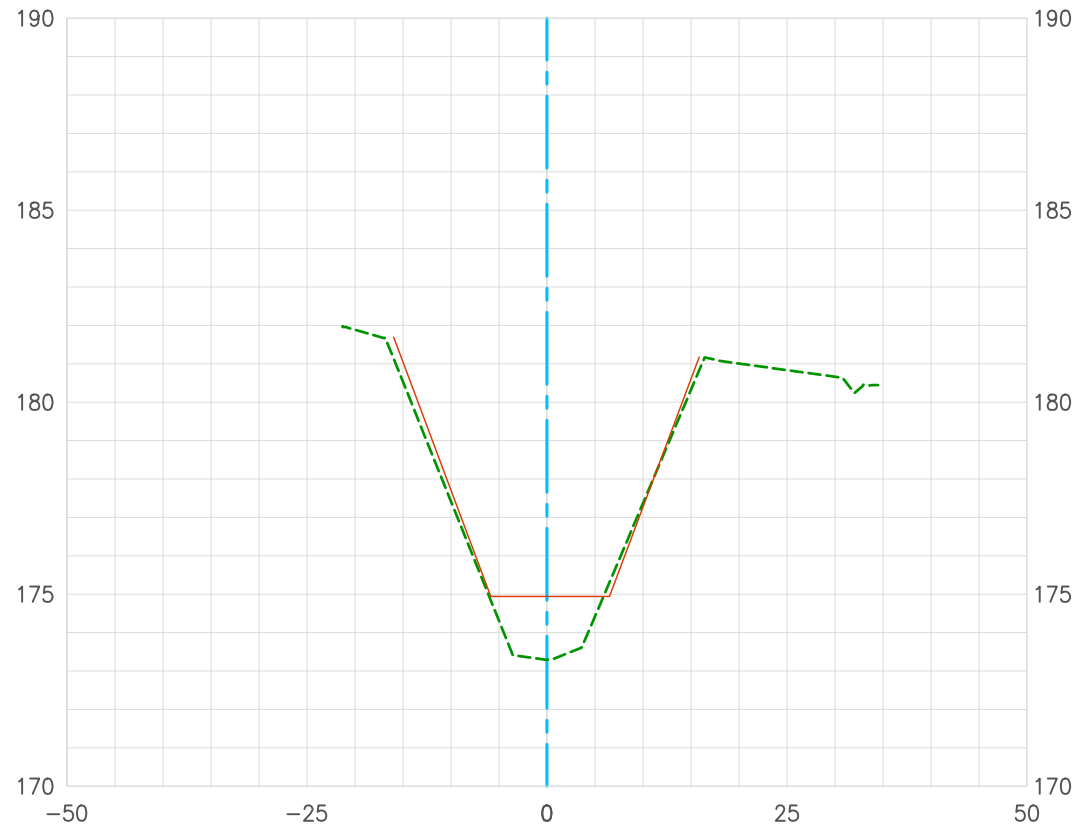

Topography Survey (2019)
Record As-Built Plan F07-101-4A (1960)
Construction Centerline
Date Prepared: 05/08/2019

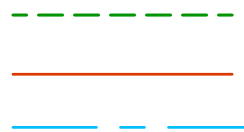


Horizontal Scale: 1"=20'
Vertical Scale: 1"=5'

**U.S. Survey
Foot**


OC Public Works/Engineering Services
OC Survey/Field Services
Boundary Analysis & Mapping



EL MODENA CHANNEL (F07) 238+00.00

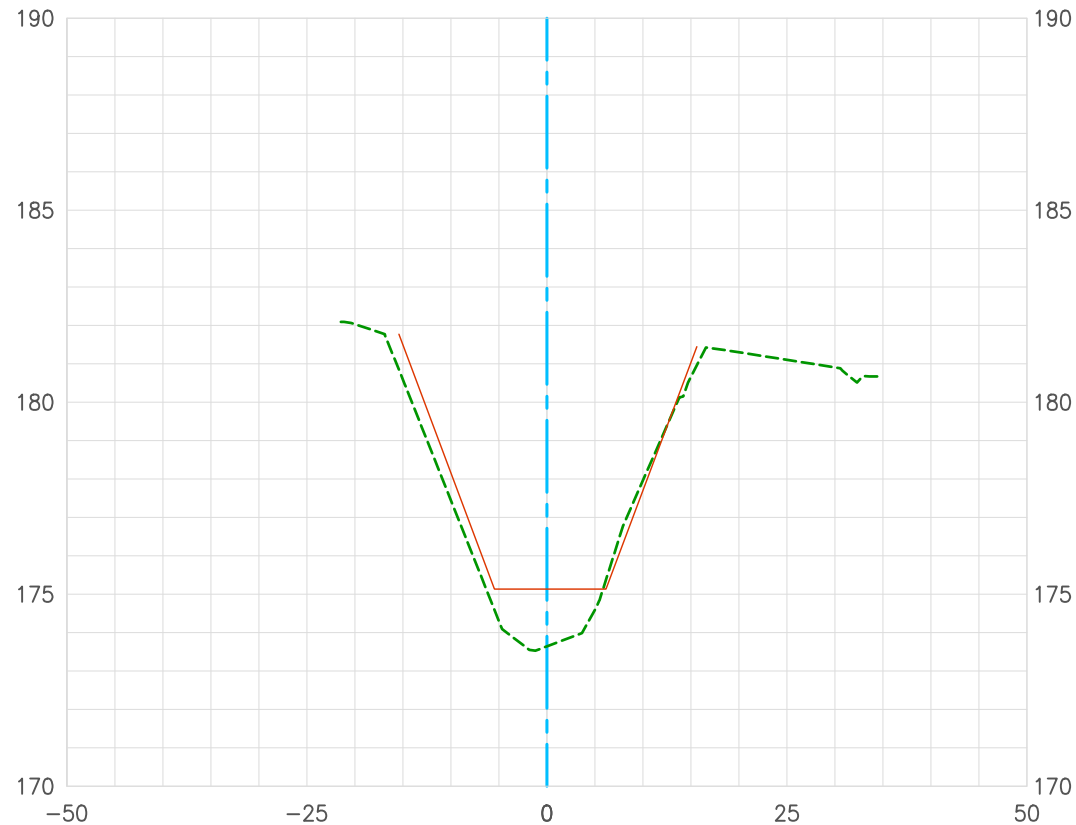

Topography Survey (2019)
Record As-Built Plan F07-101-4A (1960)
Construction Centerline
Date Prepared: 05/08/2019

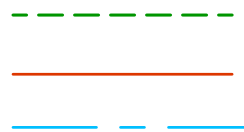


Horizontal Scale: 1"=20'
Vertical Scale: 1"=5'

**U.S. Survey
Foot**


OC Public Works/Engineering Services
OC Survey/Field Services
Boundary Analysis & Mapping



EL MODENA CHANNEL (F07) 238+50.00

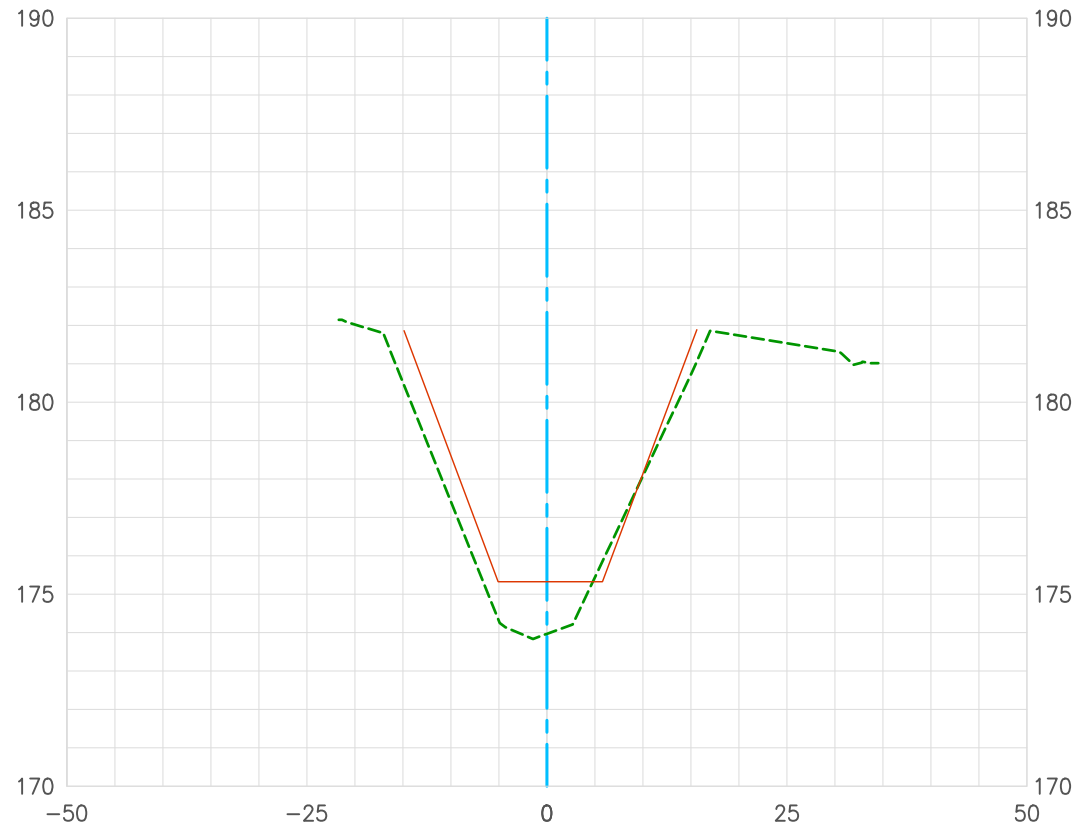

Topography Survey (2019)
Record As-Built Plan F07-101-4A (1960)
Construction Centerline
Date Prepared: 05/08/2019

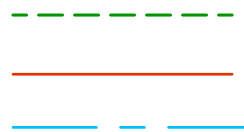


Horizontal Scale: 1"=20'
Vertical Scale: 1"=5'

**U.S. Survey
Foot**


OC Public Works/Engineering Services
OC Survey/Field Services
Boundary Analysis & Mapping



EL MODENA CHANNEL (F07) 239+00.00

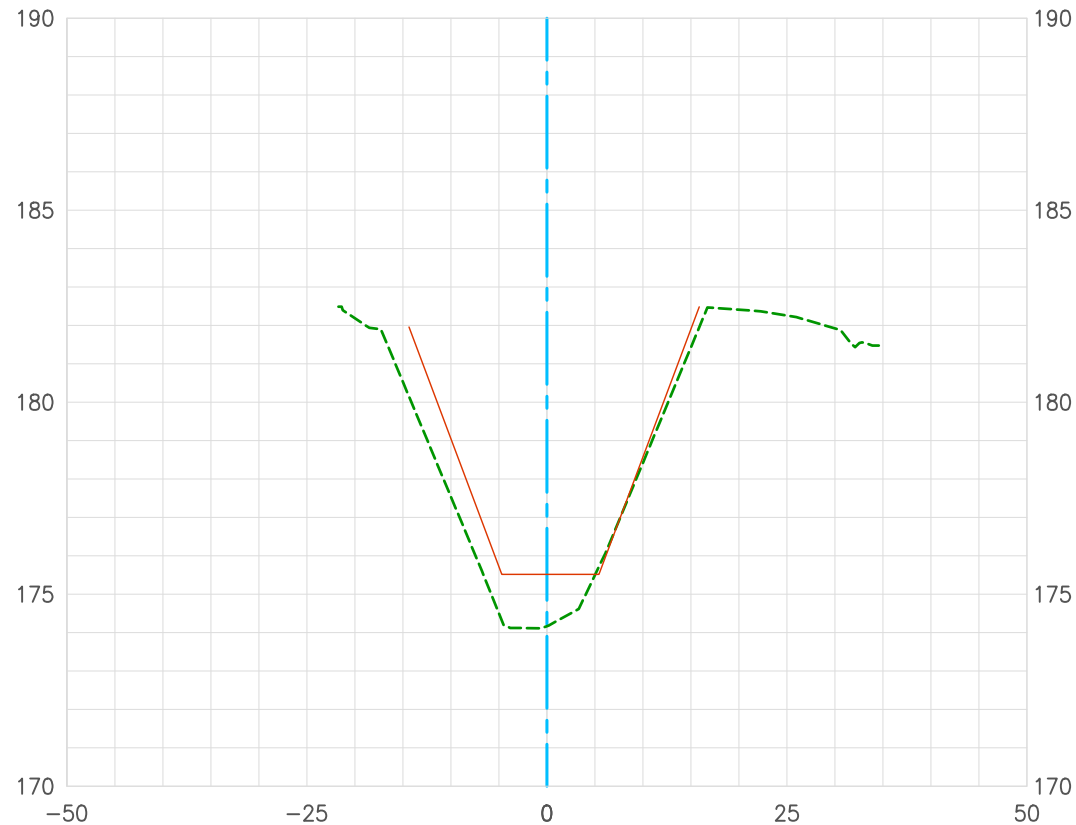

Topography Survey (2019)
Record As-Built Plan F07-101-4A (1960)
Construction Centerline
Date Prepared: 05/08/2019

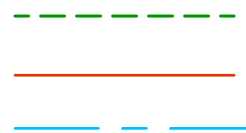


Horizontal Scale: 1"=20'
Vertical Scale: 1"=5'

**U.S. Survey
Foot**


OC Public Works/Engineering Services
OC Survey/Field Services
Boundary Analysis & Mapping



EL MODENA CHANNEL (F07) 239+50.00

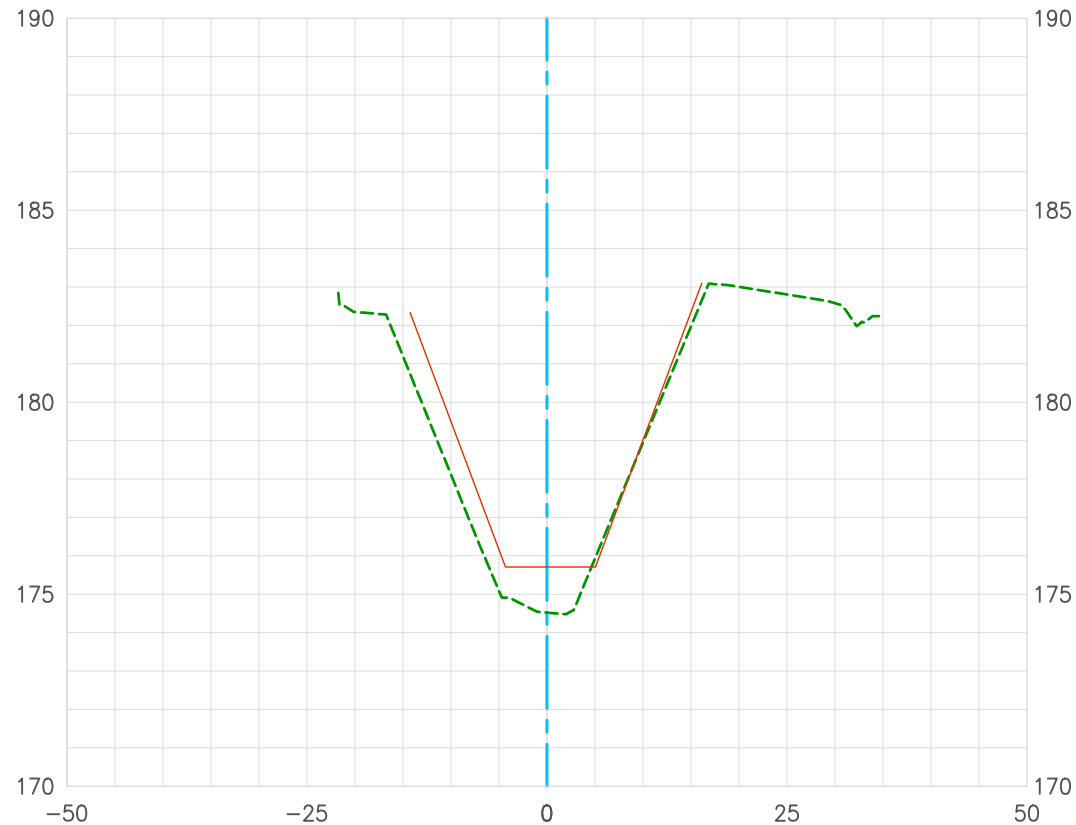

Topography Survey (2019)
Record As-Built Plan F07-101-4A (1960)
Construction Centerline
Date Prepared: 05/08/2019

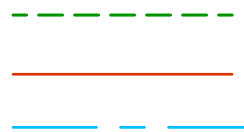


Horizontal Scale: 1"=20'
Vertical Scale: 1"=5'

**U.S. Survey
Foot**


OC Public Works/Engineering Services
OC Survey/Field Services
Boundary Analysis & Mapping



EL MODENA CHANNEL (F07) 240+00.00

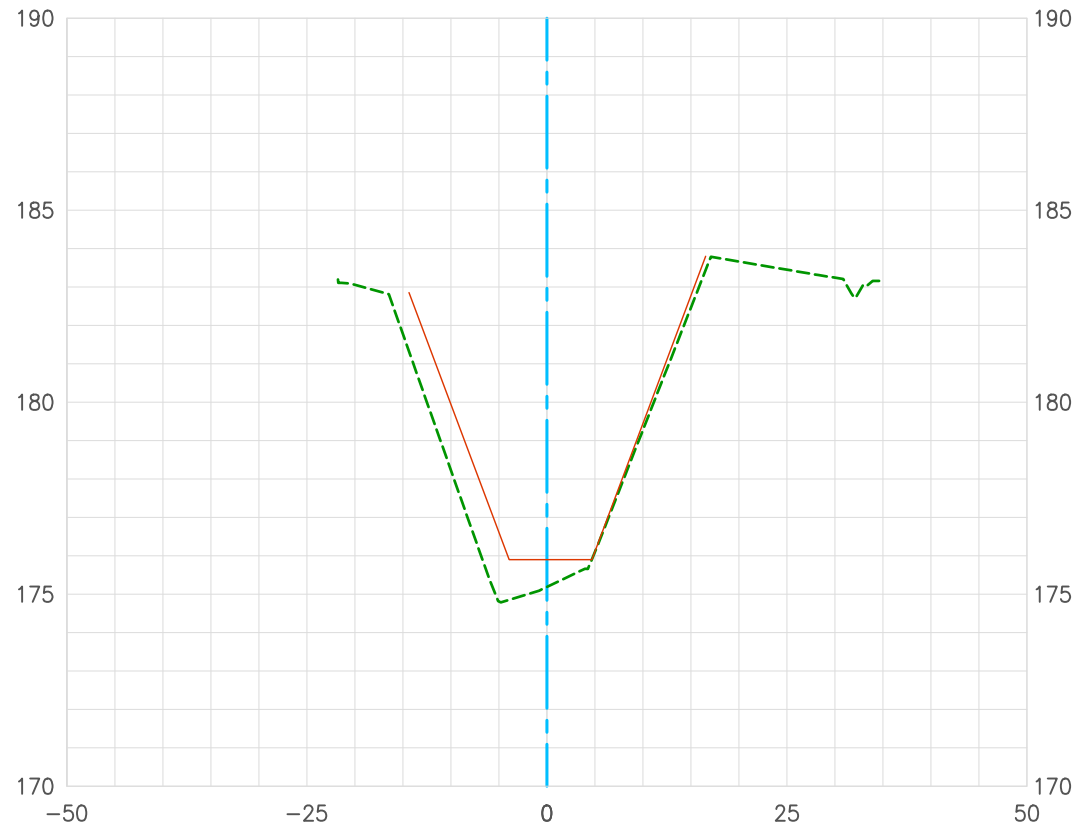

Topography Survey (2019)
Record As-Built Plan F07-101-4A (1960)
Construction Centerline
Date Prepared: 05/08/2019

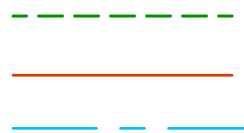


Horizontal Scale: 1"=20'
Vertical Scale: 1"=5'

**U.S. Survey
Foot**


OC Public Works/Engineering Services
OC Survey/Field Services
Boundary Analysis & Mapping



EL MODENA CHANNEL (F07) 240+50.00

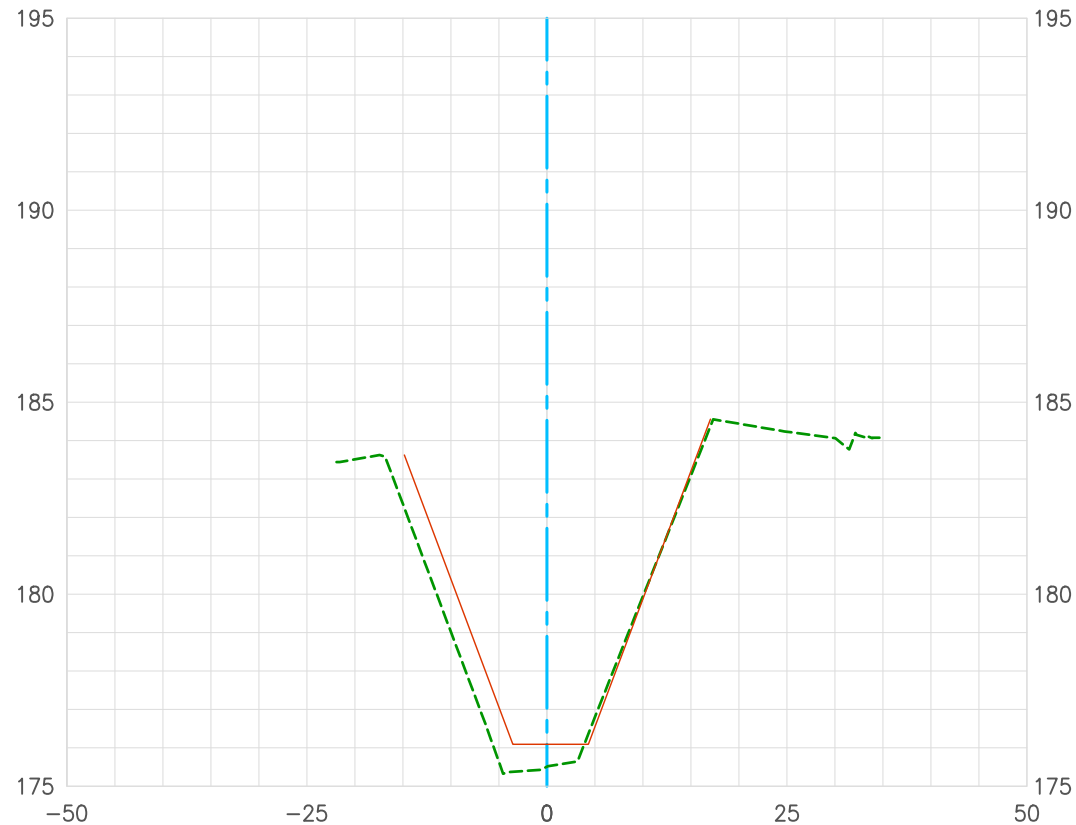

Topography Survey (2019)
Record As-Built Plan F07-101-4A (1960)
Construction Centerline
Date Prepared: 05/08/2019

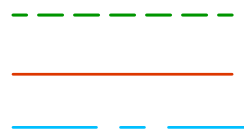


Horizontal Scale: 1"=20'
Vertical Scale: 1"=5'

**U.S. Survey
Foot**


OC Public Works/Engineering Services
OC Survey/Field Services
Boundary Analysis & Mapping



EL MODENA CHANNEL (F07) 241+00.00

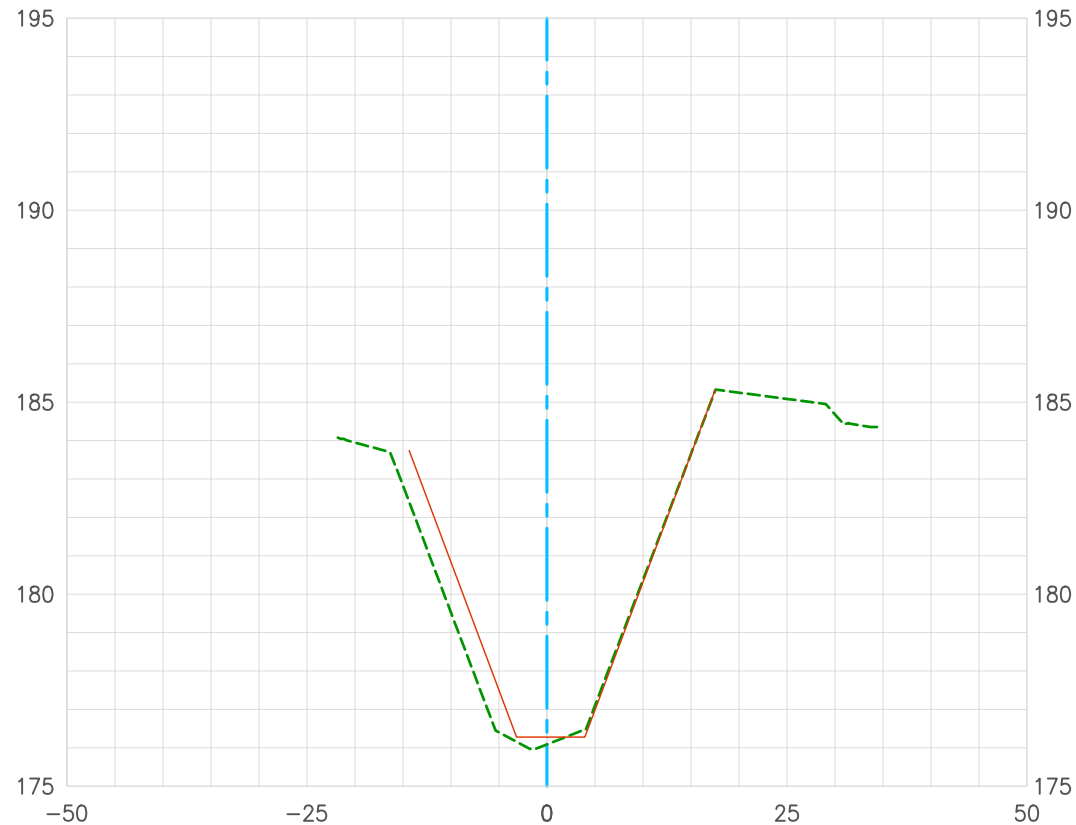

Topography Survey (2019)
Record As-Built Plan F07-101-4A (1960)
Construction Centerline
Date Prepared: 05/08/2019

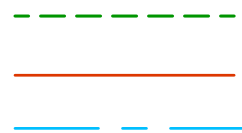


Horizontal Scale: 1"=20'
Vertical Scale: 1"=5'

**U.S. Survey
Foot**


OC Public Works/Engineering Services
OC Survey/Field Services
Boundary Analysis & Mapping



EL MODENA CHANNEL (F07) 241+50.00

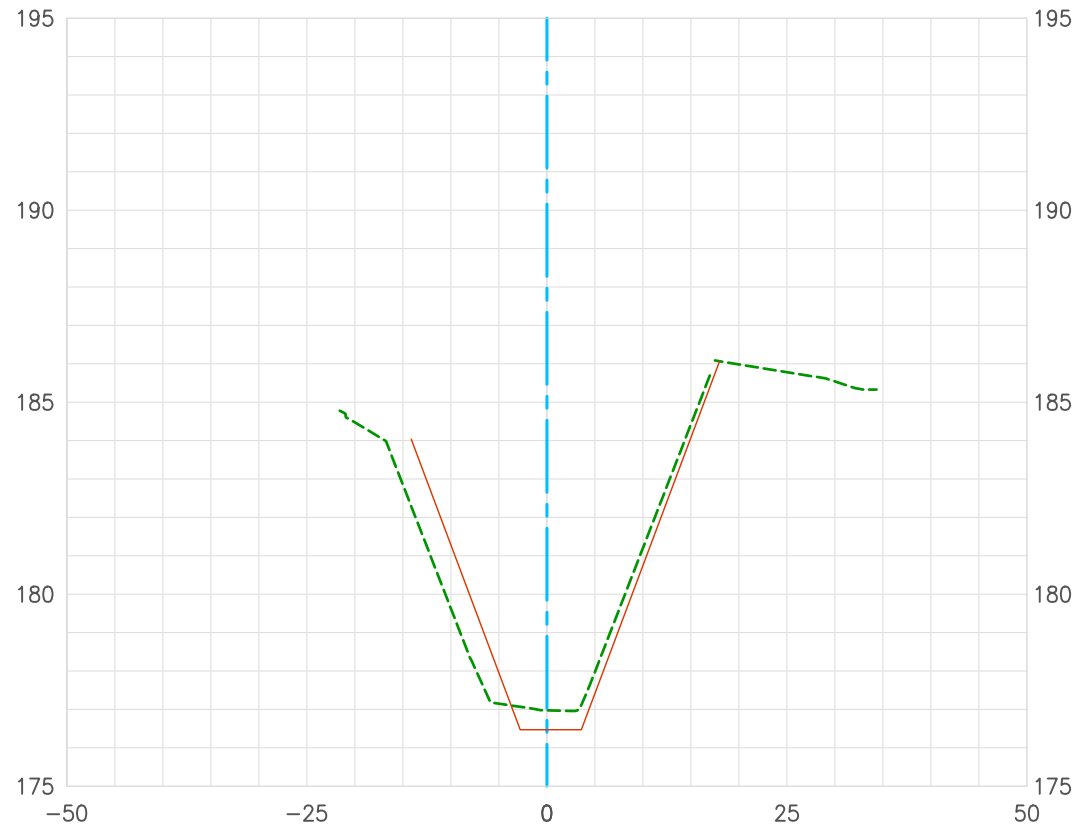

Topography Survey (2019)
Record As-Built Plan F07-101-4A (1960)
Construction Centerline
Date Prepared: 05/08/2019

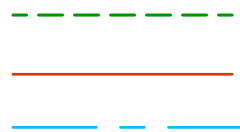


Horizontal Scale: 1"=20'
Vertical Scale: 1"=5'

**U.S. Survey
Foot**


OC Public Works/Engineering Services
OC Survey/Field Services
Boundary Analysis & Mapping



EL MODENA CHANNEL (F07) 242+06.52

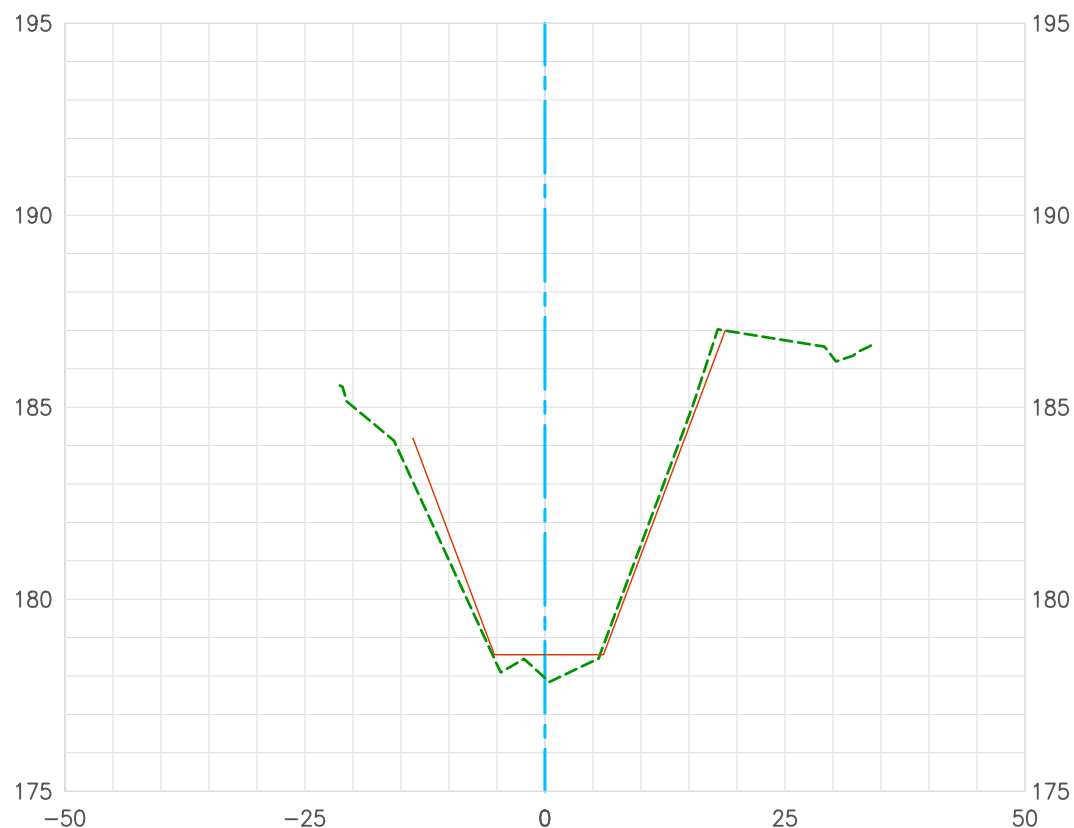

Topography Survey (2019)
Record As-Built Plan F07-101-4A (1960)
Construction Centerline
Date Prepared: 05/08/2019

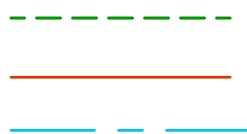


Horizontal Scale: 1"=20'
Vertical Scale: 1"=5'

**U.S. Survey
Foot**


OC Public Works/Engineering Services
OC Survey/Field Services
Boundary Analysis & Mapping



EL MODENA CHANNEL (F07) 242+50.00

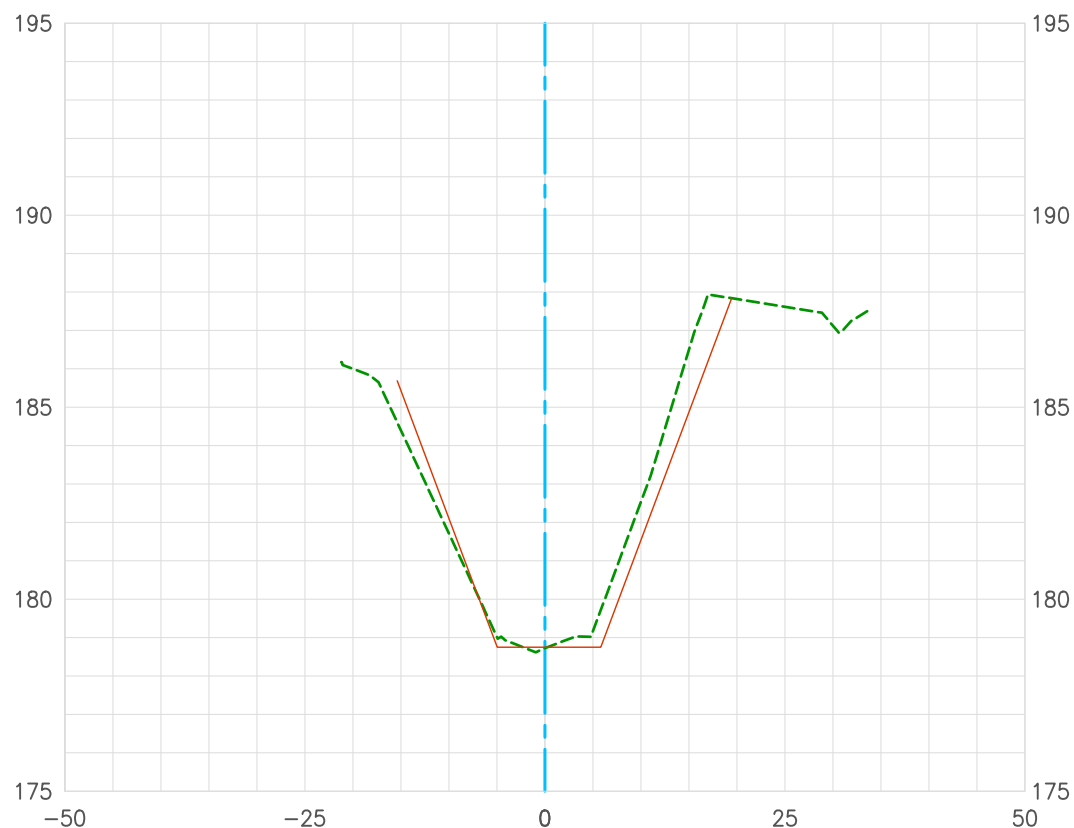

Topography Survey (2019)
Record As-Built Plan F07-101-4A (1960)
Construction Centerline
Date Prepared: 05/08/2019

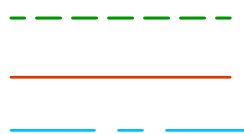


Horizontal Scale: 1"=20'
Vertical Scale: 1"=5'

**U.S. Survey
Foot**


OC Public Works/Engineering Services
OC Survey/Field Services
Boundary Analysis & Mapping



EL MODENA CHANNEL (F07) 243+00.00

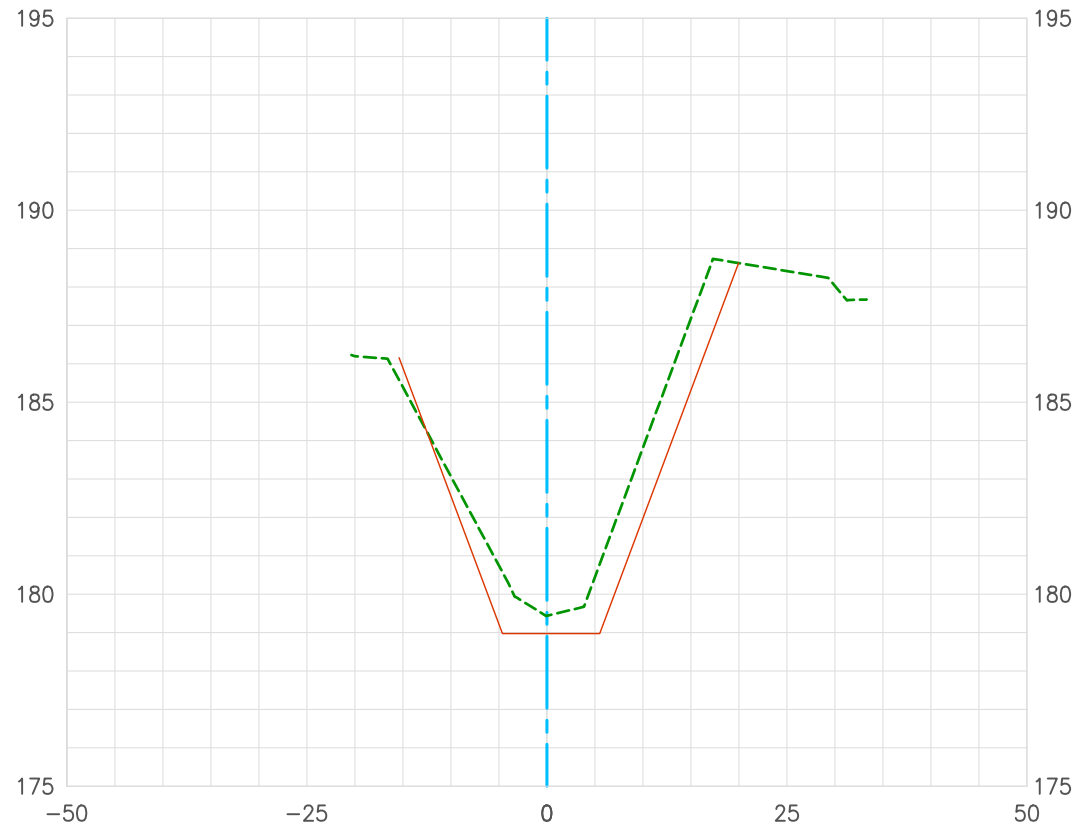

Topography Survey (2019)
Record As-Built Plan F07-101-4A (1960)
Construction Centerline
Date Prepared: 05/08/2019

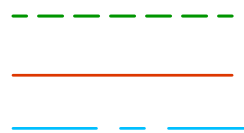


Horizontal Scale: 1"=20'
Vertical Scale: 1"=5'

**U.S. Survey
Foot**


OC Public Works/Engineering Services
OC Survey/Field Services
Boundary Analysis & Mapping



EL MODENA CHANNEL (F07) 243+50.00

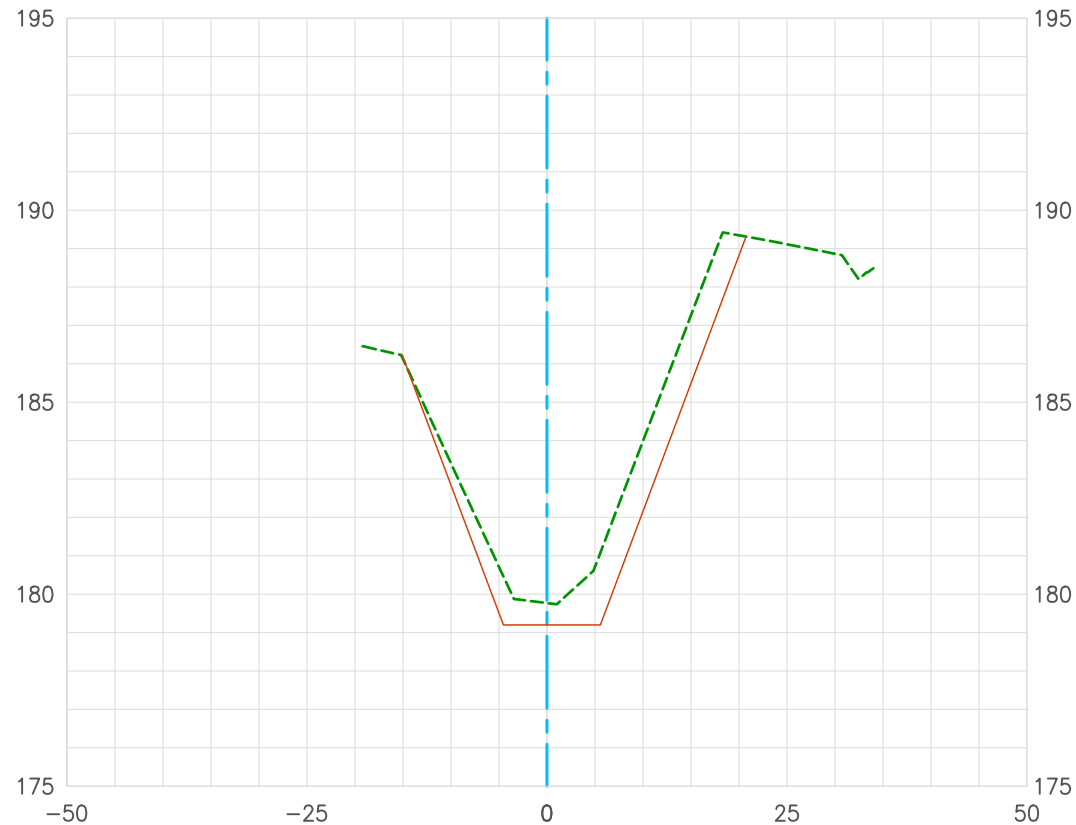

Topography Survey (2019)
Record As-Built Plan F07-101-4A (1960)
Construction Centerline
Date Prepared: 05/08/2019

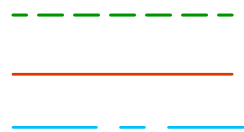


Horizontal Scale: 1"=20'
Vertical Scale: 1"=5'

**U.S. Survey
Foot**


OC Public Works/Engineering Services
OC Survey/Field Services
Boundary Analysis & Mapping



EL MODENA CHANNEL (F07) 244+00.00

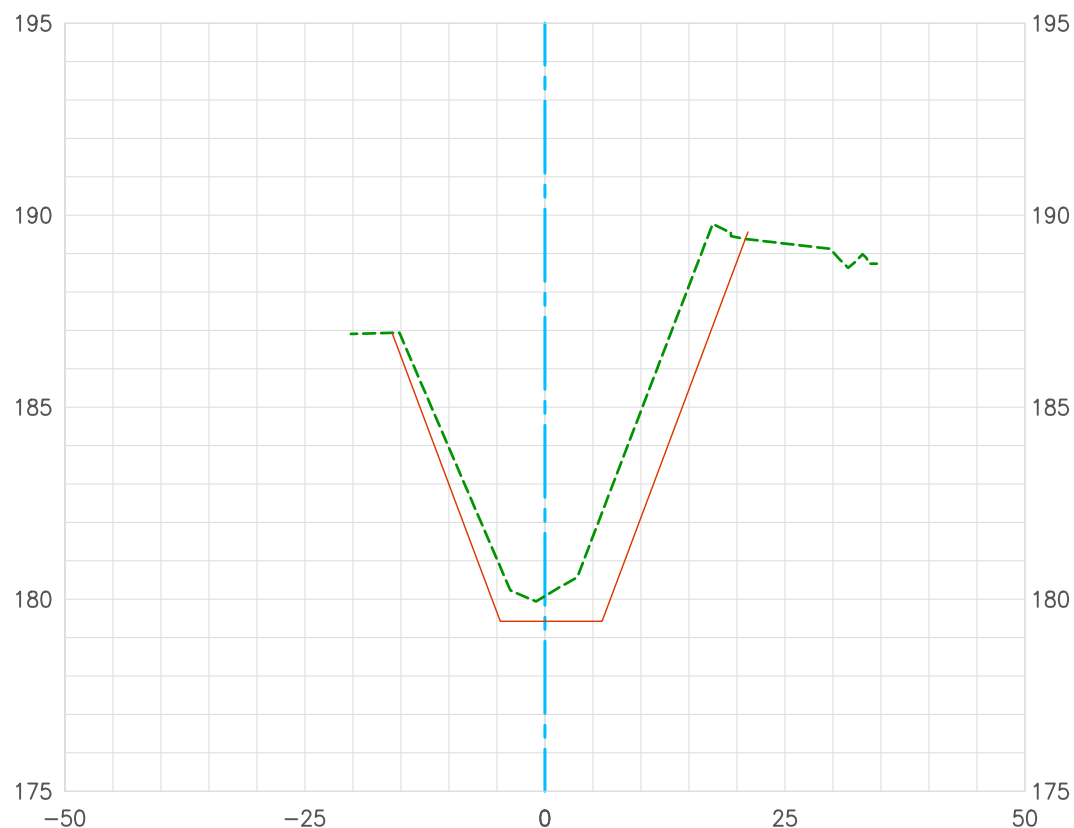

Topography Survey (2019)
Record As-Built Plan F07-101-4A (1960)
Construction Centerline
Date Prepared: 05/08/2019

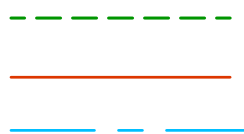


Horizontal Scale: 1"=20'
Vertical Scale: 1"=5'

**U.S. Survey
Foot**


OC Public Works/Engineering Services
OC Survey/Field Services
Boundary Analysis & Mapping



EL MODENA CHANNEL (F07) 244+50.00

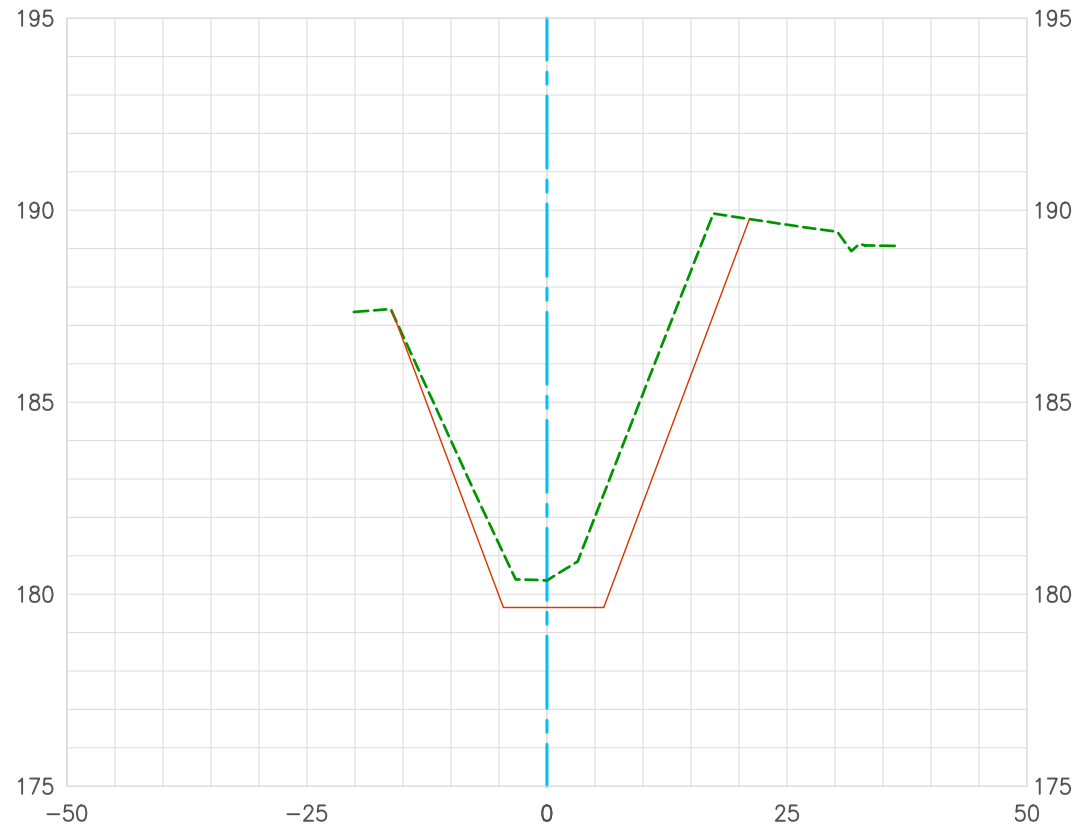


Topography Survey (2019)
Record As-Built Plan F07-101-4A (1960)
Construction Centerline
Date Prepared: 05/08/2019

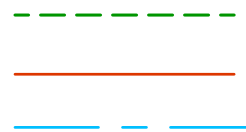


Horizontal Scale: 1"=20'
Vertical Scale: 1"=5'

U.S. Survey Foot

OC Public Works/Engineering Services
OC Survey/Field Services
Boundary Analysis & Mapping

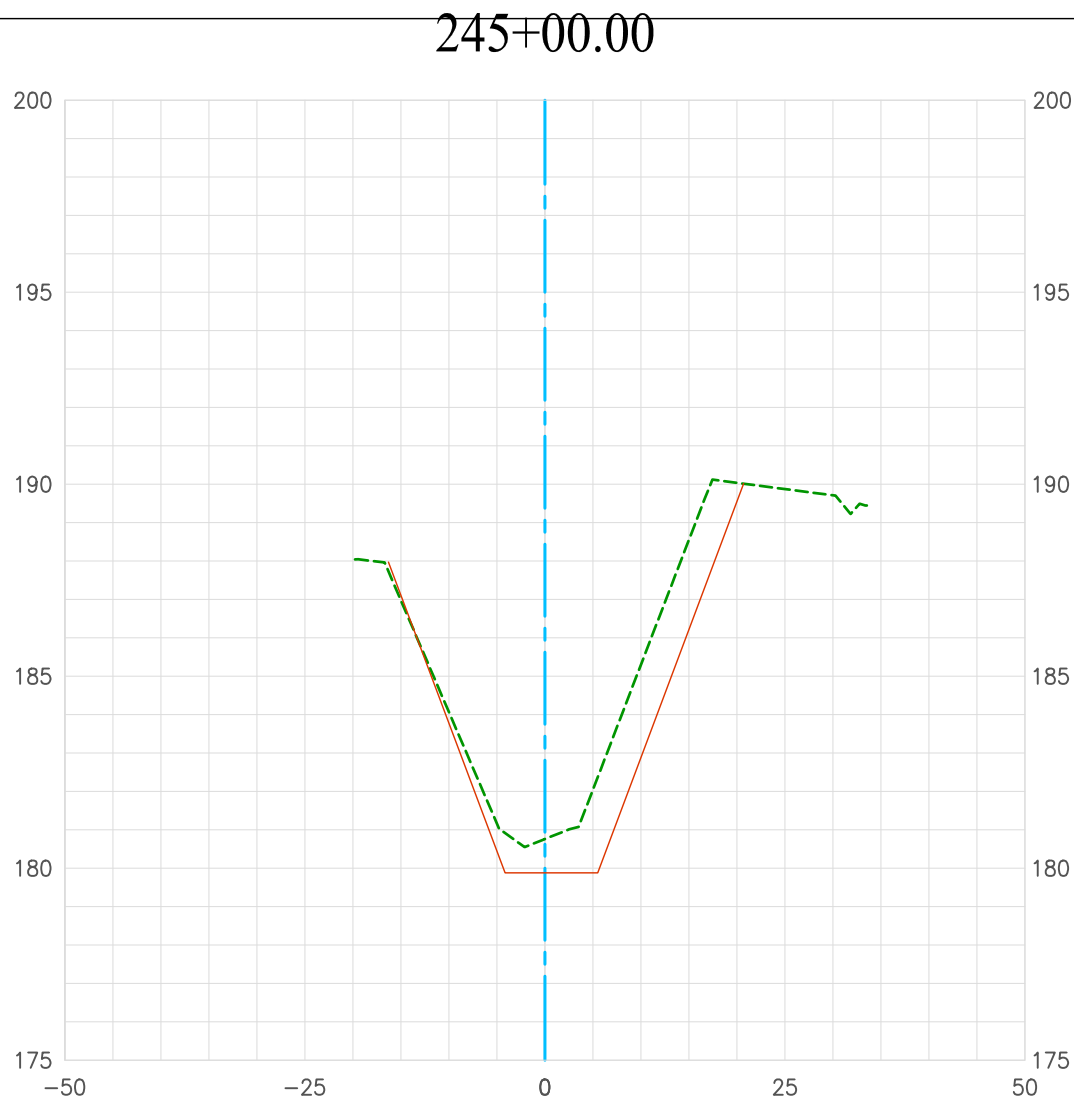

Topography Survey (2019)
Record As-Built Plan F07-101-4A (1960)
Construction Centerline
Date Prepared: 05/08/2019

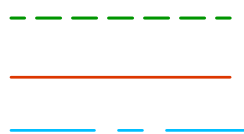


Horizontal Scale: 1"=20'
Vertical Scale: 1"=5'

**U.S. Survey
Foot**


OC Public Works/Engineering Services
OC Survey/Field Services
Boundary Analysis & Mapping



EL MODENA CHANNEL (F07) 245+50.00

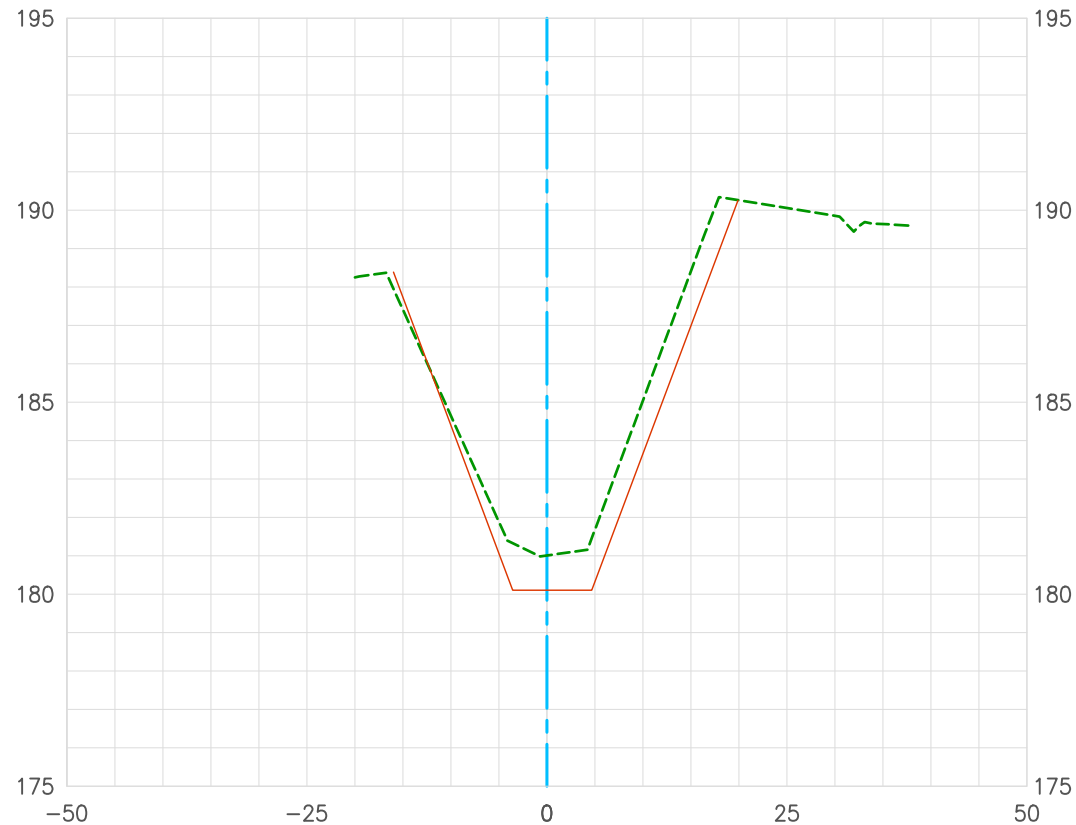

Topography Survey (2019)
Record As-Built Plan F07-101-4A (1960)
Construction Centerline
Date Prepared: 05/08/2019

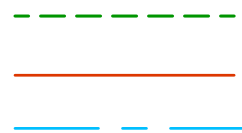


Horizontal Scale: 1"=20'
Vertical Scale: 1"=5'

**U.S. Survey
Foot**


OC Public Works/Engineering Services
OC Survey/Field Services
Boundary Analysis & Mapping



EL MODENA CHANNEL (F07) 246+00.00

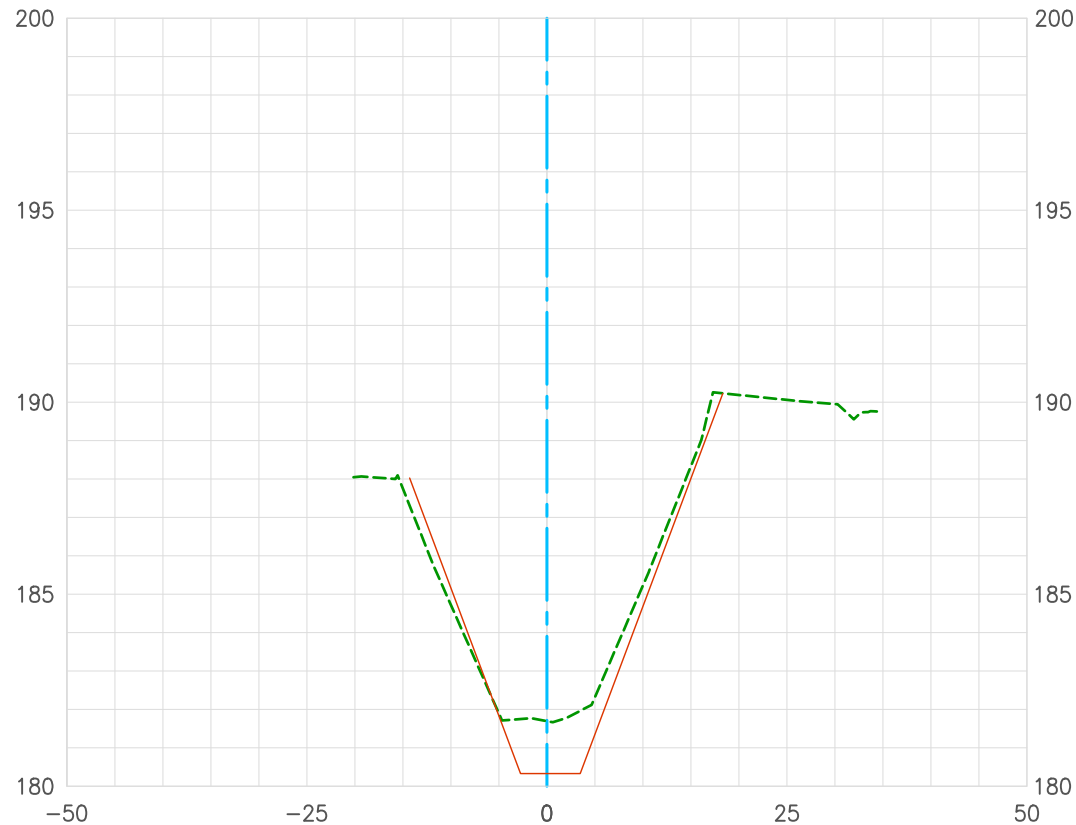

Topography Survey (2019)
Record As-Built Plan F07-101-4A (1960)
Construction Centerline
Date Prepared: 05/08/2019

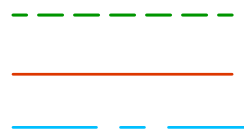


Horizontal Scale: 1"=20'
Vertical Scale: 1"=5'

**U.S. Survey
Foot**


OC Public Works/Engineering Services
OC Survey/Field Services
Boundary Analysis & Mapping



EL MODENA CHANNEL (F07) 246+37.40

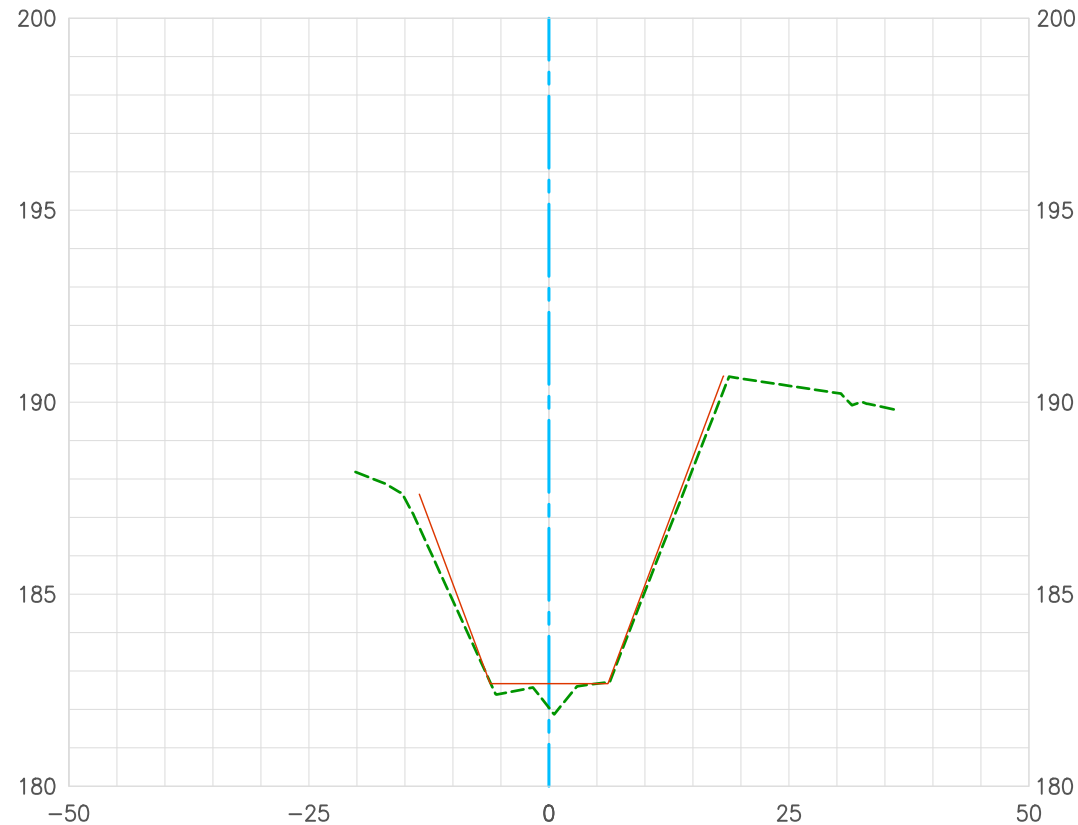

Topography Survey (2019)
Record As-Built Plan F07-101-4A (1960)
Construction Centerline
Date Prepared: 05/08/2019

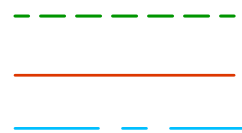


Horizontal Scale: 1"=20'
Vertical Scale: 1"=5'

**U.S. Survey
Foot**


OC Public Works/Engineering Services
OC Survey/Field Services
Boundary Analysis & Mapping



EL MODENA CHANNEL (F07) 247+00.00

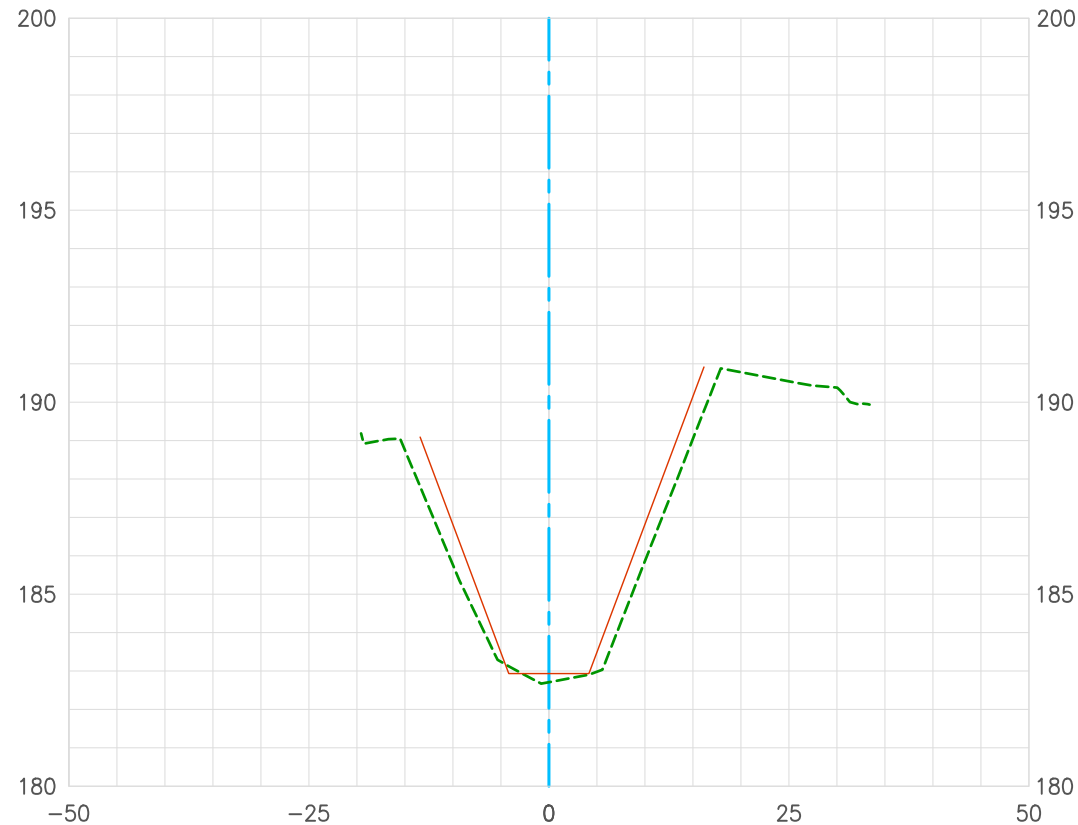

Topography Survey (2019)
Record As-Built Plan F07-101-4A (1960)
Construction Centerline
Date Prepared: 05/08/2019

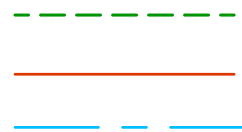


Horizontal Scale: 1"=20'
Vertical Scale: 1"=5'

**U.S. Survey
Foot**


OC Public Works/Engineering Services
OC Survey/Field Services
Boundary Analysis & Mapping



EL MODENA CHANNEL (F07) 248+00.00

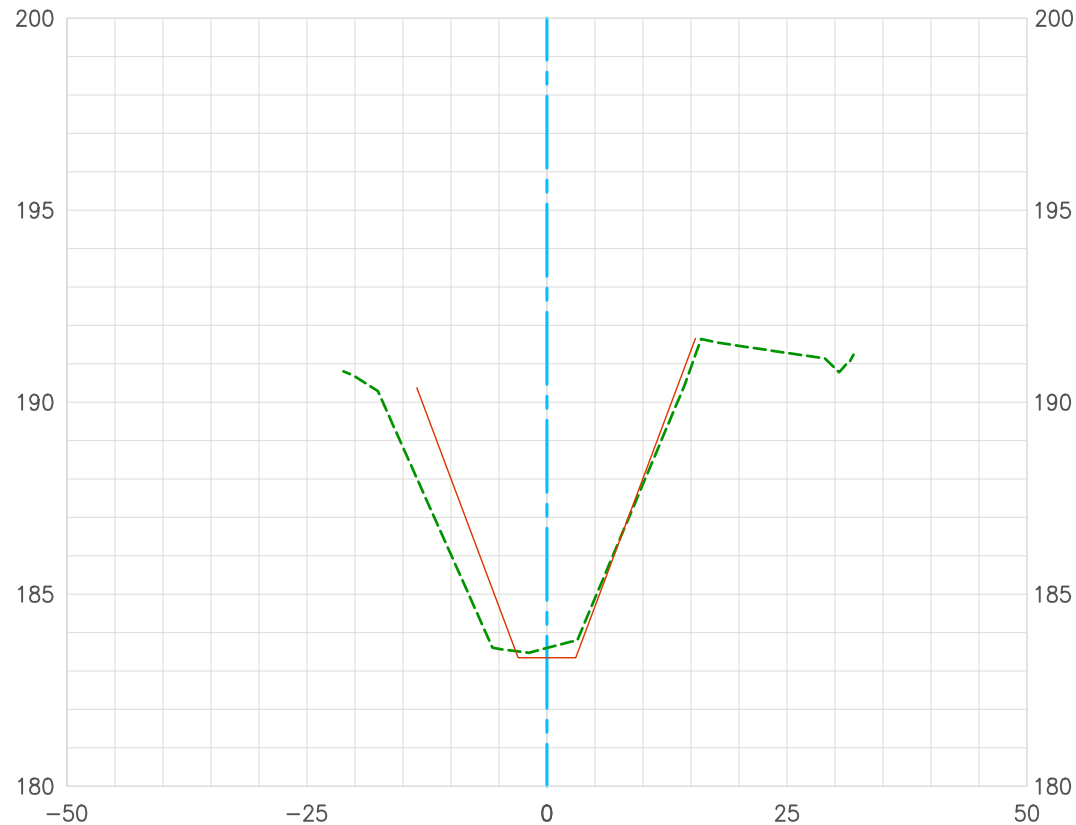

Topography Survey (2019)
Record As-Built Plan F07-101-4A (1960)
Construction Centerline
Date Prepared: 05/08/2019

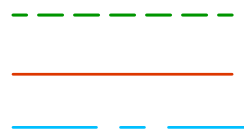


Horizontal Scale: 1"=20'
Vertical Scale: 1"=5'

**U.S. Survey
Foot**


OC Public Works/Engineering Services
OC Survey/Field Services
Boundary Analysis & Mapping



EL MODENA CHANNEL (F07) 248+50.00

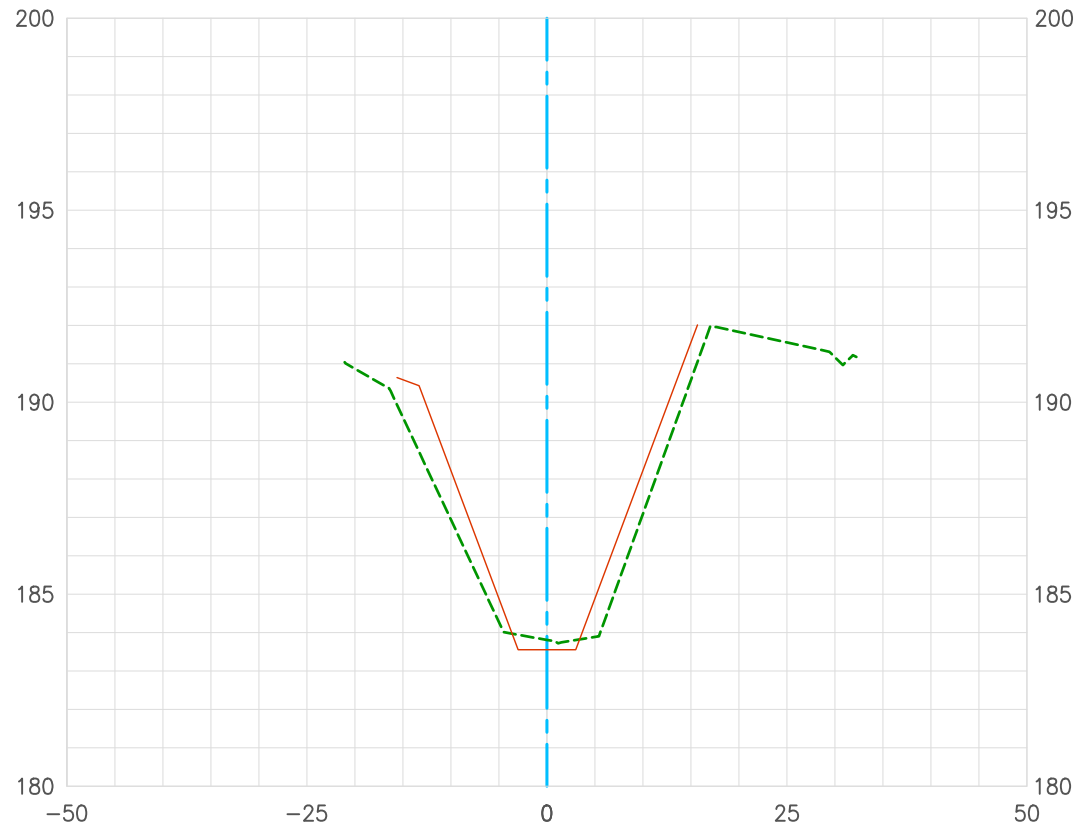

Topography Survey (2019)
Record As-Built Plan F07-101-4A (1960)
Construction Centerline
Date Prepared: 05/08/2019

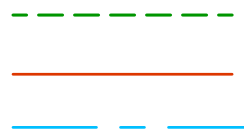


Horizontal Scale: 1"=20'
Vertical Scale: 1"=5'

**U.S. Survey
Foot**


OC Public Works/Engineering Services
OC Survey/Field Services
Boundary Analysis & Mapping



EL MODENA CHANNEL (F07) 249+00.00

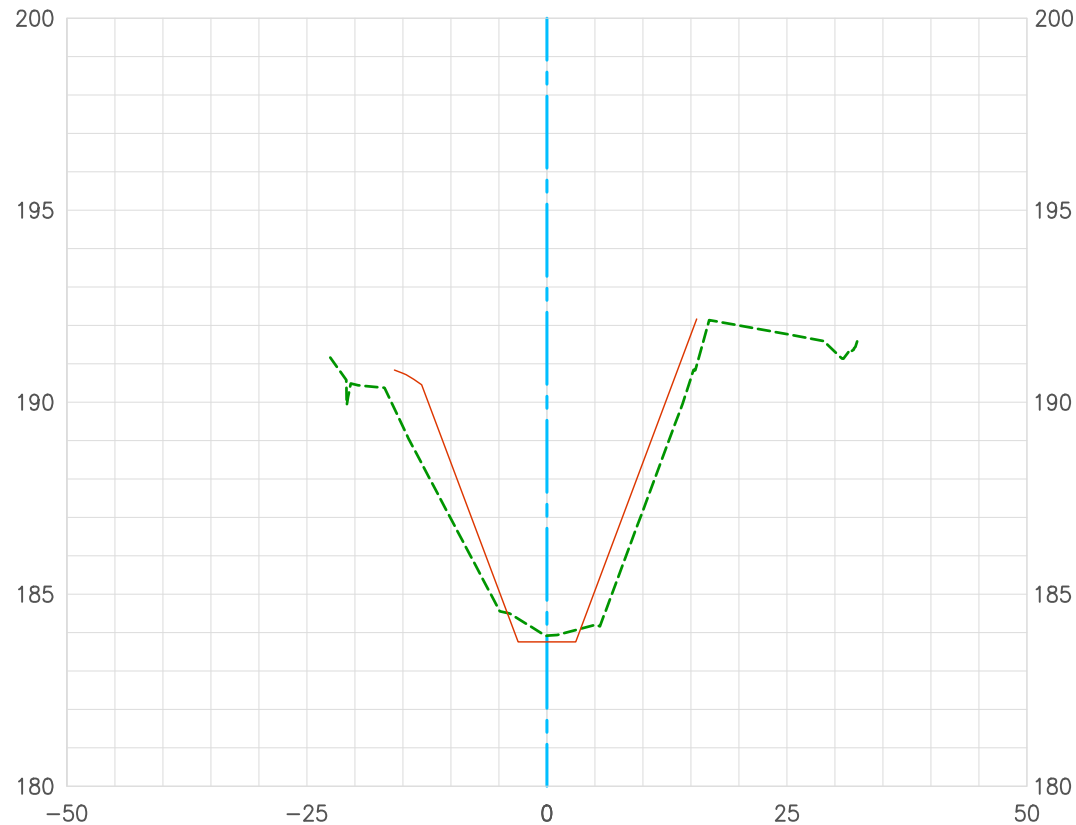

Topography Survey (2019)
Record As-Built Plan F07-101-4A (1960)
Construction Centerline
Date Prepared: 05/08/2019

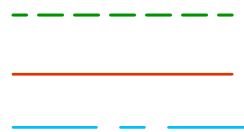


Horizontal Scale: 1"=20'
Vertical Scale: 1"=5'

**U.S. Survey
Foot**


OC Public Works/Engineering Services
OC Survey/Field Services
Boundary Analysis & Mapping



EL MODENA CHANNEL (F07) 249+50.00

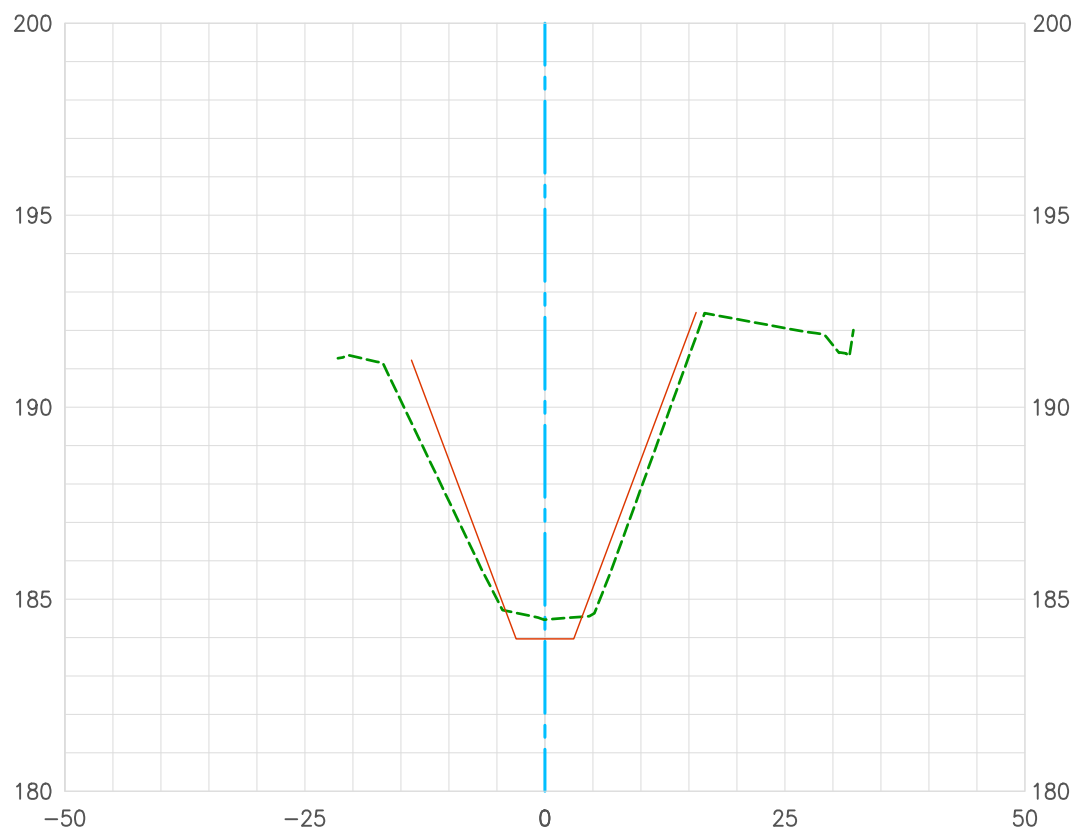

Topography Survey (2019)
Record As-Built Plan F07-101-4A (1960)
Construction Centerline
Date Prepared: 05/08/2019

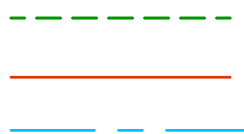


Horizontal Scale: 1"=20'
Vertical Scale: 1"=5'

**U.S. Survey
Foot**


OC Public Works/Engineering Services
OC Survey/Field Services
Boundary Analysis & Mapping



EL MODENA CHANNEL (F07) 250+00.00

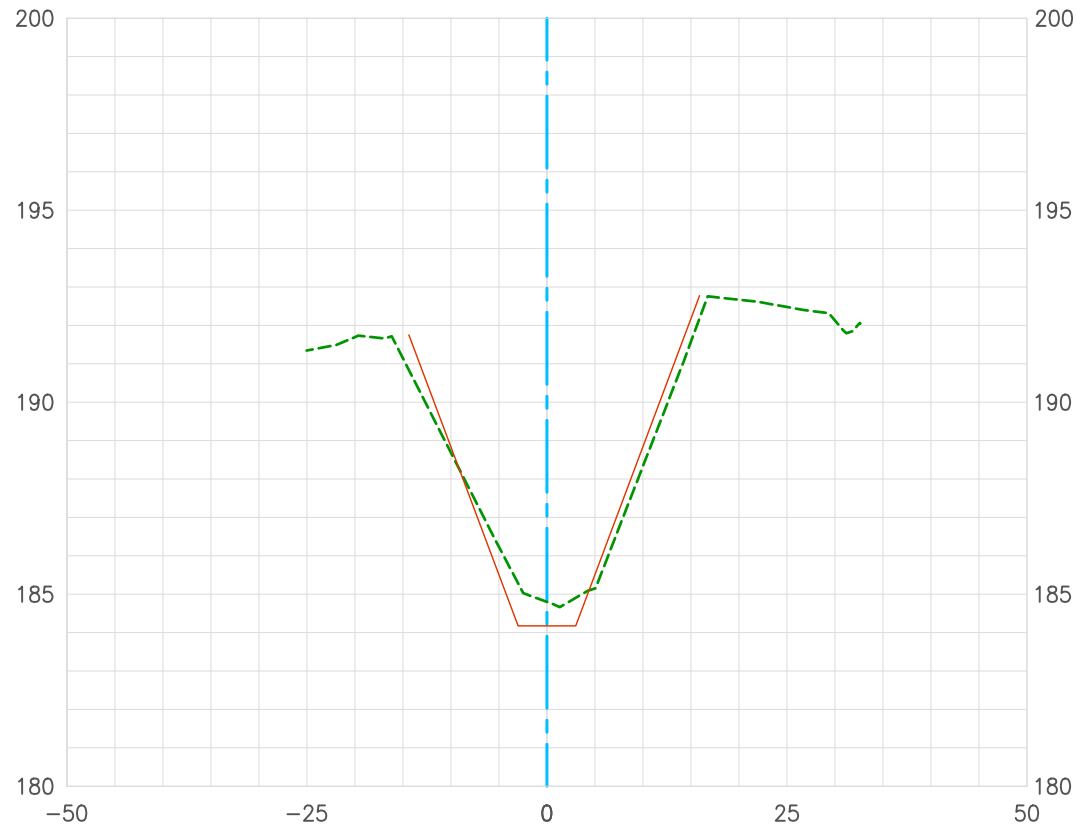

Topography Survey (2019)
Record As-Built Plan F07-101-4A (1960)
Construction Centerline
Date Prepared: 05/08/2019

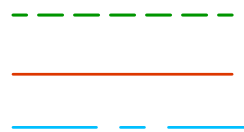


Horizontal Scale: 1"=20'
Vertical Scale: 1"=5'

**U.S. Survey
Foot**


OC Public Works/Engineering Services
OC Survey/Field Services
Boundary Analysis & Mapping



EL MODENA CHANNEL (F07) 250+50.00

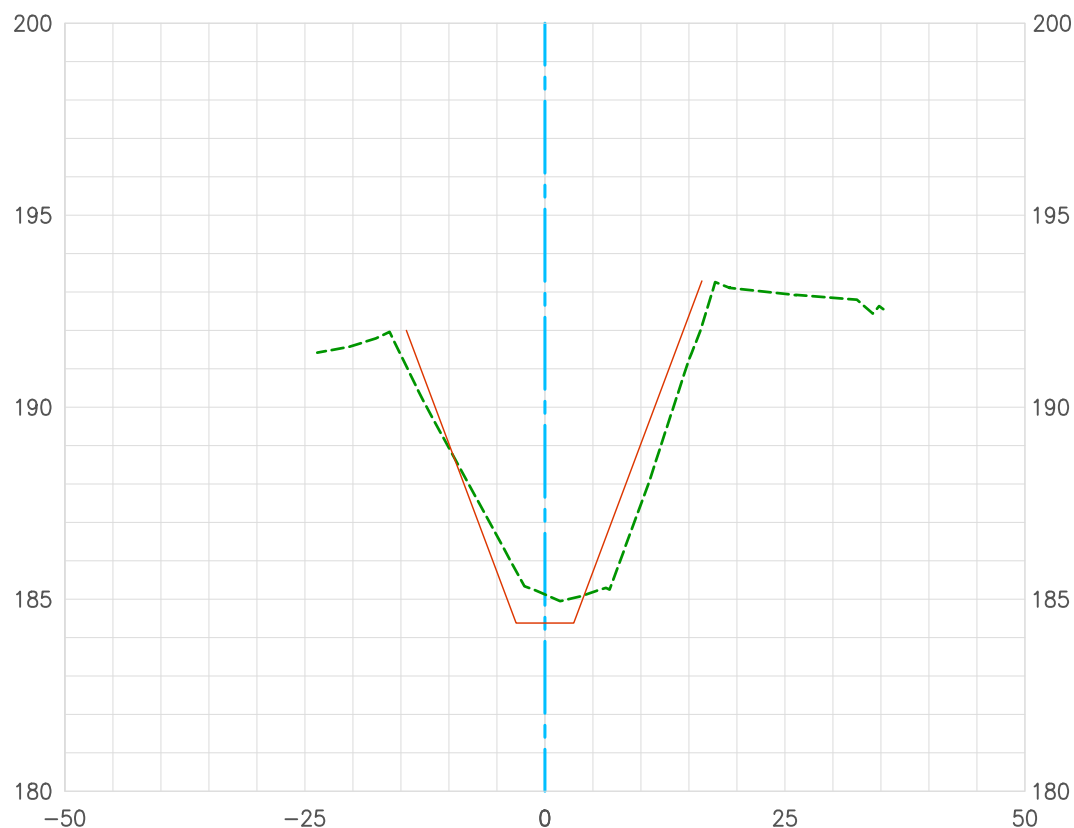

Topography Survey (2019)
Record As-Built Plan F07-101-4A (1960)
Construction Centerline
Date Prepared: 05/08/2019

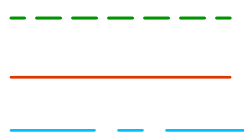


Horizontal Scale: 1"=20'
Vertical Scale: 1"=5'

**U.S. Survey
Foot**


OC Public Works/Engineering Services
OC Survey/Field Services
Boundary Analysis & Mapping



EL MODENA CHANNEL (F07) 251+00.00

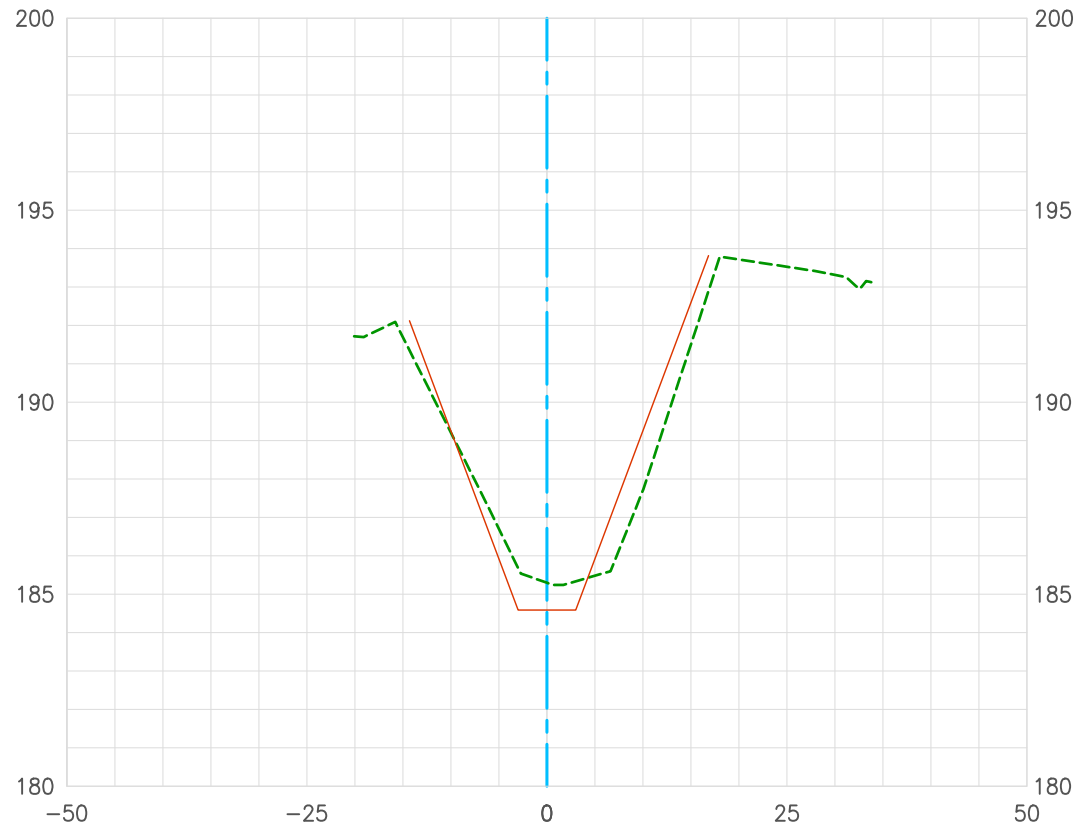

Topography Survey (2019)
Record As-Built Plan F07-101-4A (1960)
Construction Centerline
Date Prepared: 05/08/2019

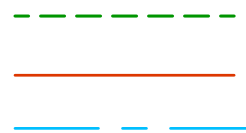


Horizontal Scale: 1"=20'
Vertical Scale: 1"=5'

**U.S. Survey
Foot**


OC Public Works/Engineering Services
OC Survey/Field Services
Boundary Analysis & Mapping



EL MODENA CHANNEL (F07) 251+50.00

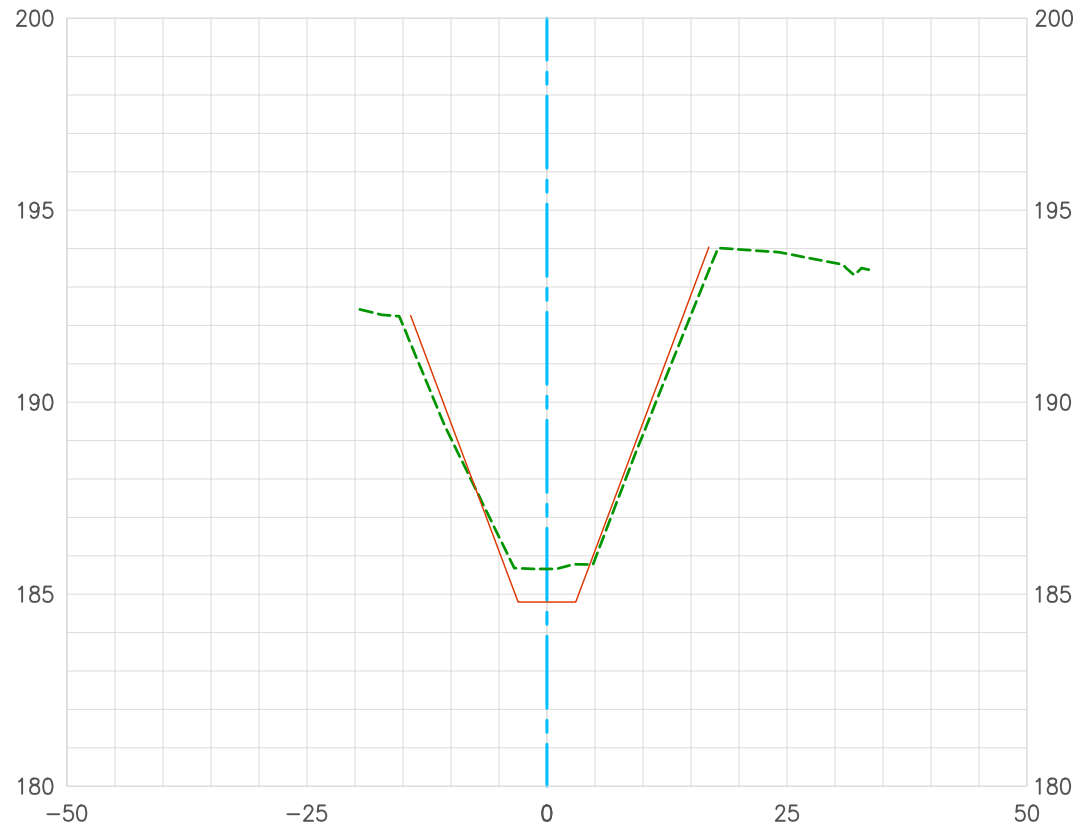

Topography Survey (2019)
Record As-Built Plan F07-101-4A (1960)
Construction Centerline
Date Prepared: 05/08/2019

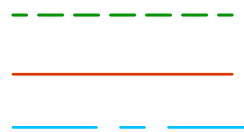


Horizontal Scale: 1"=20'
Vertical Scale: 1"=5'

U.S. Survey Foot


OC Public Works/Engineering Services
OC Survey/Field Services
Boundary Analysis & Mapping



EL MODENA CHANNEL (F07) 253+95.61

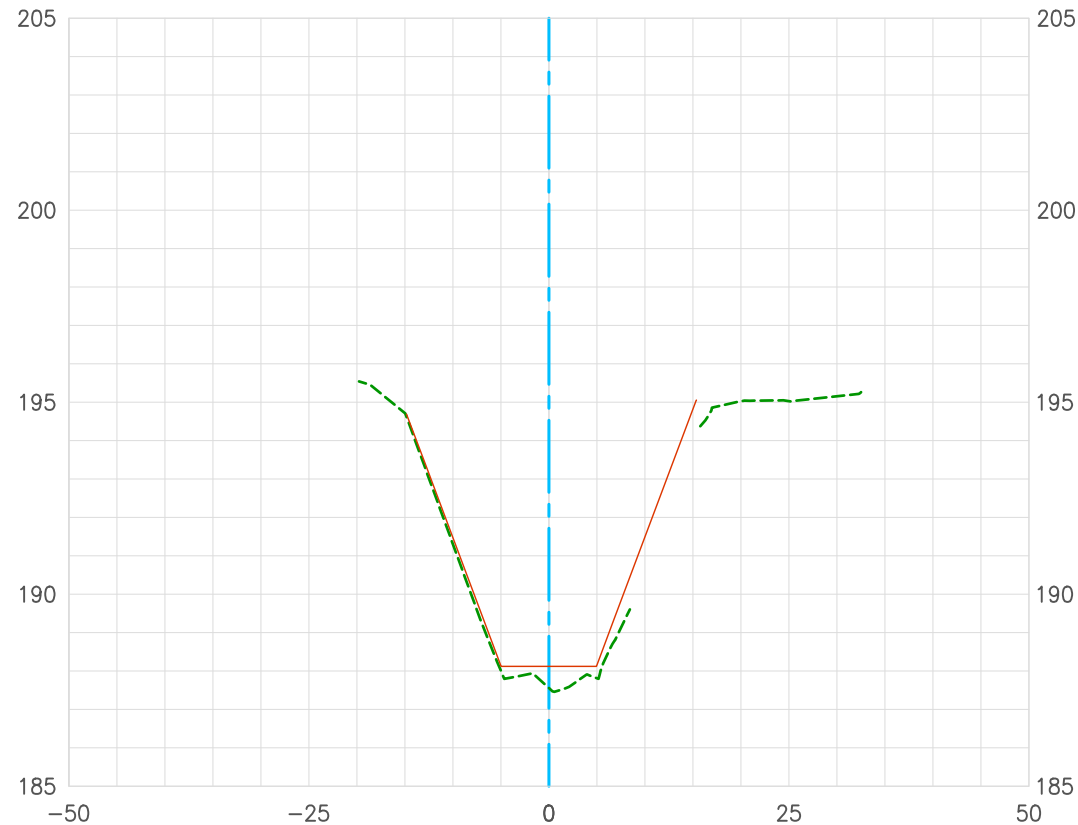

Topography Survey (2019)
Record As-Built Plan F07-101-4A (1960)
Construction Centerline
Date Prepared: 05/08/2019

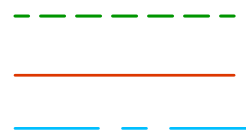


Horizontal Scale: 1"=20'
Vertical Scale: 1"=5'

**U.S. Survey
Foot**


OC Public Works/Engineering Services
OC Survey/Field Services
Boundary Analysis & Mapping



EL MODENA CHANNEL (F07) 254+50.00

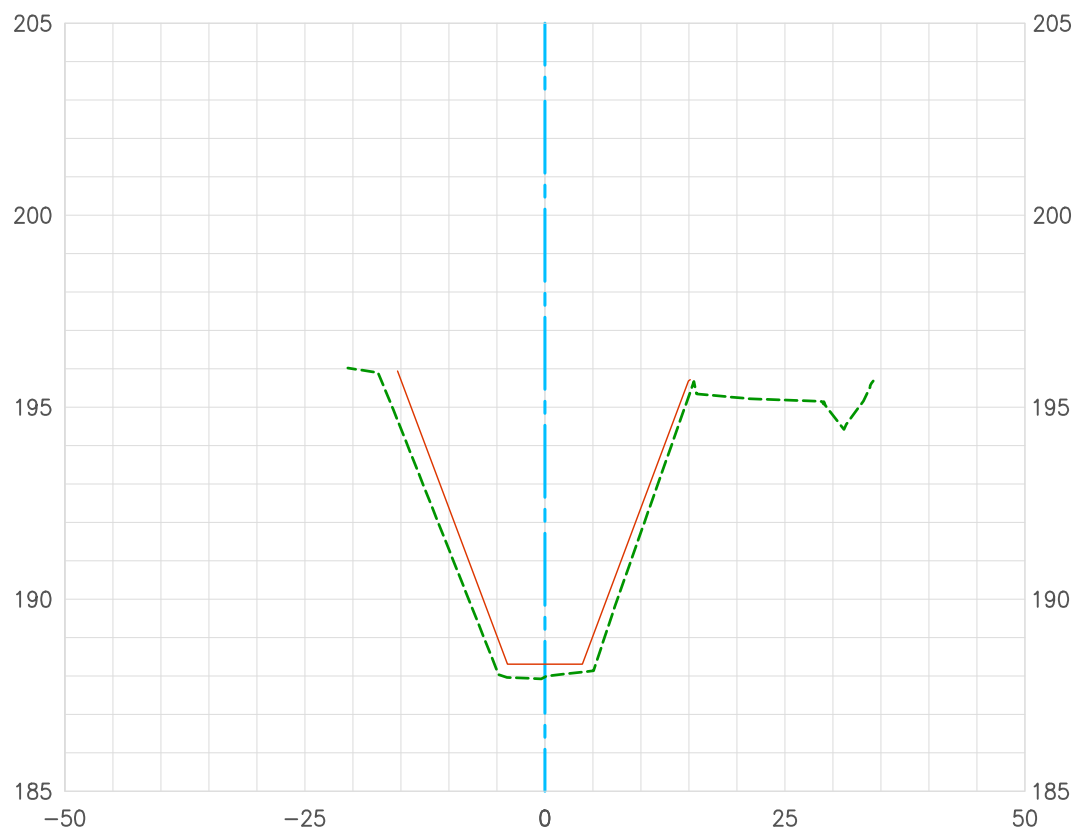

Topography Survey (2019)
Record As-Built Plan F07-101-4A (1960)
Construction Centerline
Date Prepared: 05/08/2019

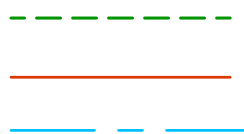


Horizontal Scale: 1"=20'
Vertical Scale: 1"=5'

**U.S. Survey
Foot**


OC Public Works/Engineering Services
OC Survey/Field Services
Boundary Analysis & Mapping



EL MODENA CHANNEL (F07) 255+00.00

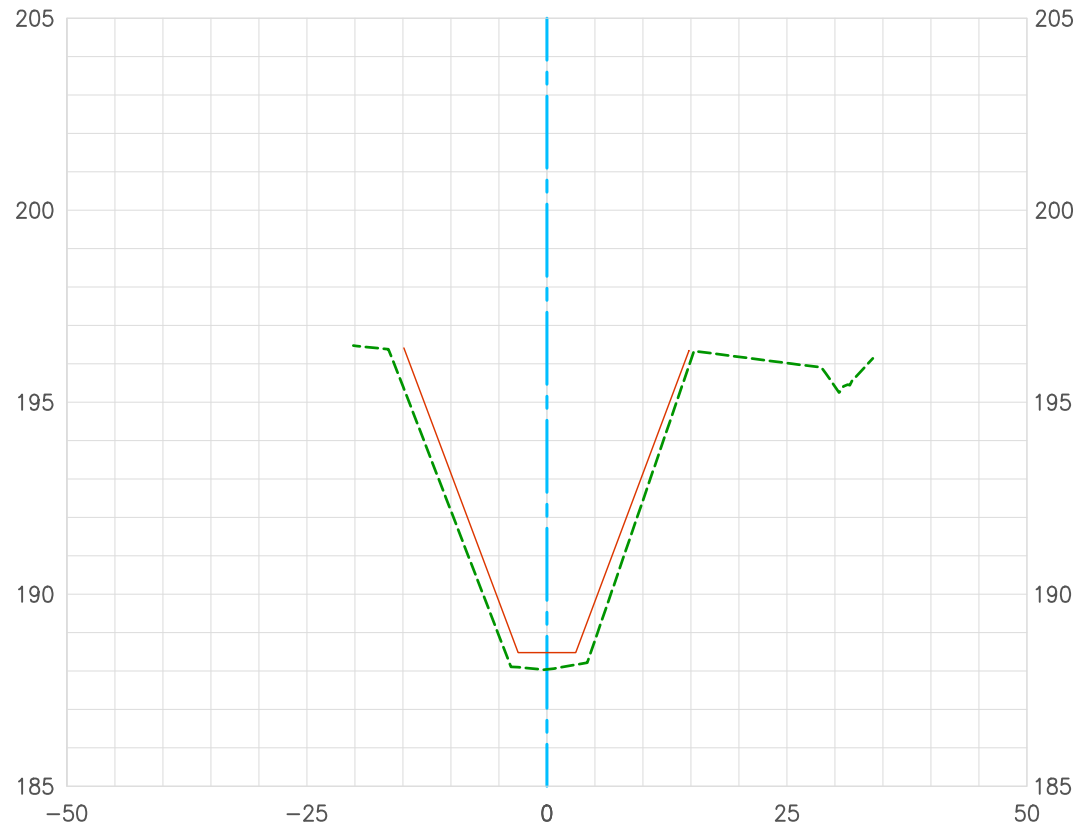

Topography Survey (2019)
Record As-Built Plan F07-101-4A (1960)
Construction Centerline
Date Prepared: 05/08/2019

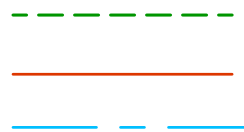


Horizontal Scale: 1"=20'
Vertical Scale: 1"=5'

**U.S. Survey
Foot**


OC Public Works/Engineering Services
OC Survey/Field Services
Boundary Analysis & Mapping



EL MODENA CHANNEL (F07) 255+50.00

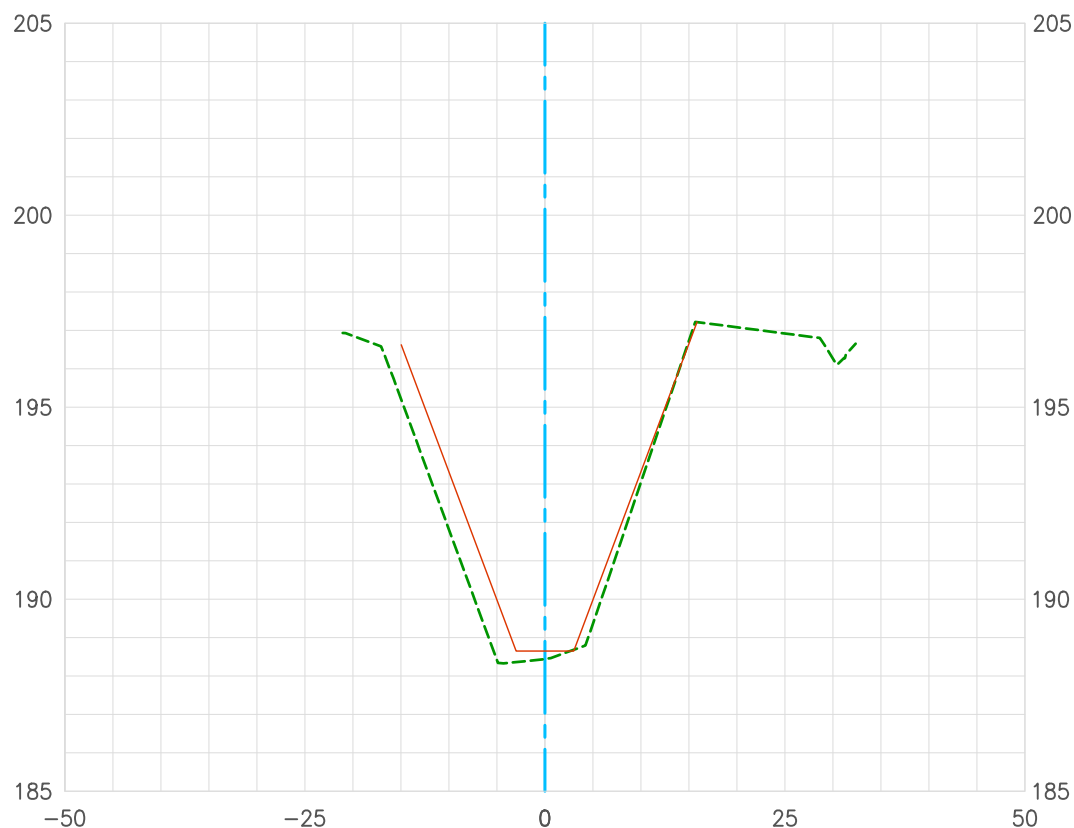

Topography Survey (2019)
Record As-Built Plan F07-101-4A (1960)
Construction Centerline
Date Prepared: 05/08/2019

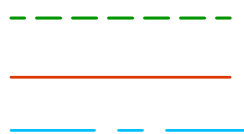


Horizontal Scale: 1"=20'
Vertical Scale: 1"=5'

**U.S. Survey
Foot**


OC Public Works/Engineering Services
OC Survey/Field Services
Boundary Analysis & Mapping



EL MODENA CHANNEL (F07) 256+00.00

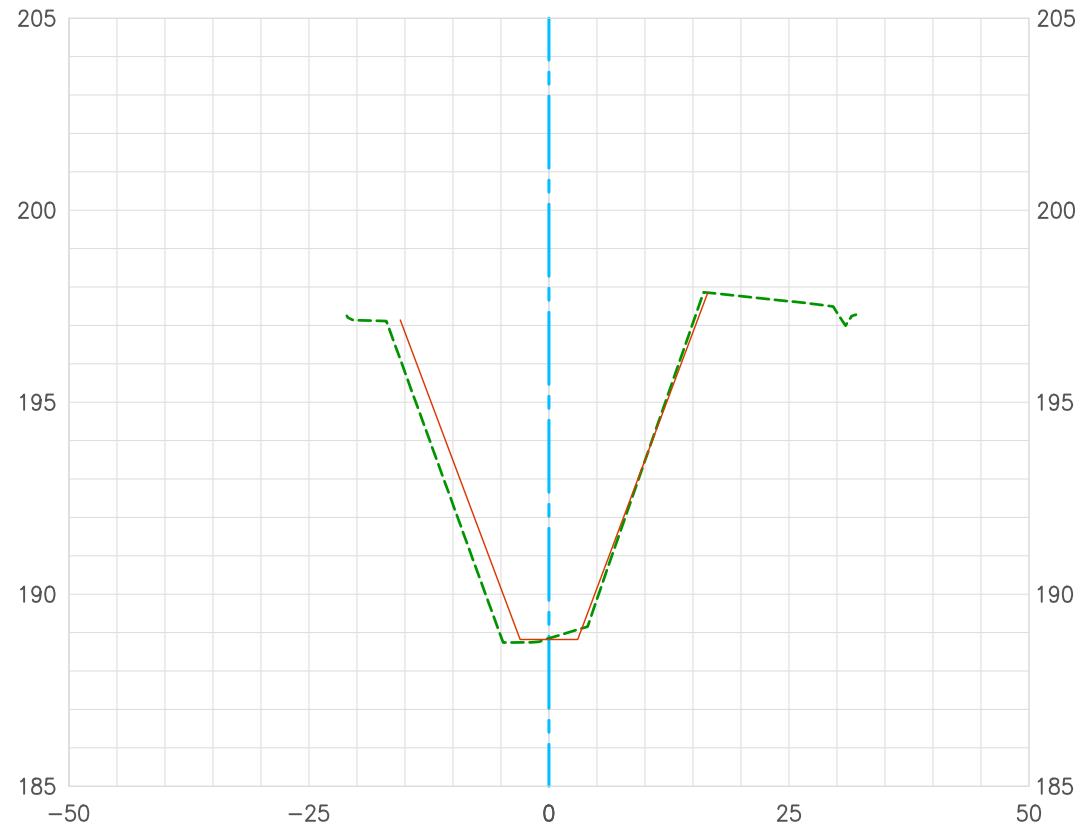

Topography Survey (2019)
Record As-Built Plan F07-101-4A (1960)
Construction Centerline
Date Prepared: 05/08/2019

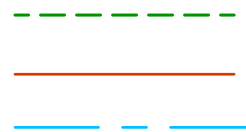


Horizontal Scale: 1"=20'
Vertical Scale: 1"=5'

**U.S. Survey
Foot**


OC Public Works/Engineering Services
OC Survey/Field Services
Boundary Analysis & Mapping



EL MODENA CHANNEL (F07) 256+50.00

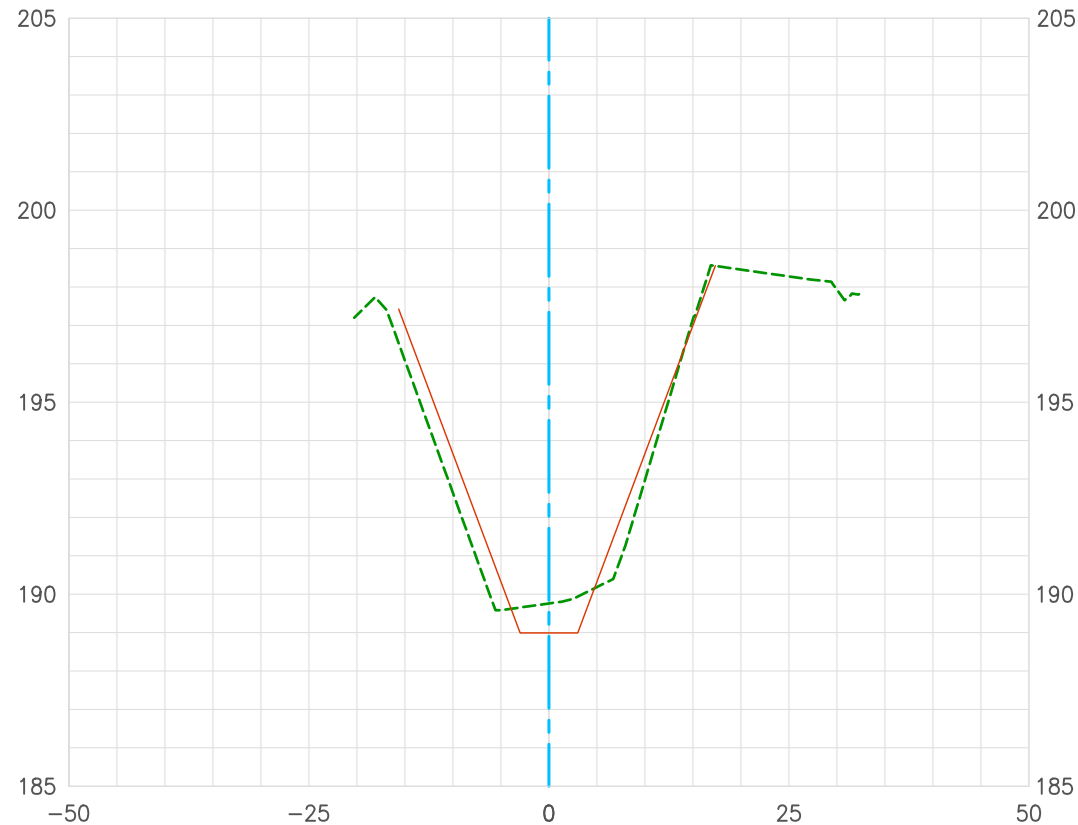

Topography Survey (2019)
Record As-Built Plan F07-101-4A (1960)
Construction Centerline
Date Prepared: 05/08/2019

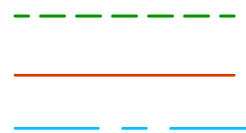


Horizontal Scale: 1"=20'
Vertical Scale: 1"=5'

**U.S. Survey
Foot**


OC Public Works/Engineering Services
OC Survey/Field Services
Boundary Analysis & Mapping



EL MODENA CHANNEL (F07) 257+00.00

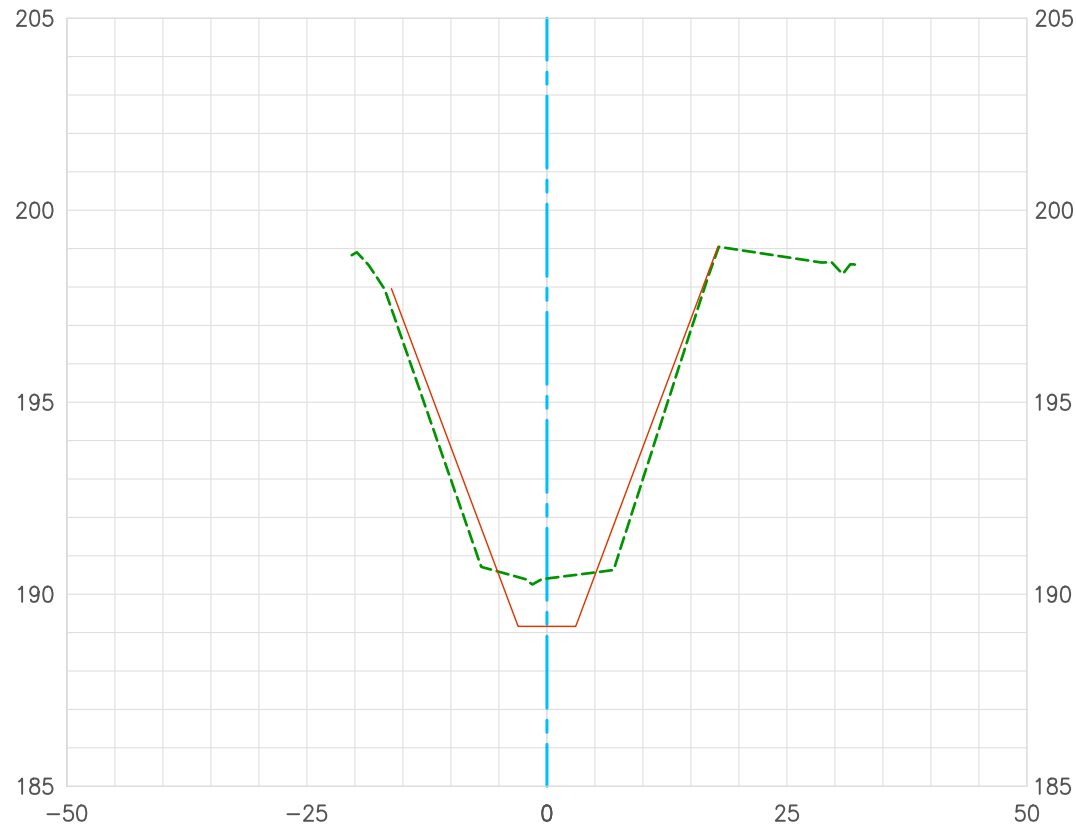

Topography Survey (2019)
Record As-Built Plan F07-101-4A (1960)
Construction Centerline
Date Prepared: 05/08/2019

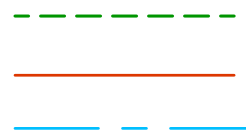


Horizontal Scale: 1"=20'
Vertical Scale: 1"=5'

**U.S. Survey
Foot**


OC Public Works/Engineering Services
OC Survey/Field Services
Boundary Analysis & Mapping



EL MODENA CHANNEL (F07) 260+14.54

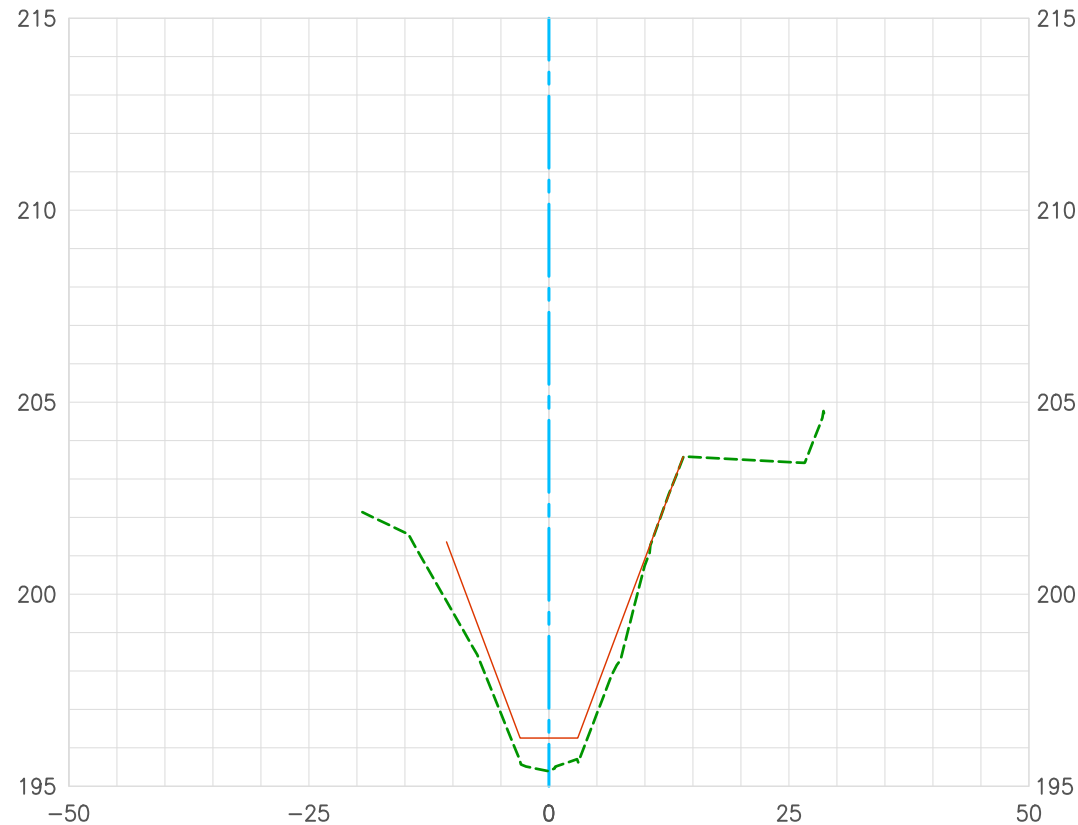

Topography Survey (2019)
Record As-Built Plan F07-101-4A (1960)
Construction Centerline
Date Prepared: 05/08/2019

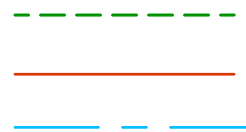


Horizontal Scale: 1"=20'
Vertical Scale: 1"=5'

**U.S. Survey
Foot**


OC Public Works/Engineering Services
OC Survey/Field Services
Boundary Analysis & Mapping



EL MODENA CHANNEL (F07) 261+00.00

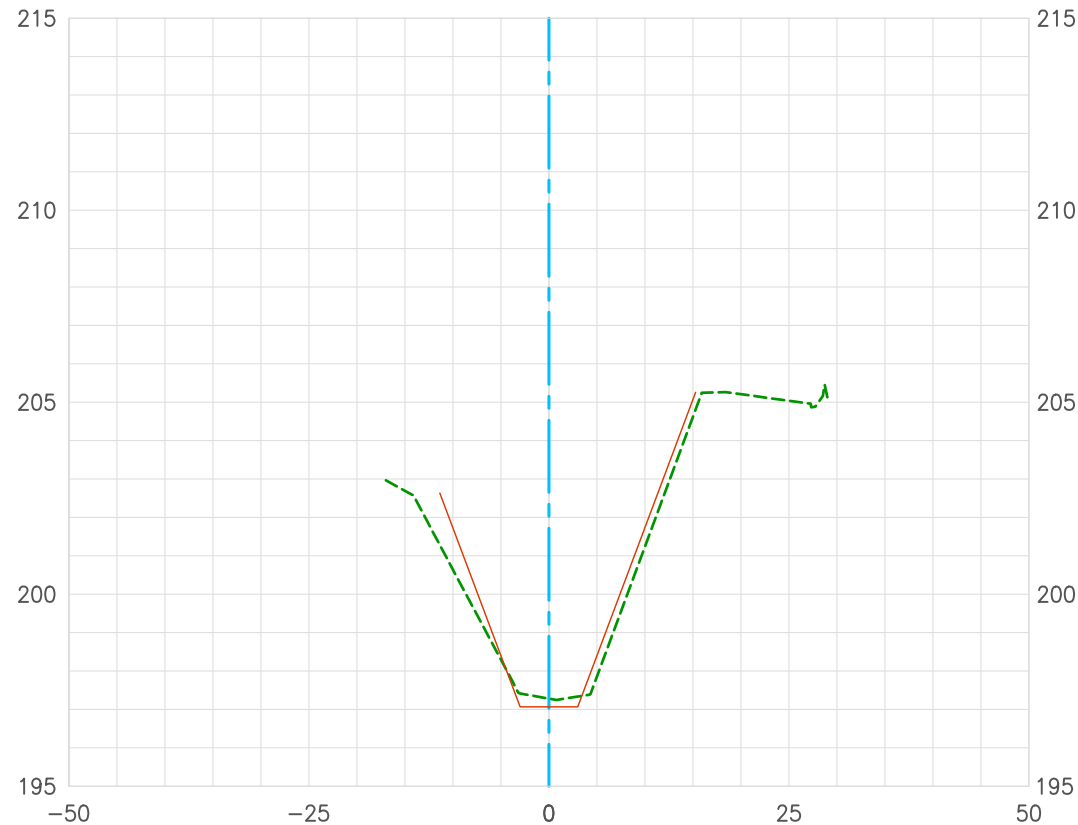

Topography Survey (2019)
Record As-Built Plan F07-101-4A (1960)
Construction Centerline
Date Prepared: 05/08/2019

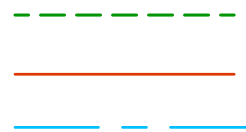


Horizontal Scale: 1"=20'
Vertical Scale: 1"=5'

**U.S. Survey
Foot**


OC Public Works/Engineering Services
OC Survey/Field Services
Boundary Analysis & Mapping



EL MODENA CHANNEL (F07) 261+50.00

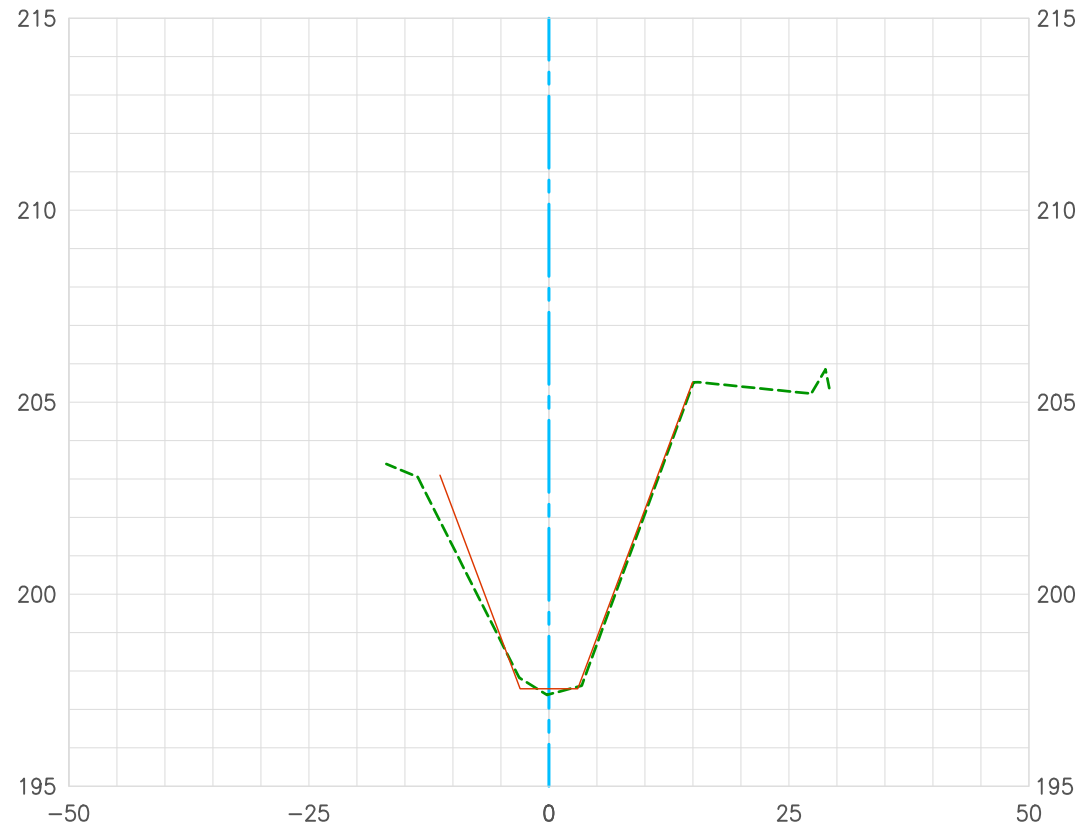

Topography Survey (2019)
Record As-Built Plan F07-101-4A (1960)
Construction Centerline
Date Prepared: 05/08/2019

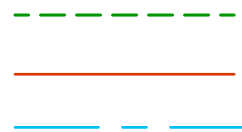


Horizontal Scale: 1"=20'
Vertical Scale: 1"=5'

**U.S. Survey
Foot**


OC Public Works/Engineering Services
OC Survey/Field Services
Boundary Analysis & Mapping



EL MODENA CHANNEL (F07) 262+00.00

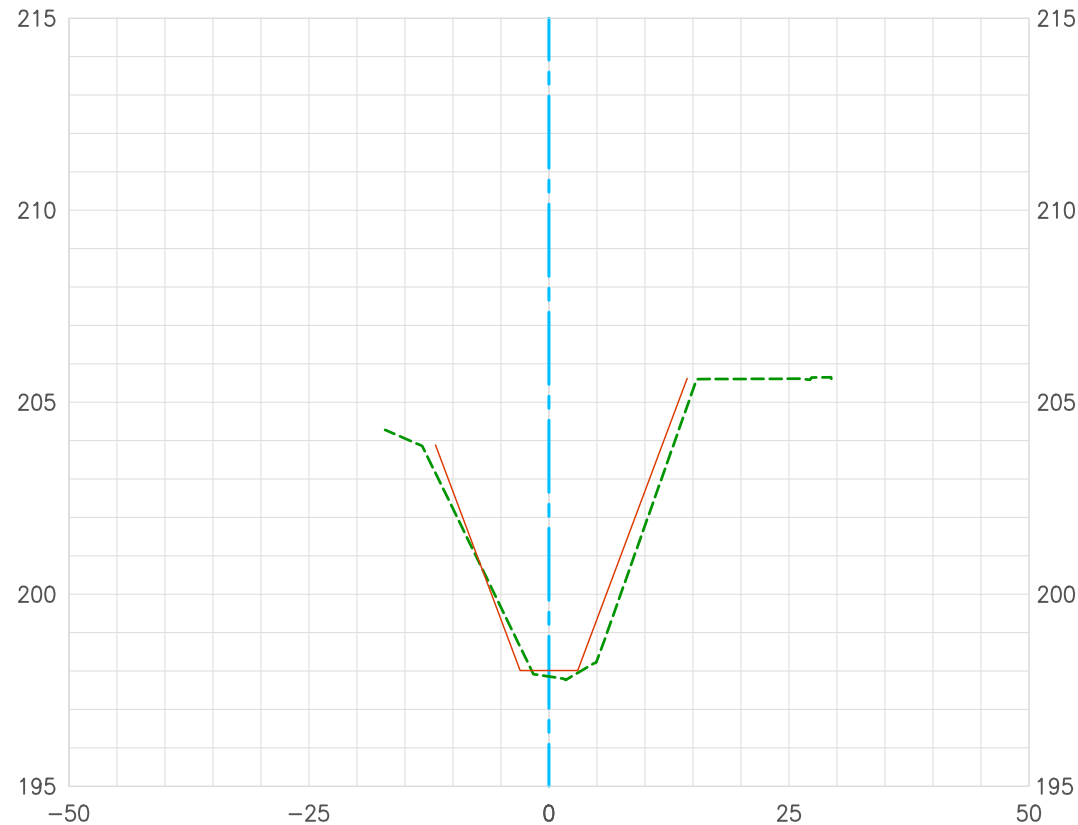

Topography Survey (2019)
Record As-Built Plan F07-101-4A (1960)
Construction Centerline
Date Prepared: 05/08/2019

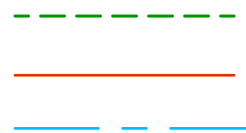


Horizontal Scale: 1"=20'
Vertical Scale: 1"=5'

**U.S. Survey
Foot**


OC Public Works/Engineering Services
OC Survey/Field Services
Boundary Analysis & Mapping



EL MODENA CHANNEL (F07) 262+50.00

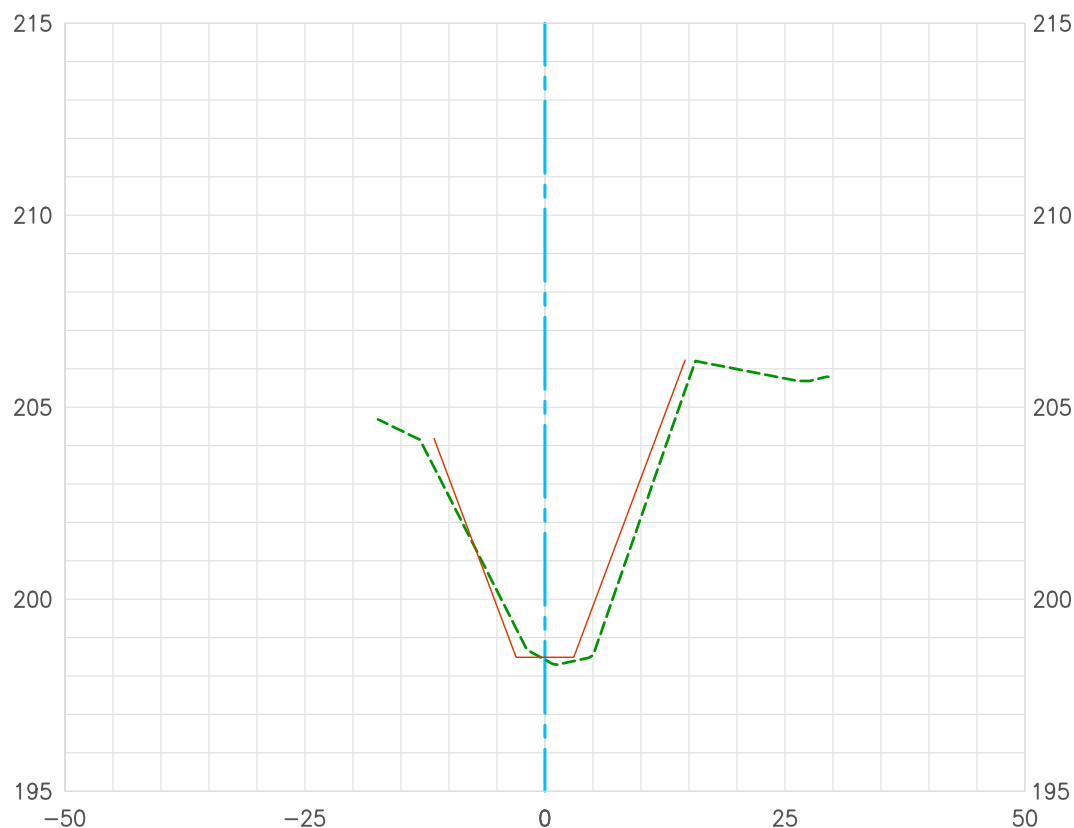

Topography Survey (2019)
Record As-Built Plan F07-101-4A (1960)
Construction Centerline
Date Prepared: 05/08/2019

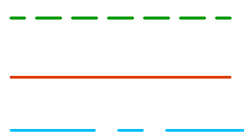


Horizontal Scale: 1"=20'
Vertical Scale: 1"=5'

**U.S. Survey
Foot**


OC Public Works/Engineering Services
OC Survey/Field Services
Boundary Analysis & Mapping



EL MODENA CHANNEL (F07) 263+00.00

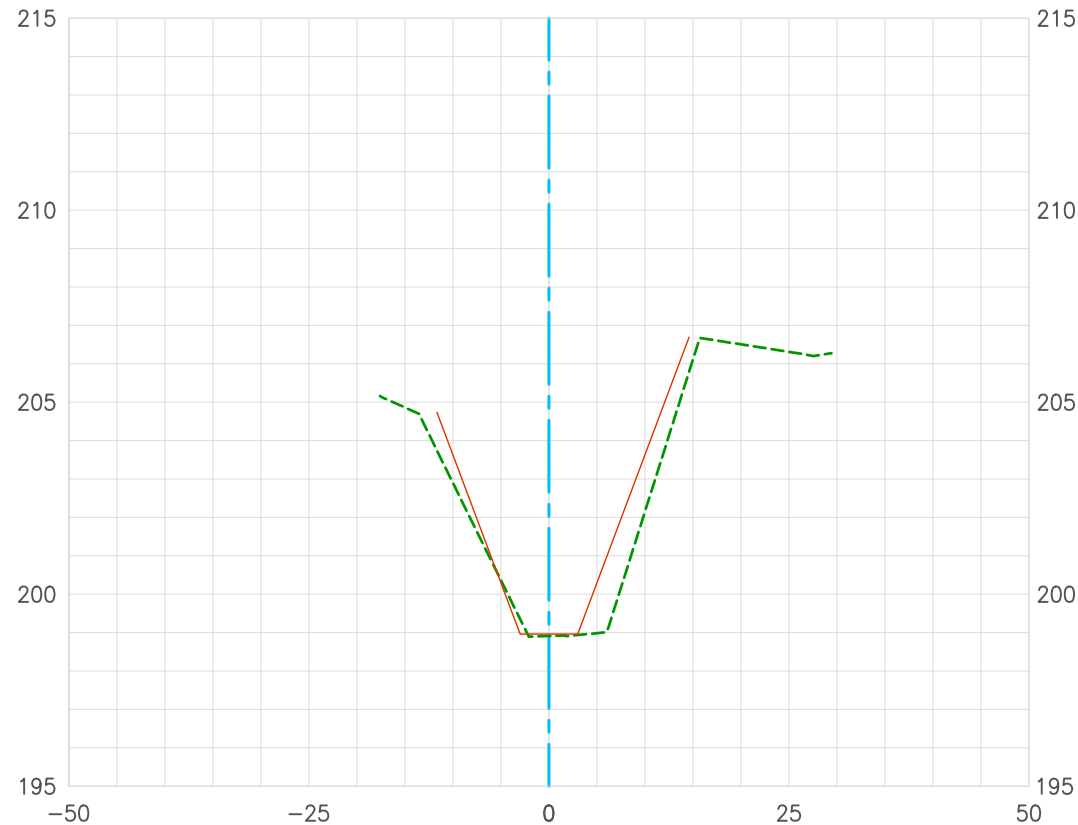

Topography Survey (2019)
Record As-Built Plan F07-101-4A (1960)
Construction Centerline
Date Prepared: 05/08/2019

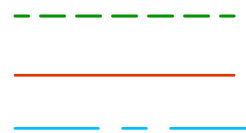


Horizontal Scale: 1"=20'
Vertical Scale: 1"=5'

**U.S. Survey
Foot**


OC Public Works/Engineering Services
OC Survey/Field Services
Boundary Analysis & Mapping



EL MODENA CHANNEL (F07) 263+50.00

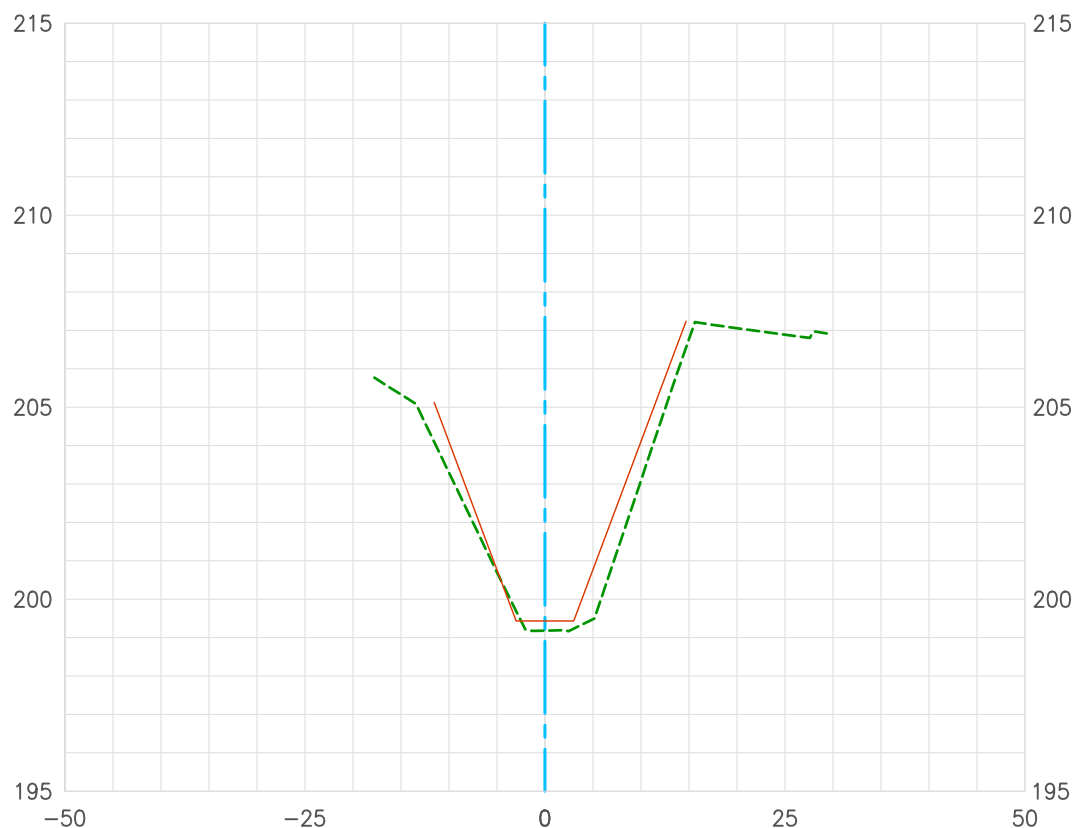

Topography Survey (2019)
Record As-Built Plan F07-101-4A (1960)
Construction Centerline
Date Prepared: 05/08/2019

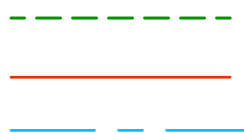


Horizontal Scale: 1"=20'
Vertical Scale: 1"=5'

**U.S. Survey
Foot**


OC Public Works/Engineering Services
OC Survey/Field Services
Boundary Analysis & Mapping



EL MODENA CHANNEL (F07) 264+00.00

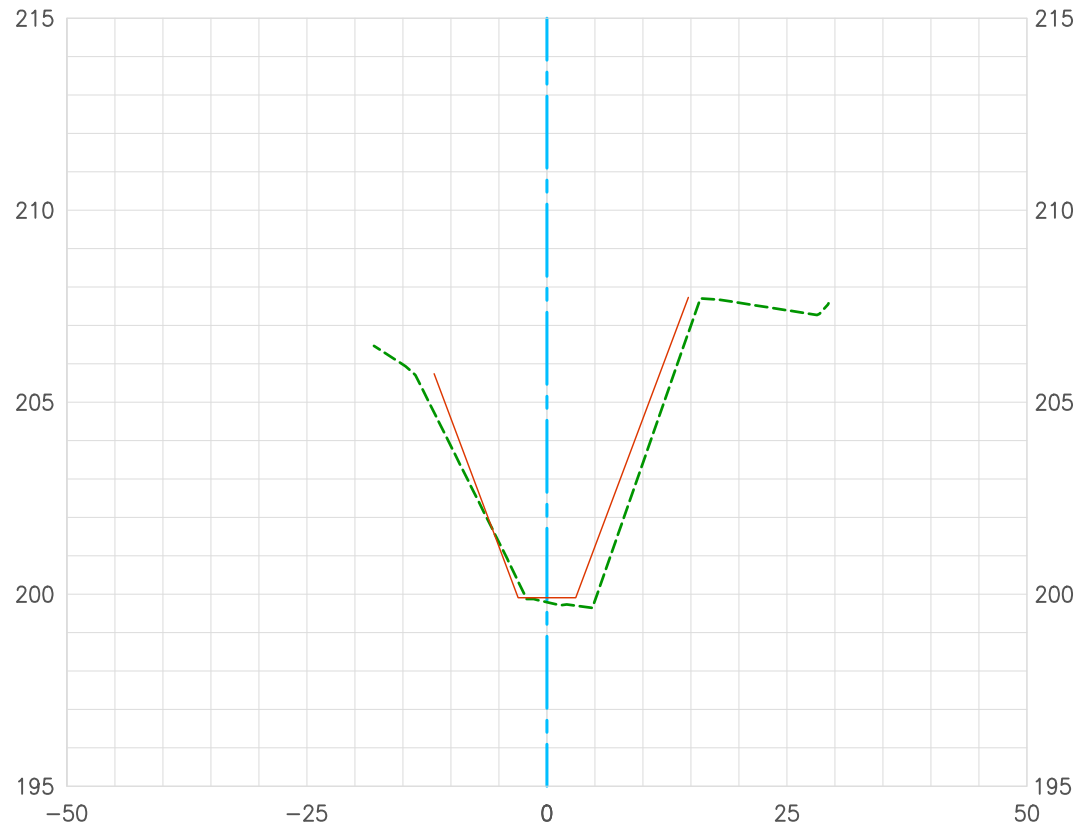

Topography Survey (2019)
Record As-Built Plan F07-101-4A (1960)
Construction Centerline
Date Prepared: 05/08/2019

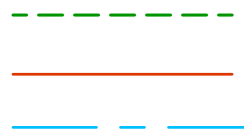


Horizontal Scale: 1"=20'
Vertical Scale: 1"=5'

**U.S. Survey
Foot**


OC Public Works/Engineering Services
OC Survey/Field Services
Boundary Analysis & Mapping



EL MODENA CHANNEL (F07) 264+50.00

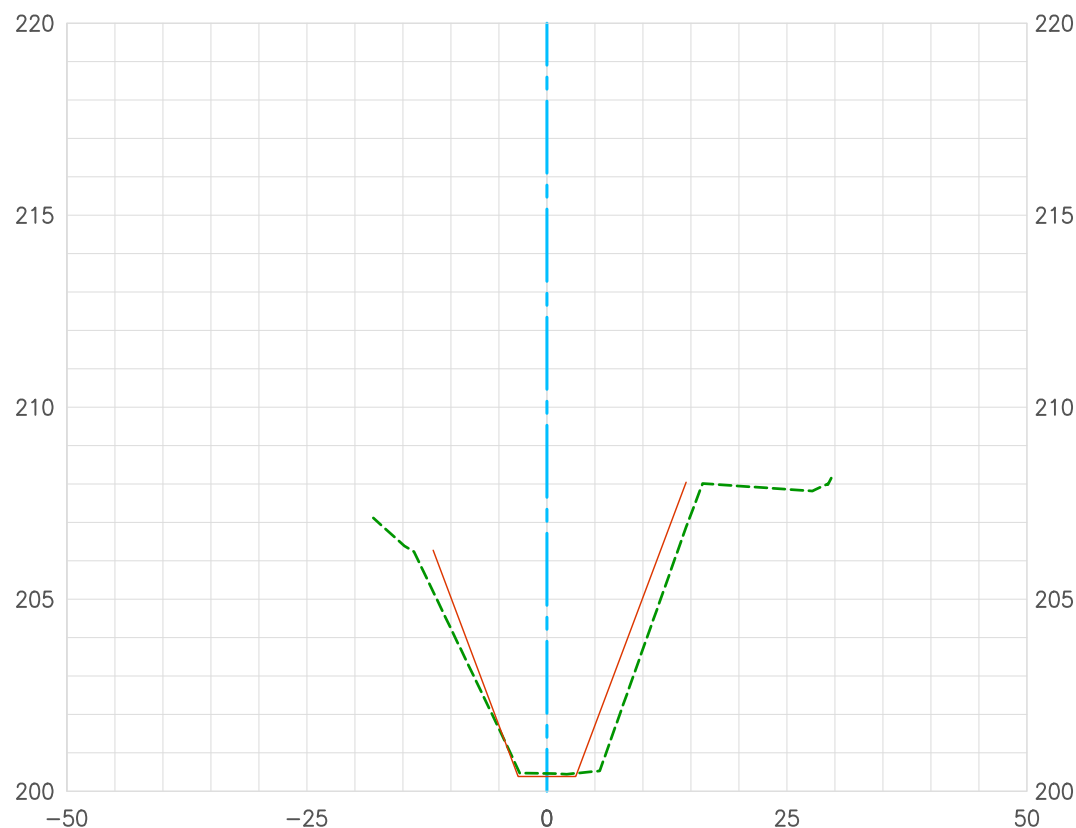

Topography Survey (2019)
Record As-Built Plan F07-101-4A (1960)
Construction Centerline
Date Prepared: 05/08/2019

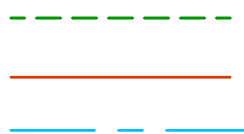


Horizontal Scale: 1"=20'
Vertical Scale: 1"=5'

**U.S. Survey
Foot**


OC Public Works/Engineering Services
OC Survey/Field Services
Boundary Analysis & Mapping



EL MODENA CHANNEL (F07) 265+00.00

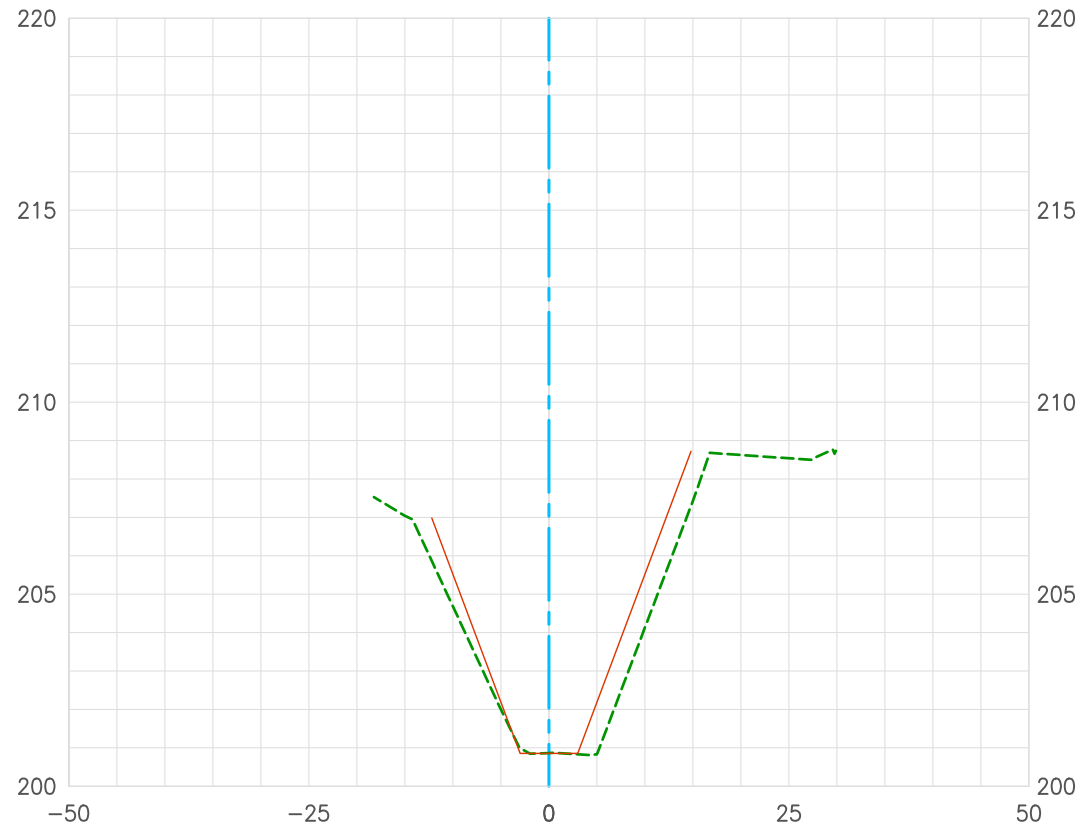

Topography Survey (2019)
Record As-Built Plan F07-101-4A (1960)
Construction Centerline
Date Prepared: 05/08/2019

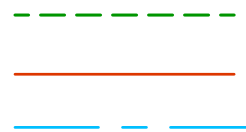


Horizontal Scale: 1"=20'
Vertical Scale: 1"=5'

**U.S. Survey
Foot**


OC Public Works/Engineering Services
OC Survey/Field Services
Boundary Analysis & Mapping



EL MODENA CHANNEL (F07) 265+50.00

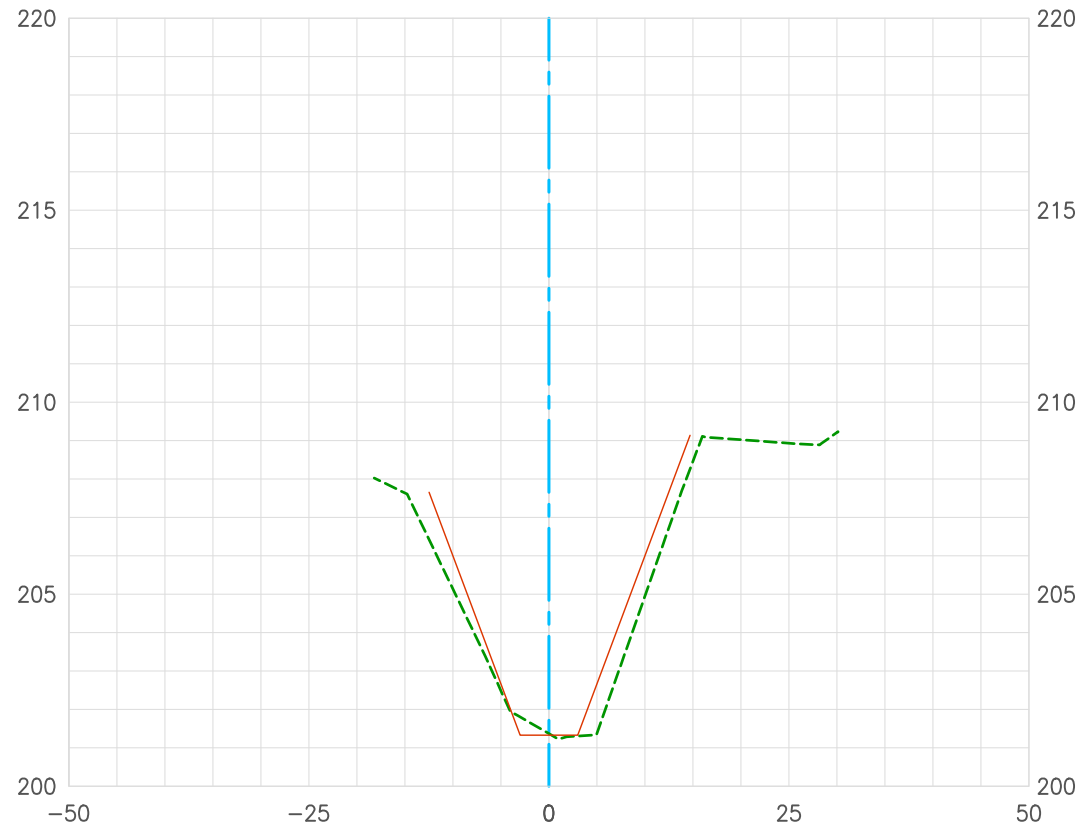

Topography Survey (2019)
Record As-Built Plan F07-101-4A (1960)
Construction Centerline
Date Prepared: 05/08/2019

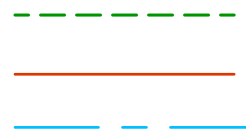


Horizontal Scale: 1"=20'
Vertical Scale: 1"=5'

**U.S. Survey
Foot**


OC Public Works/Engineering Services
OC Survey/Field Services
Boundary Analysis & Mapping



EL MODENA CHANNEL (F07) 266+00.00

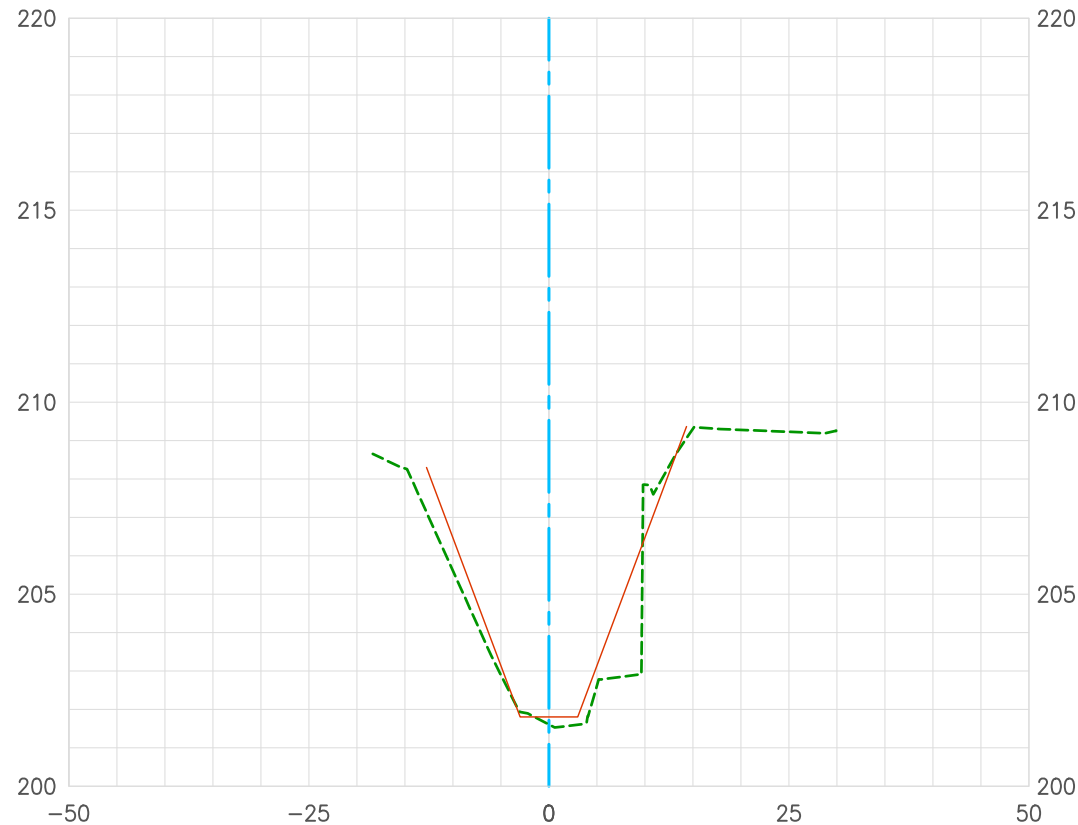

Topography Survey (2019)
Record As-Built Plan F07-101-4A (1960)
Construction Centerline
Date Prepared: 05/08/2019

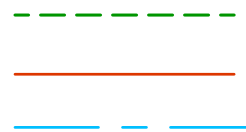


Horizontal Scale: 1"=20'
Vertical Scale: 1"=5'

**U.S. Survey
Foot**


OC Public Works/Engineering Services
OC Survey/Field Services
Boundary Analysis & Mapping



EL MODENA CHANNEL (F07) 266+50.00

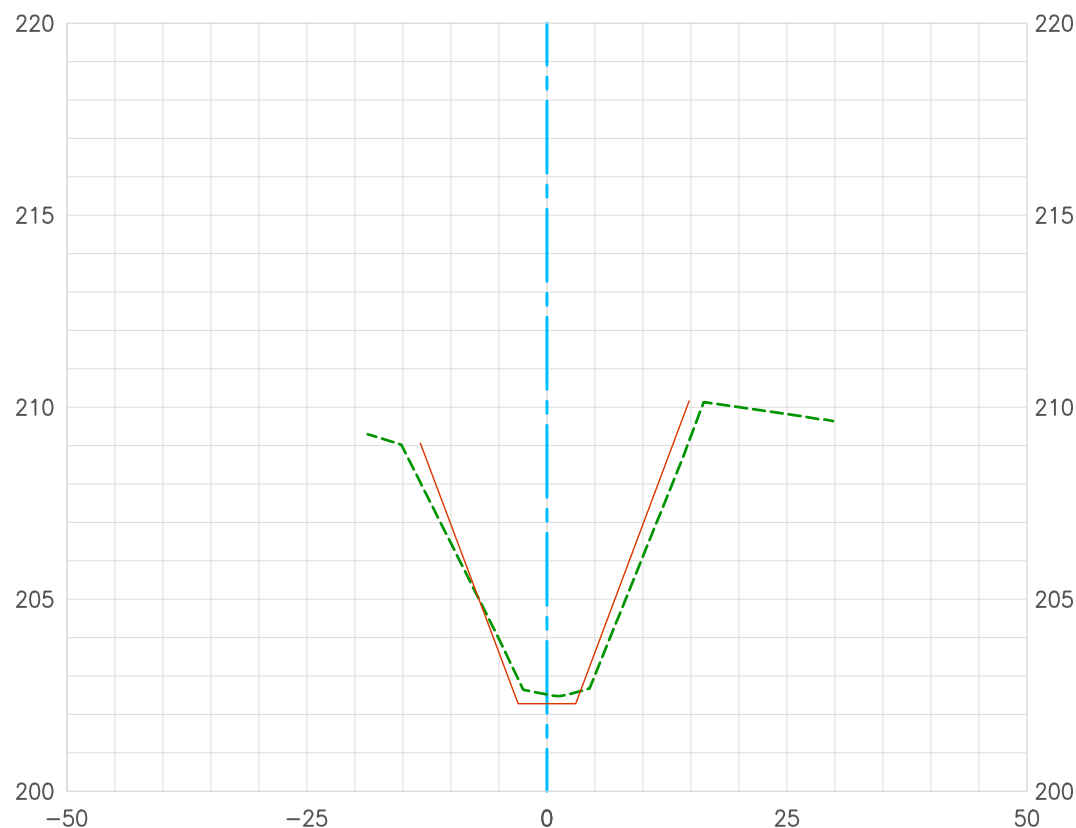

Topography Survey (2019)
Record As-Built Plan F07-101-4A (1960)
Construction Centerline
Date Prepared: 05/08/2019

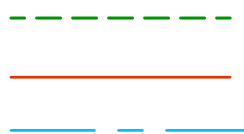


Horizontal Scale: 1"=20'
Vertical Scale: 1"=5'

**U.S. Survey
Foot**


OC Public Works/Engineering Services
OC Survey/Field Services
Boundary Analysis & Mapping



EL MODENA CHANNEL (F07) 267+00.00

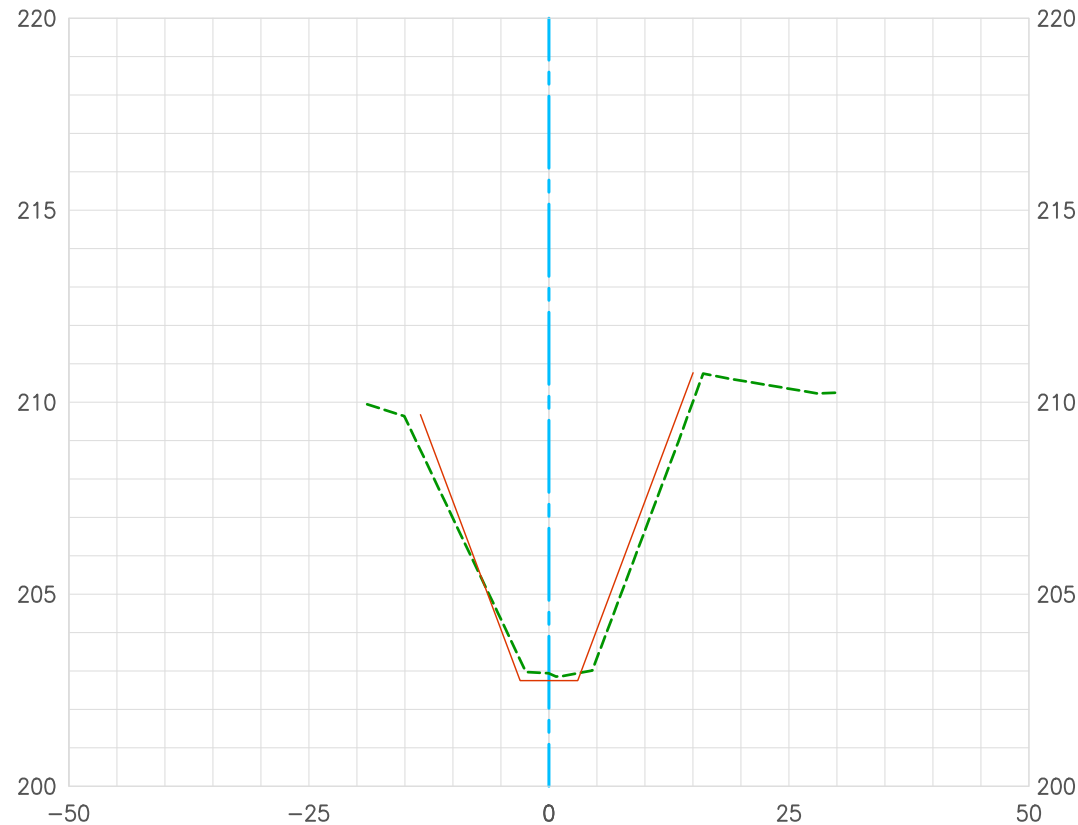

Topography Survey (2019)
Record As-Built Plan F07-101-4A (1960)
Construction Centerline
Date Prepared: 05/08/2019

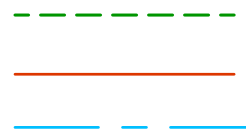


Horizontal Scale: 1"=20'
Vertical Scale: 1"=5'

**U.S. Survey
Foot**


OC Public Works/Engineering Services
OC Survey/Field Services
Boundary Analysis & Mapping



EL MODENA CHANNEL (F07) 267+50.00

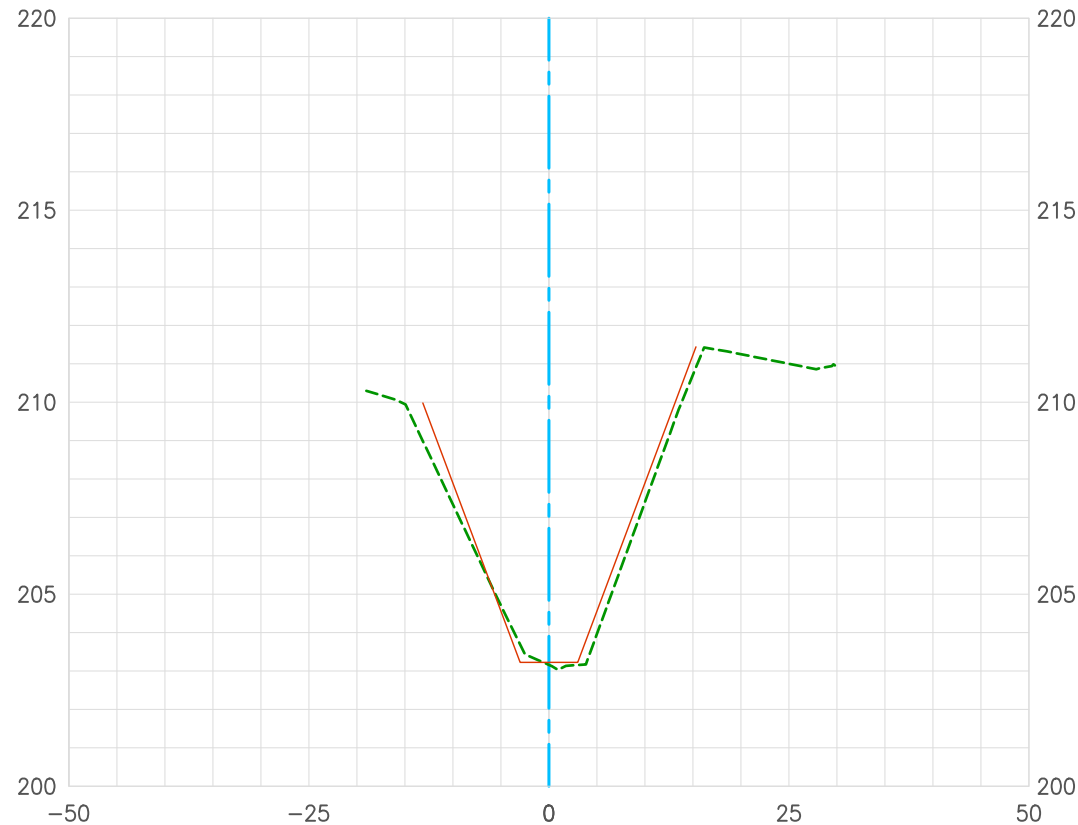

Topography Survey (2019)
Record As-Built Plan F07-101-4A (1960)
Construction Centerline
Date Prepared: 05/08/2019

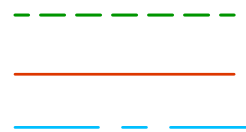


Horizontal Scale: 1"=20'
Vertical Scale: 1"=5'

**U.S. Survey
Foot**


OC Public Works/Engineering Services
OC Survey/Field Services
Boundary Analysis & Mapping



EL MODENA CHANNEL (F07) 268+00.00

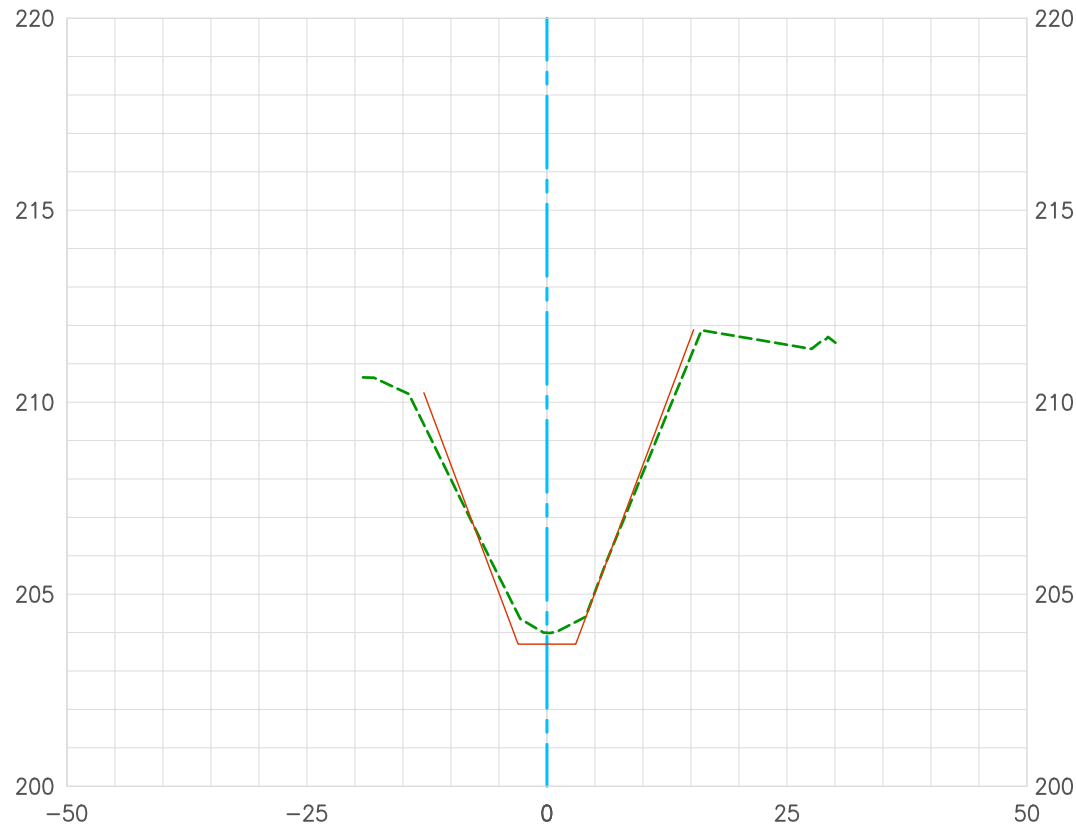

Topography Survey (2019)
Record As-Built Plan F07-101-4A (1960)
Construction Centerline
Date Prepared: 05/08/2019

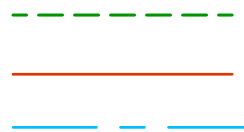


Horizontal Scale: 1"=20'
Vertical Scale: 1"=5'

**U.S. Survey
Foot**


OC Public Works/Engineering Services
OC Survey/Field Services
Boundary Analysis & Mapping



EL MODENA CHANNEL (F07) 268+50.00

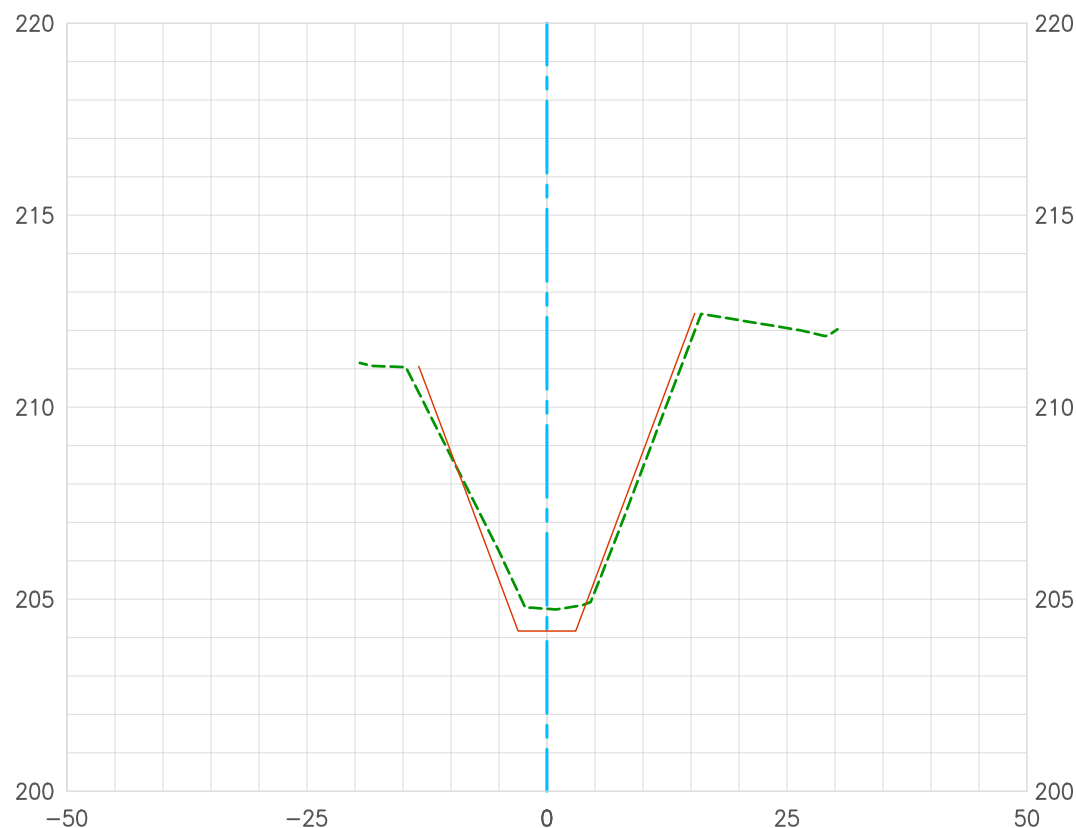

Topography Survey (2019)
Record As-Built Plan F07-101-4A (1960)
Construction Centerline
Date Prepared: 05/08/2019

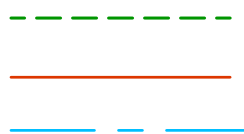


Horizontal Scale: 1"=20'
Vertical Scale: 1"=5'

**U.S. Survey
Foot**


OC Public Works/Engineering Services
OC Survey/Field Services
Boundary Analysis & Mapping



EL MODENA CHANNEL (F07) 269+00.00

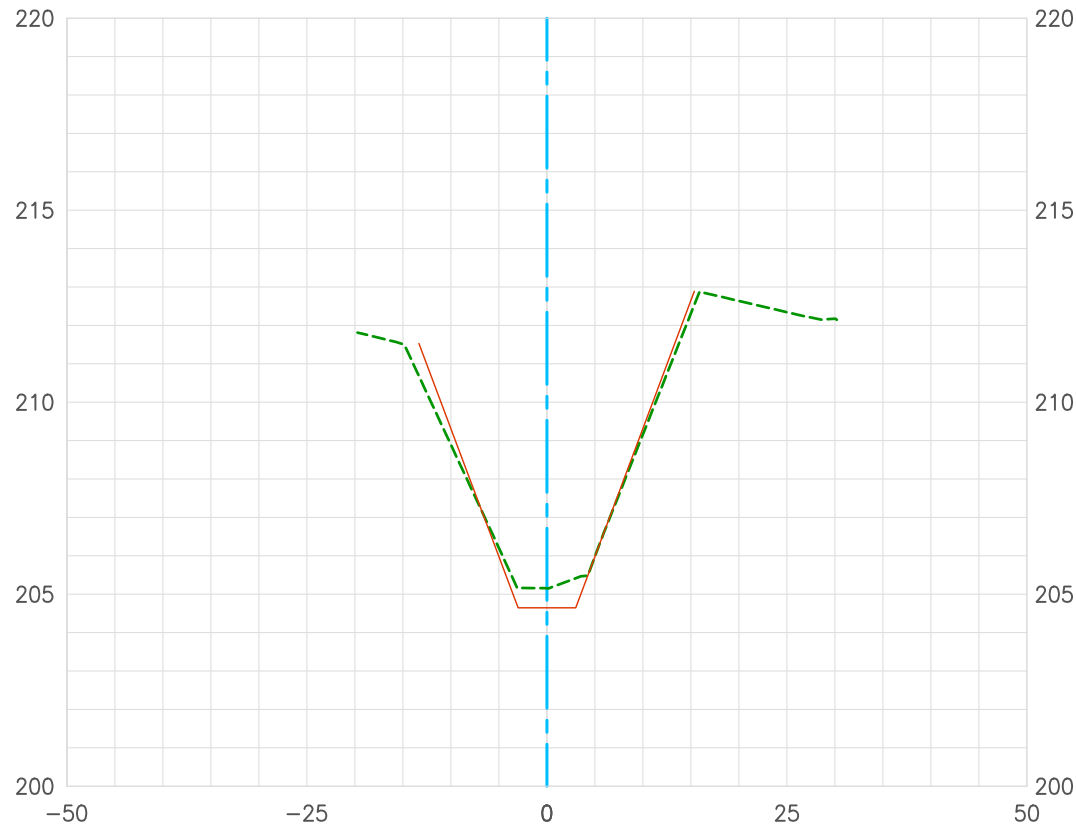

Topography Survey (2019)
Record As-Built Plan F07-101-4A (1960)
Construction Centerline
Date Prepared: 05/08/2019

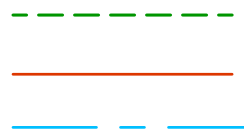


Horizontal Scale: 1"=20'
Vertical Scale: 1"=5'

**U.S. Survey
Foot**


OC Public Works/Engineering Services
OC Survey/Field Services
Boundary Analysis & Mapping



EL MODENA CHANNEL (F07) 269+50.00

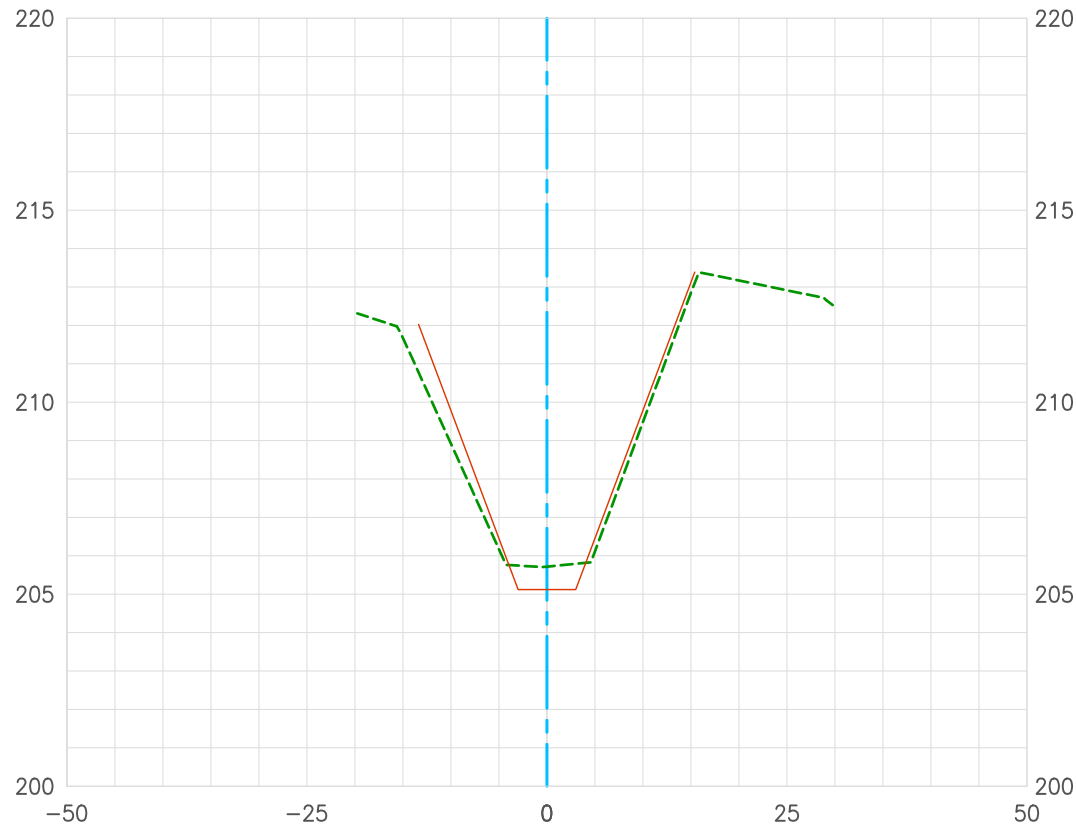

Topography Survey (2019)
Record As-Built Plan F07-101-4A (1960)
Construction Centerline
Date Prepared: 05/08/2019

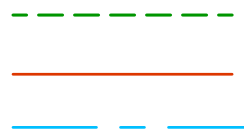


Horizontal Scale: 1"=20'
Vertical Scale: 1"=5'

**U.S. Survey
Foot**


OC Public Works/Engineering Services
OC Survey/Field Services
Boundary Analysis & Mapping



EL MODENA CHANNEL (F07) 270+00.00

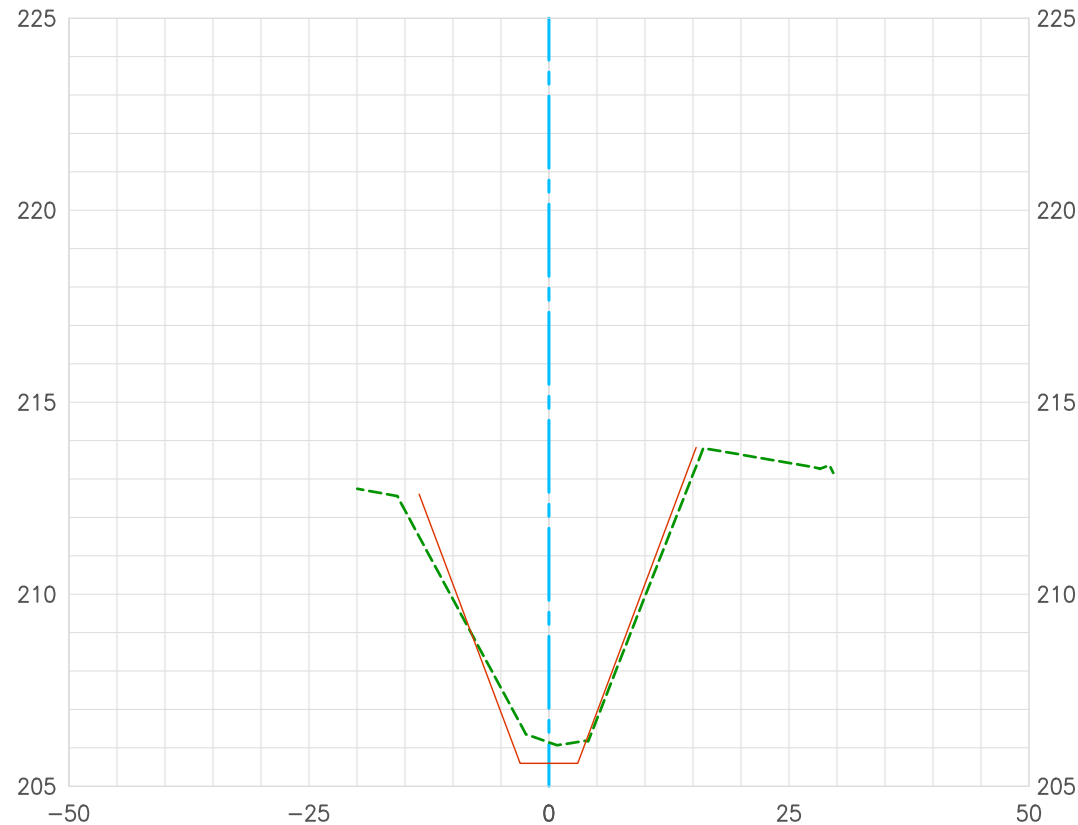

Topography Survey (2019)
Record As-Built Plan F07-101-4A (1960)
Construction Centerline
Date Prepared: 05/08/2019

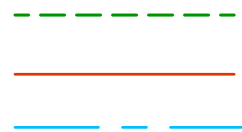


Horizontal Scale: 1"=20'
Vertical Scale: 1"=5'

**U.S. Survey
Foot**


OC Public Works/Engineering Services
OC Survey/Field Services
Boundary Analysis & Mapping



EL MODENA CHANNEL (F07) 270+50.00

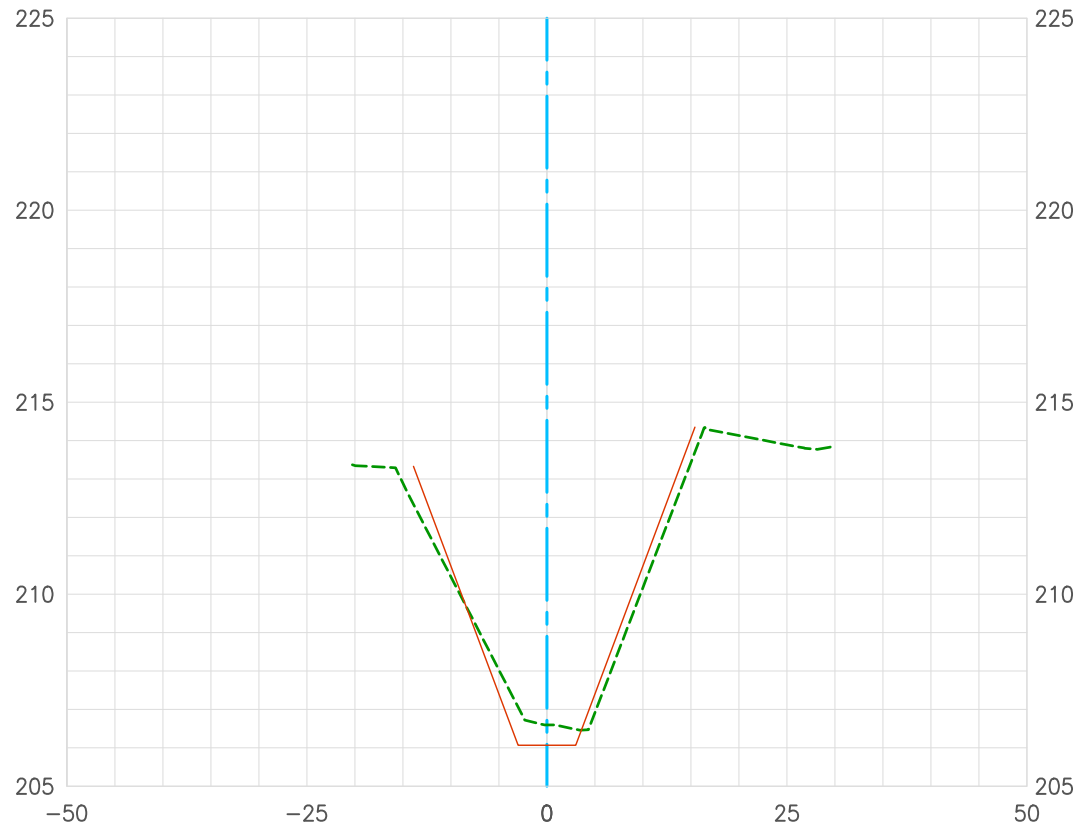

Topography Survey (2019)
Record As-Built Plan F07-101-4A (1960)
Construction Centerline
Date Prepared: 05/08/2019

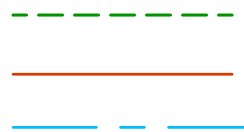


Horizontal Scale: 1"=20'
Vertical Scale: 1"=5'

**U.S. Survey
Foot**


OC Public Works/Engineering Services
OC Survey/Field Services
Boundary Analysis & Mapping



EL MODENA CHANNEL (F07) 271+00.00

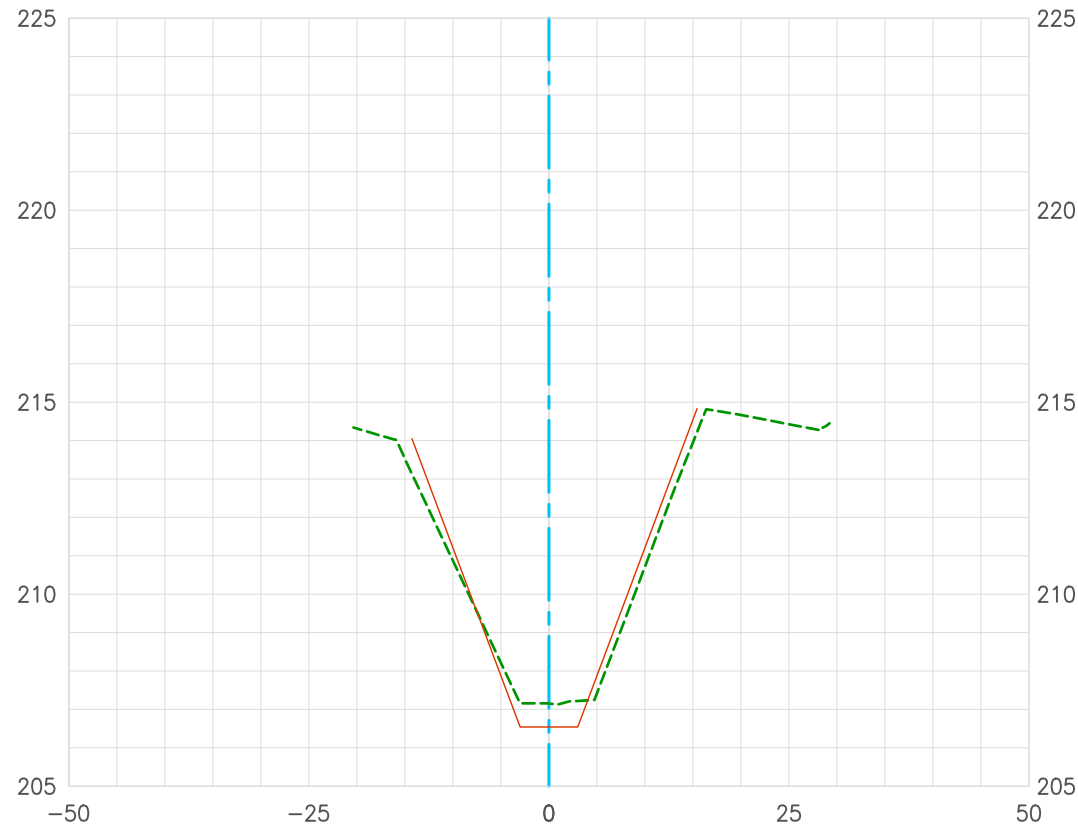

Topography Survey (2019)
Record As-Built Plan F07-101-4A (1960)
Construction Centerline
Date Prepared: 05/08/2019

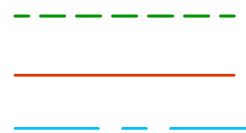


Horizontal Scale: 1"=20'
Vertical Scale: 1"=5'

**U.S. Survey
Foot**


OC Public Works/Engineering Services
OC Survey/Field Services
Boundary Analysis & Mapping



EL MODENA CHANNEL (F07) 271+50.00

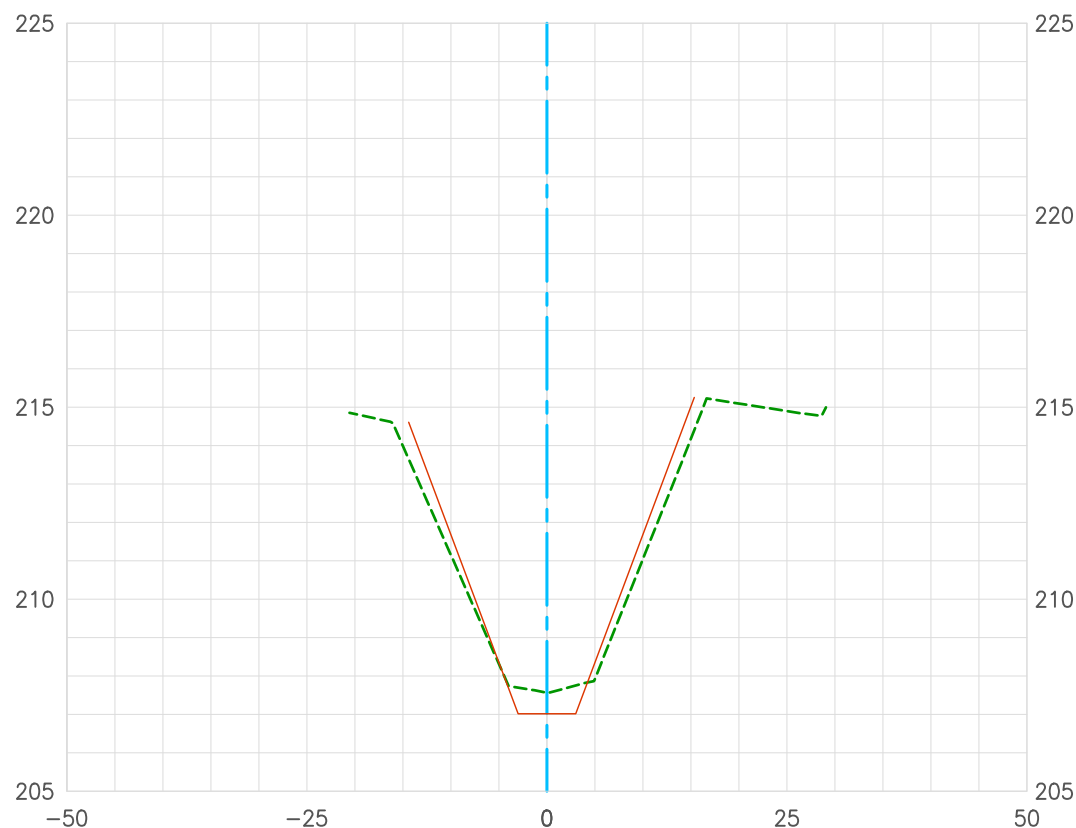

Topography Survey (2019)
Record As-Built Plan F07-101-4A (1960)
Construction Centerline
Date Prepared: 05/08/2019

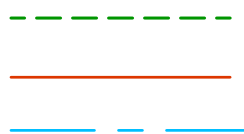


Horizontal Scale: 1"=20'
Vertical Scale: 1"=5'

**U.S. Survey
Foot**


OC Public Works/Engineering Services
OC Survey/Field Services
Boundary Analysis & Mapping



EL MODENA CHANNEL (F07) 272+00.00

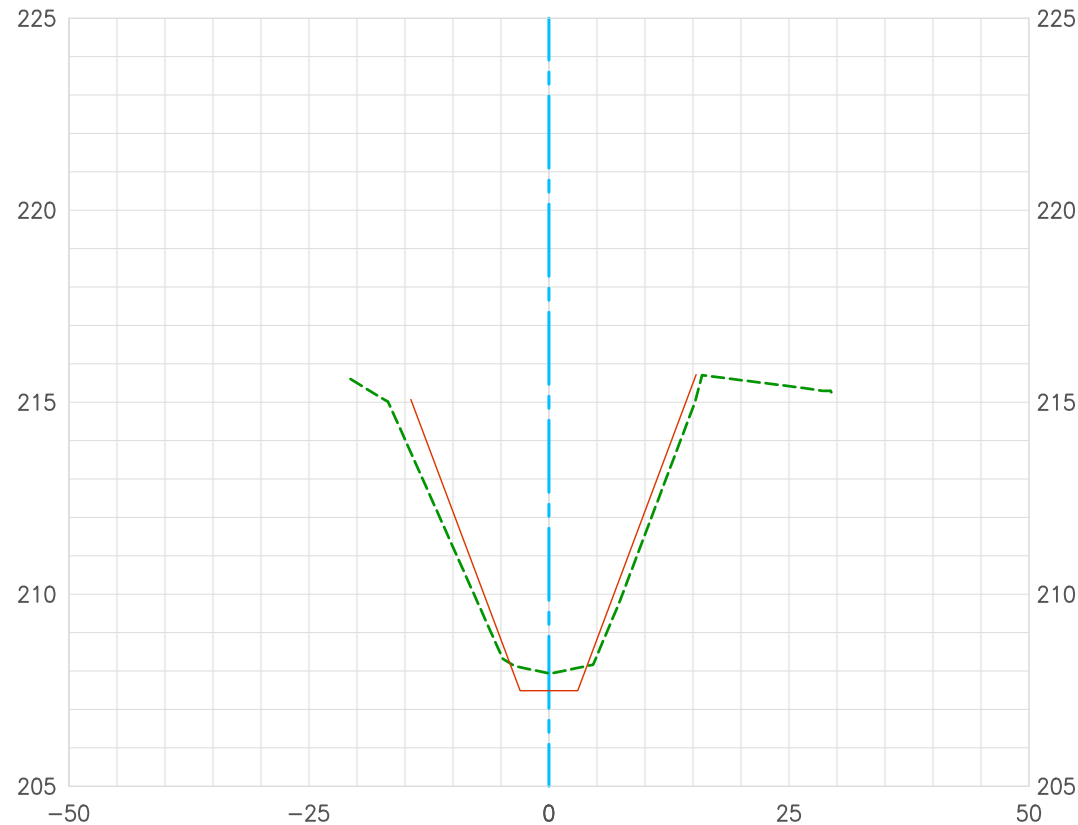

Topography Survey (2019)
Record As-Built Plan F07-101-4A (1960)
Construction Centerline
Date Prepared: 05/08/2019

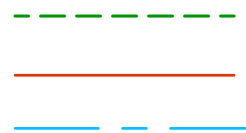


Horizontal Scale: 1"=20'
Vertical Scale: 1"=5'

**U.S. Survey
Foot**


OC Public Works/Engineering Services
OC Survey/Field Services
Boundary Analysis & Mapping



EL MODENA CHANNEL (F07) 272+50.00

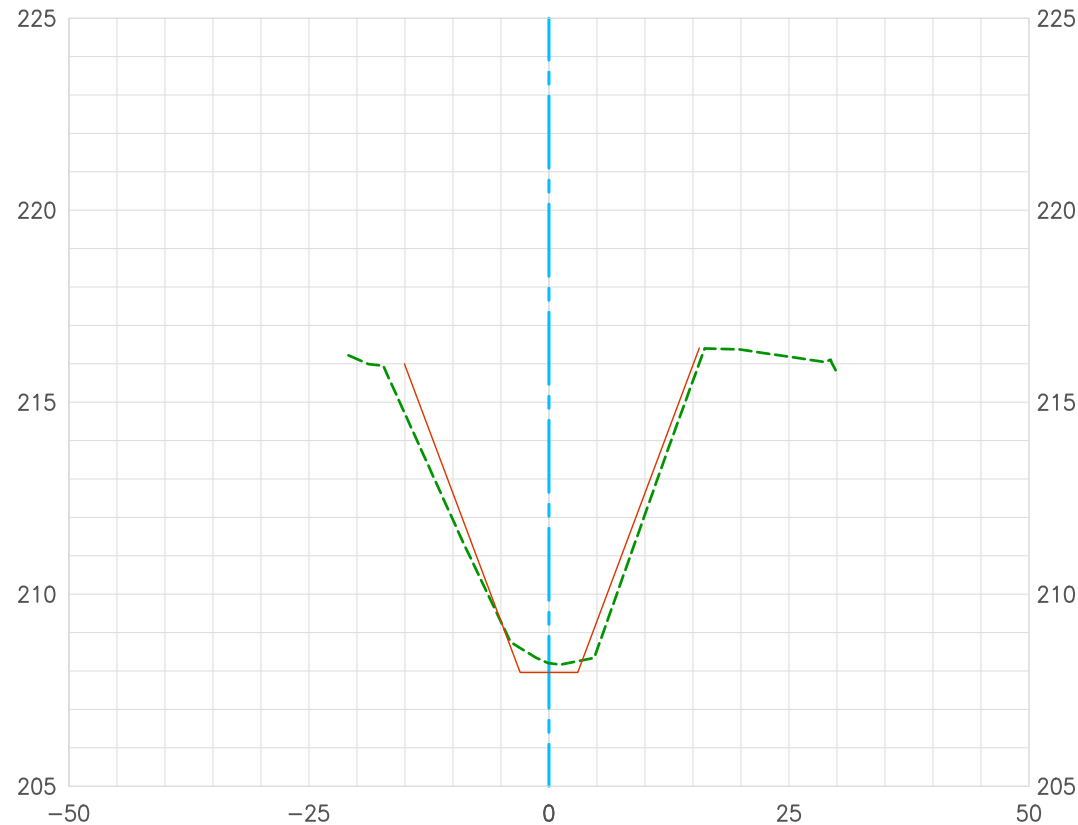

Topography Survey (2019)
Record As-Built Plan F07-101-4A (1960)
Construction Centerline
Date Prepared: 05/08/2019

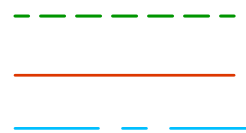


Horizontal Scale: 1"=20'
Vertical Scale: 1"=5'

**U.S. Survey
Foot**


OC Public Works/Engineering Services
OC Survey/Field Services
Boundary Analysis & Mapping



EL MODENA CHANNEL (F07) 273+00.00

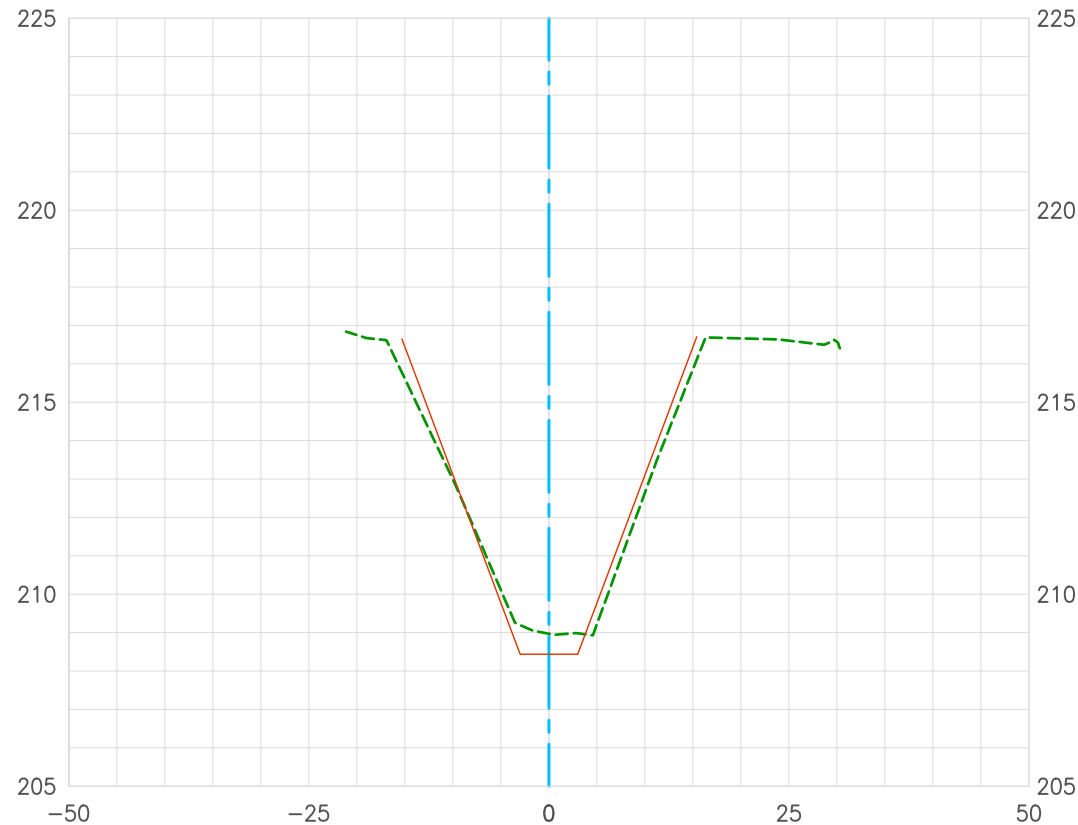

Topography Survey (2019)
Record As-Built Plan F07-101-4A (1960)
Construction Centerline
Date Prepared: 05/08/2019

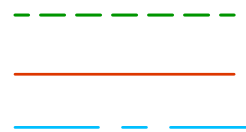


Horizontal Scale: 1"=20'
Vertical Scale: 1"=5'

**U.S. Survey
Foot**


OC Public Works/Engineering Services
OC Survey/Field Services
Boundary Analysis & Mapping



EL MODENA CHANNEL (F07) 273+50.00

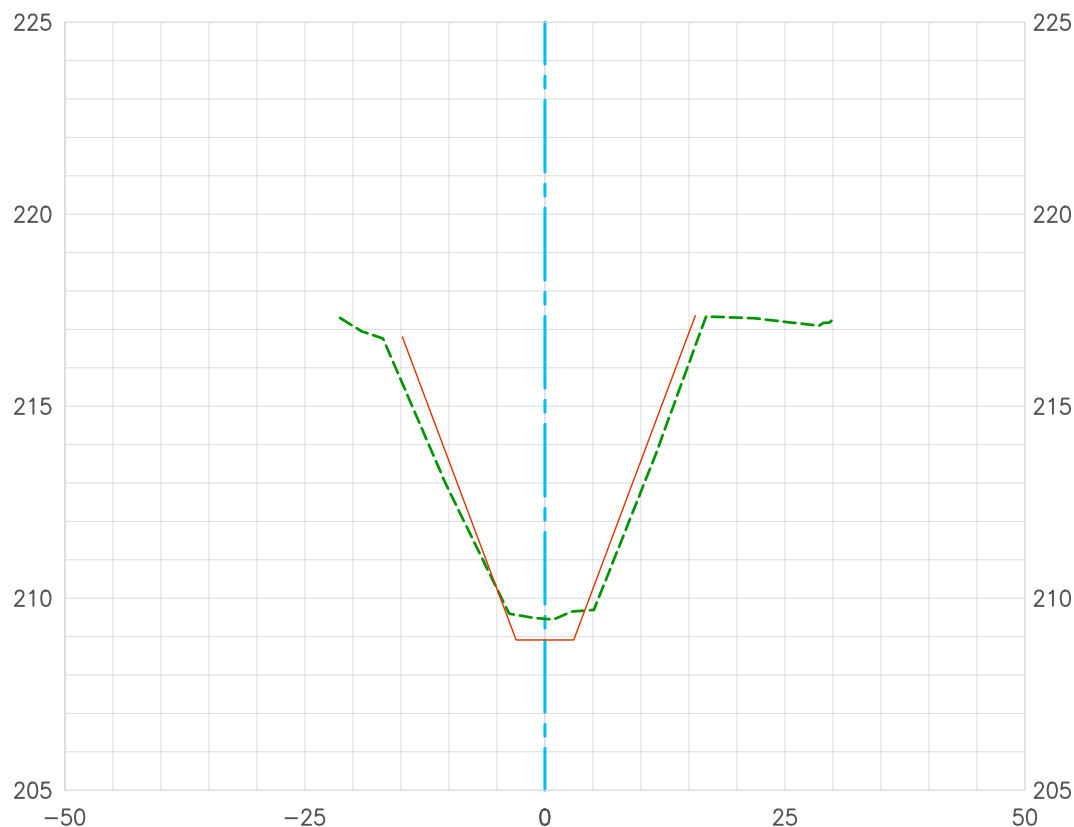

Topography Survey (2019)
Record As-Built Plan F07-101-4A (1960)
Construction Centerline
Date Prepared: 05/08/2019

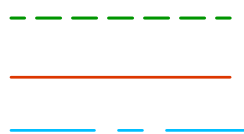


Horizontal Scale: 1"=20'
Vertical Scale: 1"=5'

**U.S. Survey
Foot**


OC Public Works/Engineering Services
OC Survey/Field Services
Boundary Analysis & Mapping



EL MODENA CHANNEL (F07) 274+00.00

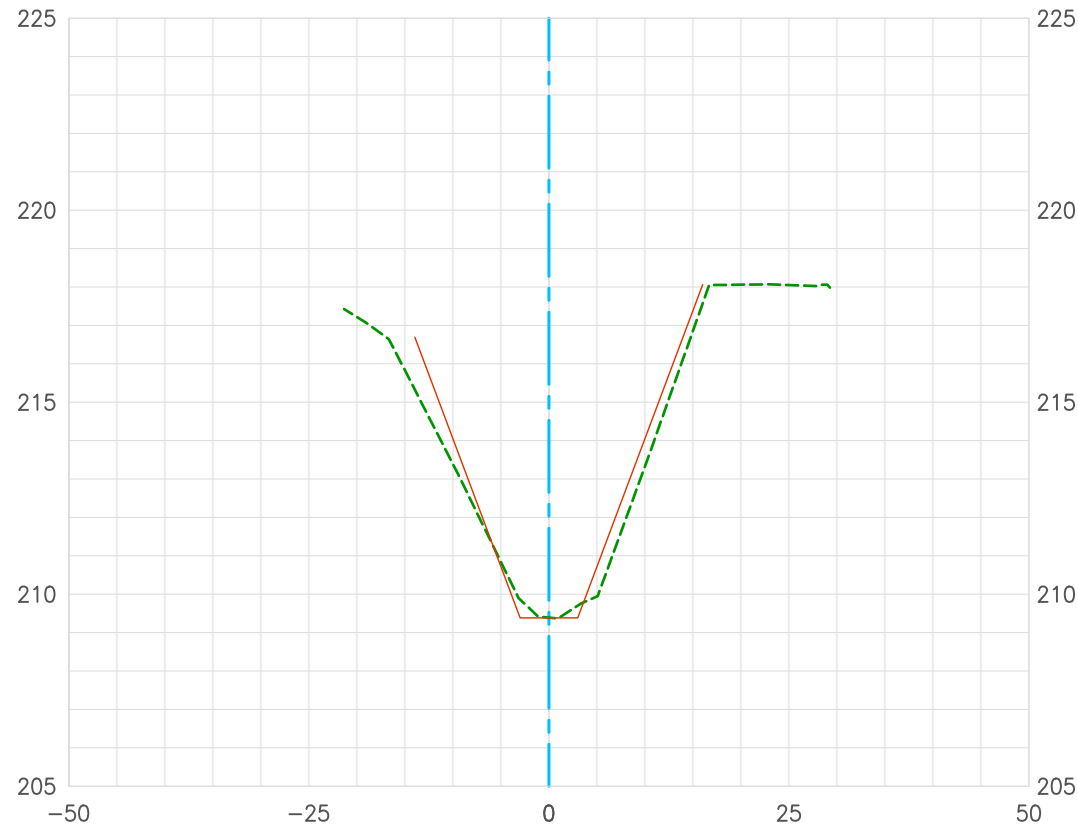

Topography Survey (2019)
Record As-Built Plan F07-101-4A (1960)
Construction Centerline
Date Prepared: 05/08/2019

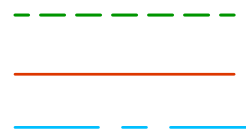


Horizontal Scale: 1"=20'
Vertical Scale: 1"=5'

**U.S. Survey
Foot**


OC Public Works/Engineering Services
OC Survey/Field Services
Boundary Analysis & Mapping



EL MODENA CHANNEL (F07) 274+50.00

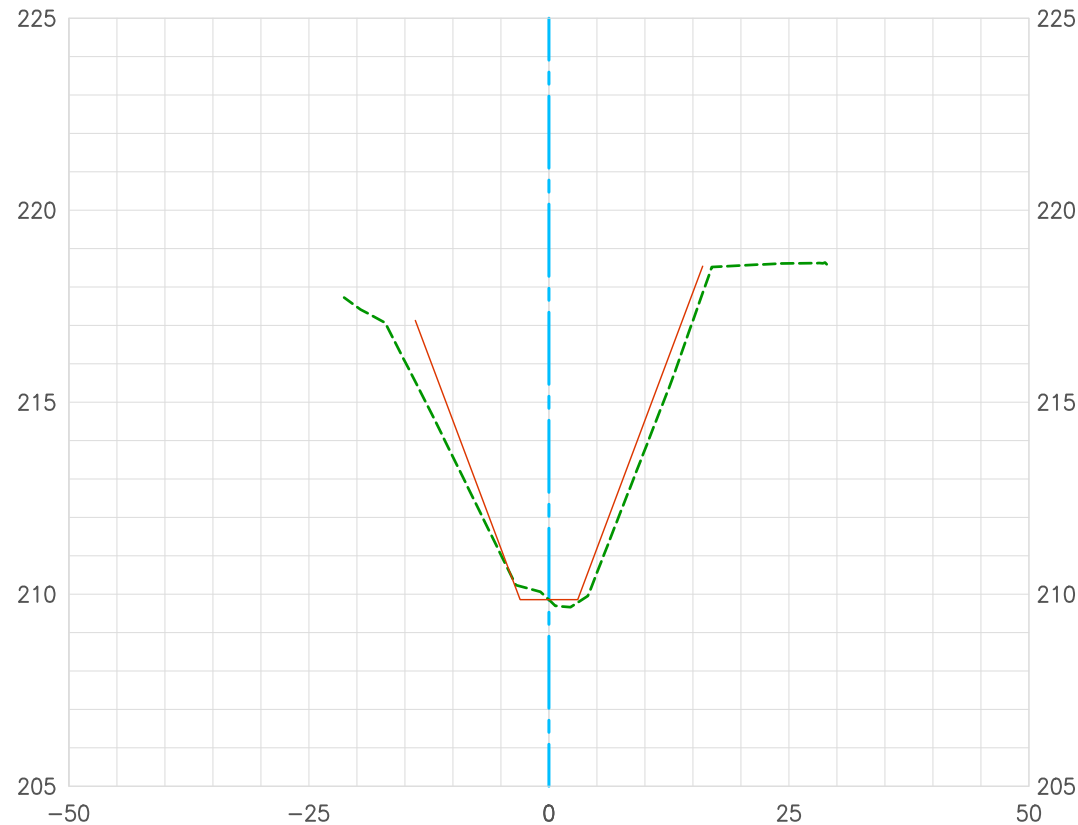

Topography Survey (2019)
Record As-Built Plan F07-101-4A (1960)
Construction Centerline
Date Prepared: 05/08/2019

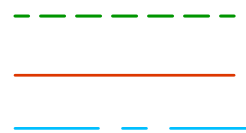


Horizontal Scale: 1"=20'
Vertical Scale: 1"=5'

**U.S. Survey
Foot**


OC Public Works/Engineering Services
OC Survey/Field Services
Boundary Analysis & Mapping



EL MODENA CHANNEL (F07) 275+00.00

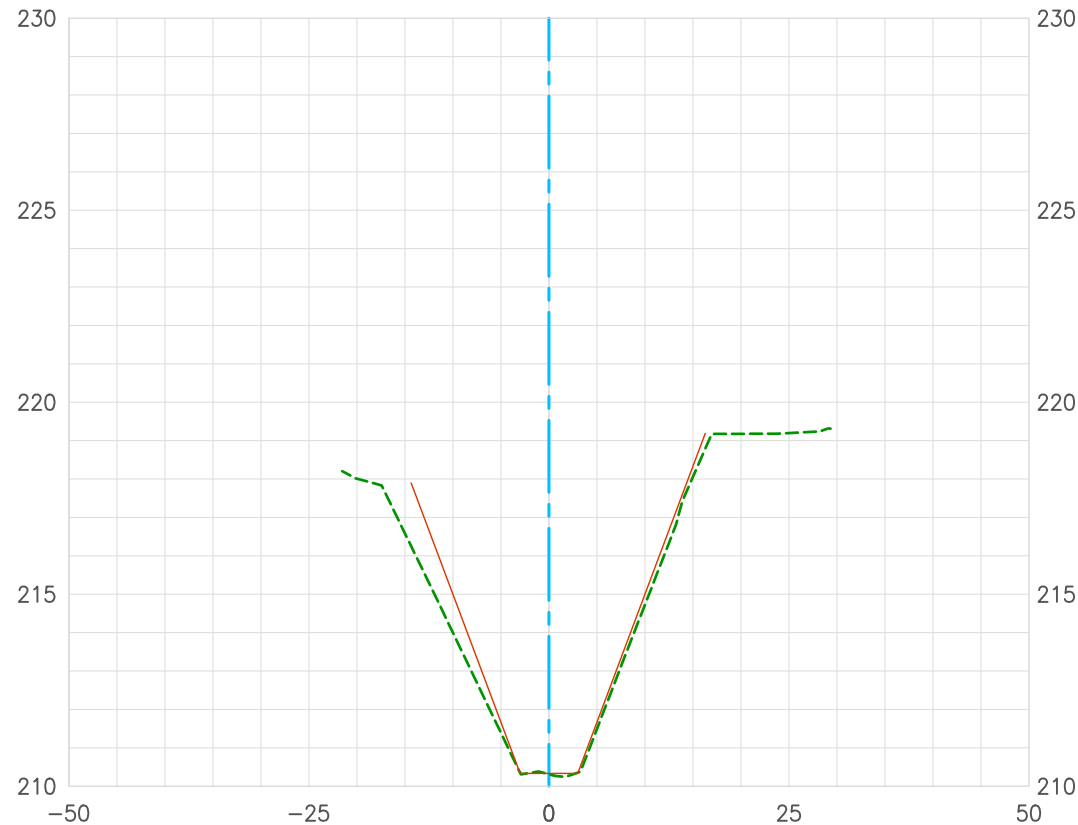

Topography Survey (2019)
Record As-Built Plan F07-101-4A (1960)
Construction Centerline
Date Prepared: 05/08/2019

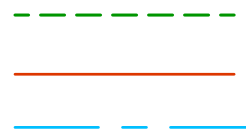

Horizontal Scale: 1"=20'
Vertical Scale: 1"=5'