


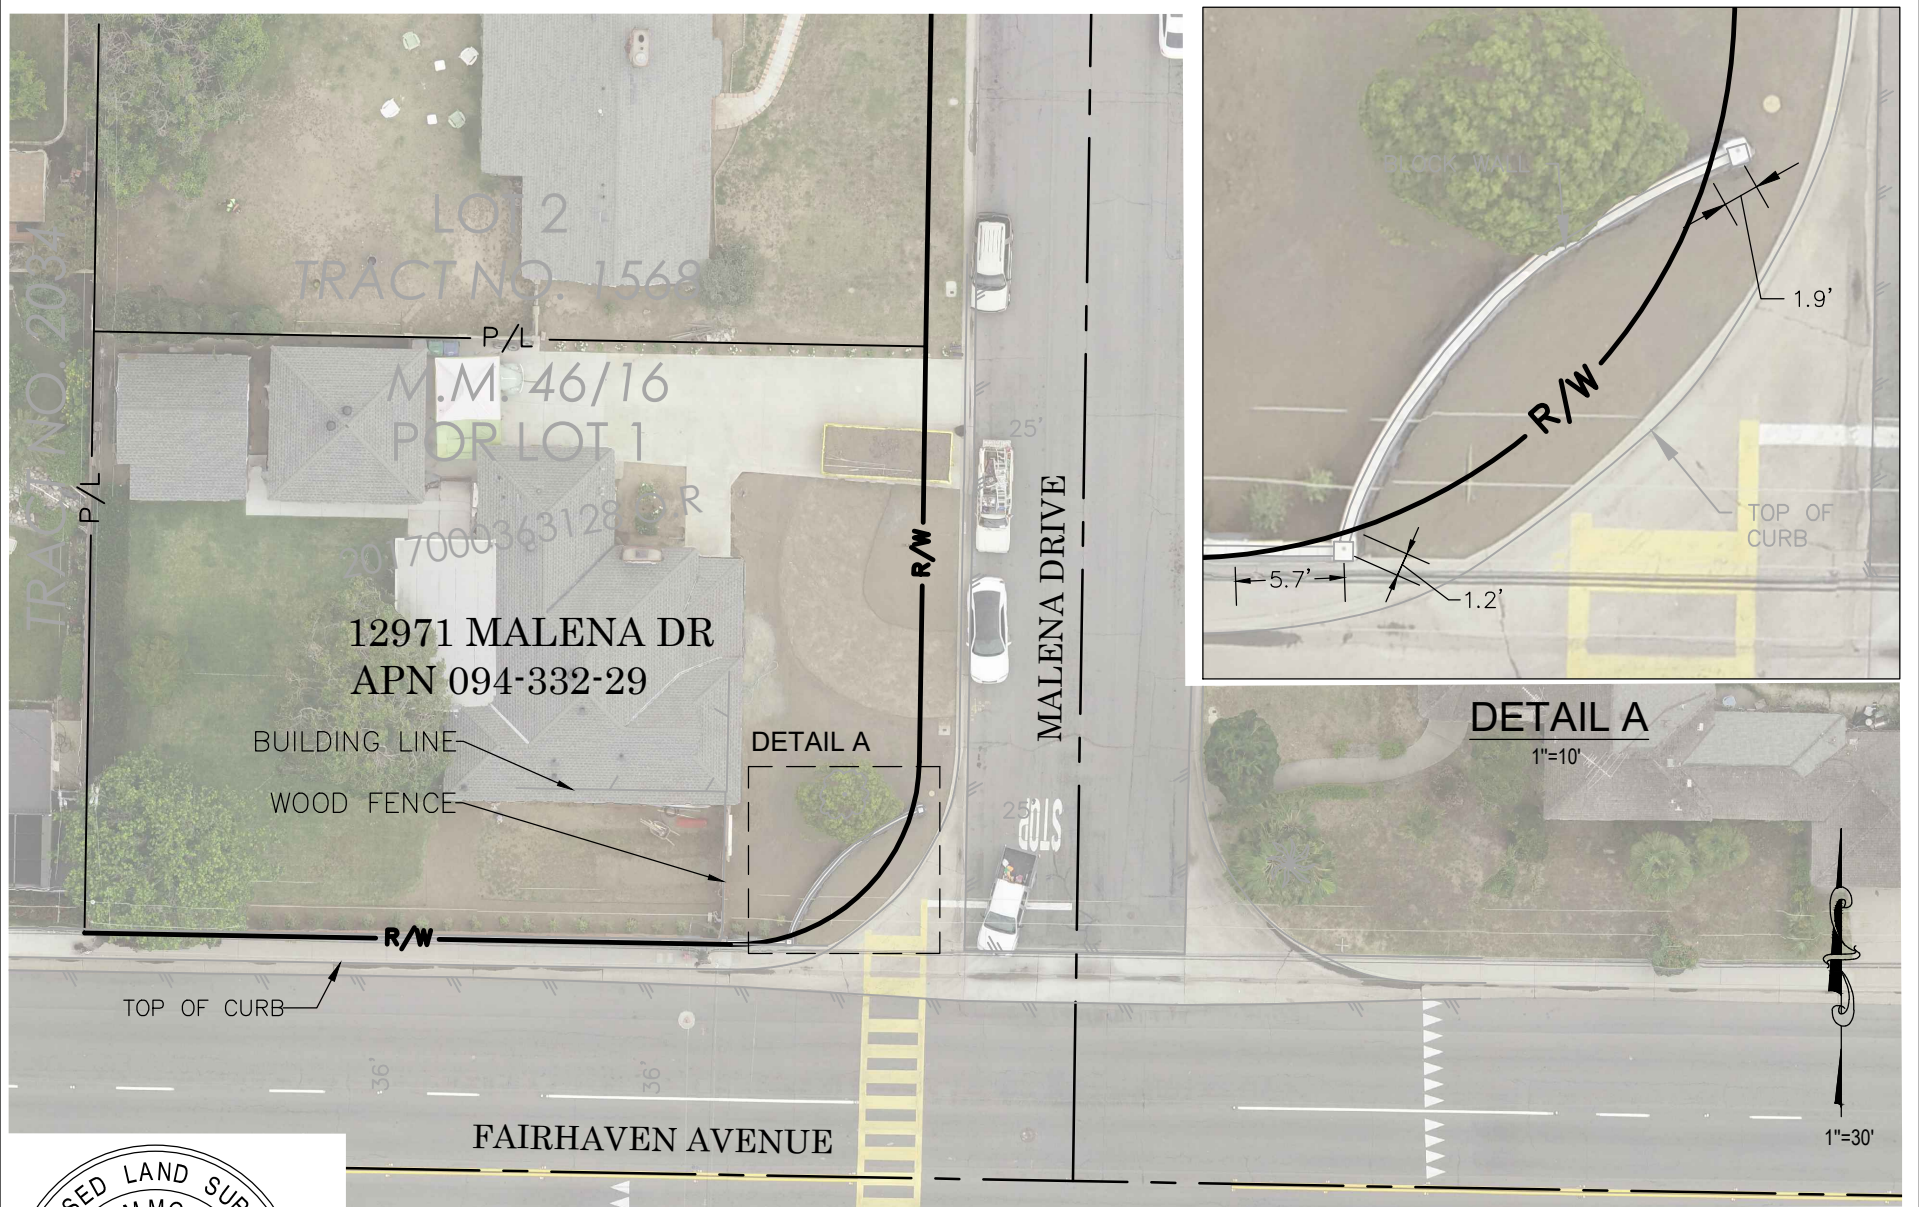

Horizontal Datum:
CCS83, Zone VI, 2007.00 Epoch

EXHIBIT

Survey showing improvements on APN
094-332-29 in relation to Fairhaven AVE.
and Malena DR. Right of way per deed
2017000363128 OR

12971 MALENA DRIVE
ORANGE COUNTY, CA

Date: 06/26/2019
Surveyed by:
OCPW Field Unit
FIELD: JOHNS & PARTY
OFFICE: J. MORENO, PLS

Job #: ER20505

