
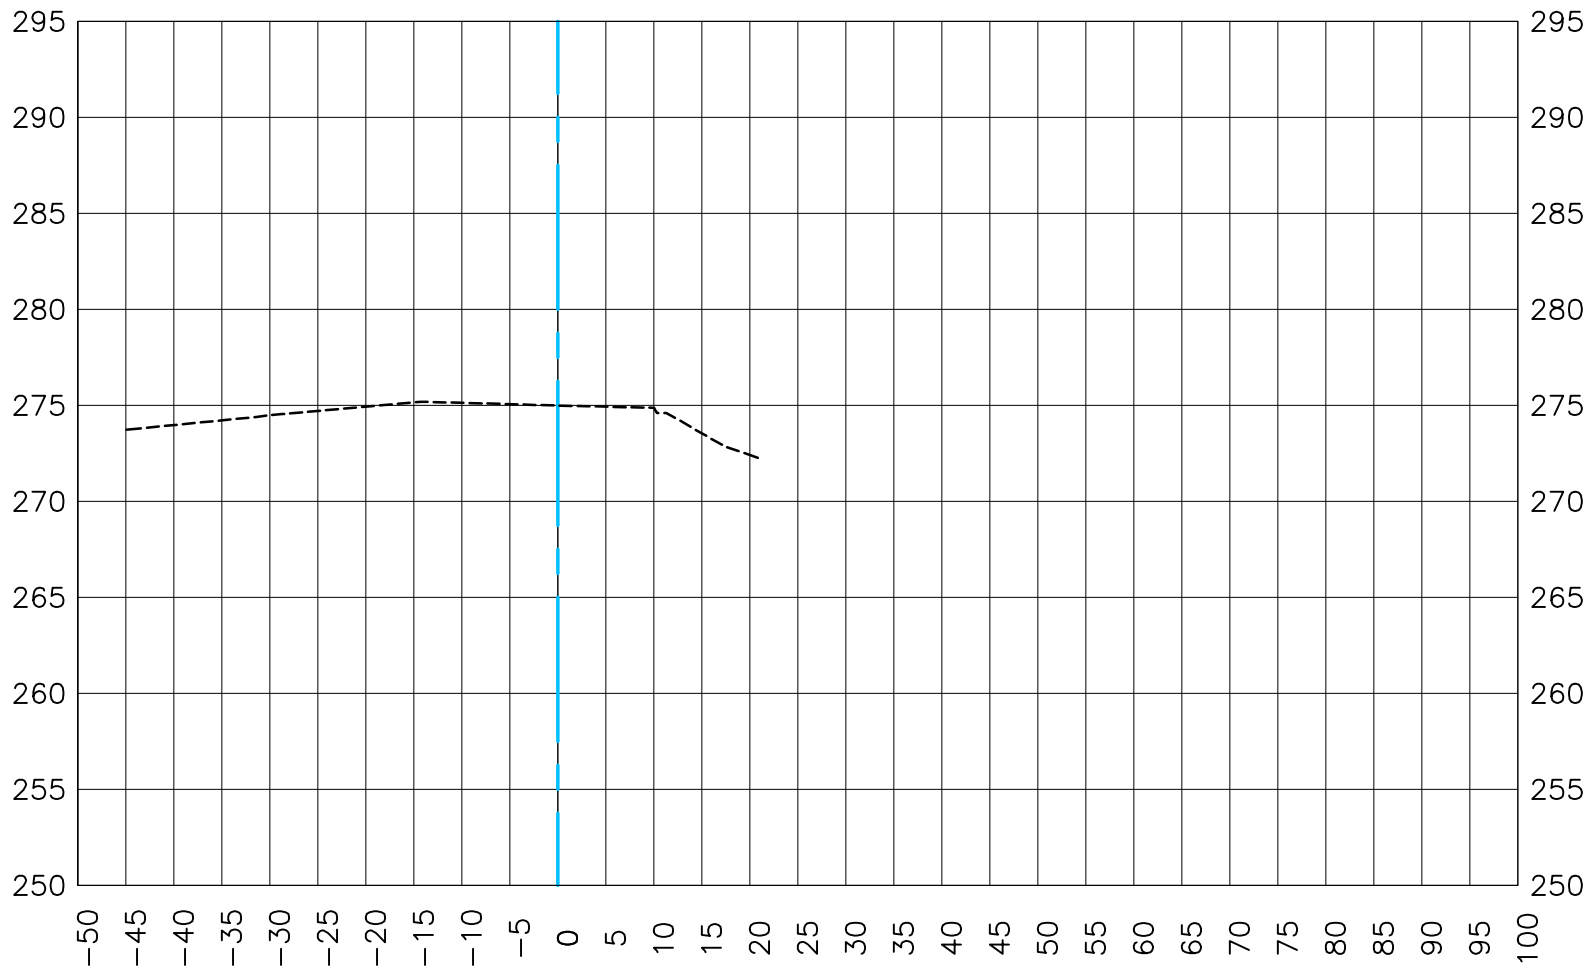


GALIVAN PERIMETER ROAD CL

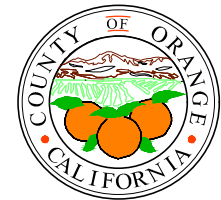


EXISTING CONDITION 2020

Station 11+00.00


Vert. Scale: 1"=5'

Hor. Scale: 1"=20'

DATE PREPARED: 03/23/2020

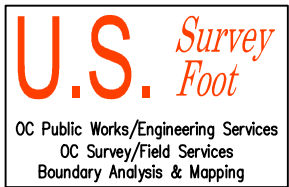

GALIVAN
PERIMETER ROAD
CL

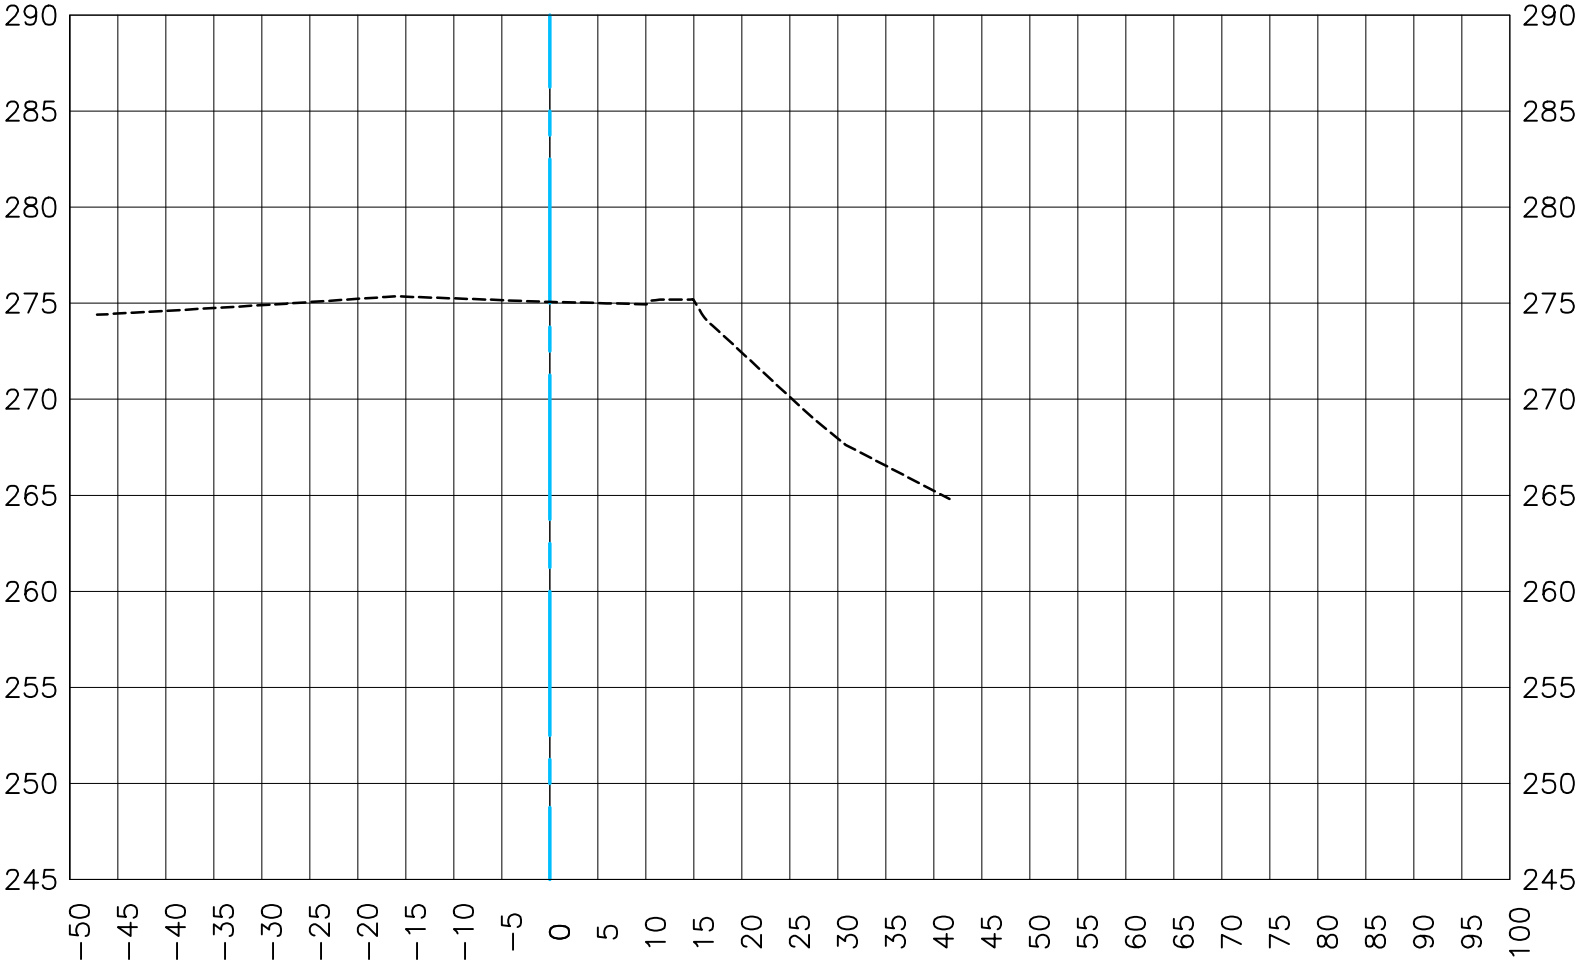


EXISTING CONDITION 2020



Station 11+25.00

Vert. Scale: 1"=5'
Hor. Scale: 1"=20'

DATE PREPARED: 03/23/2020

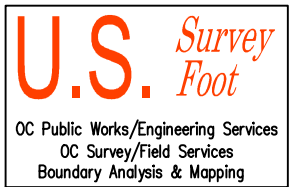

GALIVAN PERIMETER ROAD CL

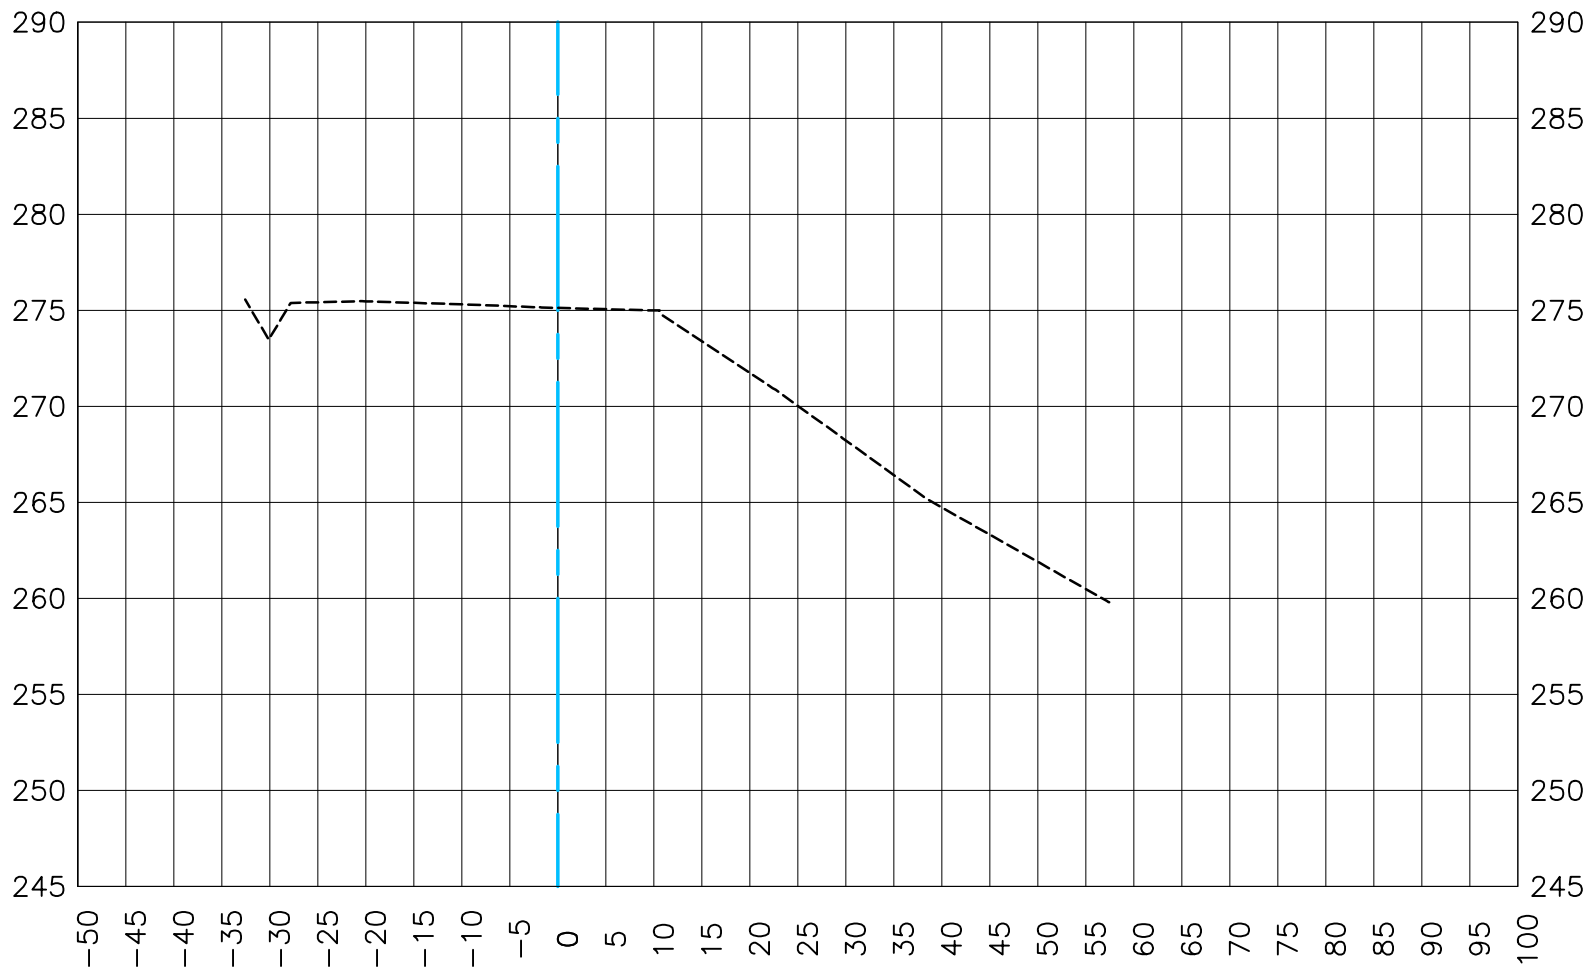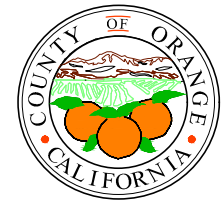

EXISTING CONDITION 2020

Station 11+50.00

Vert. Scale: 1"=5'


Hor. Scale: 1"=20'

DATE PREPARED: 03/23/2020

U.S. Survey Foot

OC Public Works/Engineering Services
OC Survey/Field Services
Boundary Analysis & Mapping

GALIVAN PERIMETER ROAD CL

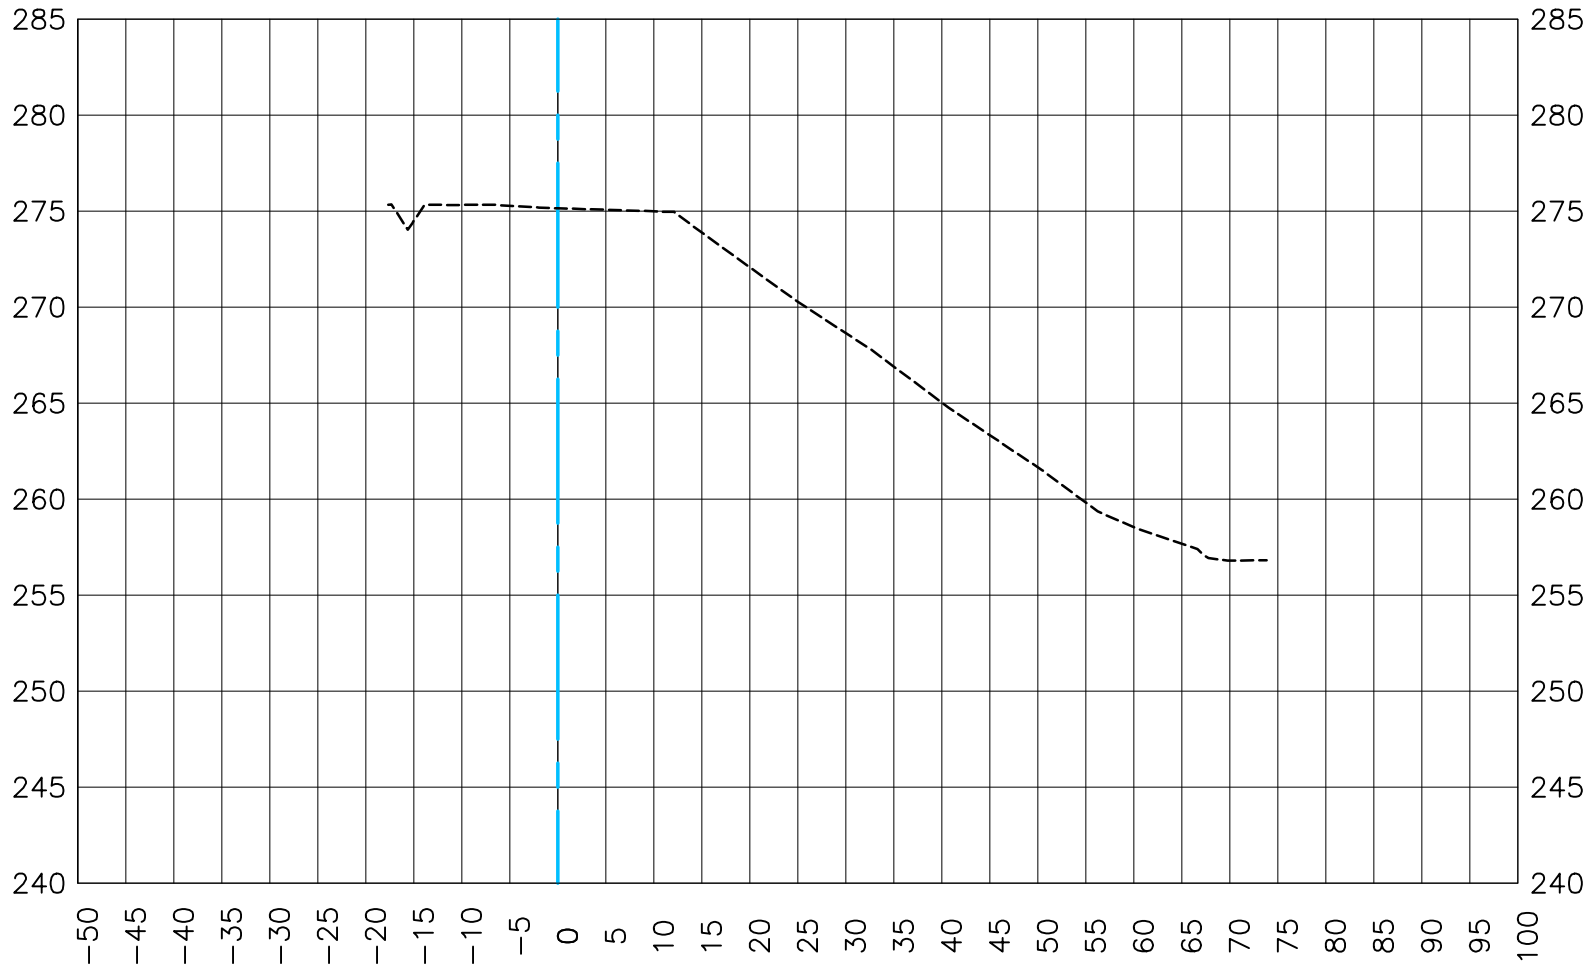

EXISTING CONDITION 2020

Station 11+75.00



Vert. Scale: 1"=5'
Hor. Scale: 1"=20'

DATE PREPARED: 03/23/2020

**U.S. Survey
Foot**

OC Public Works/Engineering Services
OC Survey/Field Services
Boundary Analysis & Mapping

GALIVAN PERIMETER ROAD CL

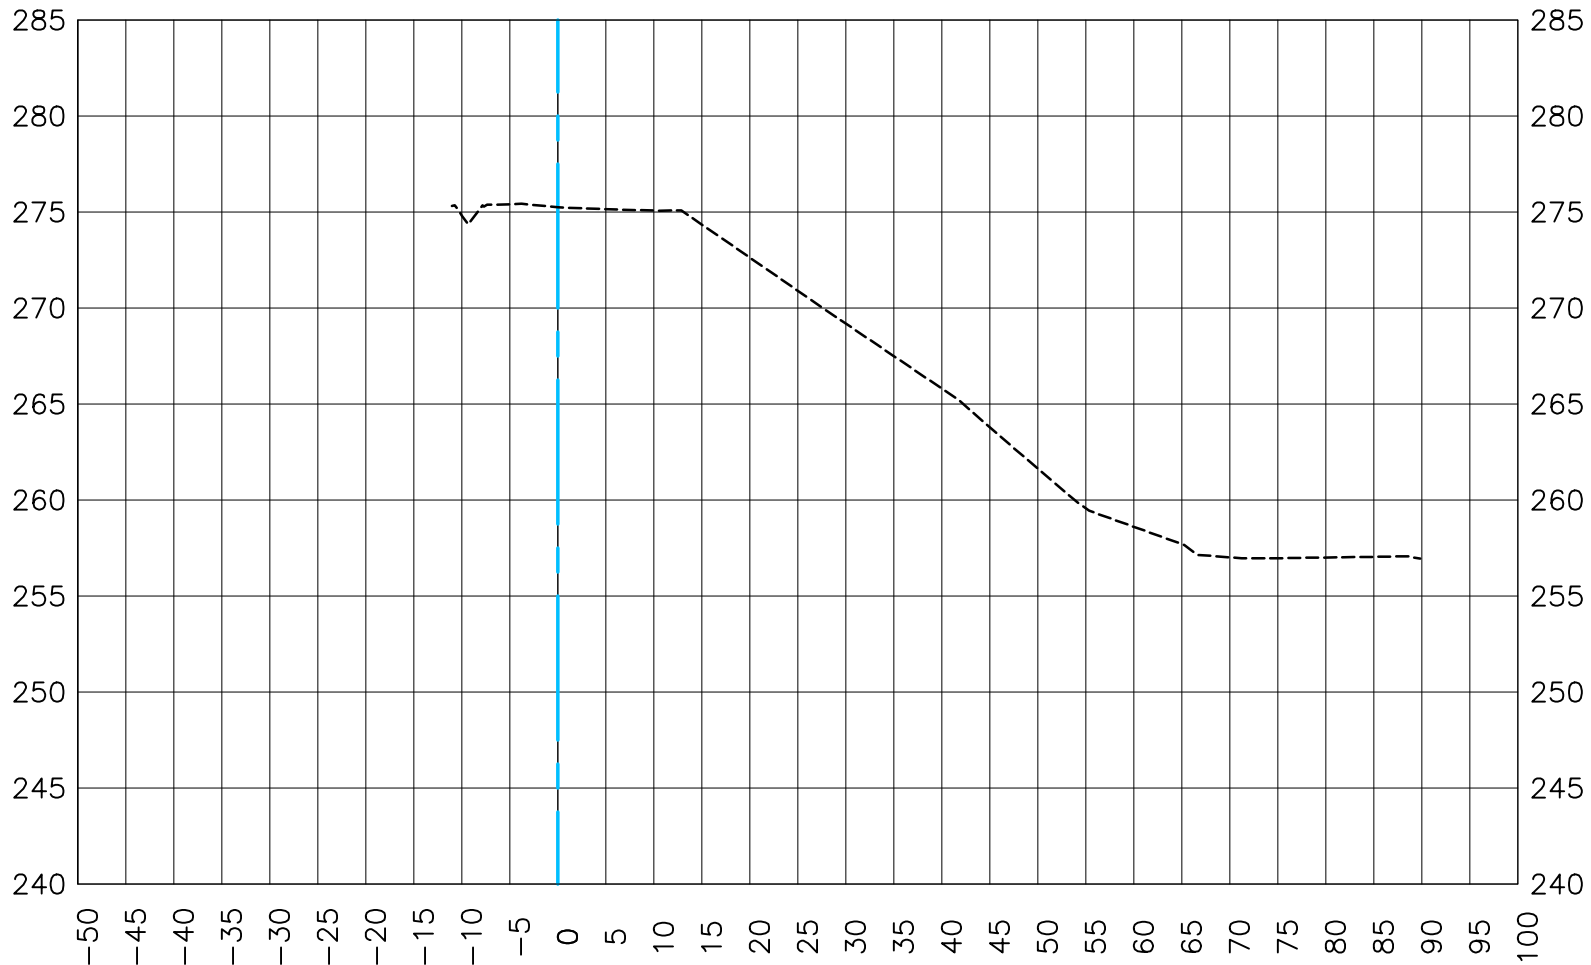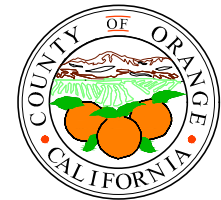


EXISTING CONDITION 2020

Station 12+00.00



Vert. Scale: 1"=5'

Hor. Scale: 1"=20'

DATE PREPARED: 03/23/2020

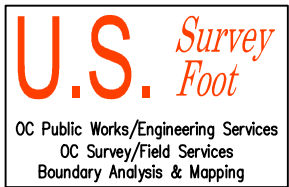

GALIVAN PERIMETER ROAD CL

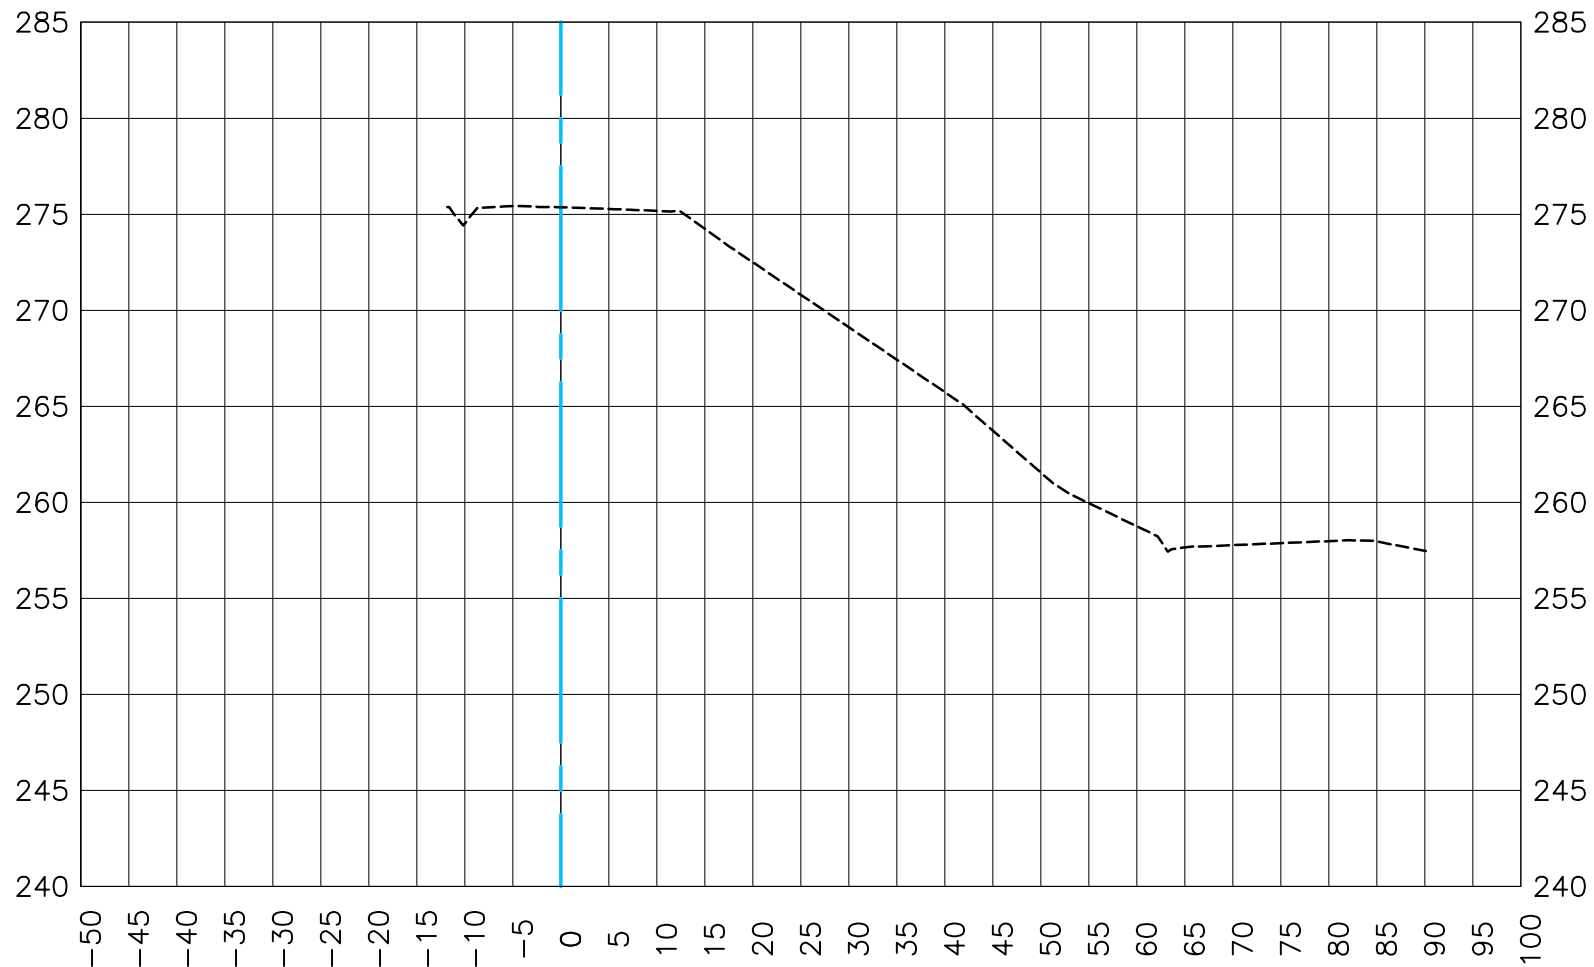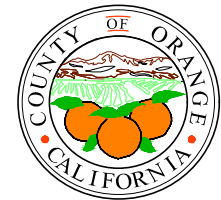

EXISTING CONDITION 2020

Station 12+25.00

Vert. Scale: 1"=5'



Hor. Scale: 1"=20'

DATE PREPARED: 03/23/2020

U.S. Survey
Foot

OC Public Works/Engineering Services
OC Survey/Field Services
Boundary Analysis & Mapping

GALIVAN PERIMETER ROAD CL

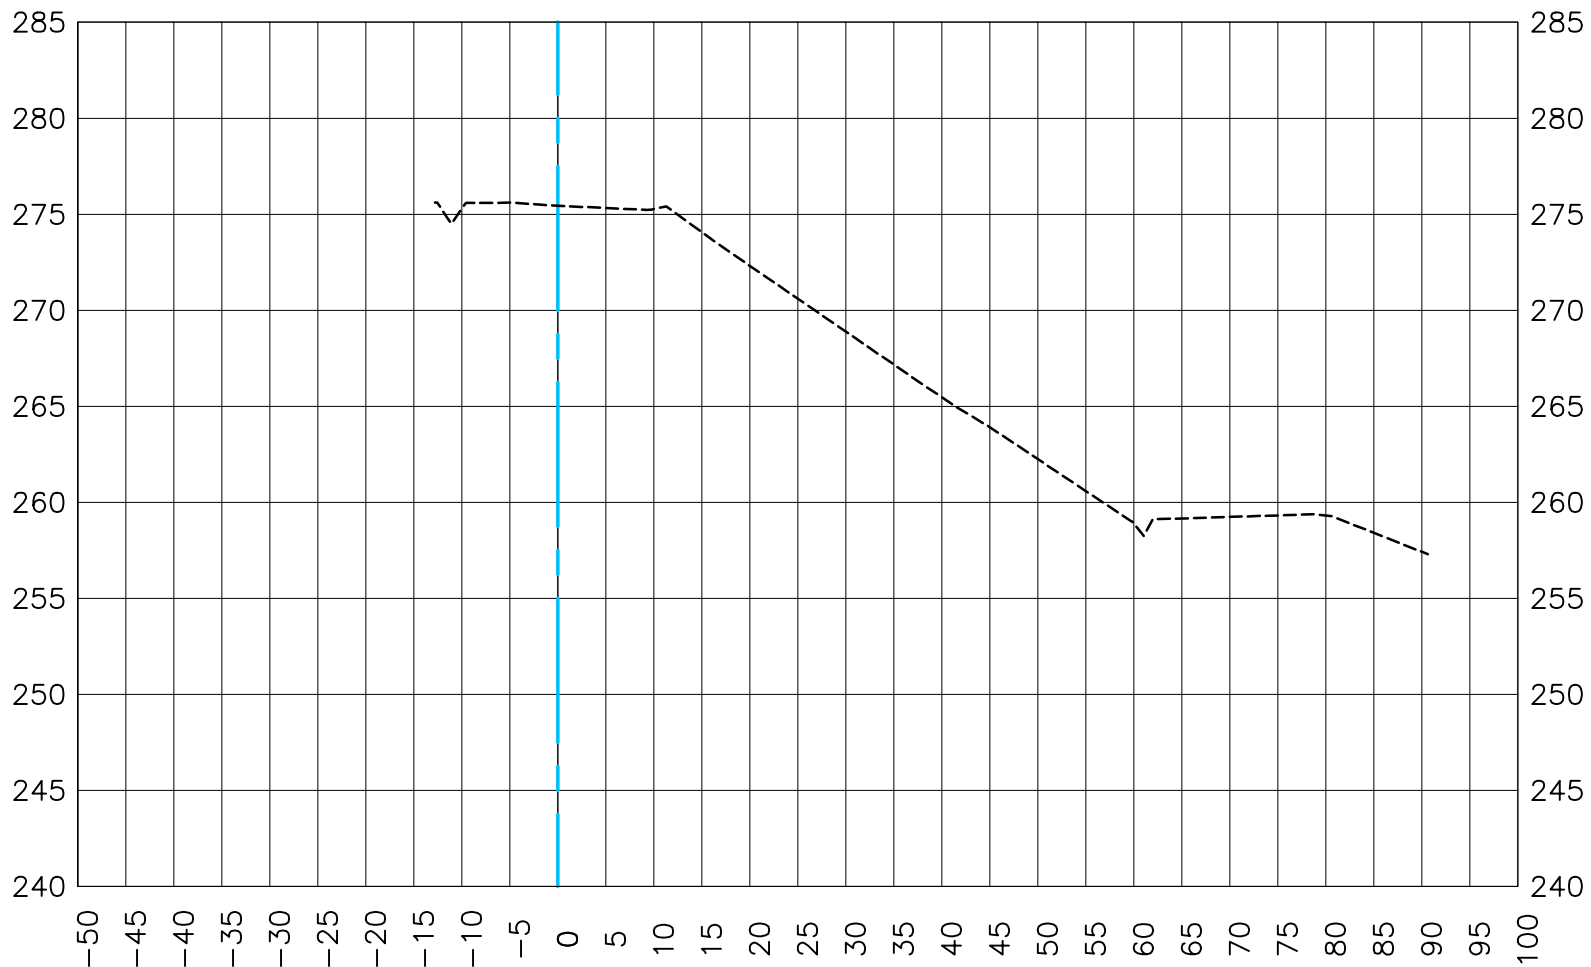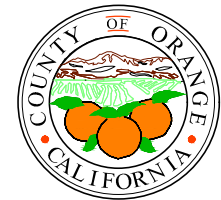


EXISTING CONDITION 2020

Station 12+50.00


Vert. Scale: 1"=5'

Hor. Scale: 1"=20'

DATE PREPARED: 03/23/2020

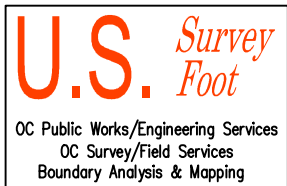

GALIVAN PERIMETER ROAD CL

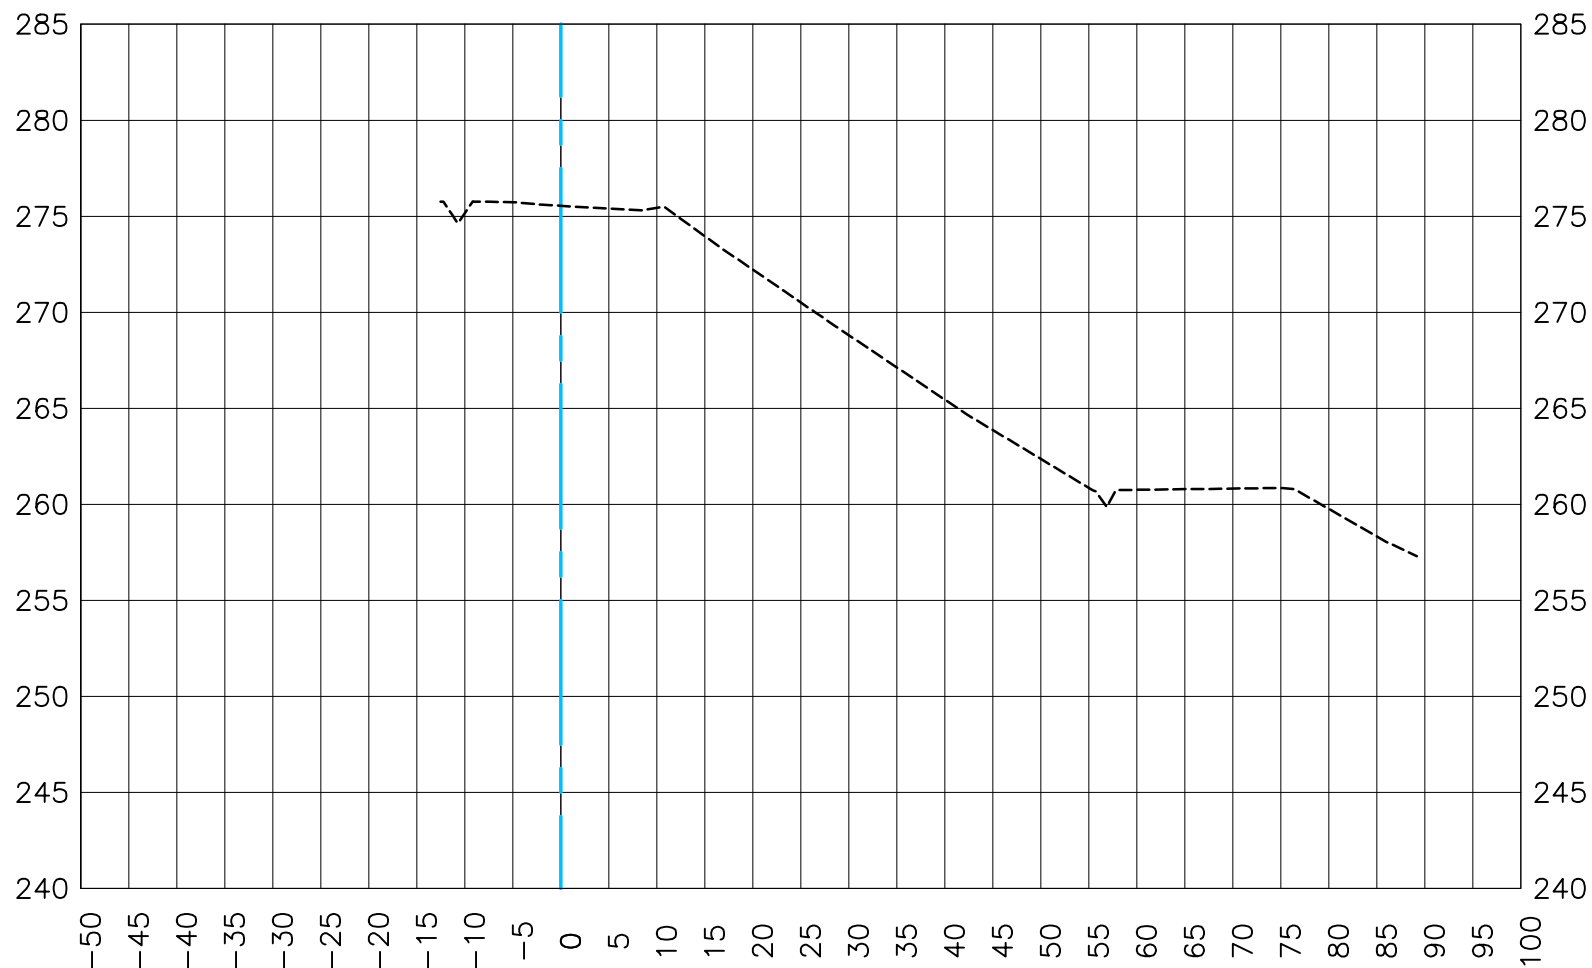


EXISTING CONDITION 2020



Station 12+75.00

Vert. Scale: 1"=5'
Hor. Scale: 1"=20'

DATE PREPARED: 03/23/2020

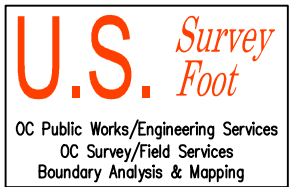

GALIVAN PERIMETER ROAD CL

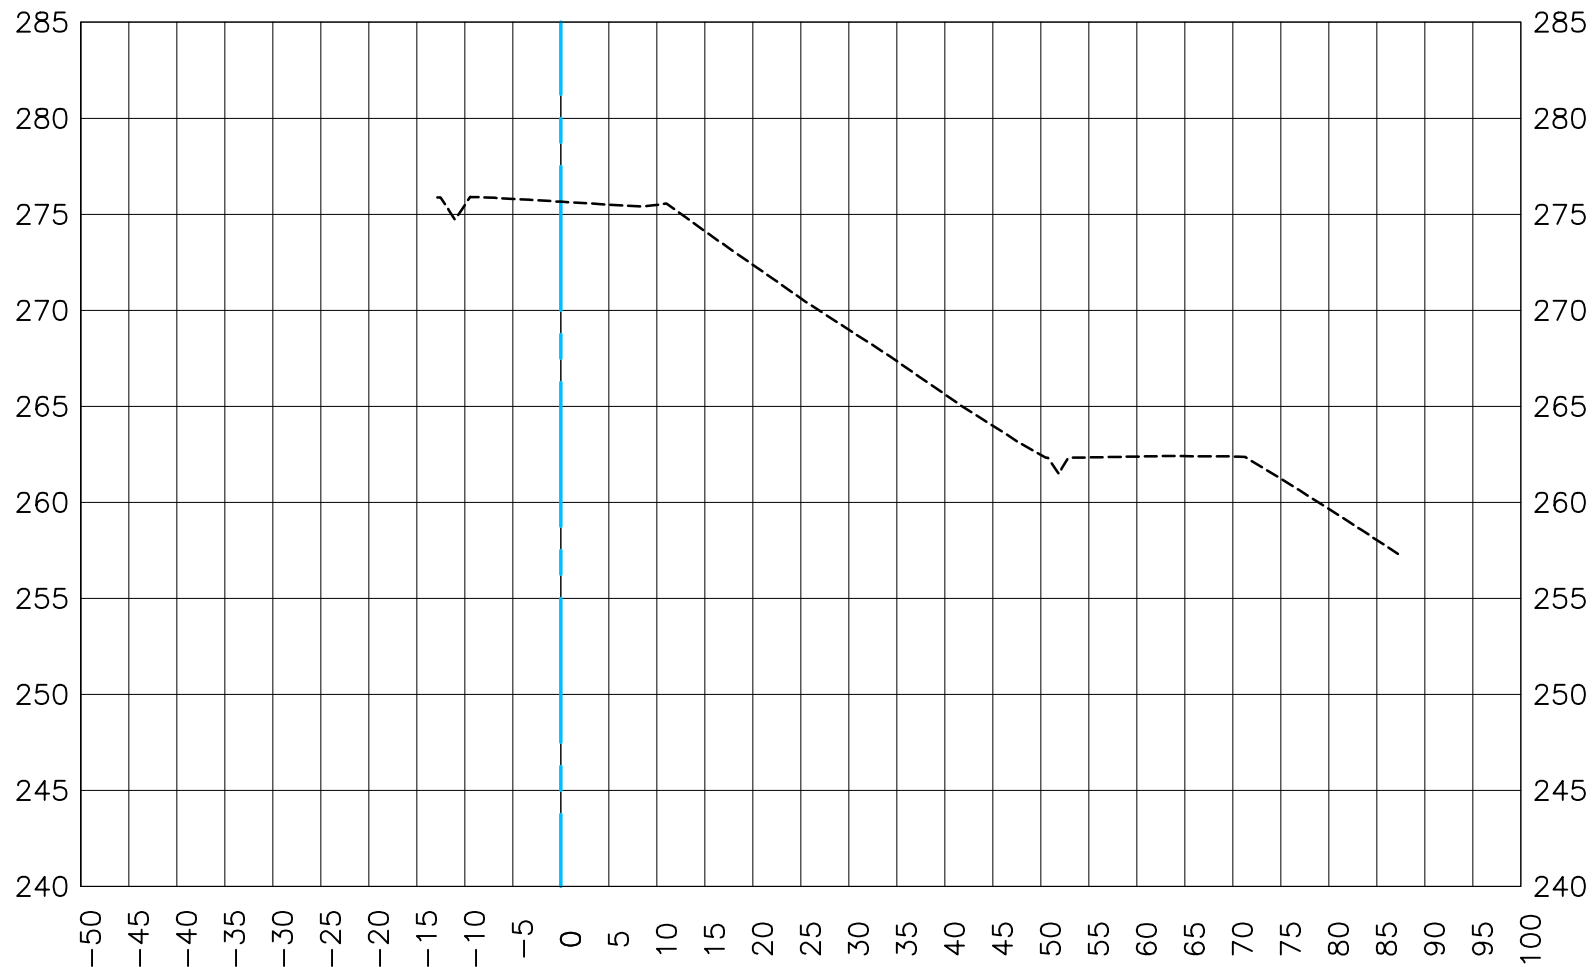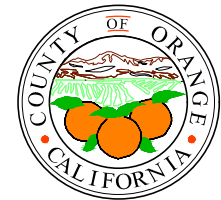

EXISTING CONDITION 2020

Station 13+00.00


Vert. Scale: 1"=5'

Hor. Scale: 1"=20'

DATE PREPARED: 03/23/2020



GALIVAN
PERIMETER ROAD
CL

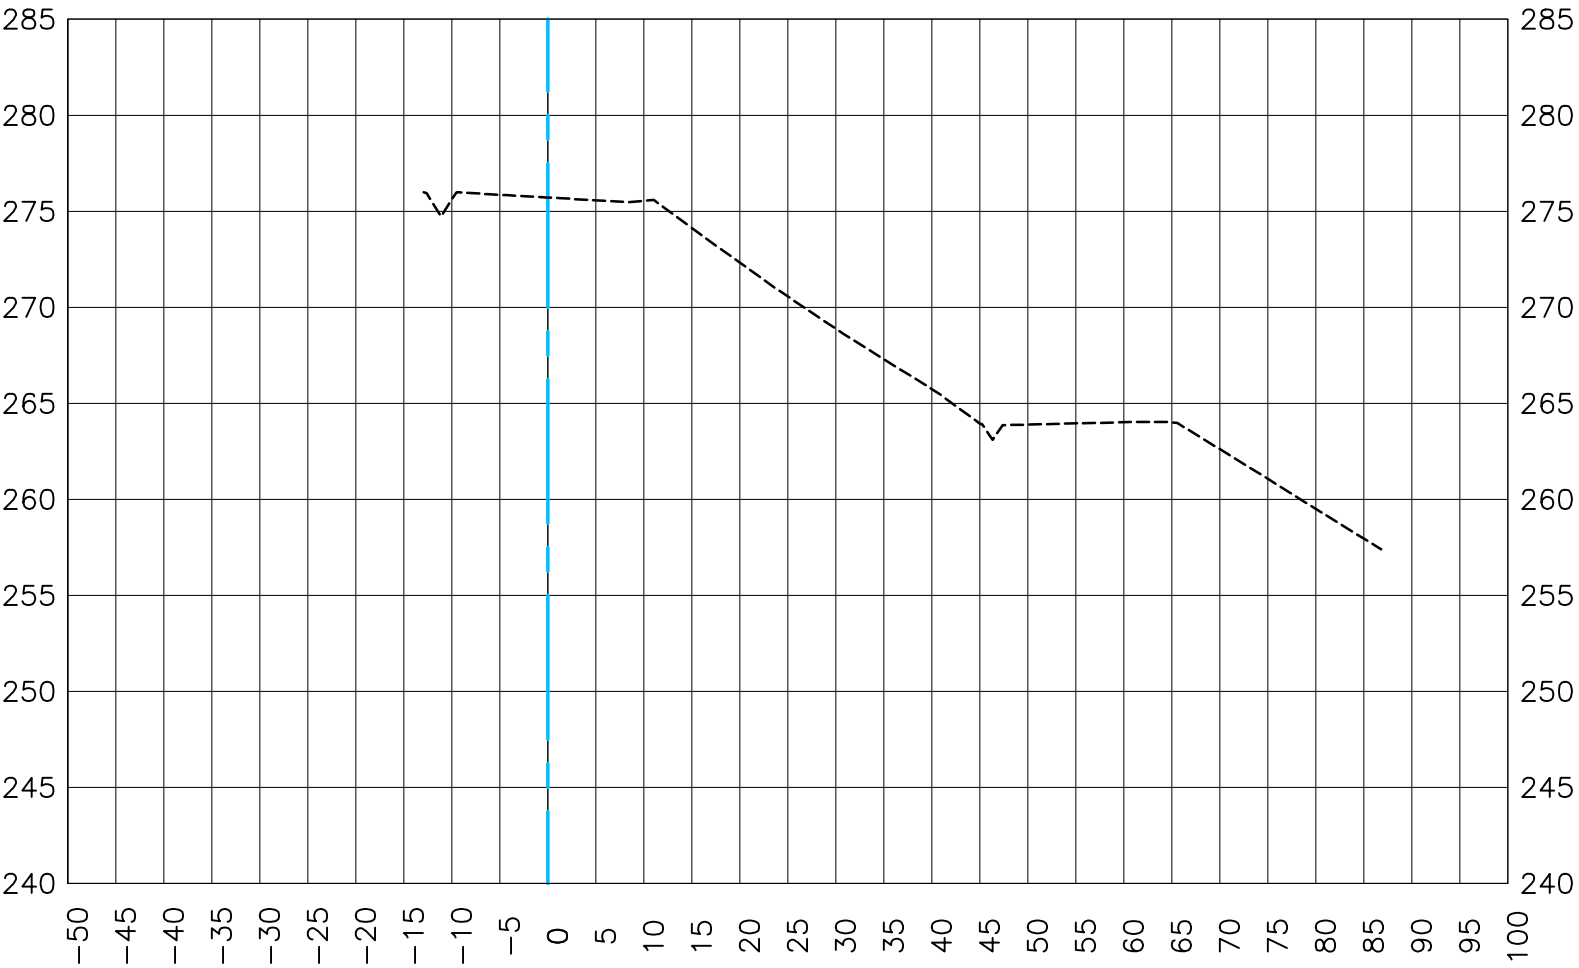

EXISTING CONDITION 2020

Station 13+25.00


Vert. Scale: 1"=5'
Hor. Scale: 1"=20'

DATE PREPARED: 03/23/2020

U.S. Survey
Foot

OC Public Works/Engineering Services
OC Survey/Field Services
Boundary Analysis & Mapping

GALIVAN PERIMETER ROAD CL

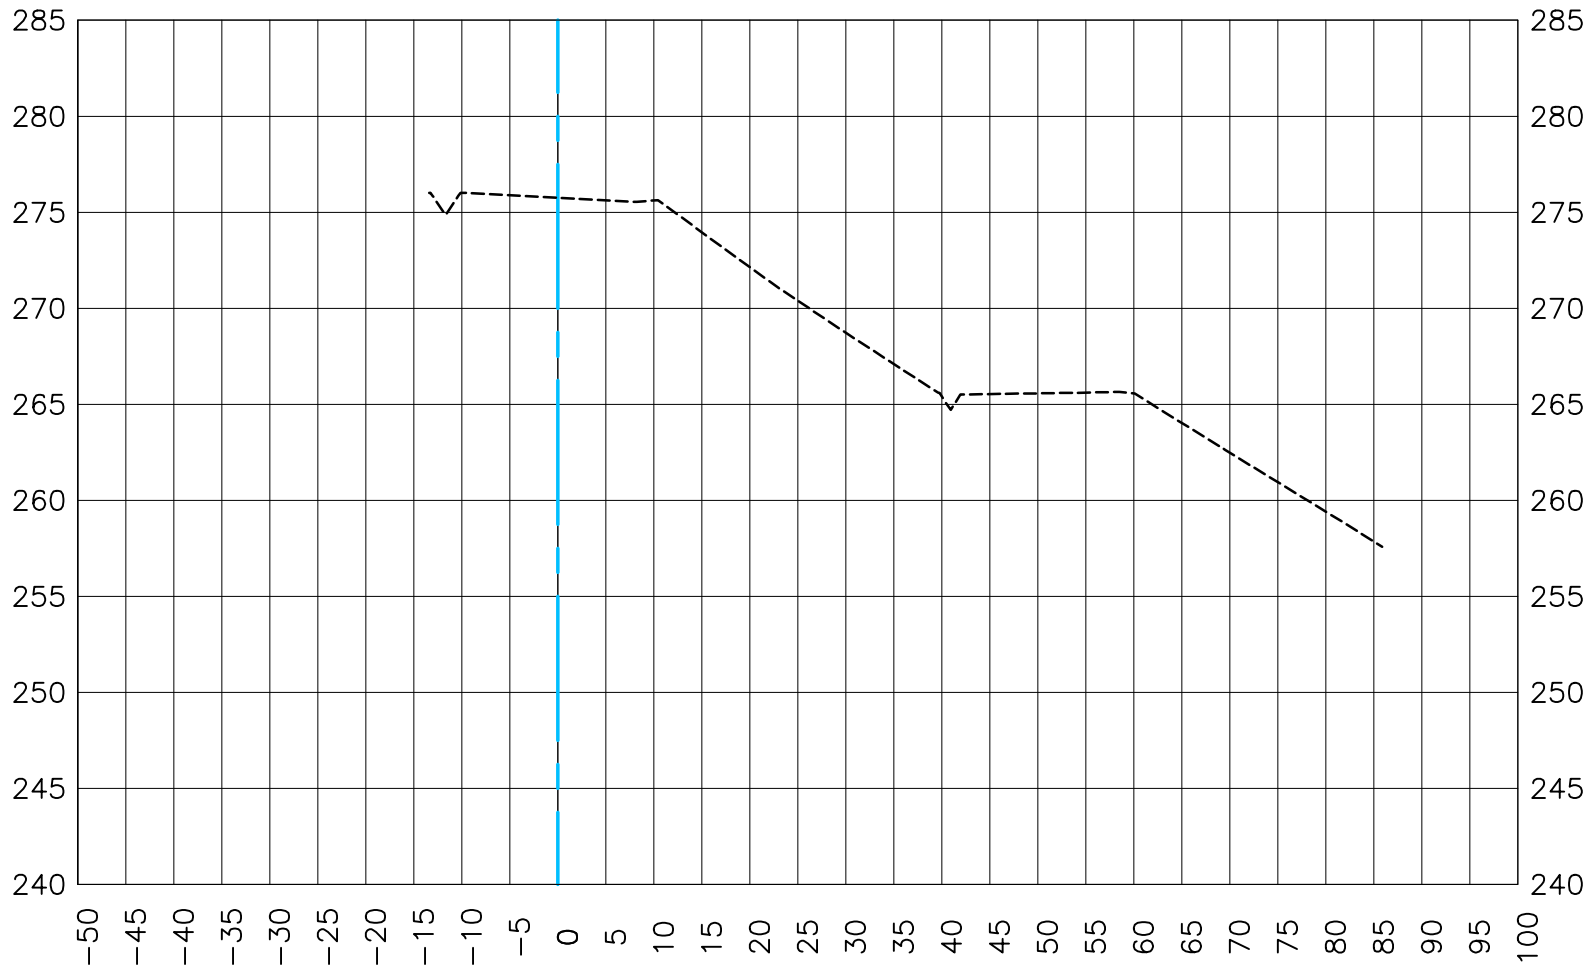

EXISTING CONDITION 2020

Station 13+50.00



Vert. Scale: 1"=5'
Hor. Scale: 1"=20'

DATE PREPARED: 03/23/2020

U.S. *Survey
Foot*

OC Public Works/Engineering Services
OC Survey/Field Services
Boundary Analysis & Mapping

GALIVAN PERIMETER ROAD CL

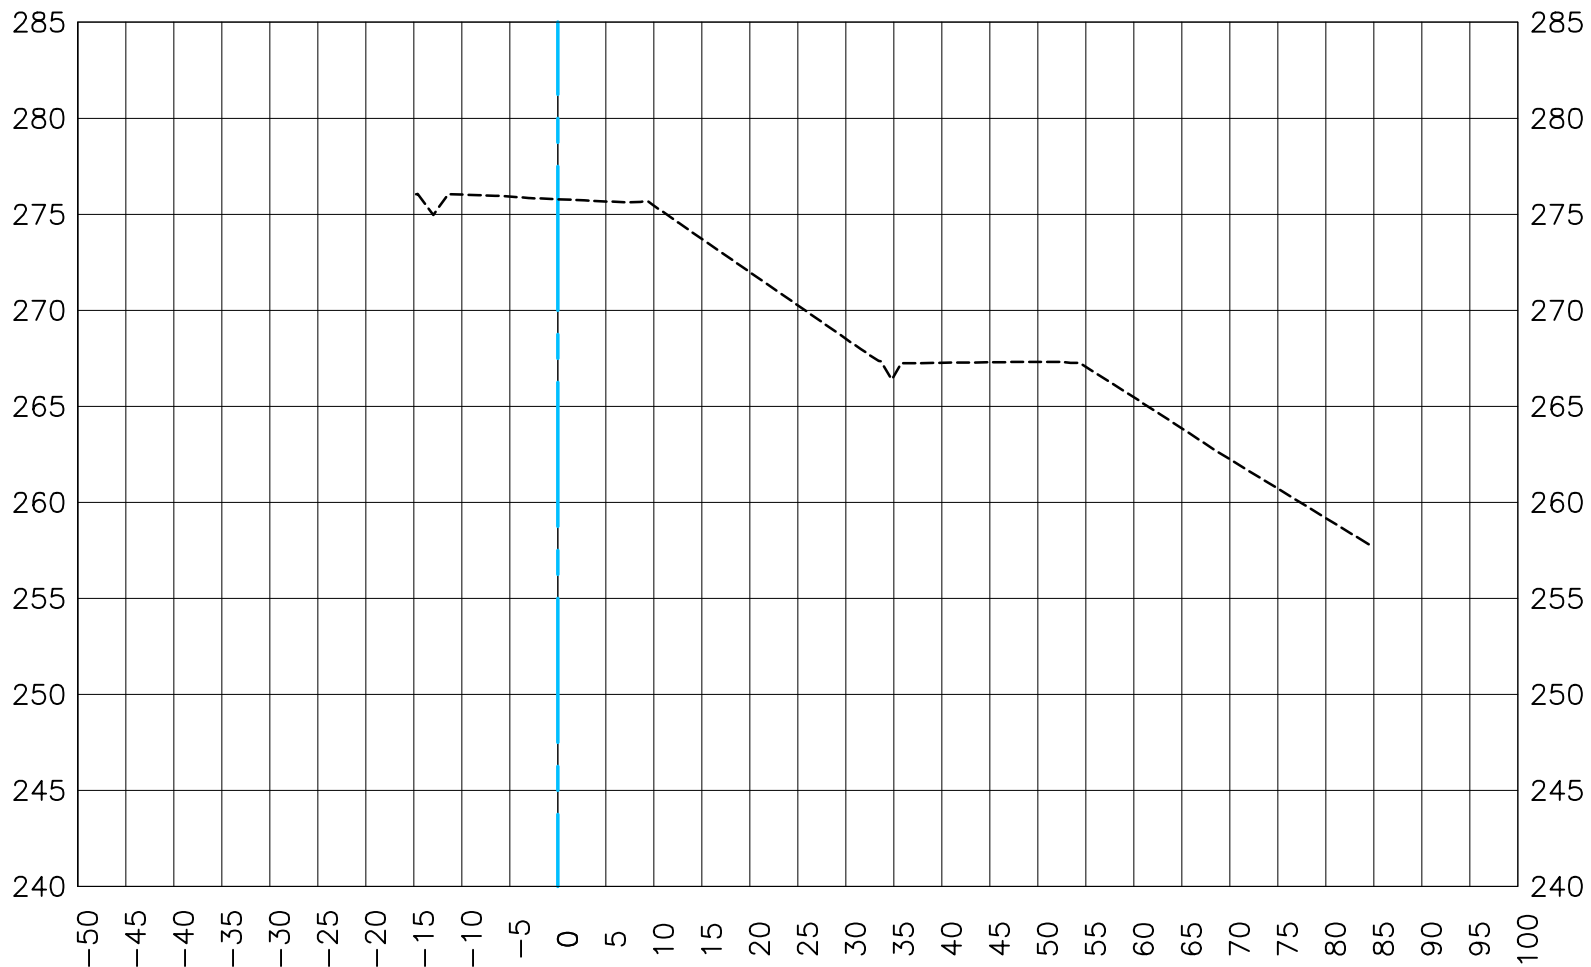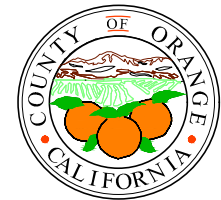

EXISTING CONDITION 2020

Station 13+75.00

Vert. Scale: 1"=5'



Hor. Scale: 1"=20'

DATE PREPARED: 03/23/2020

U.S. *Survey
Foot*

OC Public Works/Engineering Services
OC Survey/Field Services
Boundary Analysis & Mapping

GALIVAN PERIMETER ROAD CL

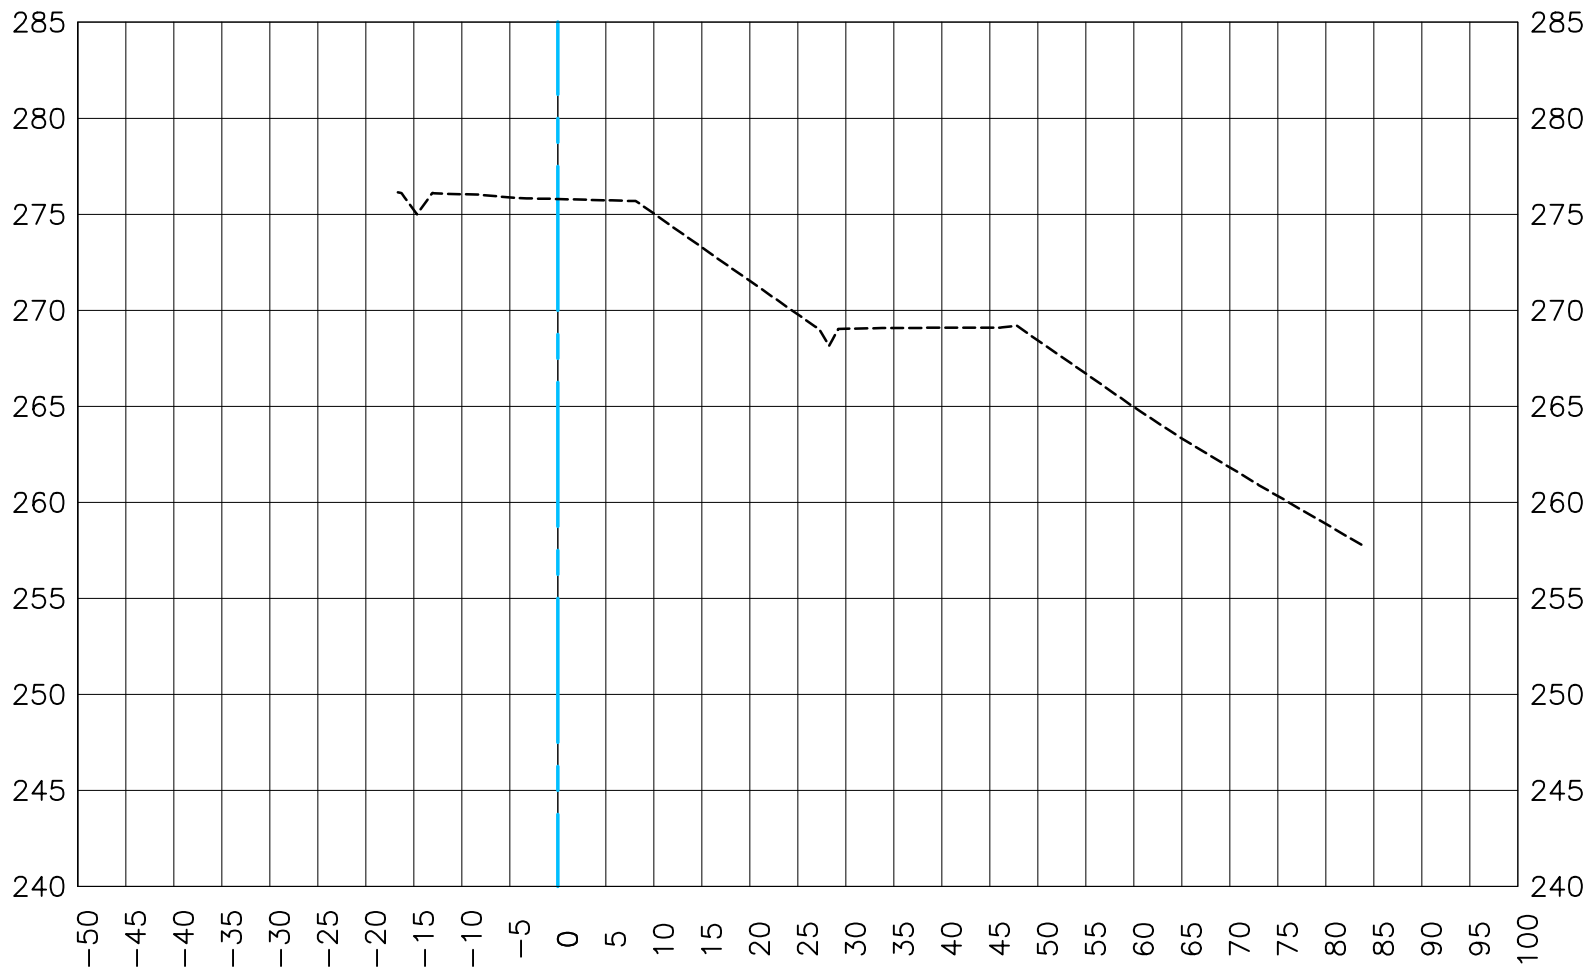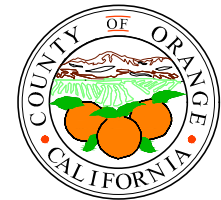

EXISTING CONDITION 2020

Station 14+00.00

Vert. Scale: 1"=5'


Hor. Scale: 1"=20'

DATE PREPARED: 03/23/2020

U.S. *Survey
Foot*

OC Public Works/Engineering Services
OC Survey/Field Services
Boundary Analysis & Mapping

GALIVAN PERIMETER ROAD CL

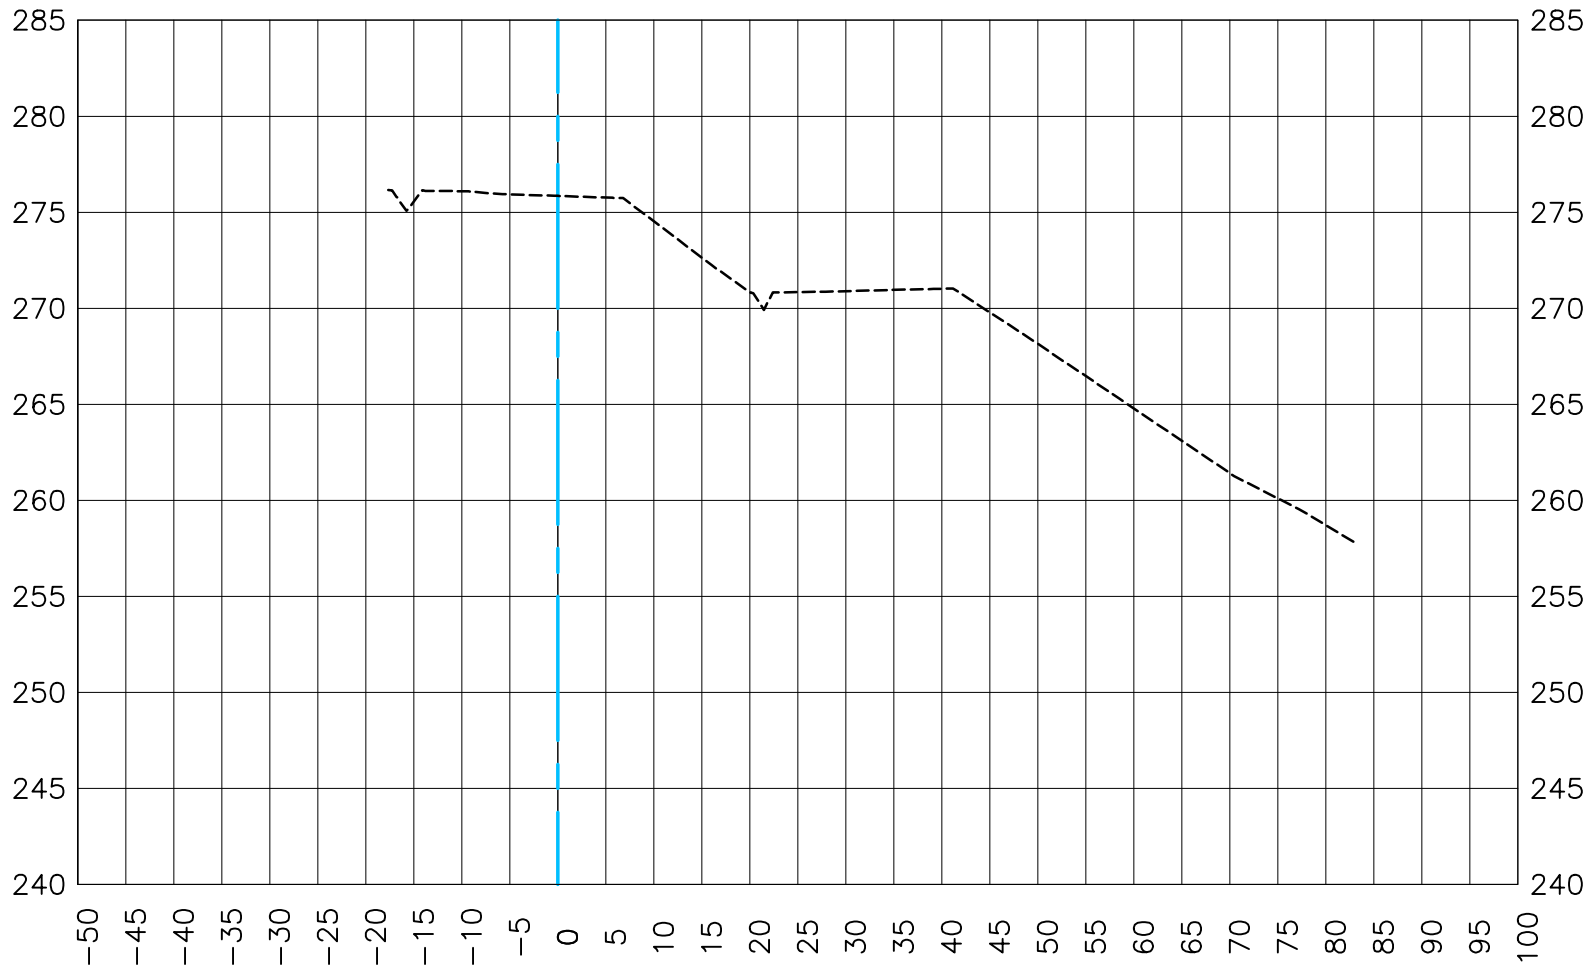


EXISTING CONDITION 2020

Station 14+25.00


Vert. Scale: 1"=5'

Hor. Scale: 1"=20'

DATE PREPARED: 03/23/2020

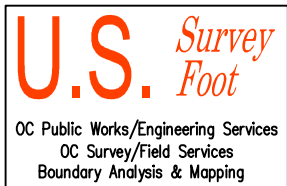

GALIVAN PERIMETER ROAD CL

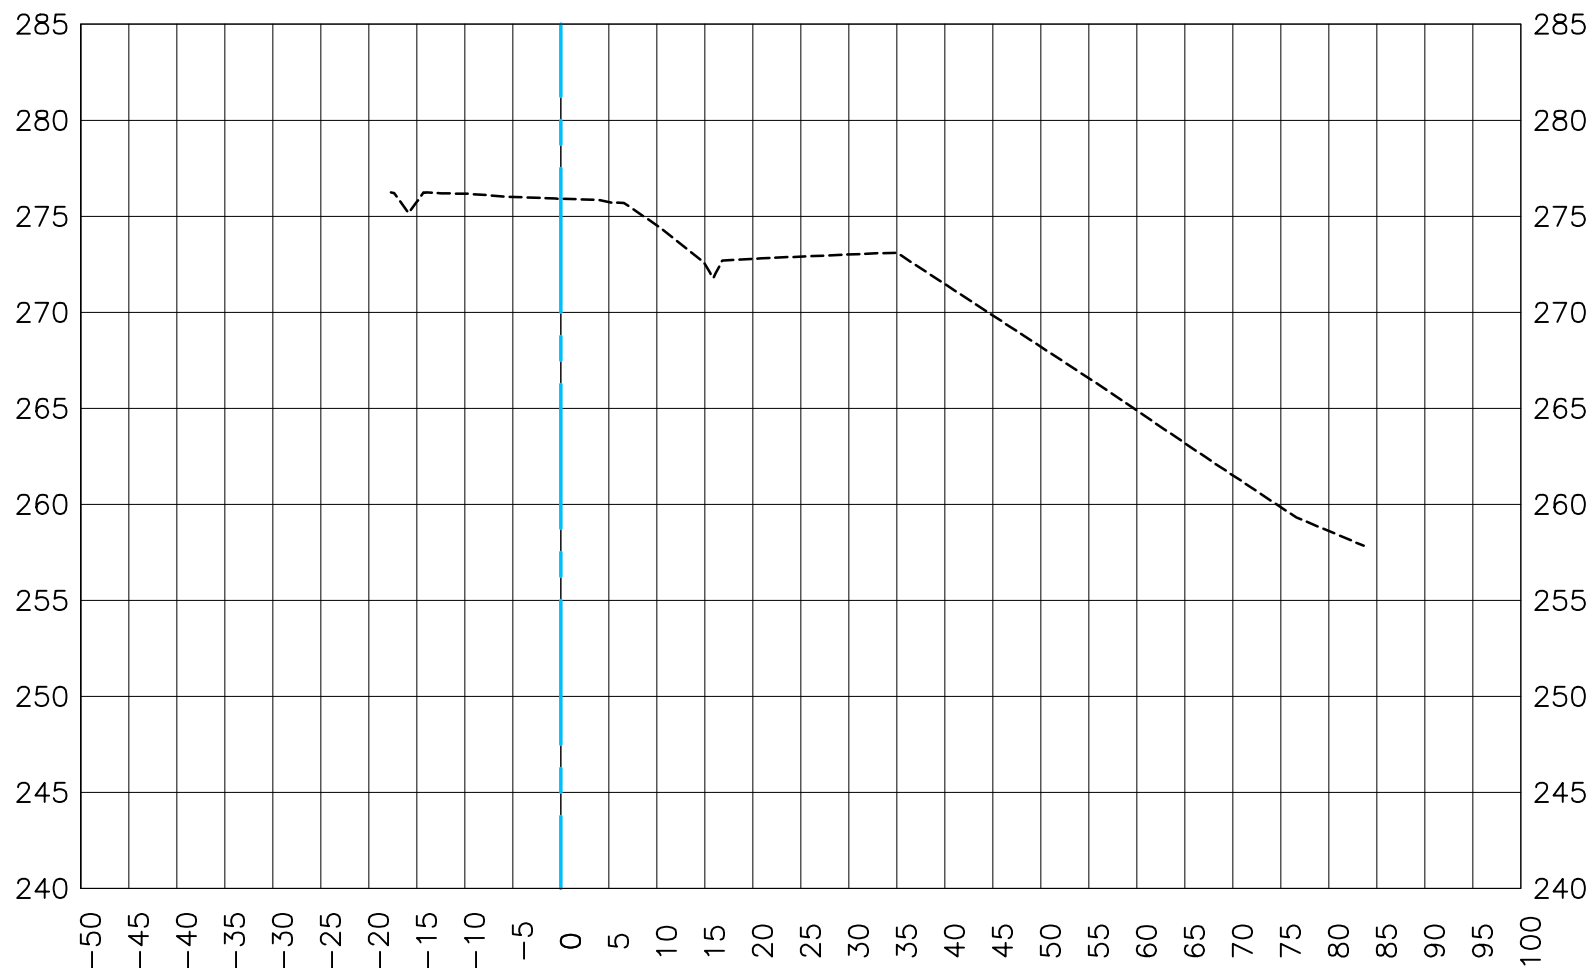


EXISTING CONDITION 2020

Station 14+50.00


Vert. Scale: 1"=5'

Hor. Scale: 1"=20'

DATE PREPARED: 03/23/2020

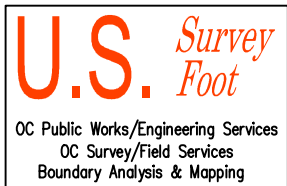

GALIVAN PERIMETER ROAD CL

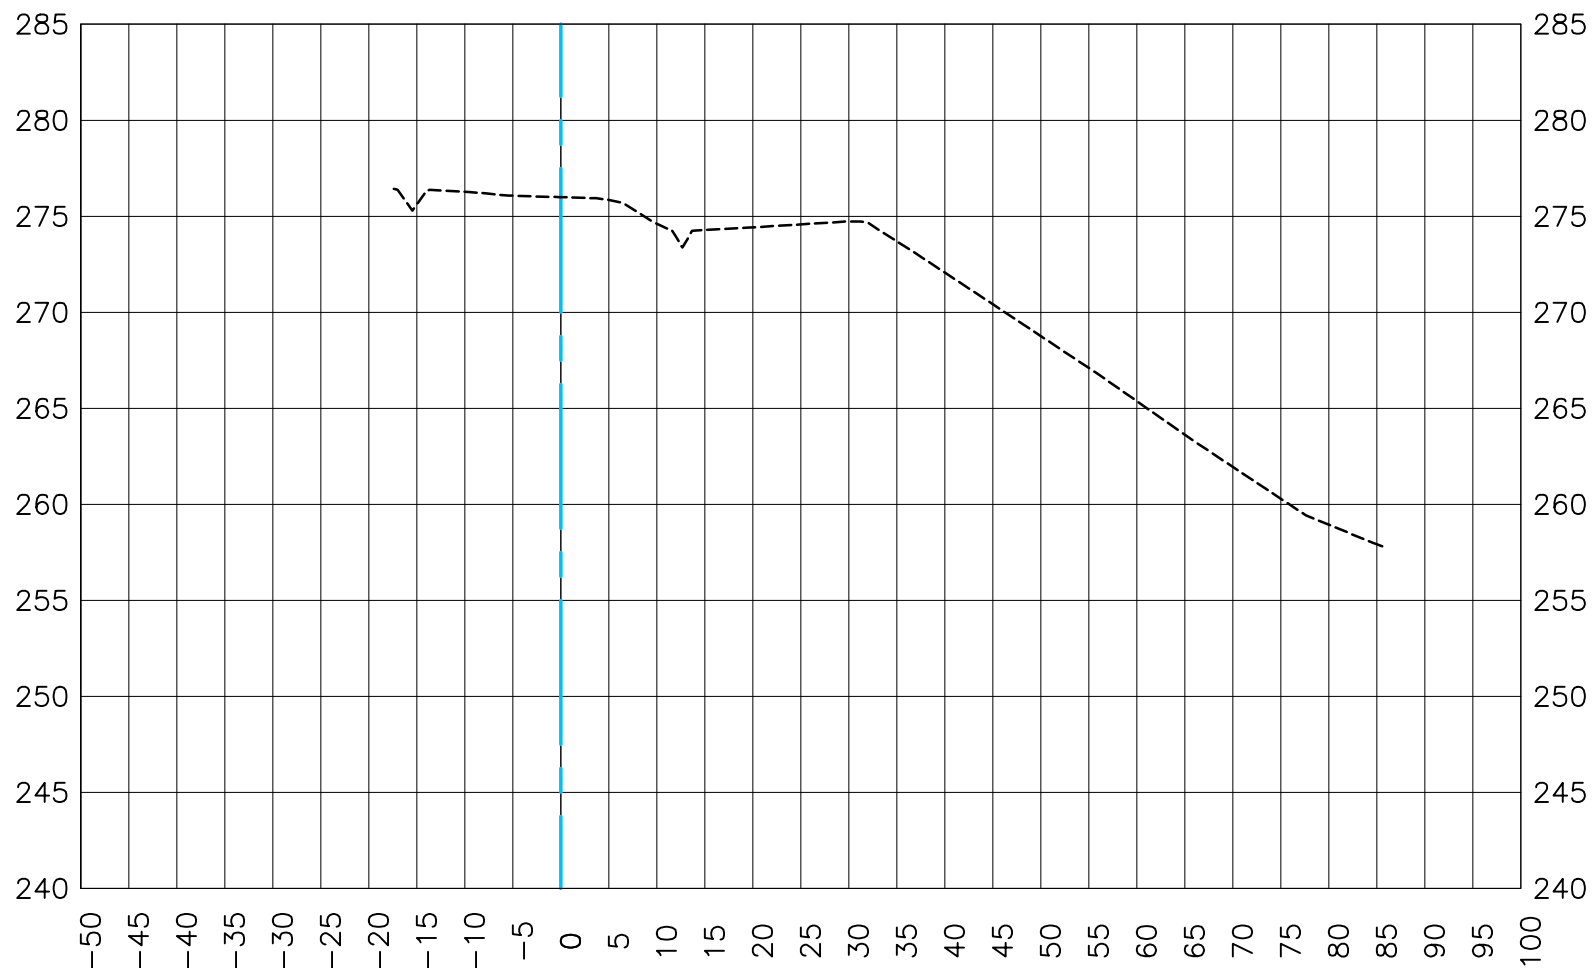

EXISTING CONDITION 2020

Station 14+75.00

Vert. Scale: 1"=5'



Hor. Scale: 1"=20'

DATE PREPARED: 03/23/2020

U.S. Survey
Foot

OC Public Works/Engineering Services
OC Survey/Field Services
Boundary Analysis & Mapping

GALIVAN PERIMETER ROAD CL

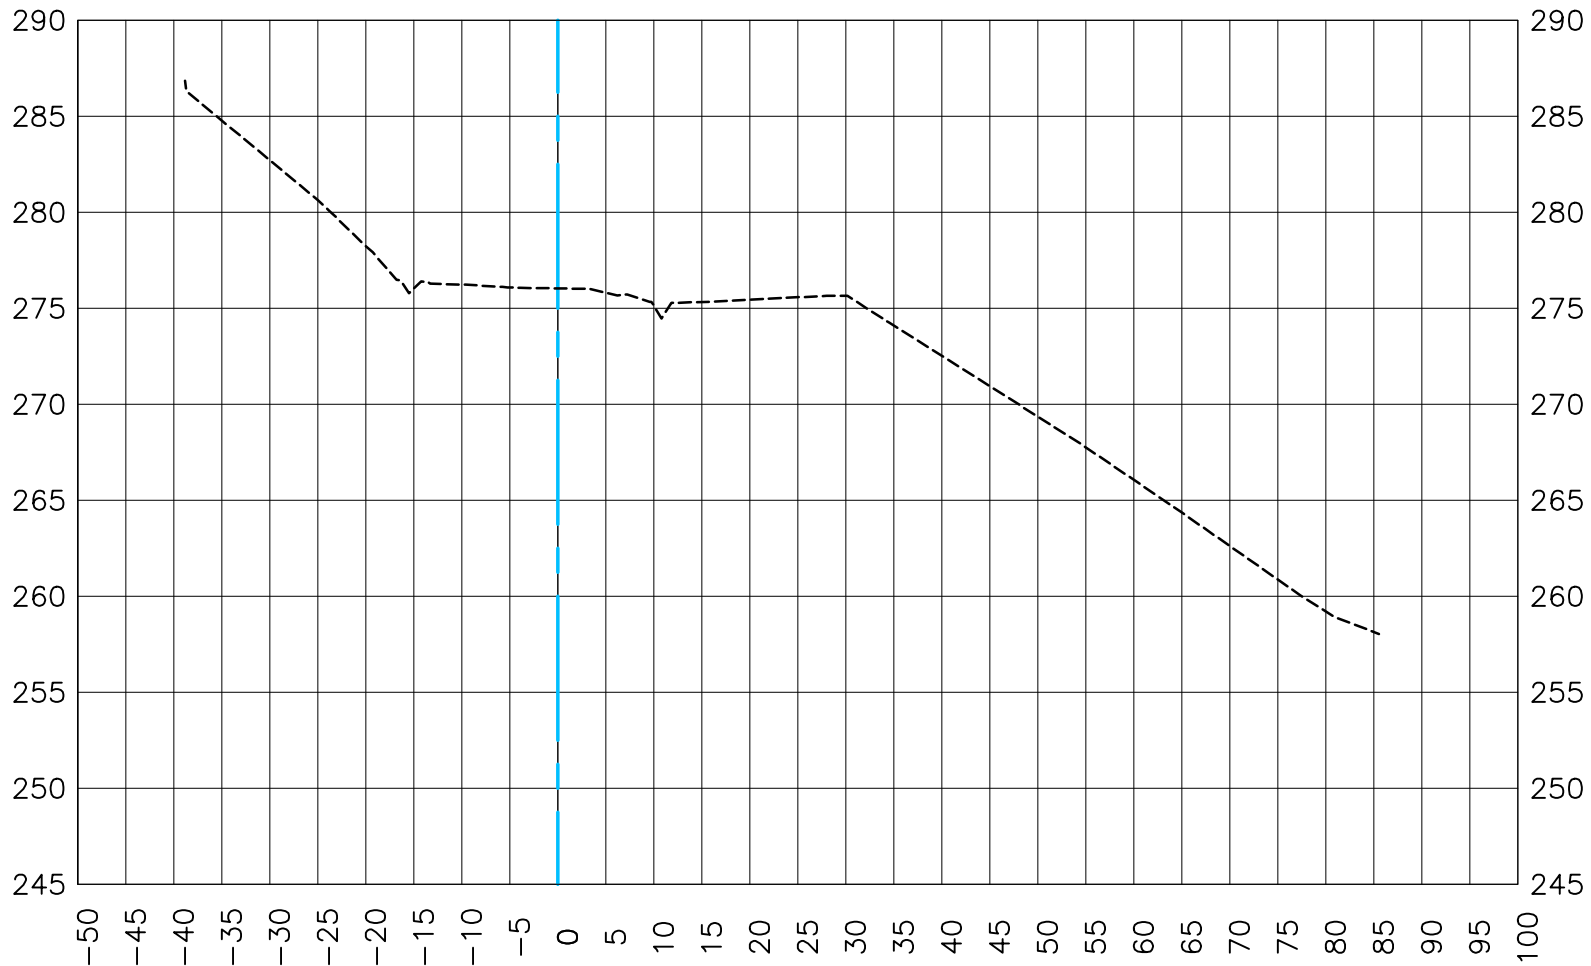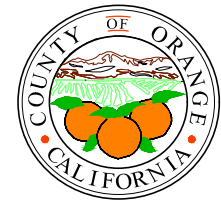


EXISTING CONDITION 2020

Station 15+00.00


Vert. Scale: 1"=5'

Hor. Scale: 1"=20'

DATE PREPARED: 03/23/2020

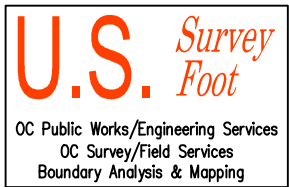

GALIVAN PERIMETER ROAD CL

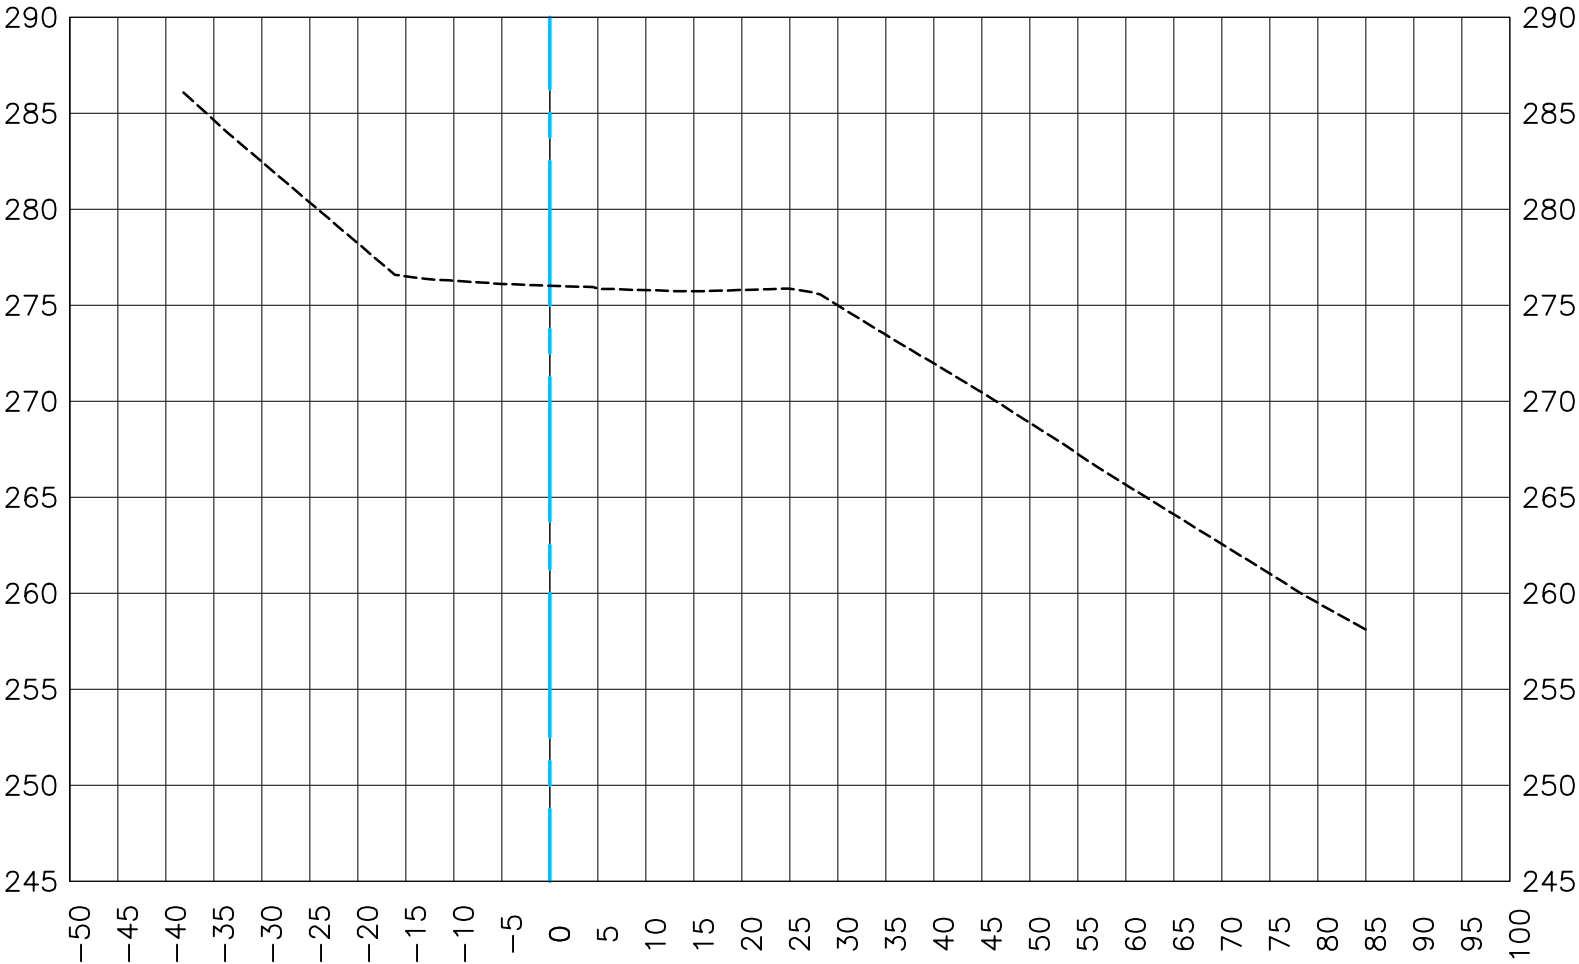

EXISTING CONDITION 2020

Station 15+25.00


Vert. Scale: 1"=5'
Hor. Scale: 1"=20'

DATE PREPARED: 03/23/2020

U.S. Survey Foot

OC Public Works/Engineering Services
OC Survey/Field Services
Boundary Analysis & Mapping

GALIVAN PERIMETER ROAD CL

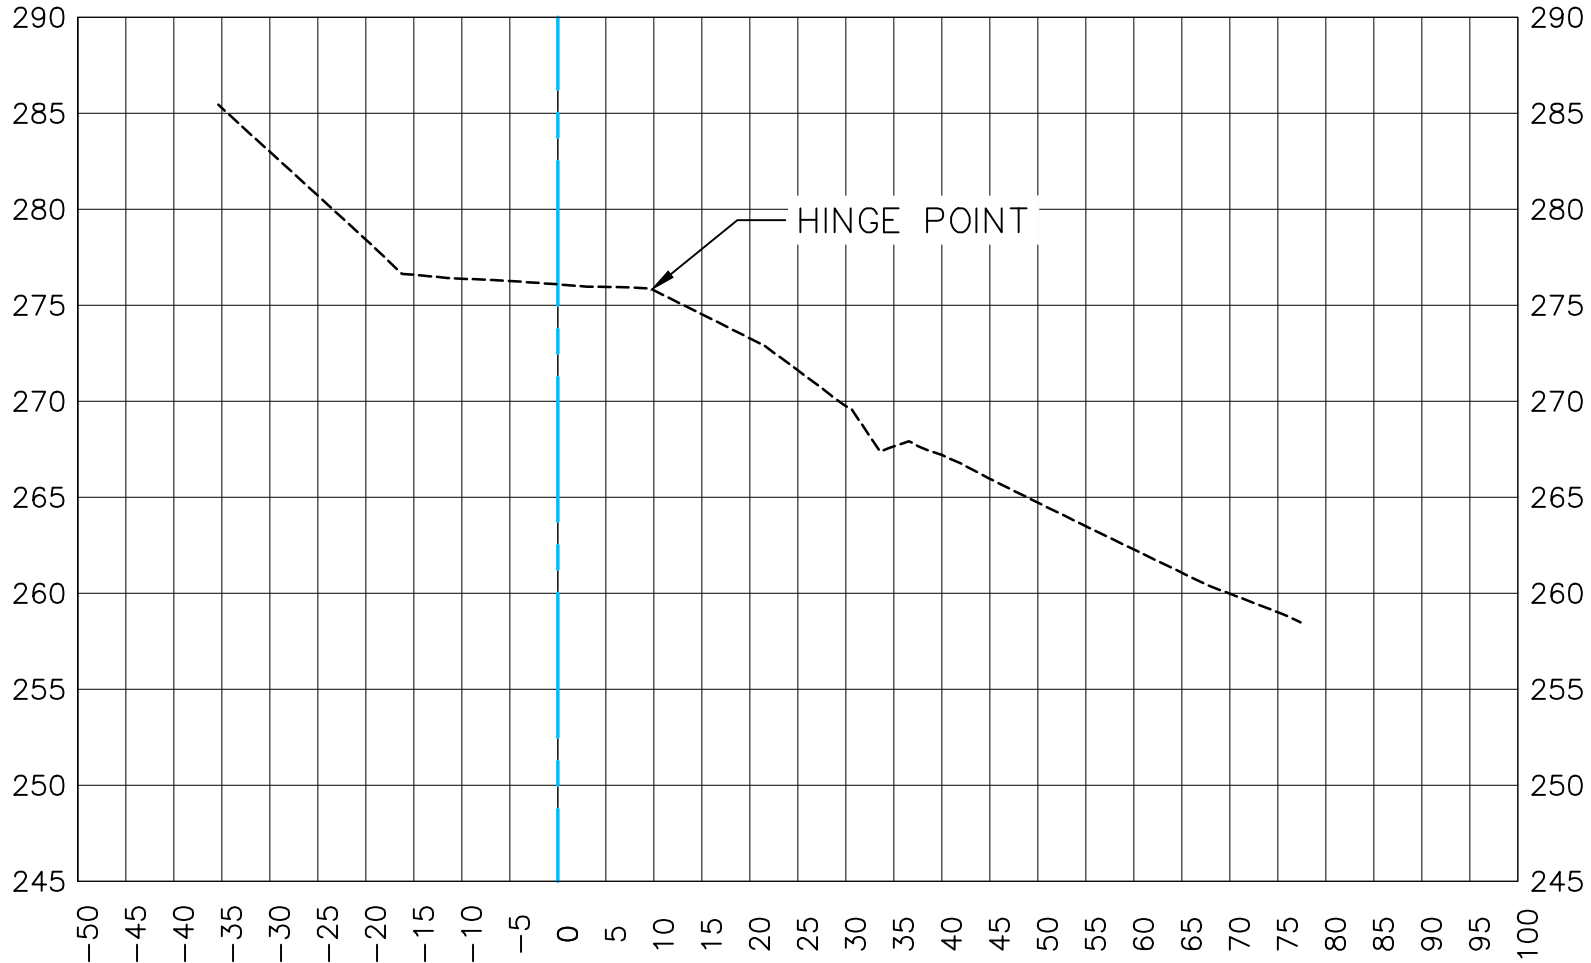

EXISTING CONDITION 2020

Station 15+50.00

Vert. Scale: 1"=5'



Hor. Scale: 1"=20'

DATE PREPARED: 03/23/2020

U.S. Survey Foot

OC Public Works/Engineering Services
OC Survey/Field Services
Boundary Analysis & Mapping

GALIVAN PERIMETER ROAD CL

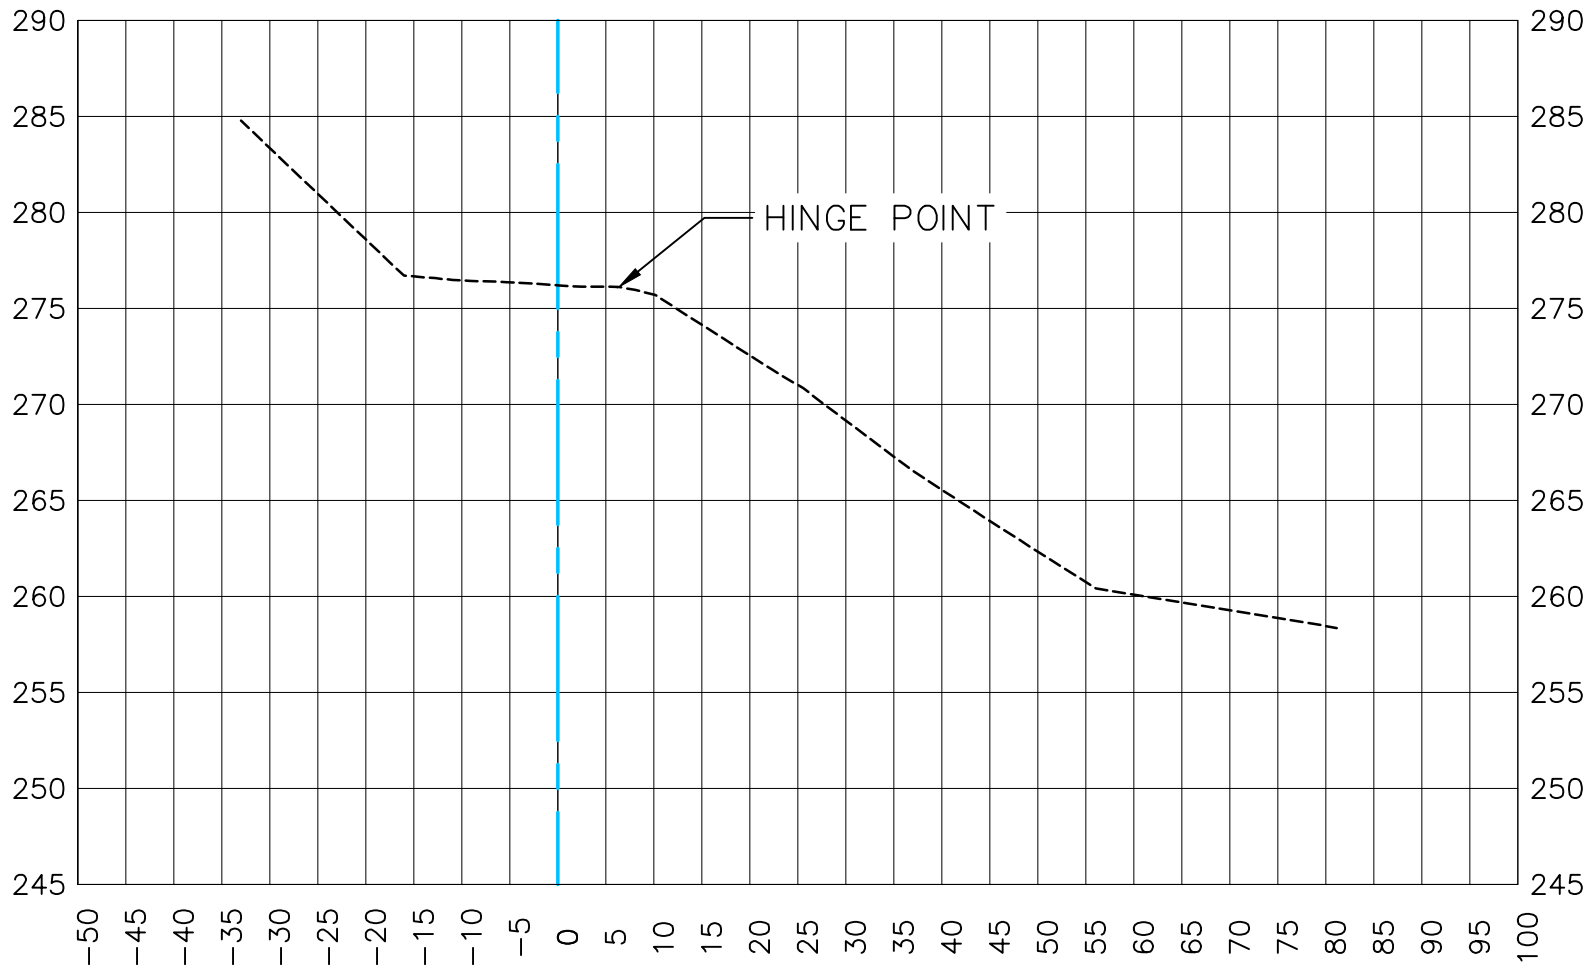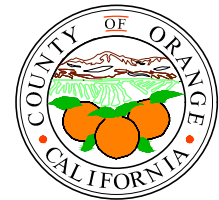

EXISTING CONDITION 2020

Station 15+75.00


Vert. Scale: 1"=5'
Hor. Scale: 1"=20'

DATE PREPARED: 03/23/2020

U.S. Survey Foot

OC Public Works/Engineering Services
OC Survey/Field Services
Boundary Analysis & Mapping

GALIVAN PERIMETER ROAD CL

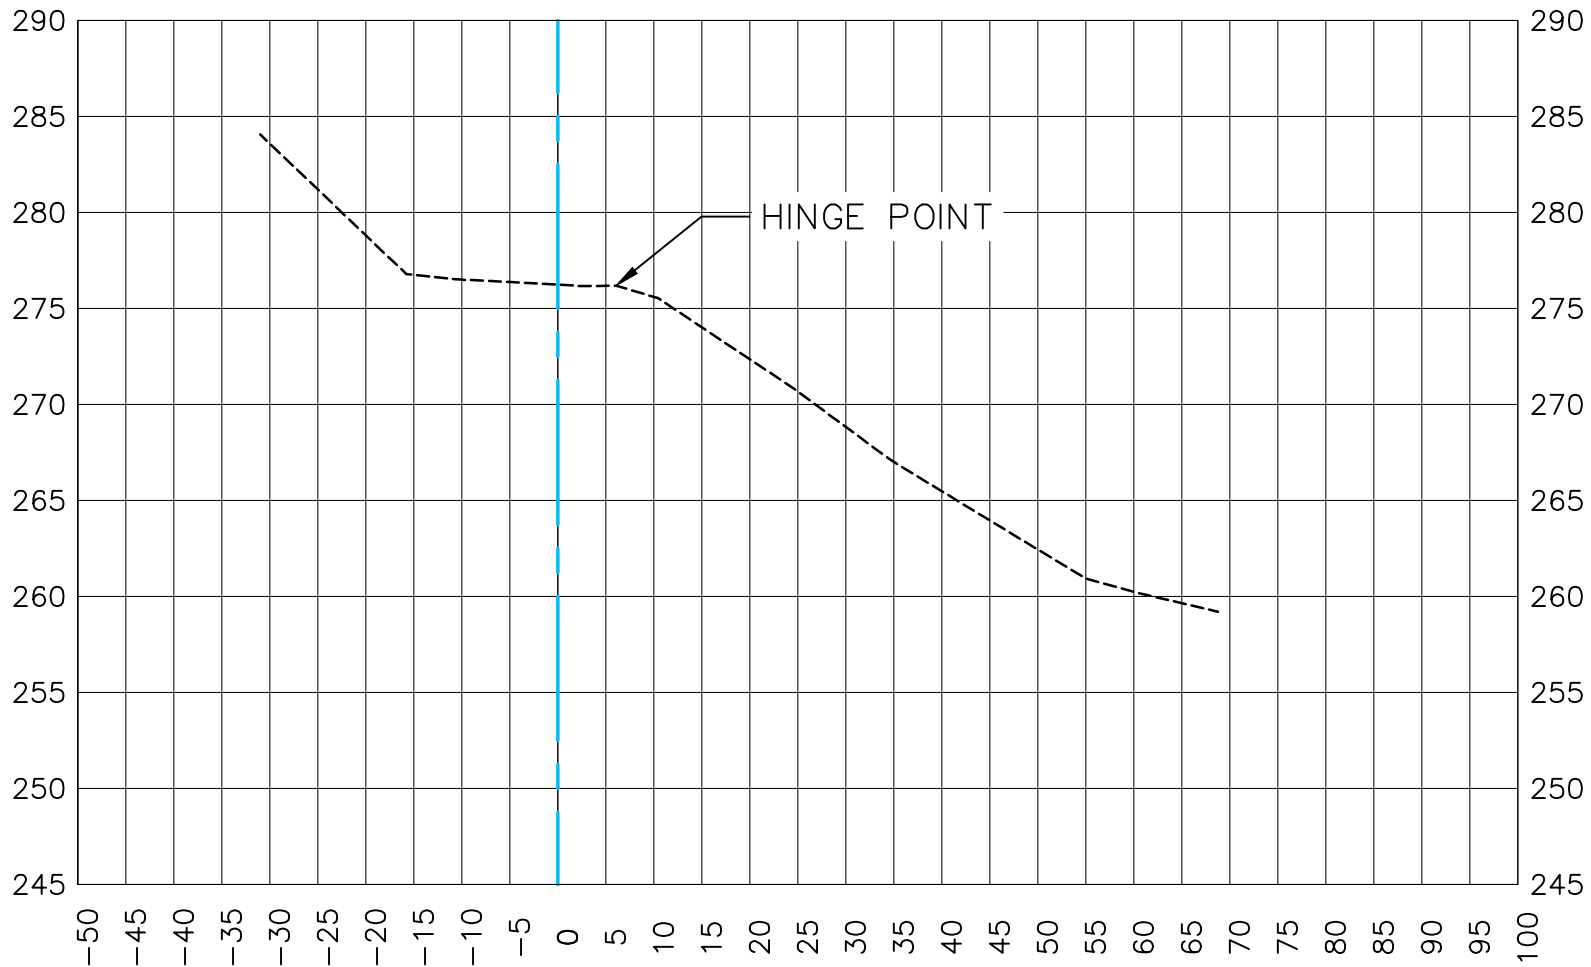

EXISTING CONDITION 2020

Station 16+00.00



Vert. Scale: 1"=5'
Hor. Scale: 1"=20'

DATE PREPARED: 03/23/2020

U.S. Survey Foot

OC Public Works/Engineering Services
OC Survey/Field Services
Boundary Analysis & Mapping

GALIVAN PERIMETER ROAD CL

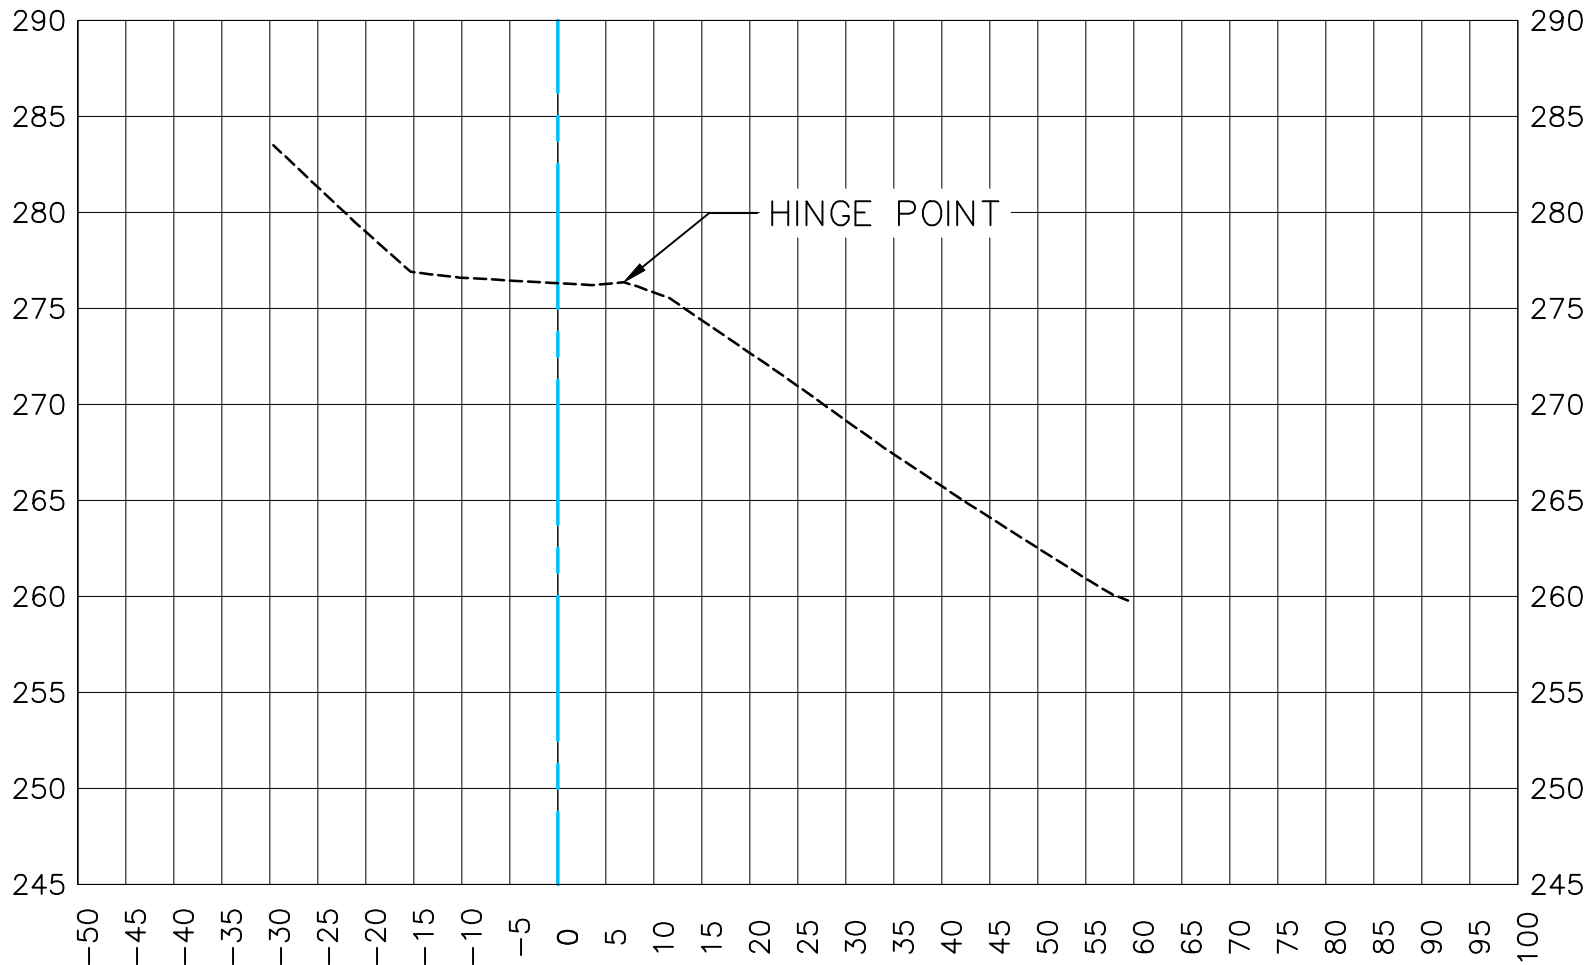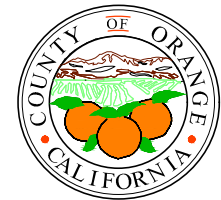

EXISTING CONDITION 2020

Station 16+25.00


Vert. Scale: 1"=5'
Hor. Scale: 1"=20'

DATE PREPARED: 03/23/2020

U.S. Survey Foot

OC Public Works/Engineering Services
OC Survey/Field Services
Boundary Analysis & Mapping

GALIVAN PERIMETER ROAD CL

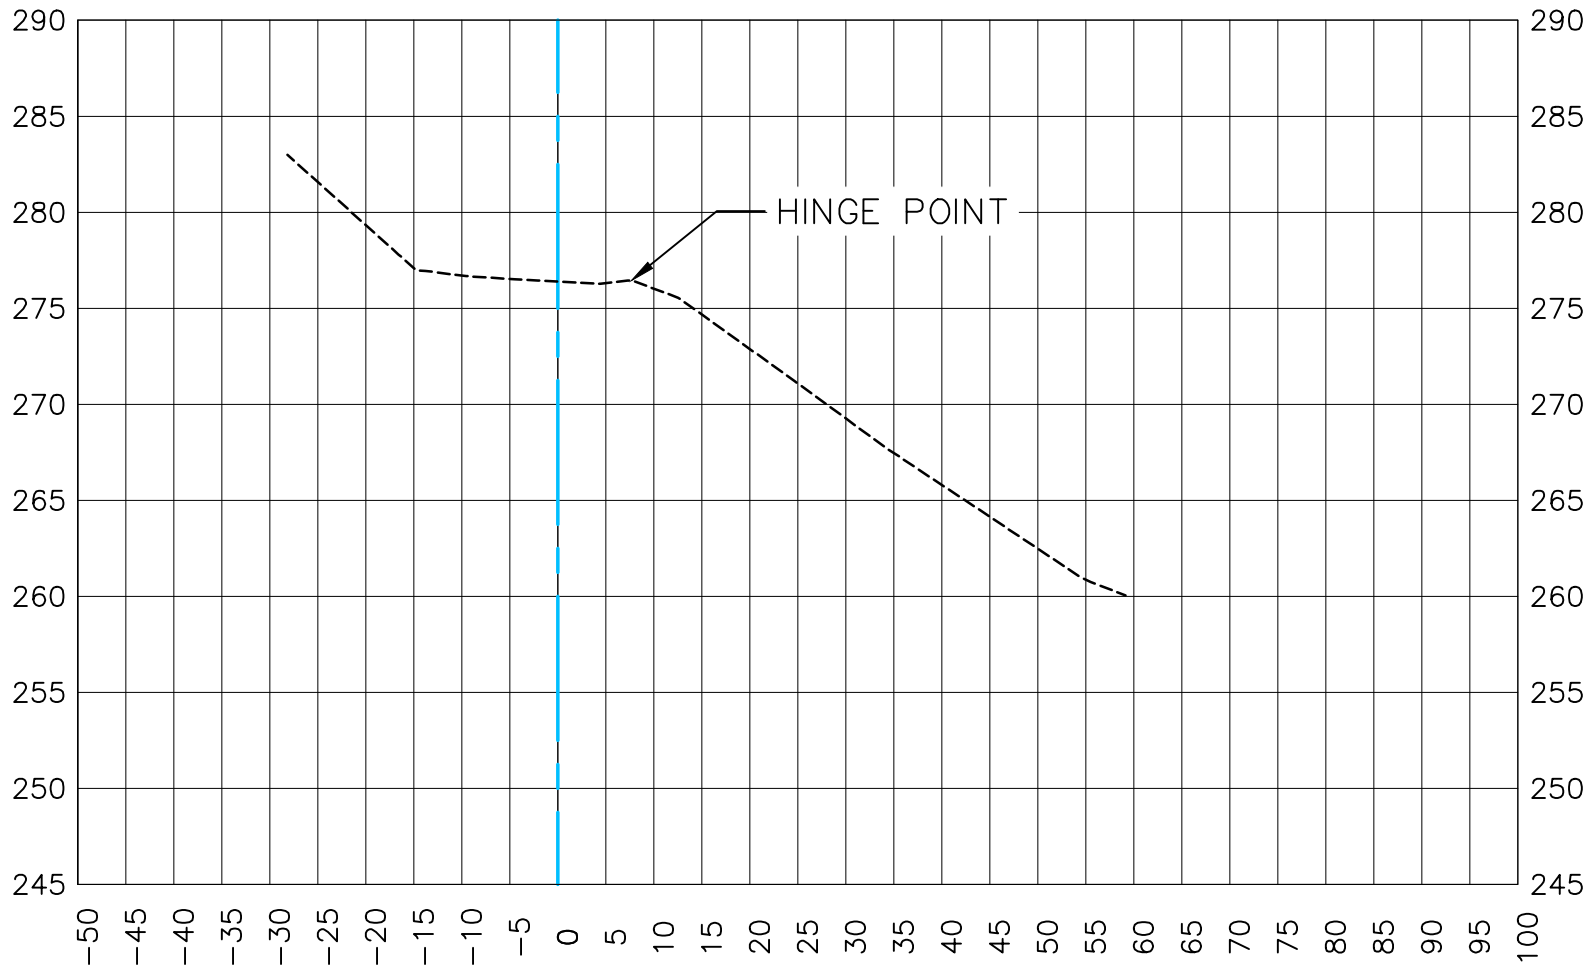


EXISTING CONDITION 2020


Station 16+50.00

Vert. Scale: 1"=5'
Hor. Scale: 1"=20'

DATE PREPARED: 03/23/2020

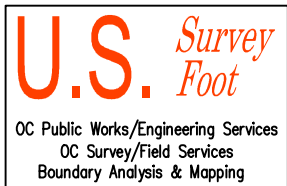

GALIVAN PERIMETER ROAD CL

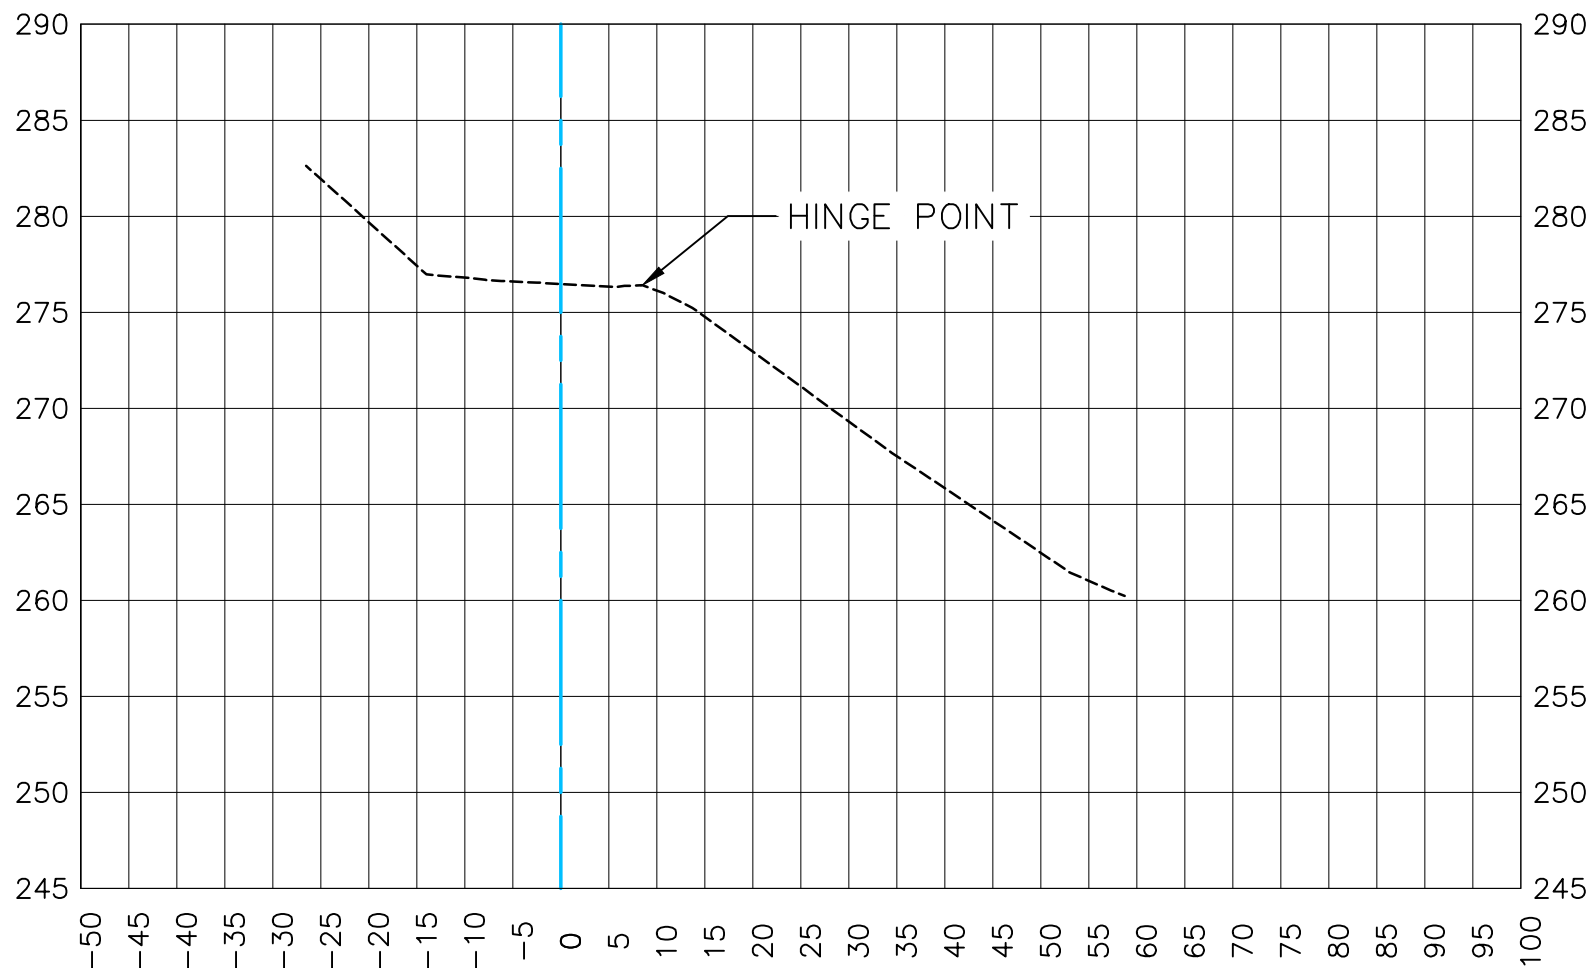


EXISTING CONDITION 2020

Station 16+75.00



Vert. Scale: 1"=5'

Hor. Scale: 1"=20'

DATE PREPARED: 03/23/2020

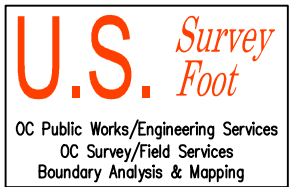

GALIVAN PERIMETER ROAD CL

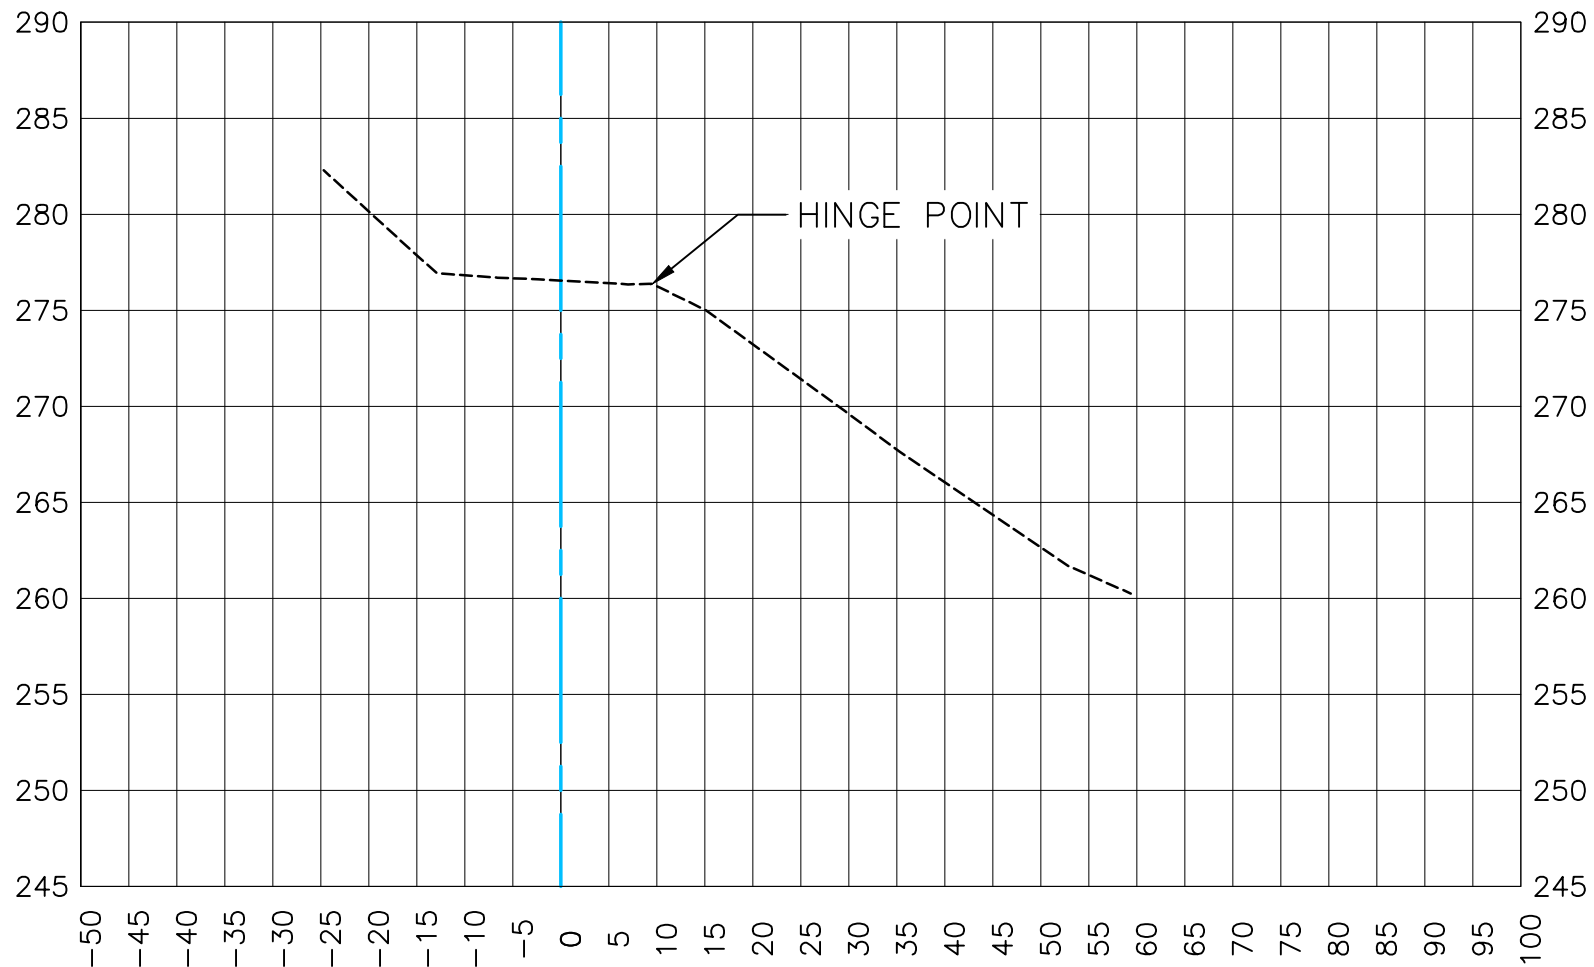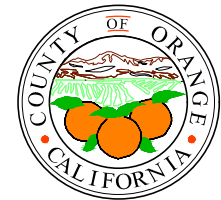

EXISTING CONDITION 2020

Station 17+00.00


Vert. Scale: 1"=5'

Hor. Scale: 1"=20'

DATE PREPARED: 03/23/2020



GALIVAN
PERIMETER ROAD
CL

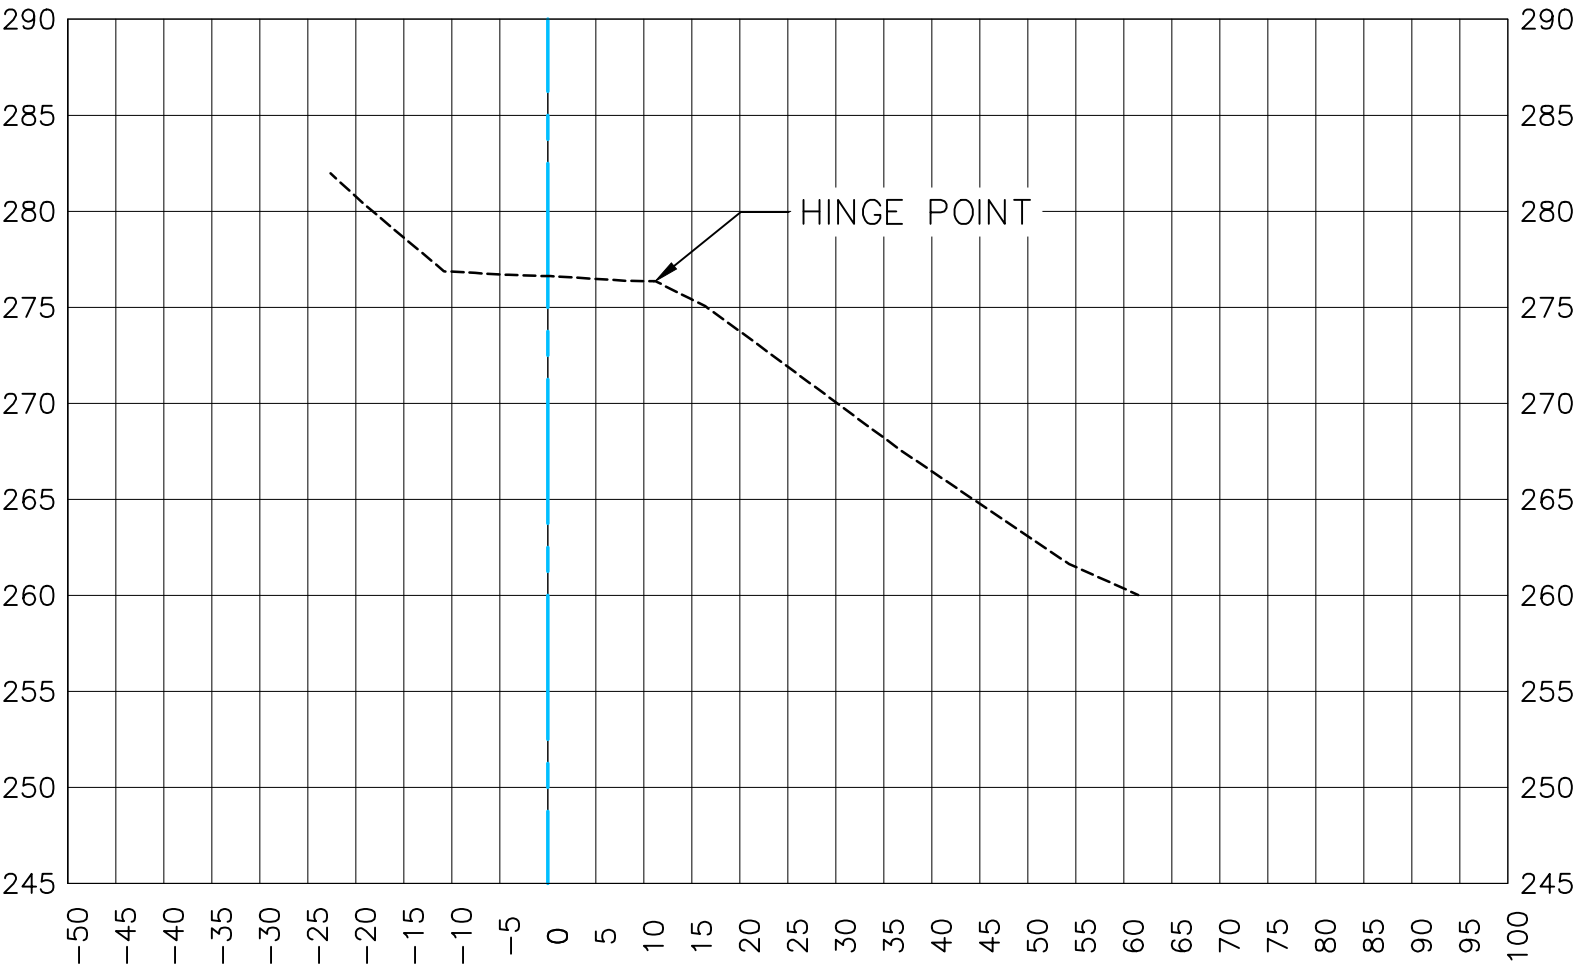


EXISTING CONDITION 2020



Station 17+25.00

Vert. Scale: 1"=5'
Hor. Scale: 1"=20'

DATE PREPARED: 03/23/2020

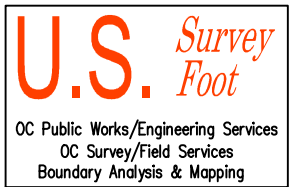

GALIVAN PERIMETER ROAD CL

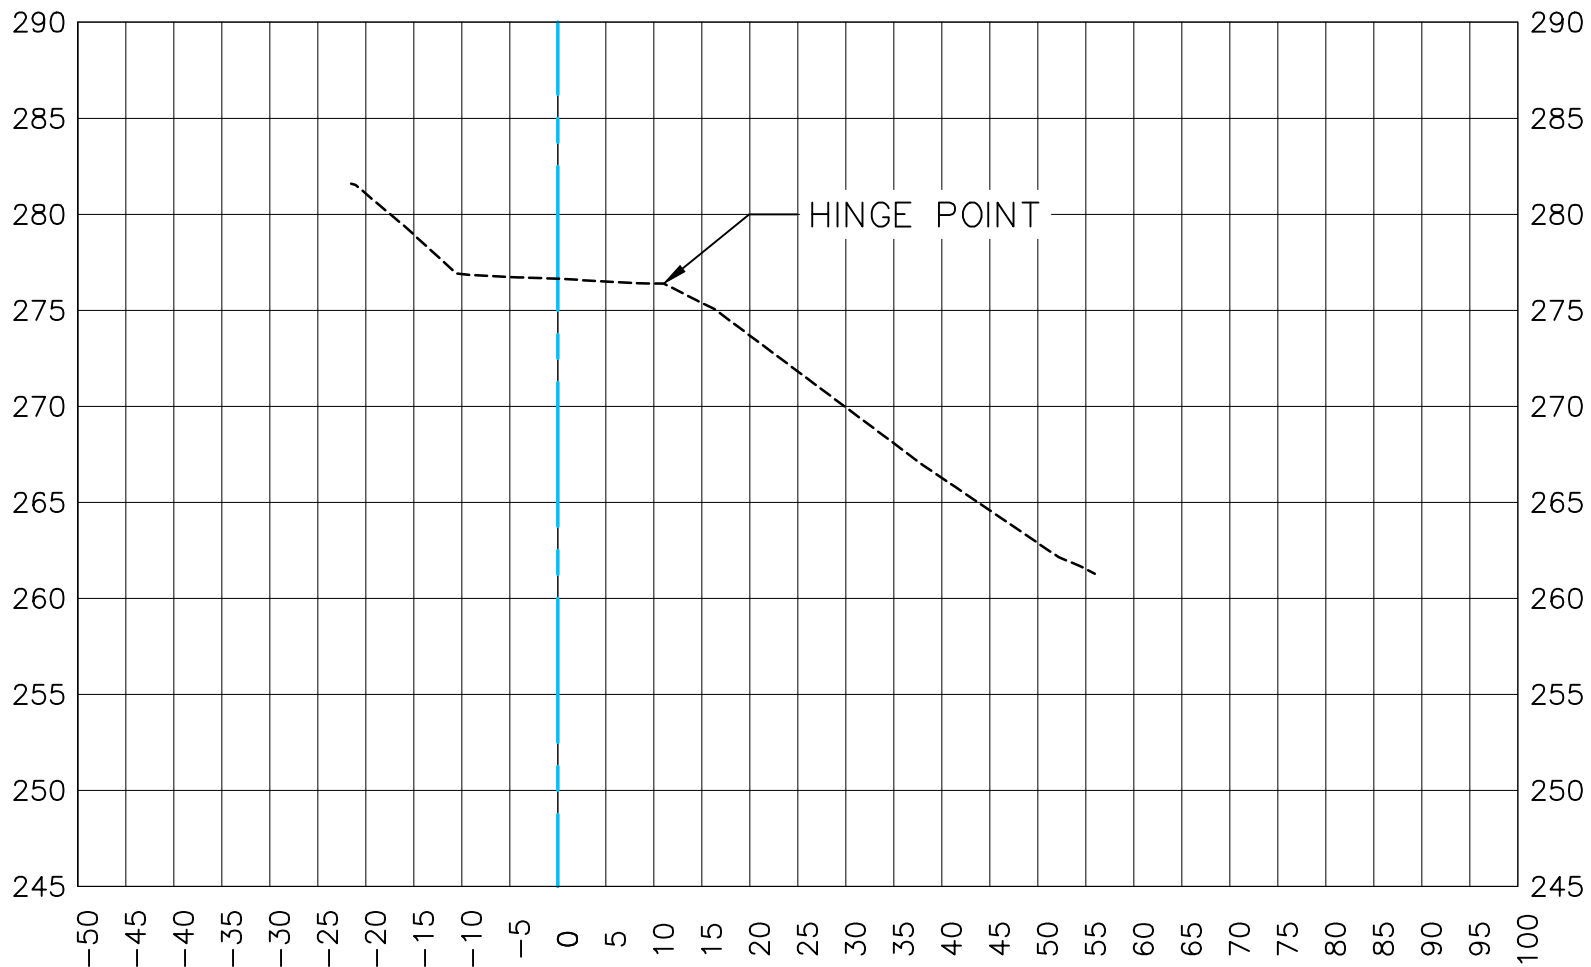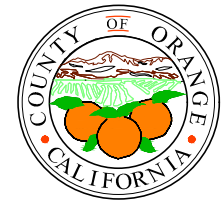


EXISTING CONDITION 2020

Station 17+50.00



Vert. Scale: 1"=5'

Hor. Scale: 1"=20'

DATE PREPARED: 03/23/2020

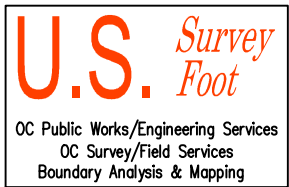

GALIVAN PERIMETER ROAD CL

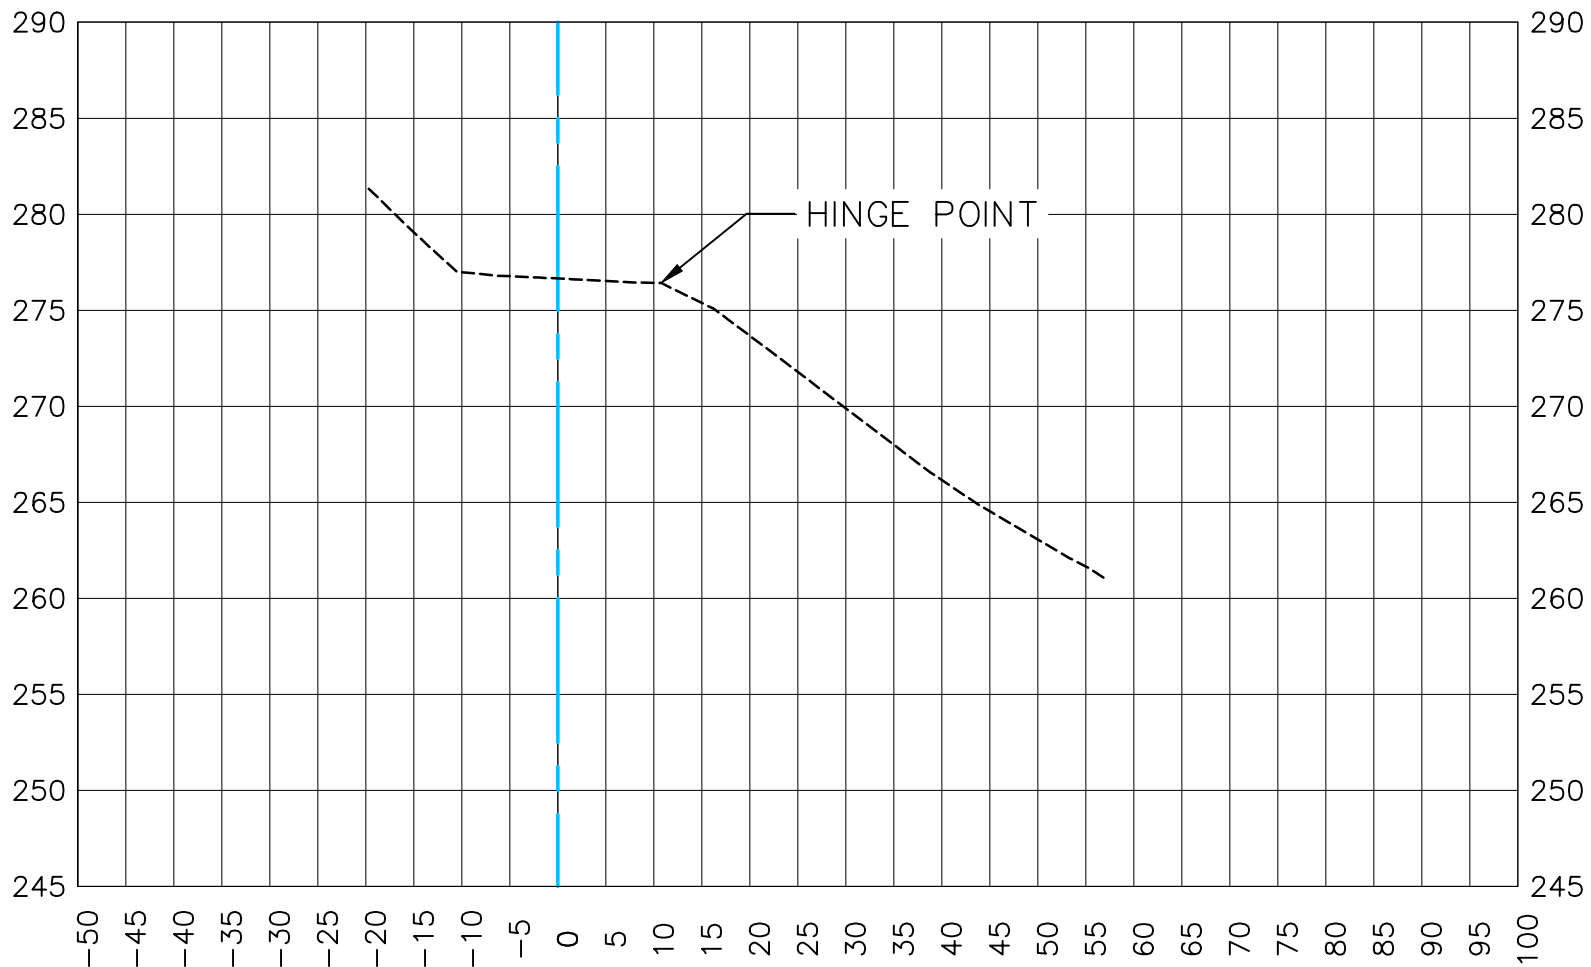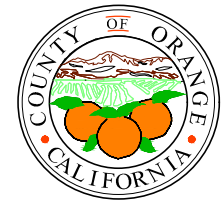

EXISTING CONDITION 2020

Station 17+75.00

Vert. Scale: 1"=5'


Hor. Scale: 1"=20'

DATE PREPARED: 03/23/2020

U.S. Survey Foot

OC Public Works/Engineering Services
OC Survey/Field Services
Boundary Analysis & Mapping

GALIVAN PERIMETER ROAD CL

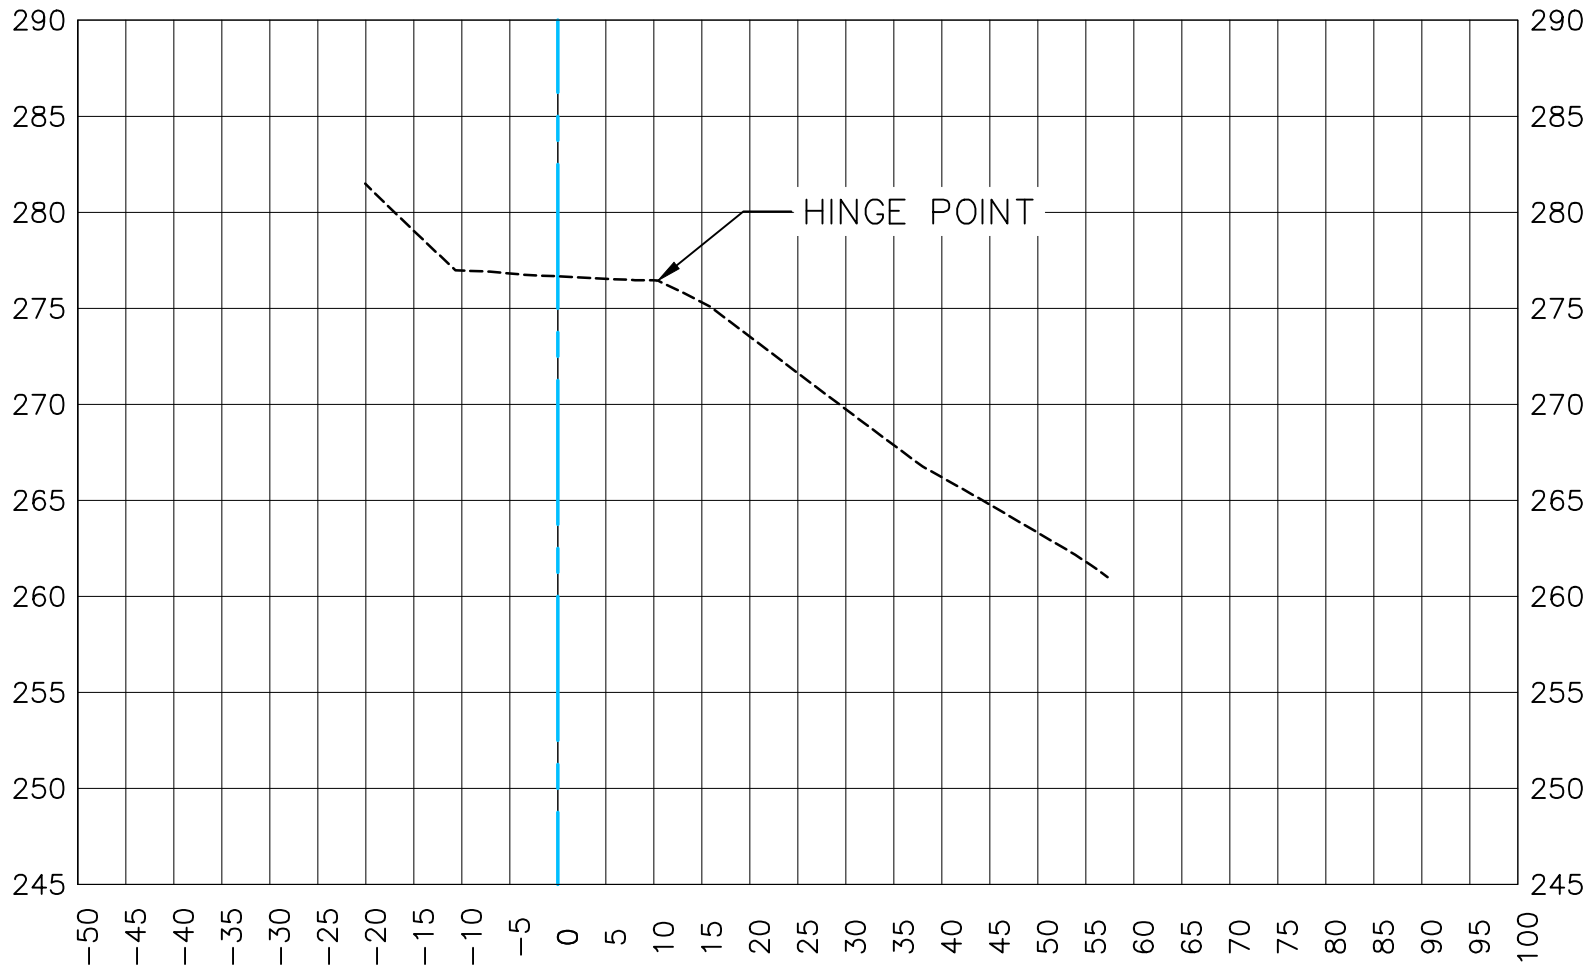

EXISTING CONDITION 2020

Station 18+00.00

Vert. Scale: 1"=5'



Hor. Scale: 1"=20'

DATE PREPARED: 03/23/2020

U.S. Survey
Foot

OC Public Works/Engineering Services
OC Survey/Field Services
Boundary Analysis & Mapping

GALIVAN PERIMETER ROAD CL

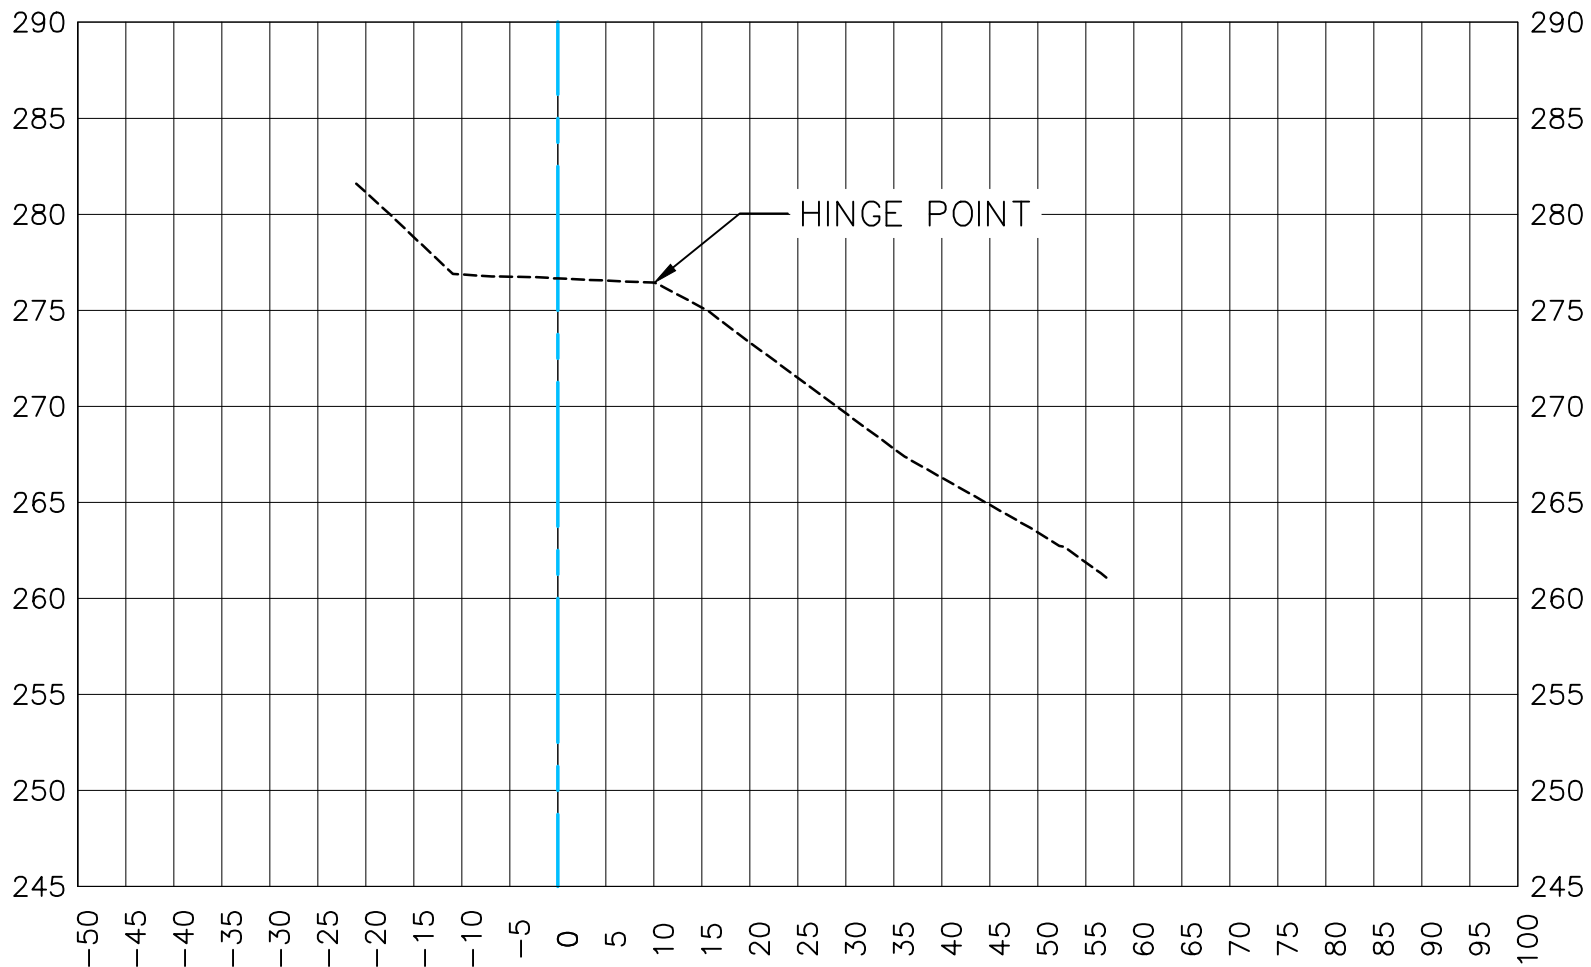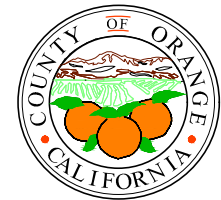

EXISTING CONDITION 2020

Station 18+25.00

Vert. Scale: 1"=5'



Hor. Scale: 1"=20'

DATE PREPARED: 03/23/2020

U.S. *Survey
Foot*

OC Public Works/Engineering Services
OC Survey/Field Services
Boundary Analysis & Mapping

GALIVAN PERIMETER ROAD CL

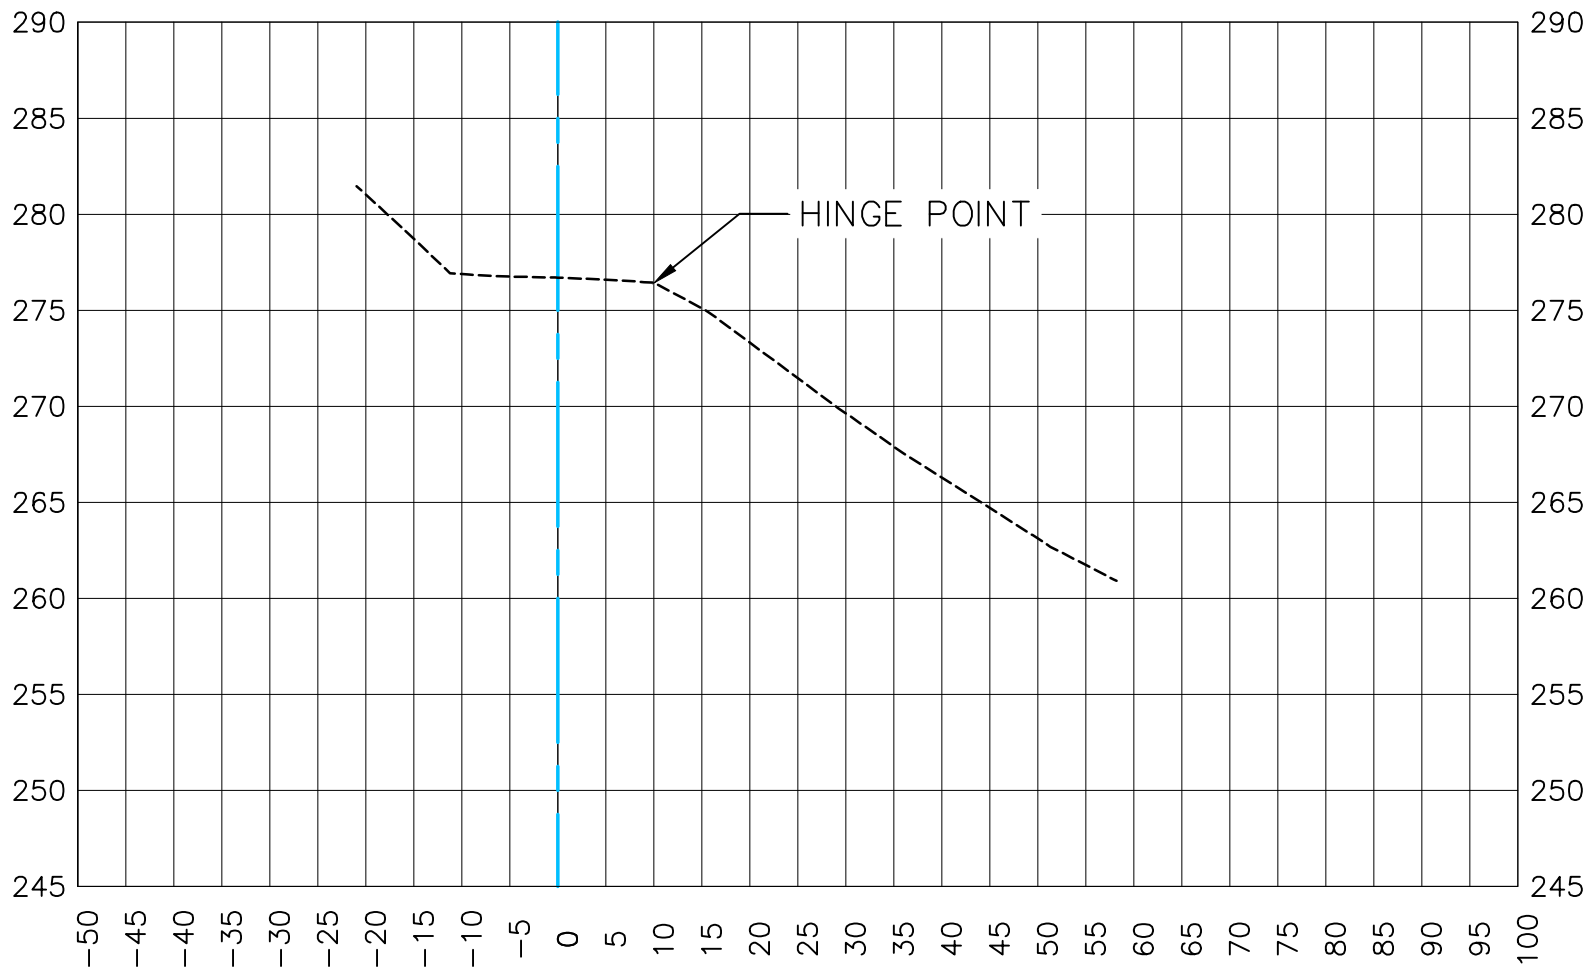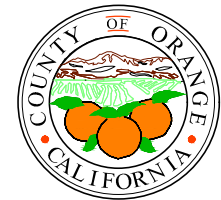

EXISTING CONDITION 2020

Station 18+50.00

Vert. Scale: 1"=5'


Hor. Scale: 1"=20'

DATE PREPARED: 03/23/2020

U.S. Survey Foot

OC Public Works/Engineering Services
OC Survey/Field Services
Boundary Analysis & Mapping

GALIVAN PERIMETER ROAD CL

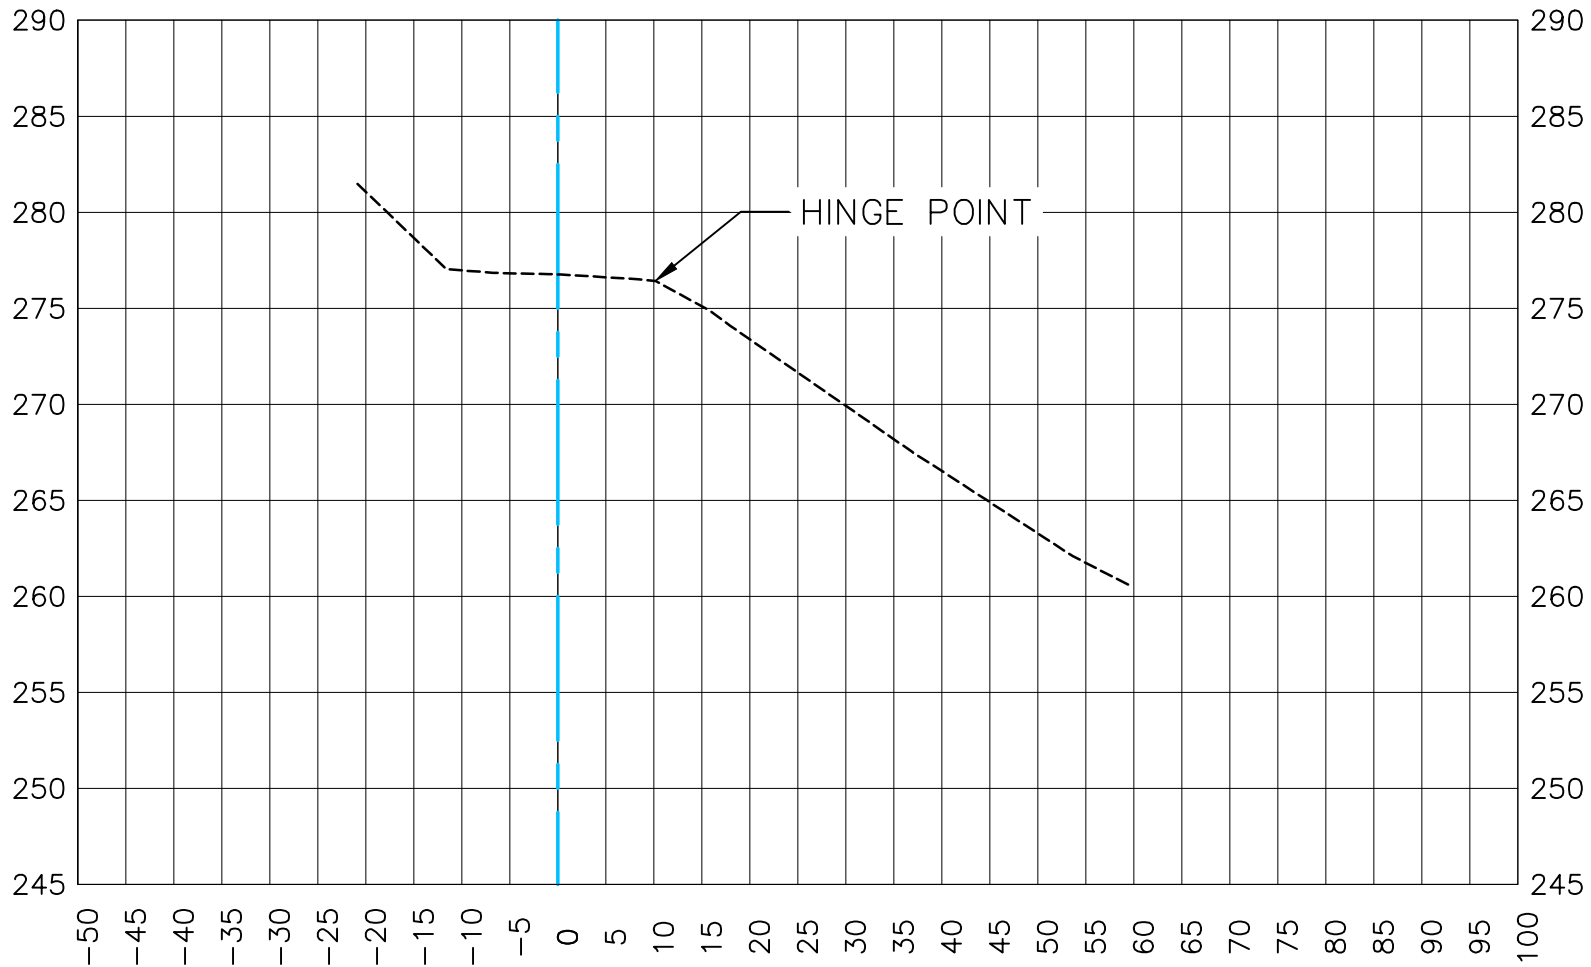


EXISTING CONDITION 2020


Station 18+75.00

Vert. Scale: 1"=5'
Hor. Scale: 1"=20'

DATE PREPARED: 03/23/2020

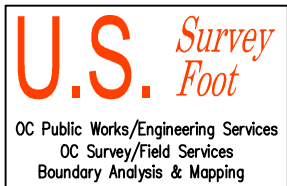

GALIVAN PERIMETER ROAD CL

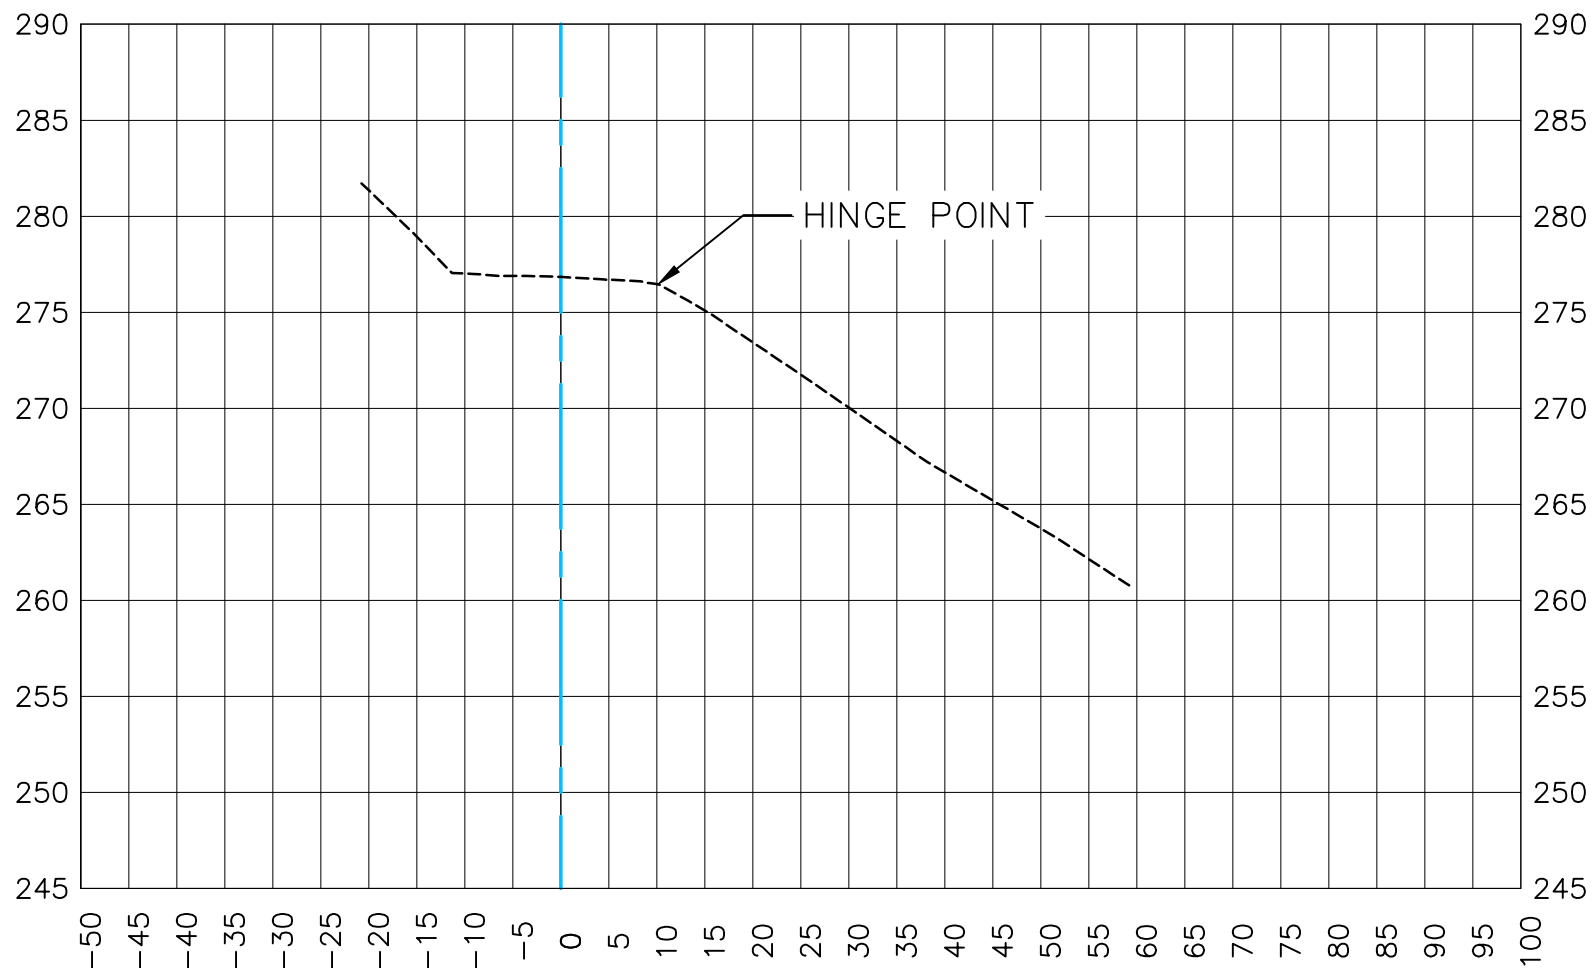


EXISTING CONDITION 2020

Station 19+00.00


Vert. Scale: 1"=5'

Hor. Scale: 1"=20'

DATE PREPARED: 03/23/2020

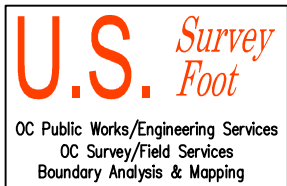

GALIVAN PERIMETER ROAD CL

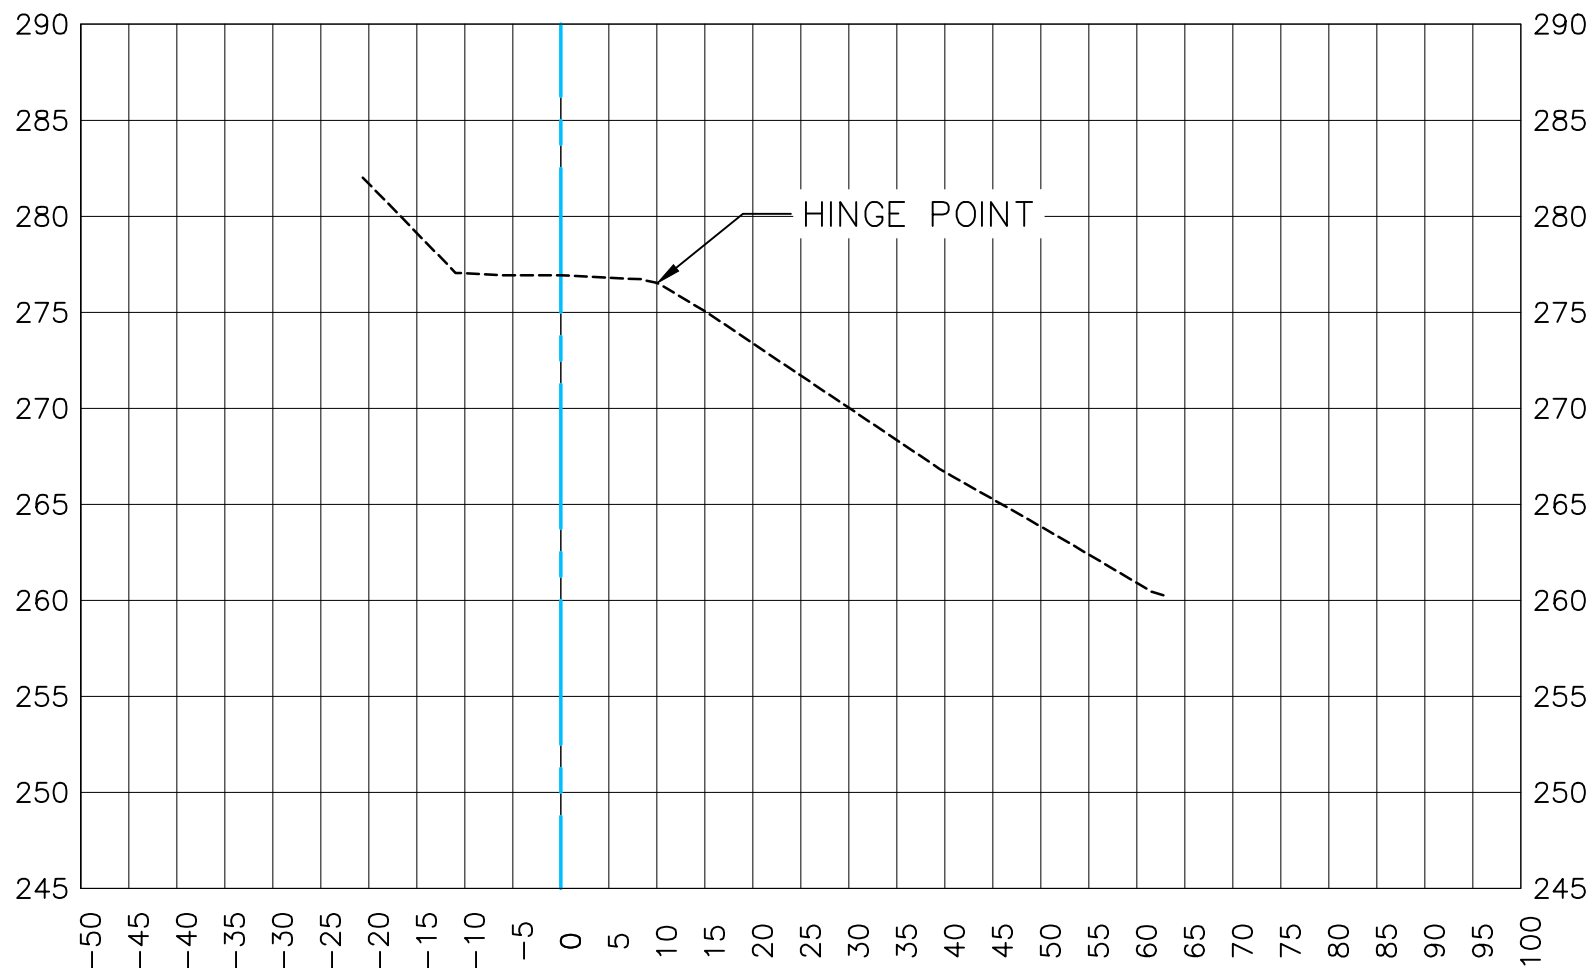

EXISTING CONDITION 2020

Station 19+25.00

Vert. Scale: 1"=5'


Hor. Scale: 1"=20'

DATE PREPARED: 03/23/2020

U.S. Survey Foot

OC Public Works/Engineering Services
OC Survey/Field Services
Boundary Analysis & Mapping

GALIVAN PERIMETER ROAD CL

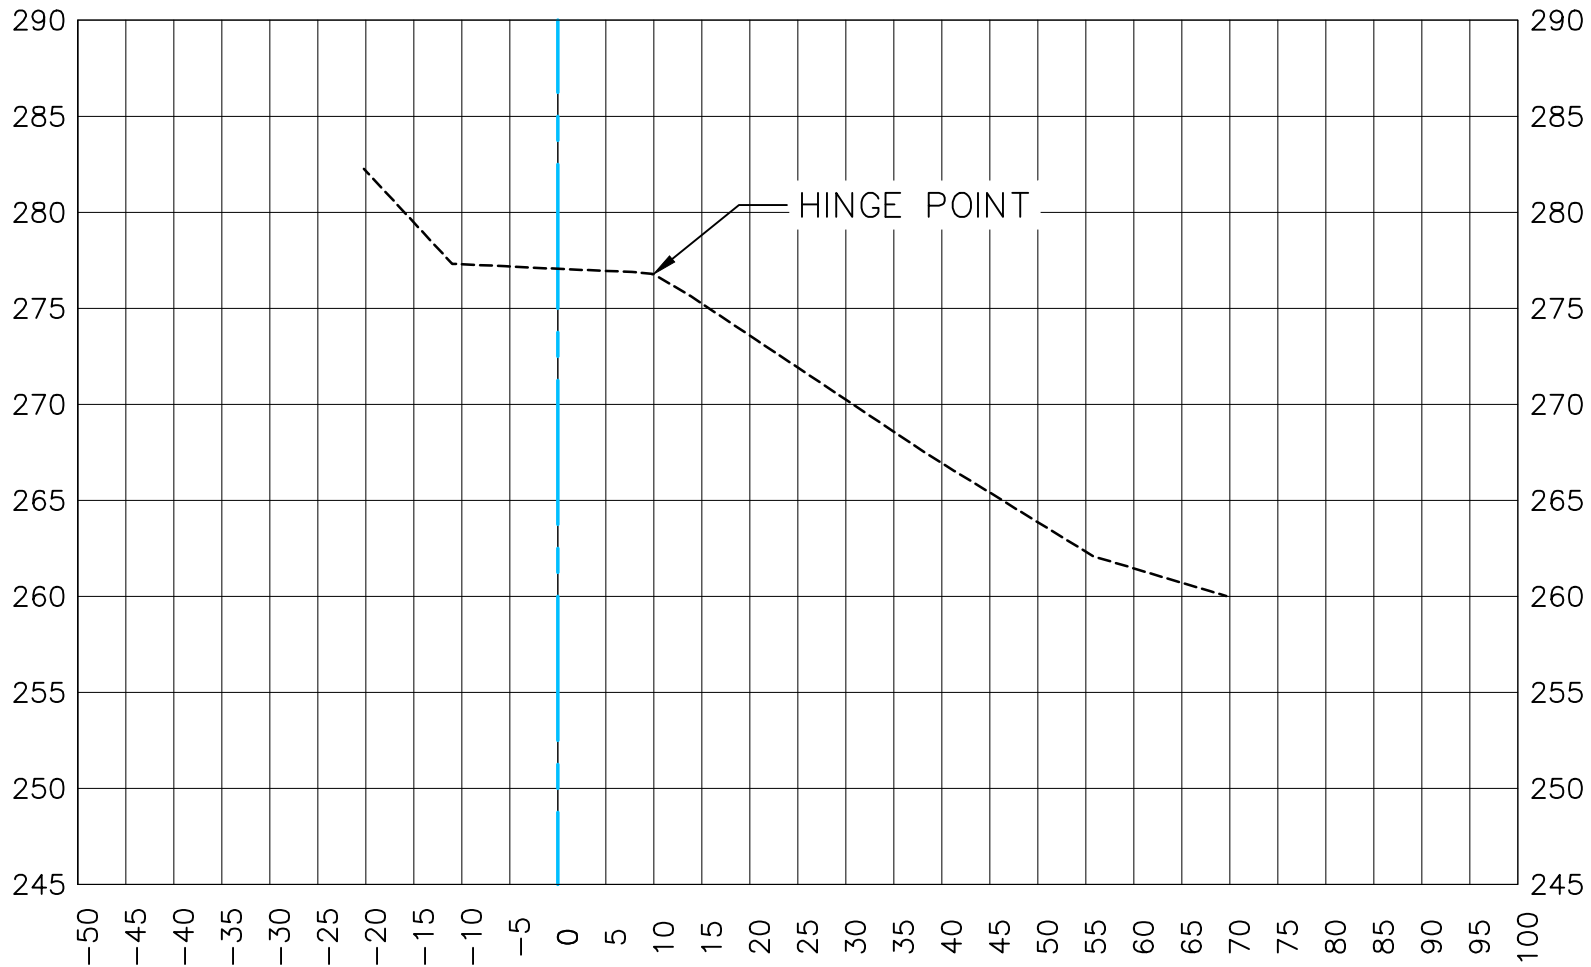


EXISTING CONDITION 2020


Station 19+50.00

Vert. Scale: 1"=5'
Hor. Scale: 1"=20'

DATE PREPARED: 03/23/2020

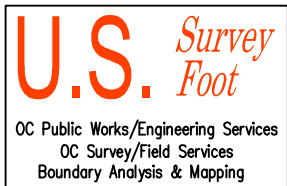

GALIVAN PERIMETER ROAD CL

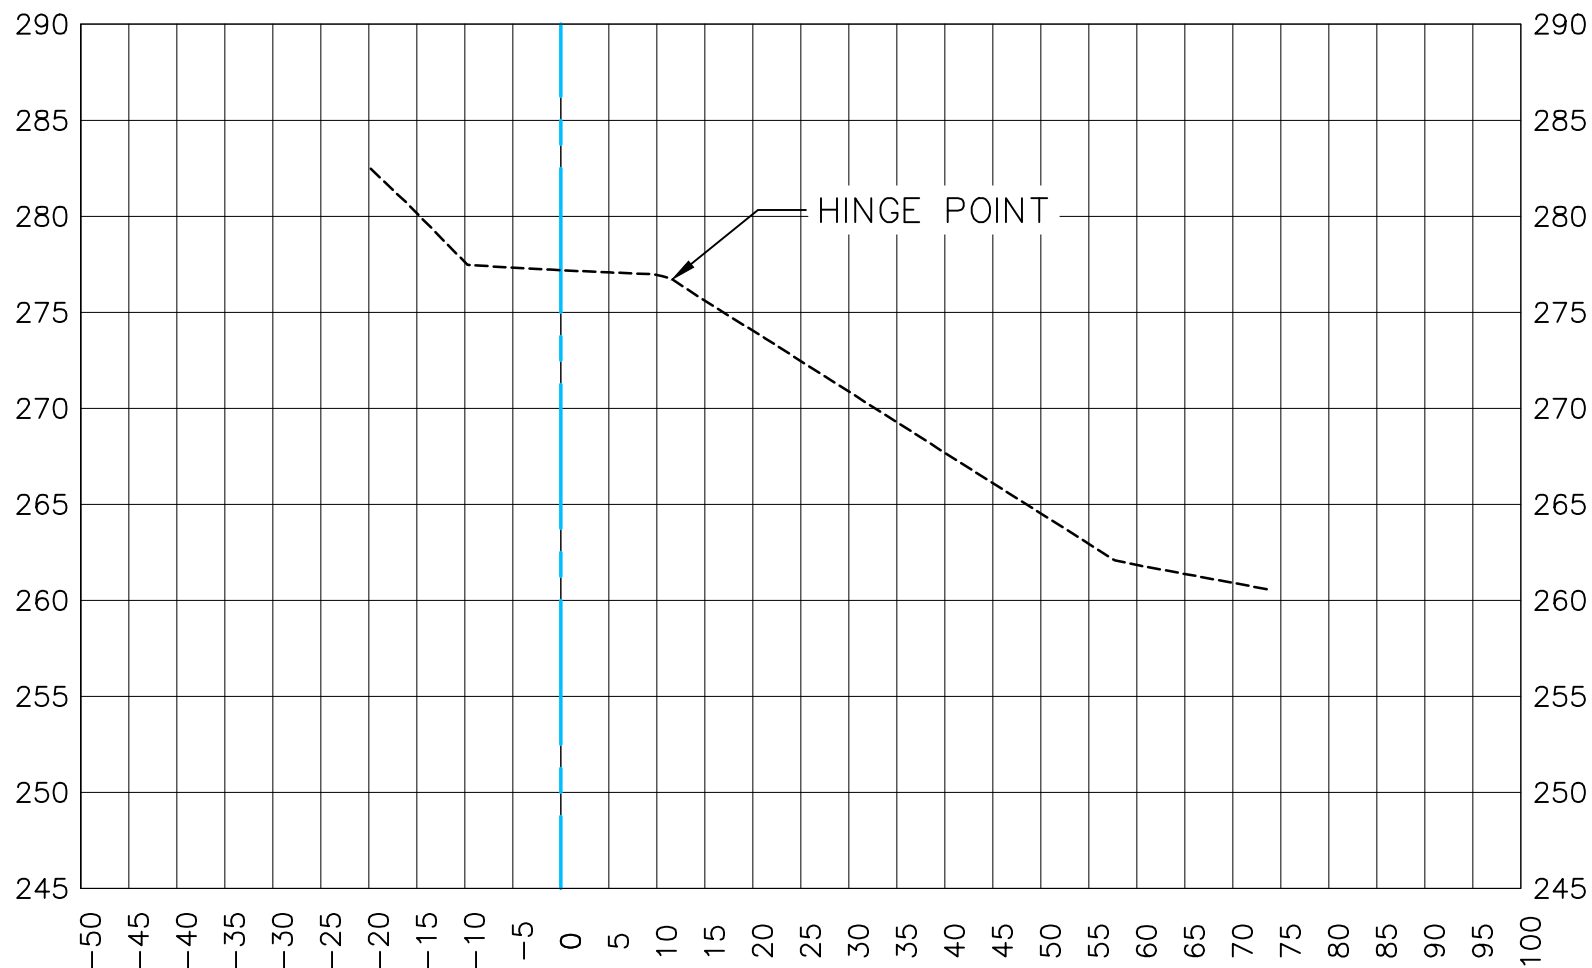

EXISTING CONDITION 2020

Station 19+75.00

Vert. Scale: 1"=5'


Hor. Scale: 1"=20'

DATE PREPARED: 03/23/2020

U.S. Survey Foot

OC Public Works/Engineering Services
OC Survey/Field Services
Boundary Analysis & Mapping

GALIVAN PERIMETER ROAD CL

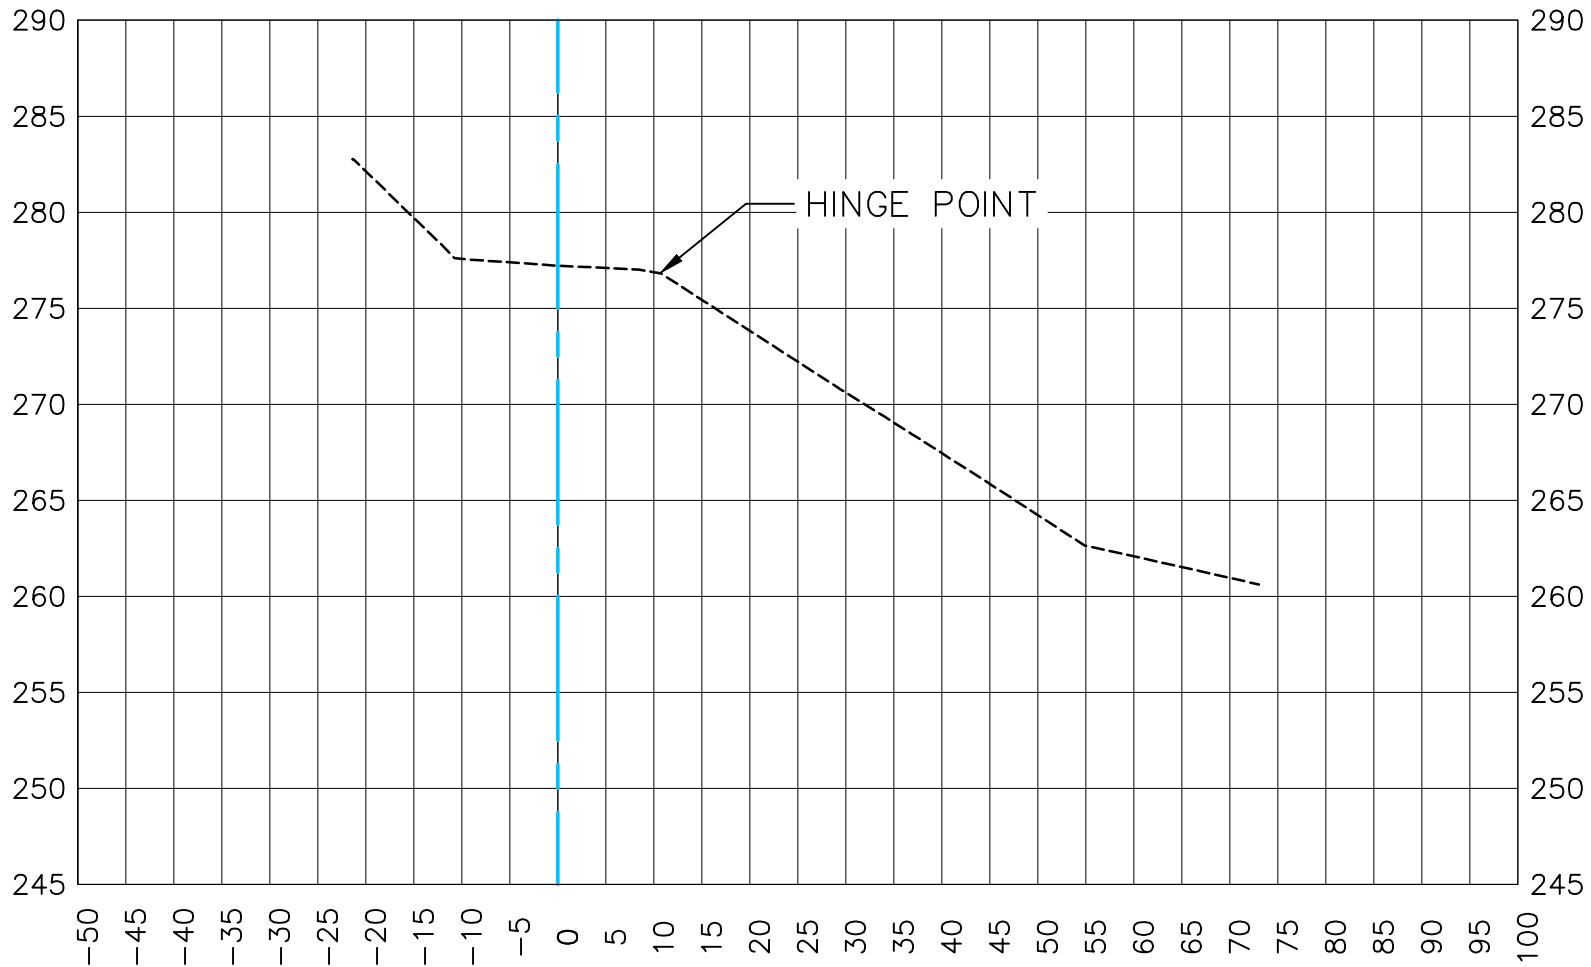


EXISTING CONDITION 2020



Station 20+00.00

Vert. Scale: 1"=5'
Hor. Scale: 1"=20'

DATE PREPARED: 03/23/2020

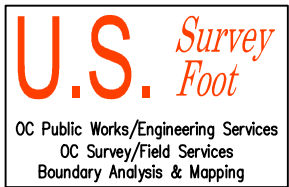

GALIVAN PERIMETER ROAD CL

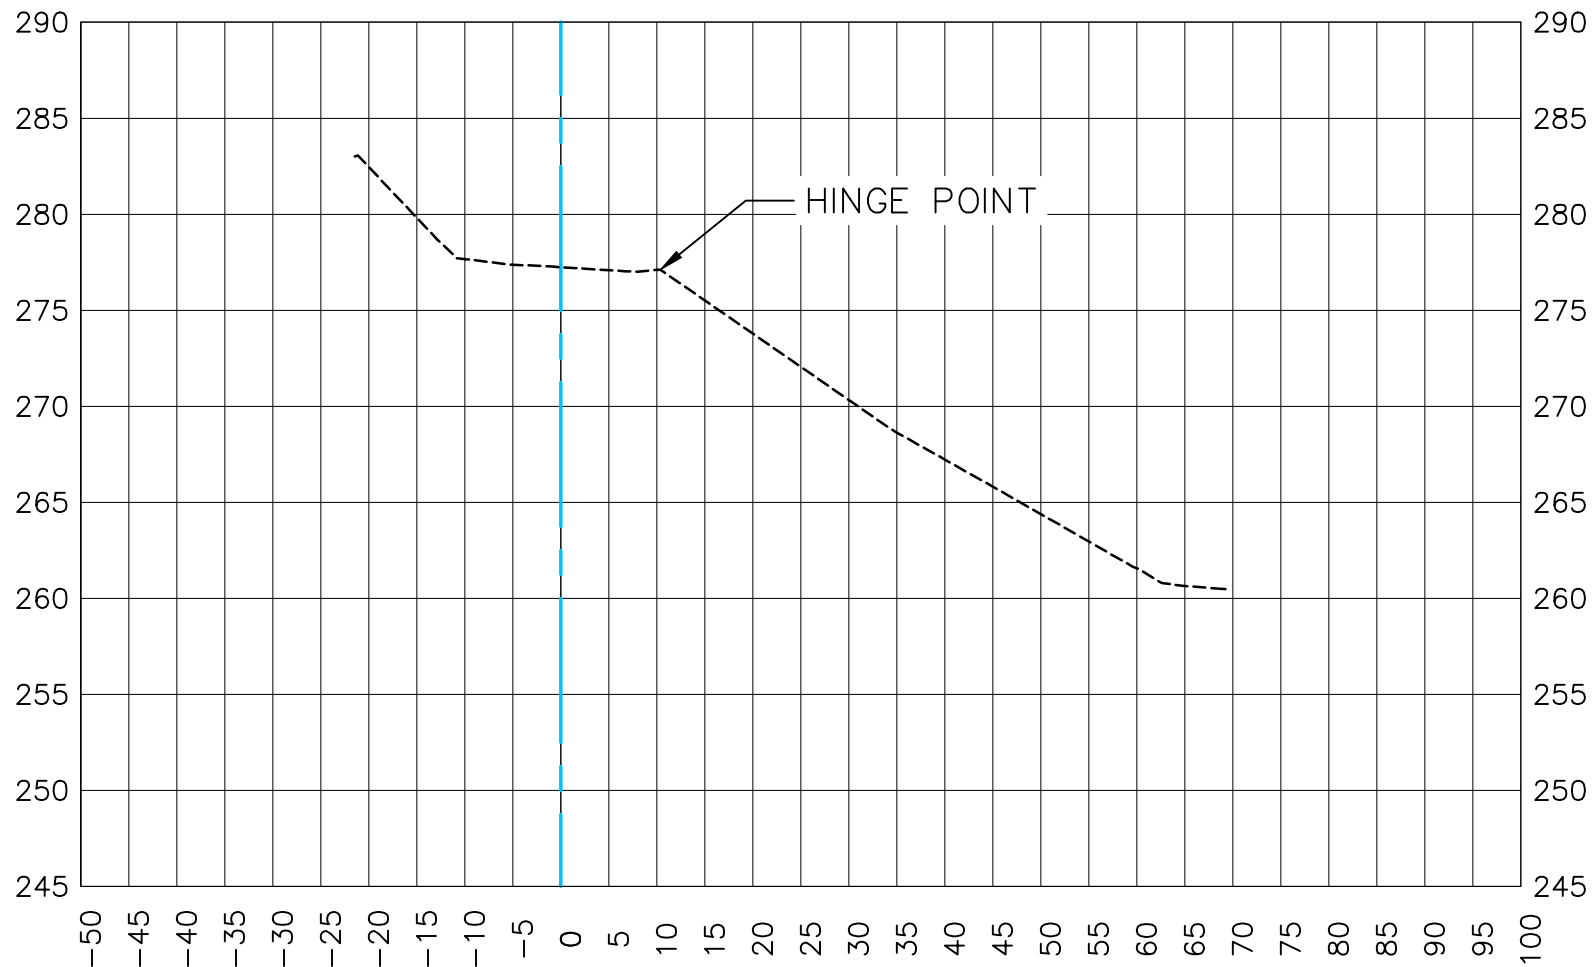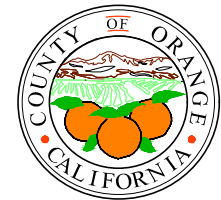

EXISTING CONDITION 2020

Station 20+25.00

Vert. Scale: 1"=5'


Hor. Scale: 1"=20'

DATE PREPARED: 03/23/2020

U.S. Survey Foot

OC Public Works/Engineering Services
OC Survey/Field Services
Boundary Analysis & Mapping

GALIVAN PERIMETER ROAD CL

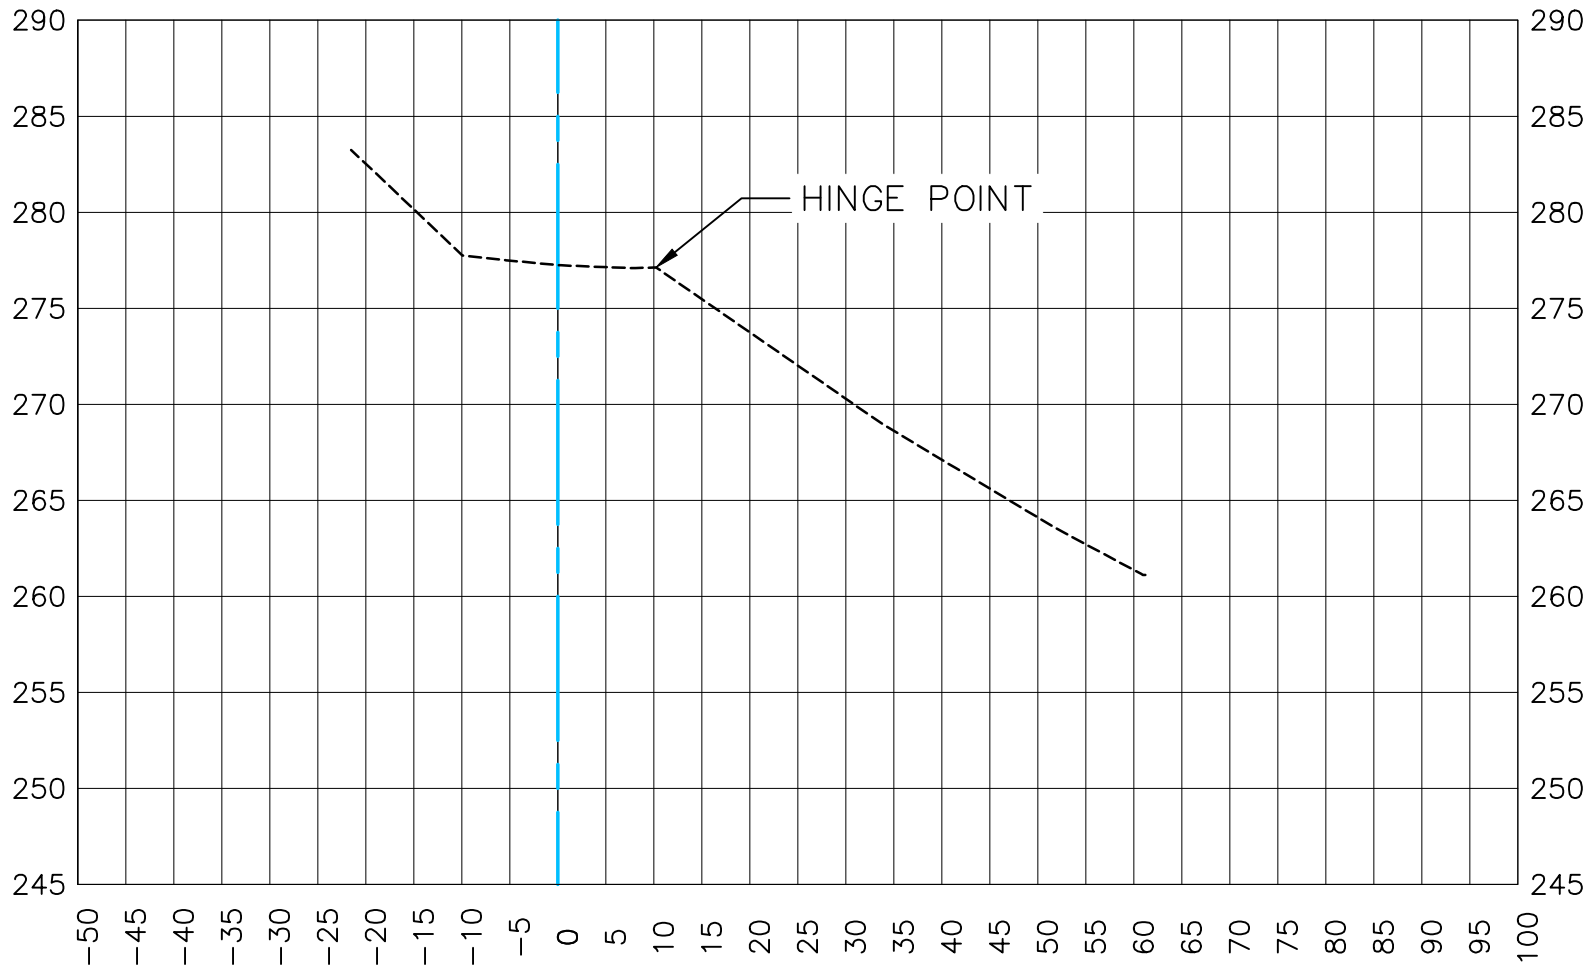

EXISTING CONDITION 2020

Station 20+50.00


Vert. Scale: 1"=5'

Hor. Scale: 1"=20'

DATE PREPARED: 03/23/2020



GALIVAN
PERIMETER ROAD
CL

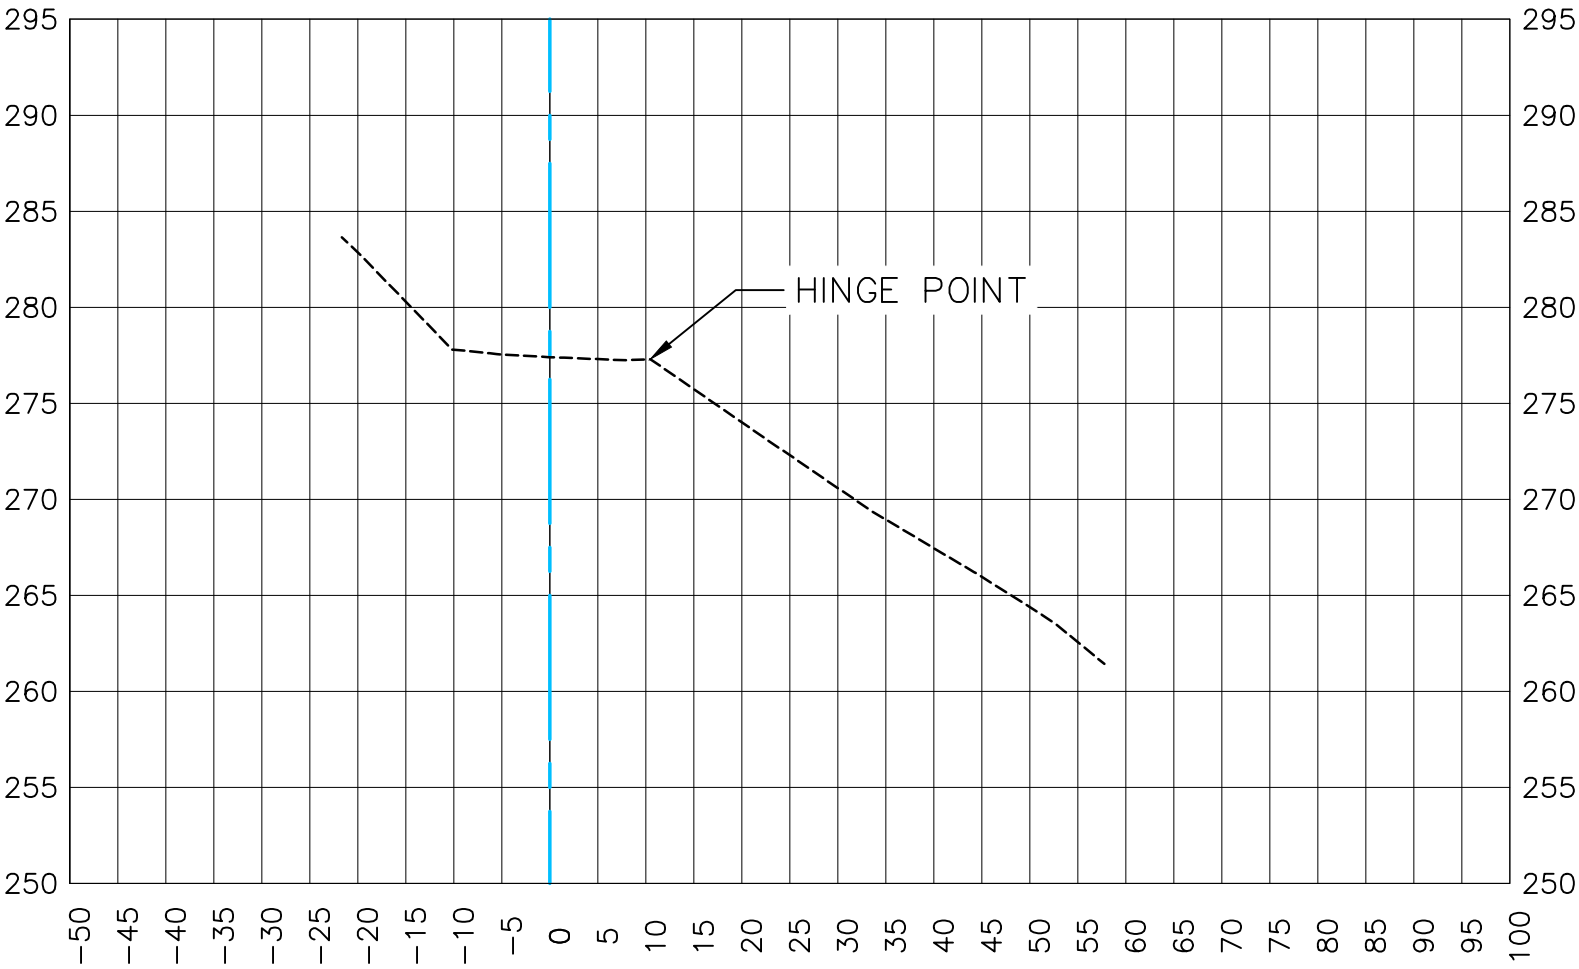

EXISTING CONDITION 2020

----- Station 20+75.00


Vert. Scale: 1"=5'
Hor. Scale: 1"=20'

DATE PREPARED: 03/23/2020

U.S. Survey
Foot

OC Public Works/Engineering Services
OC Survey/Field Services
Boundary Analysis & Mapping

GALIVAN PERIMETER ROAD CL

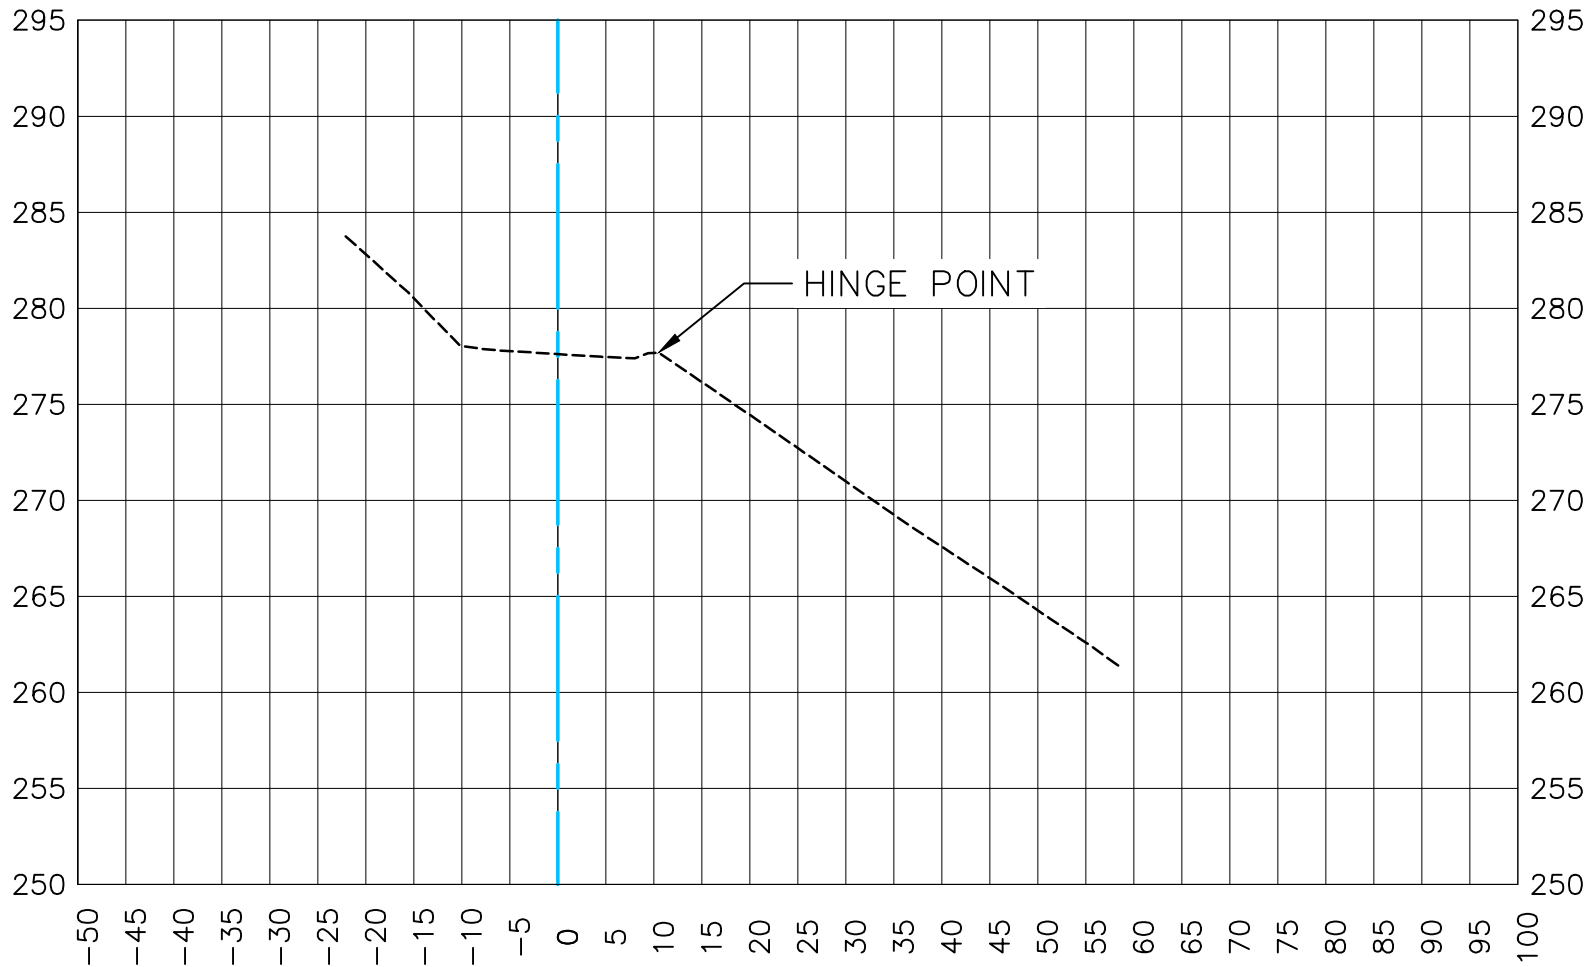


EXISTING CONDITION 2020



Station 21+00.00

Vert. Scale: 1"=5'
Hor. Scale: 1"=20'

DATE PREPARED: 03/23/2020

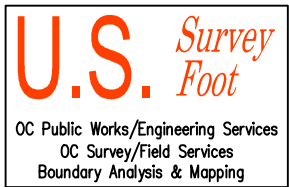

GALIVAN PERIMETER ROAD CL

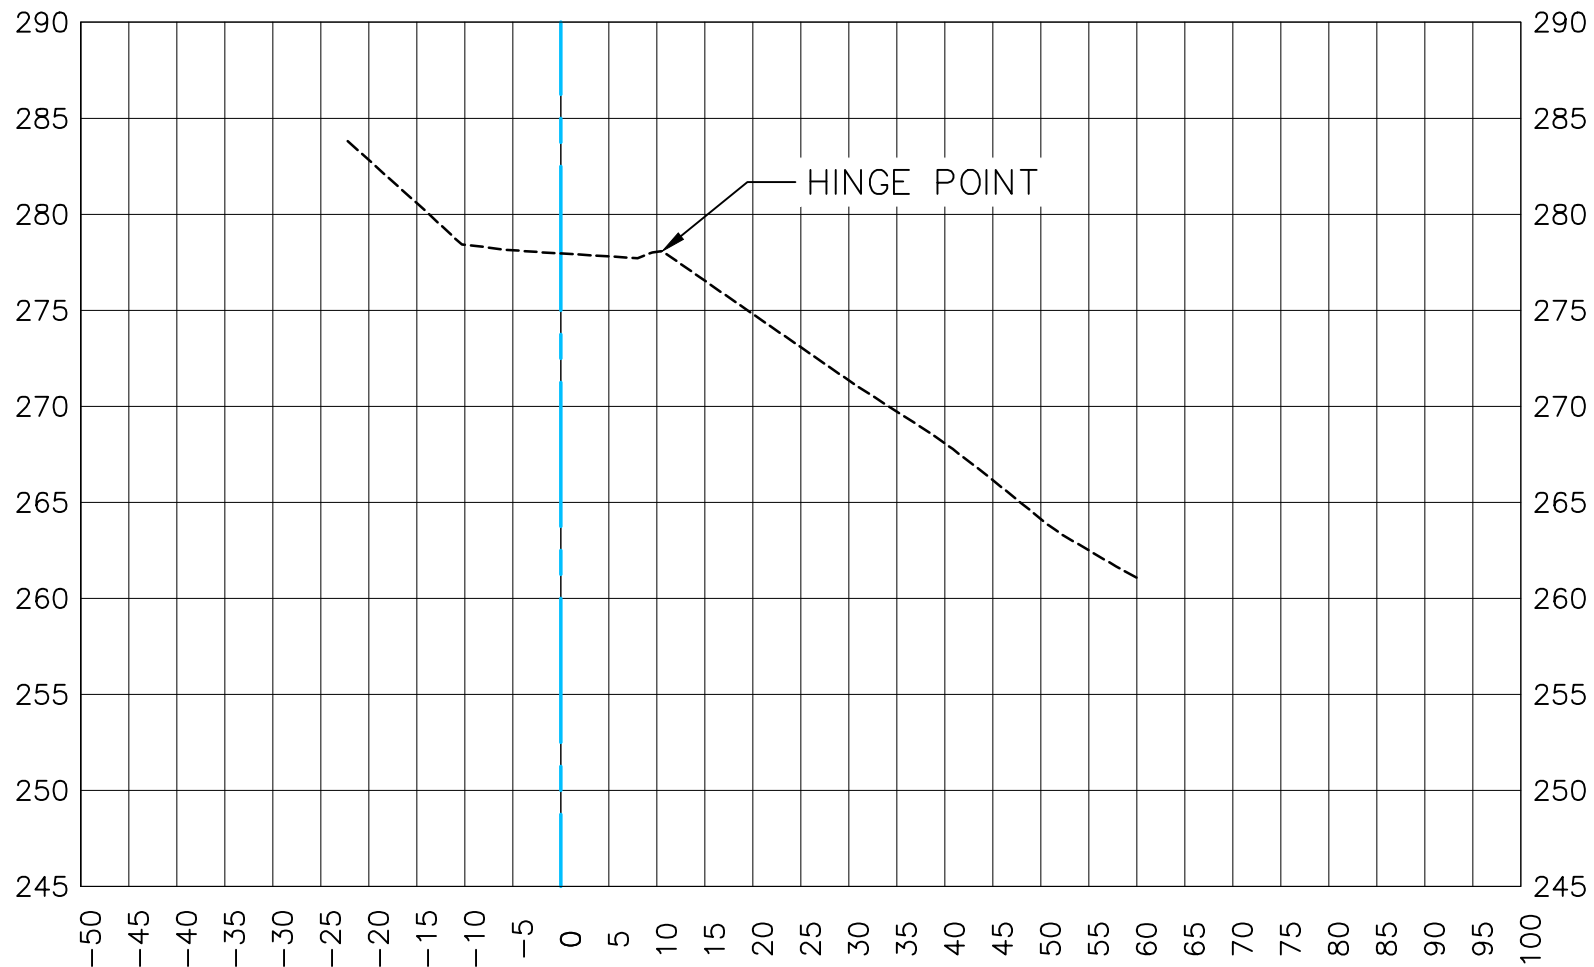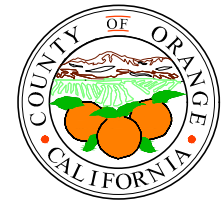

EXISTING CONDITION 2020

Station 21+25.00

Vert. Scale: 1"=5'



Hor. Scale: 1"=20'

DATE PREPARED: 03/23/2020

U.S. *Survey
Foot*

OC Public Works/Engineering Services
OC Survey/Field Services
Boundary Analysis & Mapping

GALIVAN PERIMETER ROAD CL

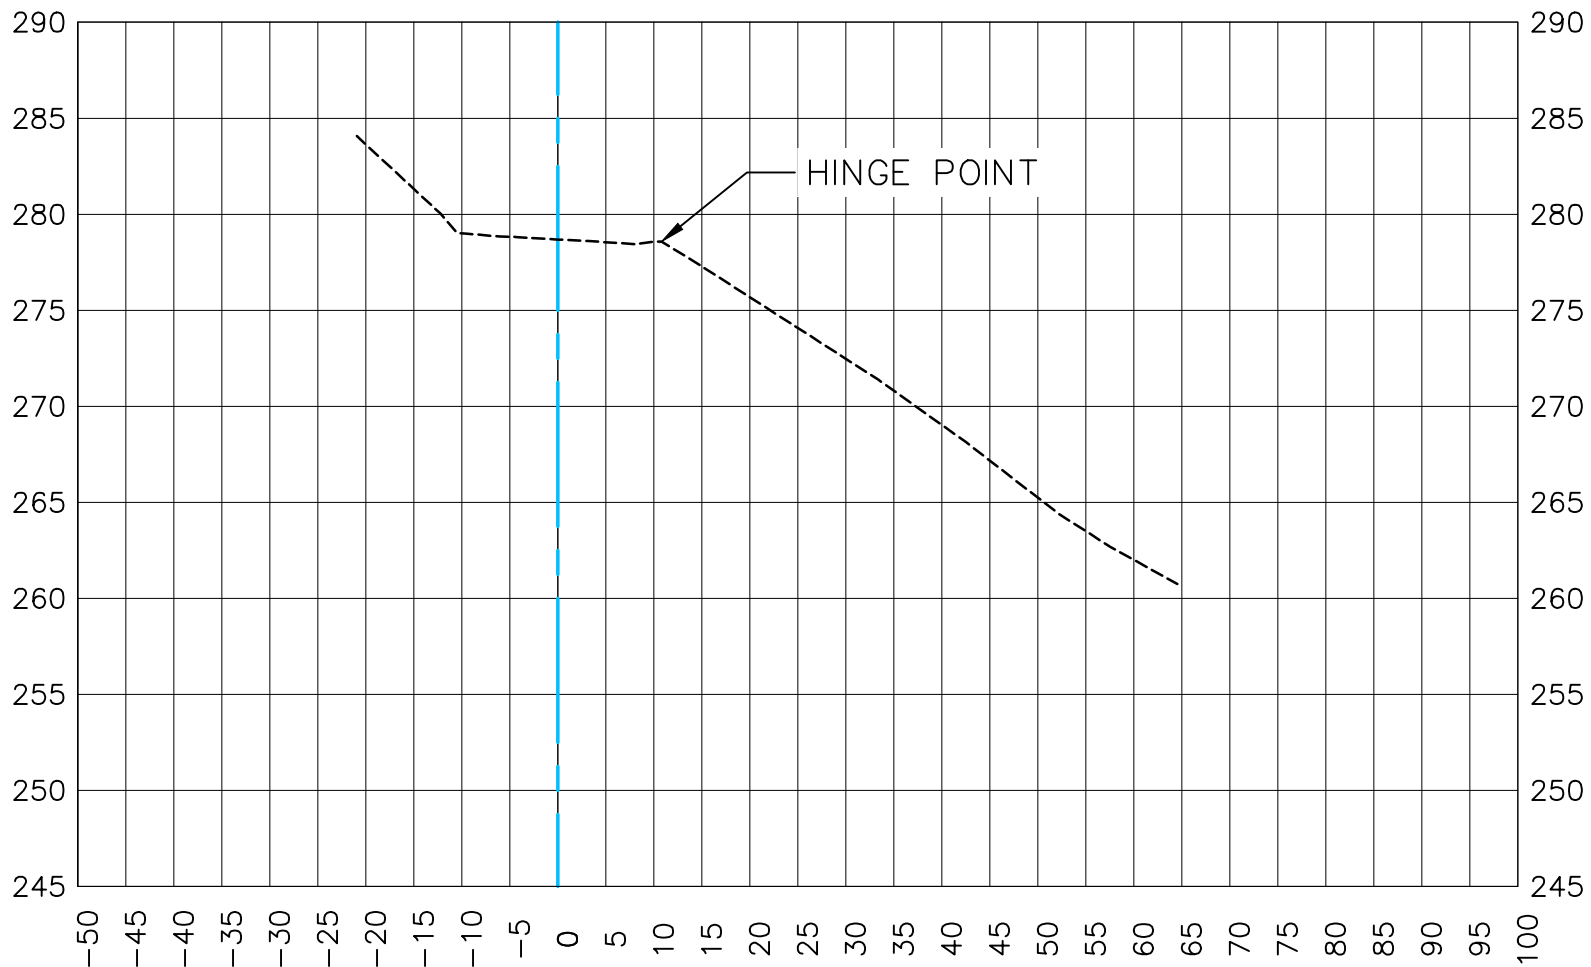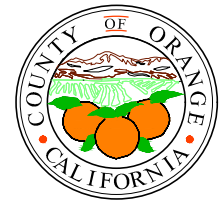


EXISTING CONDITION 2020

Station 21+50.00



Vert. Scale: 1"=5'

Hor. Scale: 1"=20'

DATE PREPARED: 03/23/2020

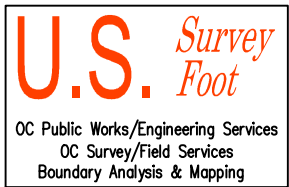

GALIVAN PERIMETER ROAD CL

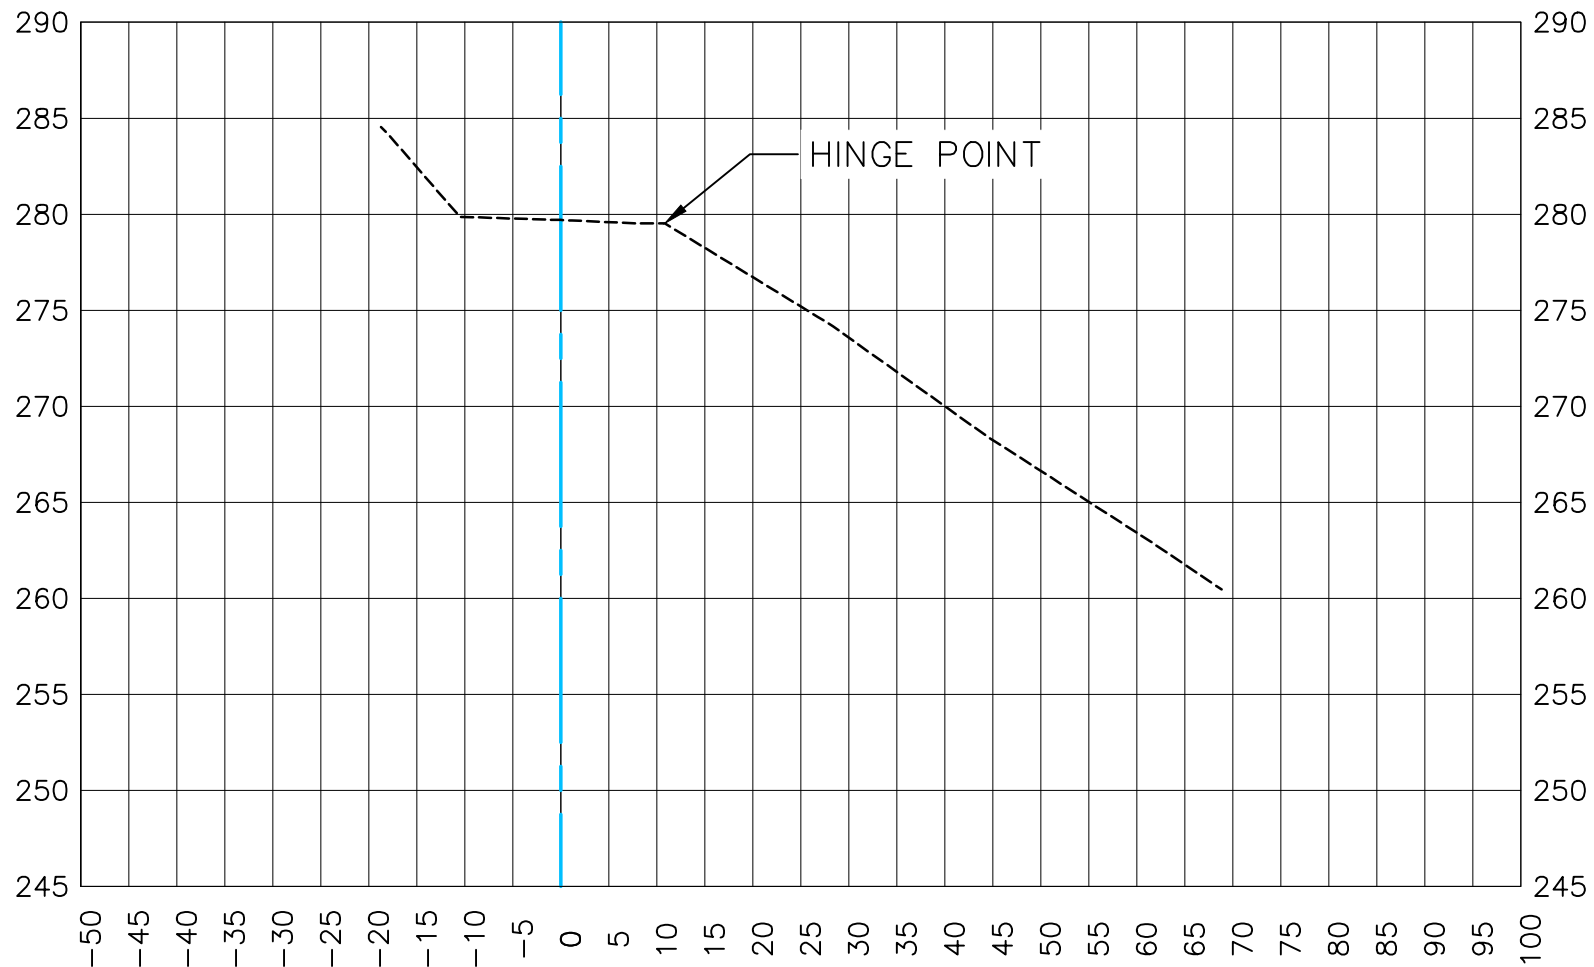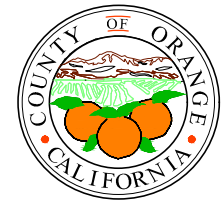

EXISTING CONDITION 2020

Station 21+75.00


Vert. Scale: 1"=5'

Hor. Scale: 1"=20'


DATE PREPARED: 03/23/2020

**U.S. Survey
Foot**

OC Public Works/Engineering Services
OC Survey/Field Services
Boundary Analysis & Mapping

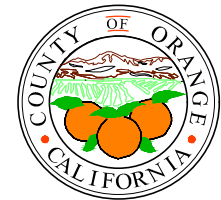

GALIVAN PERIMETER ROAD CL

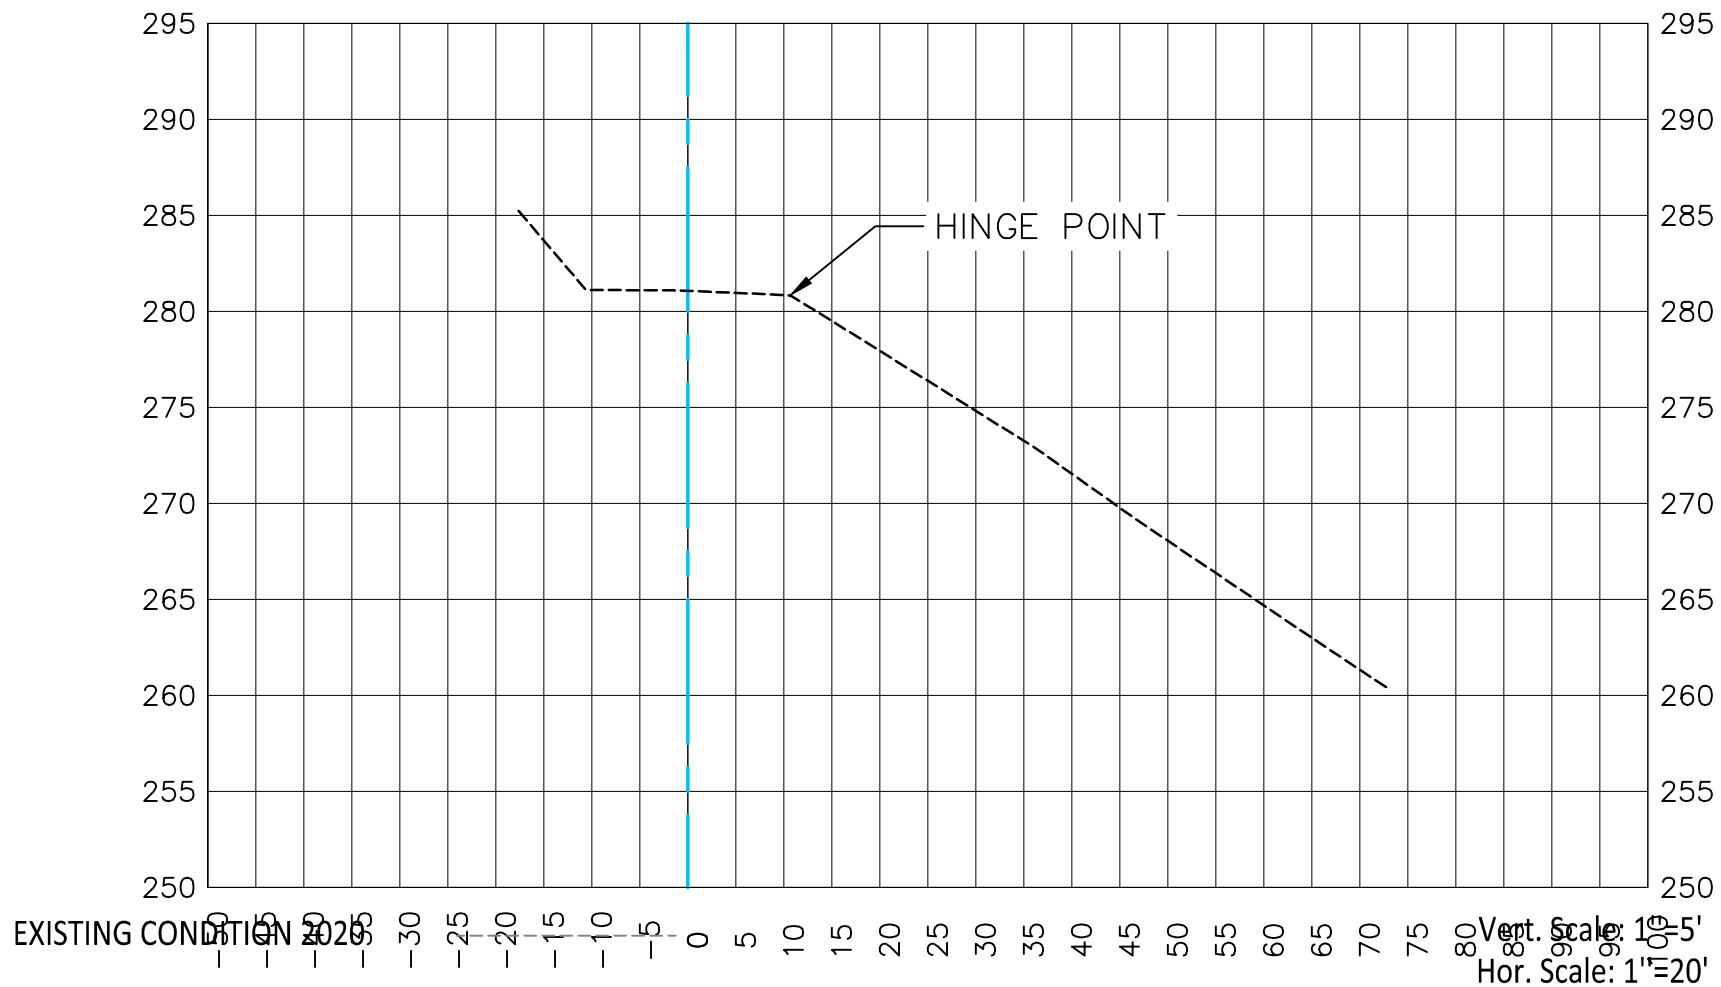


DATE PREPARED: 03/23/2020

U.S. Survey Foot

OC Public Works/Engineering Services
OC Survey/Field Services
Boundary Analysis & Mapping

GALIVAN PERIMETER ROAD CL

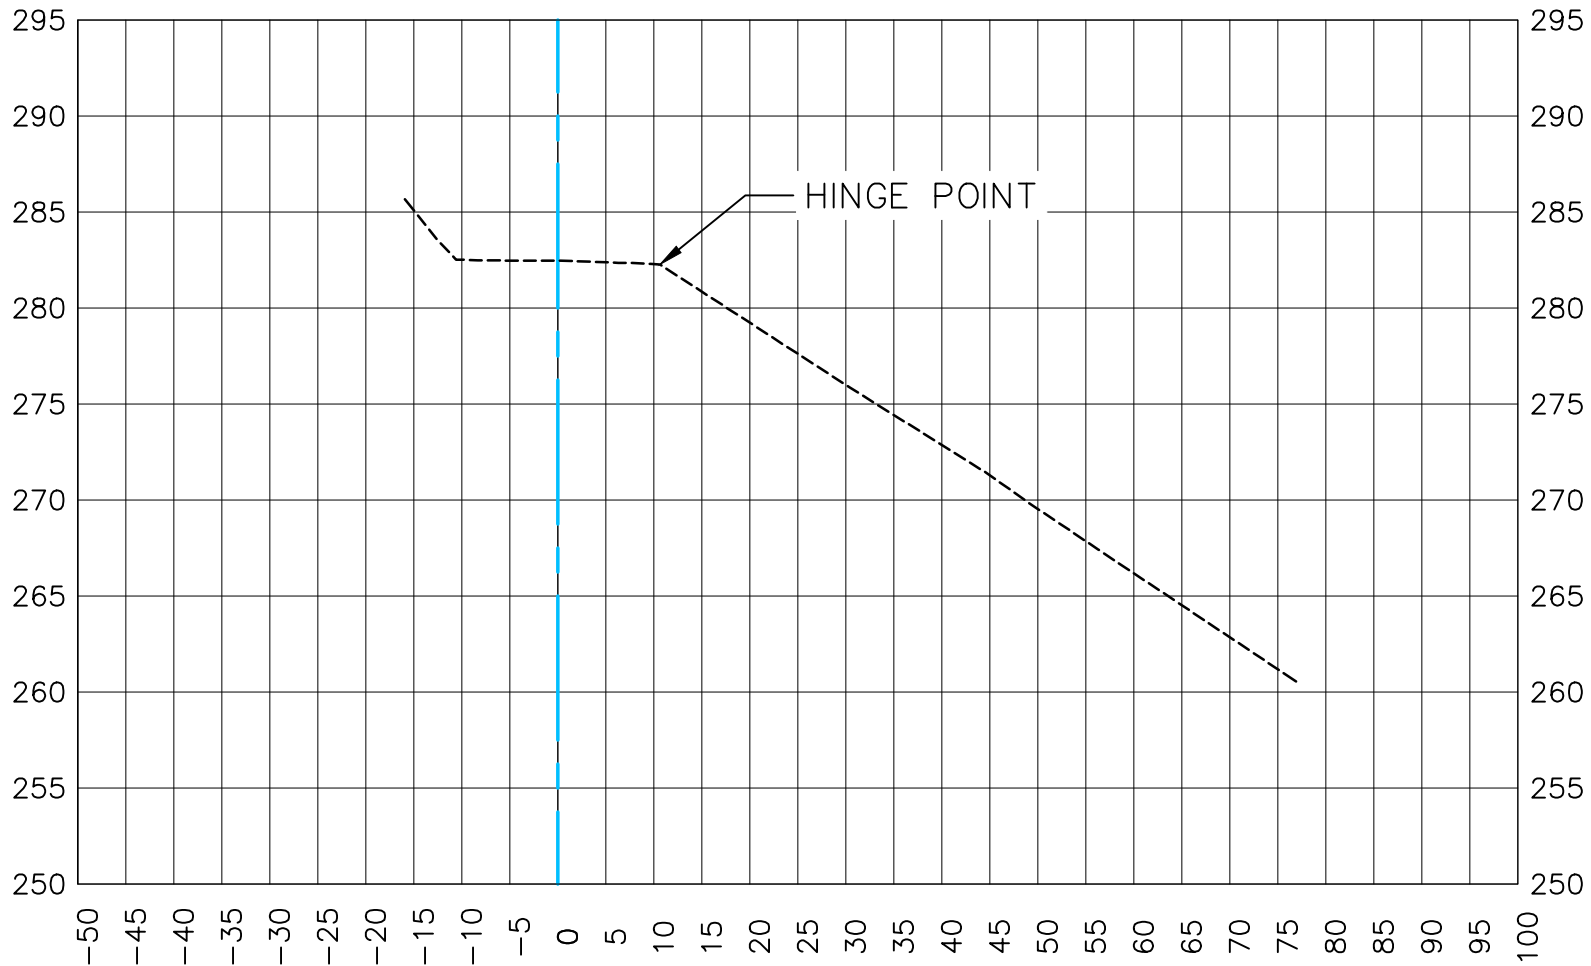

EXISTING CONDITION 2020

Station 22+25.00



Vert. Scale: 1"=5'
Hor. Scale: 1"=20'

DATE PREPARED: 03/23/2020

U.S. Survey Foot

OC Public Works/Engineering Services
OC Survey/Field Services
Boundary Analysis & Mapping

GALIVAN PERIMETER ROAD CL

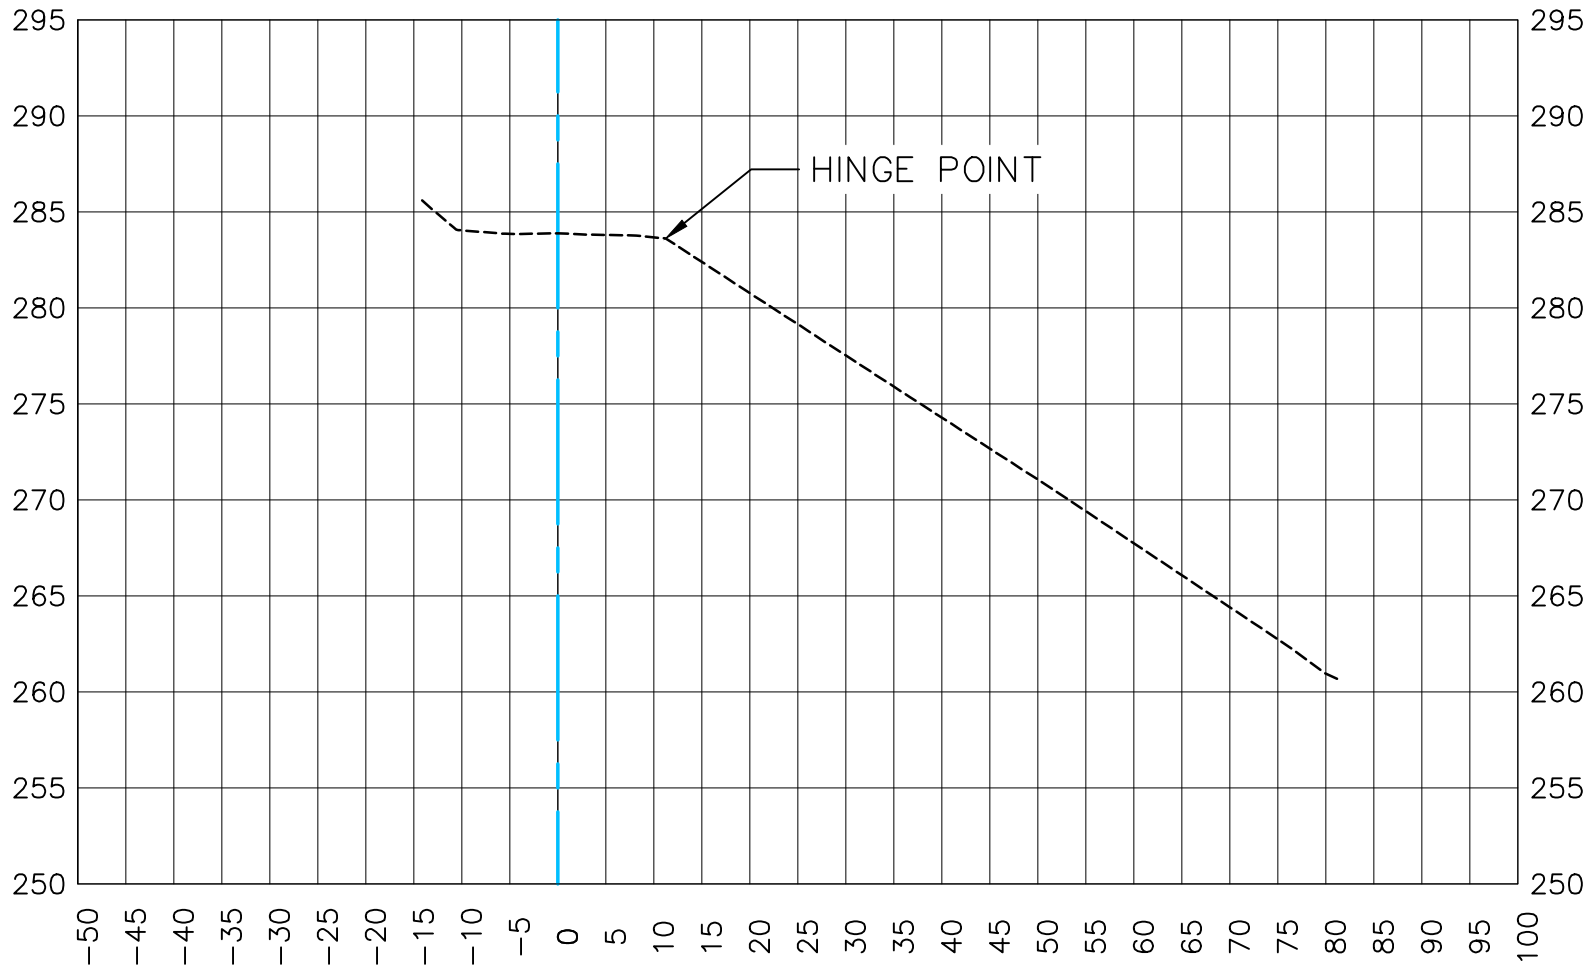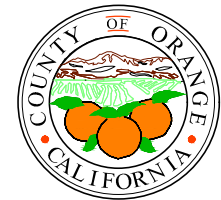

EXISTING CONDITION 2020

Station 22+50.00



Vert. Scale: 1"=5'
Hor. Scale: 1"=20'

DATE PREPARED: 03/23/2020

**U.S. Survey
Foot**

OC Public Works/Engineering Services
OC Survey/Field Services
Boundary Analysis & Mapping

GALIVAN PERIMETER ROAD CL

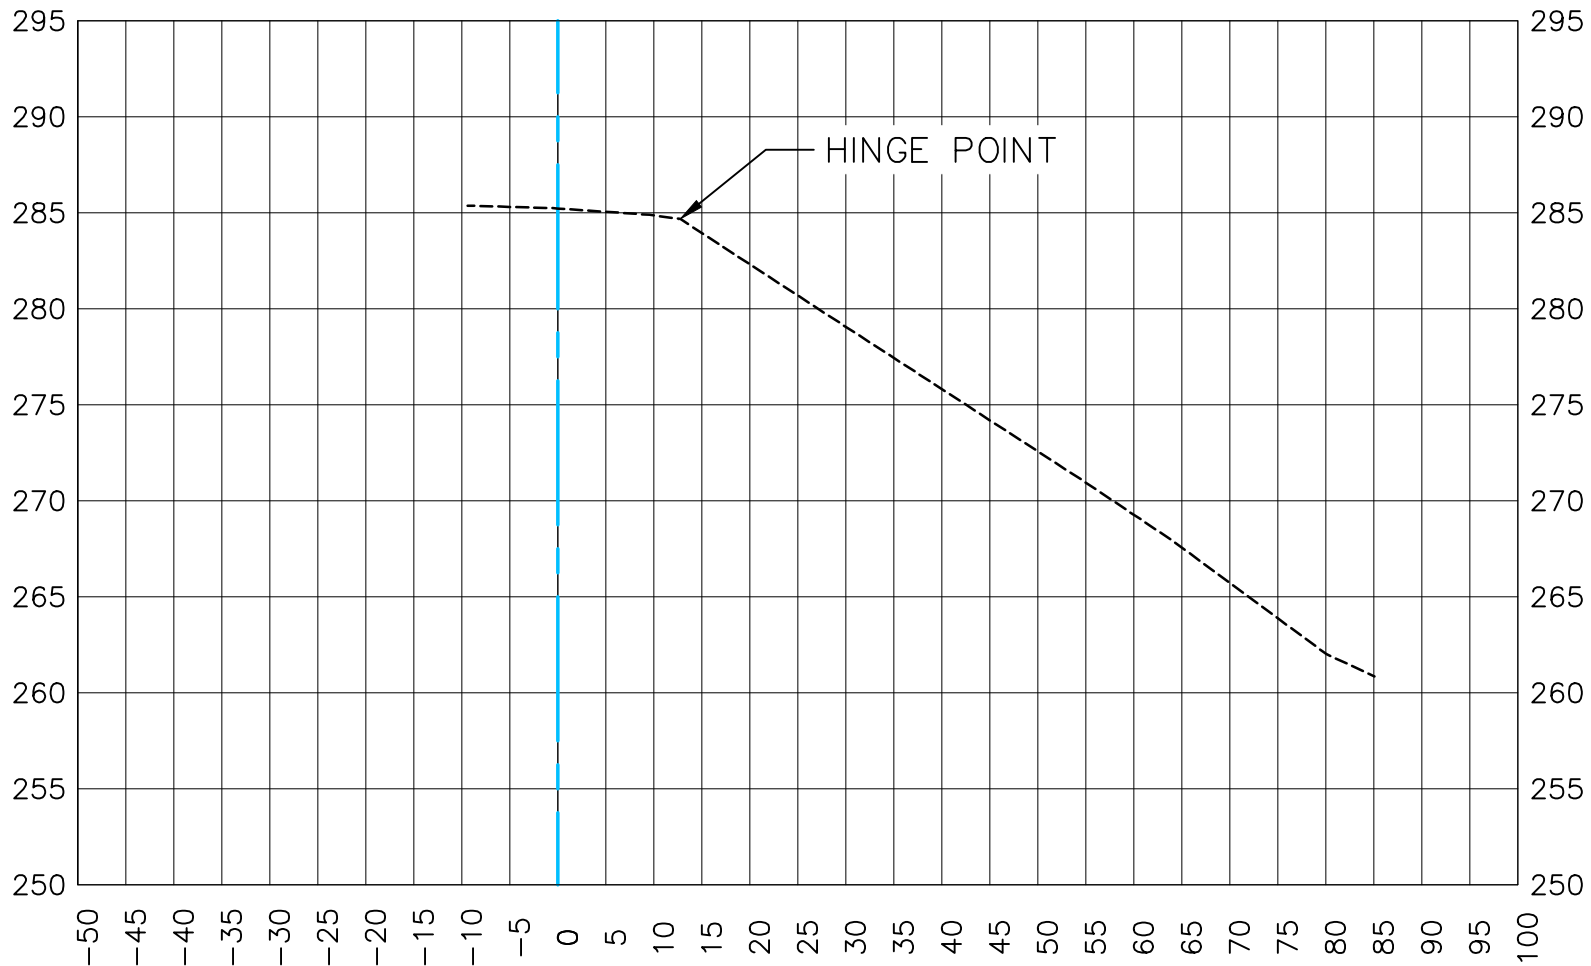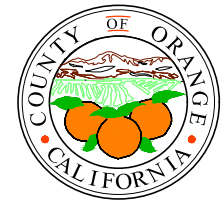

EXISTING CONDITION 2020

Station 22+75.00


Vert. Scale: 1"=5'
Hor. Scale: 1"=20'

DATE PREPARED: 03/23/2020

U.S. Survey Foot

OC Public Works/Engineering Services
OC Survey/Field Services
Boundary Analysis & Mapping

GALIVAN PERIMETER ROAD CL

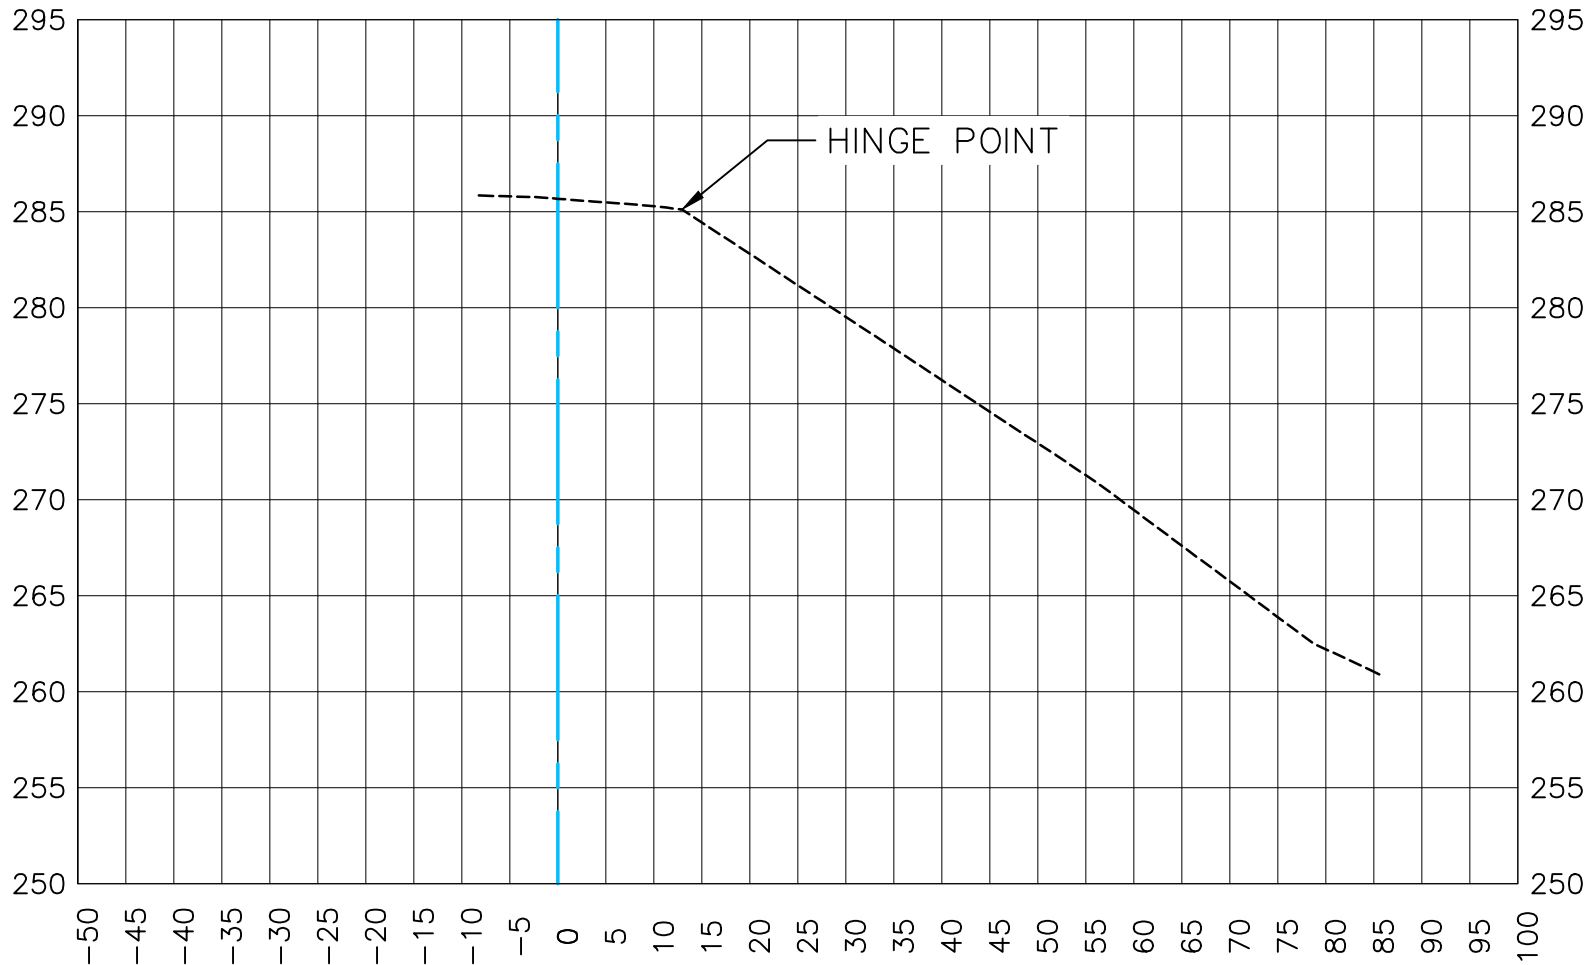


EXISTING CONDITION 2020


Station 23+00.00

Vert. Scale: 1"=5'
Hor. Scale: 1"=20'

DATE PREPARED: 03/23/2020

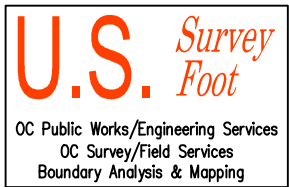

GALIVAN
PERIMETER ROAD
CL

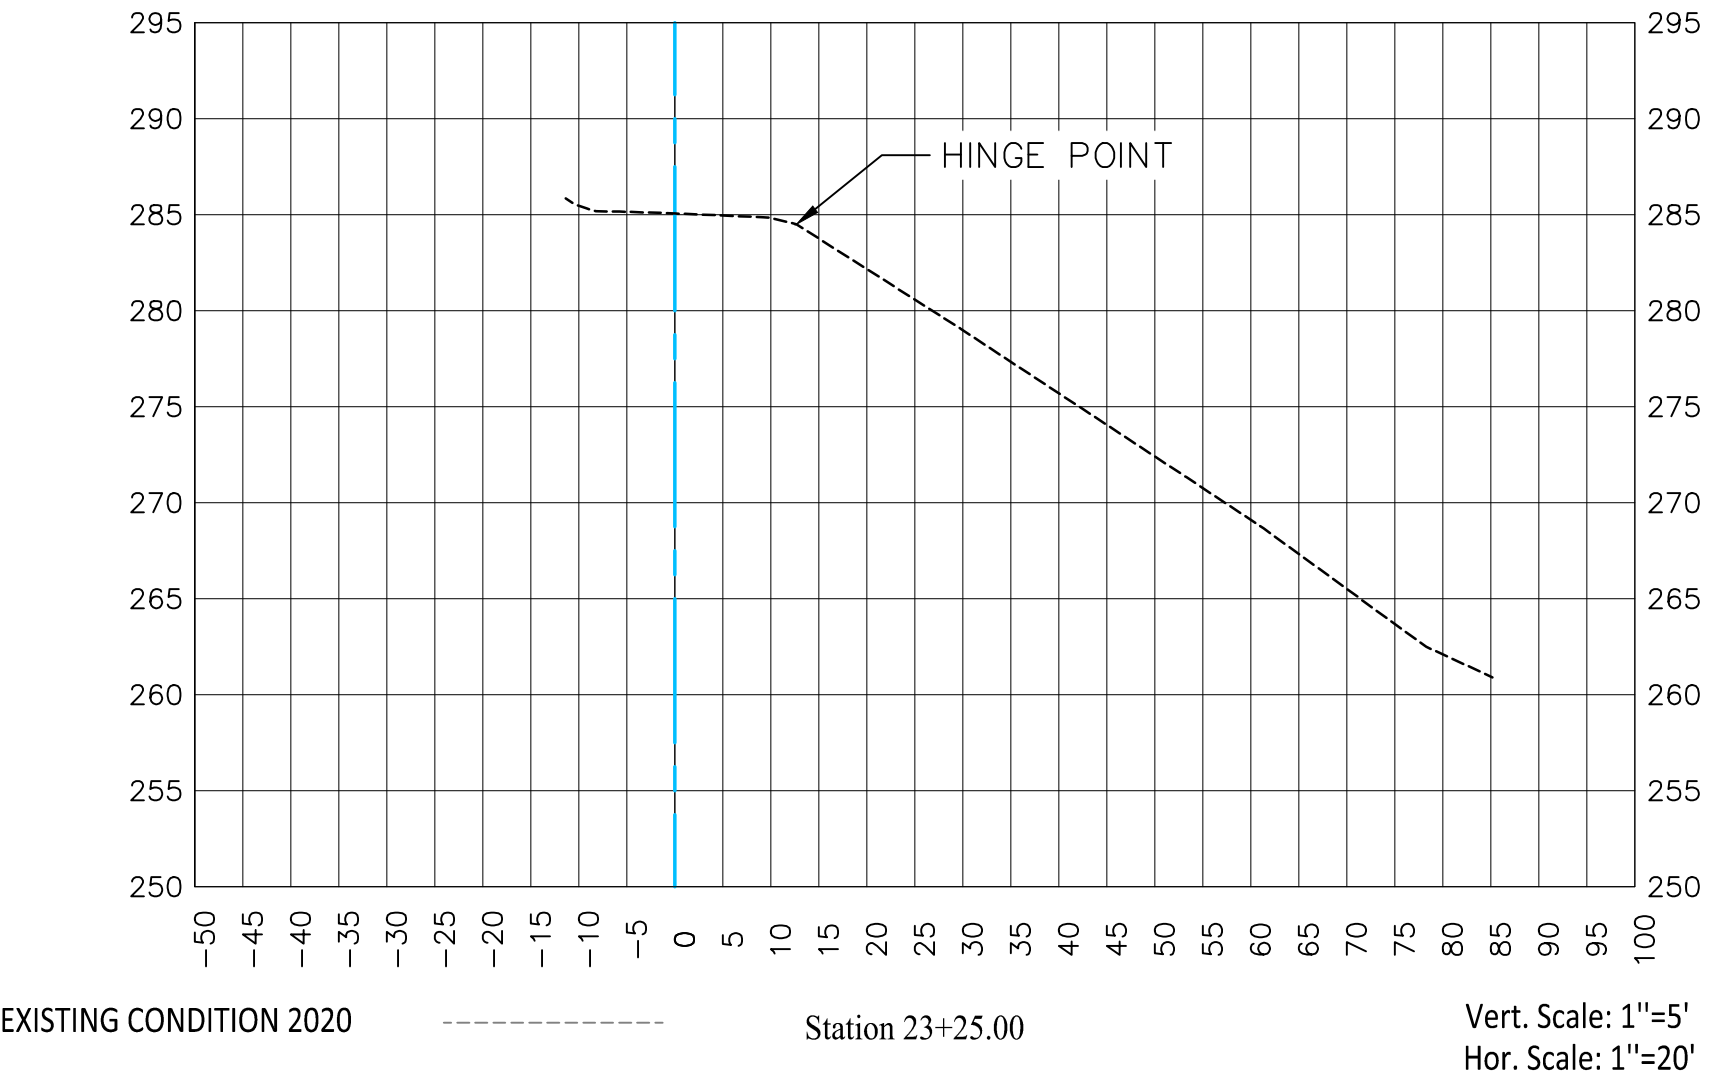


DATE PREPARED: 03/23/2020

U.S. Survey Foot

OC Public Works/Engineering Services
OC Survey/Field Services
Boundary Analysis & Mapping

GALIVAN PERIMETER ROAD CL

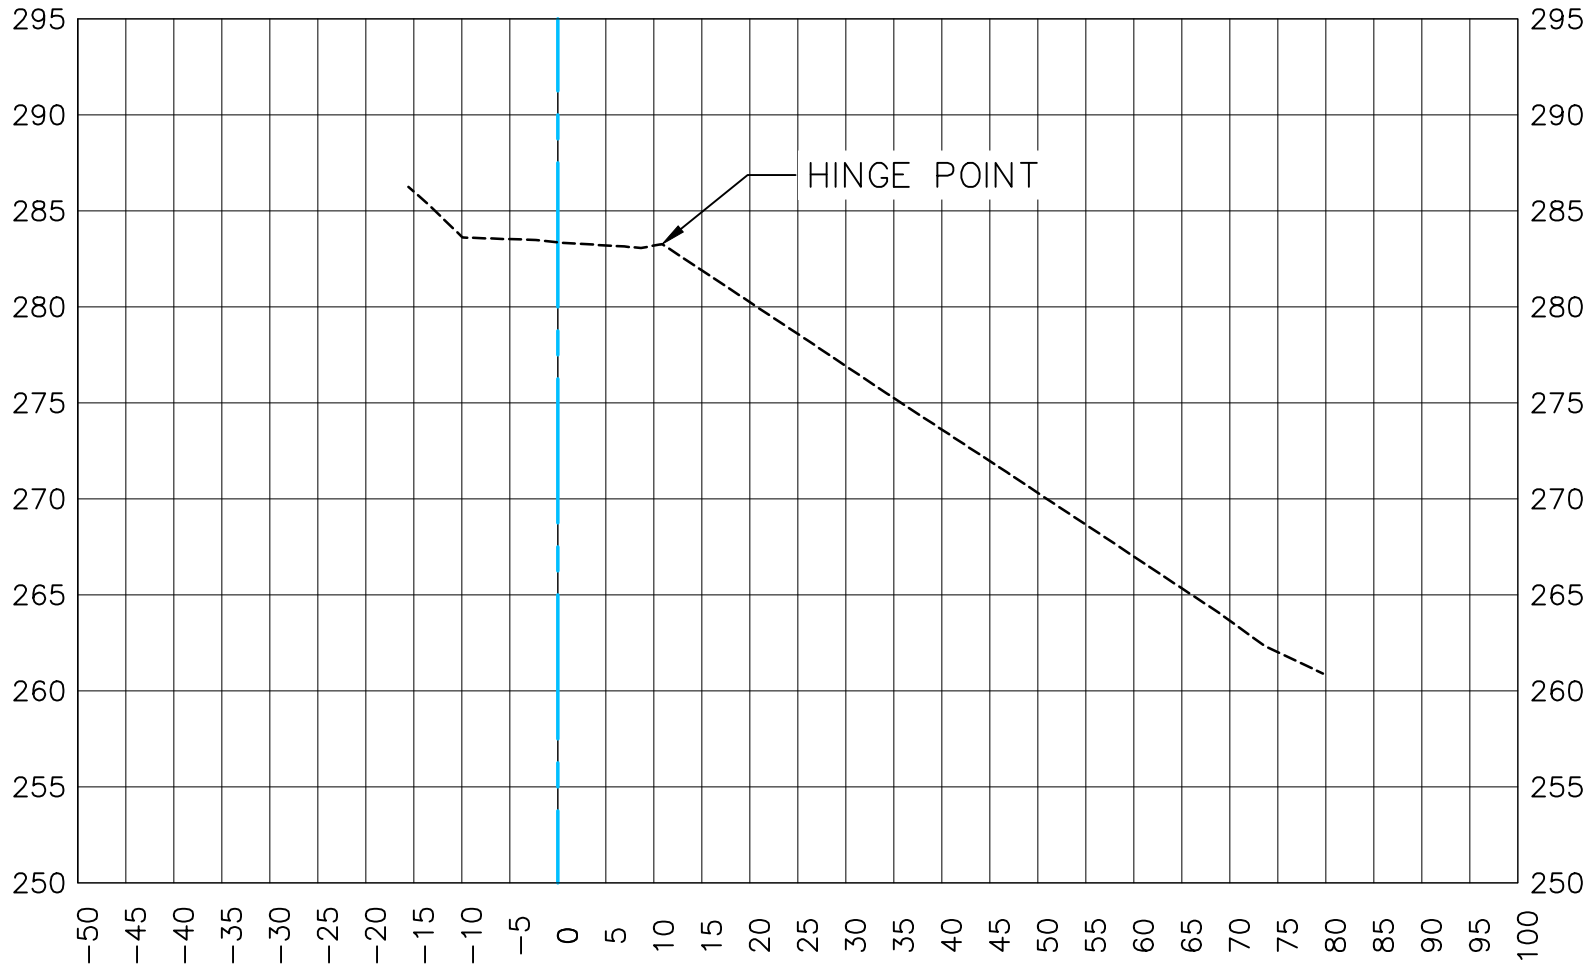

EXISTING CONDITION 2020

Station 23+50.00



Vert. Scale: 1"=5'
Hor. Scale: 1"=20'

DATE PREPARED: 03/23/2020

U.S. *Survey
Foot*

OC Public Works/Engineering Services
OC Survey/Field Services
Boundary Analysis & Mapping

GALIVAN PERIMETER ROAD CL

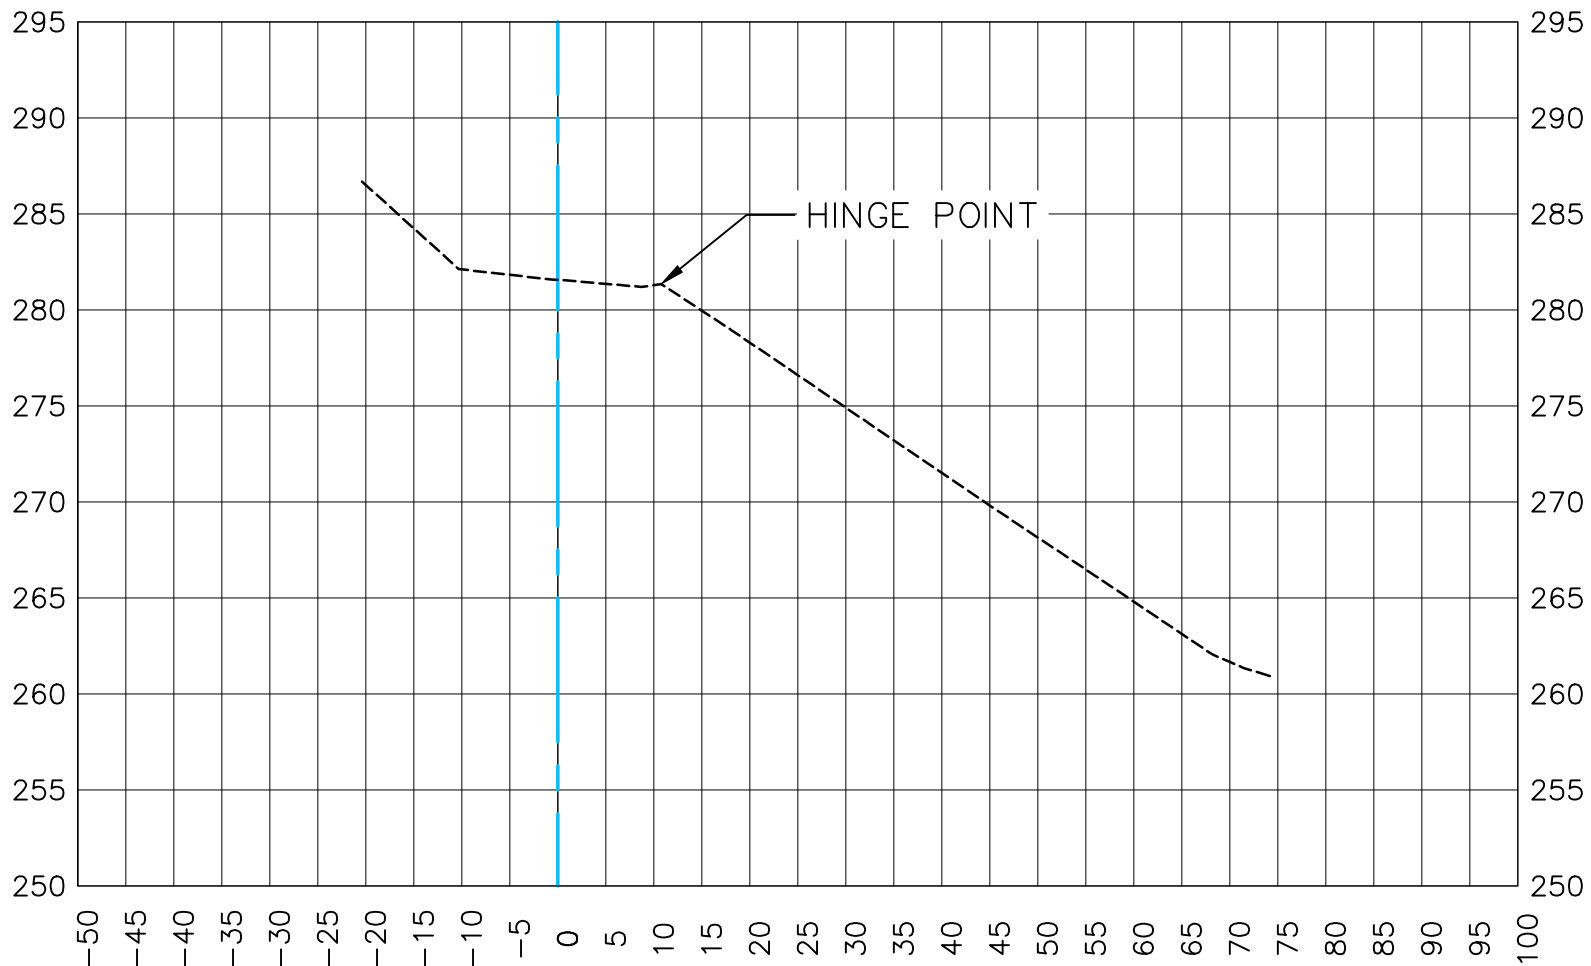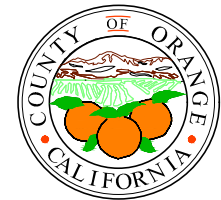

EXISTING CONDITION 2020

Station 23+75.00

Vert. Scale: 1"=5'



Hor. Scale: 1"=20'

DATE PREPARED: 03/23/2020

U.S. Survey
Foot

OC Public Works/Engineering Services
OC Survey/Field Services
Boundary Analysis & Mapping

GALIVAN PERIMETER ROAD CL

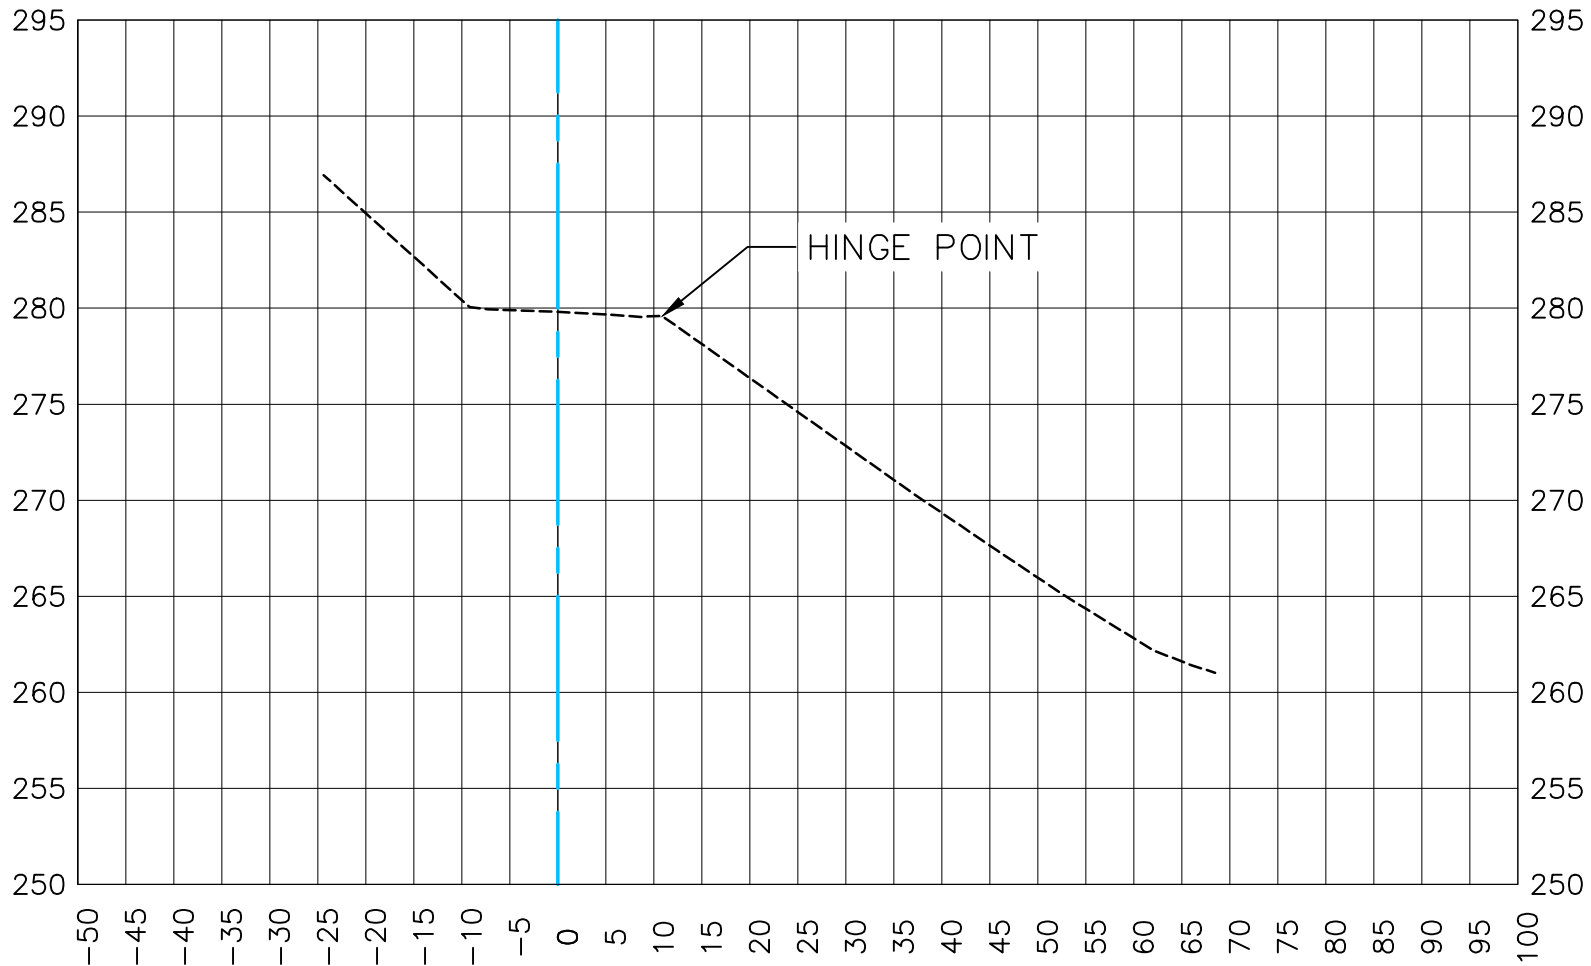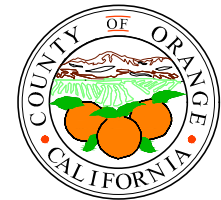

EXISTING CONDITION 2020

Station 24+00.00


Vert. Scale: 1"=5'
Hor. Scale: 1"=20'

DATE PREPARED: 03/23/2020

U.S. Survey Foot

OC Public Works/Engineering Services
OC Survey/Field Services
Boundary Analysis & Mapping

GALIVAN PERIMETER ROAD CL

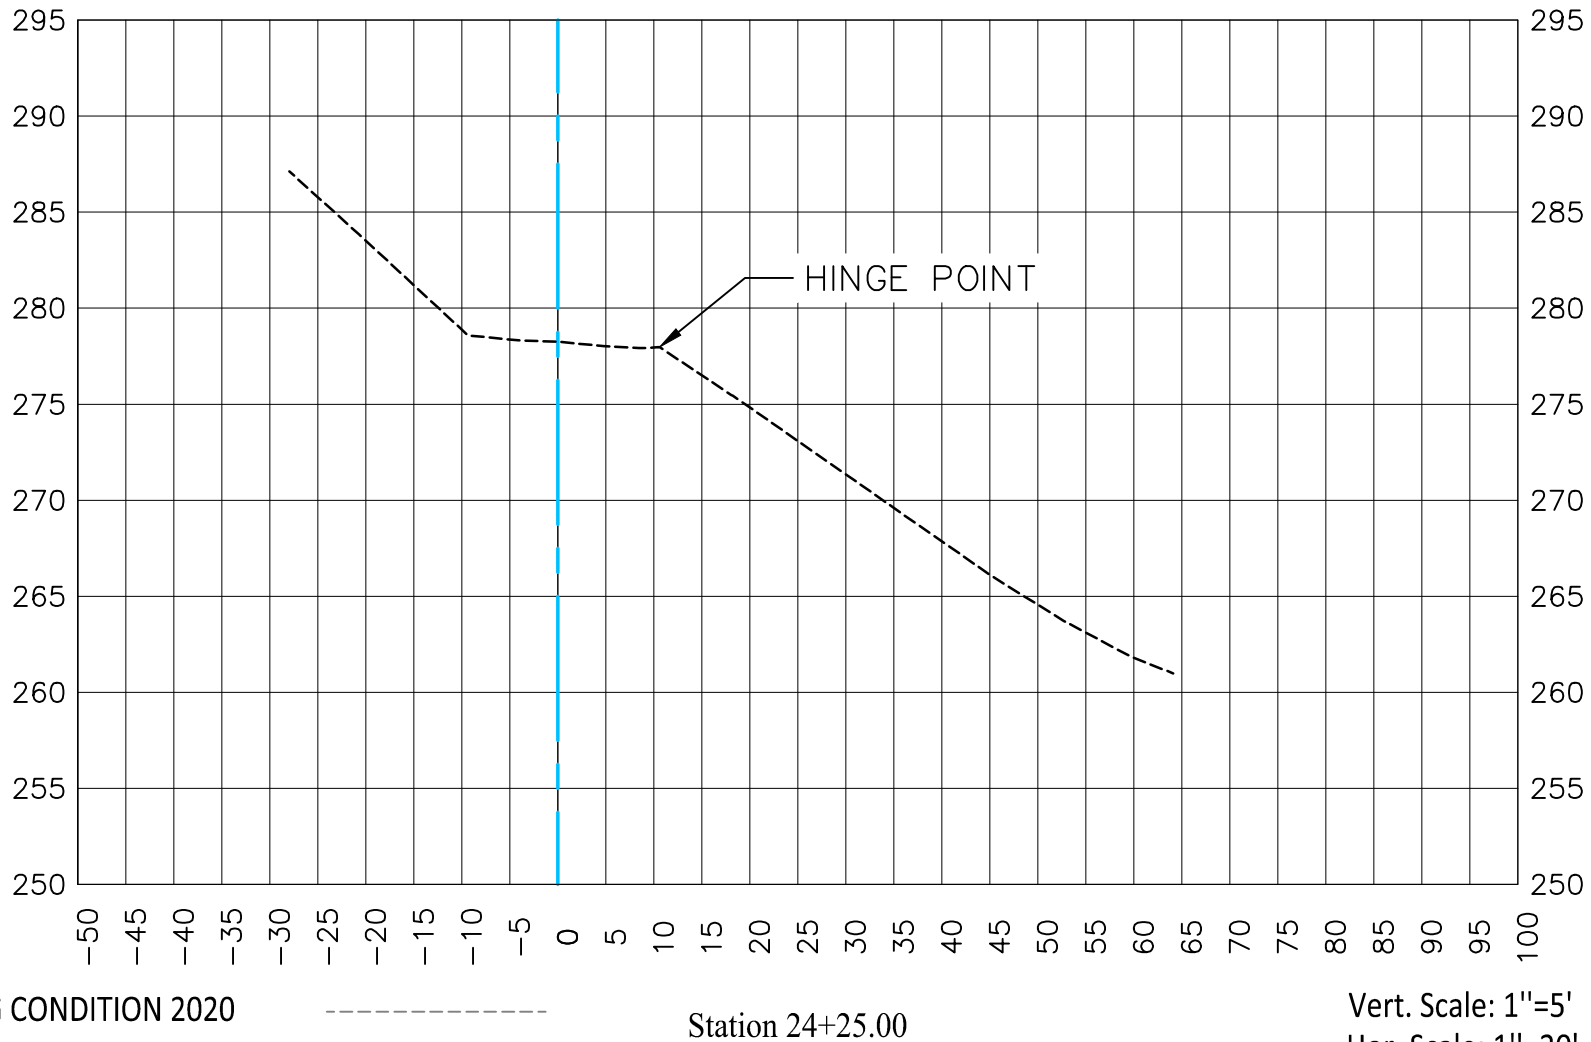

EXISTING CONDITION 2020

Station 24+25.00



Vert. Scale: 1"=5'
Hor. Scale: 1"=20'

DATE PREPARED: 03/23/2020

**U.S. Survey
Foot**

OC Public Works/Engineering Services
OC Survey/Field Services
Boundary Analysis & Mapping

GALIVAN PERIMETER ROAD CL

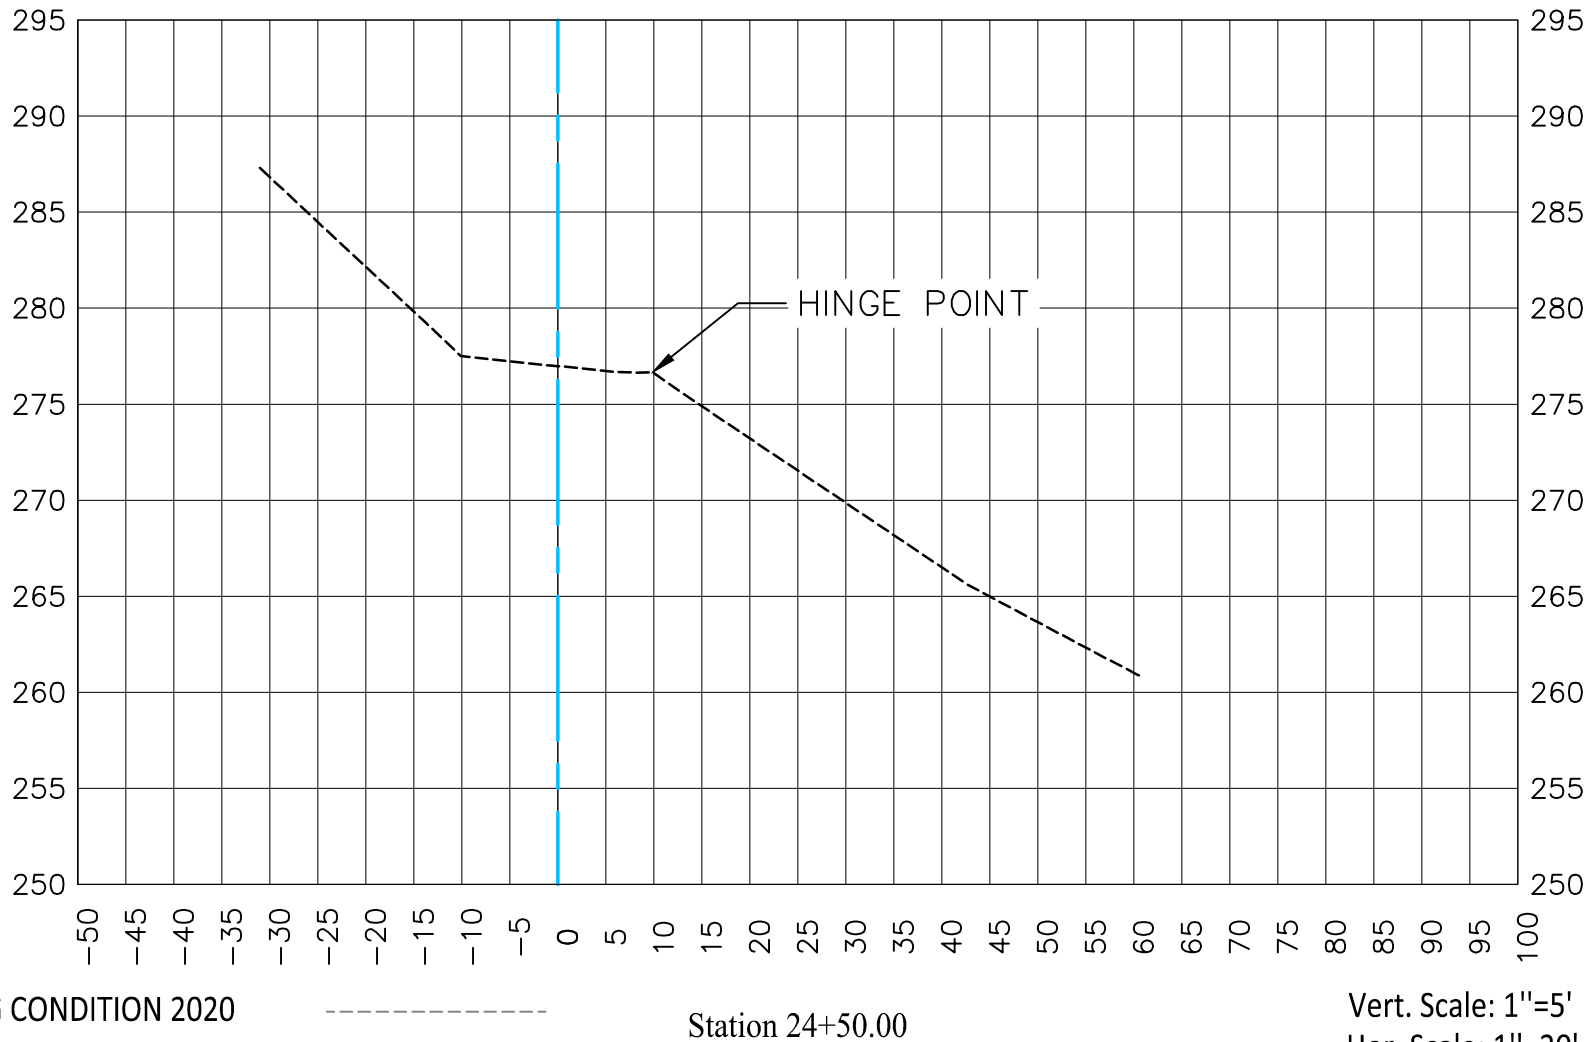
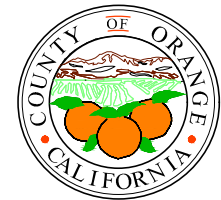


DATE PREPARED: 03/23/2020

**U.S. Survey
Foot**

OC Public Works/Engineering Services
OC Survey/Field Services
Boundary Analysis & Mapping

GALIVAN PERIMETER ROAD CL

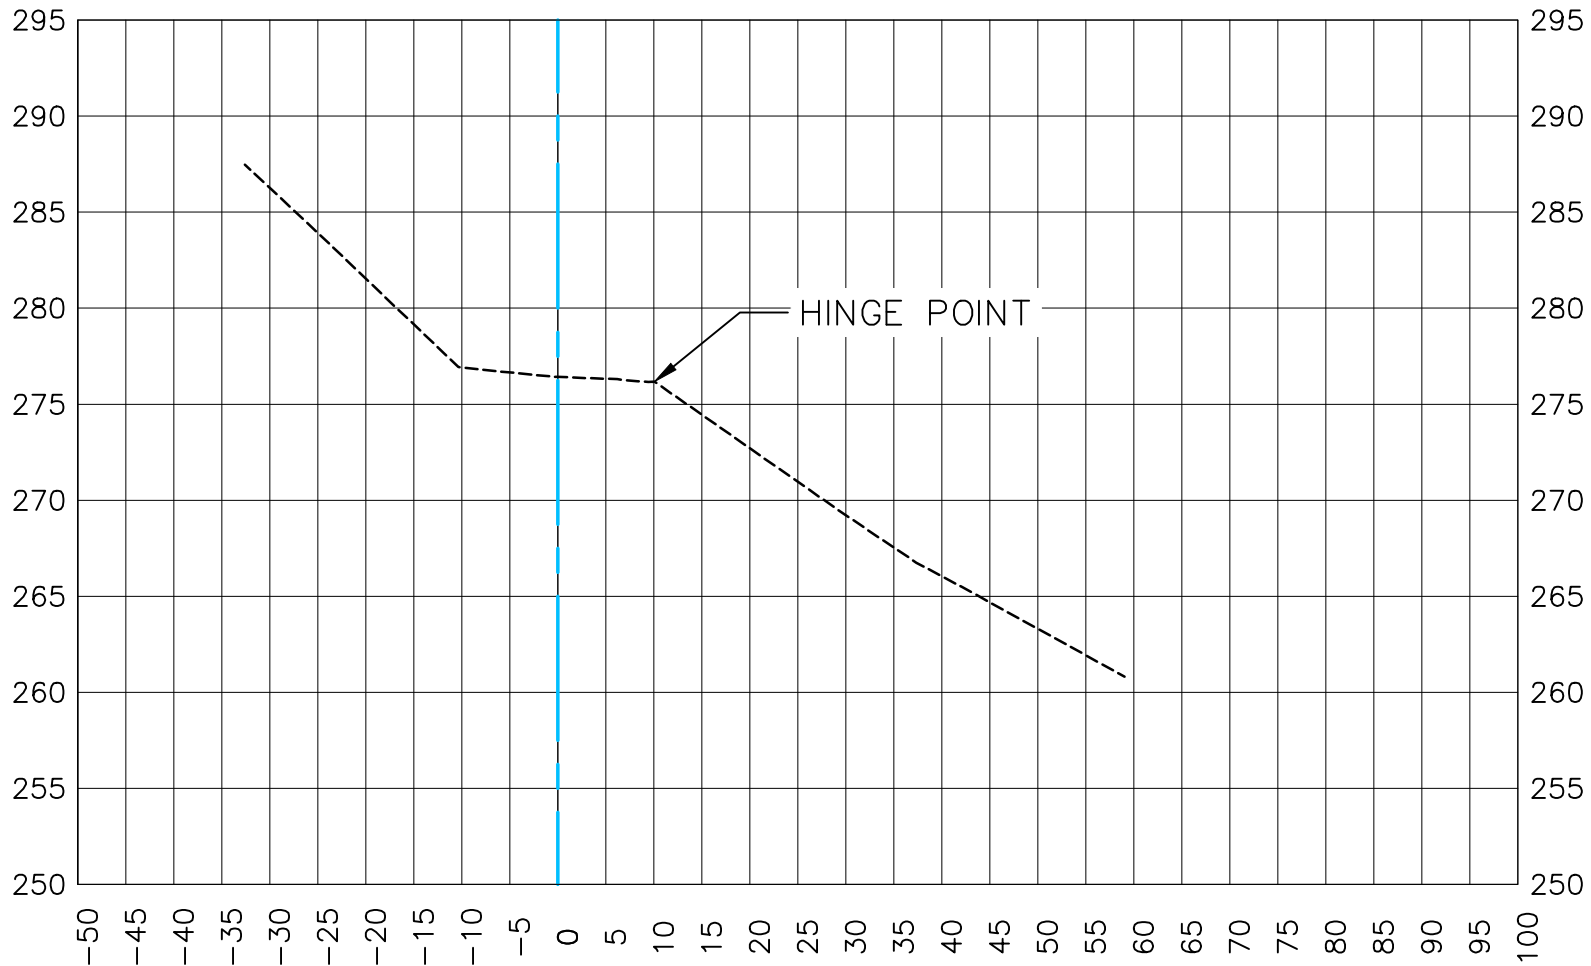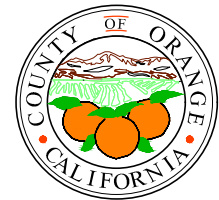


EXISTING CONDITION 2020



Station 24+75.00

Vert. Scale: 1"=5'
Hor. Scale: 1"=20'

DATE PREPARED: 03/23/2020

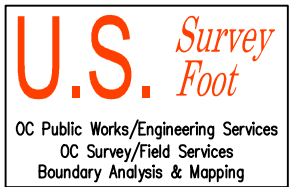

GALIVAN PERIMETER ROAD CL

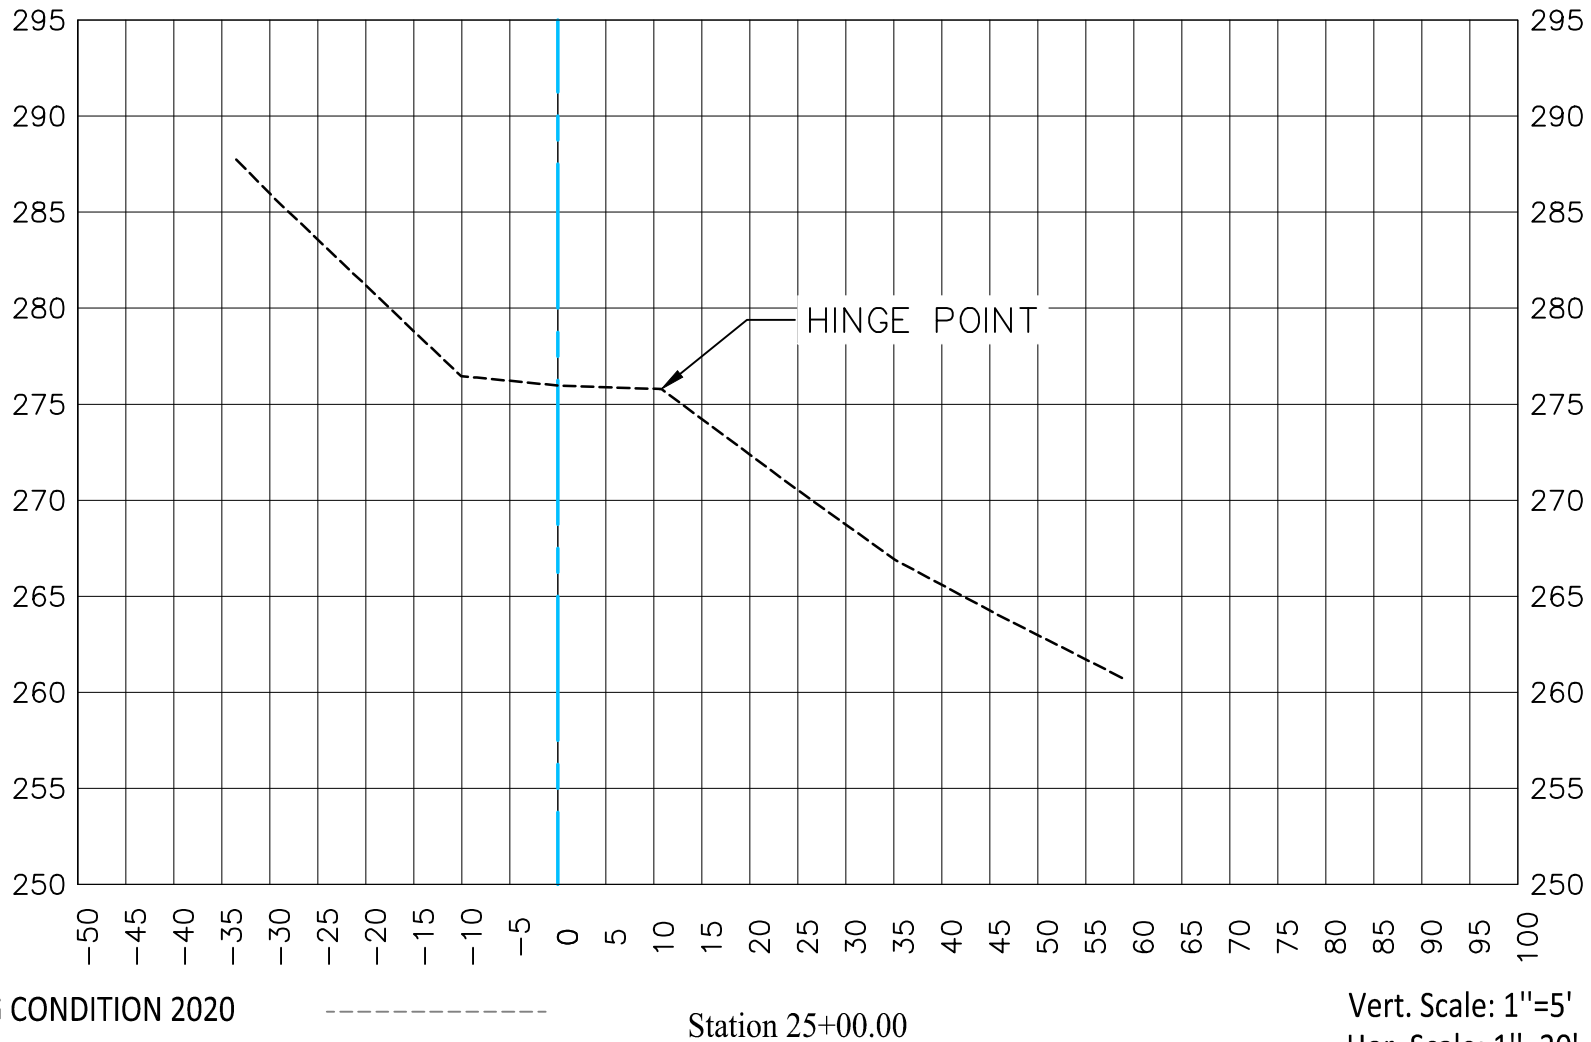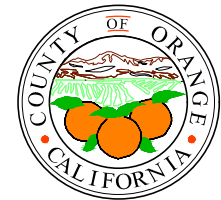


EXISTING CONDITION 2020



Station 25+00.00

Vert. Scale: 1"=5'
Hor. Scale: 1"=20'

DATE PREPARED: 03/23/2020

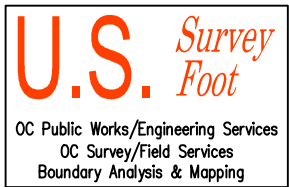

GALIVAN PERIMETER ROAD CL

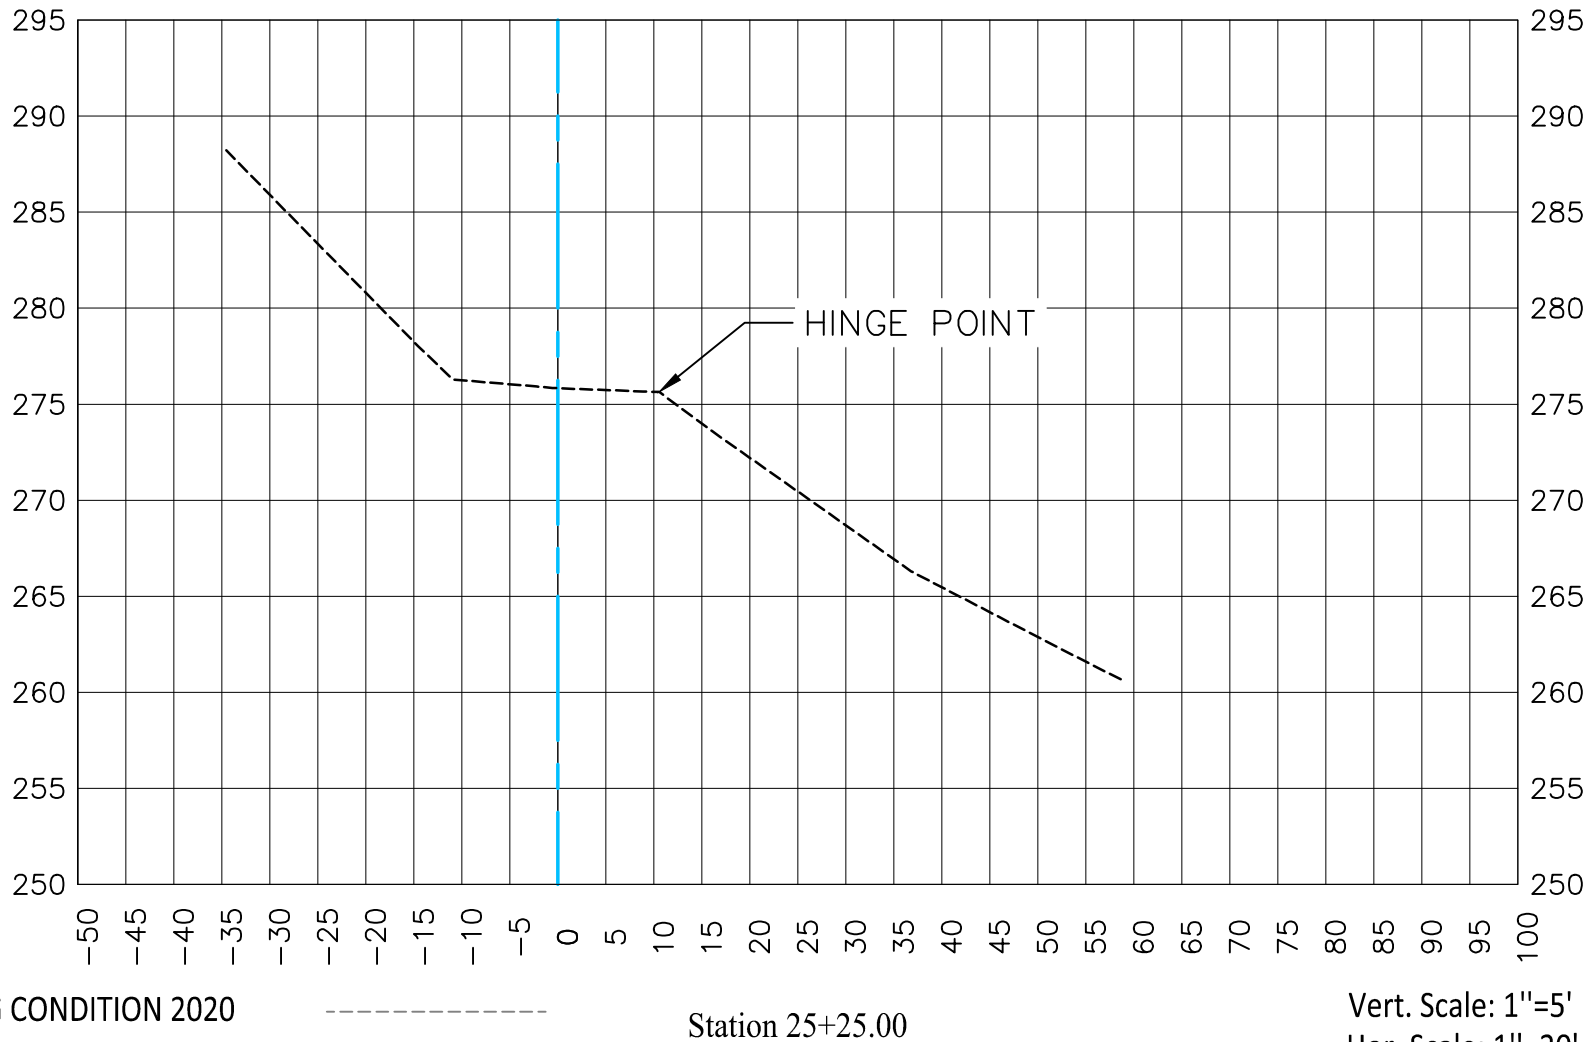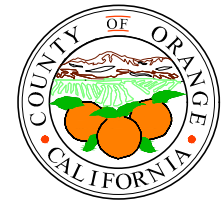


EXISTING CONDITION 2020



Station 25+25.00

Vert. Scale: 1"=5'
Hor. Scale: 1"=20'

DATE PREPARED: 03/23/2020

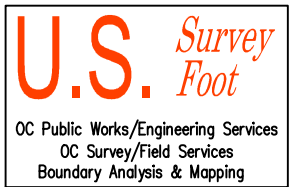

GALIVAN PERIMETER ROAD CL

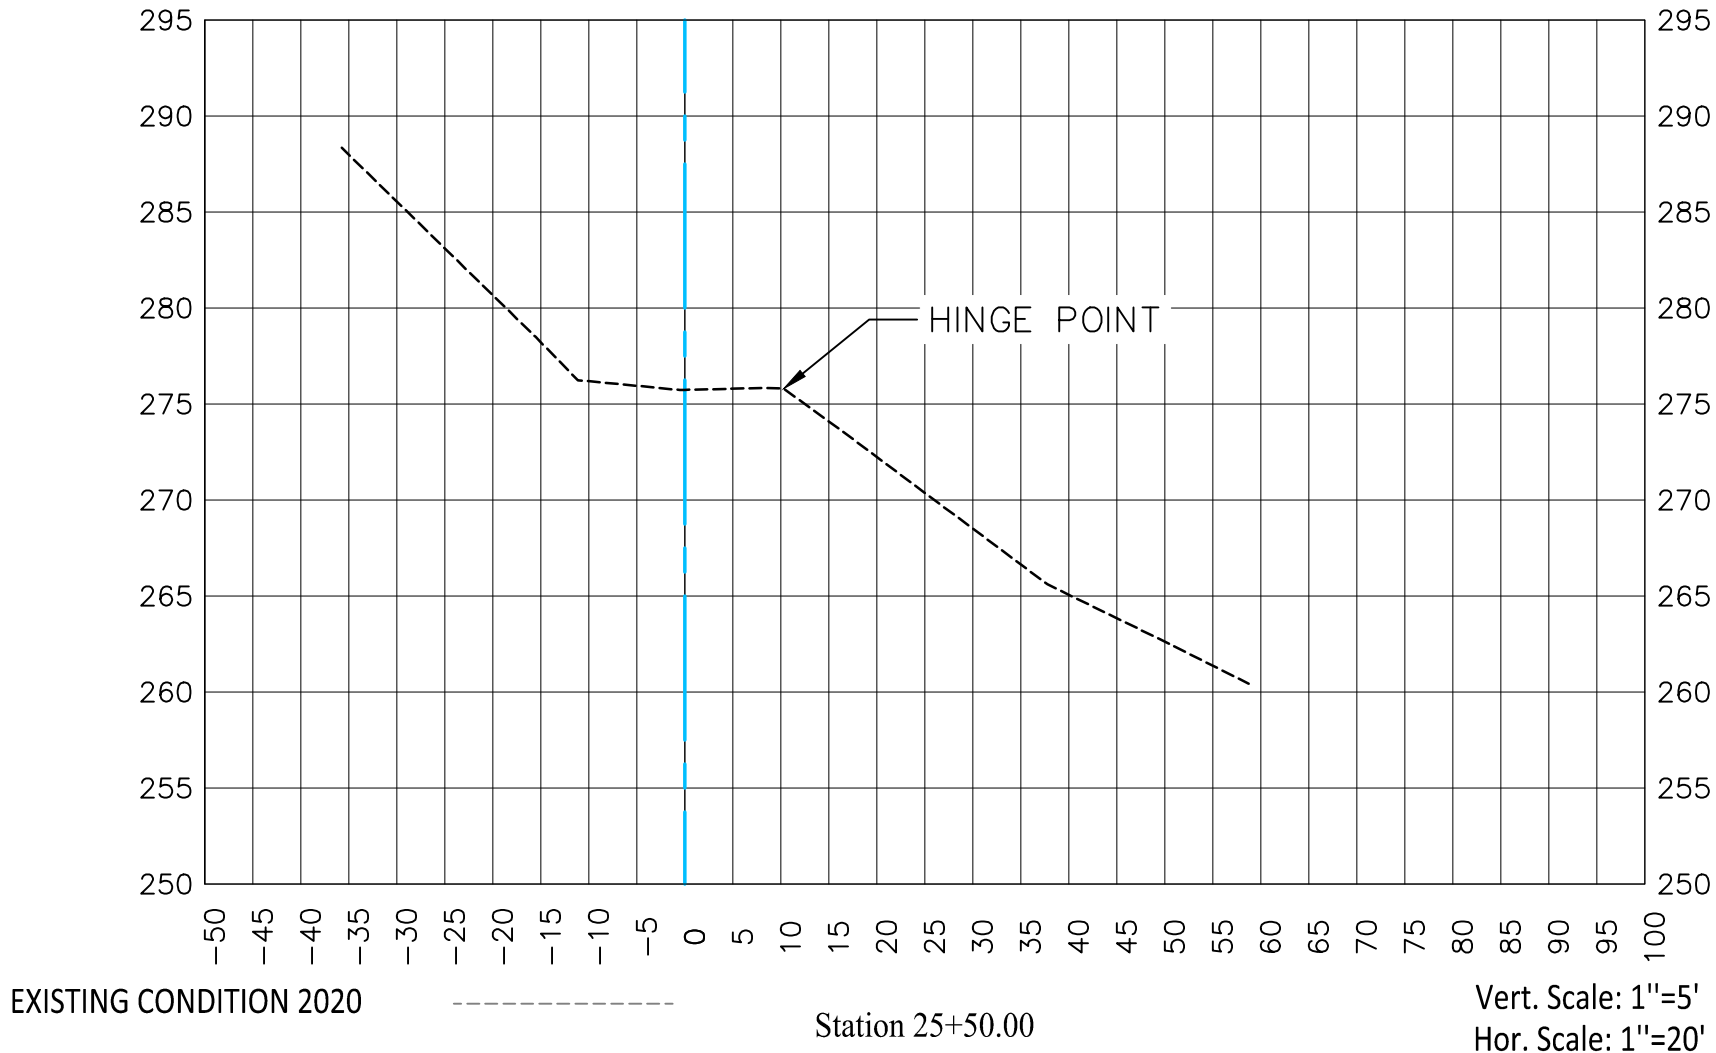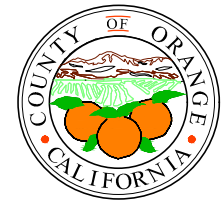


DATE PREPARED: 03/23/2020

**U.S. Survey
Foot**

OC Public Works/Engineering Services
OC Survey/Field Services
Boundary Analysis & Mapping

GALIVAN PERIMETER ROAD CL

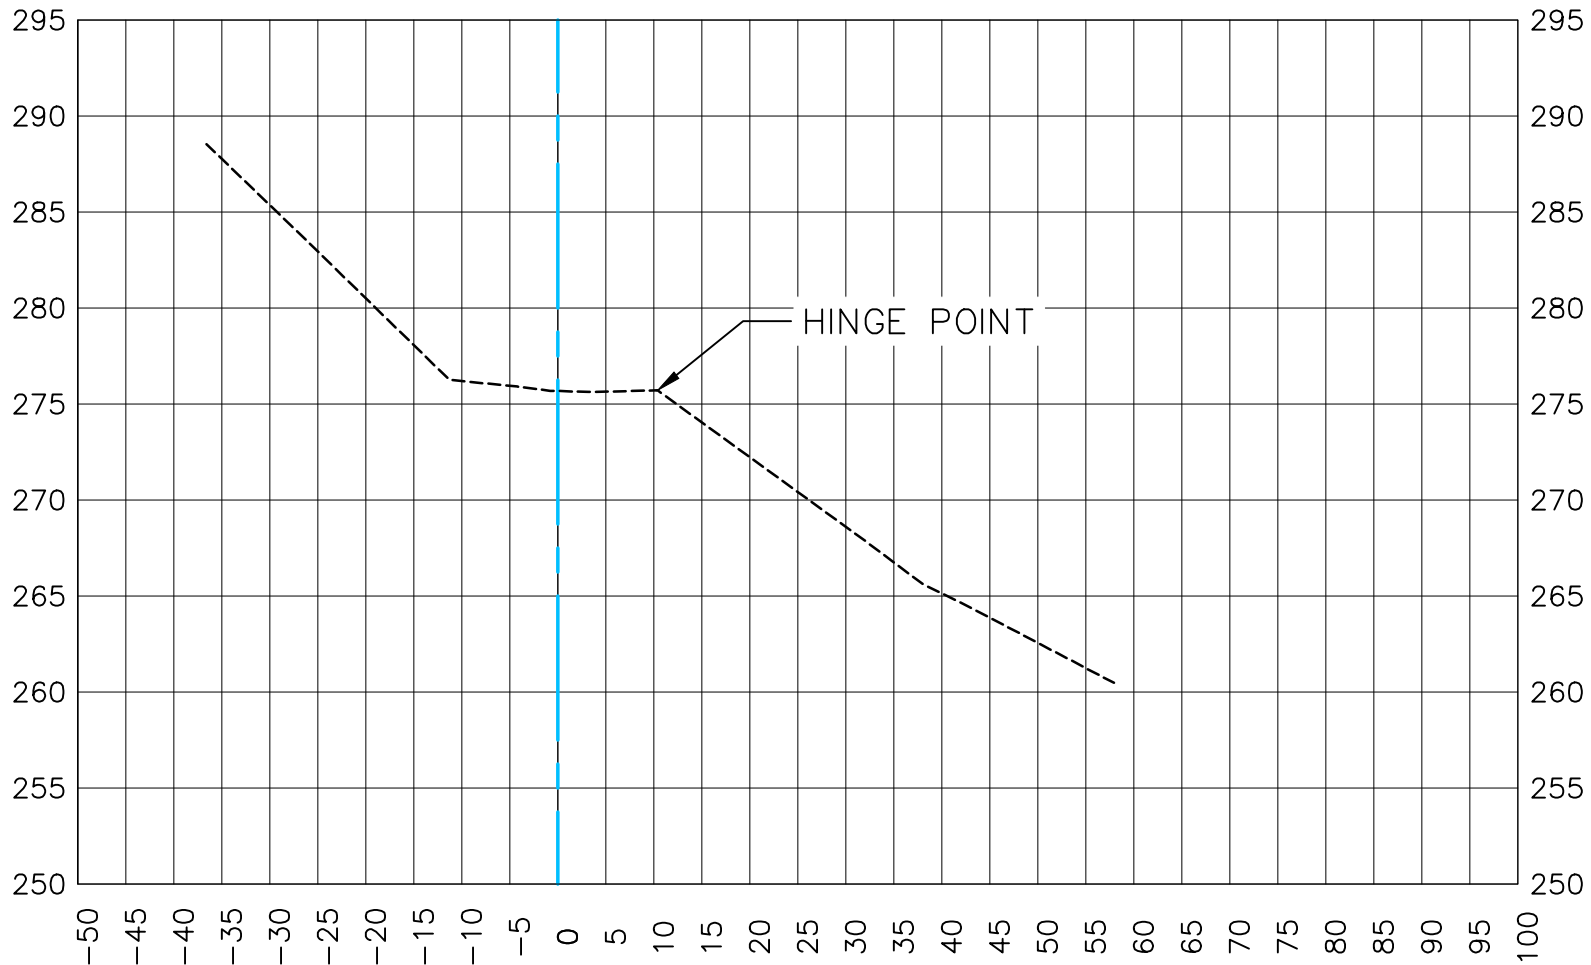

EXISTING CONDITION 2020

Station 25+75.00


Vert. Scale: 1"=5'
Hor. Scale: 1"=20'

DATE PREPARED: 03/23/2020

U.S. Survey
Foot

OC Public Works/Engineering Services
OC Survey/Field Services
Boundary Analysis & Mapping

GALIVAN PERIMETER ROAD CL

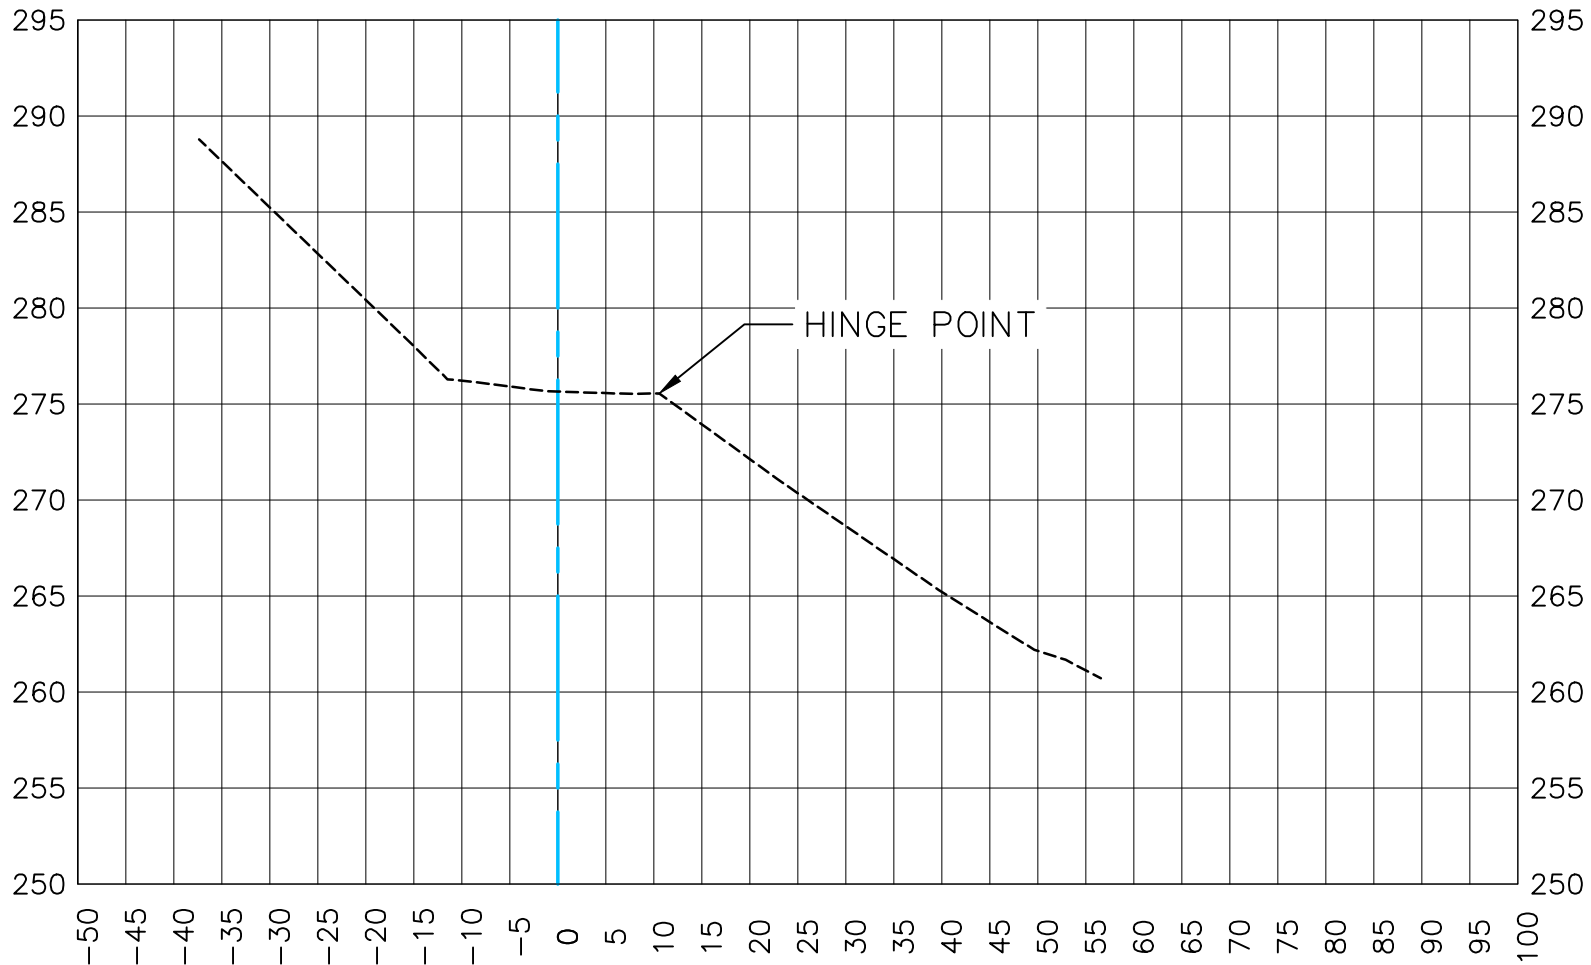

EXISTING CONDITION 2020

Station 26+00.00


Vert. Scale: 1"=5'
Hor. Scale: 1"=20'

DATE PREPARED: 03/23/2020

U.S. Survey Foot

OC Public Works/Engineering Services
OC Survey/Field Services
Boundary Analysis & Mapping

GALIVAN PERIMETER ROAD CL

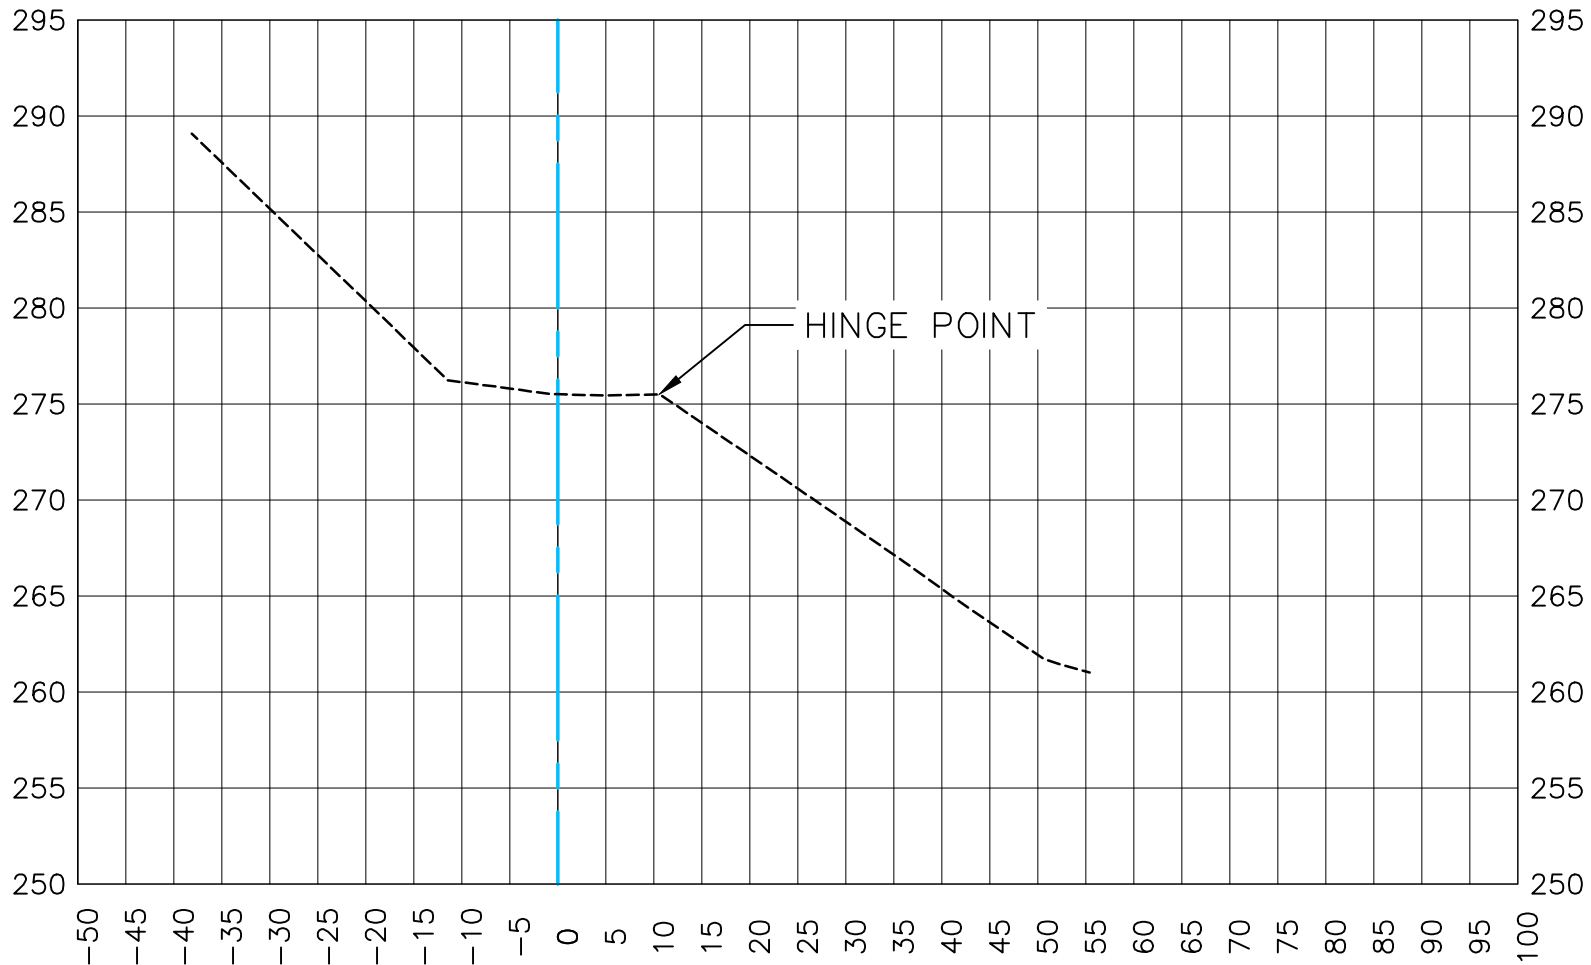

EXISTING CONDITION 2020

Station 26+25.00


Vert. Scale: 1"=5'
Hor. Scale: 1"=20'

DATE PREPARED: 03/23/2020

U.S. Survey Foot

OC Public Works/Engineering Services
OC Survey/Field Services
Boundary Analysis & Mapping

GALIVAN PERIMETER ROAD CL

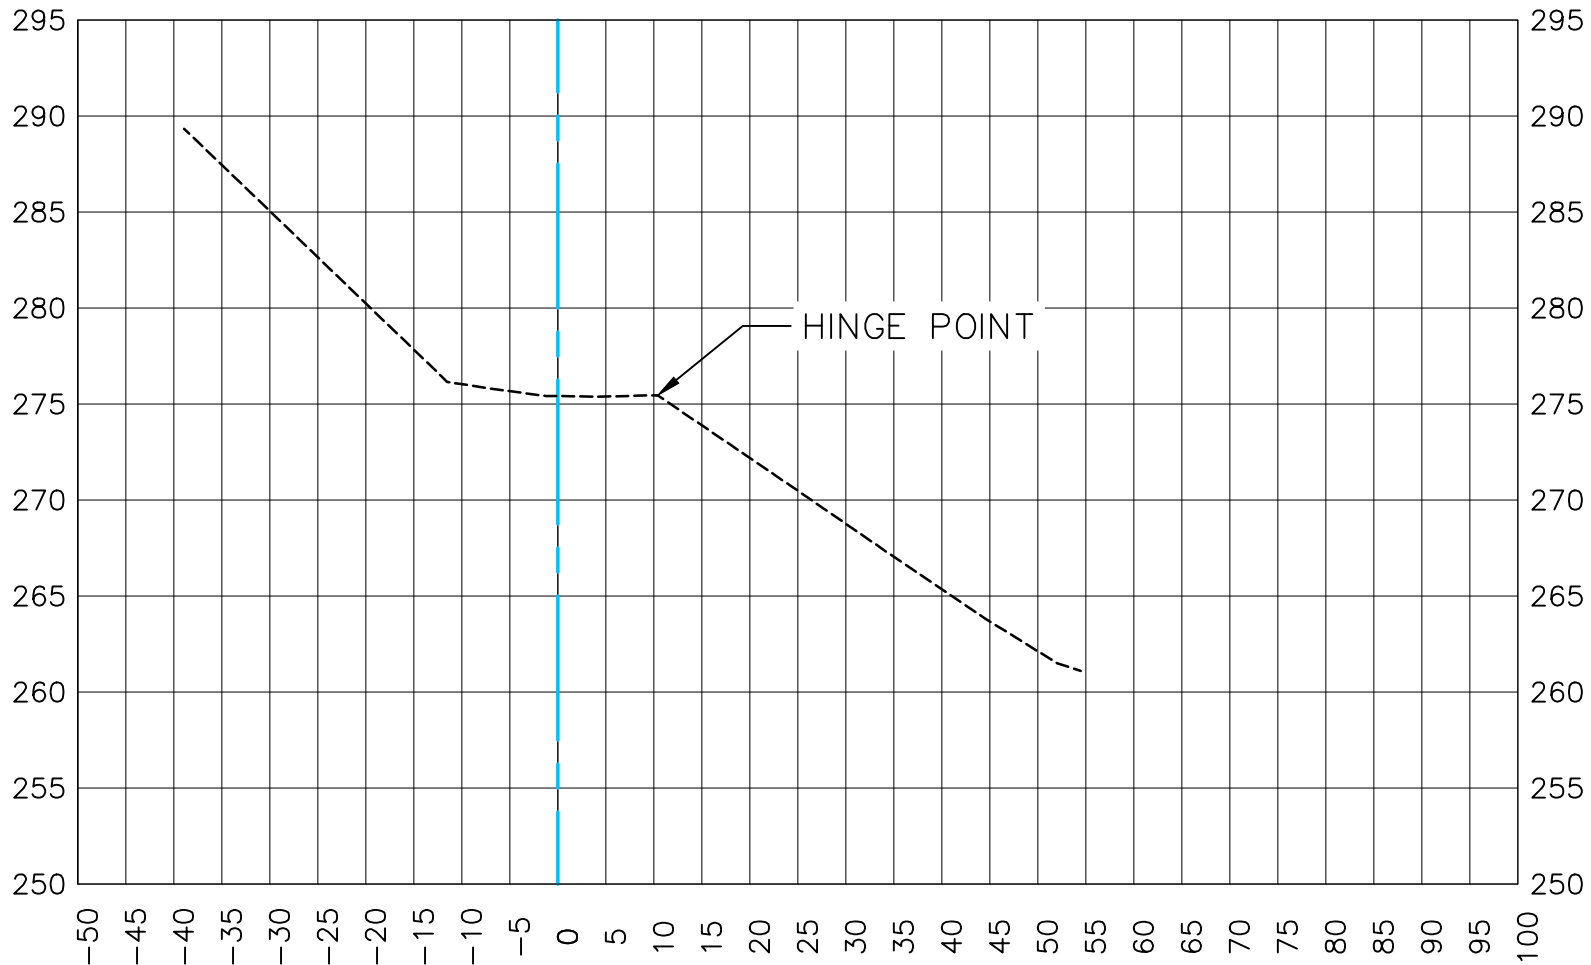

EXISTING CONDITION 2020

Station 26+50.00


Vert. Scale: 1"=5'
Hor. Scale: 1"=20'

DATE PREPARED: 03/23/2020

U.S. Survey Foot

OC Public Works/Engineering Services
OC Survey/Field Services
Boundary Analysis & Mapping

GALIVAN PERIMETER ROAD CL

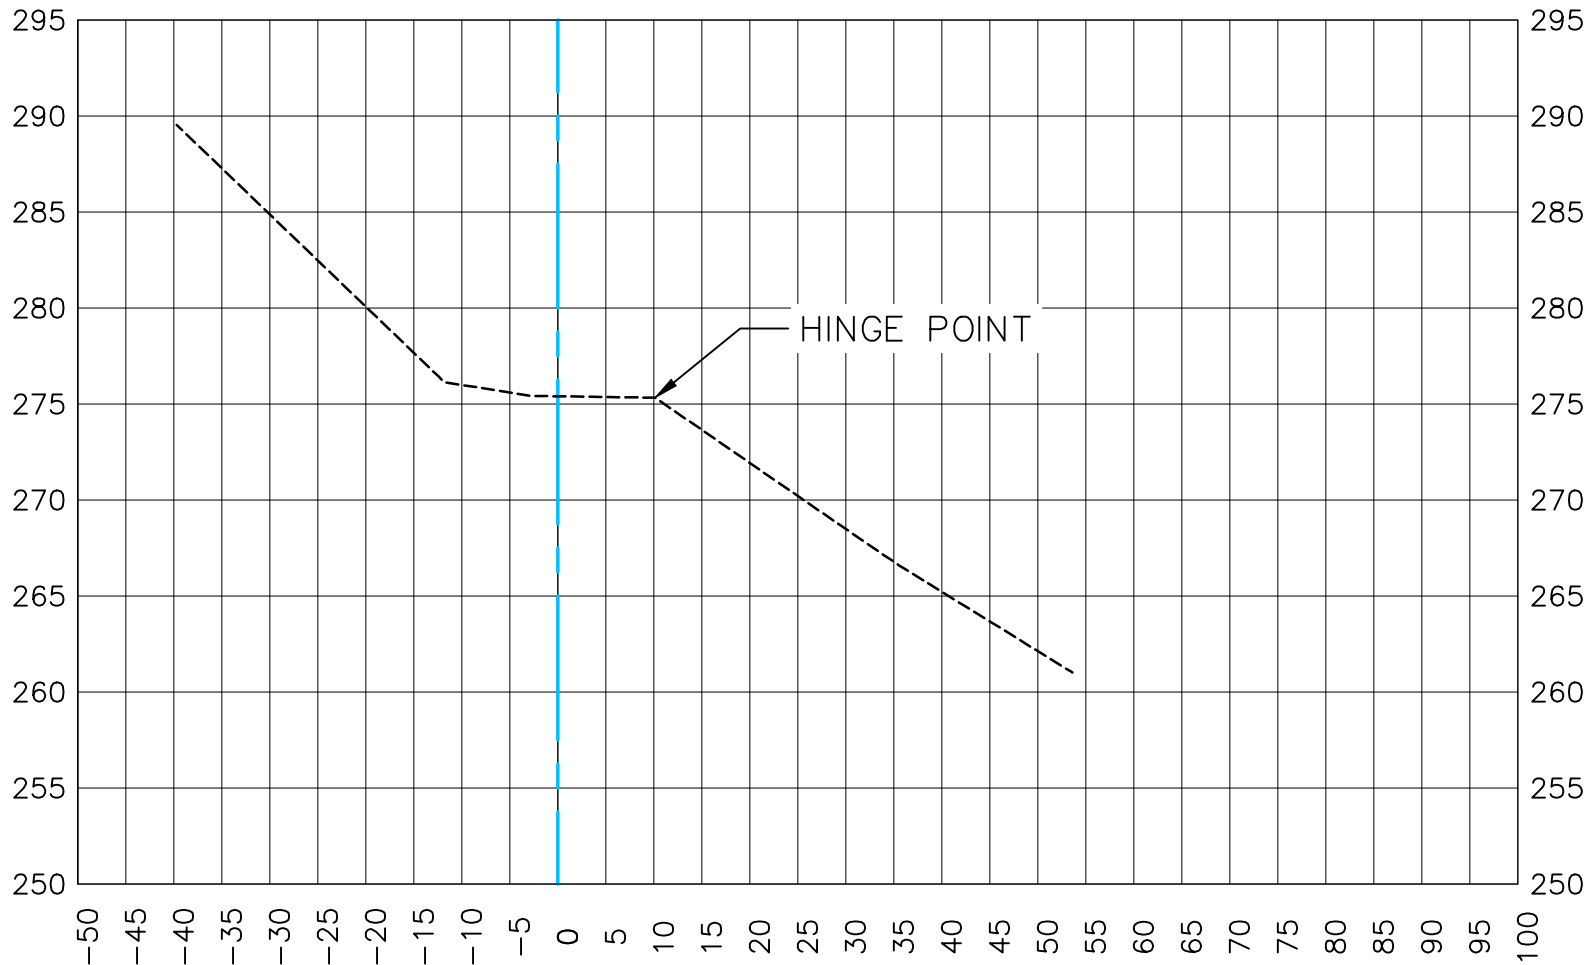

EXISTING CONDITION 2020

Station 26+75.00


Vert. Scale: 1"=5'
Hor. Scale: 1"=20'

DATE PREPARED: 03/23/2020

U.S. Survey
Foot

OC Public Works/Engineering Services
OC Survey/Field Services
Boundary Analysis & Mapping

GALIVAN PERIMETER ROAD CL

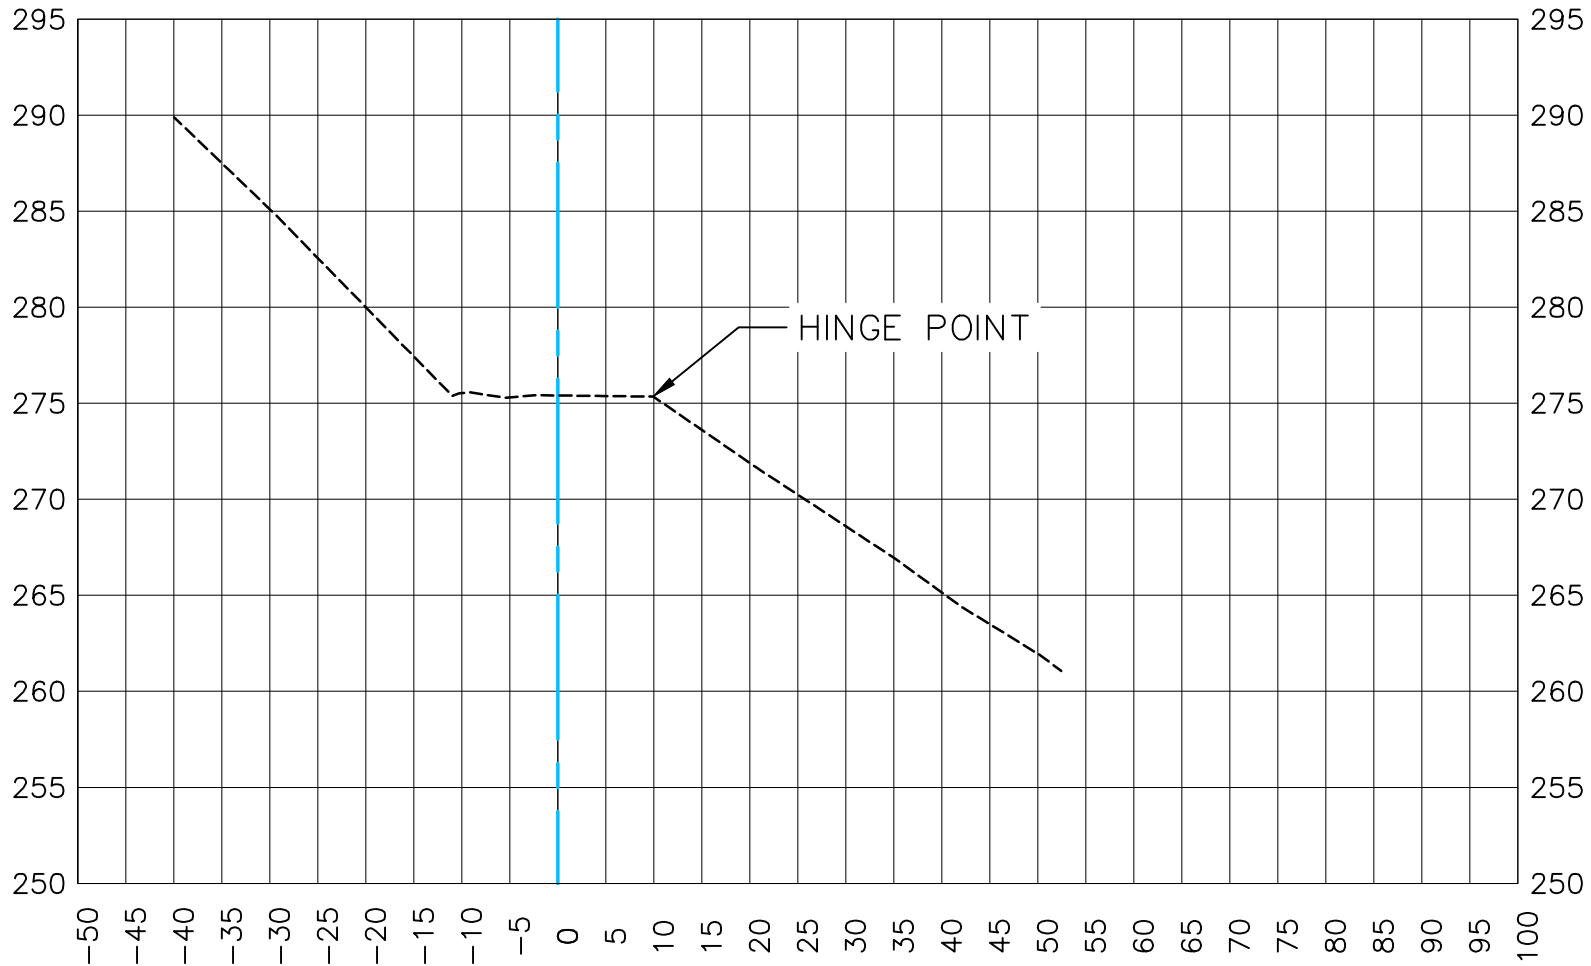

EXISTING CONDITION 2020

Station 27+00.00


Vert. Scale: 1"=5'
Hor. Scale: 1"=20'

DATE PREPARED: 03/23/2020

U.S. Survey Foot

OC Public Works/Engineering Services
OC Survey/Field Services
Boundary Analysis & Mapping

GALIVAN PERIMETER ROAD CL

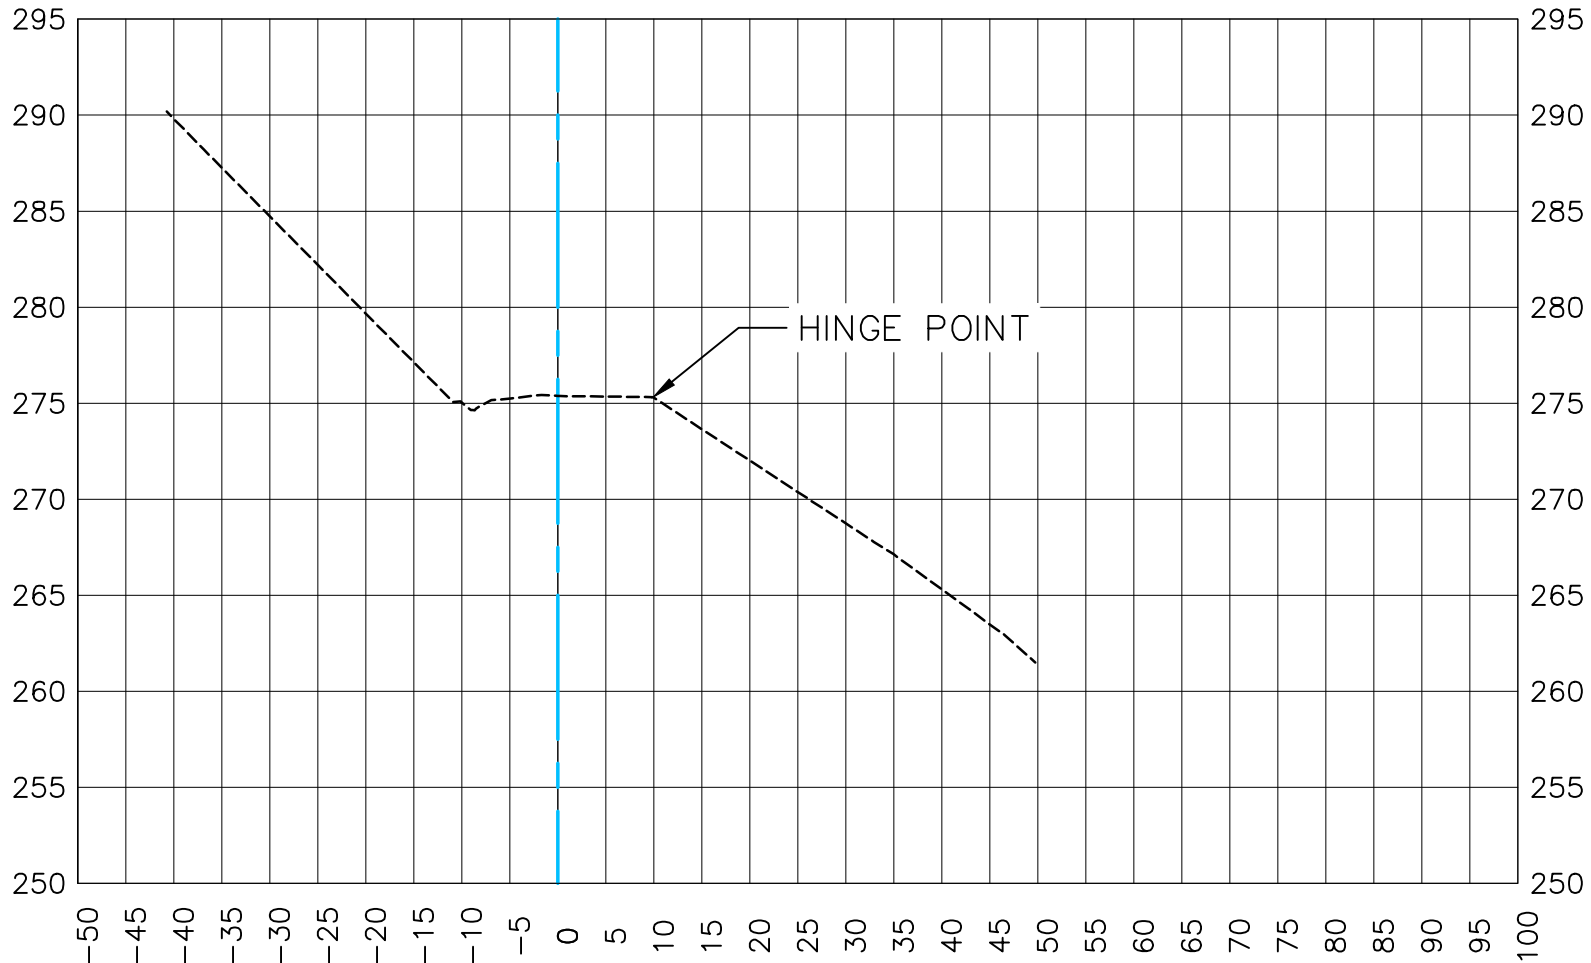

EXISTING CONDITION 2020

Station 27+25.00


Vert. Scale: 1"=5'
Hor. Scale: 1"=20'

DATE PREPARED: 03/23/2020

U.S. Survey Foot

OC Public Works/Engineering Services
OC Survey/Field Services
Boundary Analysis & Mapping

GALIVAN PERIMETER ROAD CL

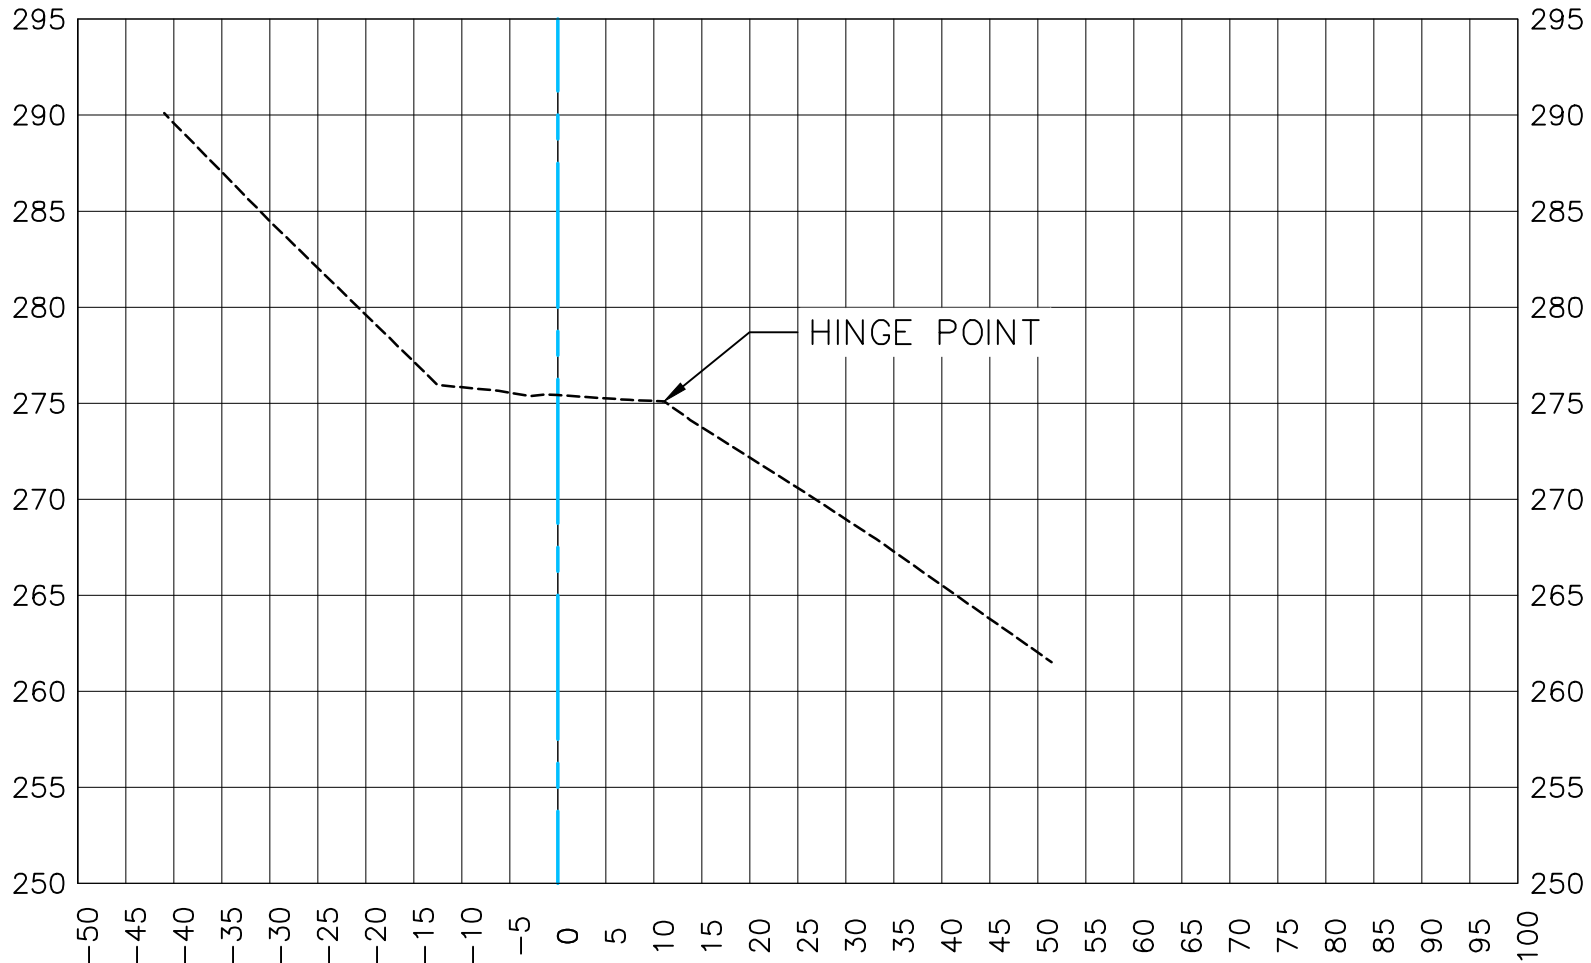


EXISTING CONDITION 2020


Station 27+50.00

Vert. Scale: 1"=5'
Hor. Scale: 1"=20'

DATE PREPARED: 03/23/2020

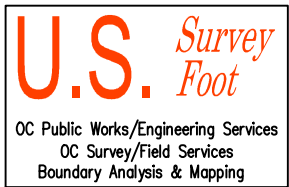

GALIVAN PERIMETER ROAD CL

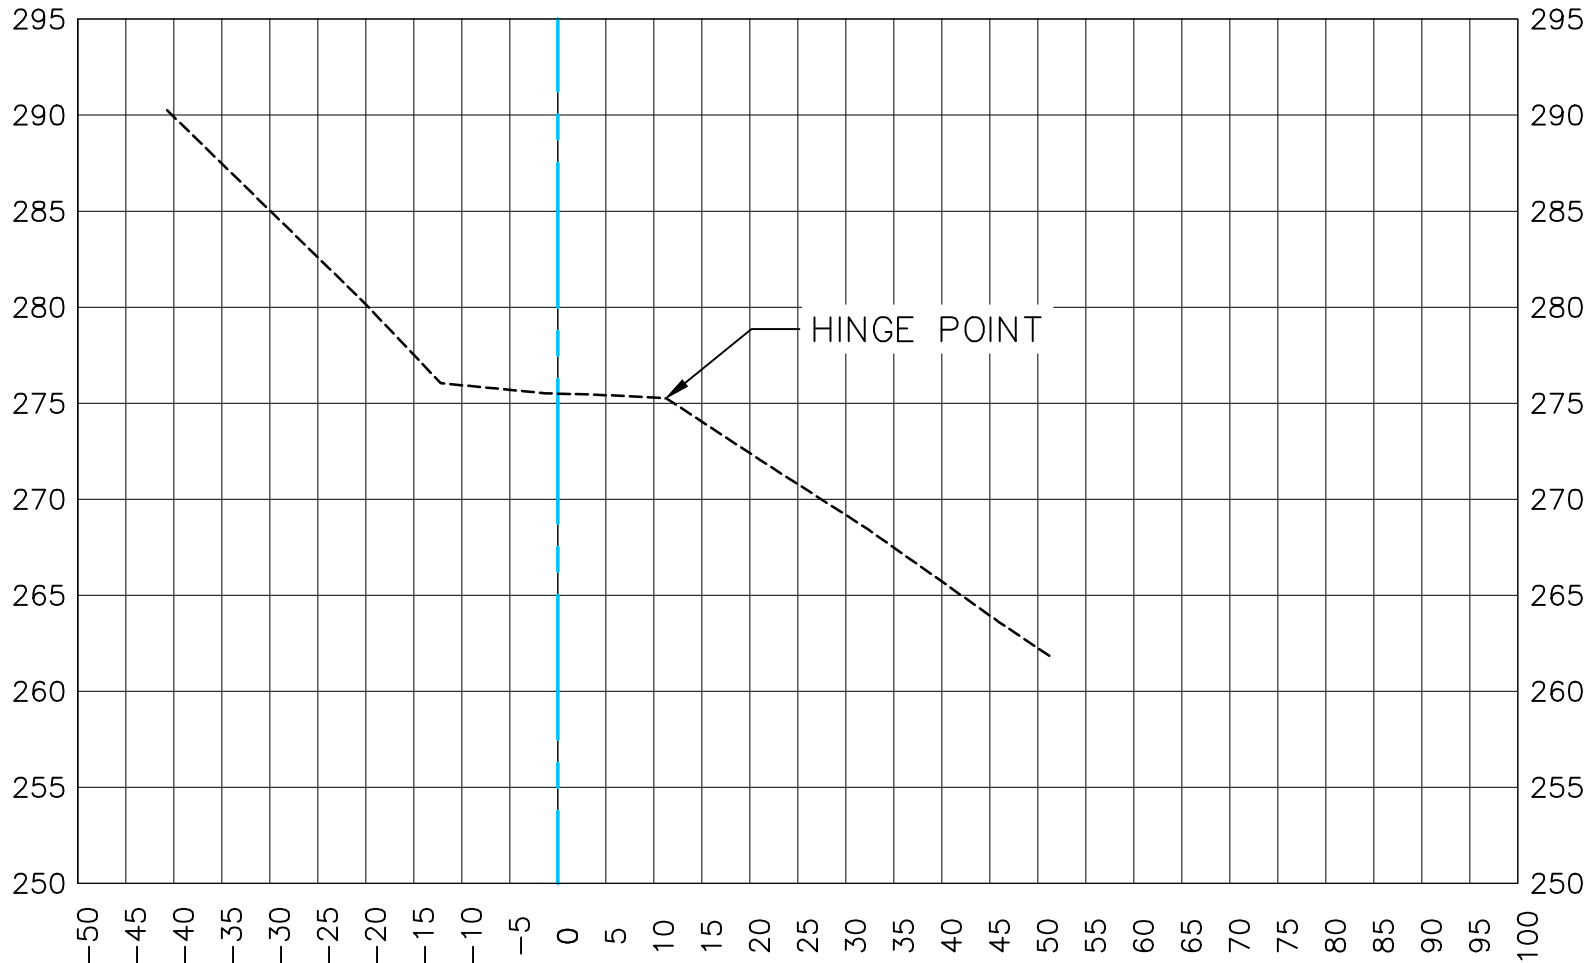


EXISTING CONDITION 2020



Station 27+75.00

Vert. Scale: 1"=5'
Hor. Scale: 1"=20'

DATE PREPARED: 03/23/2020

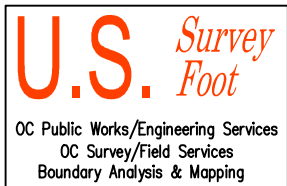

GALIVAN PERIMETER ROAD CL

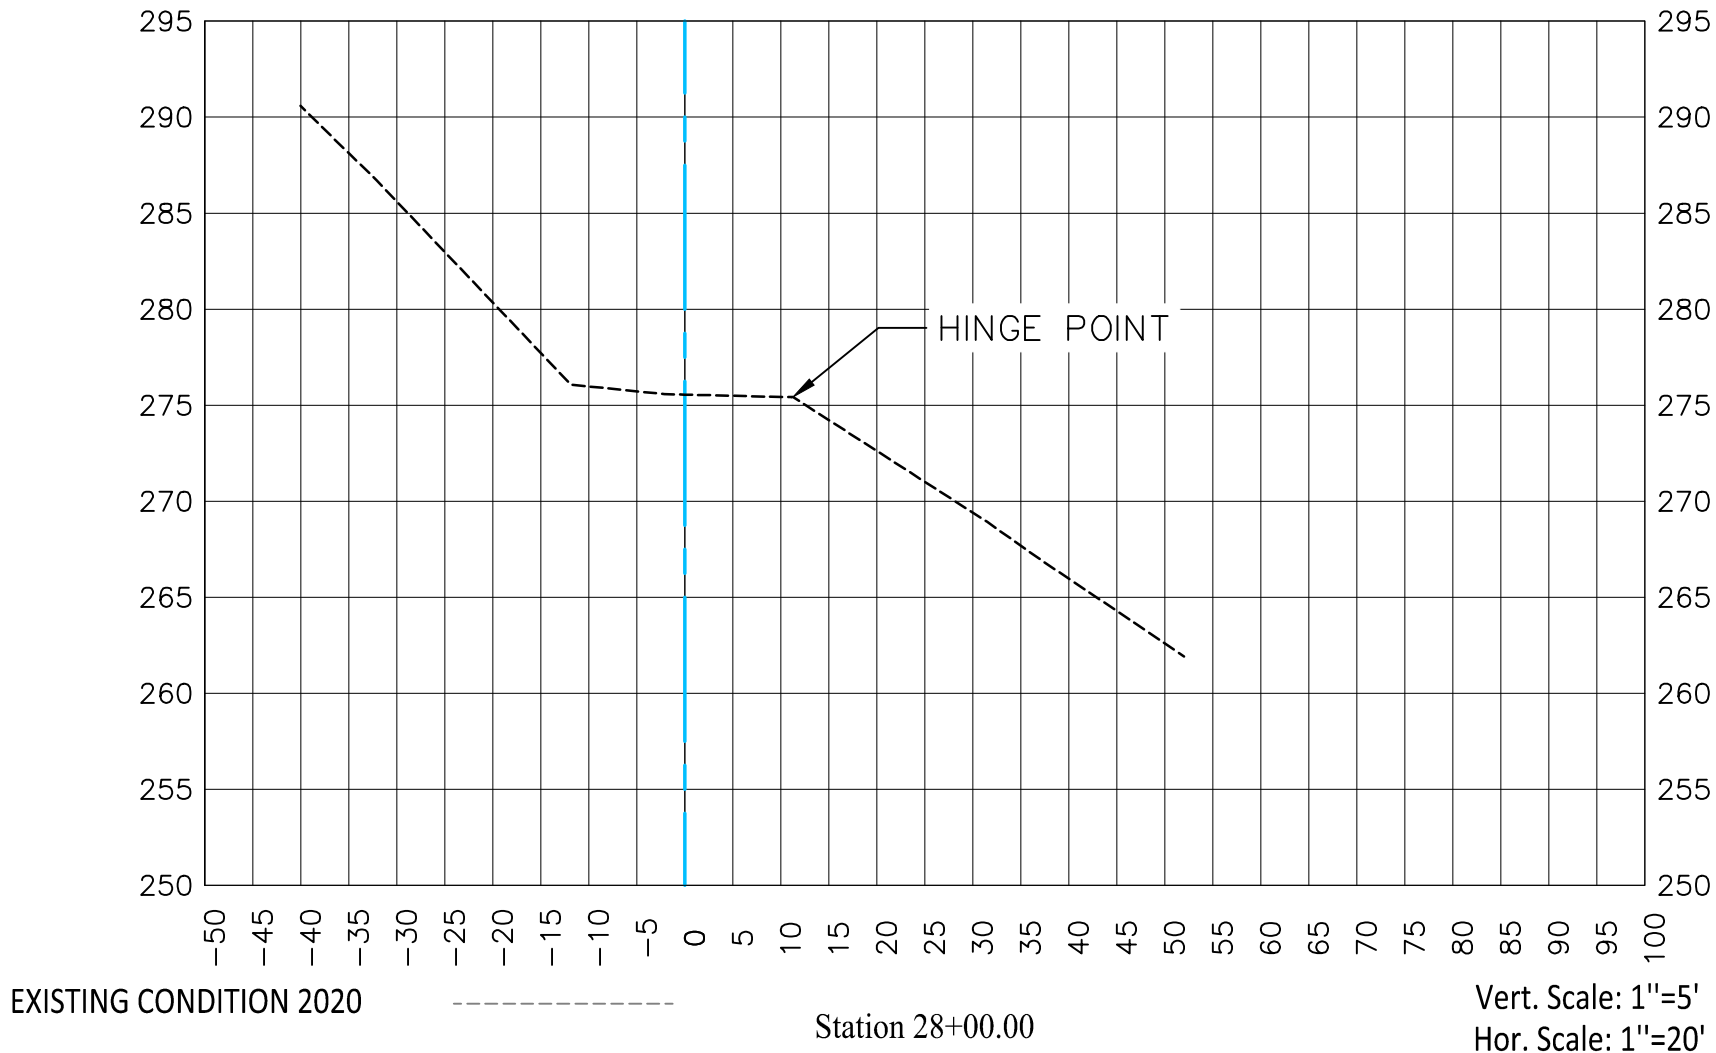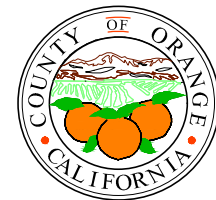


DATE PREPARED: 03/23/2020

U.S. Survey Foot

OC Public Works/Engineering Services
OC Survey/Field Services
Boundary Analysis & Mapping

GALIVAN PERIMETER ROAD CL

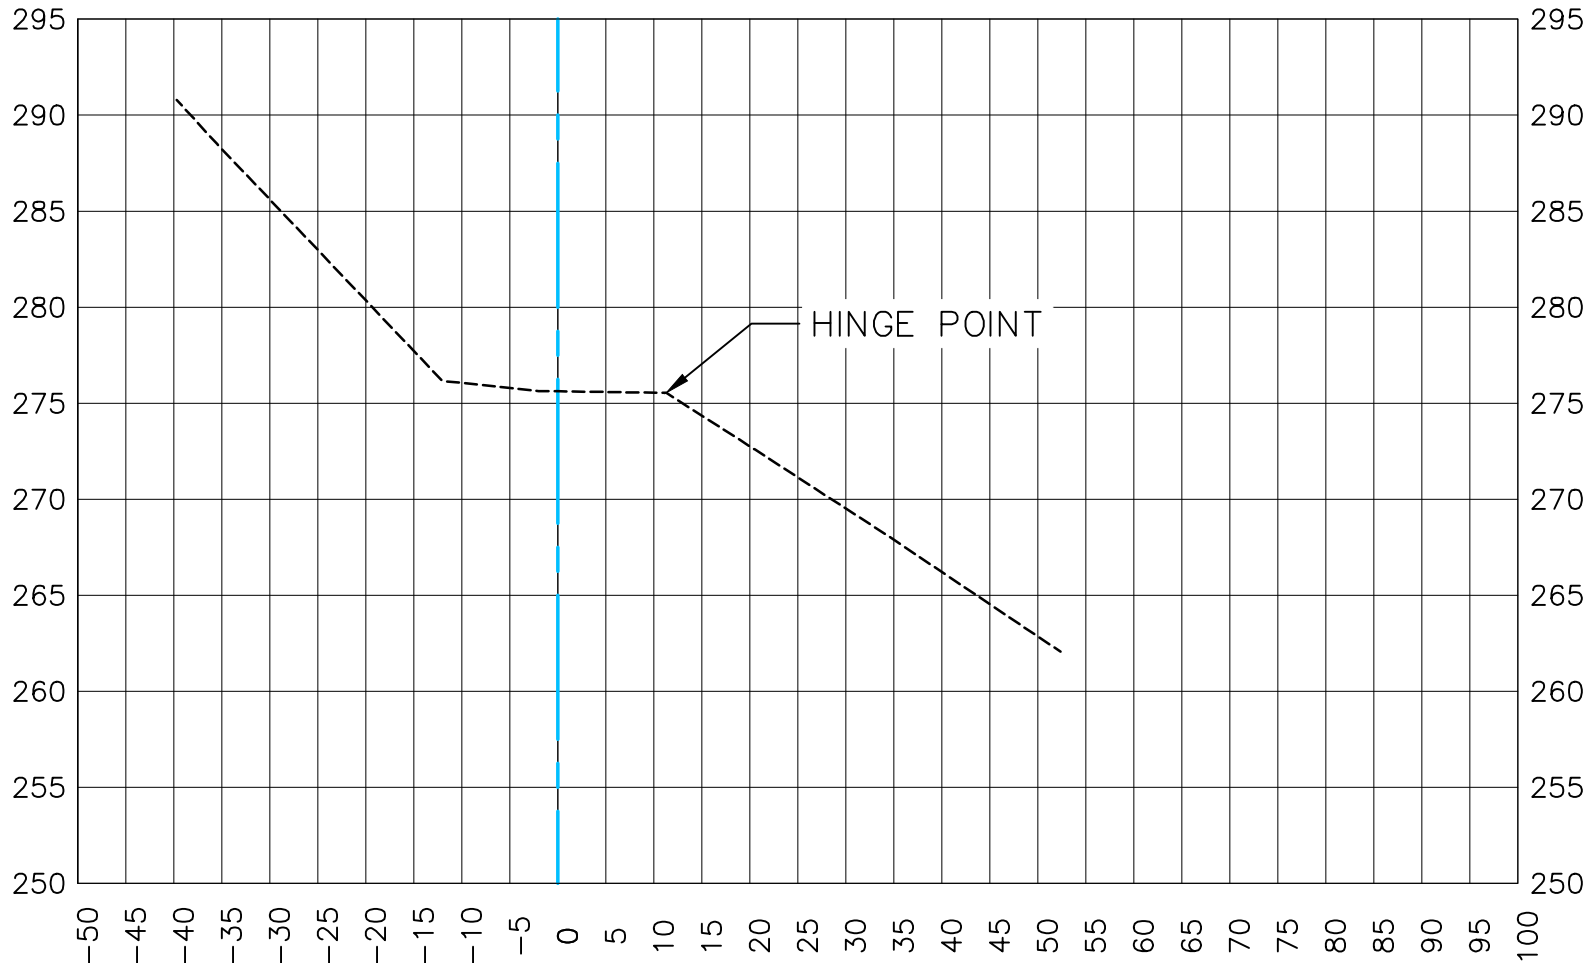

EXISTING CONDITION 2020

Station 28+25.00



Vert. Scale: 1"=5'
Hor. Scale: 1"=20'

DATE PREPARED: 03/23/2020

**U.S. Survey
Foot**

OC Public Works/Engineering Services
OC Survey/Field Services
Boundary Analysis & Mapping

GALIVAN PERIMETER ROAD CL

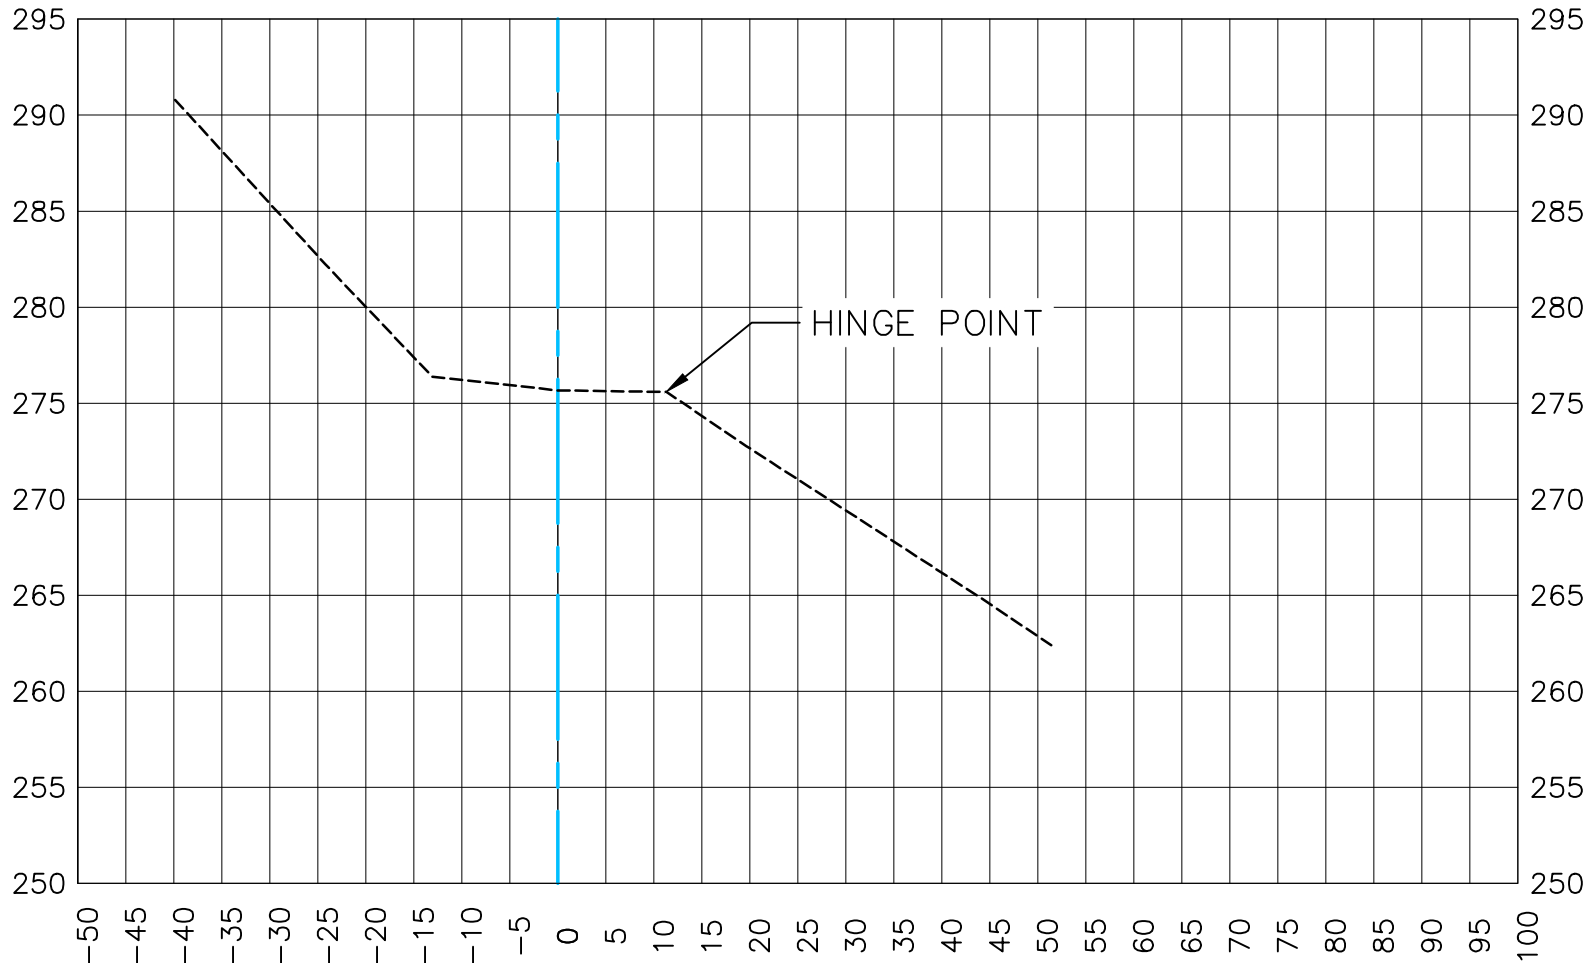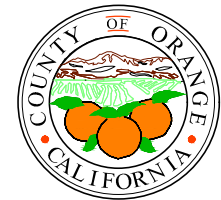

EXISTING CONDITION 2020

Station 28+50.00


Vert. Scale: 1"=5'
Hor. Scale: 1"=20'

DATE PREPARED: 03/23/2020

U.S. Survey Foot

OC Public Works/Engineering Services
OC Survey/Field Services
Boundary Analysis & Mapping

GALIVAN PERIMETER ROAD CL

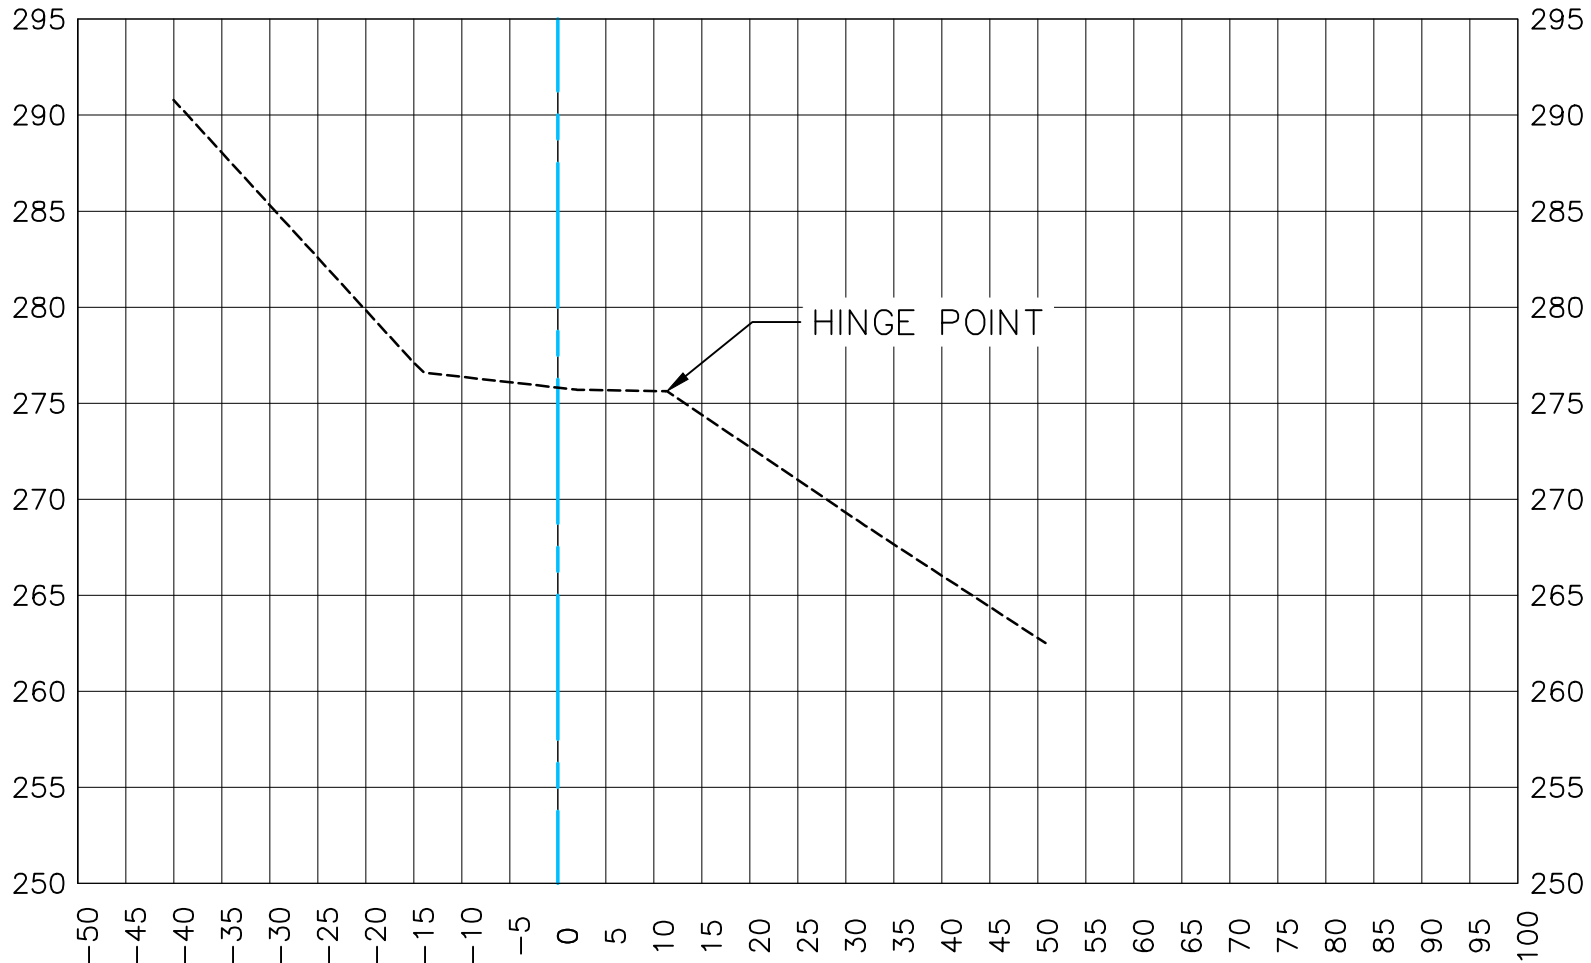

EXISTING CONDITION 2020

Station 28+75.00


Vert. Scale: 1"=5'
Hor. Scale: 1"=20'

DATE PREPARED: 03/23/2020

U.S. Survey Foot

OC Public Works/Engineering Services
OC Survey/Field Services
Boundary Analysis & Mapping

GALIVAN PERIMETER ROAD CL

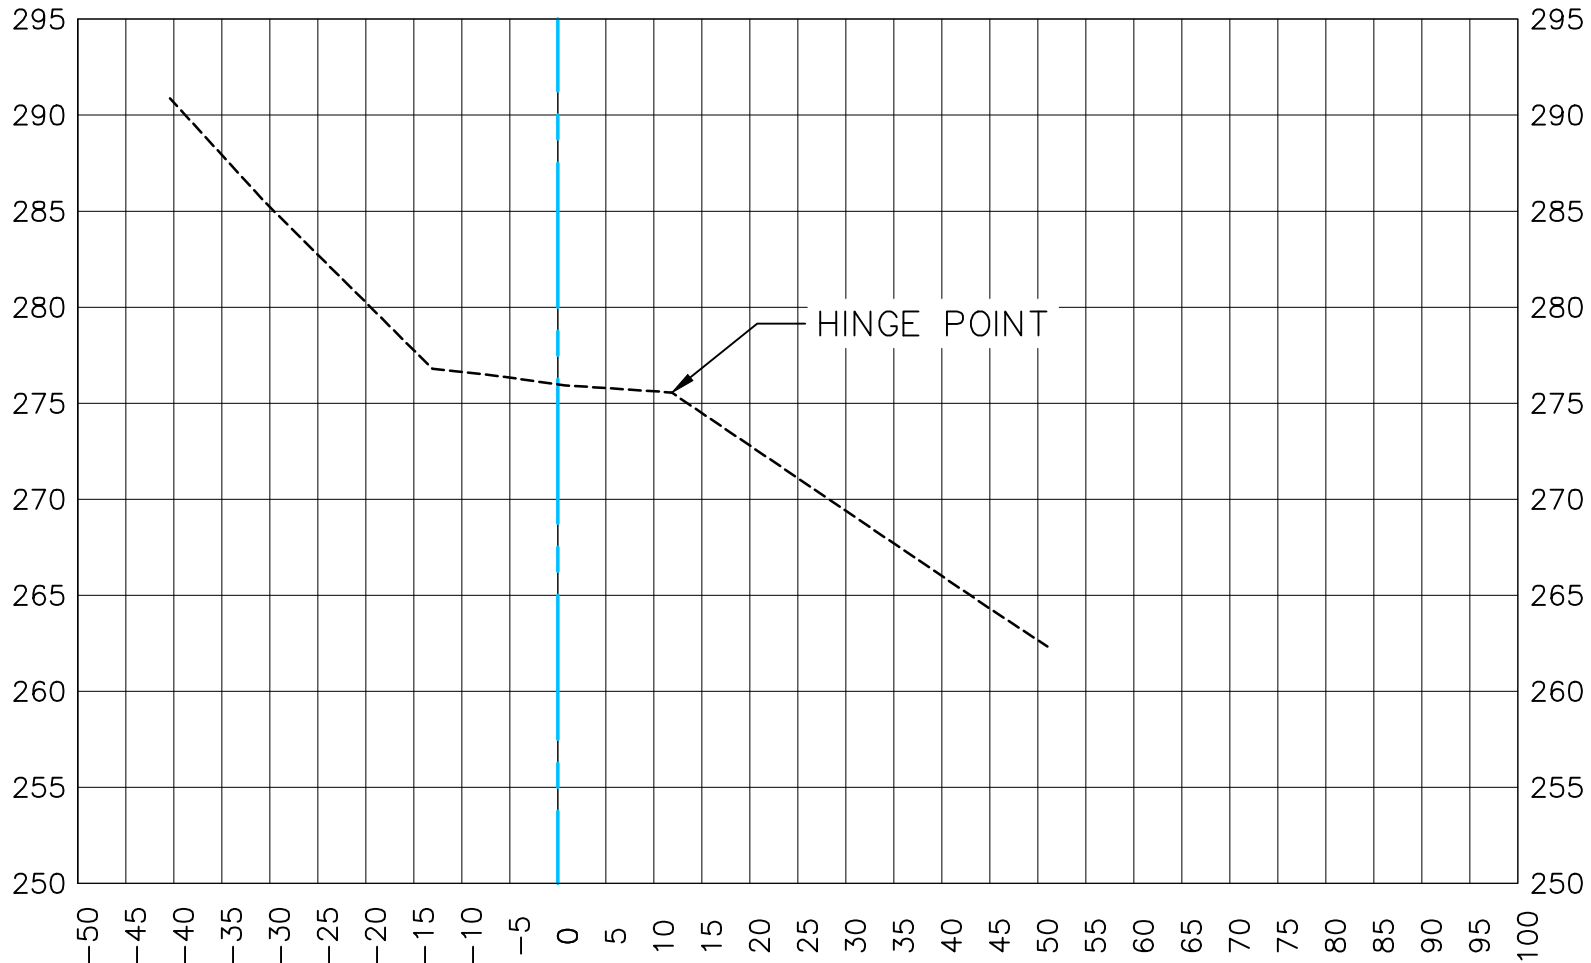


EXISTING CONDITION 2020


Station 29+00.00

Vert. Scale: 1"=5'
Hor. Scale: 1"=20'

DATE PREPARED: 03/23/2020

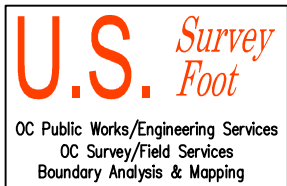

GALIVAN PERIMETER ROAD CL

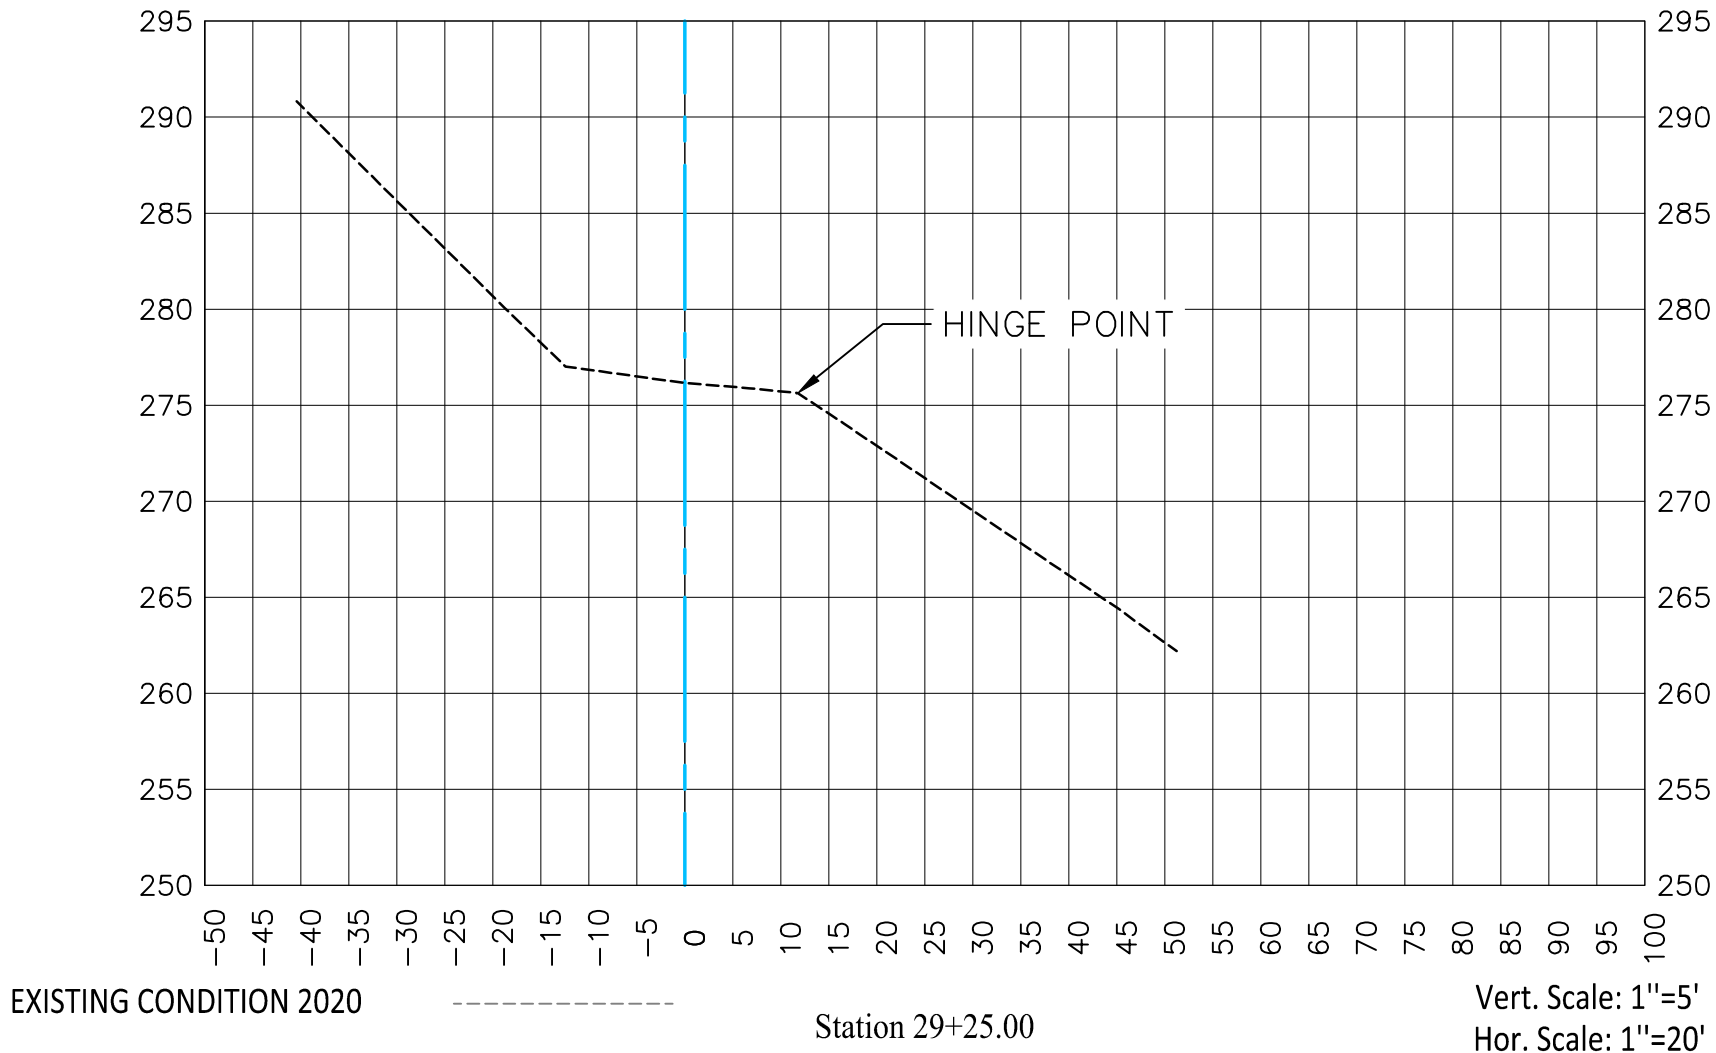


DATE PREPARED: 03/23/2020

U.S. Survey Foot

OC Public Works/Engineering Services
OC Survey/Field Services
Boundary Analysis & Mapping

GALIVAN PERIMETER ROAD CL

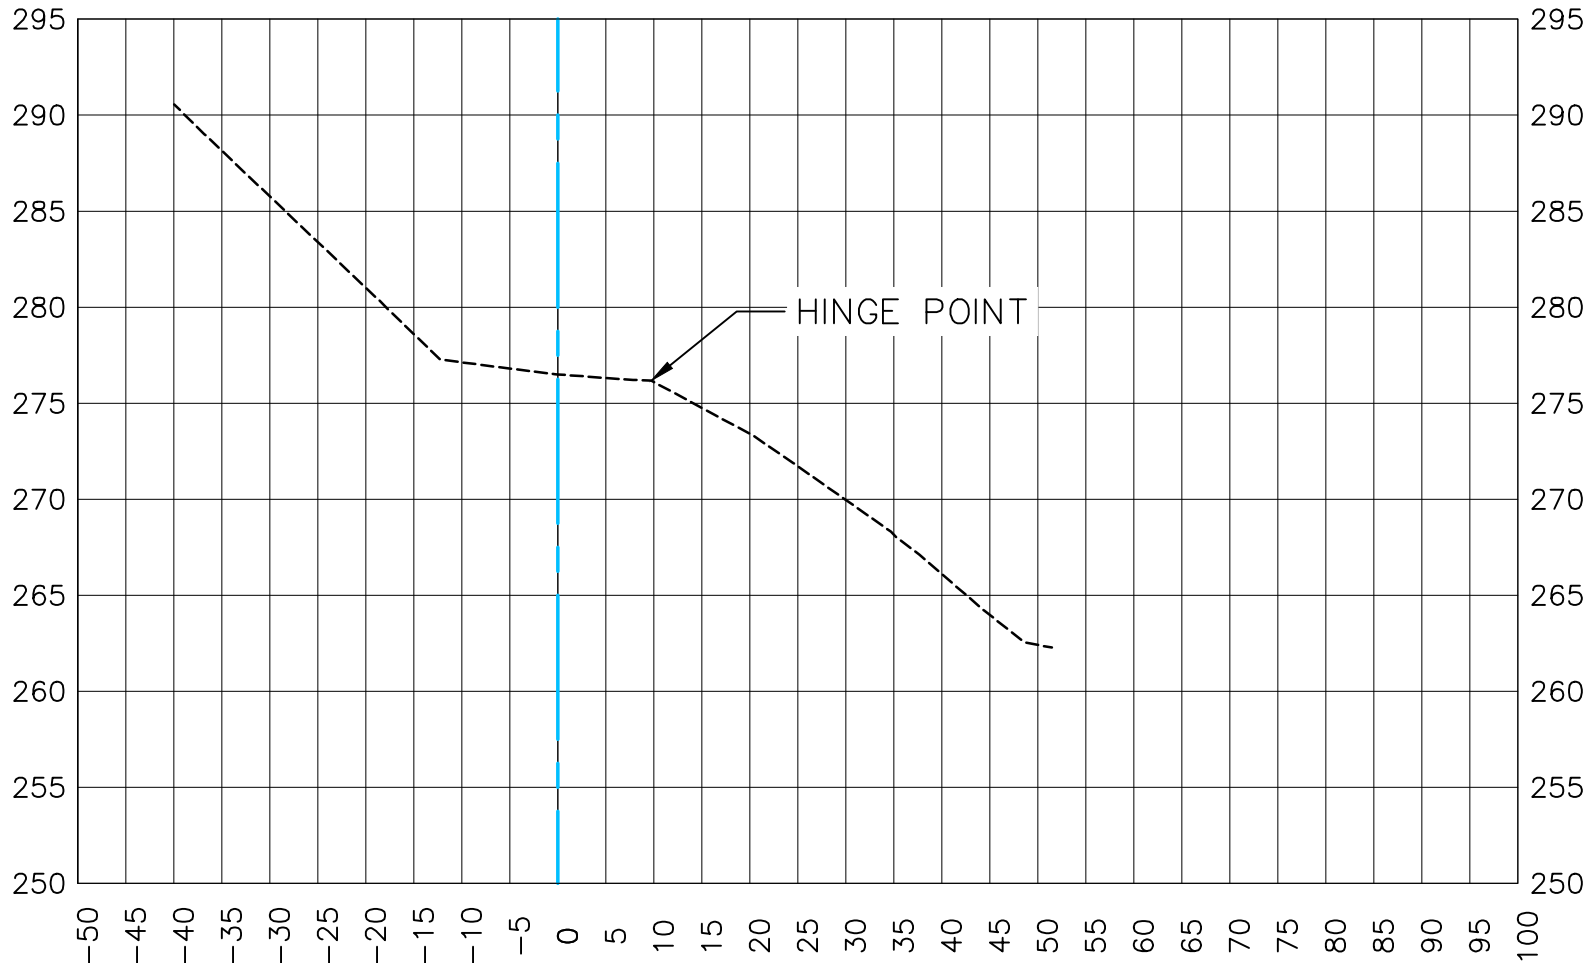


EXISTING CONDITION 2020


Station 29+50.00

Vert. Scale: 1"=5'
Hor. Scale: 1"=20'

DATE PREPARED: 03/23/2020

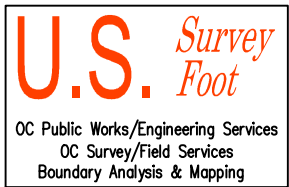


GALIVAN PERIMETER ROAD CL

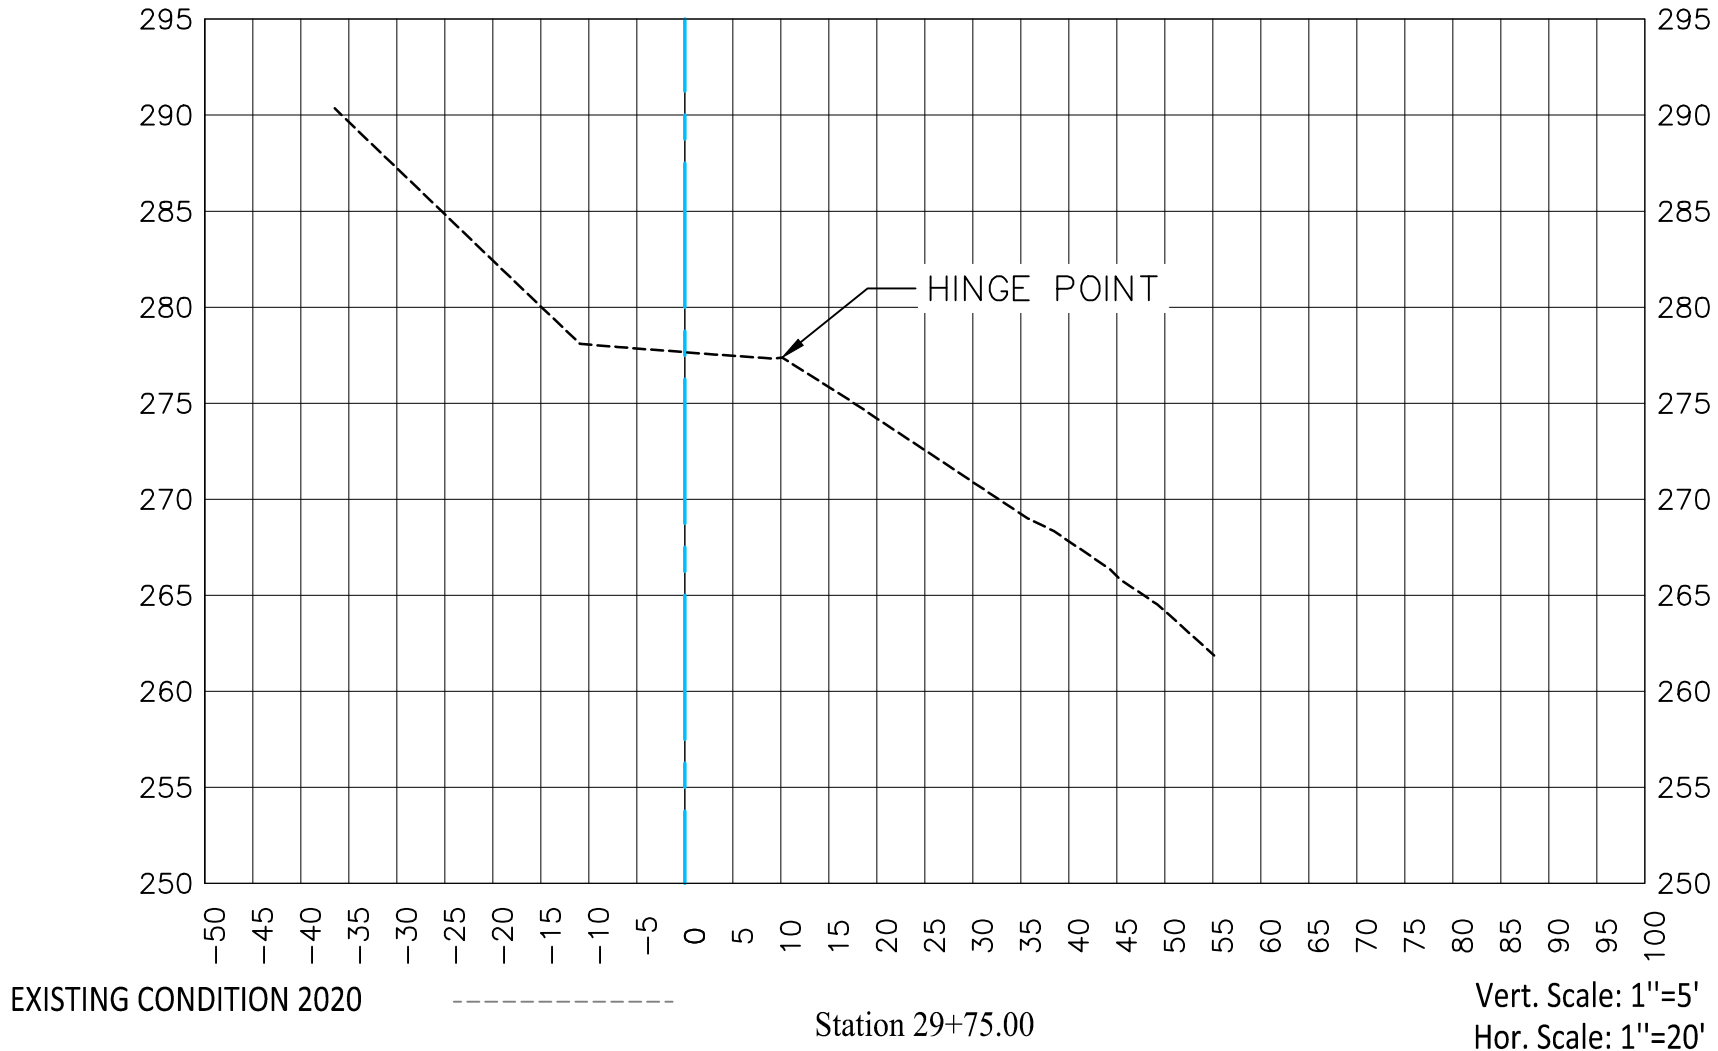

DATE PREPARED: 03/23/2020



GALIVAN PERIMETER ROAD CL


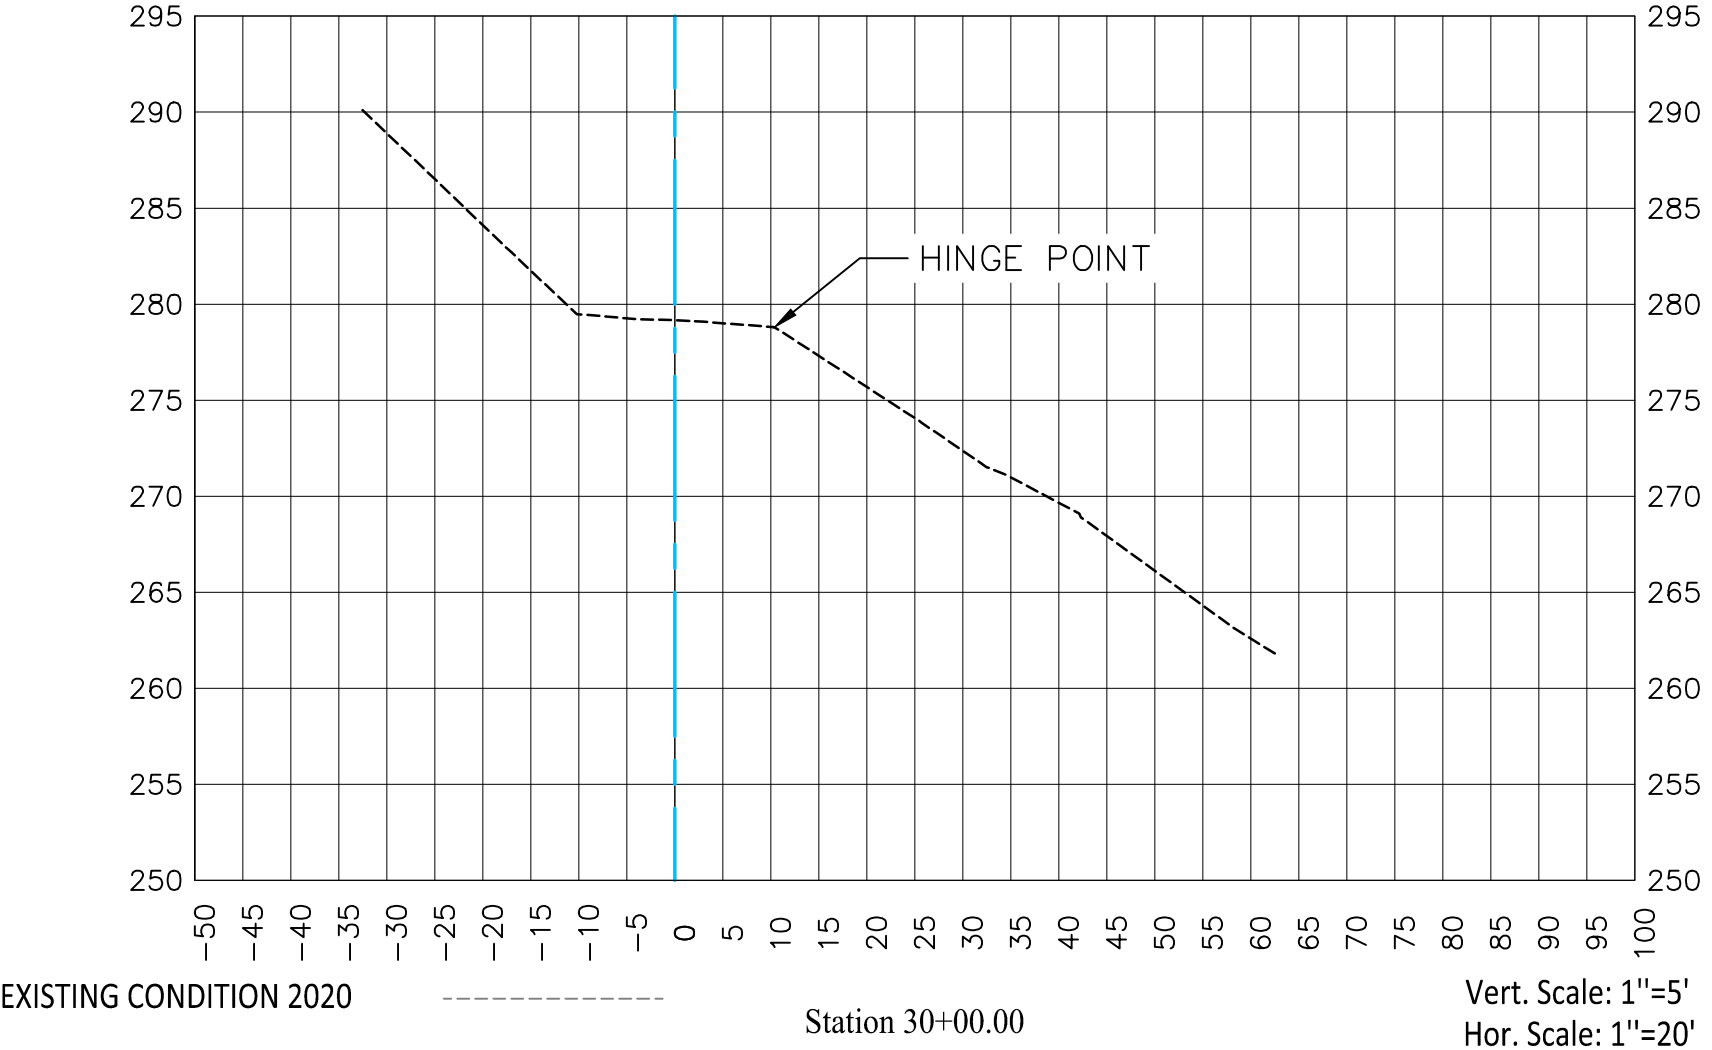


DATE PREPARED: 03/23/2020

U.S. Survey Foot

OC Public Works/Engineering Services
OC Survey/Field Services
Boundary Analysis & Mapping

GALIVAN PERIMETER ROAD CL

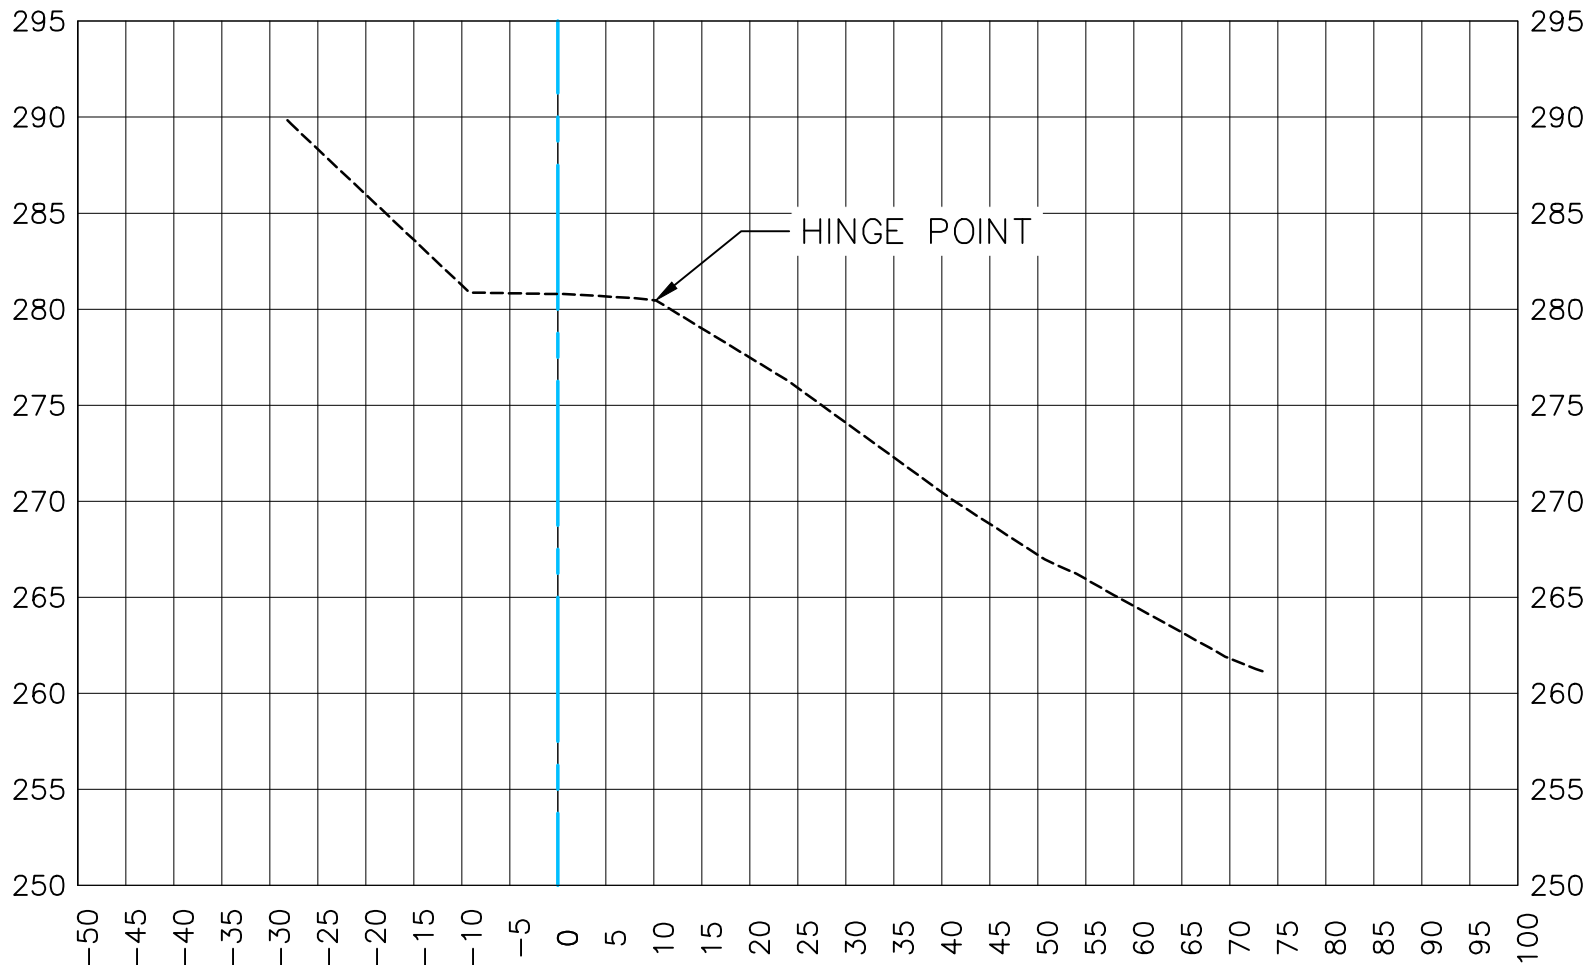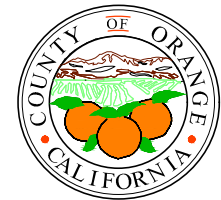

EXISTING CONDITION 2020

Station 30+25.00



Vert. Scale: 1"=5'
Hor. Scale: 1"=20'

DATE PREPARED: 03/23/2020

U.S. Survey Foot

OC Public Works/Engineering Services
OC Survey/Field Services
Boundary Analysis & Mapping

GALIVAN PERIMETER ROAD CL

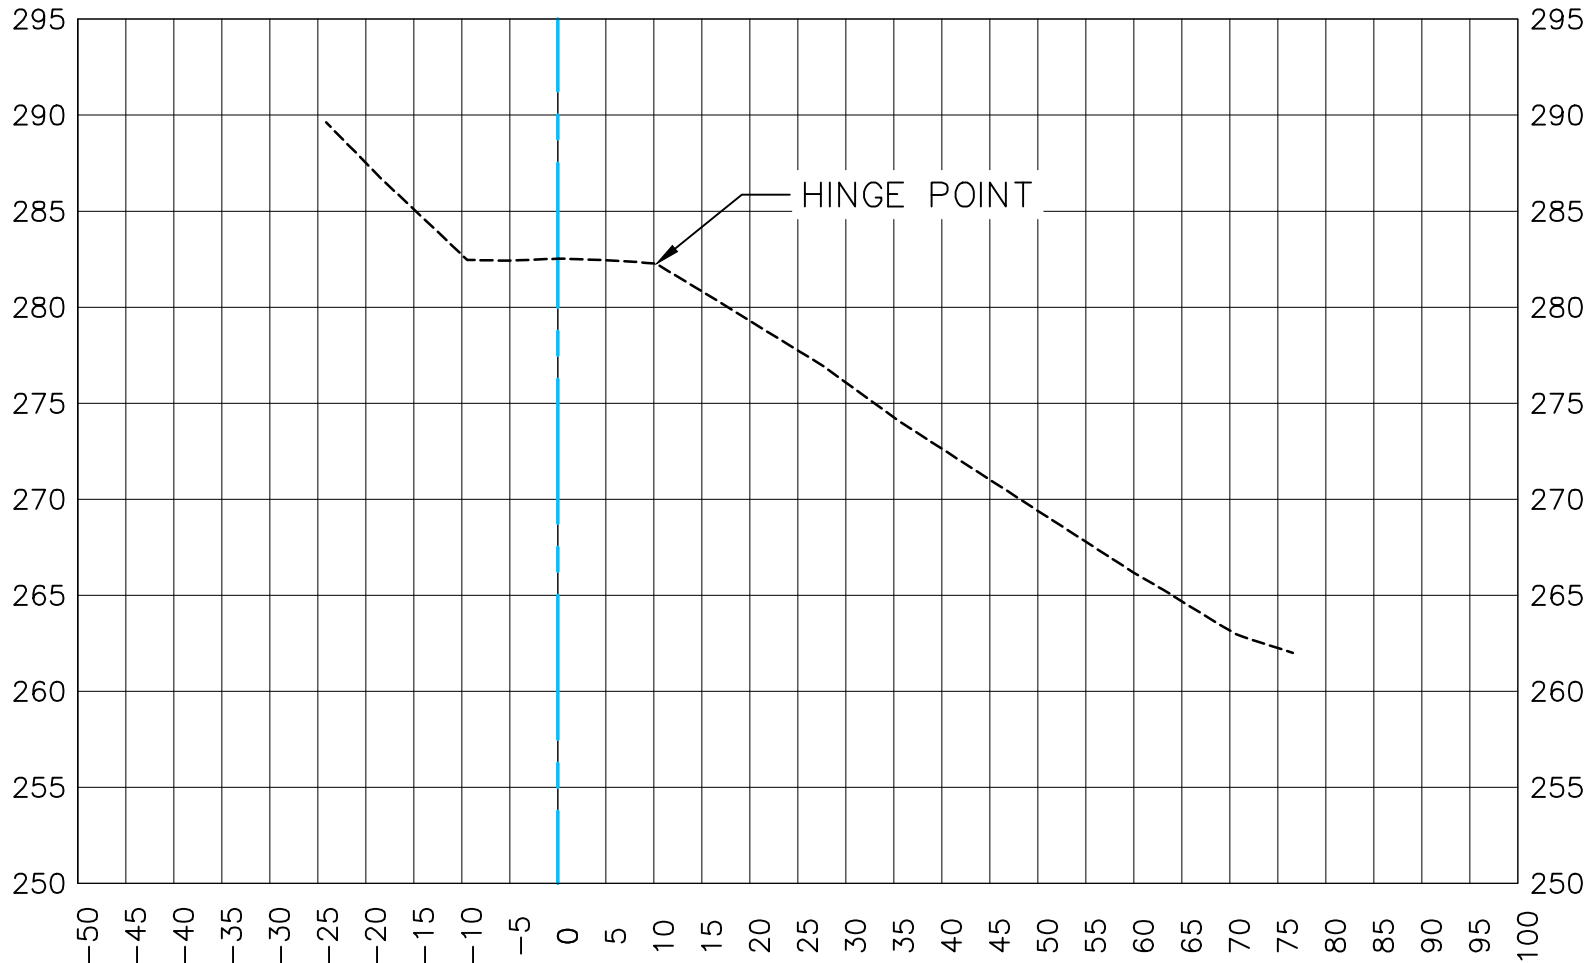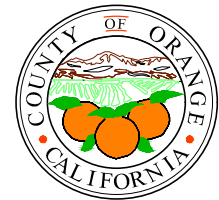

EXISTING CONDITION 2020

Station 30+50.00


Vert. Scale: 1"=5'
Hor. Scale: 1"=20'

DATE PREPARED: 03/23/2020

U.S. Survey Foot

OC Public Works/Engineering Services
OC Survey/Field Services
Boundary Analysis & Mapping

GALIVAN PERIMETER ROAD CL

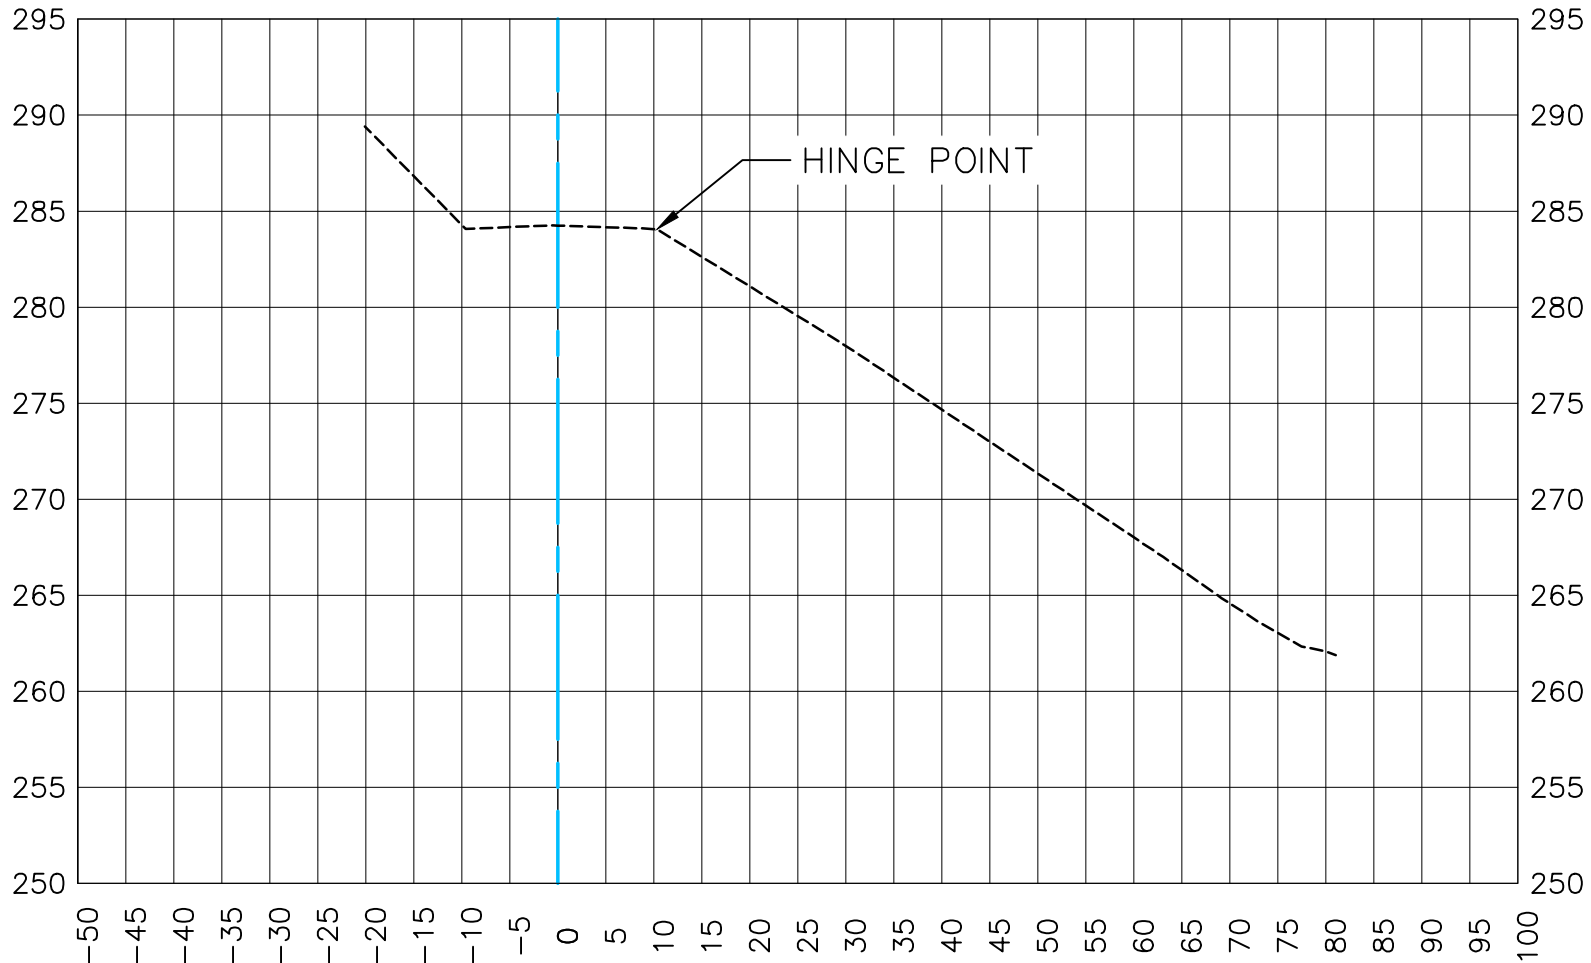

EXISTING CONDITION 2020

Station 30+75.00


Vert. Scale: 1"=5'
Hor. Scale: 1"=20'

DATE PREPARED: 03/23/2020

U.S. Survey Foot

OC Public Works/Engineering Services
OC Survey/Field Services
Boundary Analysis & Mapping

GALIVAN PERIMETER ROAD CL

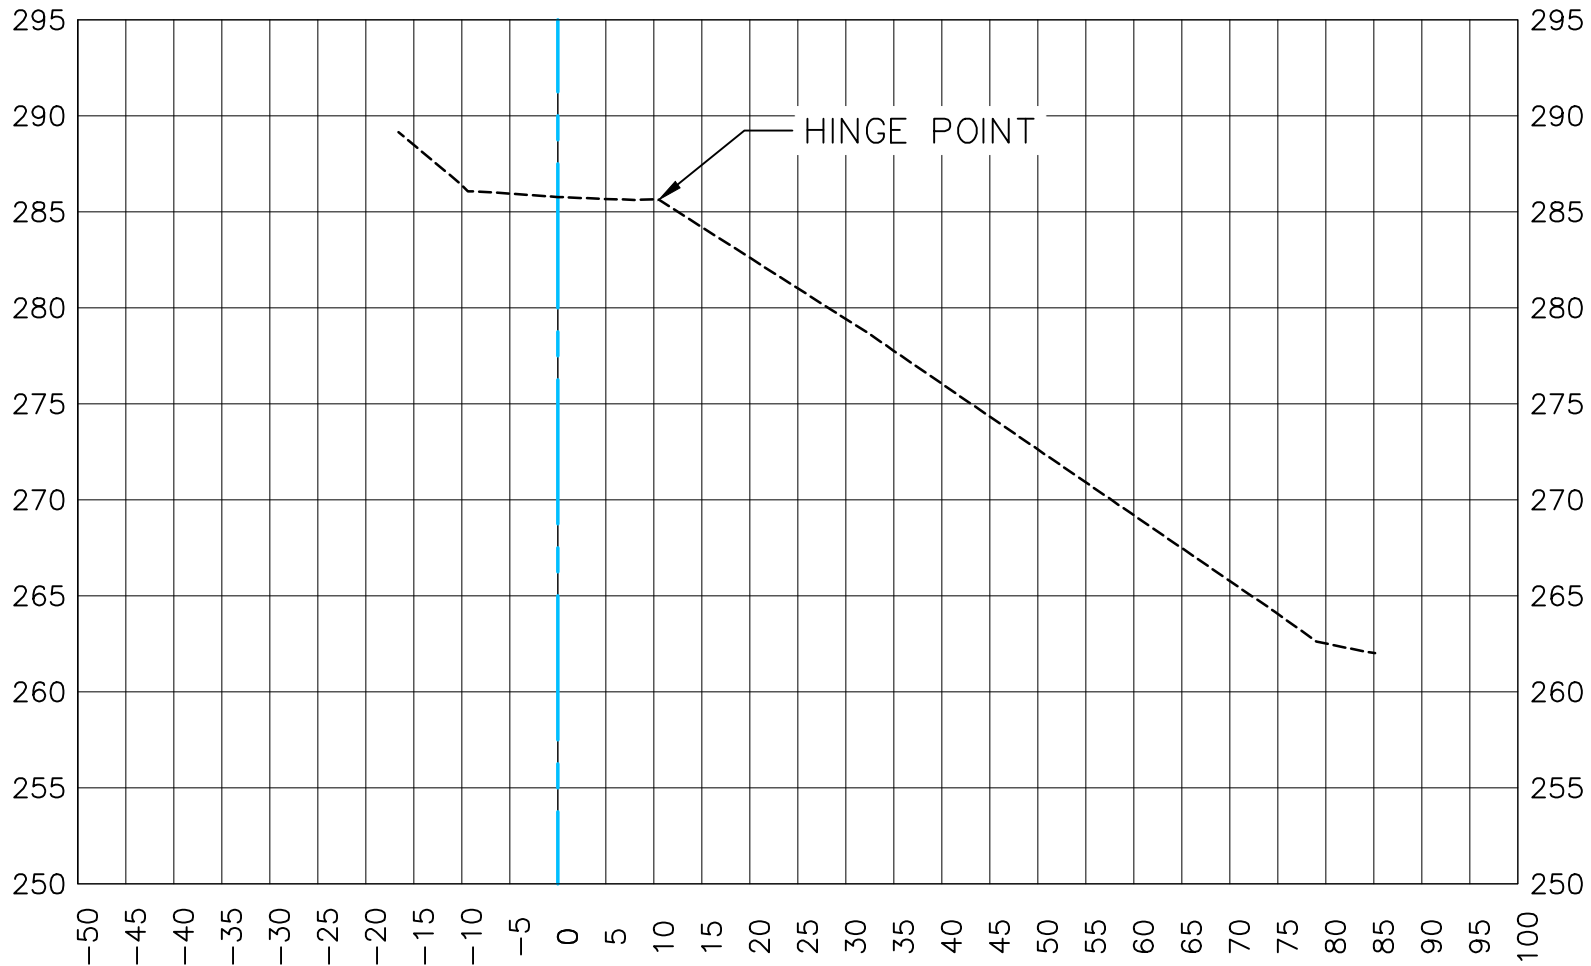


EXISTING CONDITION 2020



Station 31+00.00

Vert. Scale: 1"=5'
Hor. Scale: 1"=20'

DATE PREPARED: 03/23/2020

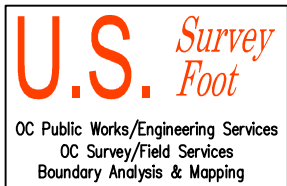

GALIVAN PERIMETER ROAD CL

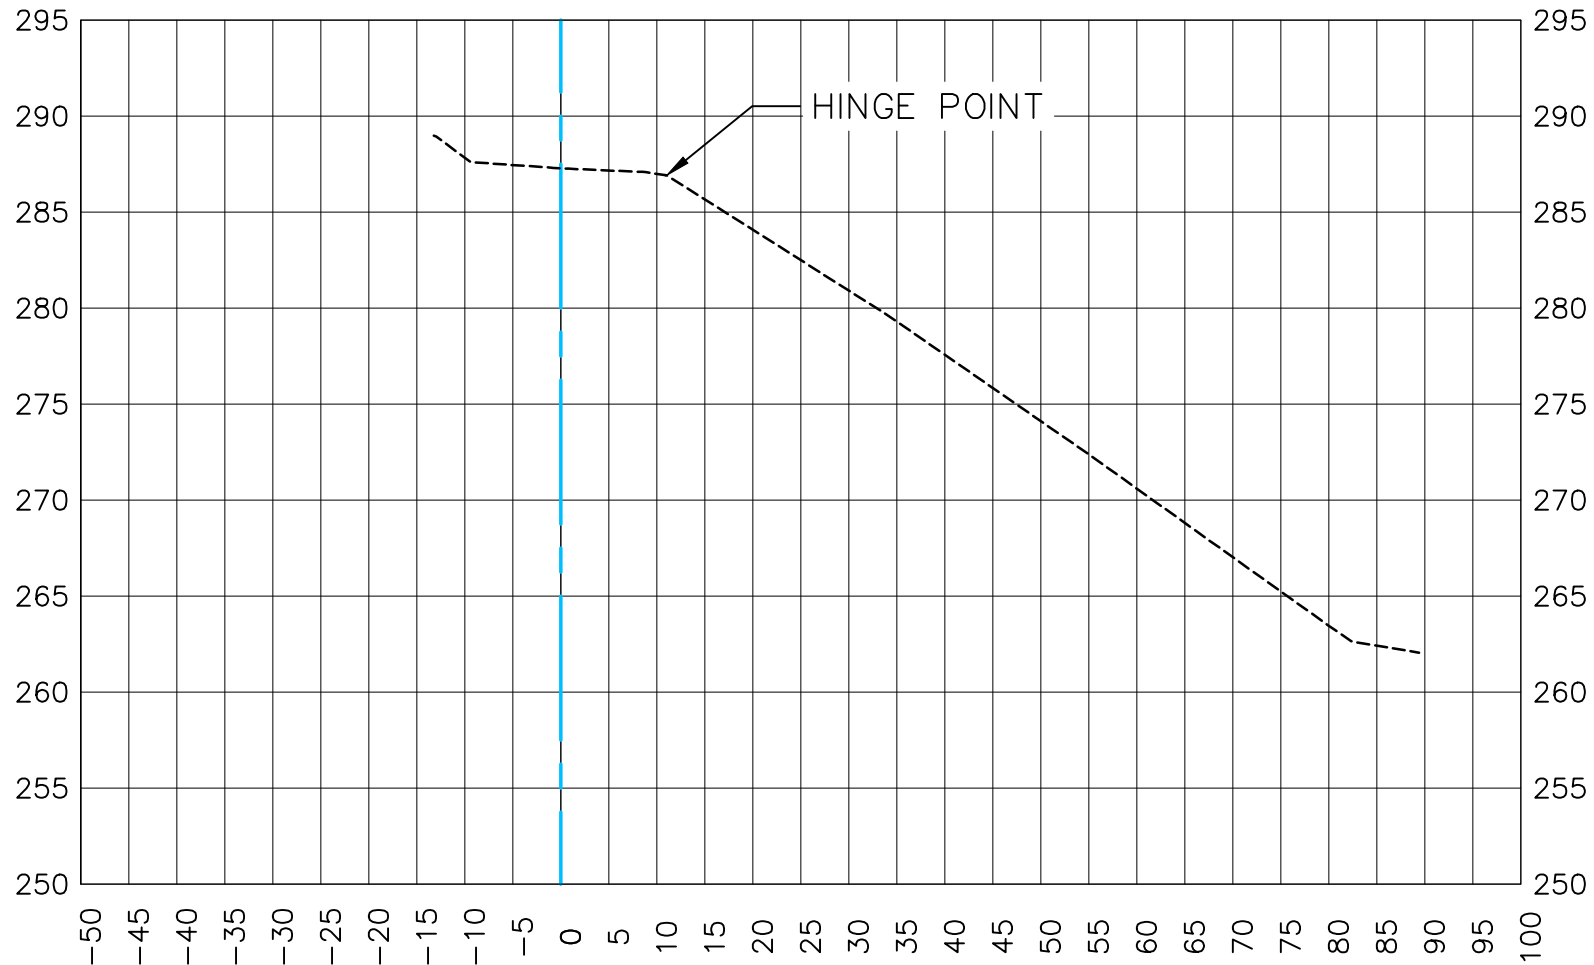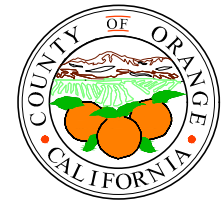

EXISTING CONDITION 2020

Station 31+25.00

Vert. Scale: 1"=5'


Hor. Scale: 1"=20'

DATE PREPARED: 03/23/2020

U.S. Survey Foot

OC Public Works/Engineering Services
OC Survey/Field Services
Boundary Analysis & Mapping

GALIVAN PERIMETER ROAD CL

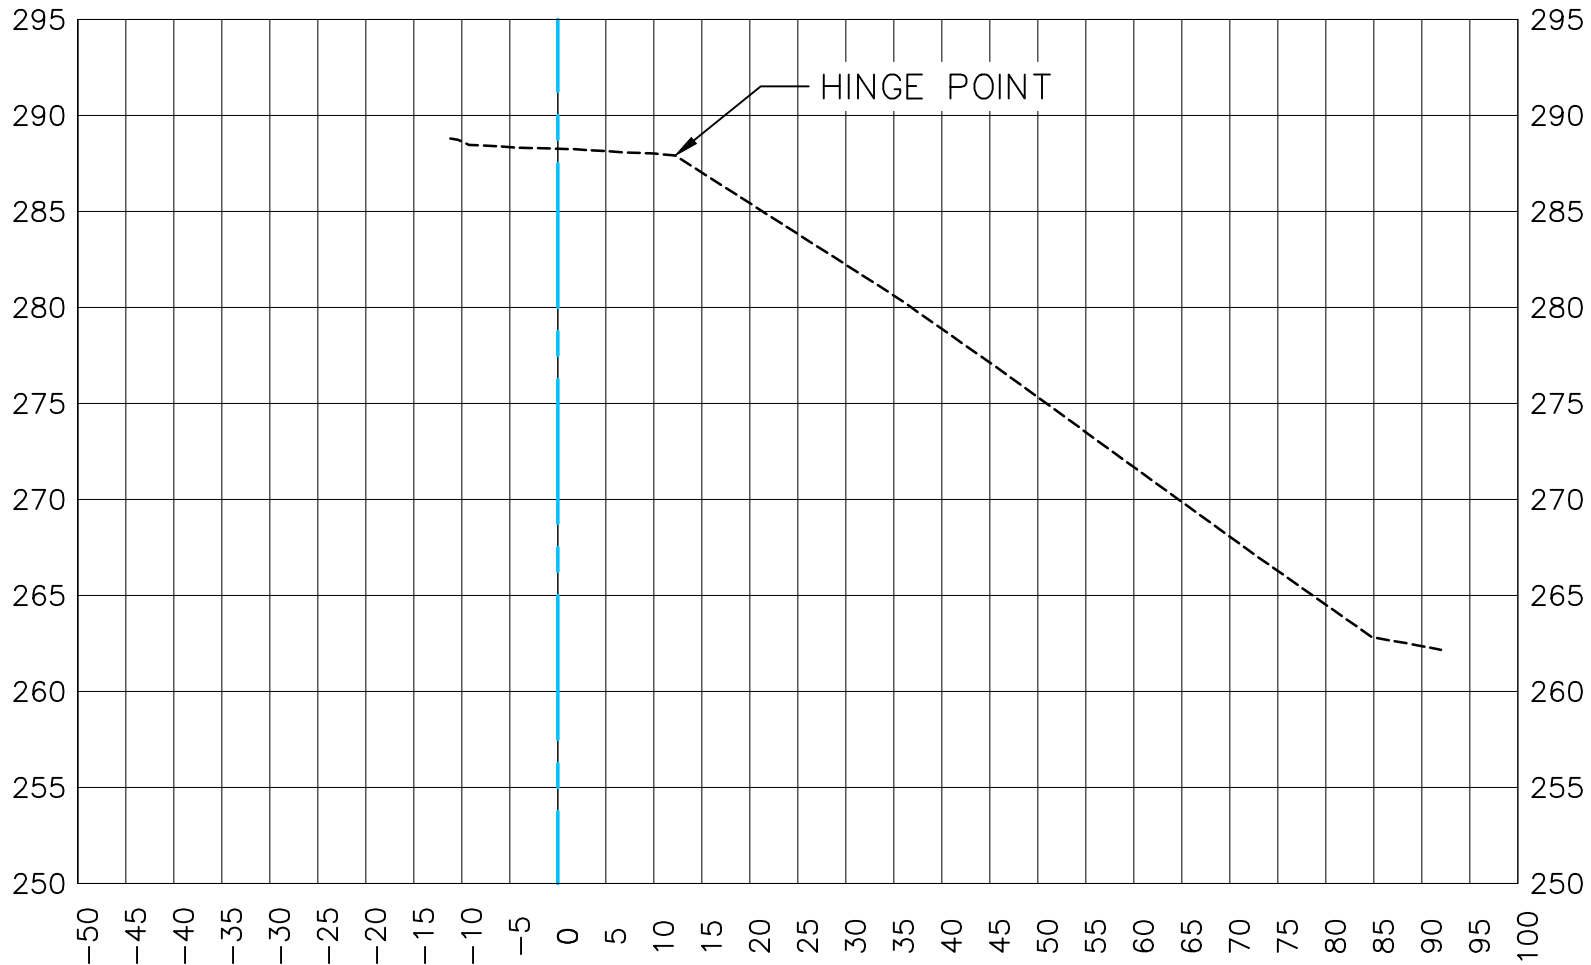


EXISTING CONDITION 2020



Station 31+50.00

Vert. Scale: 1"=5'
Hor. Scale: 1"=20'

DATE PREPARED: 03/23/2020

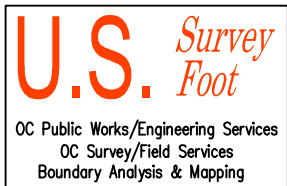

GALIVAN PERIMETER ROAD CL

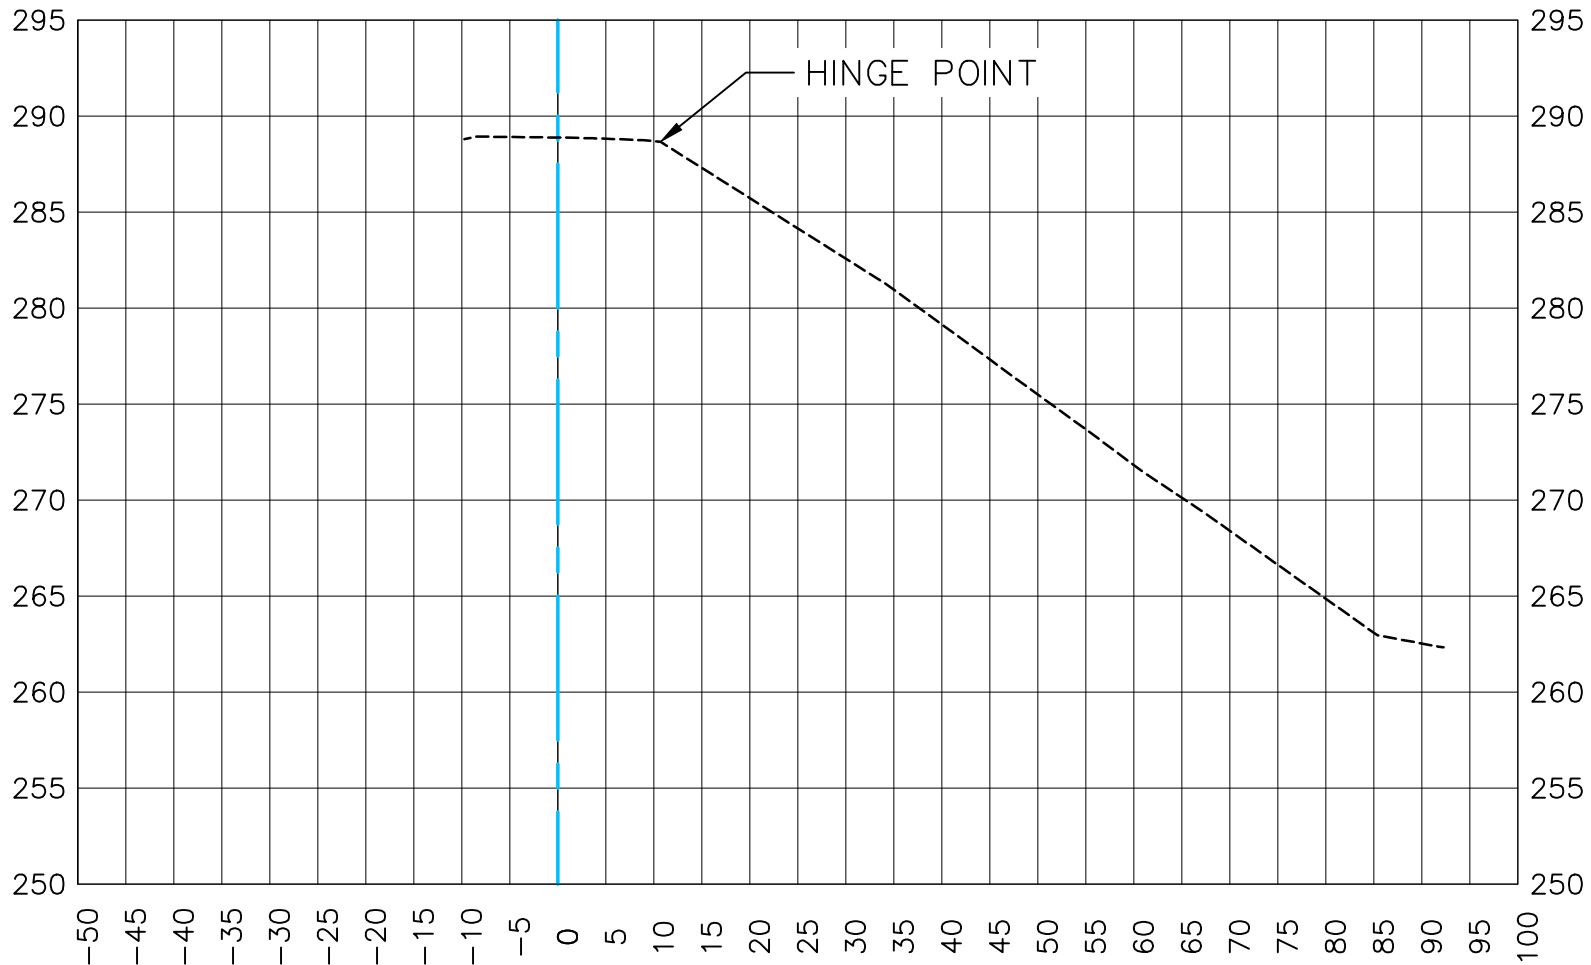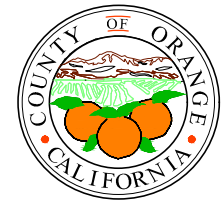

EXISTING CONDITION 2020

Station 31+75.00

Vert. Scale: 1"=5'


Hor. Scale: 1"=20'

DATE PREPARED: 03/23/2020


U.S. Survey Foot

OC Public Works/Engineering Services
OC Survey/Field Services
Boundary Analysis & Mapping


GALIVAN PERIMETER ROAD CL

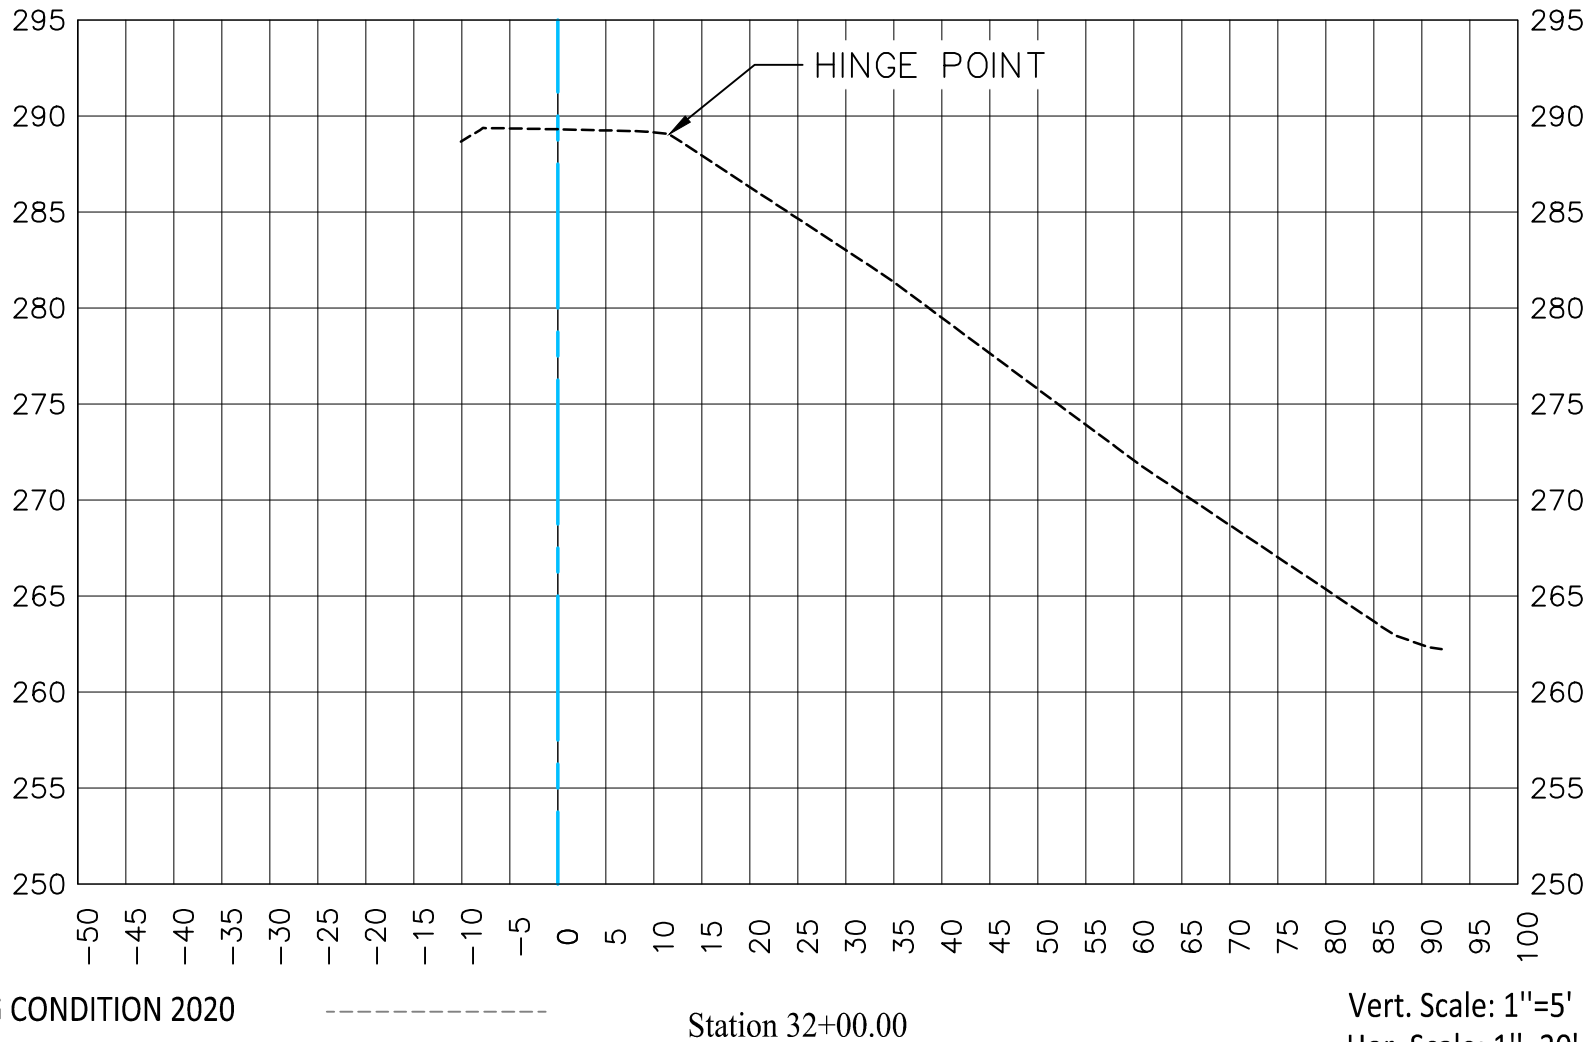

DATE PREPARED: 03/23/2020

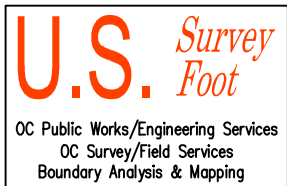

GALIVAN PERIMETER ROAD CL

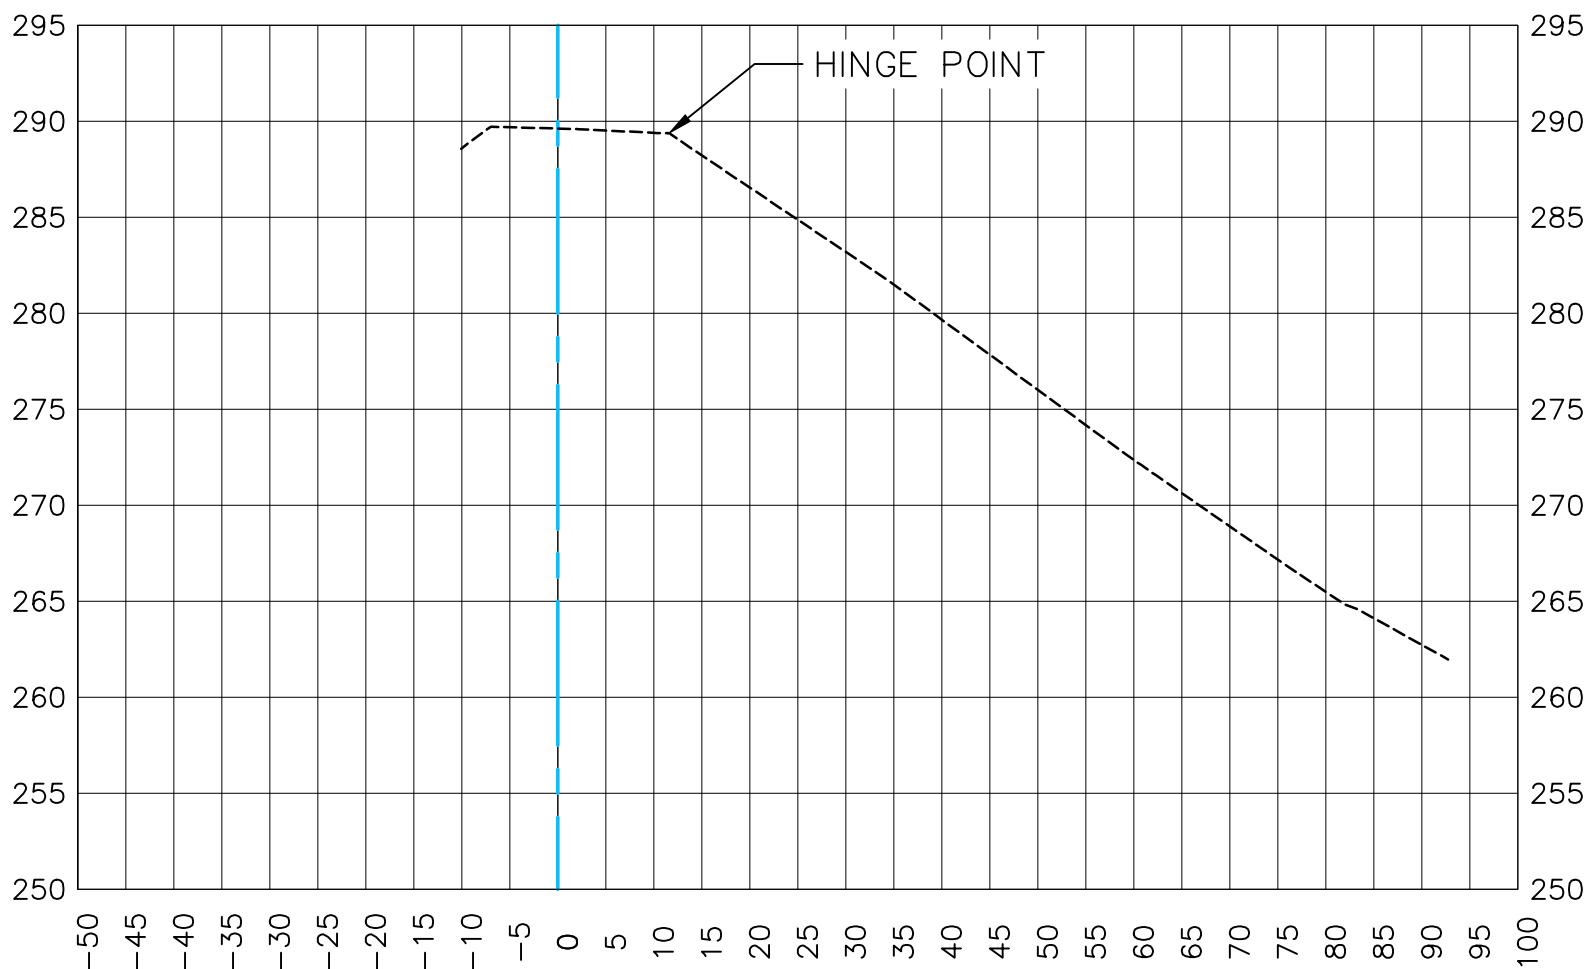

EXISTING CONDITION 2020

Station 32+25.00

Vert. Scale: 1"=5'



Hor. Scale: 1"=20'

DATE PREPARED: 03/23/2020

U.S. *Survey Foot*

OC Public Works/Engineering Services
OC Survey/Field Services
Boundary Analysis & Mapping

GALIVAN PERIMETER ROAD CL

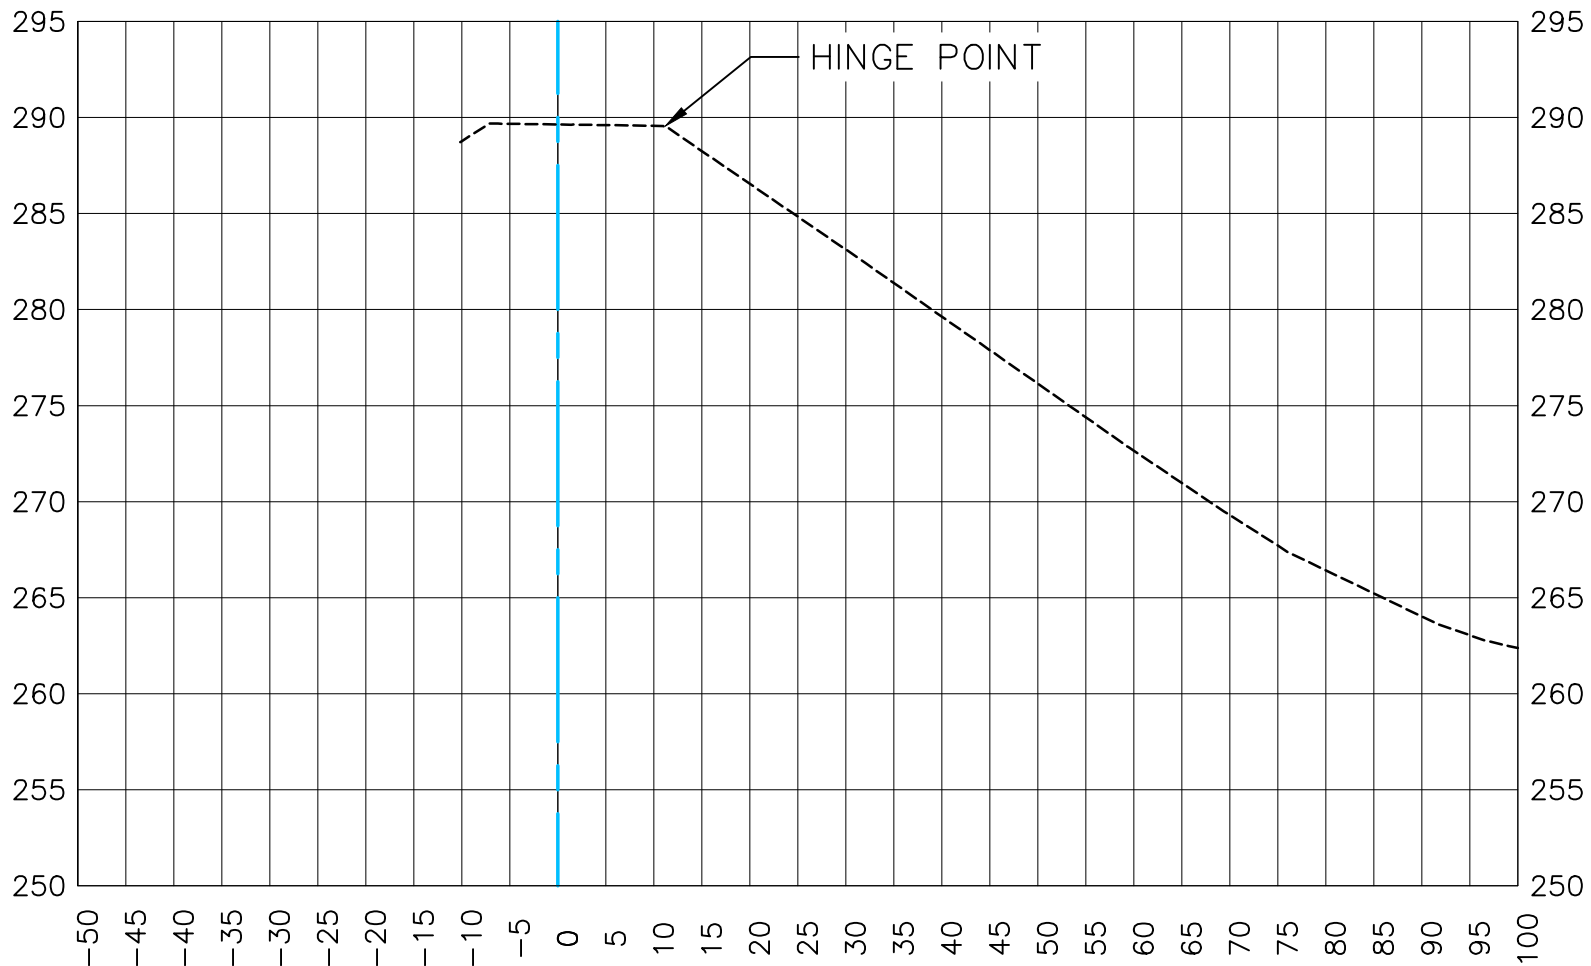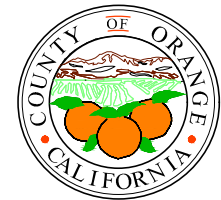


EXISTING CONDITION 2020

Station 32+50.00


Vert. Scale: 1"=5'

Hor. Scale: 1"=20'

DATE PREPARED: 03/23/2020

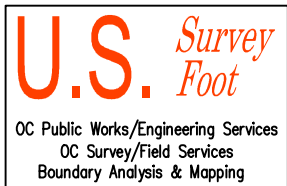

GALIVAN PERIMETER ROAD CL

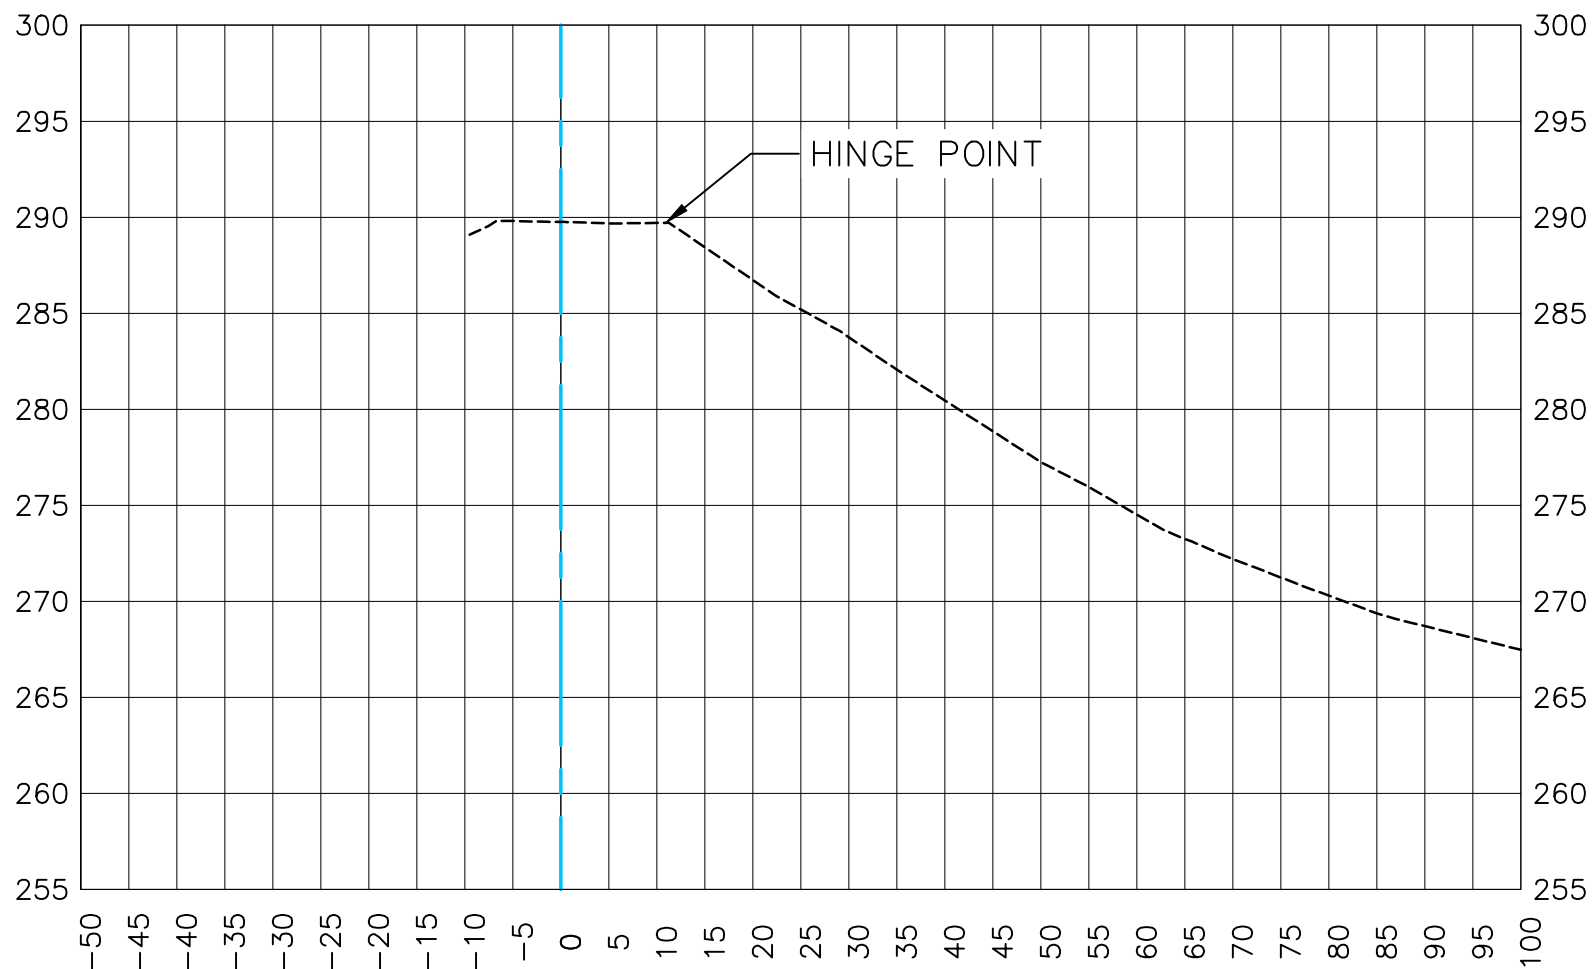

EXISTING CONDITION 2020

Station 32+75.00

Vert. Scale: 1"=5'



Hor. Scale: 1"=20'

DATE PREPARED: 03/23/2020

**U.S. Survey
Foot**

OC Public Works/Engineering Services
OC Survey/Field Services
Boundary Analysis & Mapping

GALIVAN PERIMETER ROAD CL

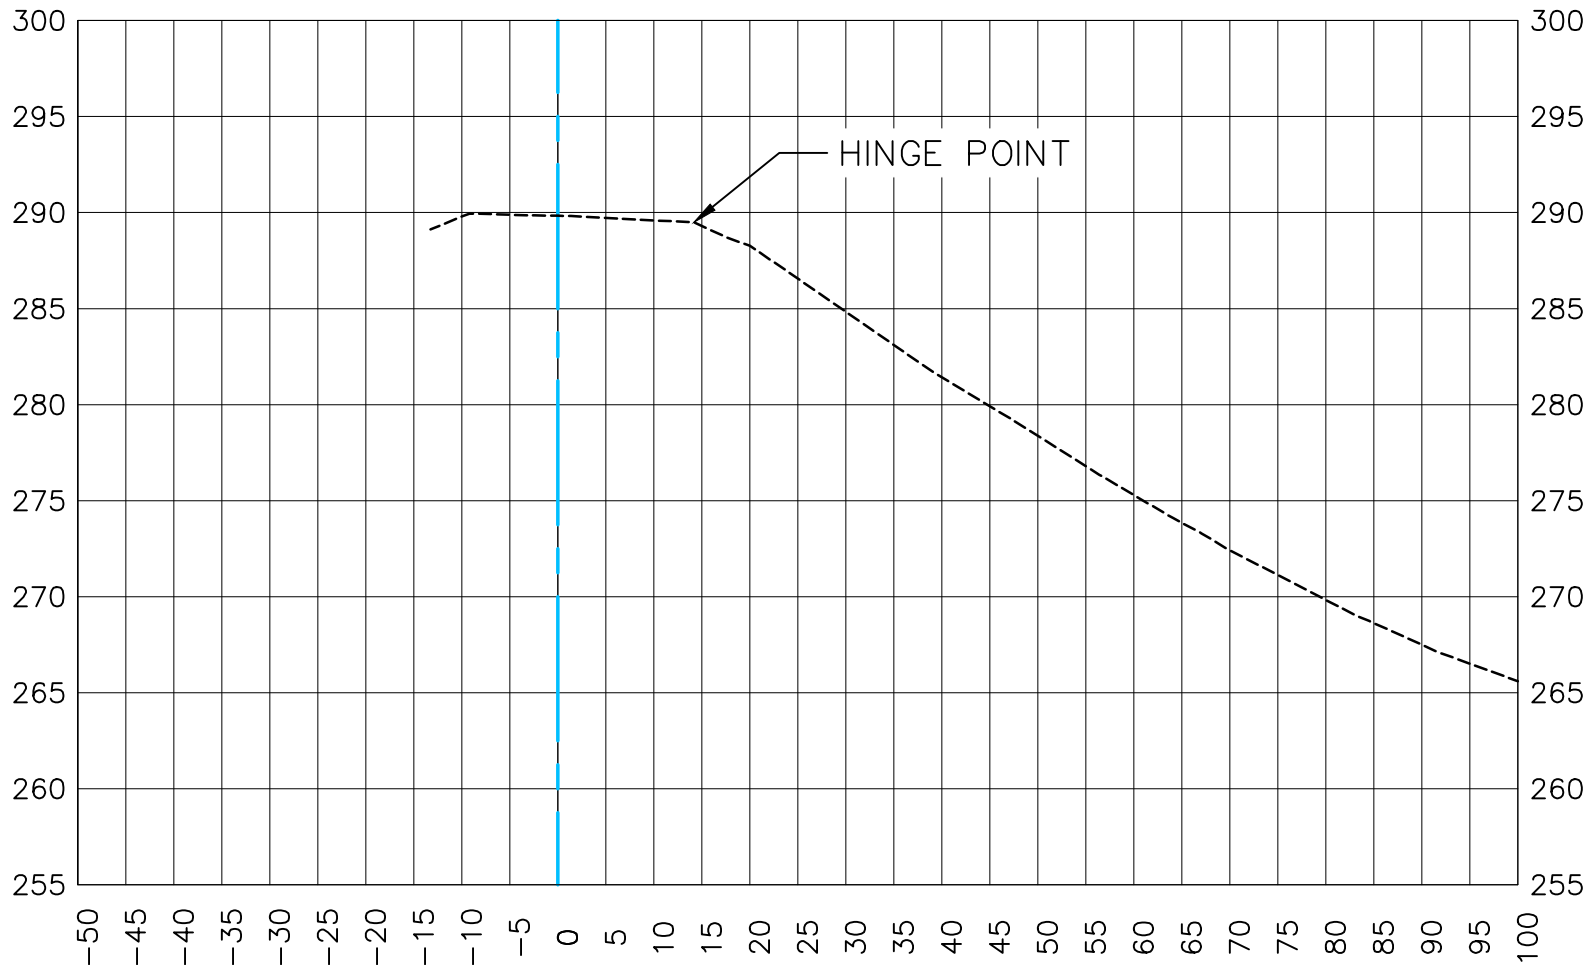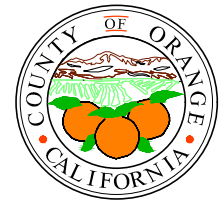


EXISTING CONDITION 2020


Station 33+00.00

Vert. Scale: 1"=5'
Hor. Scale: 1"=20'

DATE PREPARED: 03/23/2020

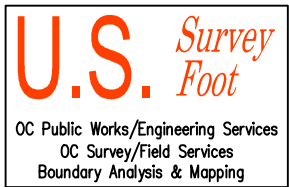

GALIVAN
PERIMETER ROAD
CL


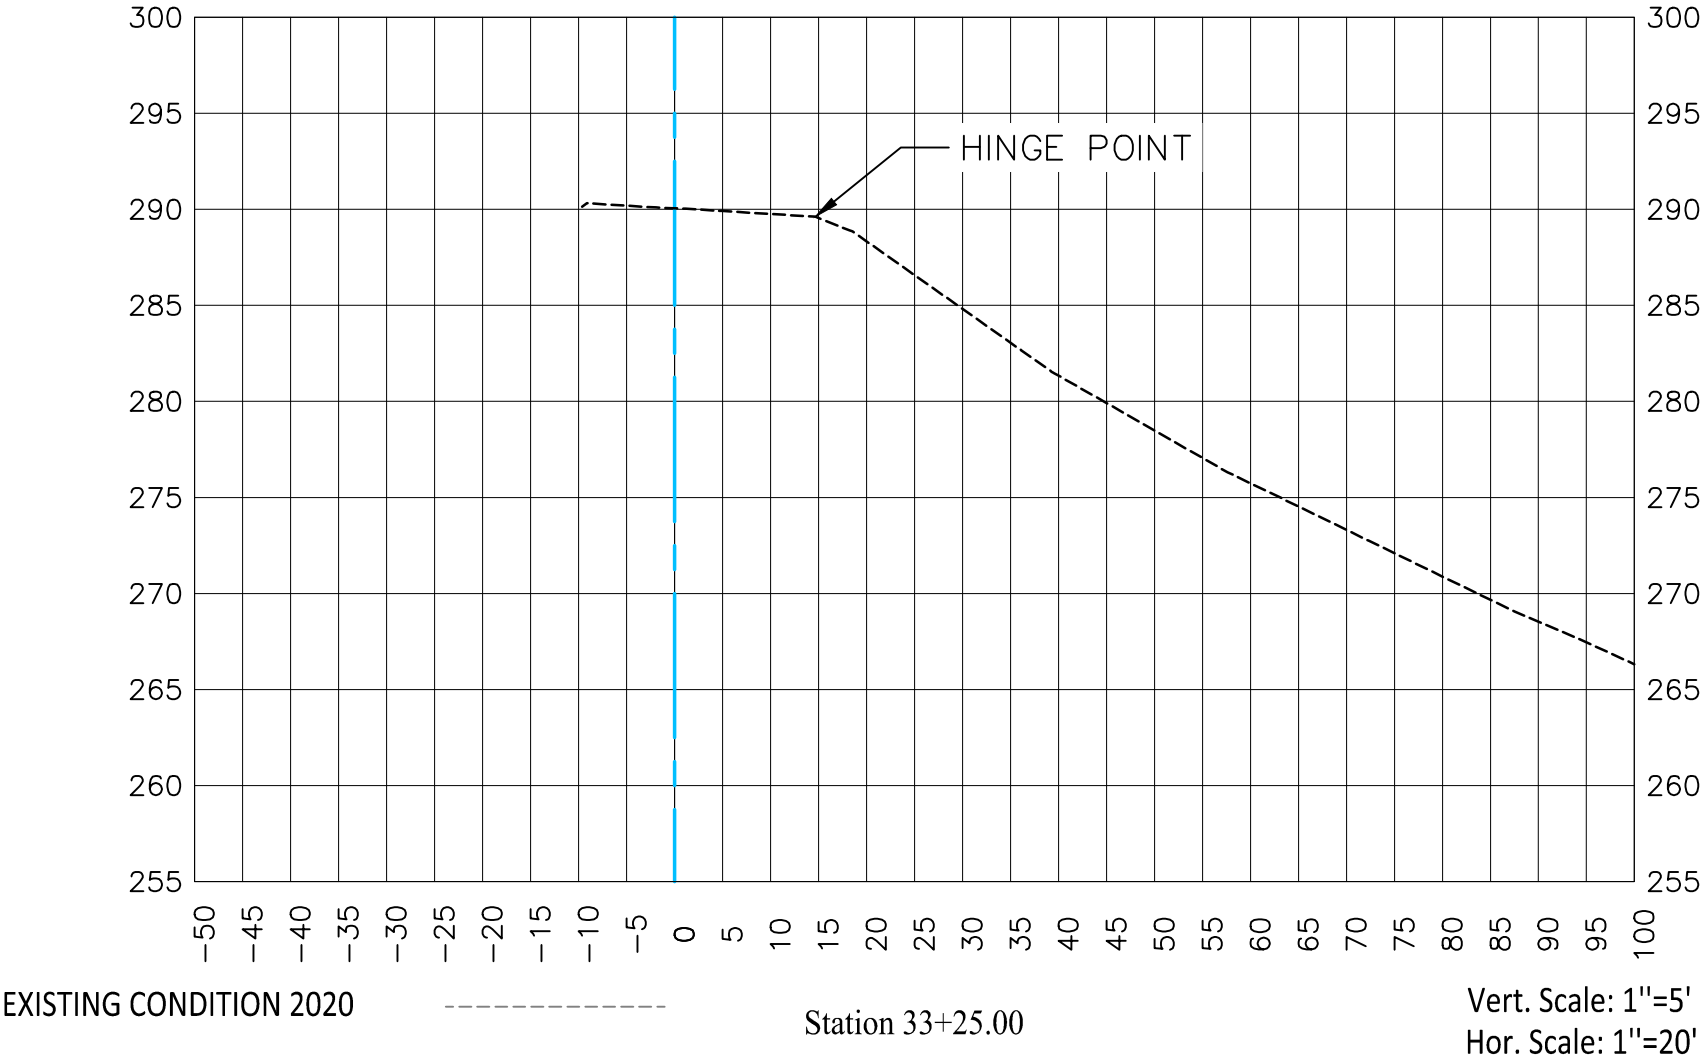


DATE PREPARED: 03/23/2020

**U.S. Survey
Foot**

OC Public Works/Engineering Services
OC Survey/Field Services
Boundary Analysis & Mapping

GALIVAN PERIMETER ROAD CL

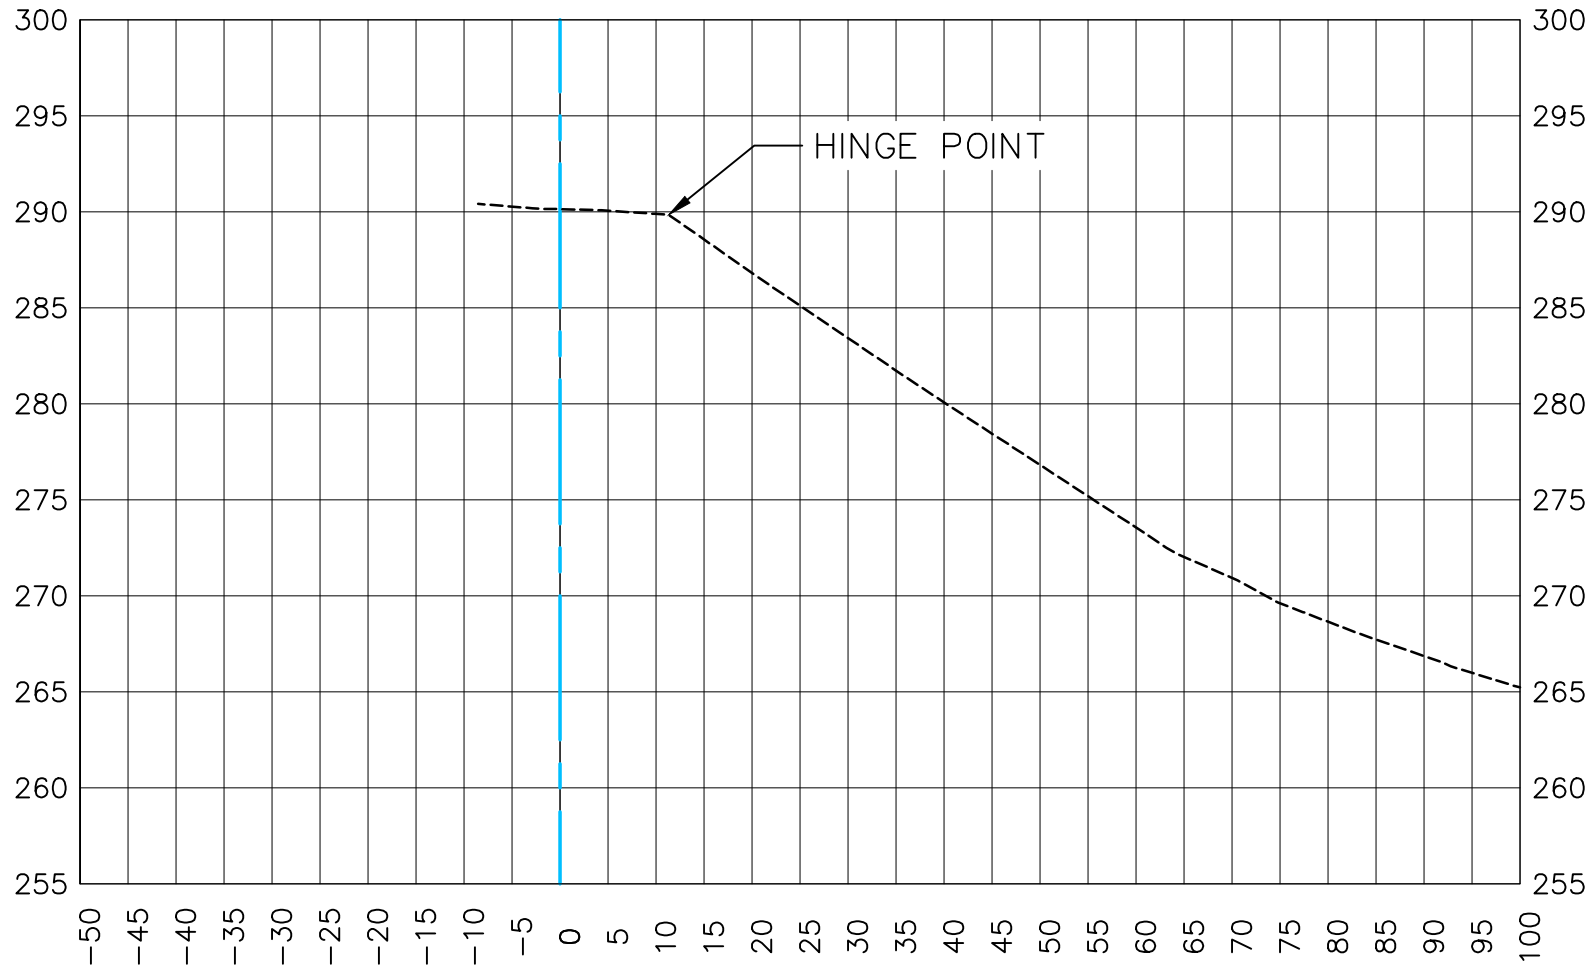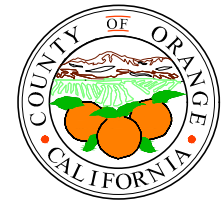

EXISTING CONDITION 2020

Station 33+50.00



Vert. Scale: 1"=5'
Hor. Scale: 1"=20'

DATE PREPARED: 03/23/2020

U.S. Survey Foot

OC Public Works/Engineering Services
OC Survey/Field Services
Boundary Analysis & Mapping

GALIVAN PERIMETER ROAD CL

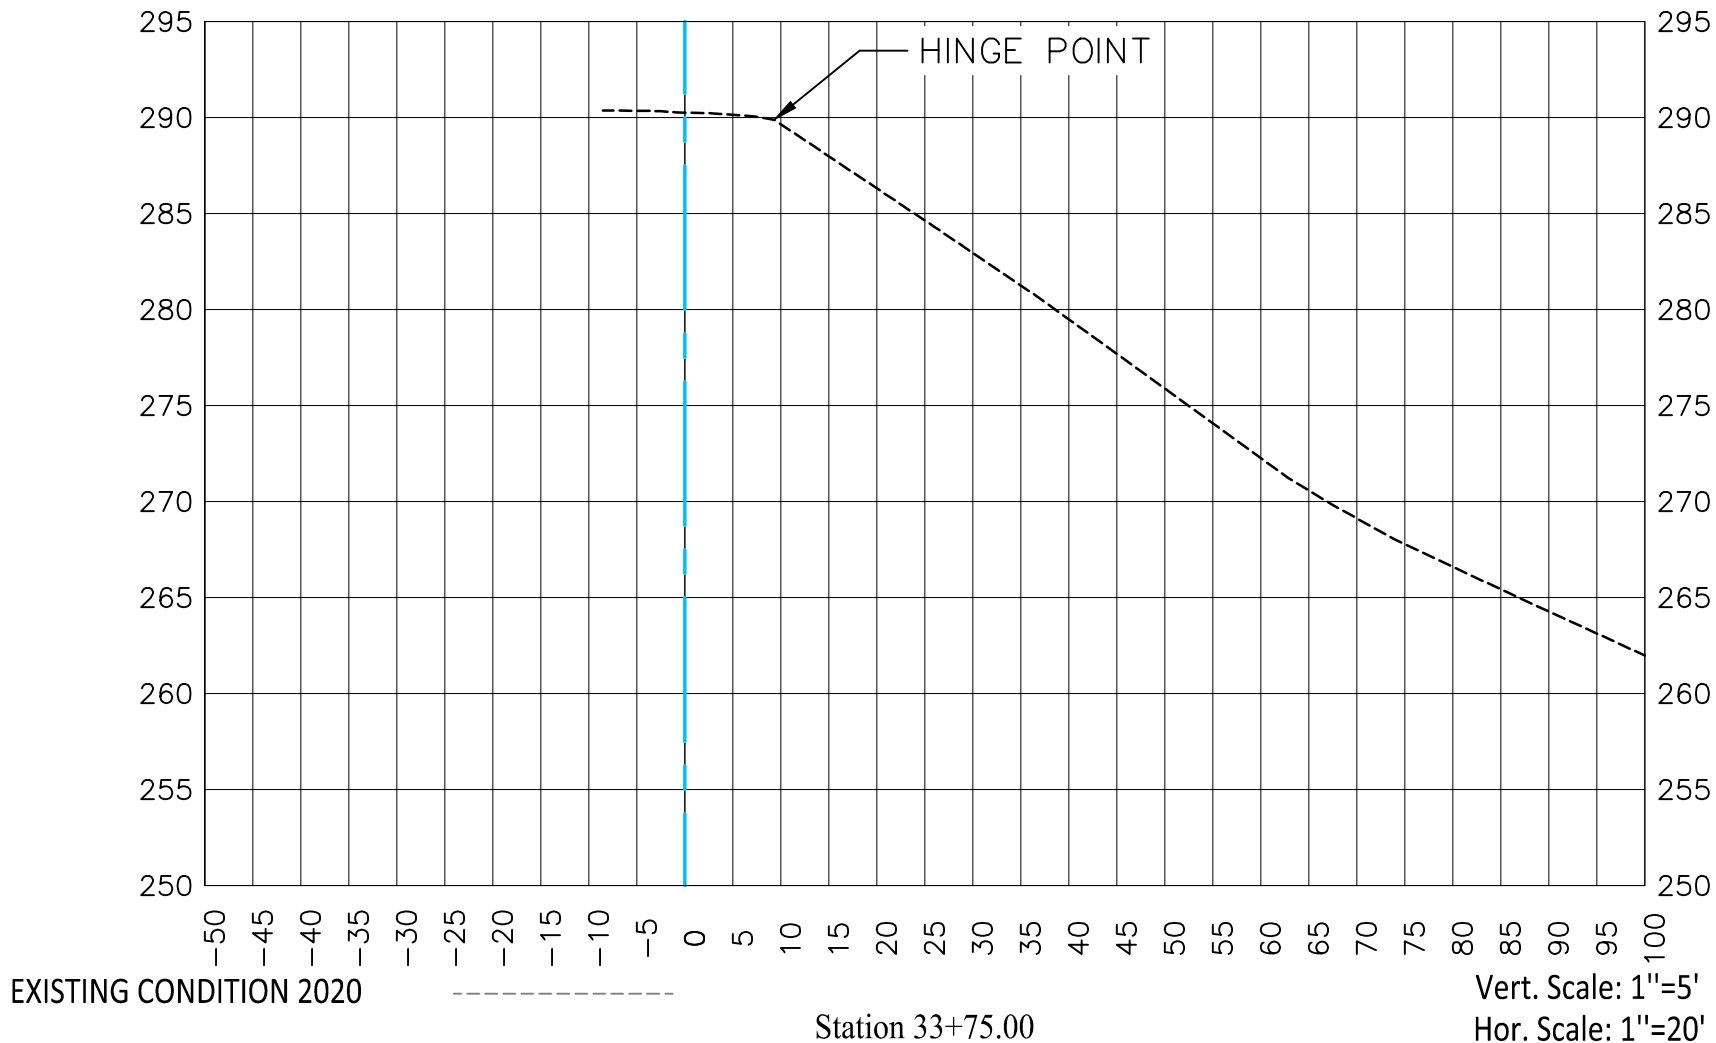
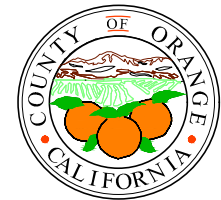


DATE PREPARED: 03/23/2020

U.S. Survey Foot

OC Public Works/Engineering Services
OC Survey/Field Services
Boundary Analysis & Mapping


GALIVAN PERIMETER ROAD CL

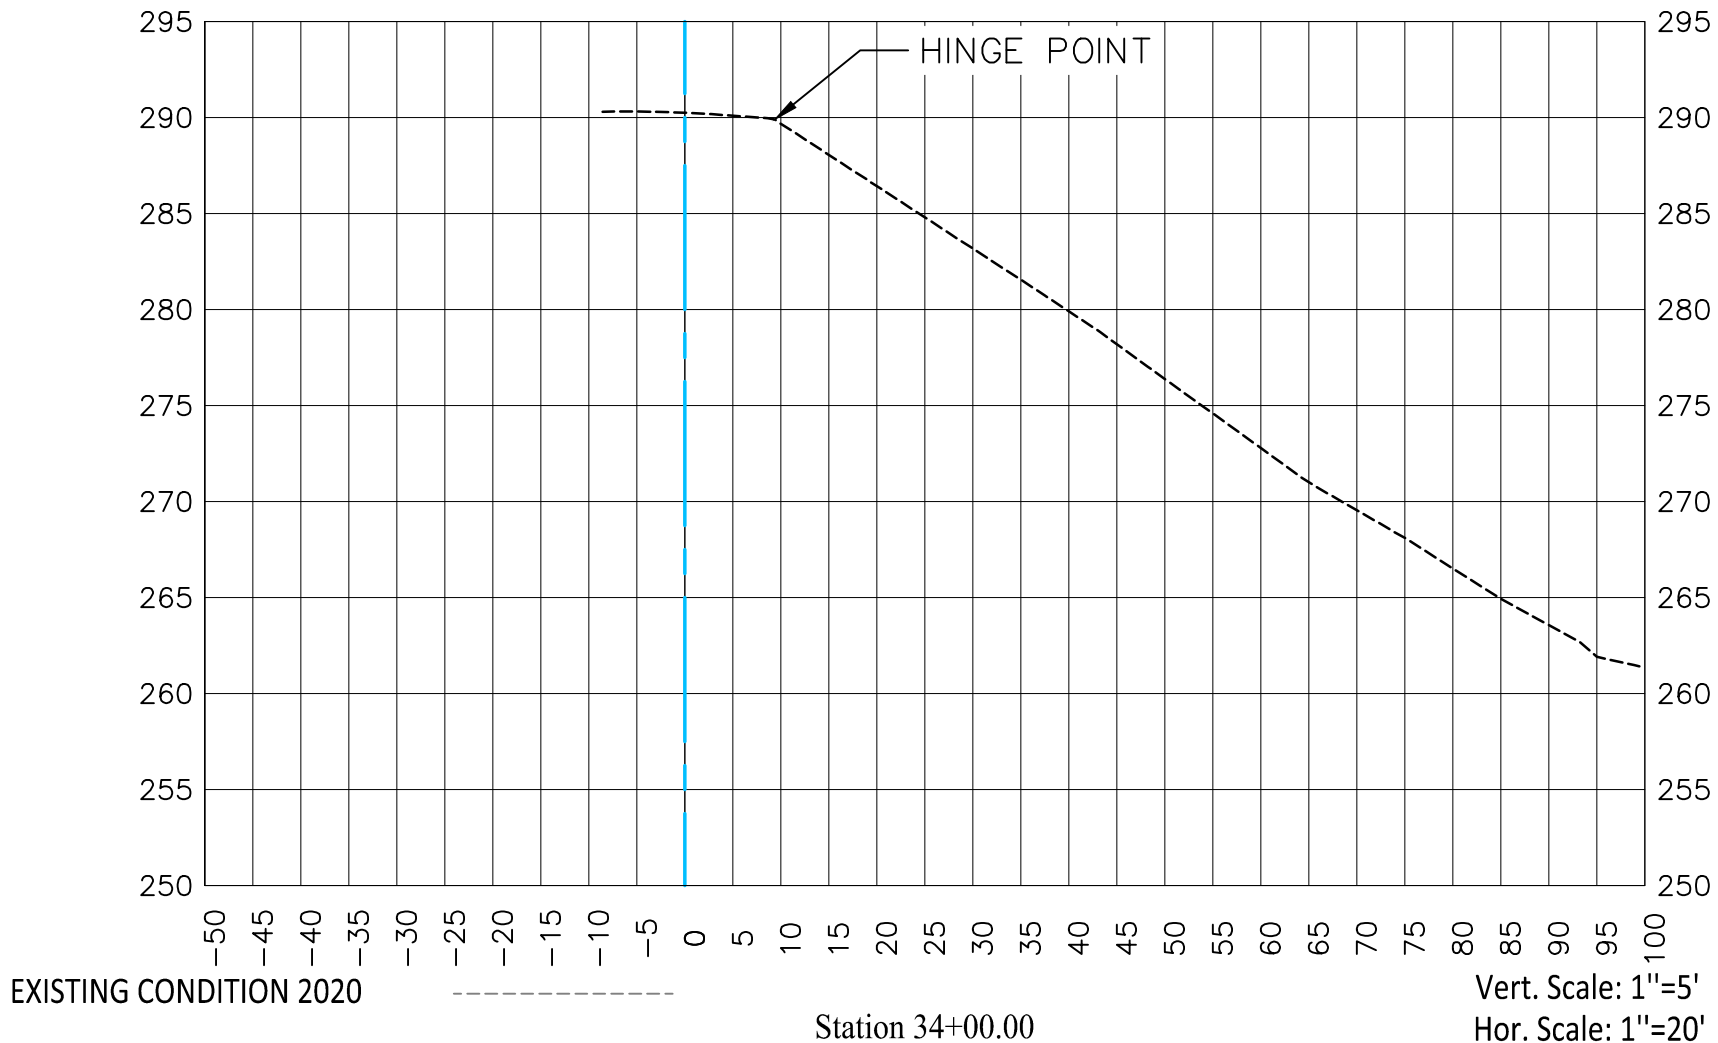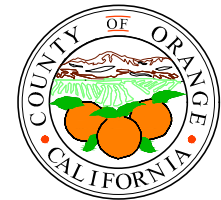


DATE PREPARED: 03/23/2020

U.S. Survey Foot

OC Public Works/Engineering Services
OC Survey/Field Services
Boundary Analysis & Mapping

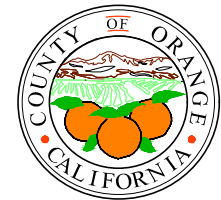

GALIVAN PERIMETER ROAD CL

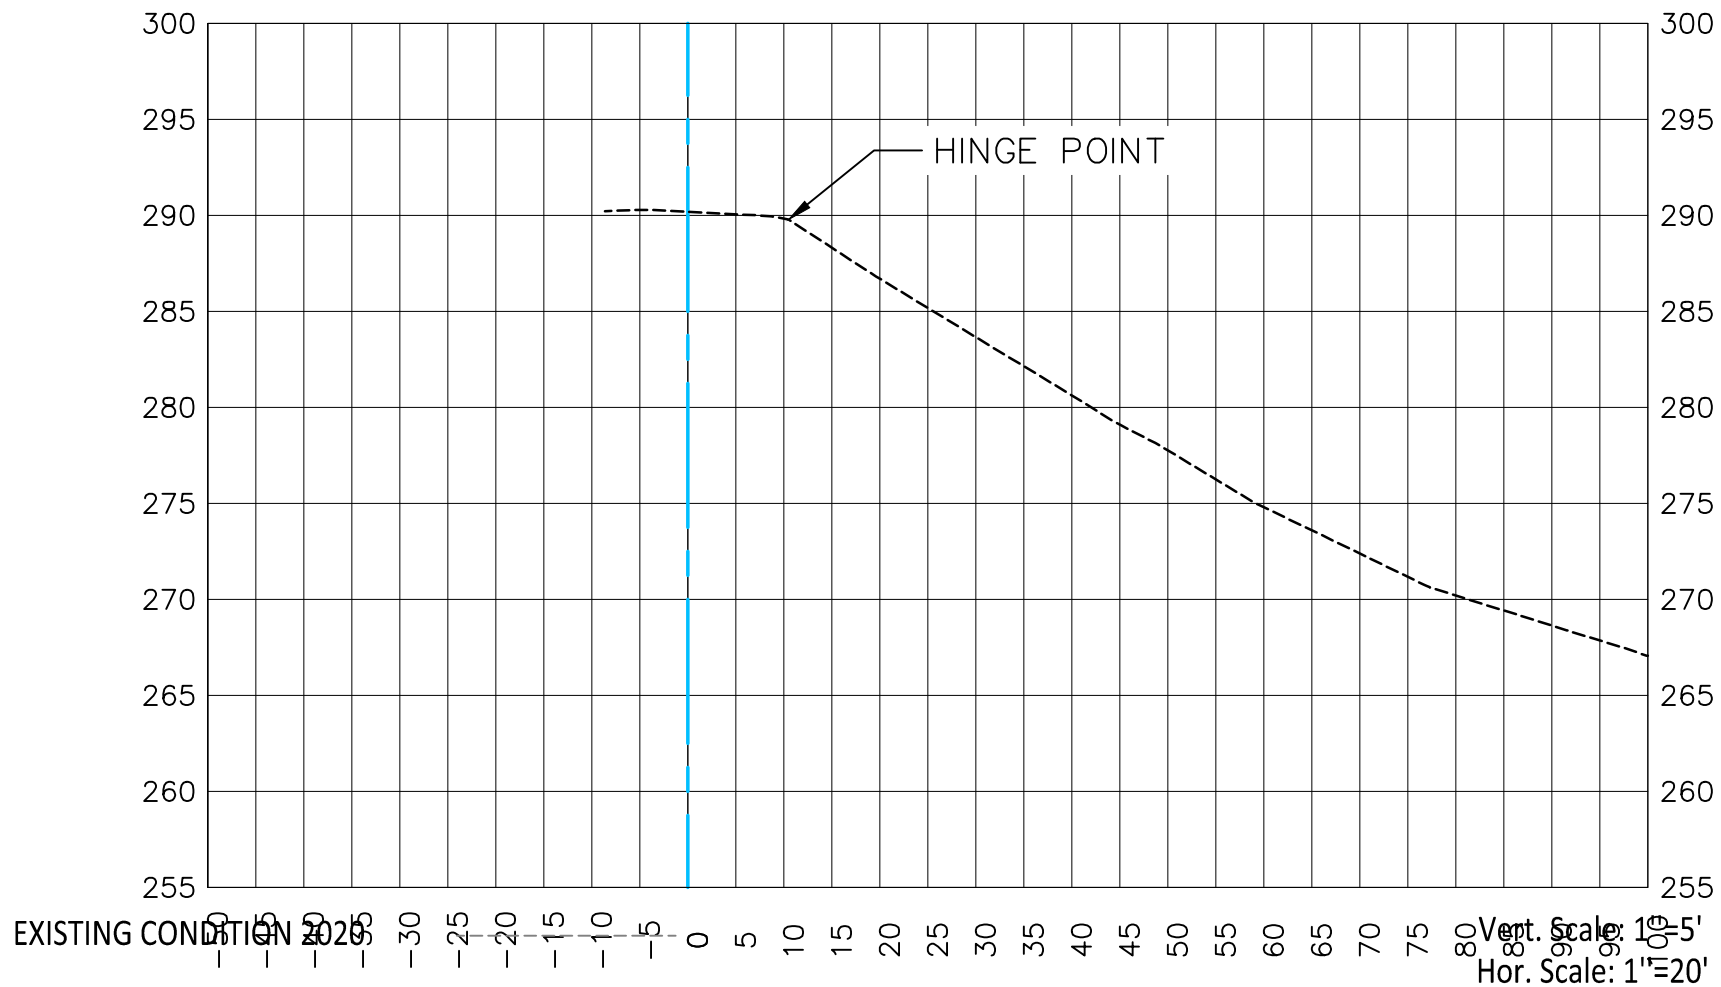


DATE PREPARED: 03/23/2020

U.S. Survey Foot

OC Public Works/Engineering Services
OC Survey/Field Services
Boundary Analysis & Mapping

GALIVAN PERIMETER ROAD CL

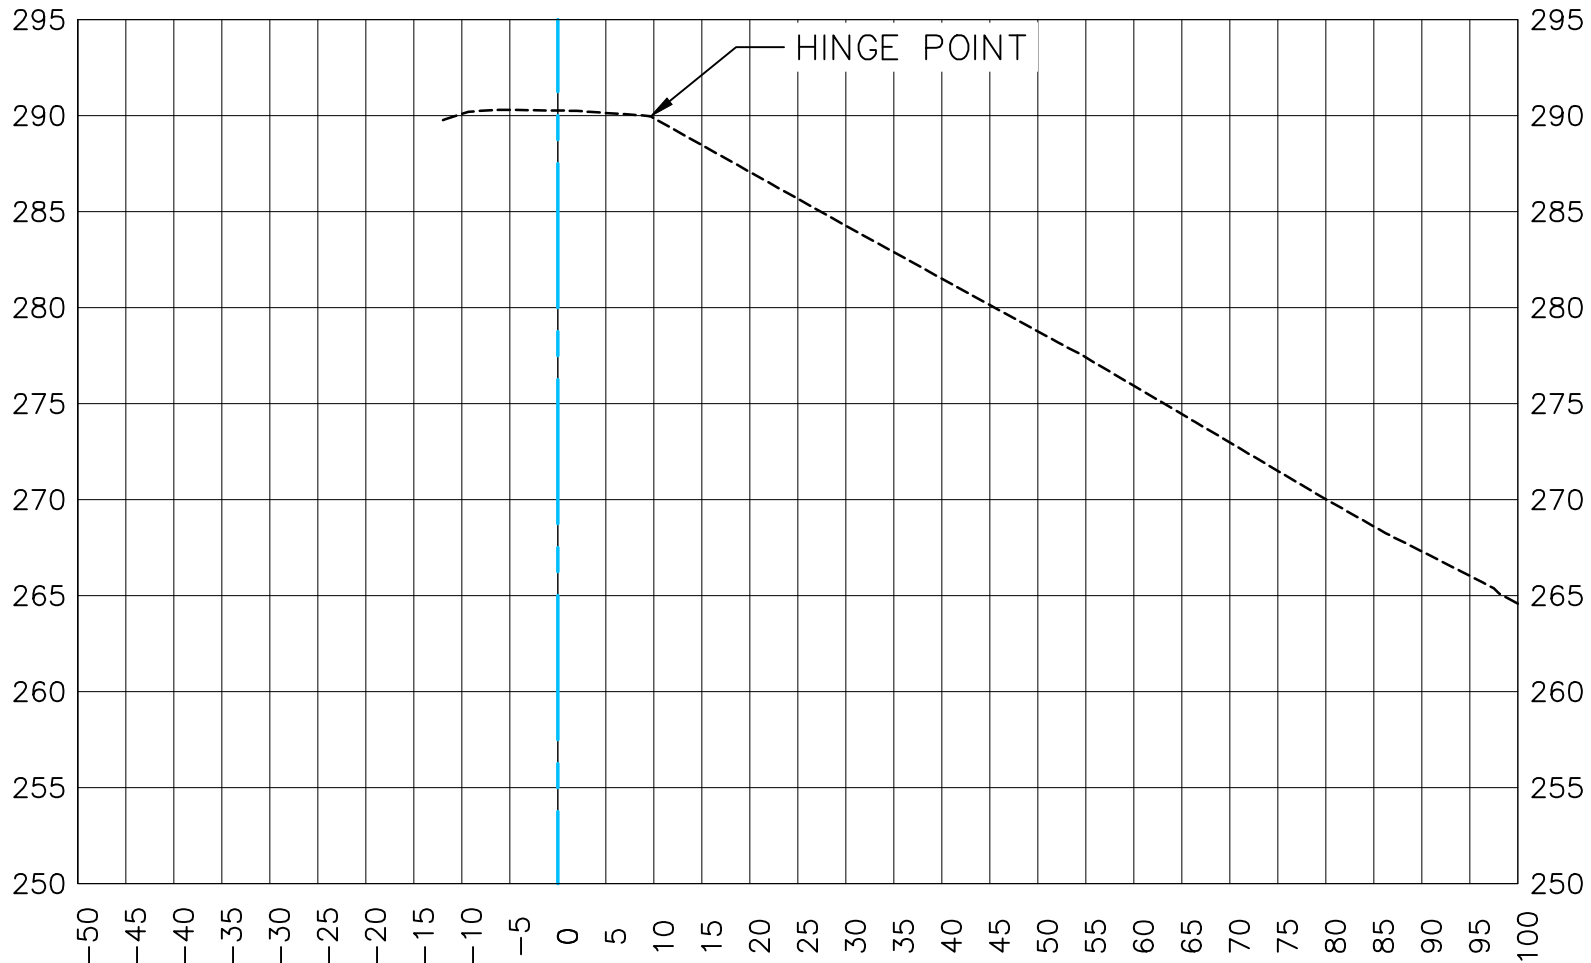

EXISTING CONDITION 2020

Station 34+50.00


Vert. Scale: 1"=5'
Hor. Scale: 1"=20'

DATE PREPARED: 03/23/2020

U.S. Survey Foot

OC Public Works/Engineering Services
OC Survey/Field Services
Boundary Analysis & Mapping

GALIVAN PERIMETER ROAD CL

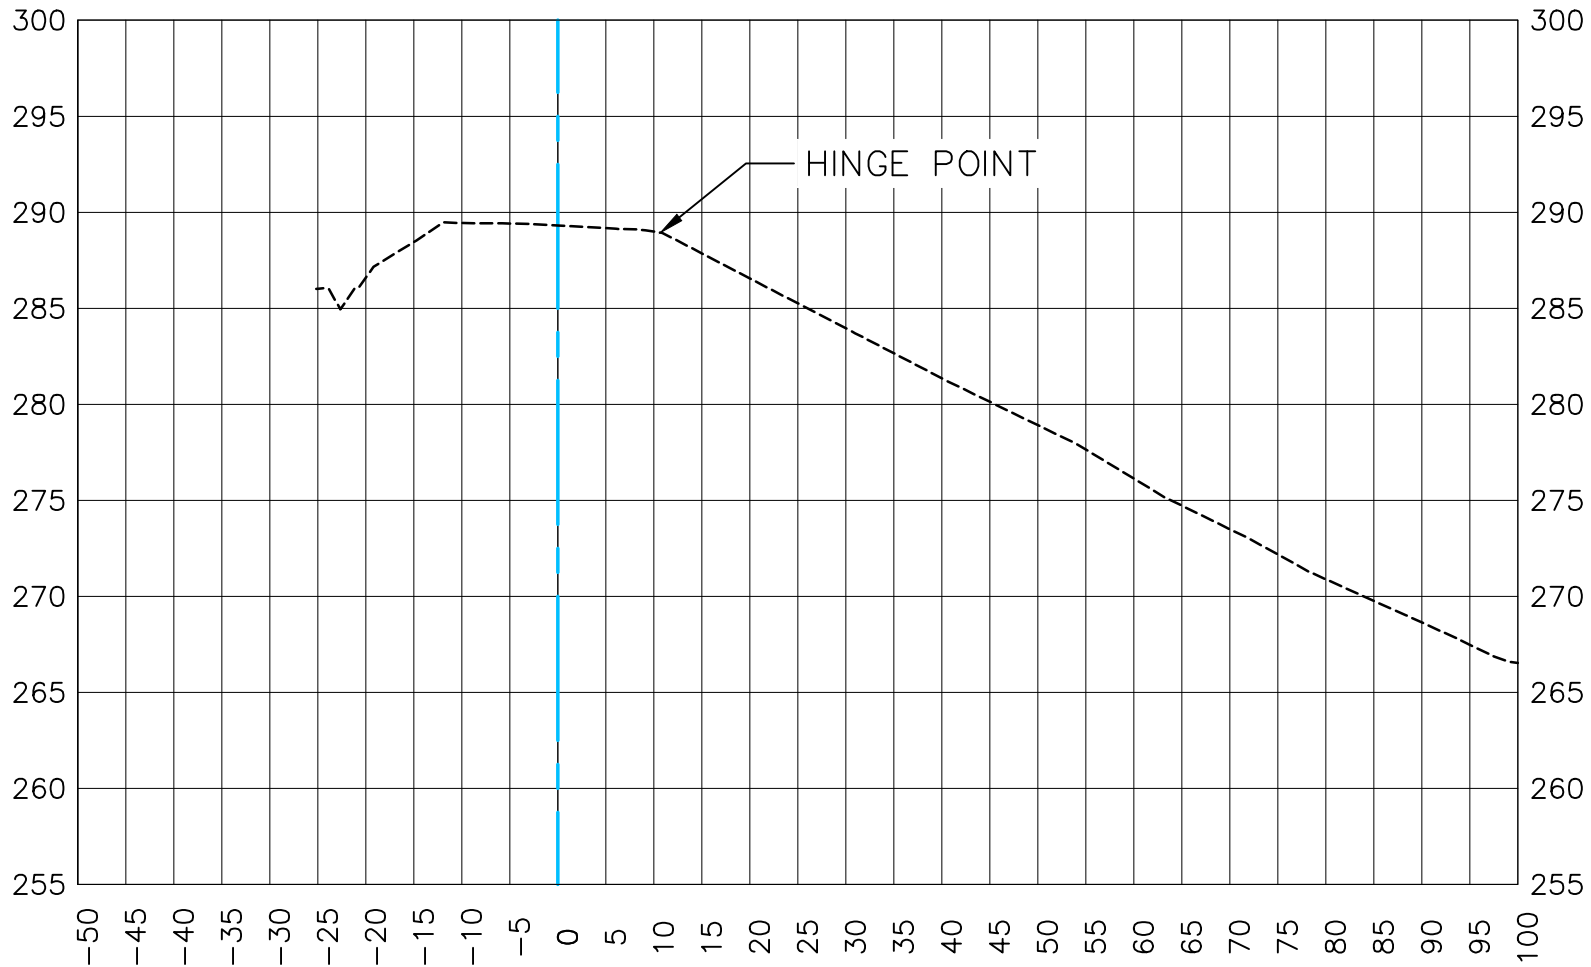


EXISTING CONDITION 2020

Station 34+75.00


Vert. Scale: 1"=5'

Hor. Scale: 1"=20'

DATE PREPARED: 03/23/2020

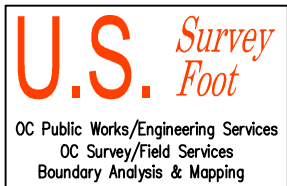

GALIVAN PERIMETER ROAD CL

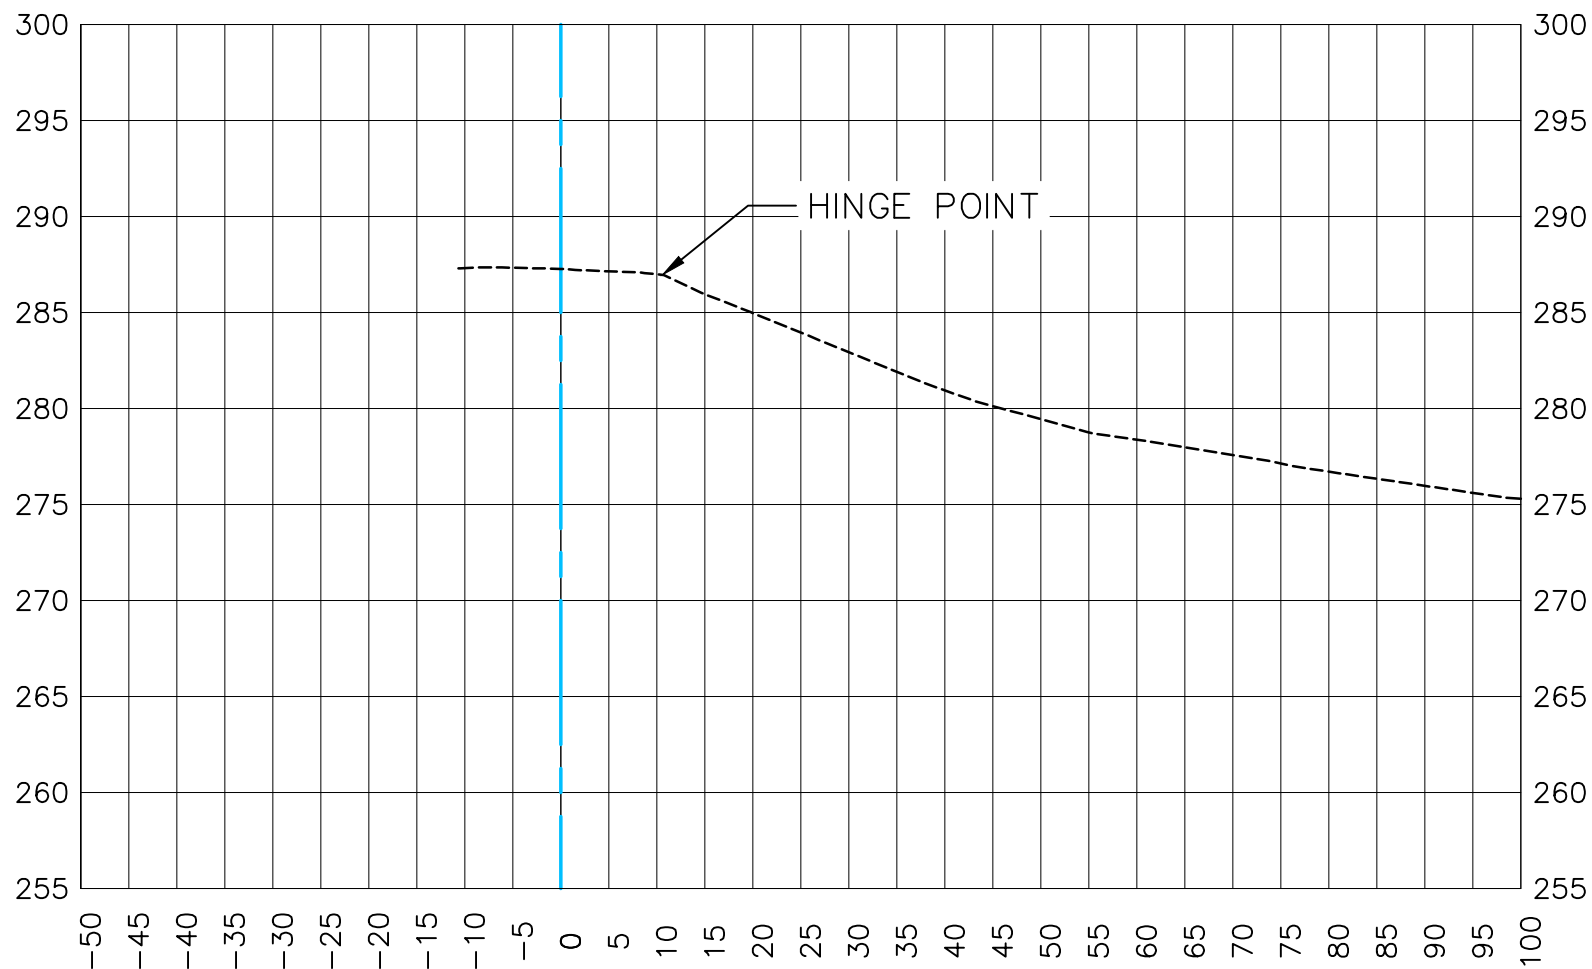


EXISTING CONDITION 2020


Station 35+00.00

Vert. Scale: 1"=5'
Hor. Scale: 1"=20'

DATE PREPARED: 03/23/2020

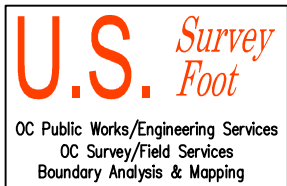

GALIVAN PERIMETER ROAD CL

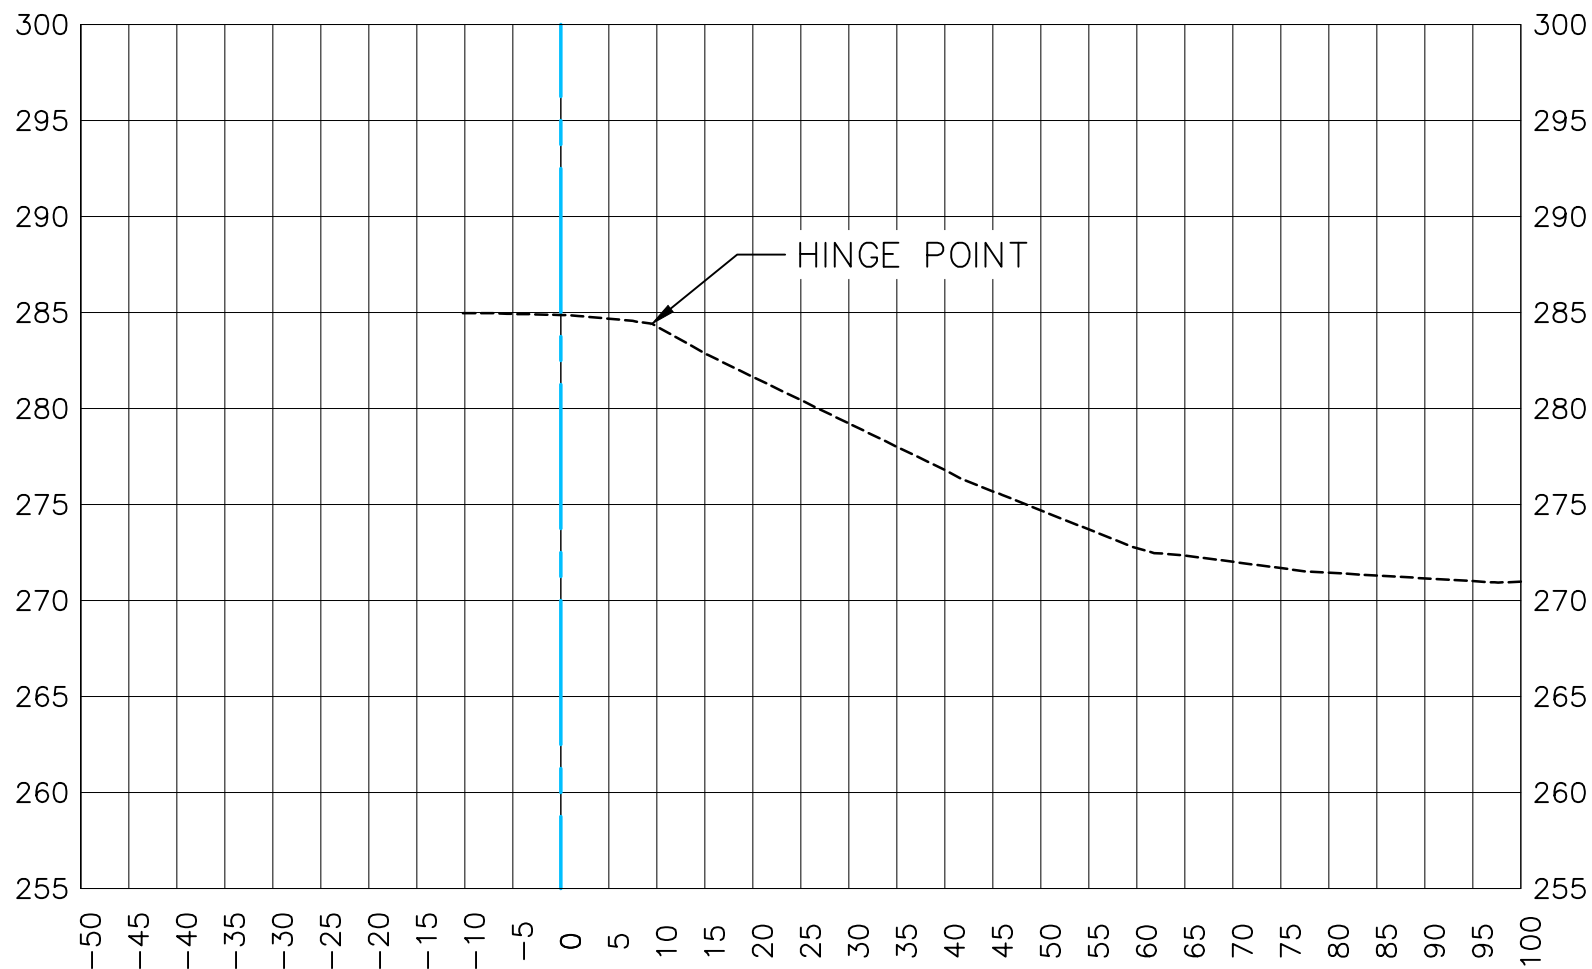


EXISTING CONDITION 2020


Station 35+25.00

Vert. Scale: 1"=5'
Hor. Scale: 1"=20'

DATE PREPARED: 03/23/2020

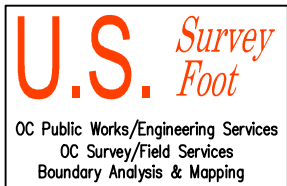

GALIVAN PERIMETER ROAD CL

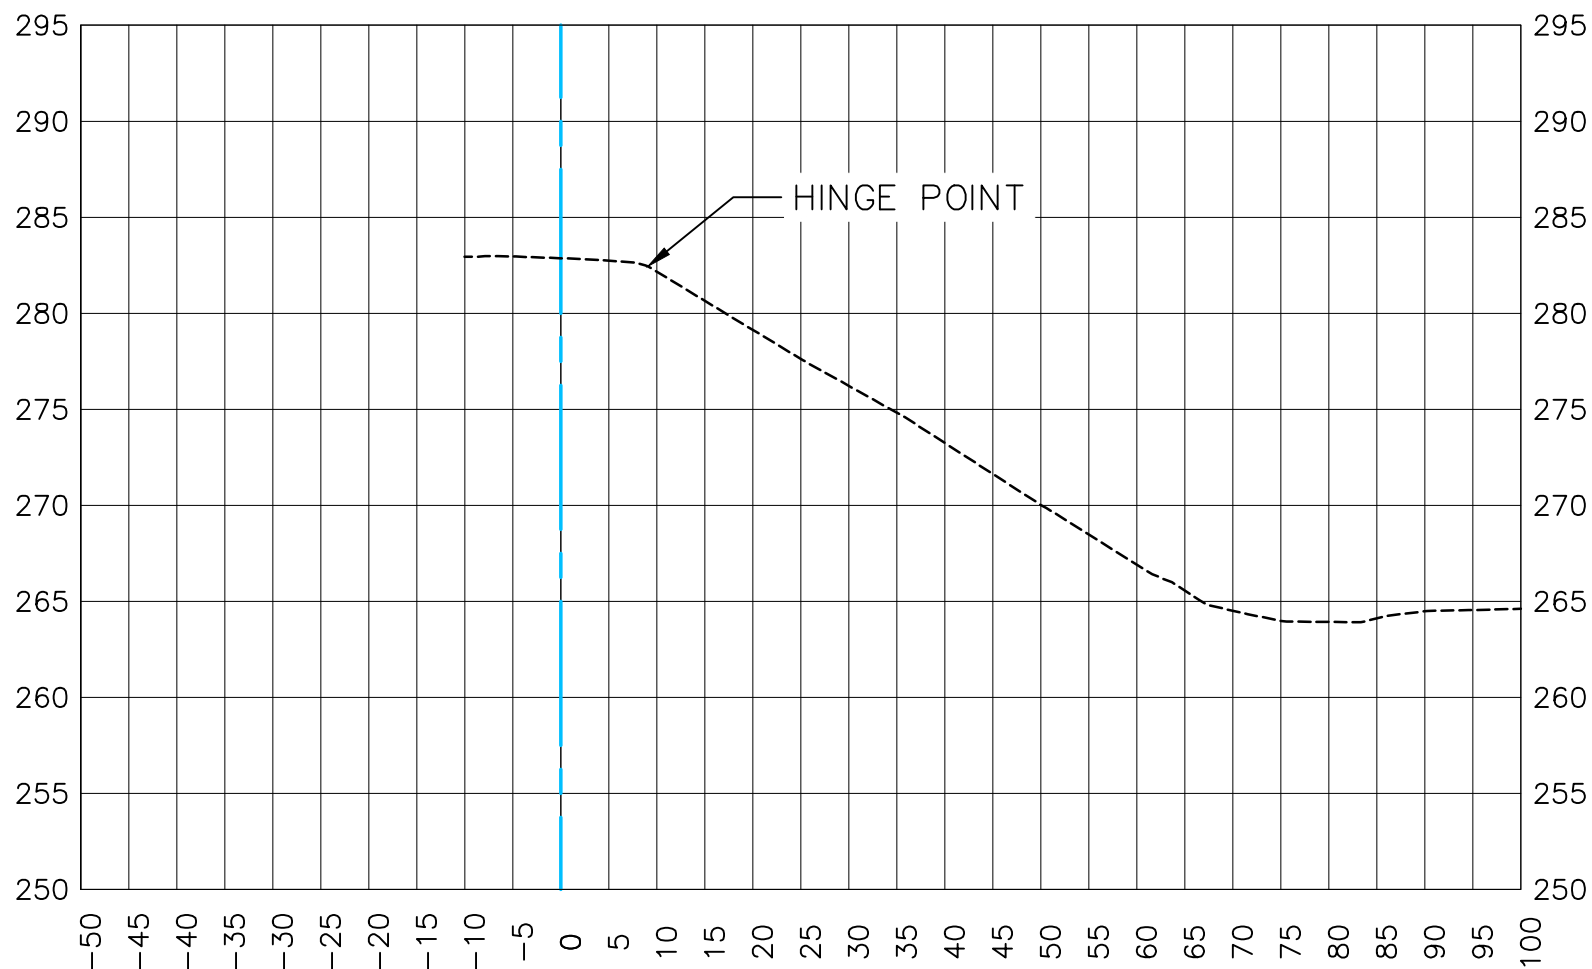

EXISTING CONDITION 2020

Station 35+50.00

Vert. Scale: 1"=5'


Hor. Scale: 1"=20'

DATE PREPARED: 03/23/2020

U.S. *Survey
Foot*

OC Public Works/Engineering Services
OC Survey/Field Services
Boundary Analysis & Mapping

GALIVAN PERIMETER ROAD CL

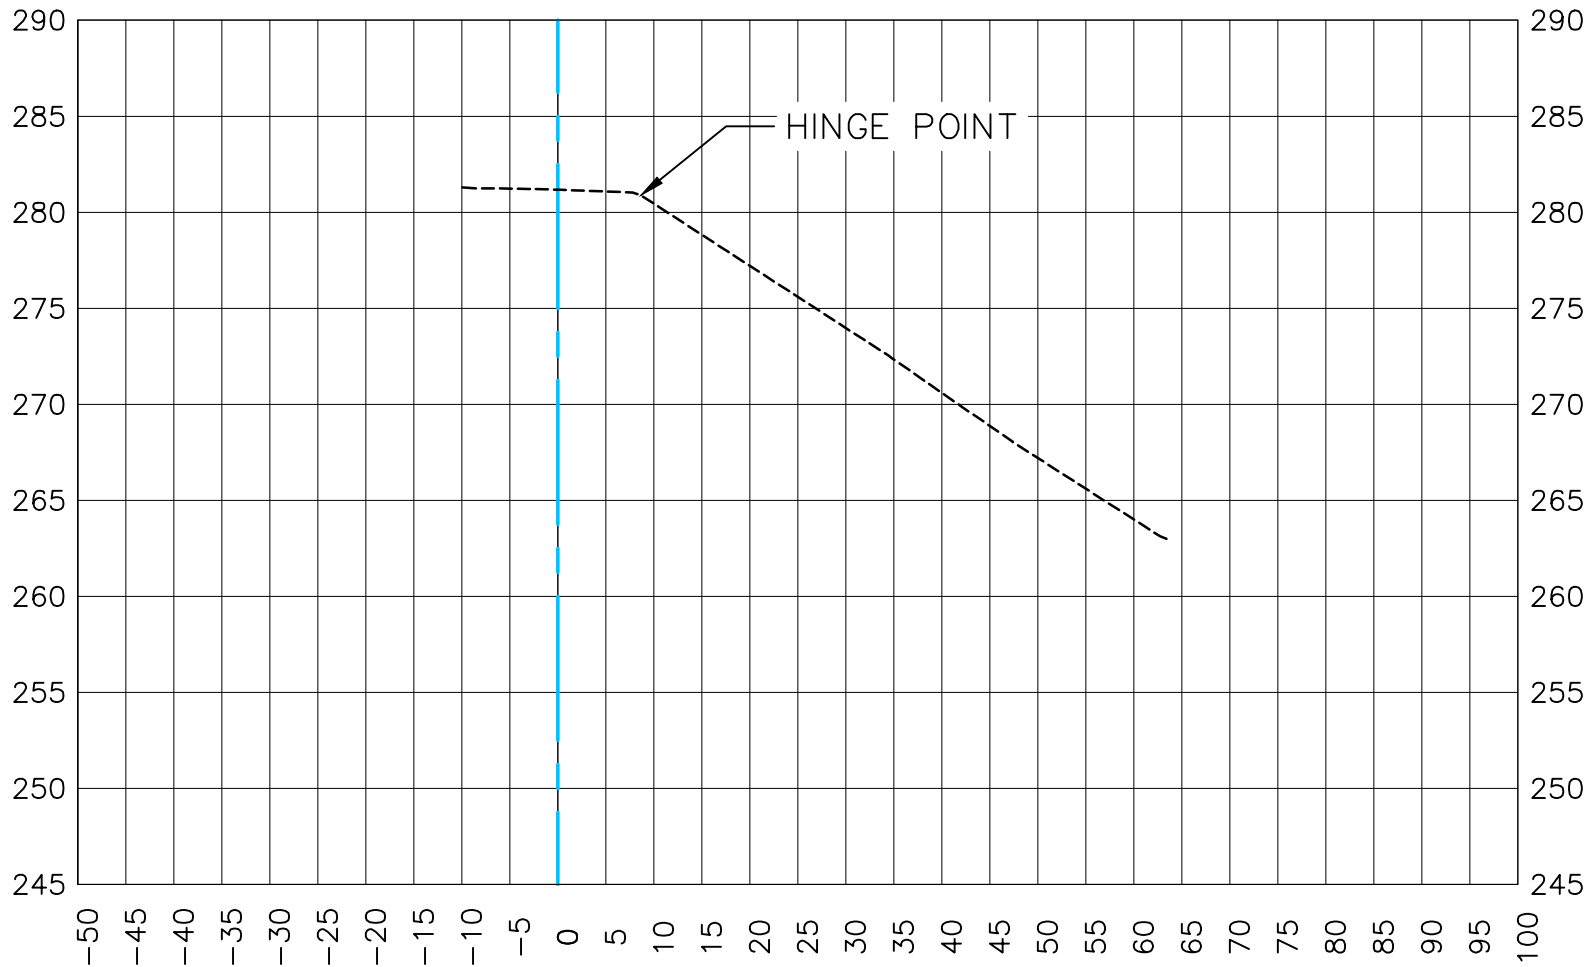


EXISTING CONDITION 2020

Station 35+75.00



Vert. Scale: 1"=5'

Hor. Scale: 1"=20'

DATE PREPARED: 03/23/2020

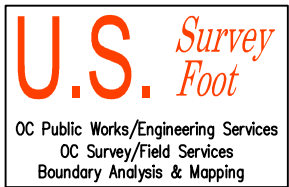

GALIVAN PERIMETER ROAD CL

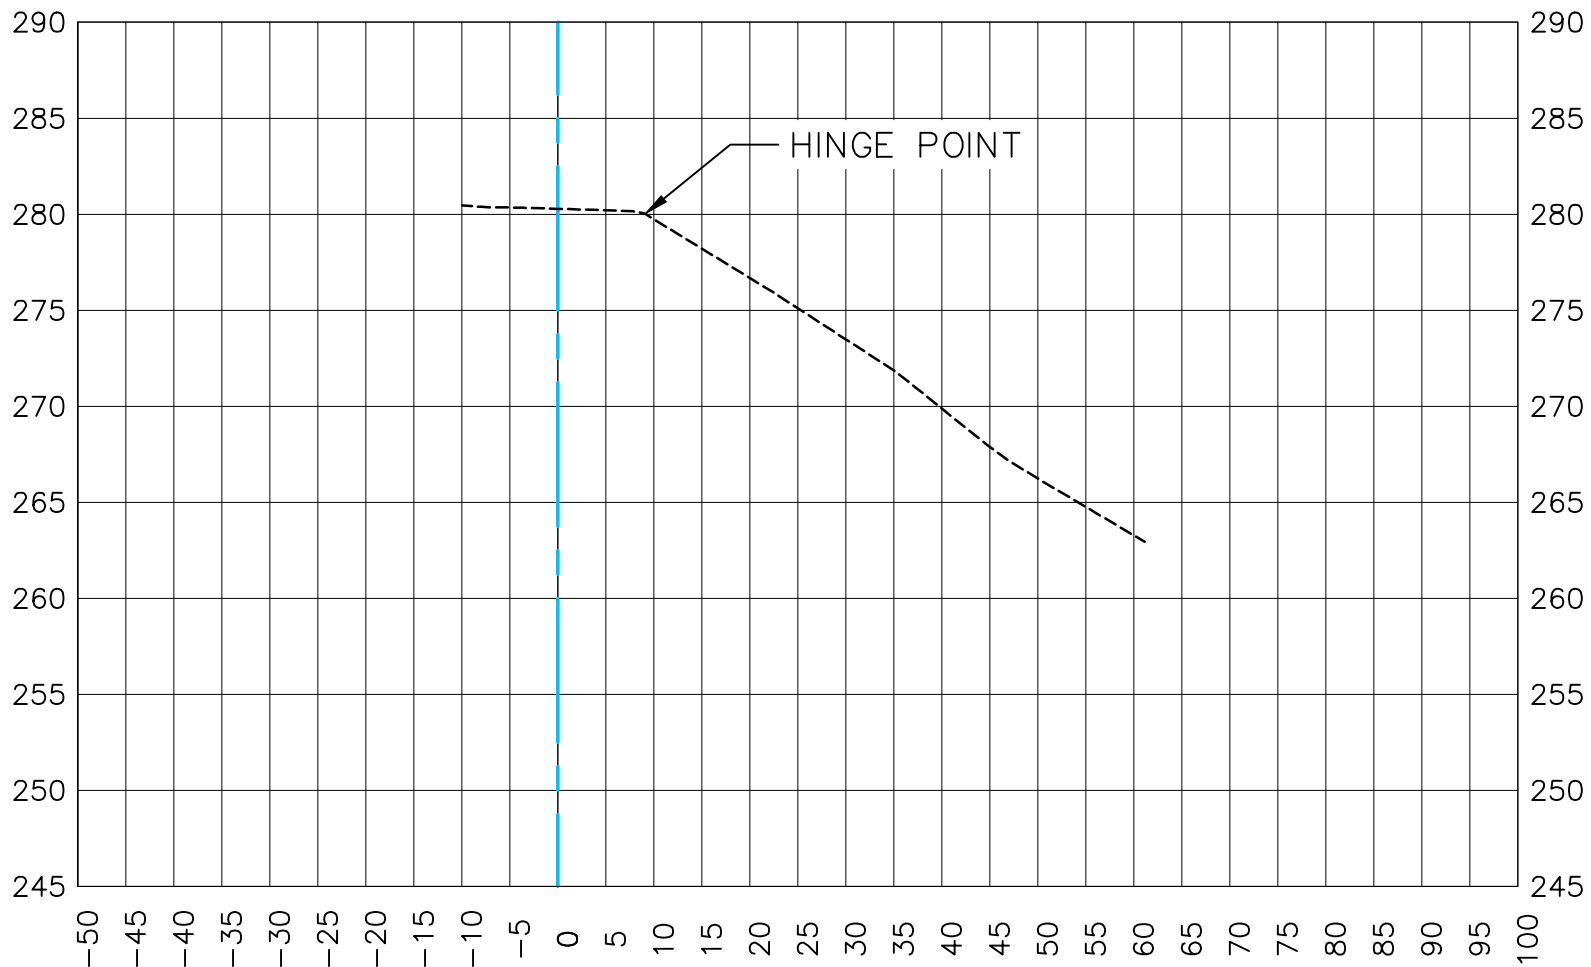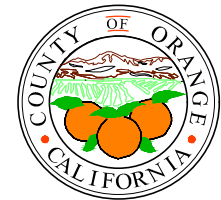


EXISTING CONDITION 2020

Station 36+00.00



Vert. Scale: 1"=5'

Hor. Scale: 1"=20'

DATE PREPARED: 03/23/2020

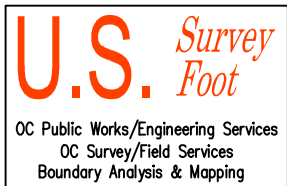

GALIVAN PERIMETER ROAD CL

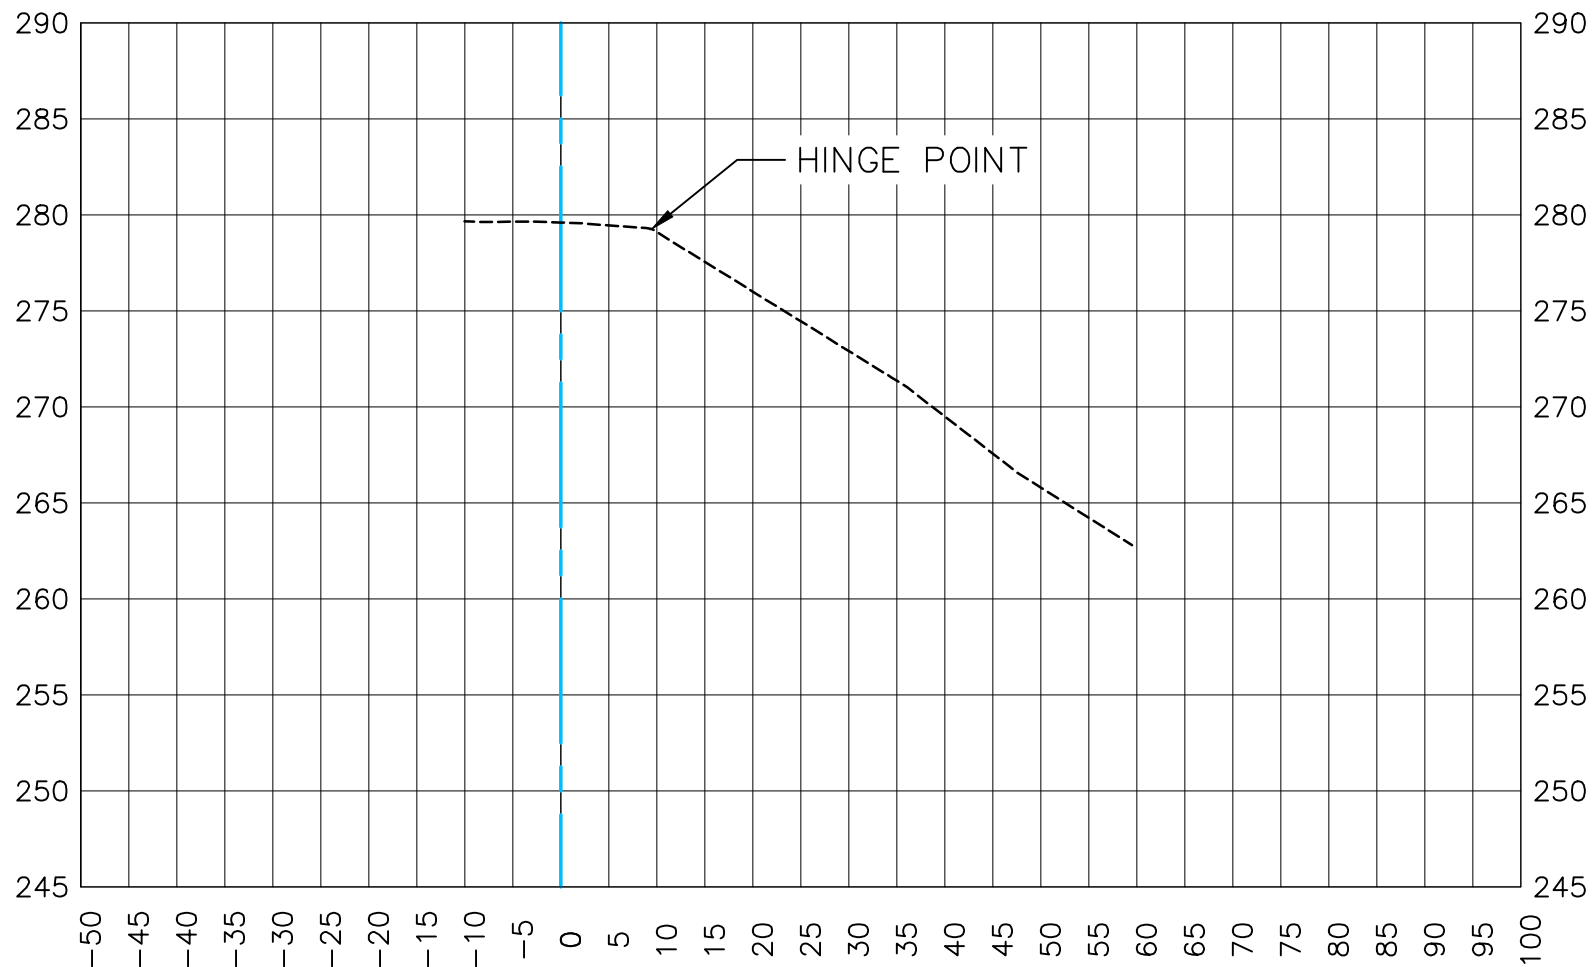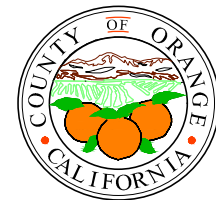


EXISTING CONDITION 2020

Station 36+25.00



Vert. Scale: 1"=5'

Hor. Scale: 1"=20'

DATE PREPARED: 03/23/2020

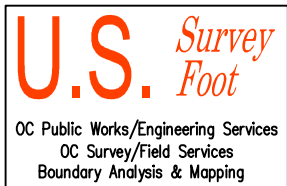

GALIVAN PERIMETER ROAD CL

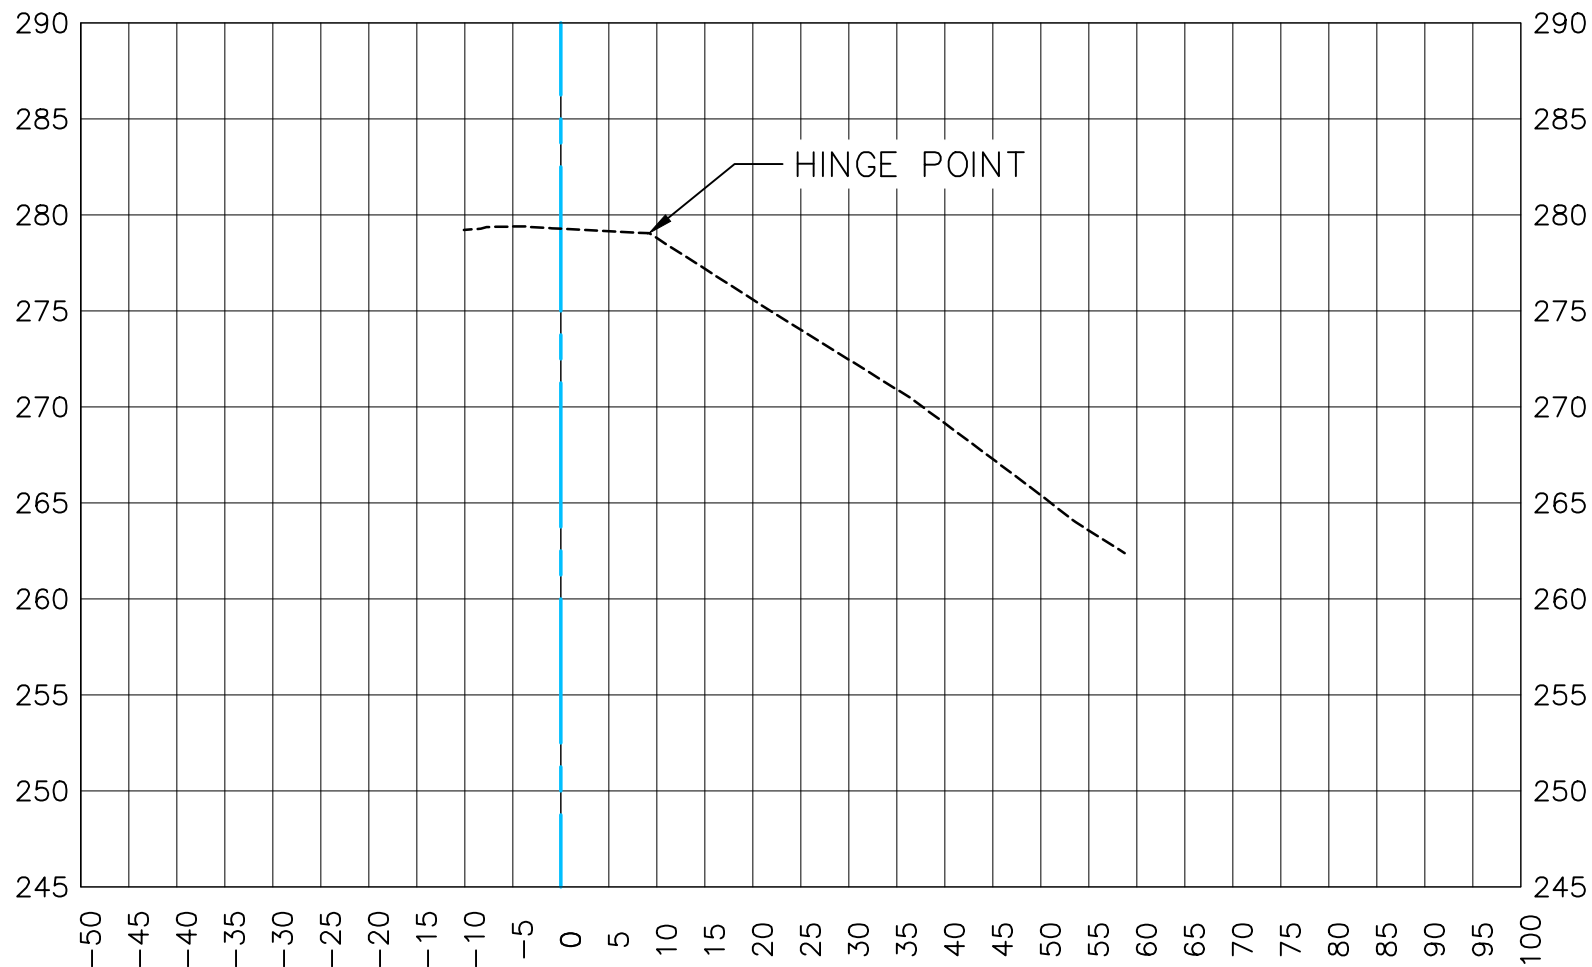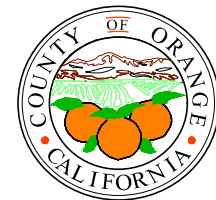


EXISTING CONDITION 2020

Station 36+50.00



Vert. Scale: 1"=5'

Hor. Scale: 1"=20'

DATE PREPARED: 03/23/2020

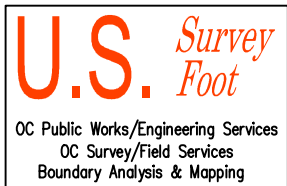

GALIVAN PERIMETER ROAD CL

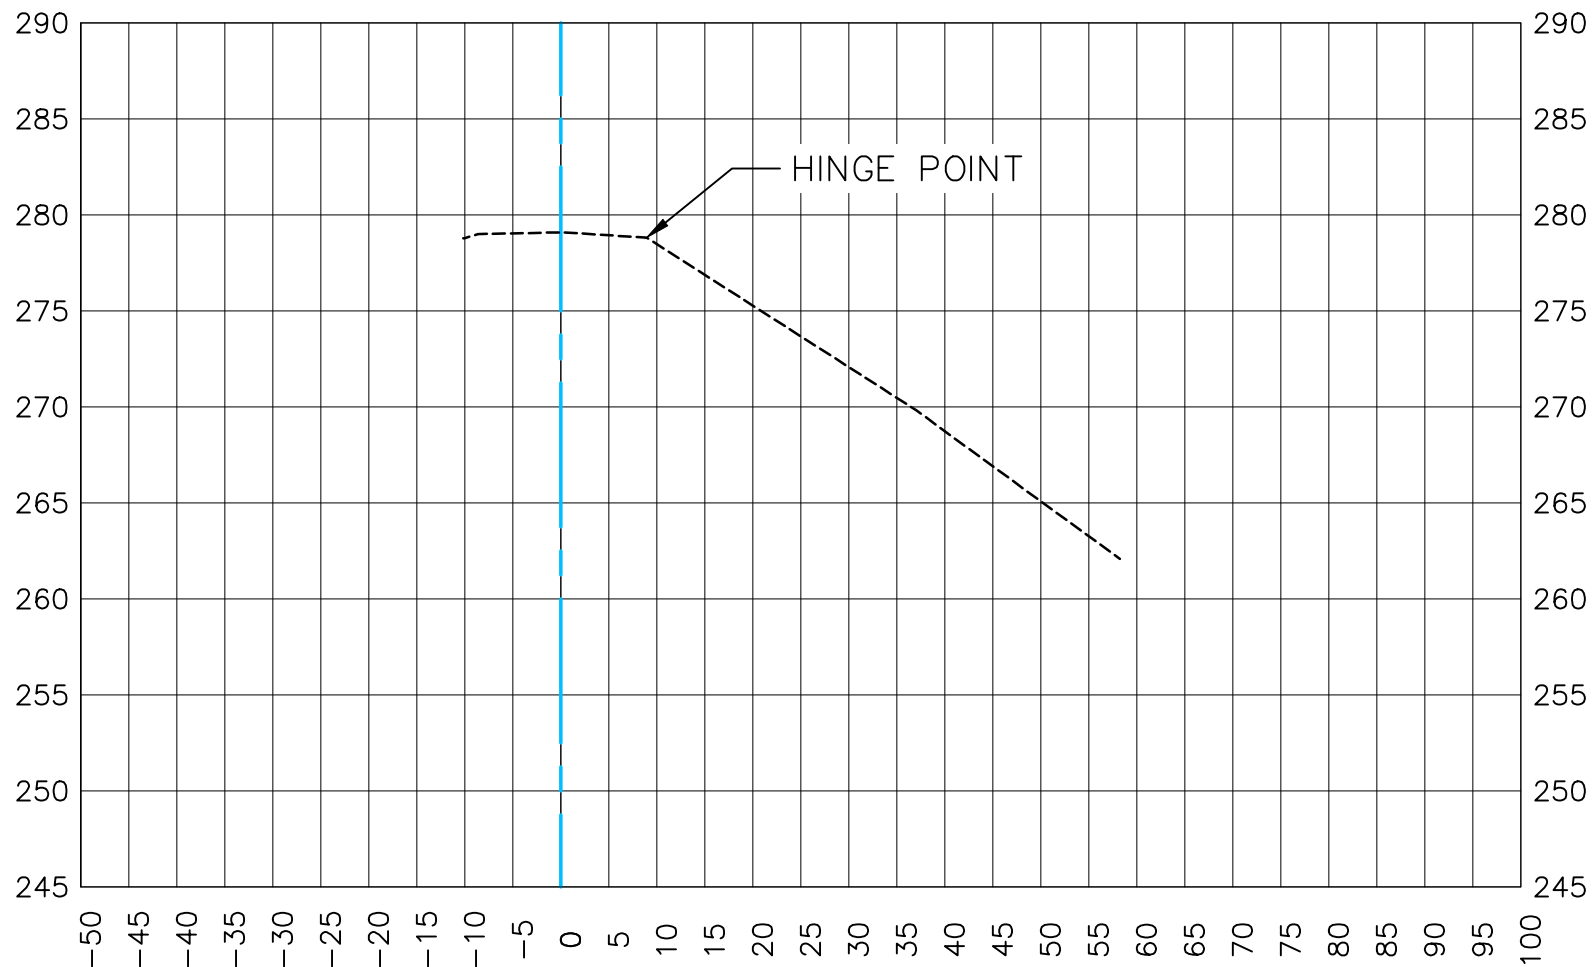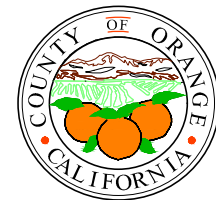


EXISTING CONDITION 2020



Station 36+75.00

Vert. Scale: 1"=5'
Hor. Scale: 1"=20'

DATE PREPARED: 03/23/2020

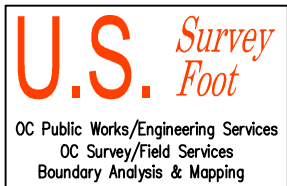

GALIVAN PERIMETER ROAD CL

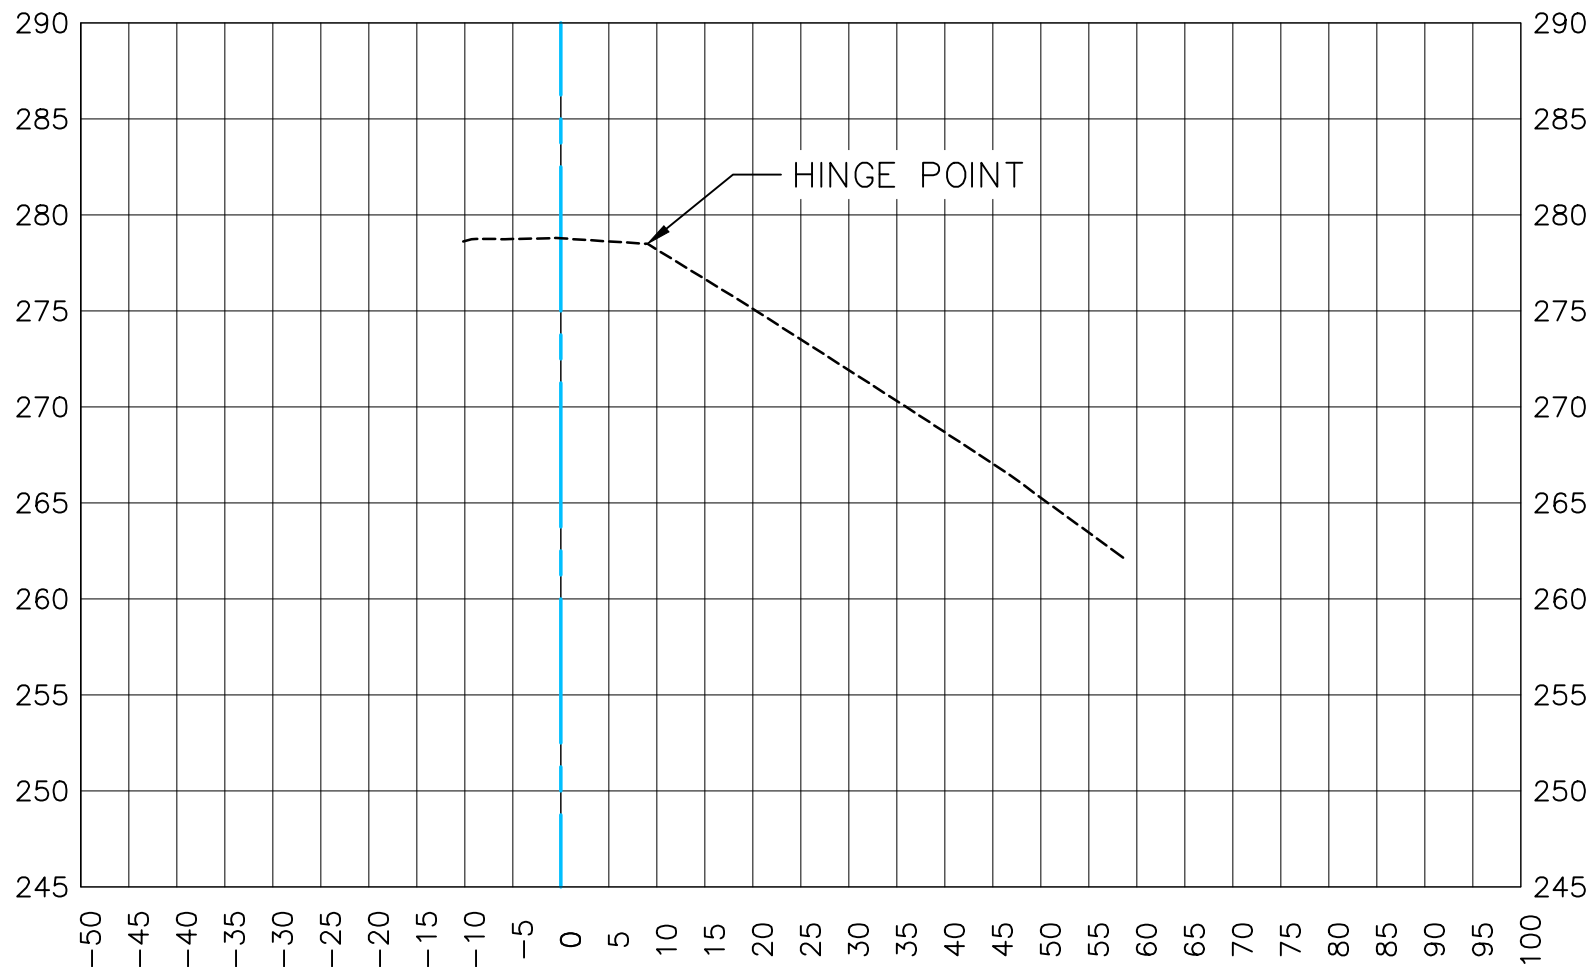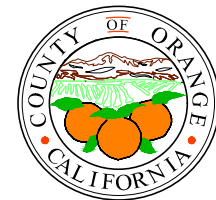


EXISTING CONDITION 2020

Station 37+00.00



Vert. Scale: 1"=5'

Hor. Scale: 1"=20'

DATE PREPARED: 03/23/2020

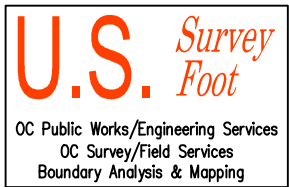

GALIVAN PERIMETER ROAD CL

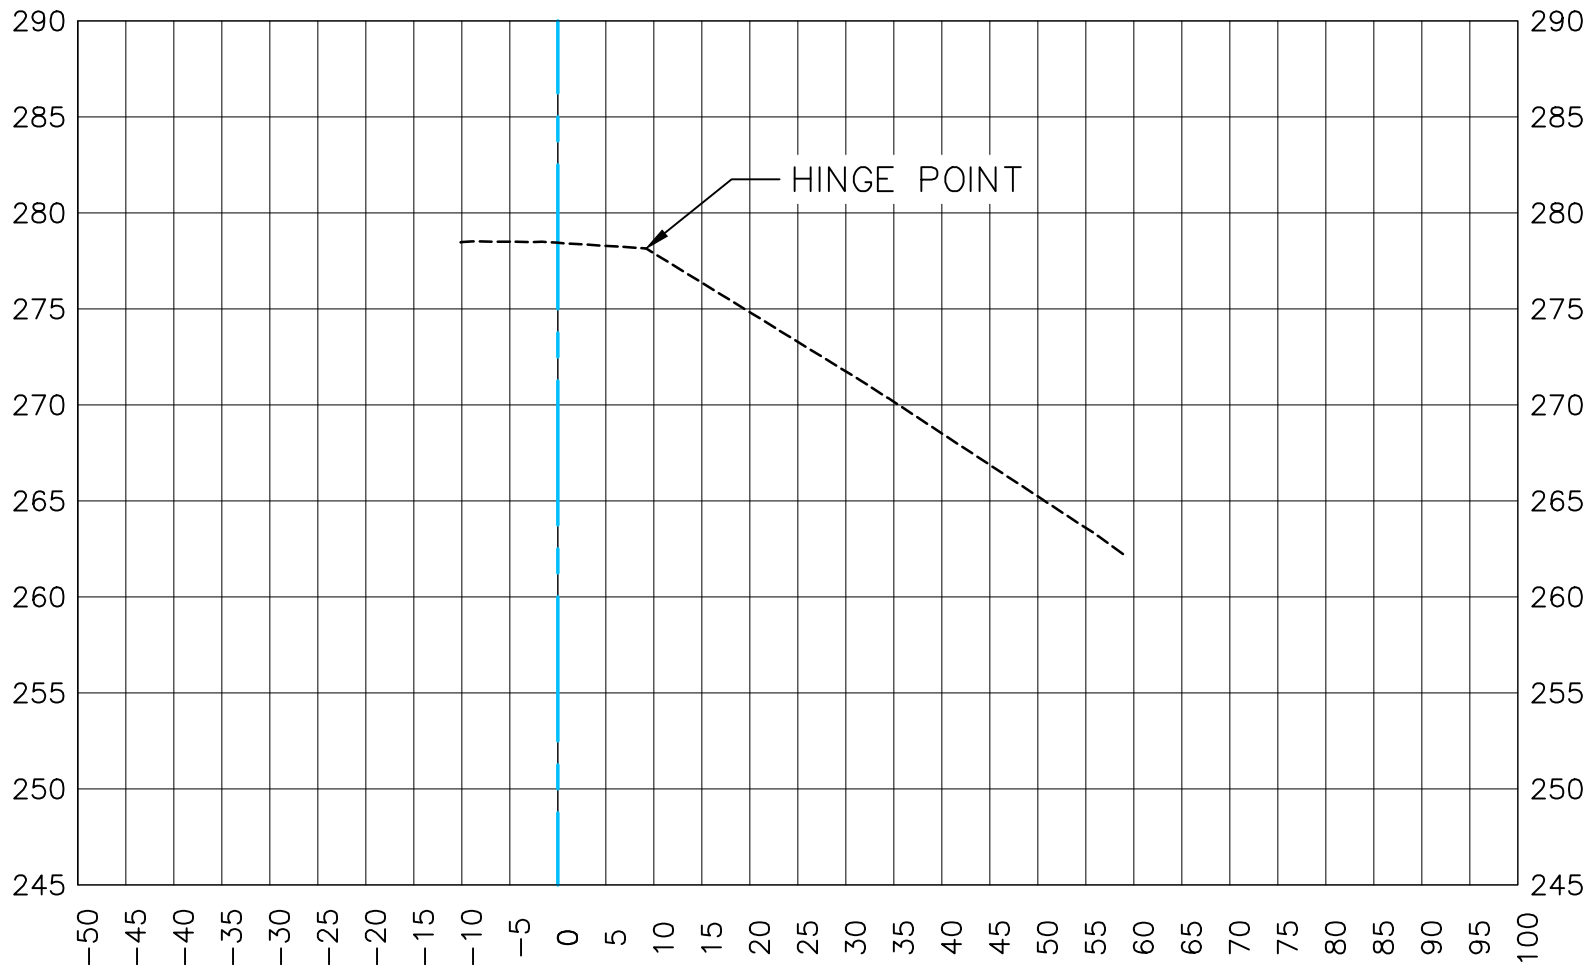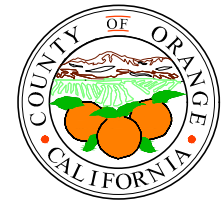

EXISTING CONDITION 2020

Station 37+25.00


Vert. Scale: 1"=5'
Hor. Scale: 1"=20'

DATE PREPARED: 03/23/2020

U.S. Survey Foot

OC Public Works/Engineering Services
OC Survey/Field Services
Boundary Analysis & Mapping

GALIVAN PERIMETER ROAD CL

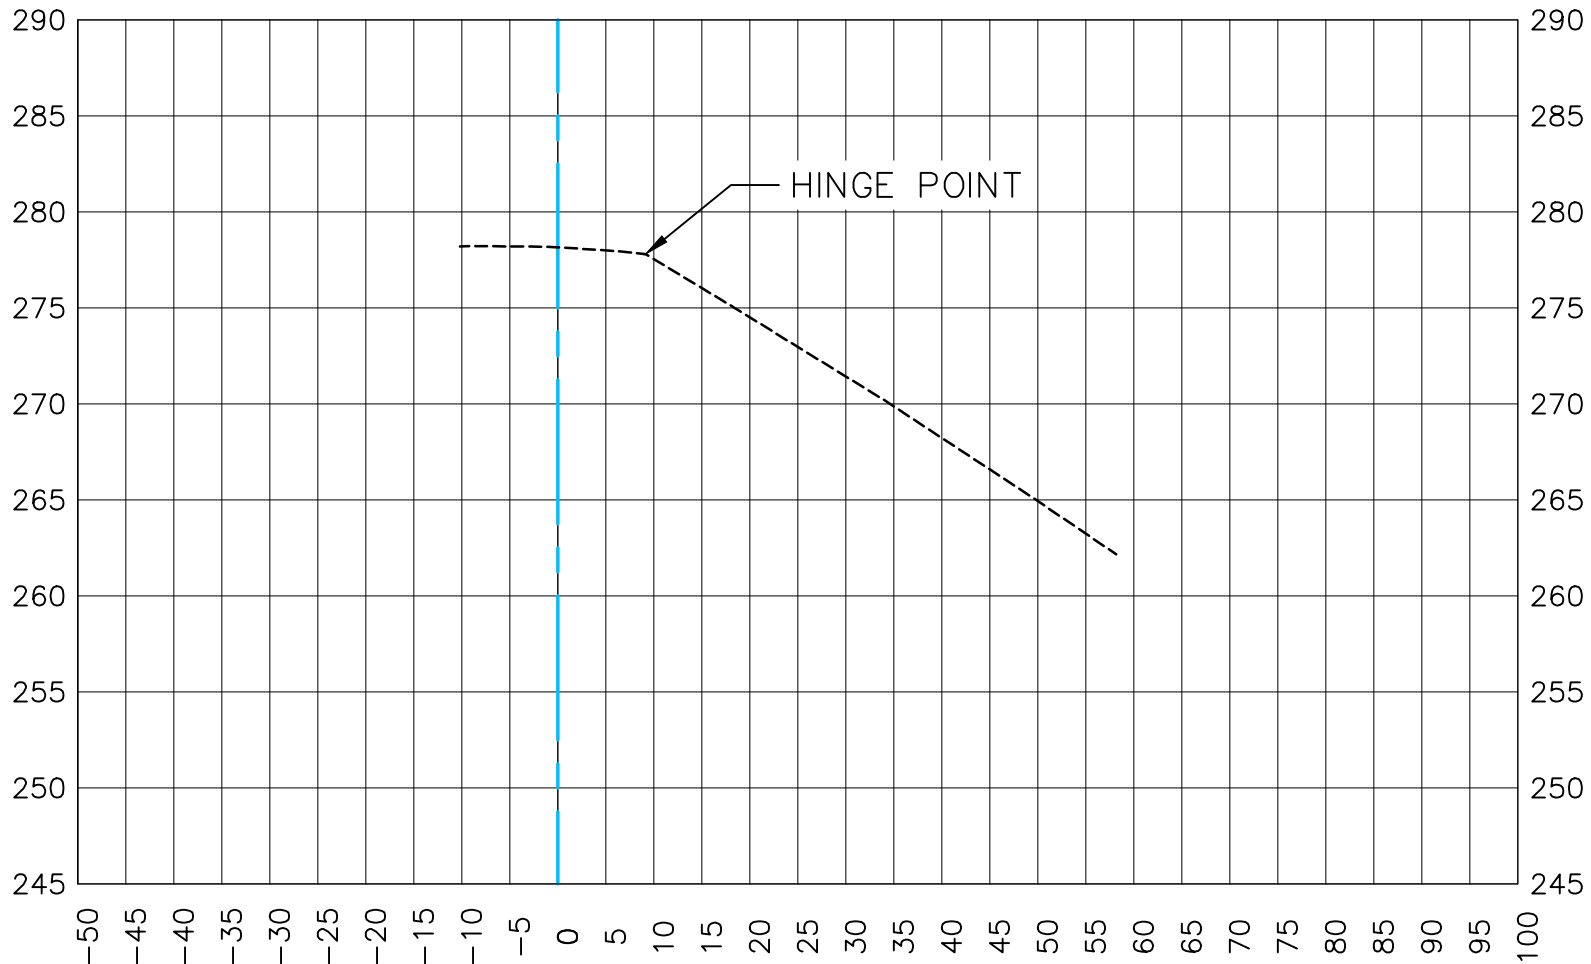

EXISTING CONDITION 2020

Station 37+50.00

Vert. Scale: 1"=5'
Hor. Scale: 1"=20'

DATE PREPARED: 03/23/2020

U.S. Survey Foot

OC Public Works/Engineering Services
OC Survey/Field Services
Boundary Analysis & Mapping

GALIVAN PERIMETER ROAD CL



EXISTING CONDITION 2020

Station 37+75.00


Vert. Scale: 1"=5'
Hor. Scale: 1"=20'

DATE PREPARED: 03/23/2020

U.S. Survey Foot

OC Public Works/Engineering Services
OC Survey/Field Services
Boundary Analysis & Mapping

GALIVAN PERIMETER ROAD CL

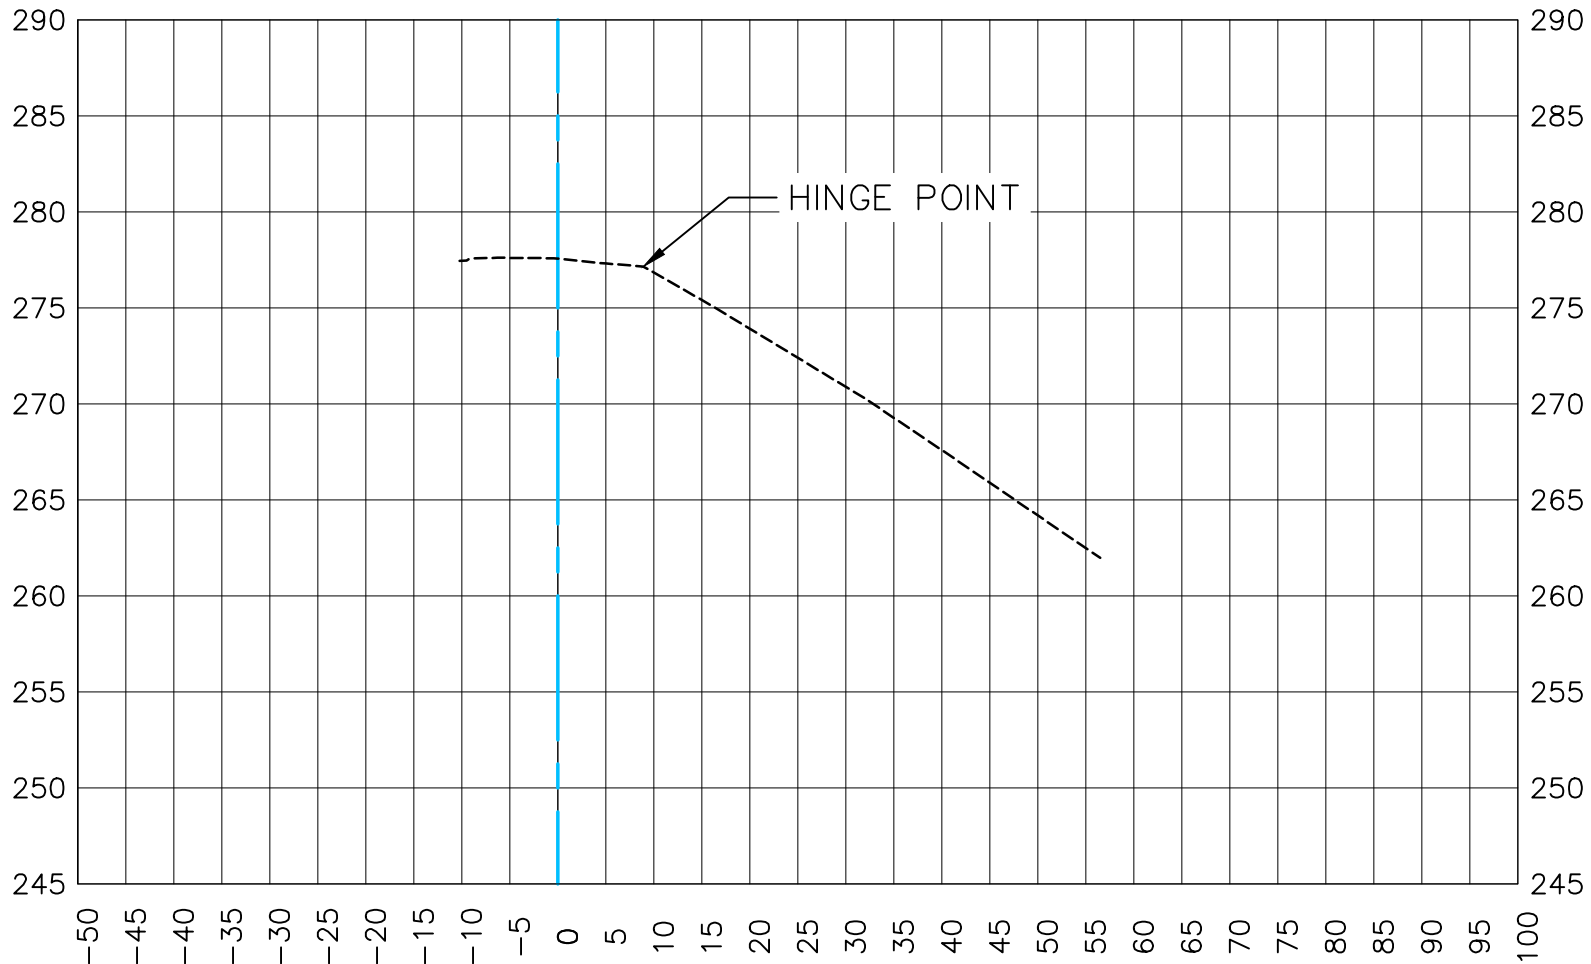


EXISTING CONDITION 2020



Station 38+00.00

Vert. Scale: 1"=5'
Hor. Scale: 1"=20'

DATE PREPARED: 03/23/2020

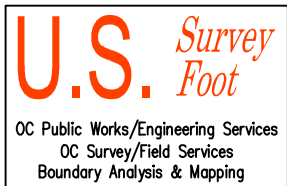

GALIVAN PERIMETER ROAD CL

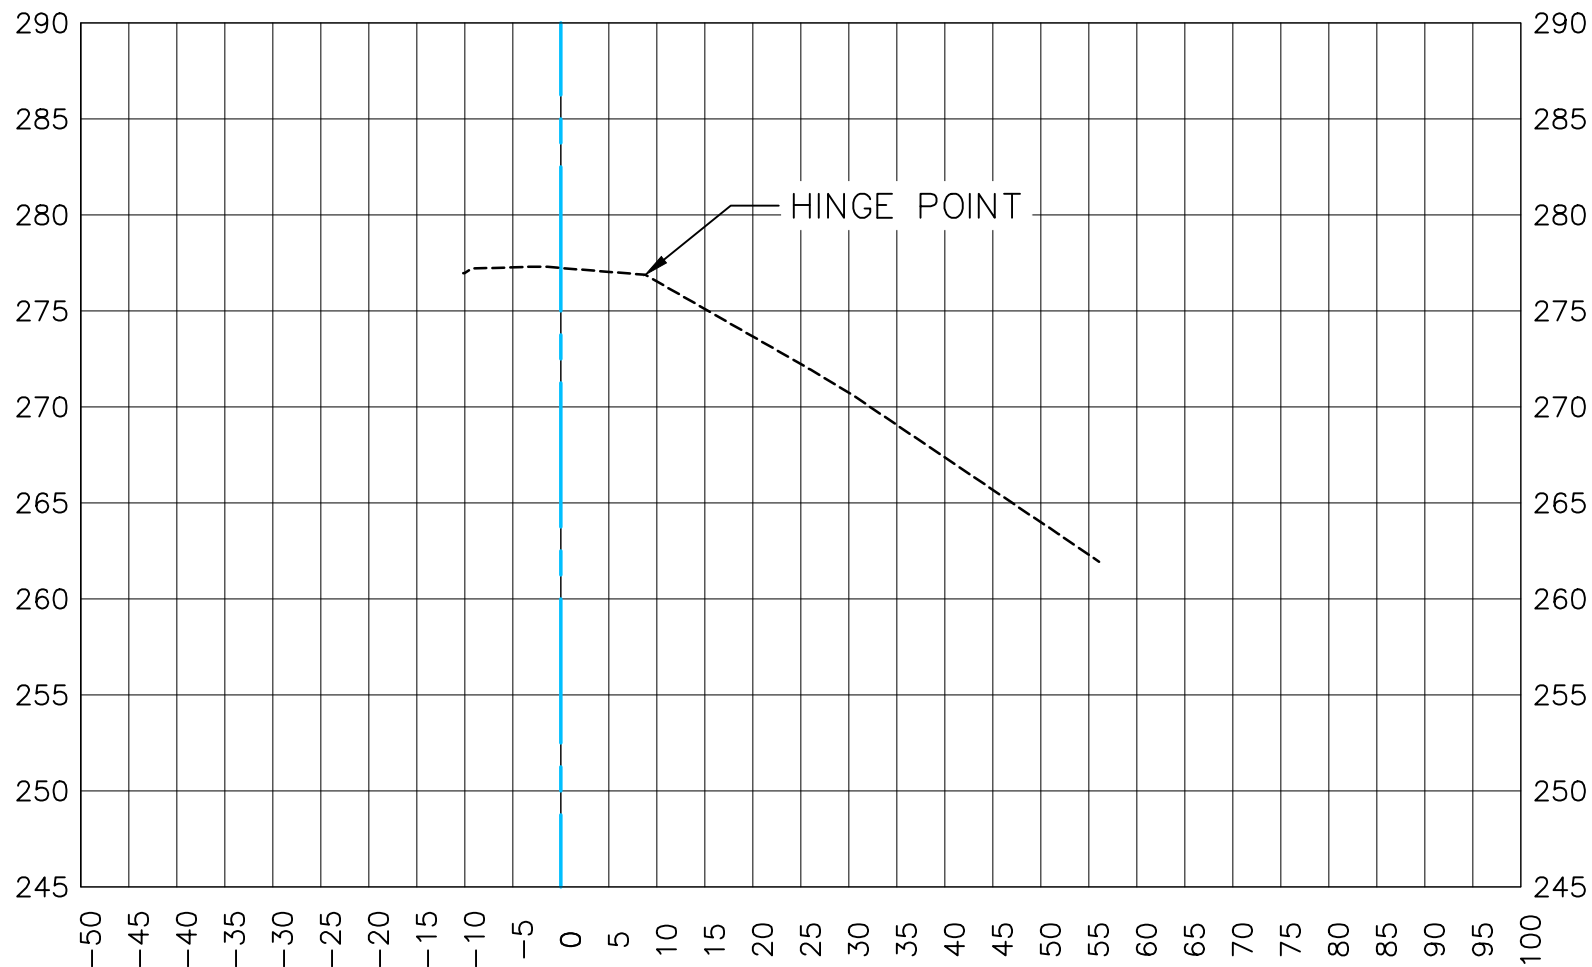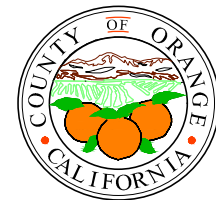


EXISTING CONDITION 2020


Station 38+25.00

Vert. Scale: 1"=5'
Hor. Scale: 1"=20'

DATE PREPARED: 03/23/2020

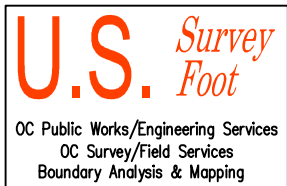

GALIVAN PERIMETER ROAD CL

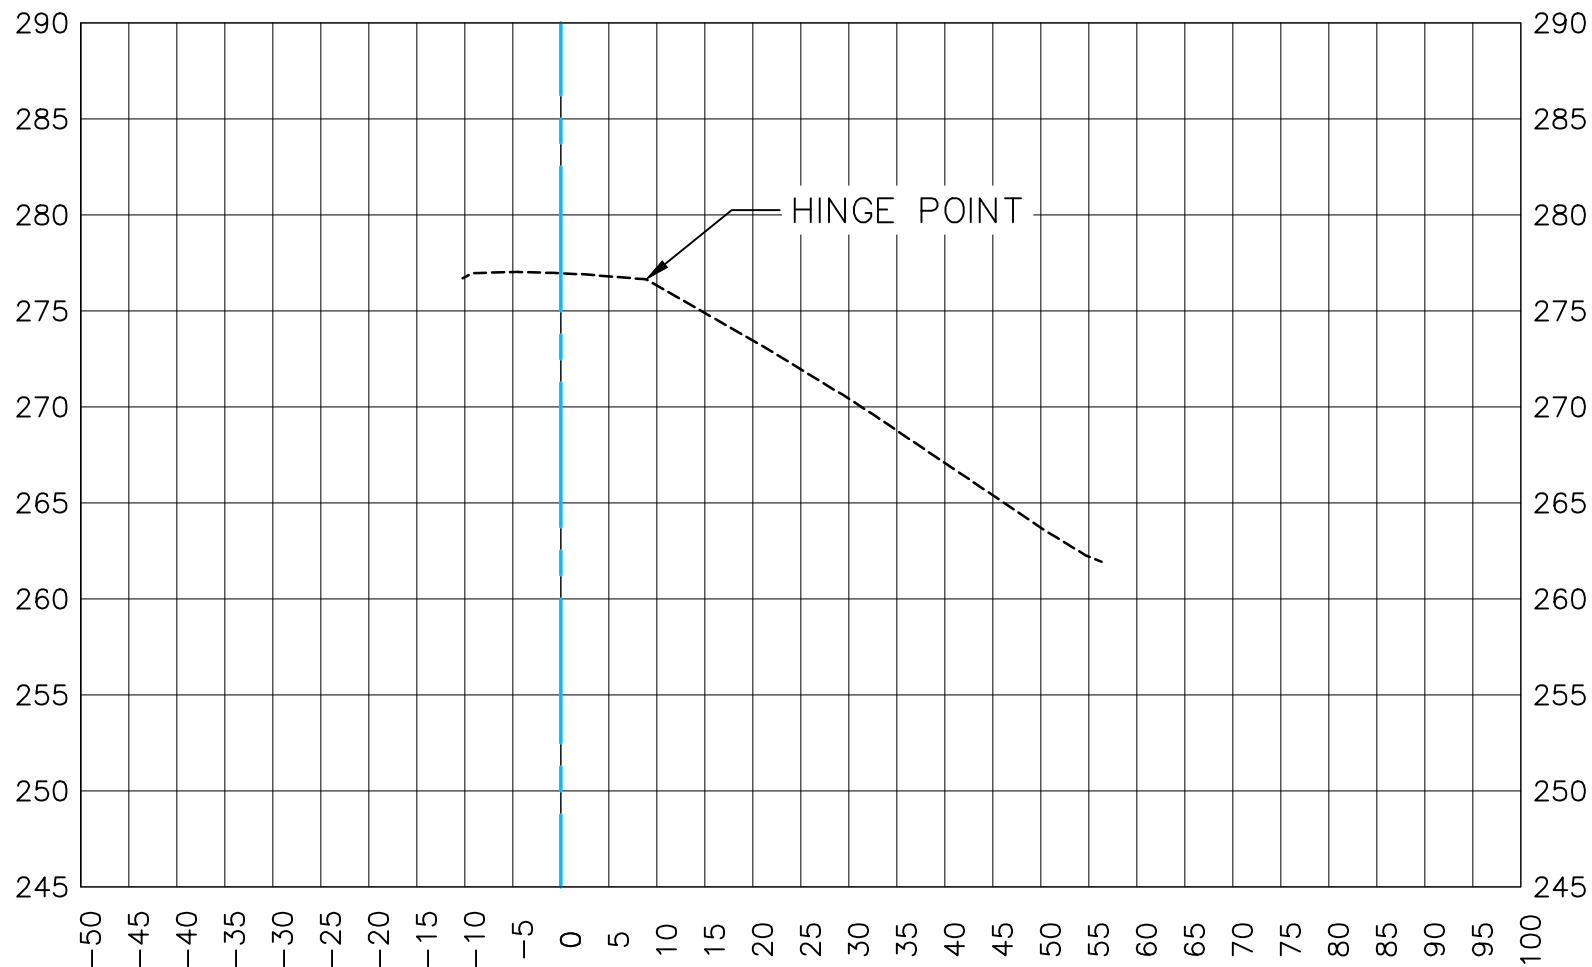

EXISTING CONDITION 2020

Station 38+50.00

Vert. Scale: 1"=5'


Hor. Scale: 1"=20'

DATE PREPARED: 03/23/2020

U.S. Survey Foot

OC Public Works/Engineering Services
OC Survey/Field Services
Boundary Analysis & Mapping

GALIVAN PERIMETER ROAD CL

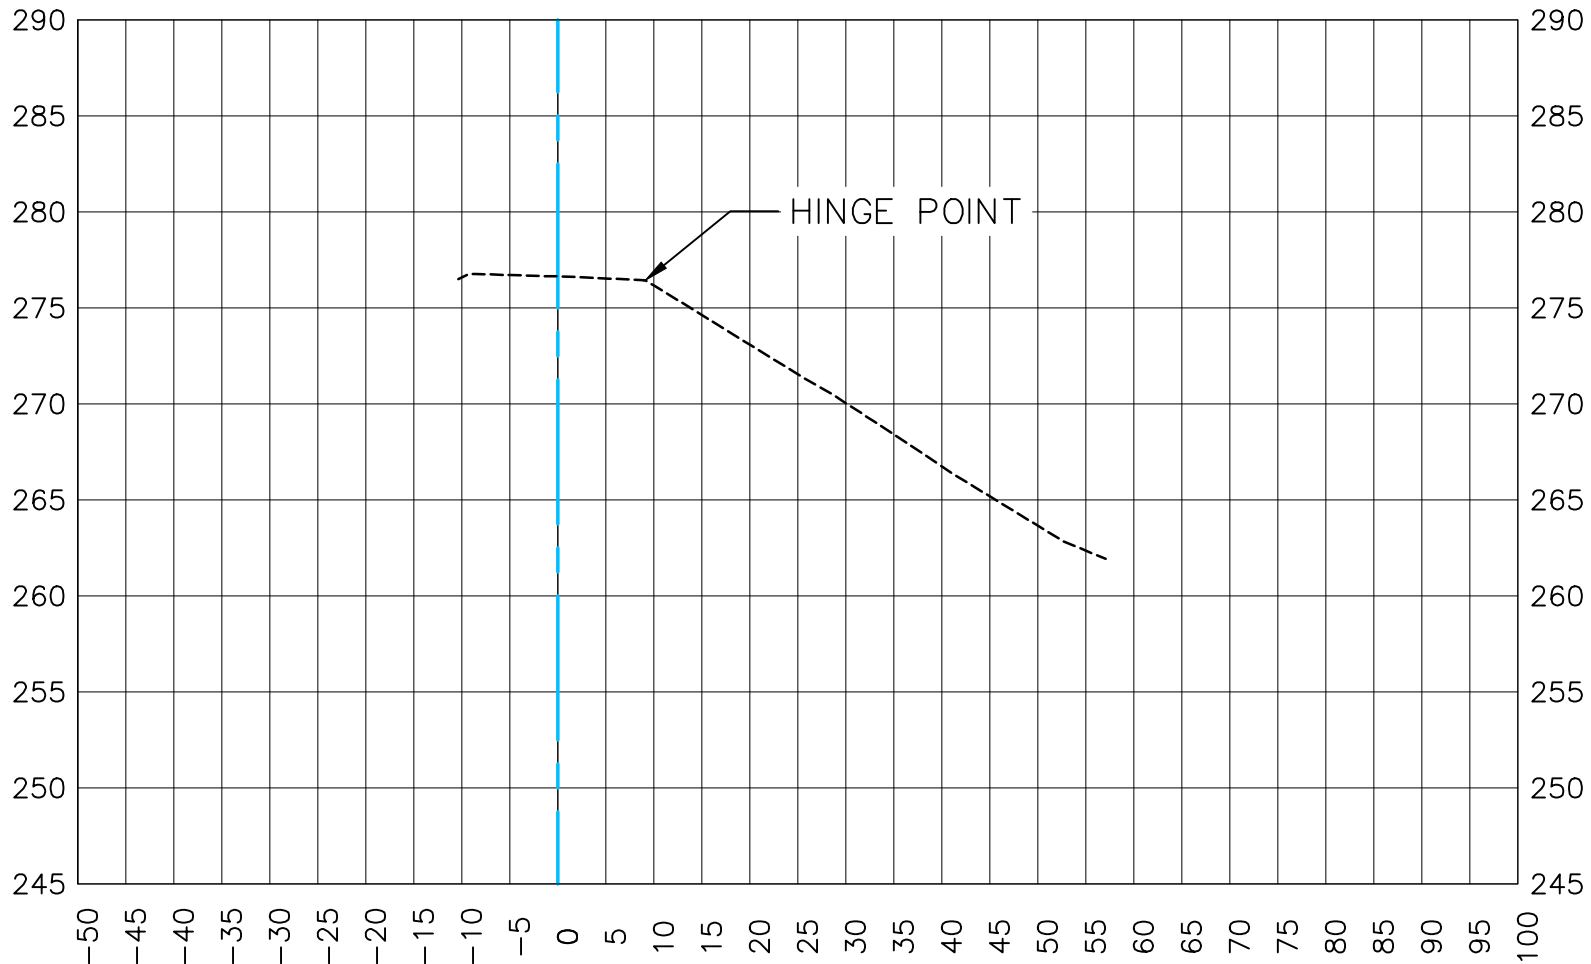


EXISTING CONDITION 2020



Station 38+75.00

Vert. Scale: 1"=5'
Hor. Scale: 1"=20'

DATE PREPARED: 03/23/2020

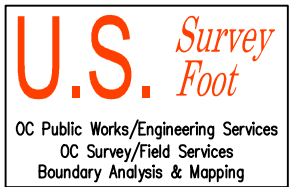

GALIVAN PERIMETER ROAD CL

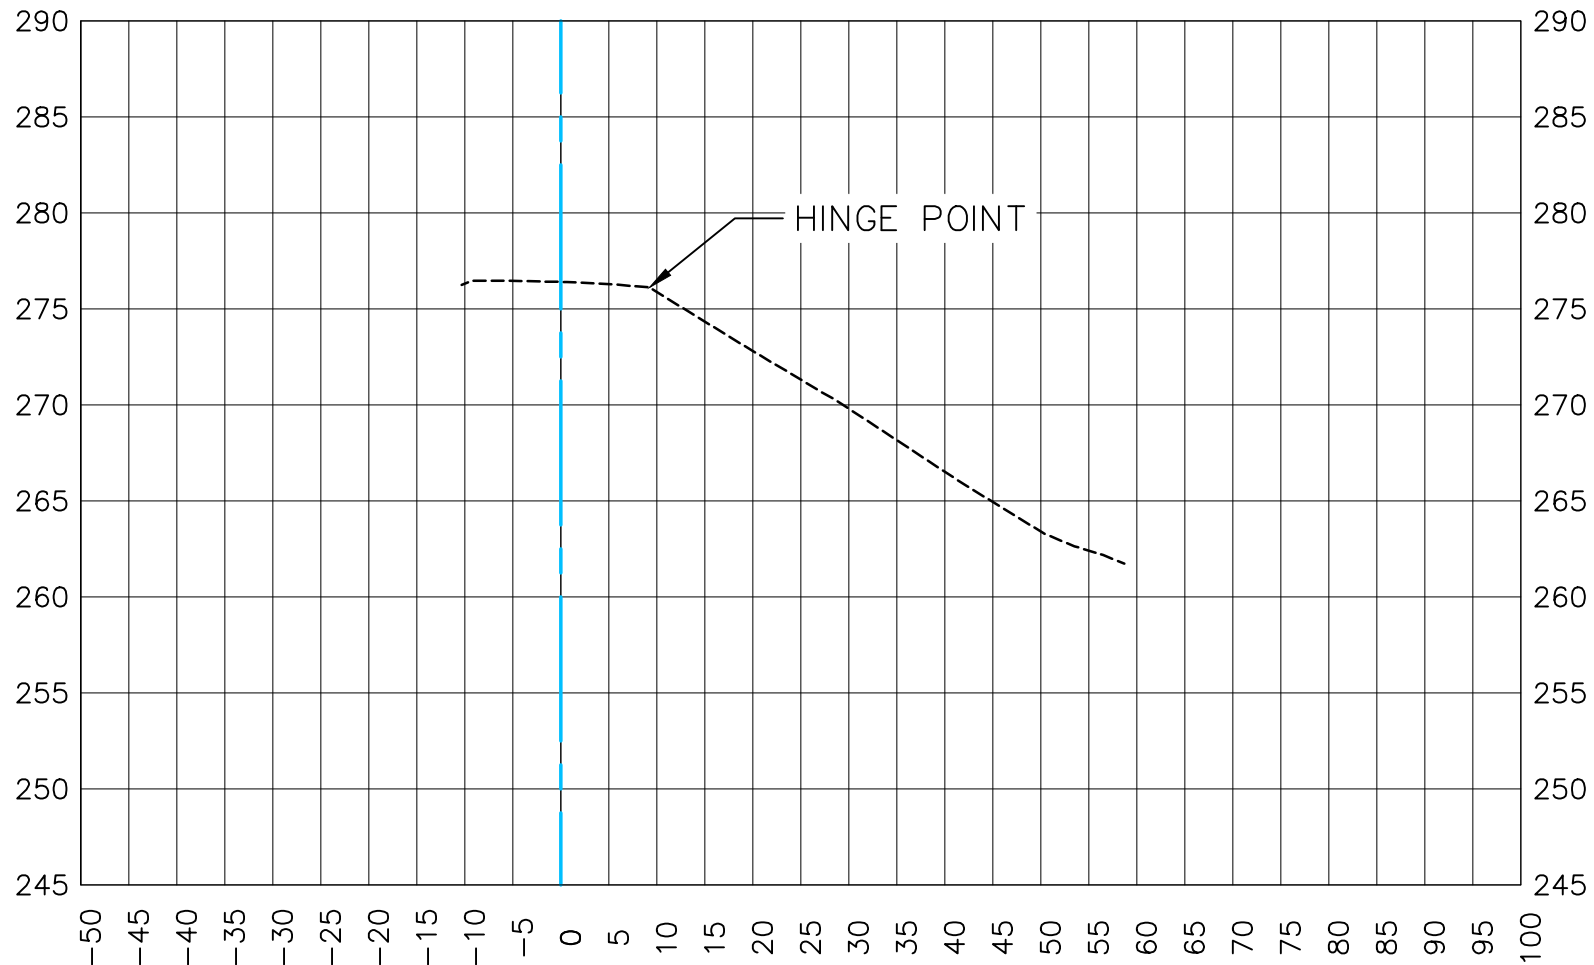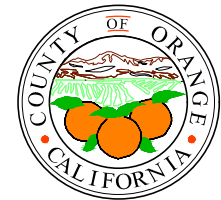


EXISTING CONDITION 2020



Station 39+00.00

Vert. Scale: 1"=5'
Hor. Scale: 1"=20'

DATE PREPARED: 03/23/2020

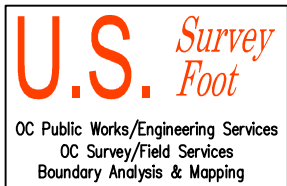

GALIVAN PERIMETER ROAD CL

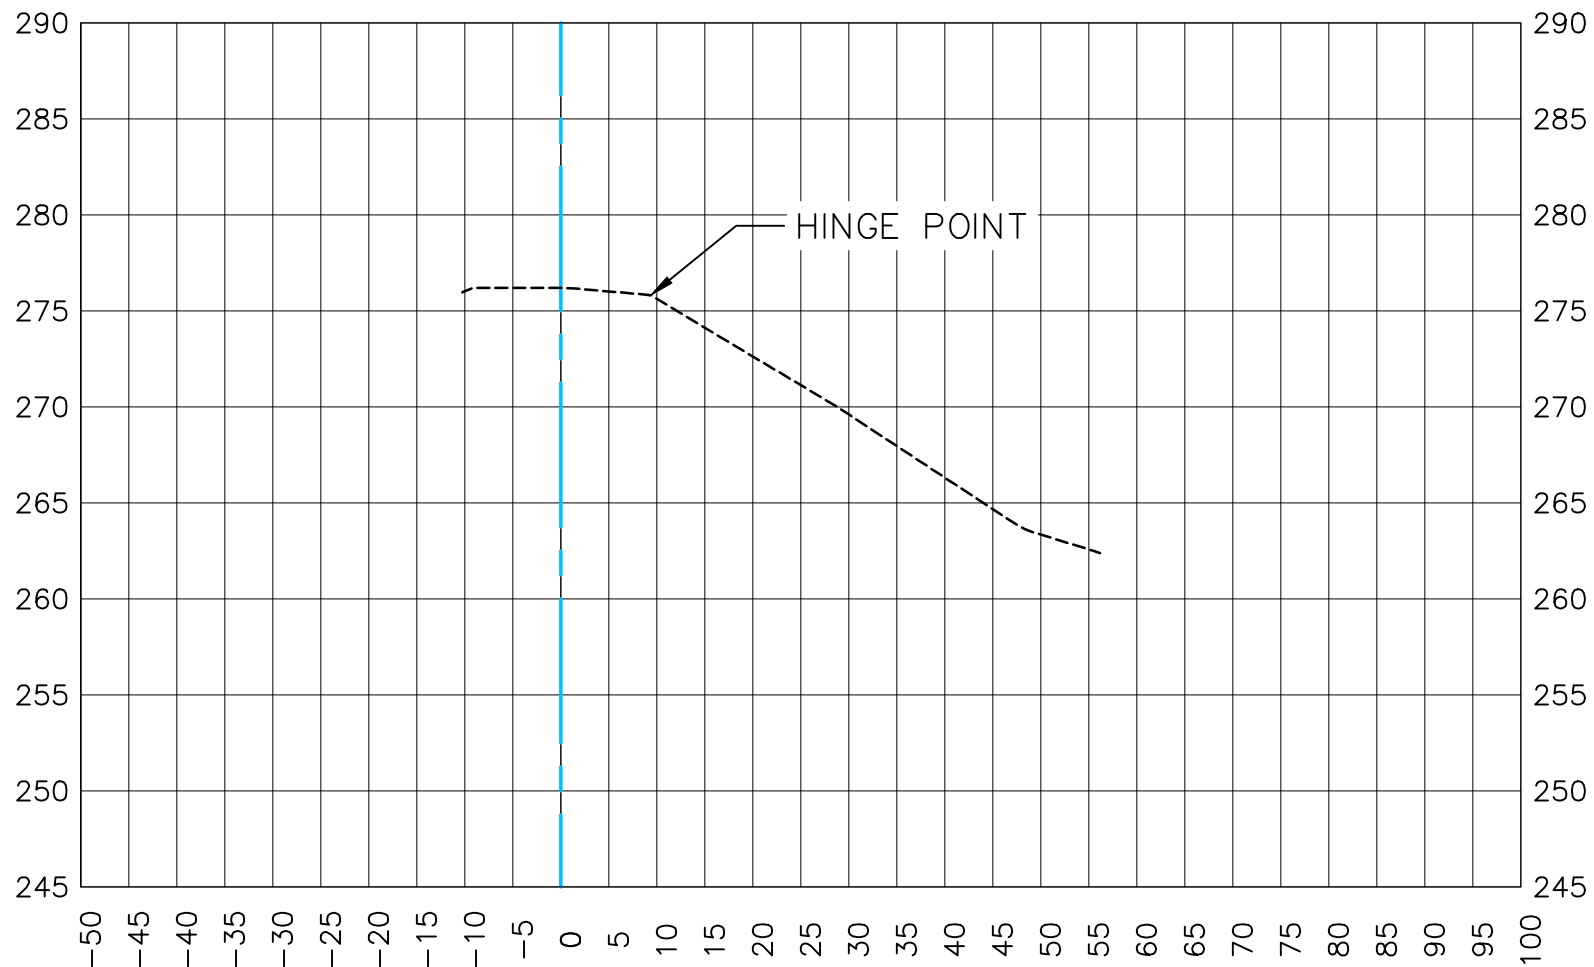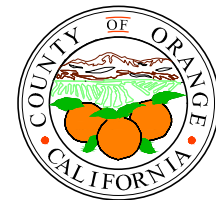


EXISTING CONDITION 2020



Station 39+25.00

Vert. Scale: 1"=5'
Hor. Scale: 1"=20'

DATE PREPARED: 03/23/2020

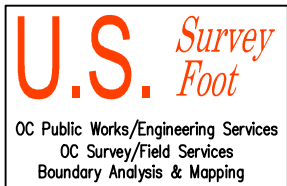

GALIVAN PERIMETER ROAD CL

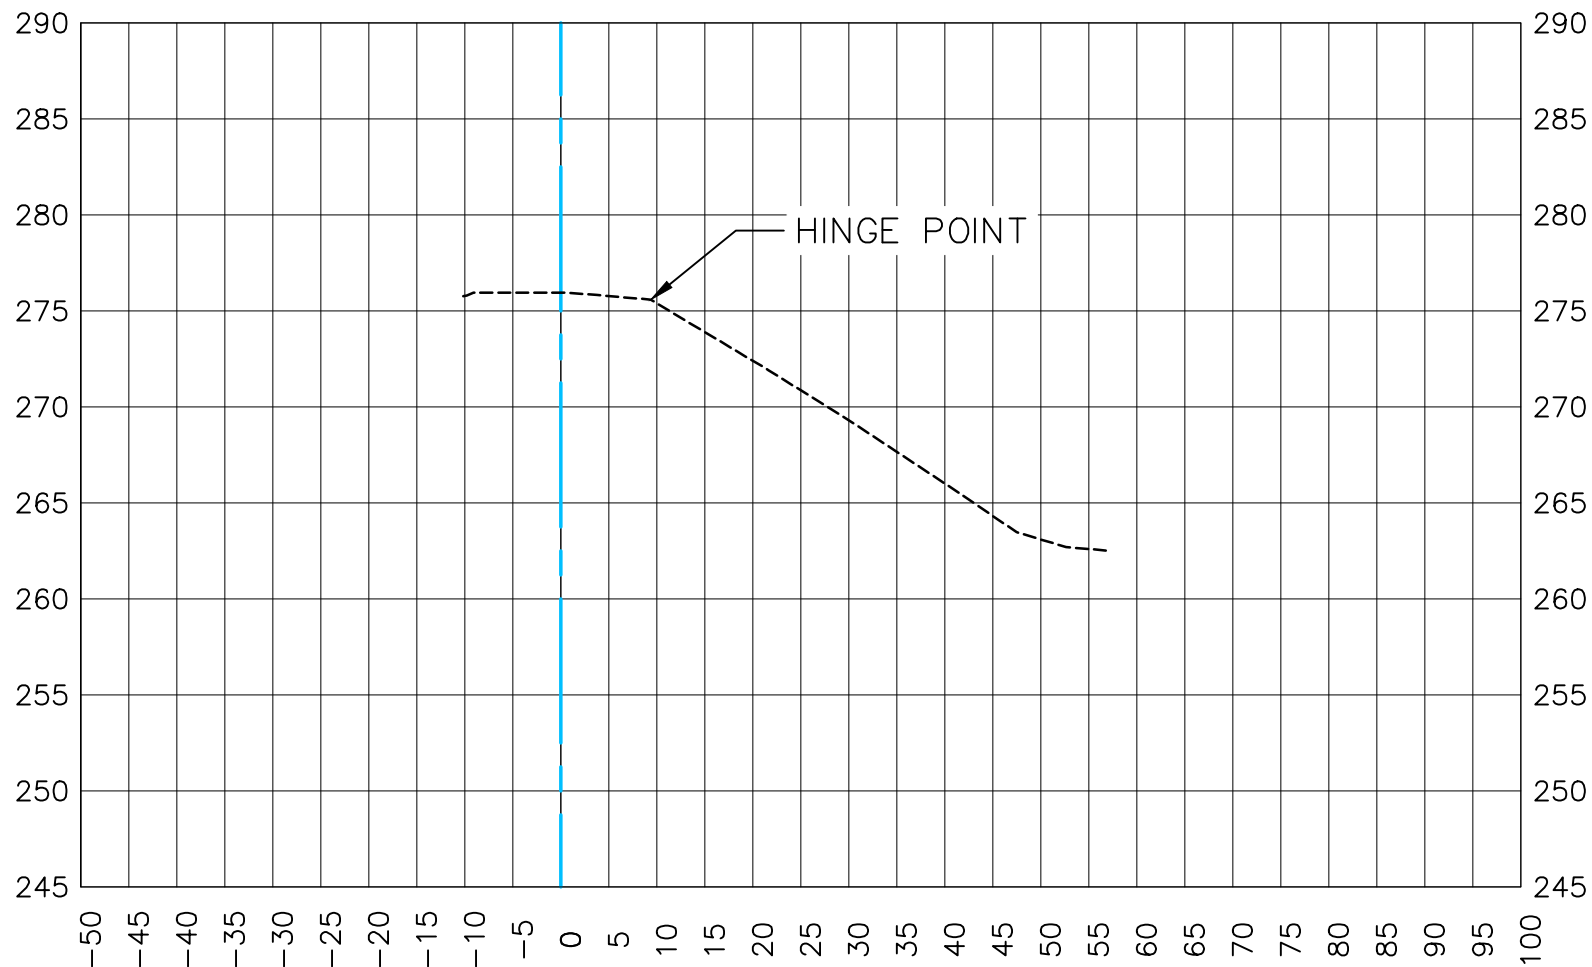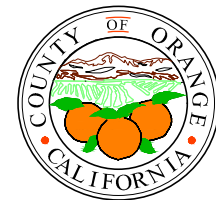


EXISTING CONDITION 2020



Station 39+50.00

Vert. Scale: 1"=5'
Hor. Scale: 1"=20'

DATE PREPARED: 03/23/2020

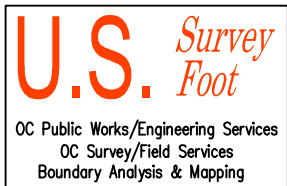

GALIVAN PERIMETER ROAD CL

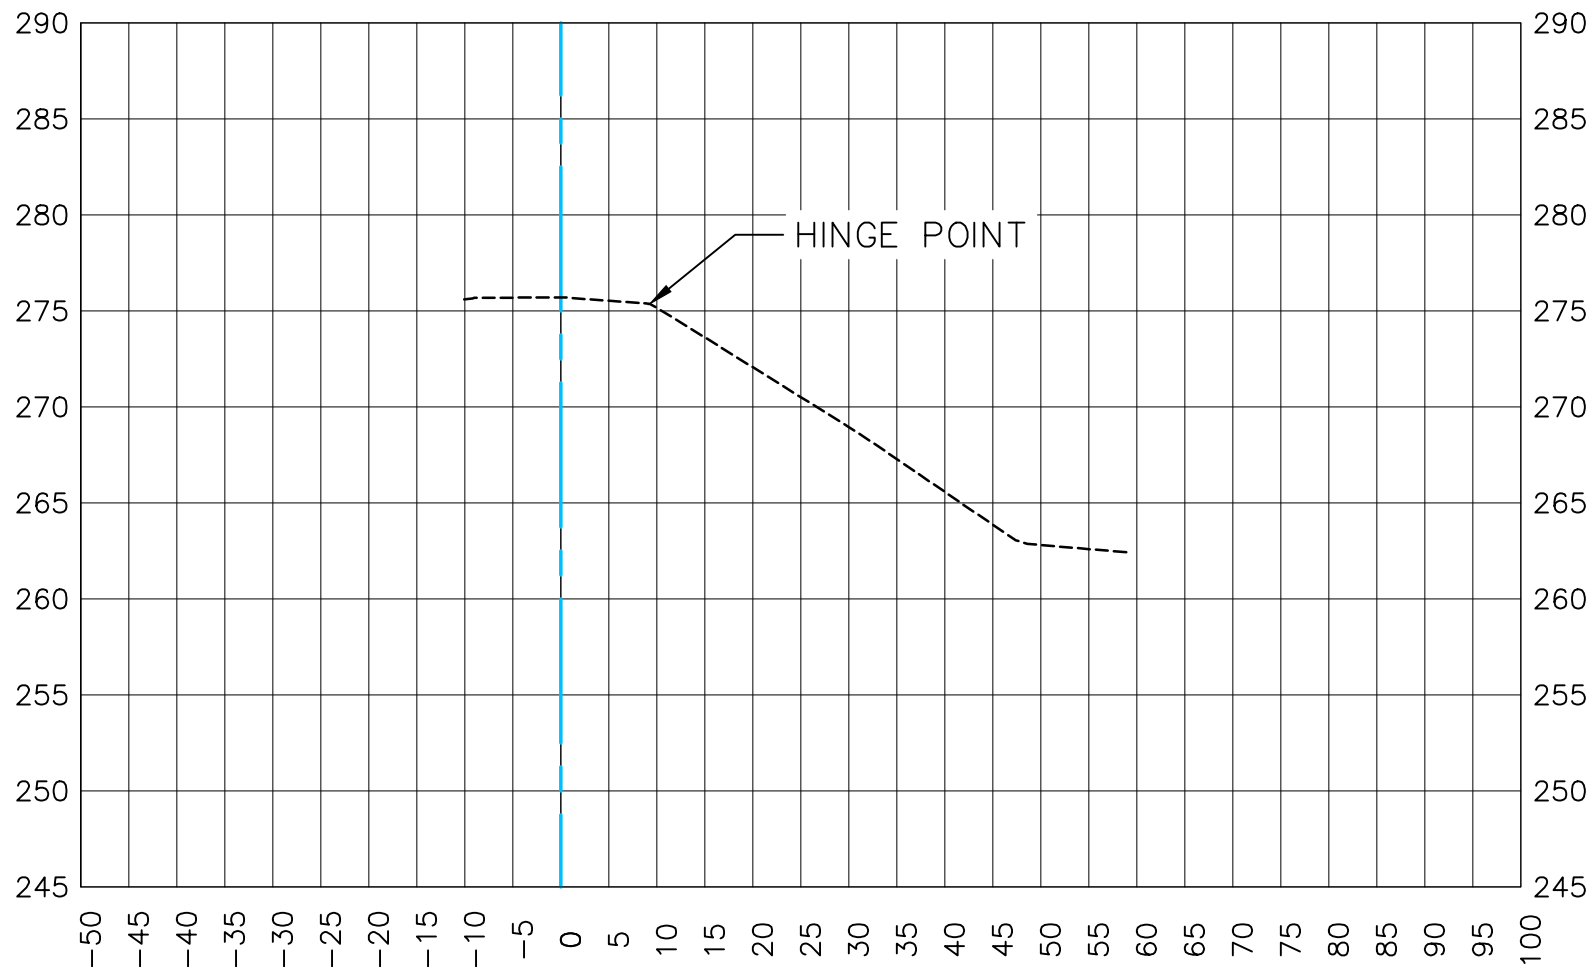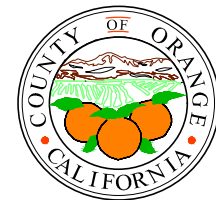


EXISTING CONDITION 2020



Station 39+75.00

Vert. Scale: 1"=5'
Hor. Scale: 1"=20'

DATE PREPARED: 03/23/2020

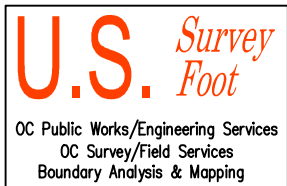

GALIVAN PERIMETER ROAD CL

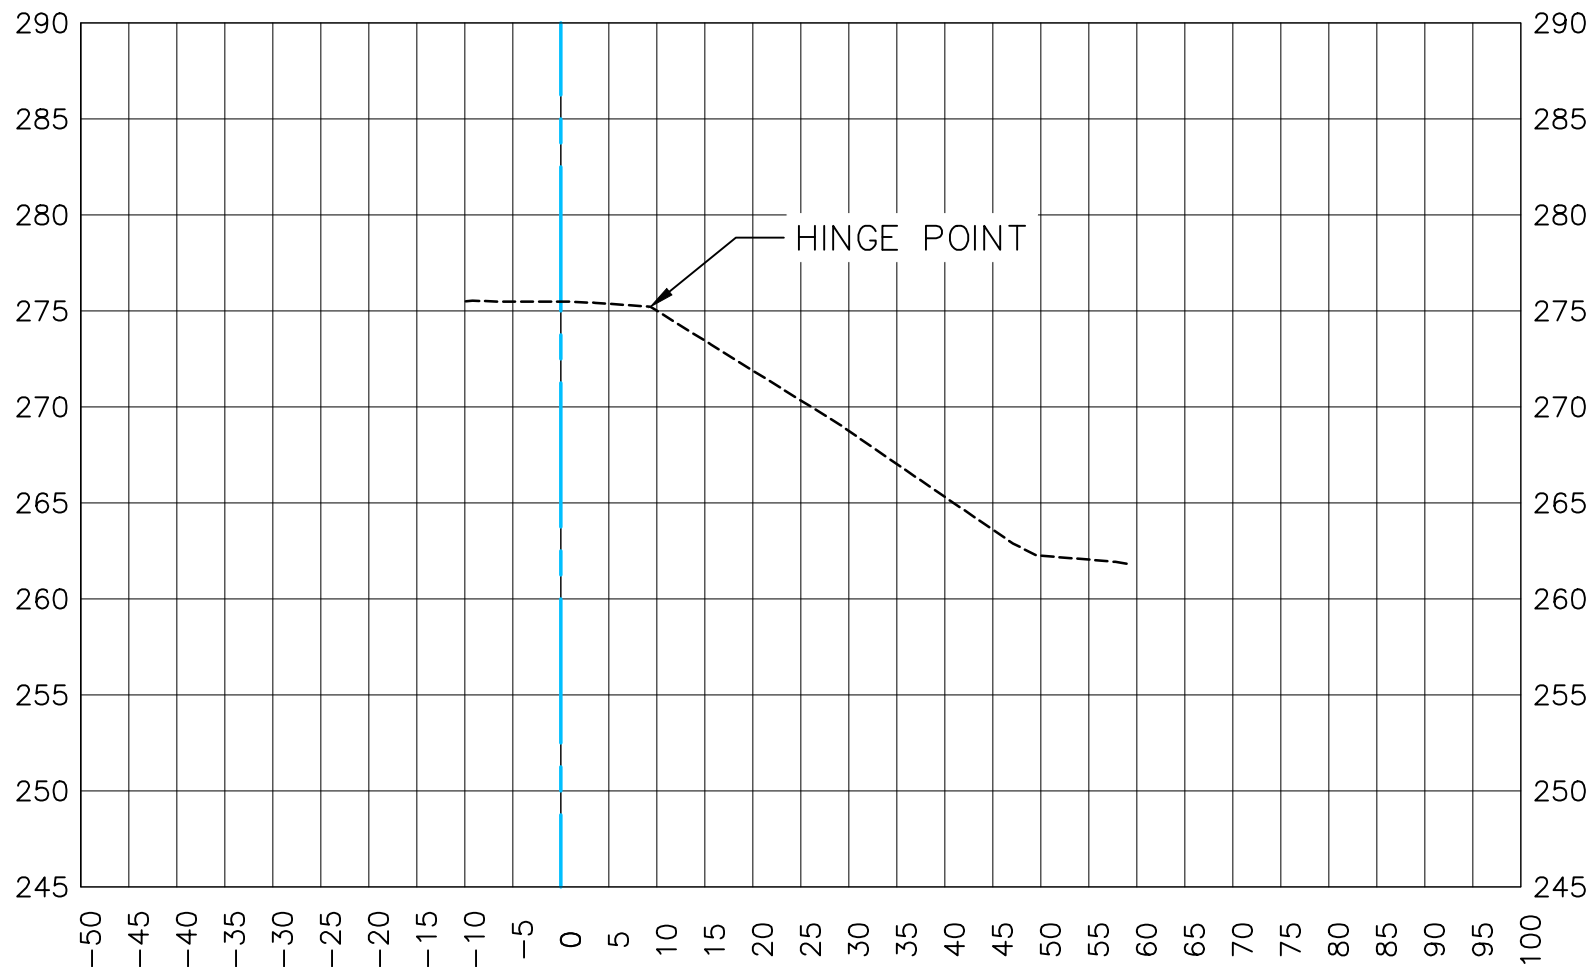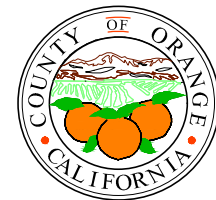


EXISTING CONDITION 2020



Station 40+00.00

Vert. Scale: 1"=5'
Hor. Scale: 1"=20'

DATE PREPARED: 03/23/2020

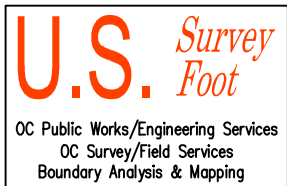

GALIVAN PERIMETER ROAD CL

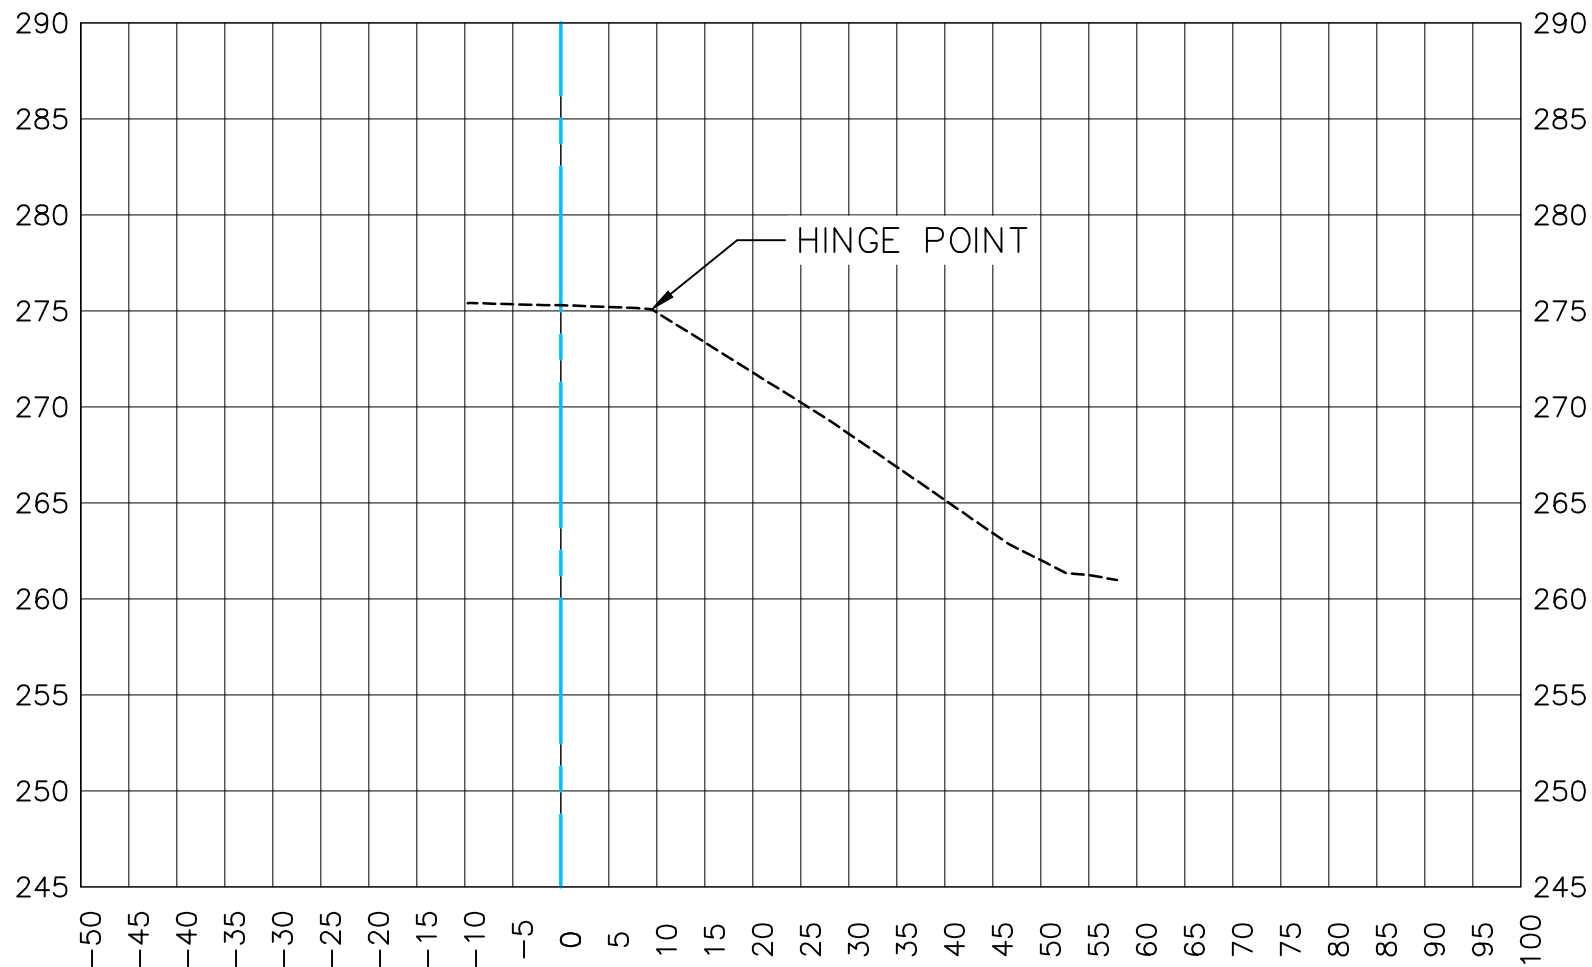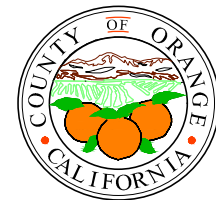


EXISTING CONDITION 2020

Station 40+25.00



Vert. Scale: 1"=5'

Hor. Scale: 1"=20'

DATE PREPARED: 03/23/2020

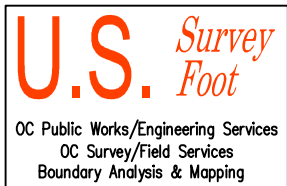

GALIVAN PERIMETER ROAD CL

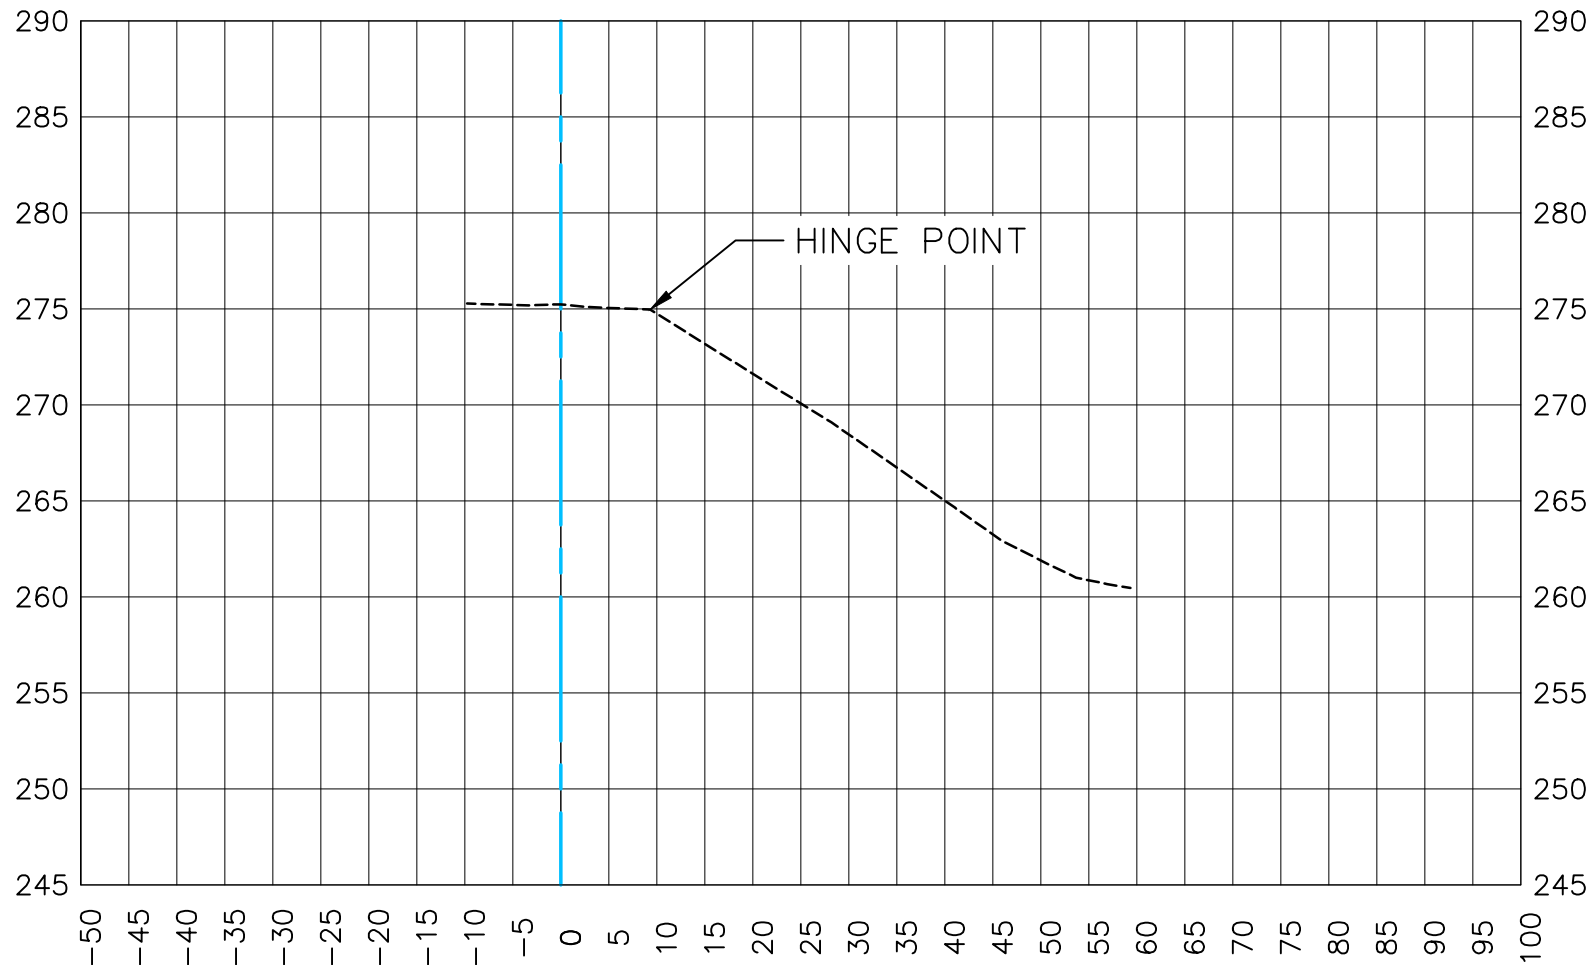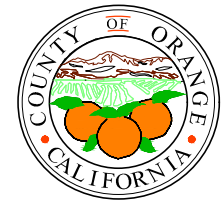


EXISTING CONDITION 2020

Station 40+50.00



Vert. Scale: 1"=5'

Hor. Scale: 1"=20'

DATE PREPARED: 03/23/2020

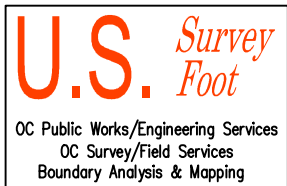

GALIVAN PERIMETER ROAD CL

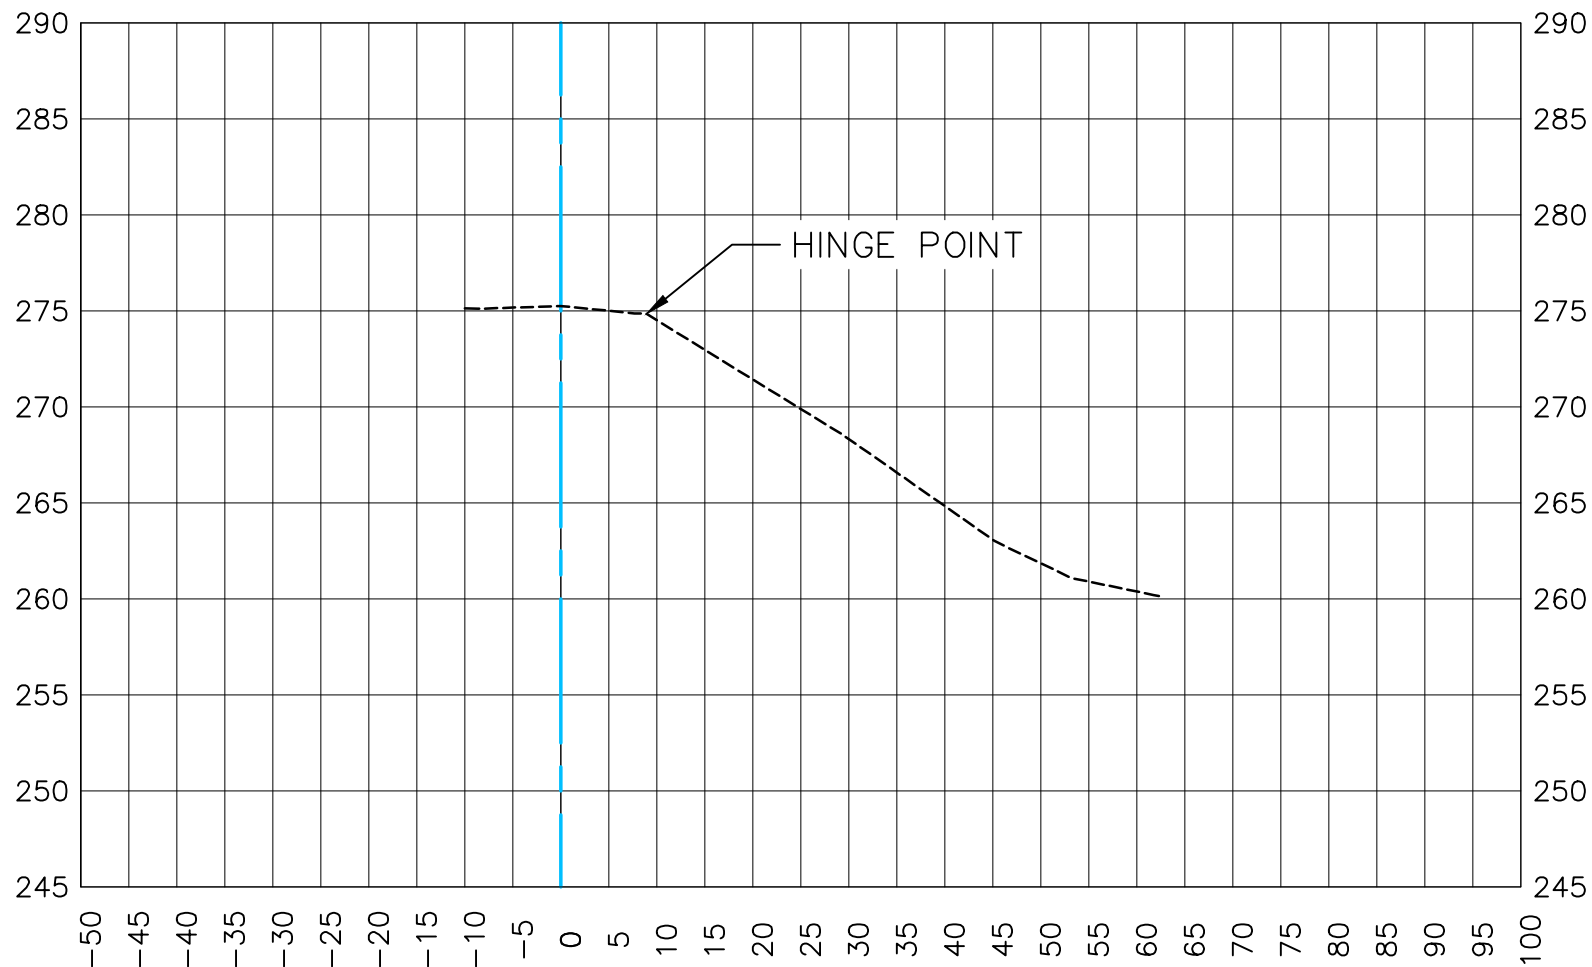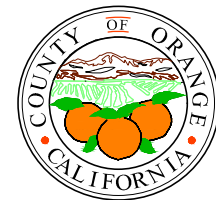


EXISTING CONDITION 2020



Station 40+75.00

Vert. Scale: 1"=5'
Hor. Scale: 1"=20'

DATE PREPARED: 03/23/2020

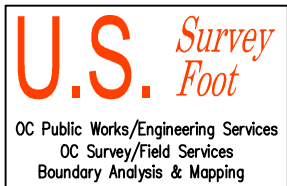

GALIVAN PERIMETER ROAD CL

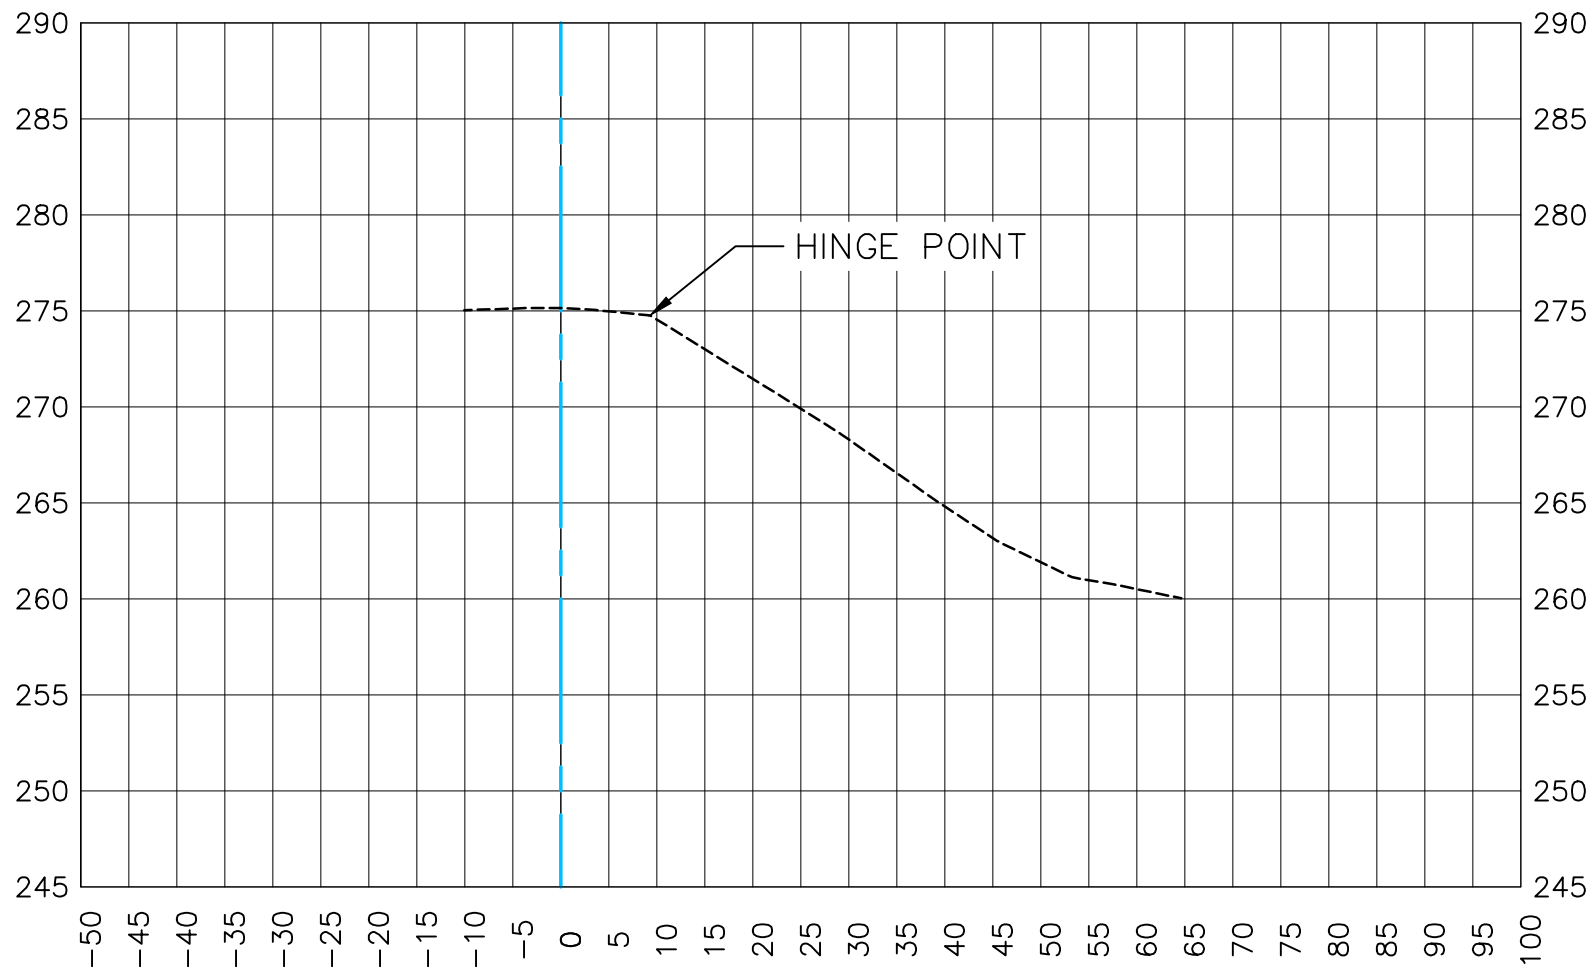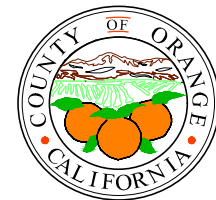


EXISTING CONDITION 2020

Station 41+00.00


Vert. Scale: 1"=5'

Hor. Scale: 1"=20'

DATE PREPARED: 03/23/2020

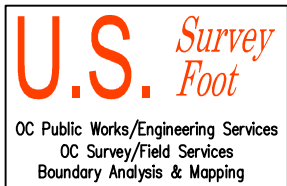

GALIVAN PERIMETER ROAD CL

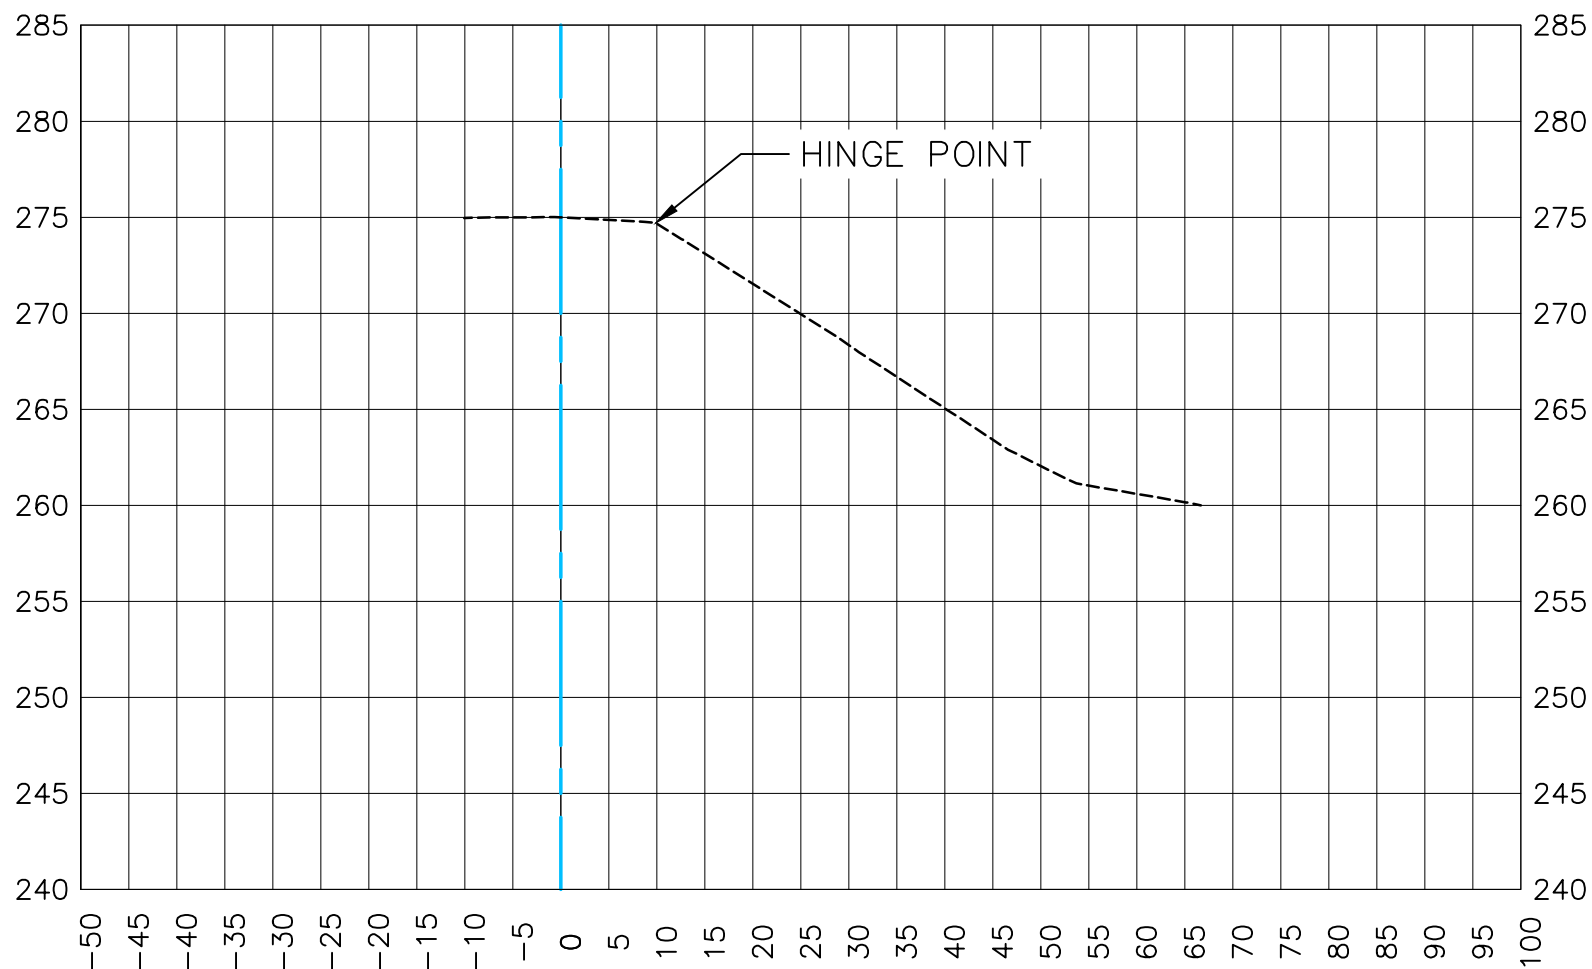


EXISTING CONDITION 2020

Station 41+25.00



Vert. Scale: 1"=5'

Hor. Scale: 1"=20'

DATE PREPARED: 03/23/2020

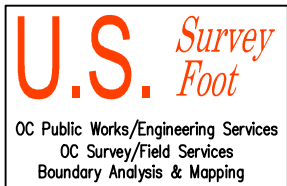

GALIVAN PERIMETER ROAD CL

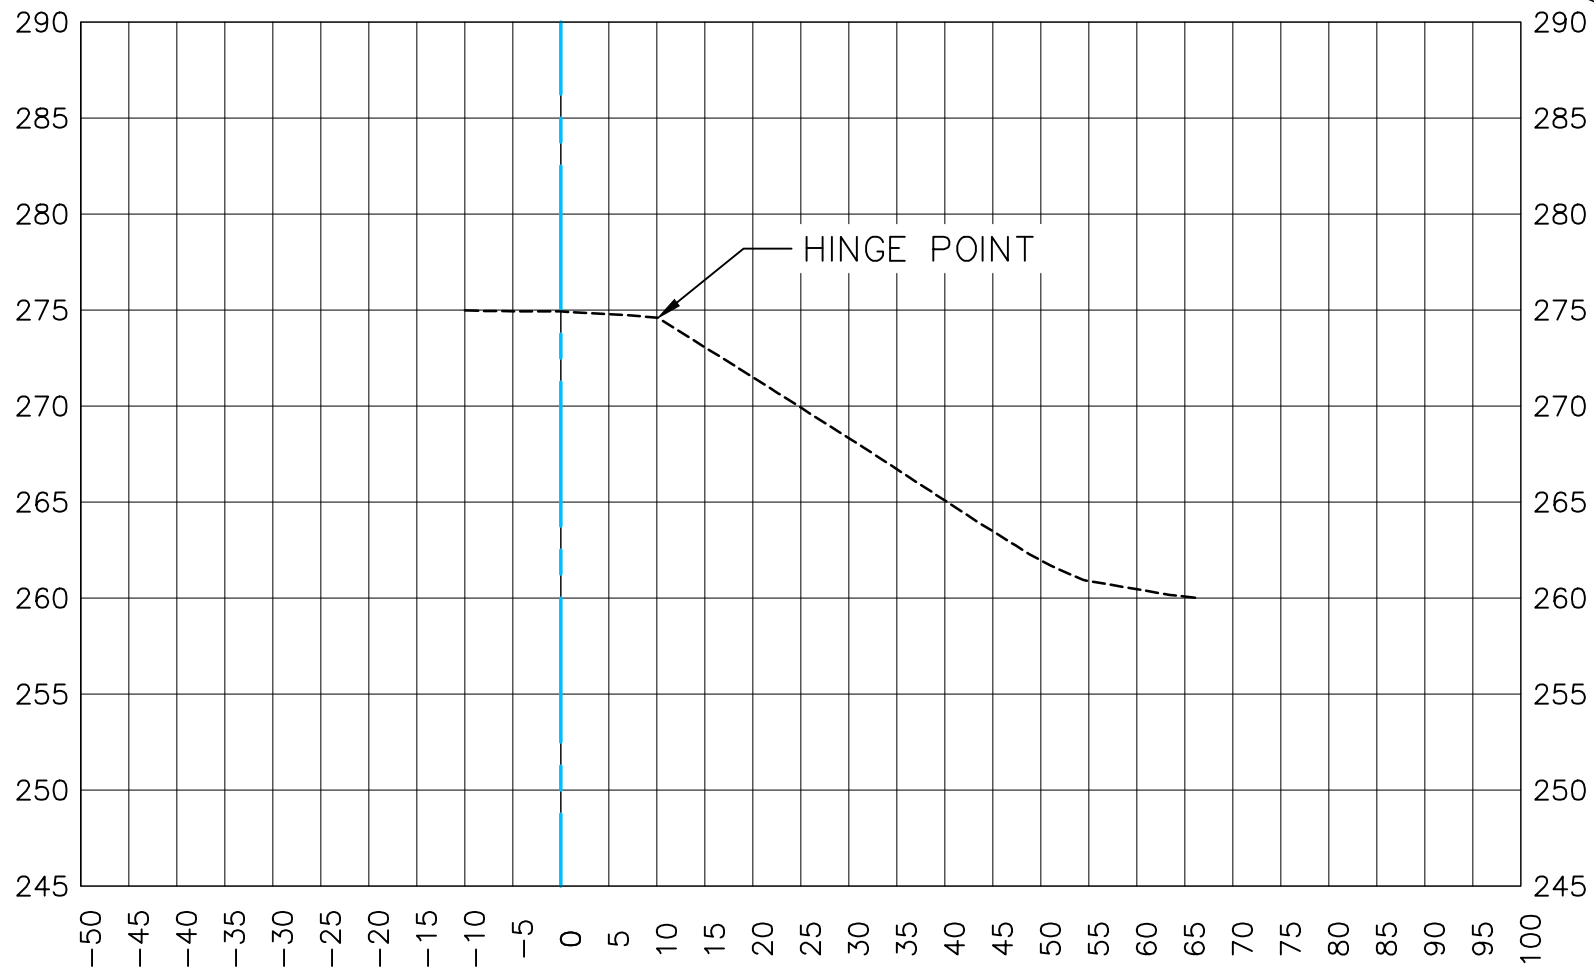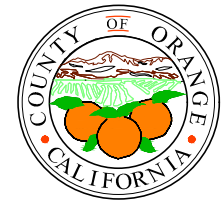


EXISTING CONDITION 2020


Station 41+50.00

Vert. Scale: 1"=5'
Hor. Scale: 1"=20'

DATE PREPARED: 03/23/2020

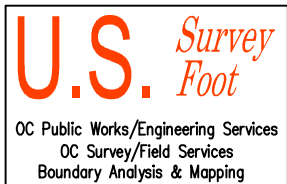

GALIVAN PERIMETER ROAD CL

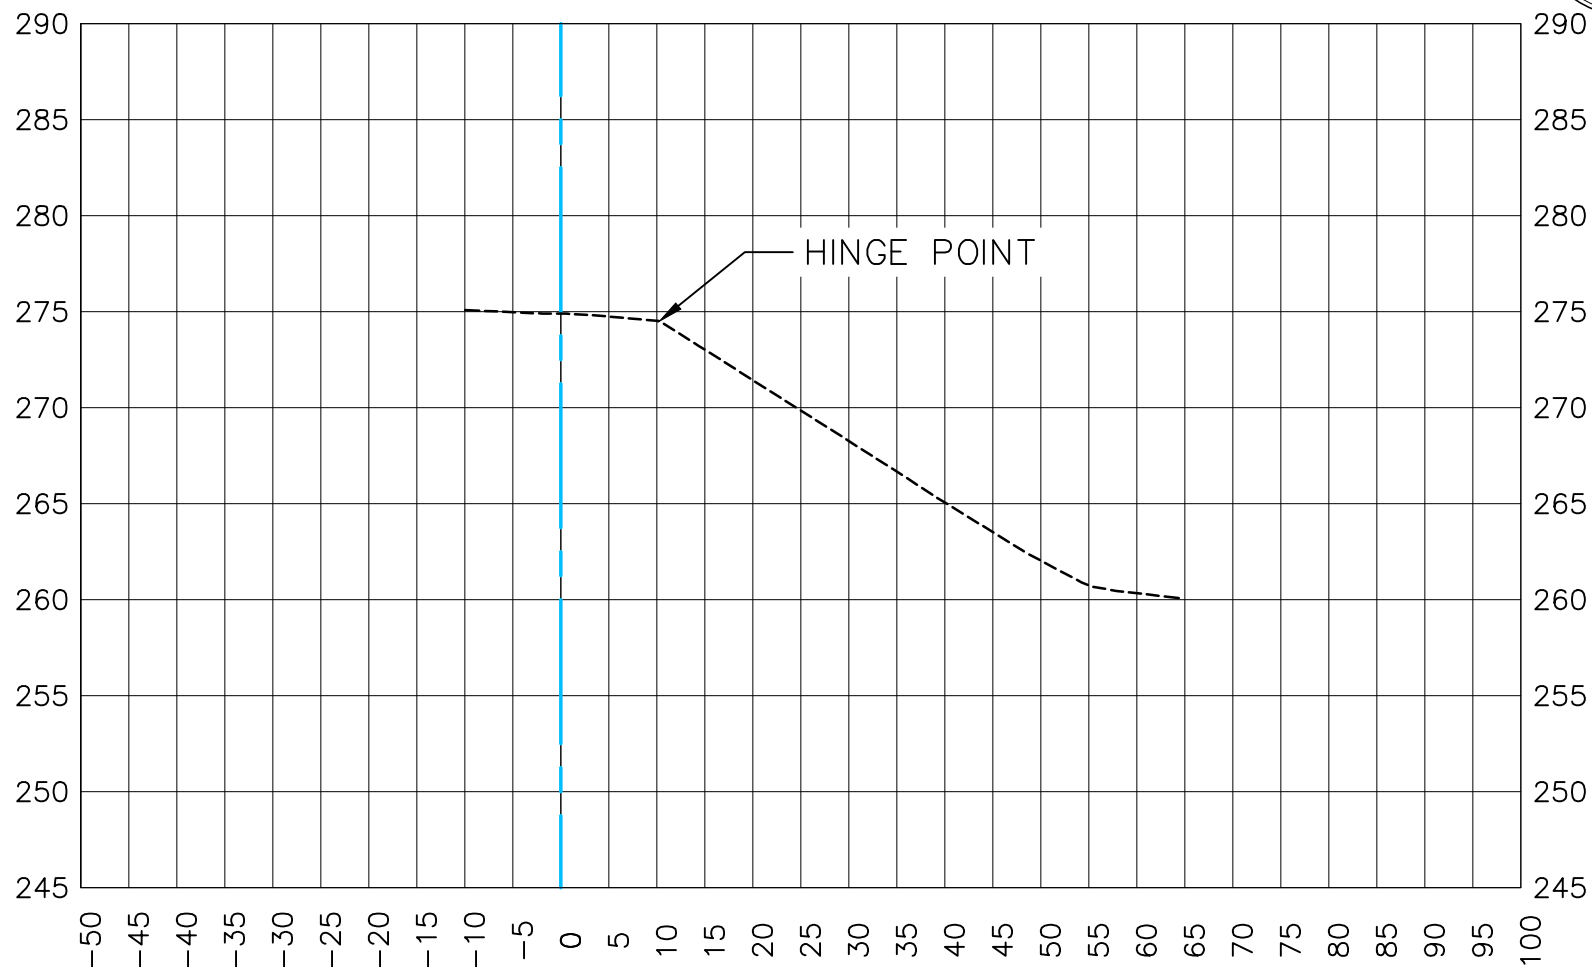


EXISTING CONDITION 2020


Station 41+75.00

Vert. Scale: 1"=5'
Hor. Scale: 1"=20'

DATE PREPARED: 03/23/2020

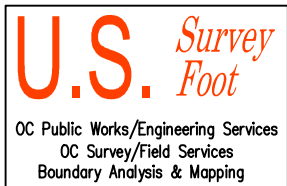

GALIVAN PERIMETER ROAD CL

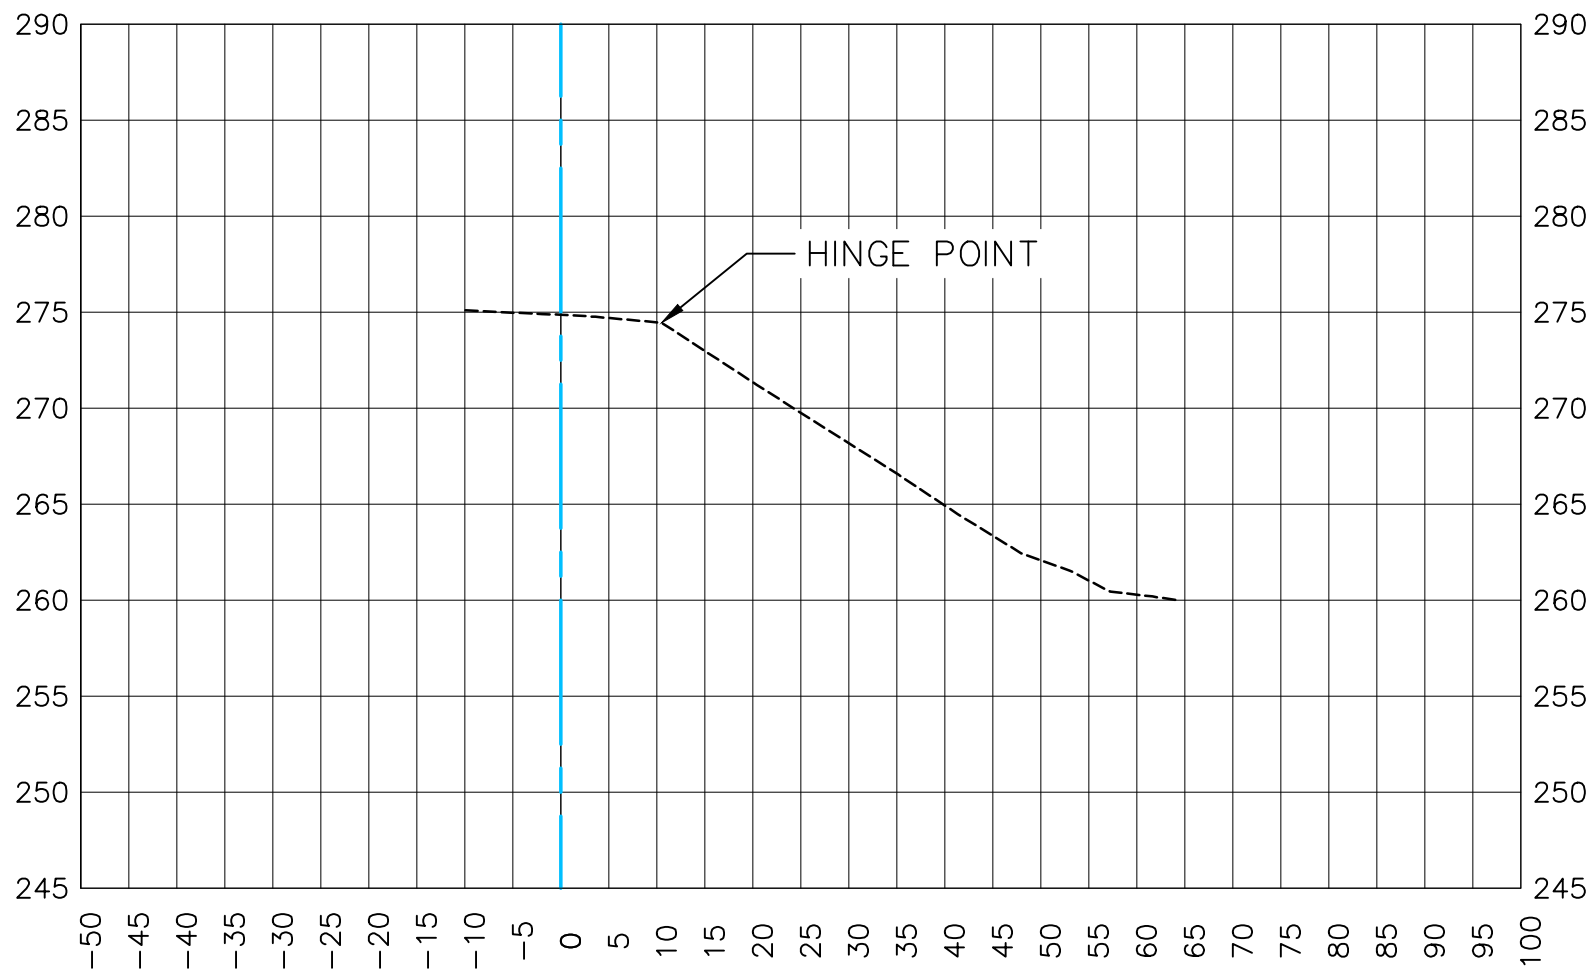


EXISTING CONDITION 2020

Station 42+00.00


Vert. Scale: 1"=5'

Hor. Scale: 1"=20'

DATE PREPARED: 03/23/2020

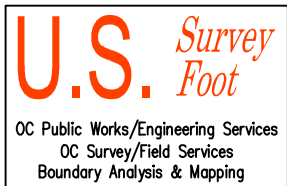

GALIVAN PERIMETER ROAD CL

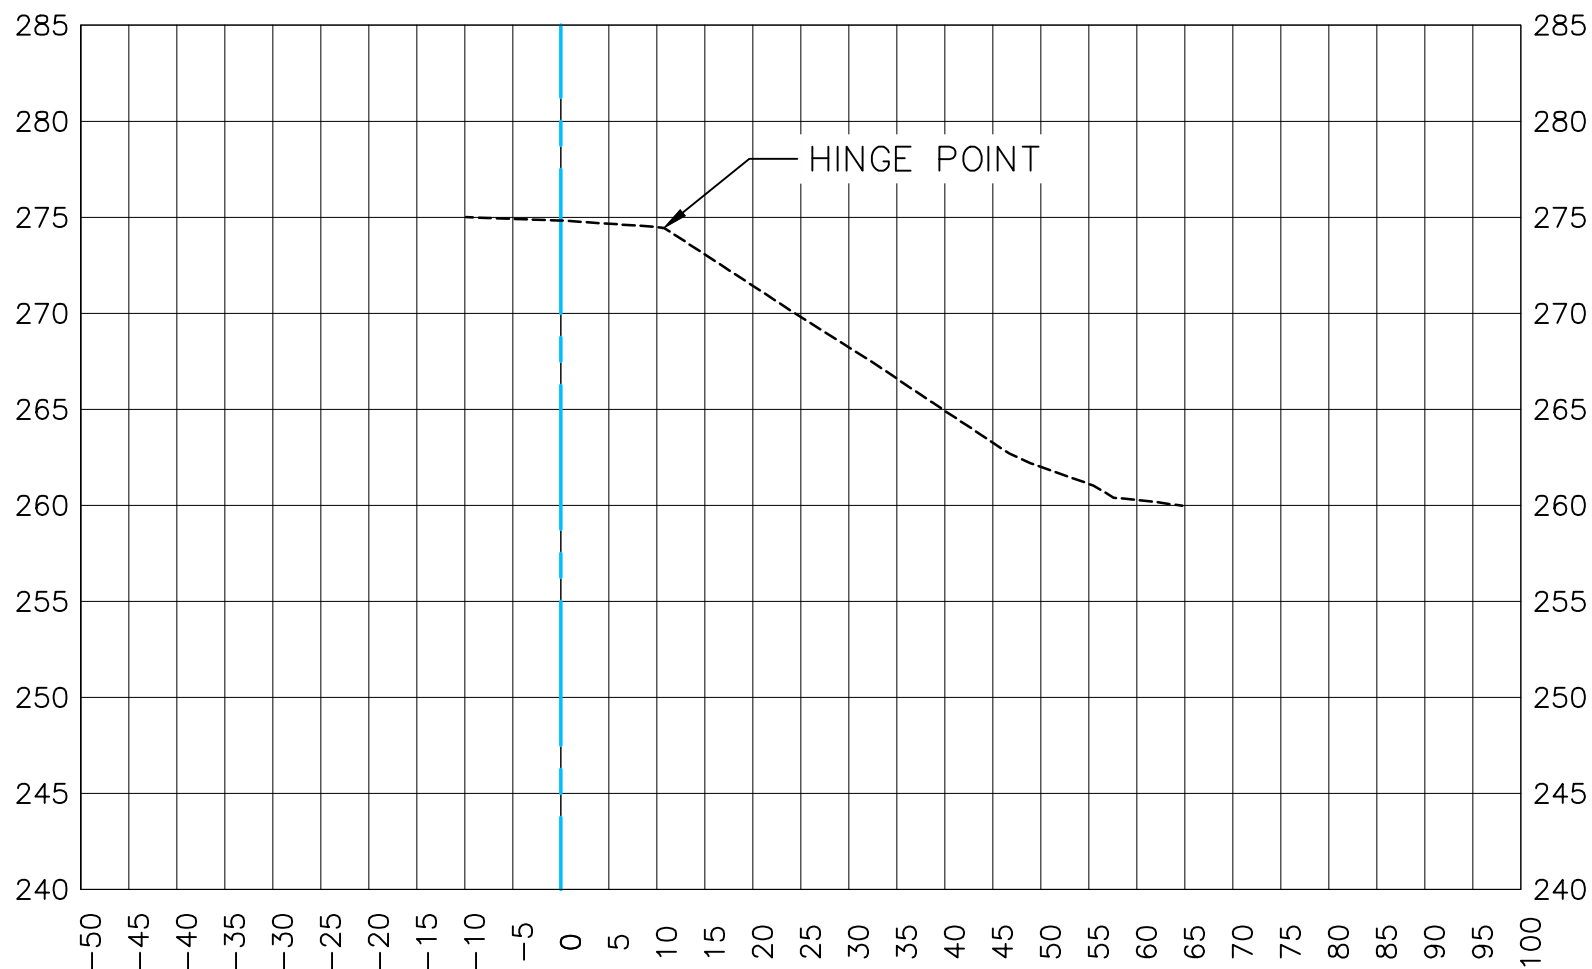

EXISTING CONDITION 2020

Station 42+25.00

Vert. Scale: 1"=5'



Hor. Scale: 1"=20'

DATE PREPARED: 03/23/2020

U.S. *Survey
Foot*

OC Public Works/Engineering Services
OC Survey/Field Services
Boundary Analysis & Mapping

GALIVAN PERIMETER ROAD CL

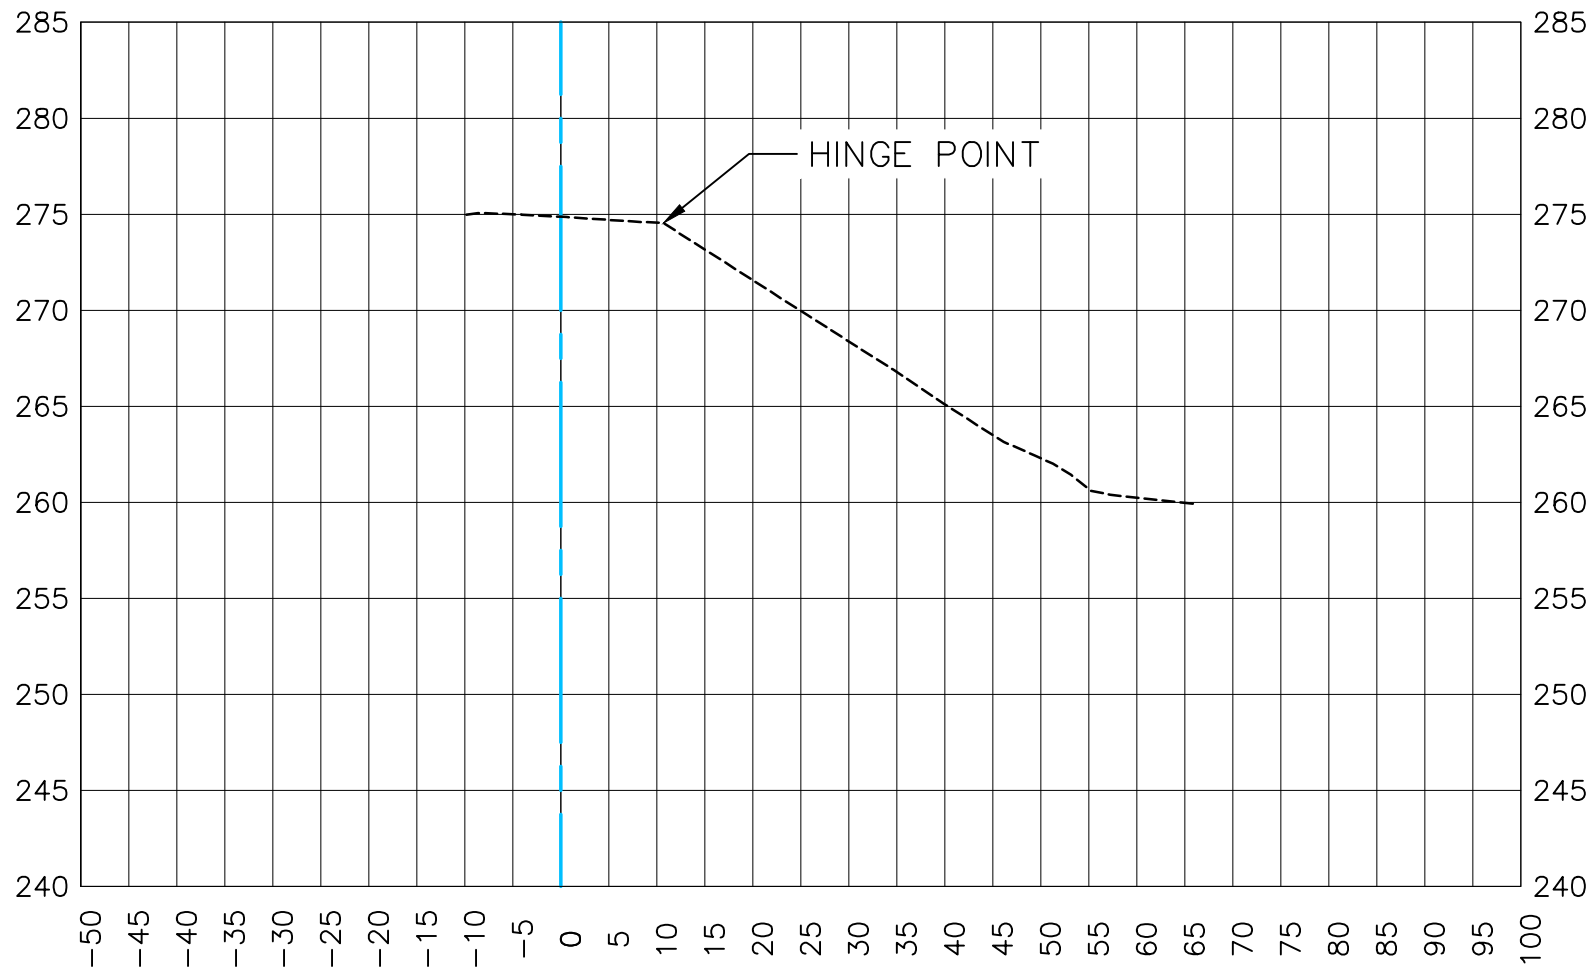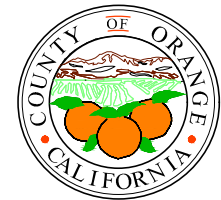

EXISTING CONDITION 2020

Station 42+50.00

Vert. Scale: 1"=5'



Hor. Scale: 1"=20'

DATE PREPARED: 03/23/2020

U.S. Survey
Foot

OC Public Works/Engineering Services
OC Survey/Field Services
Boundary Analysis & Mapping

GALIVAN PERIMETER ROAD CL

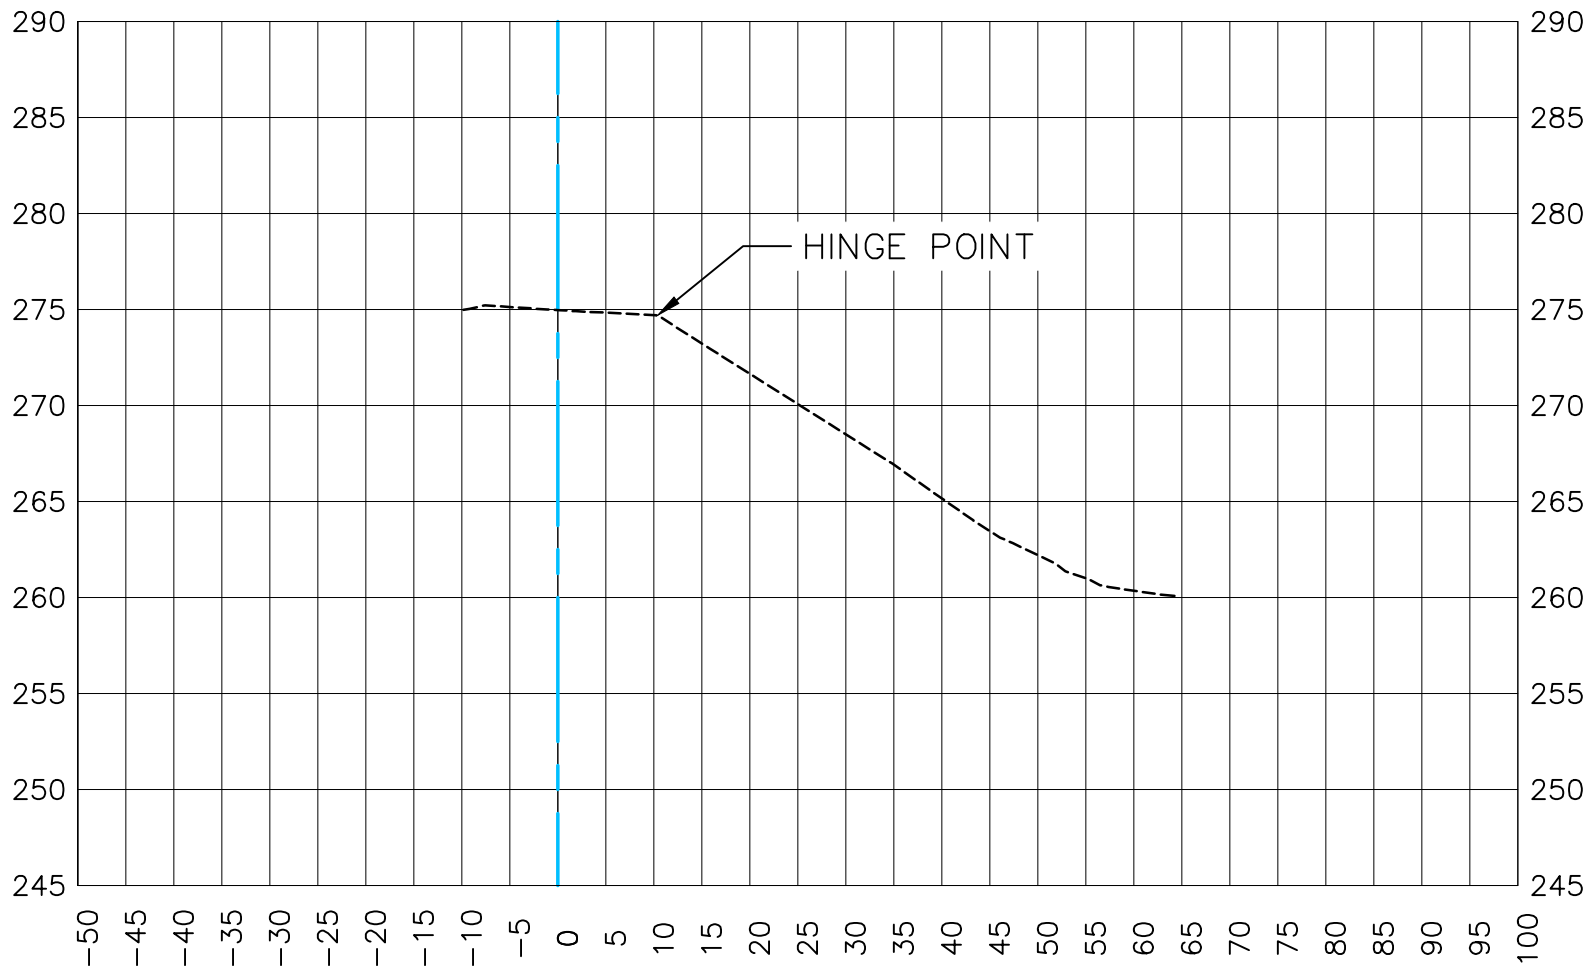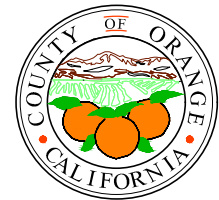


EXISTING CONDITION 2020

Station 42+75.00


Vert. Scale: 1"=5'

Hor. Scale: 1"=20'

DATE PREPARED: 03/23/2020

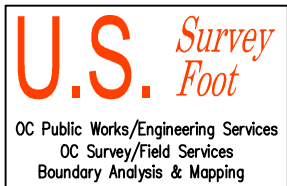

GALIVAN PERIMETER ROAD CL

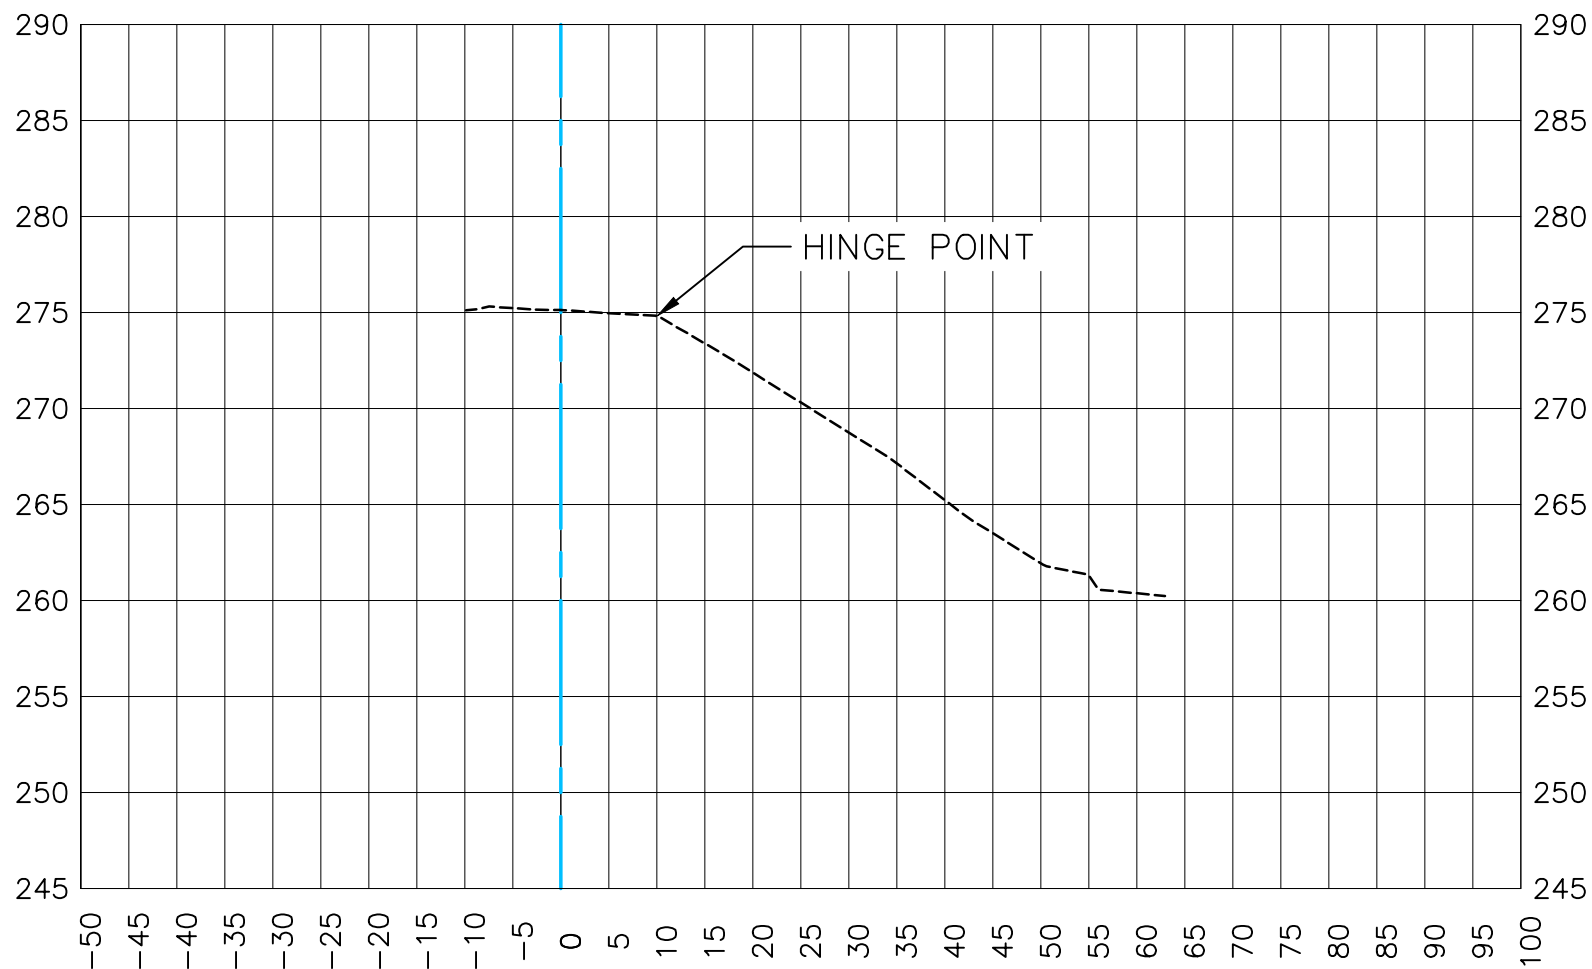


EXISTING CONDITION 2020


Station 43+00.00

Vert. Scale: 1"=5'
Hor. Scale: 1"=20'

DATE PREPARED: 03/23/2020

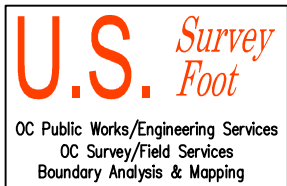

GALIVAN PERIMETER ROAD CL

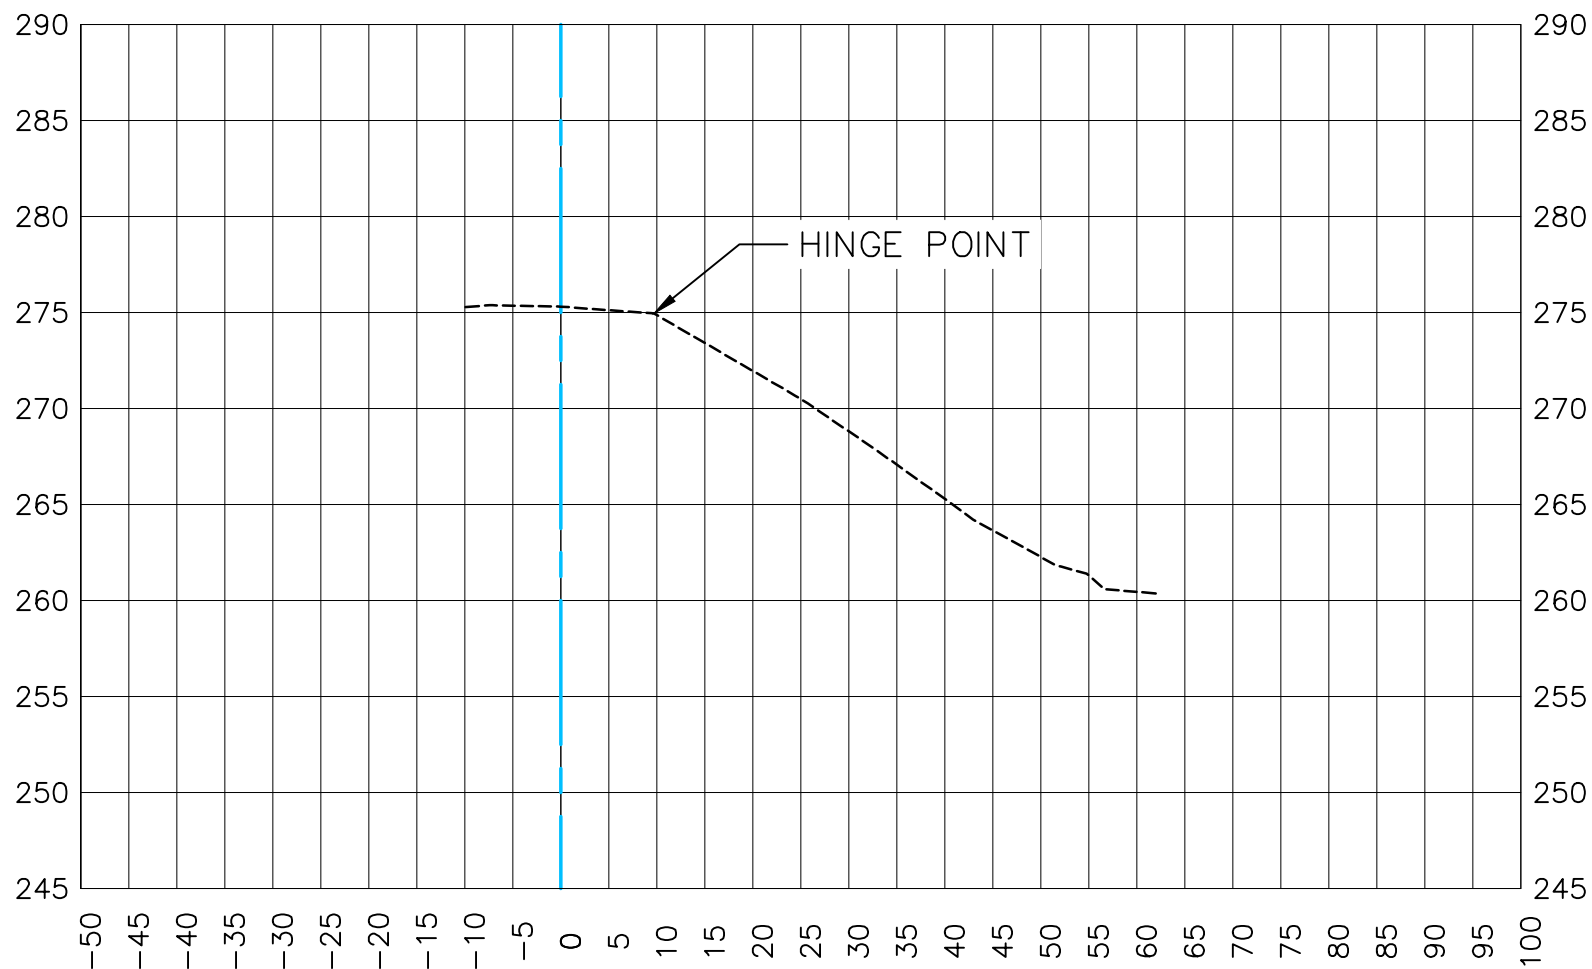


EXISTING CONDITION 2020


Station 43+25.00

Vert. Scale: 1"=5'
Hor. Scale: 1"=20'

DATE PREPARED: 03/23/2020

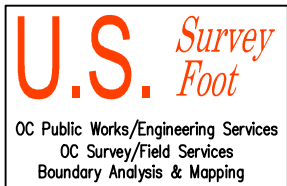

GALIVAN PERIMETER ROAD CL

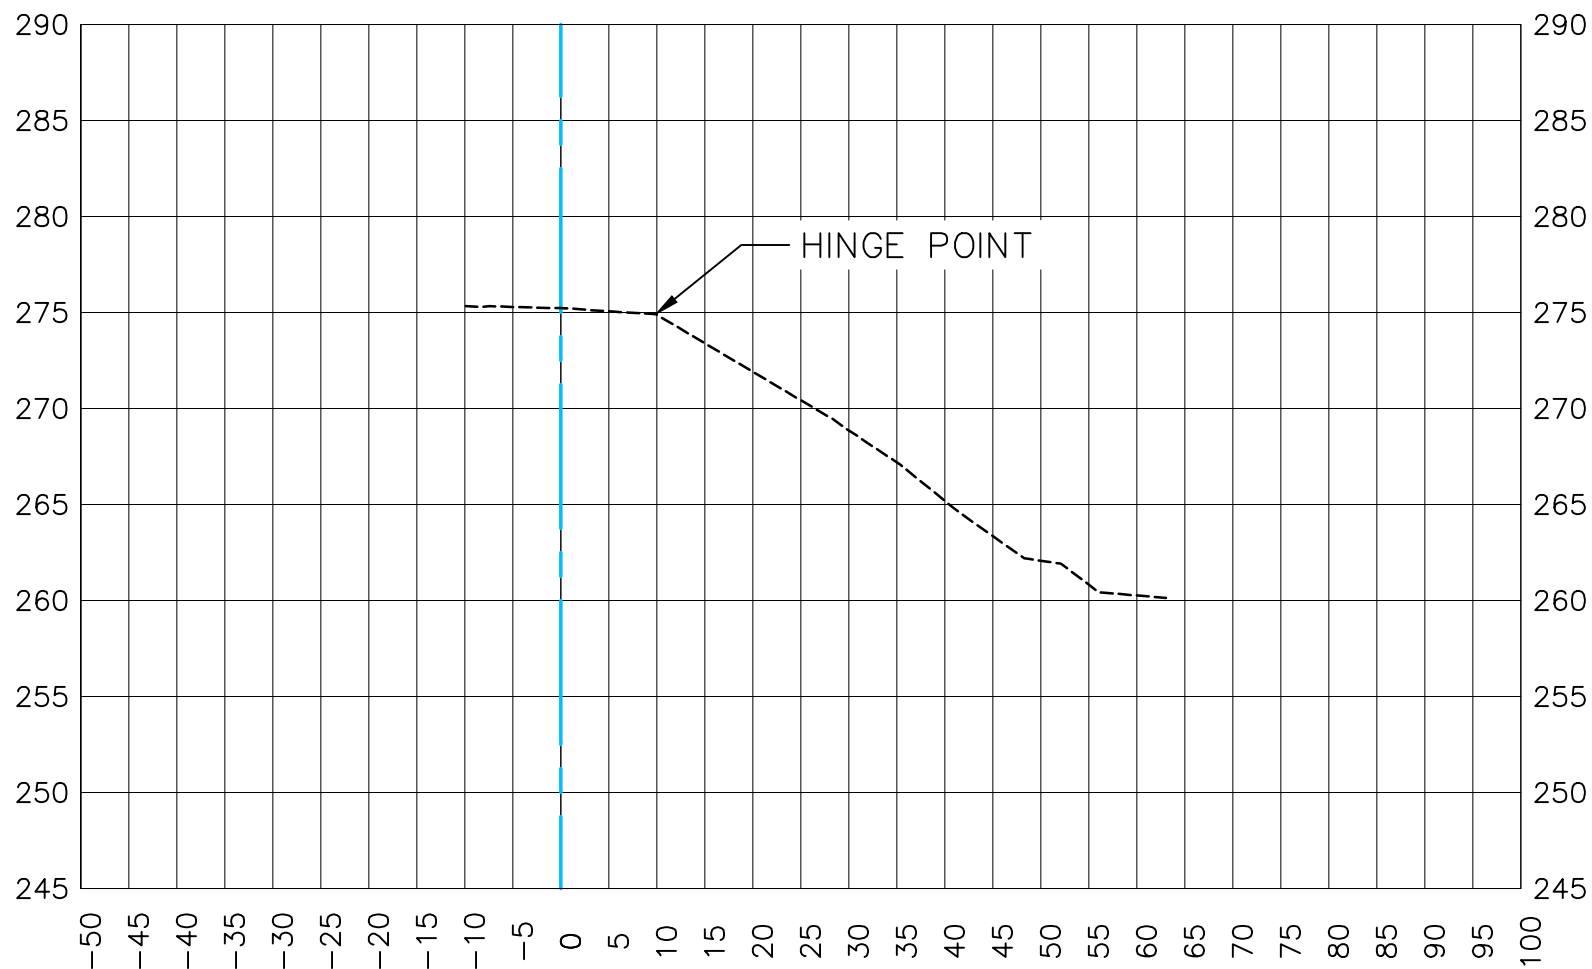


EXISTING CONDITION 2020


Station 43+50.00

Vert. Scale: 1"=5'
Hor. Scale: 1"=20'

DATE PREPARED: 03/23/2020

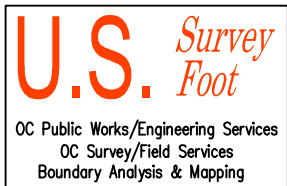

GALIVAN PERIMETER ROAD CL

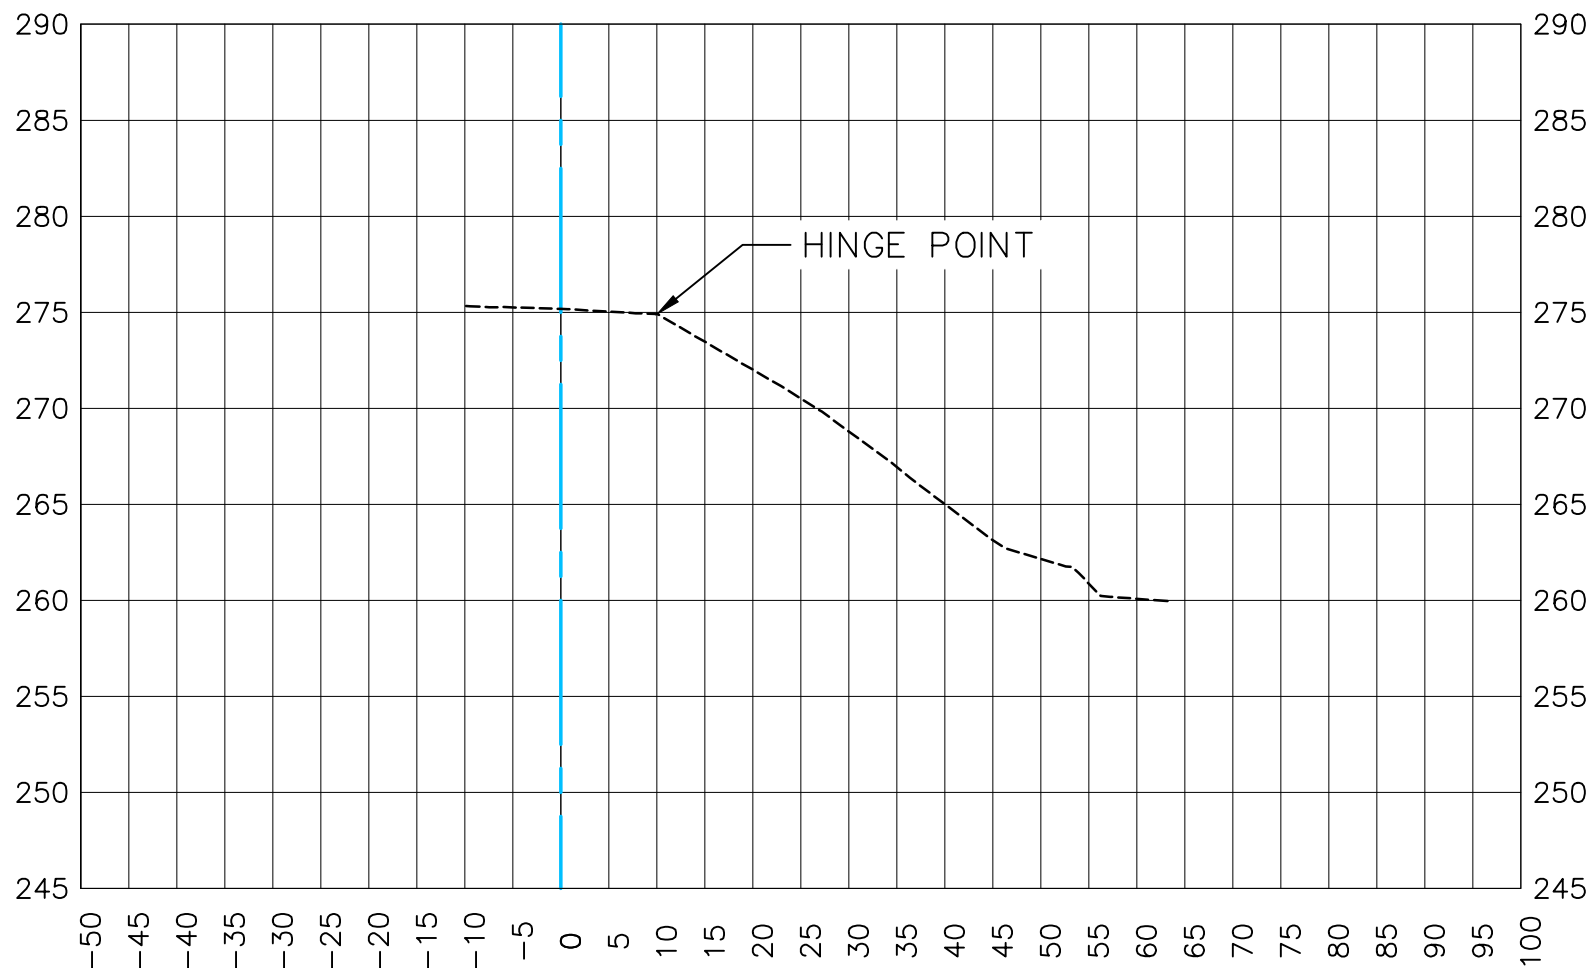


EXISTING CONDITION 2020

Station 43+75.00


Vert. Scale: 1"=5'

Hor. Scale: 1"=20'

DATE PREPARED: 03/23/2020

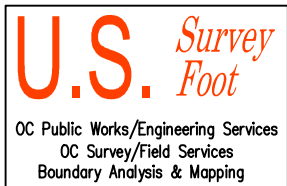

GALIVAN PERIMETER ROAD CL

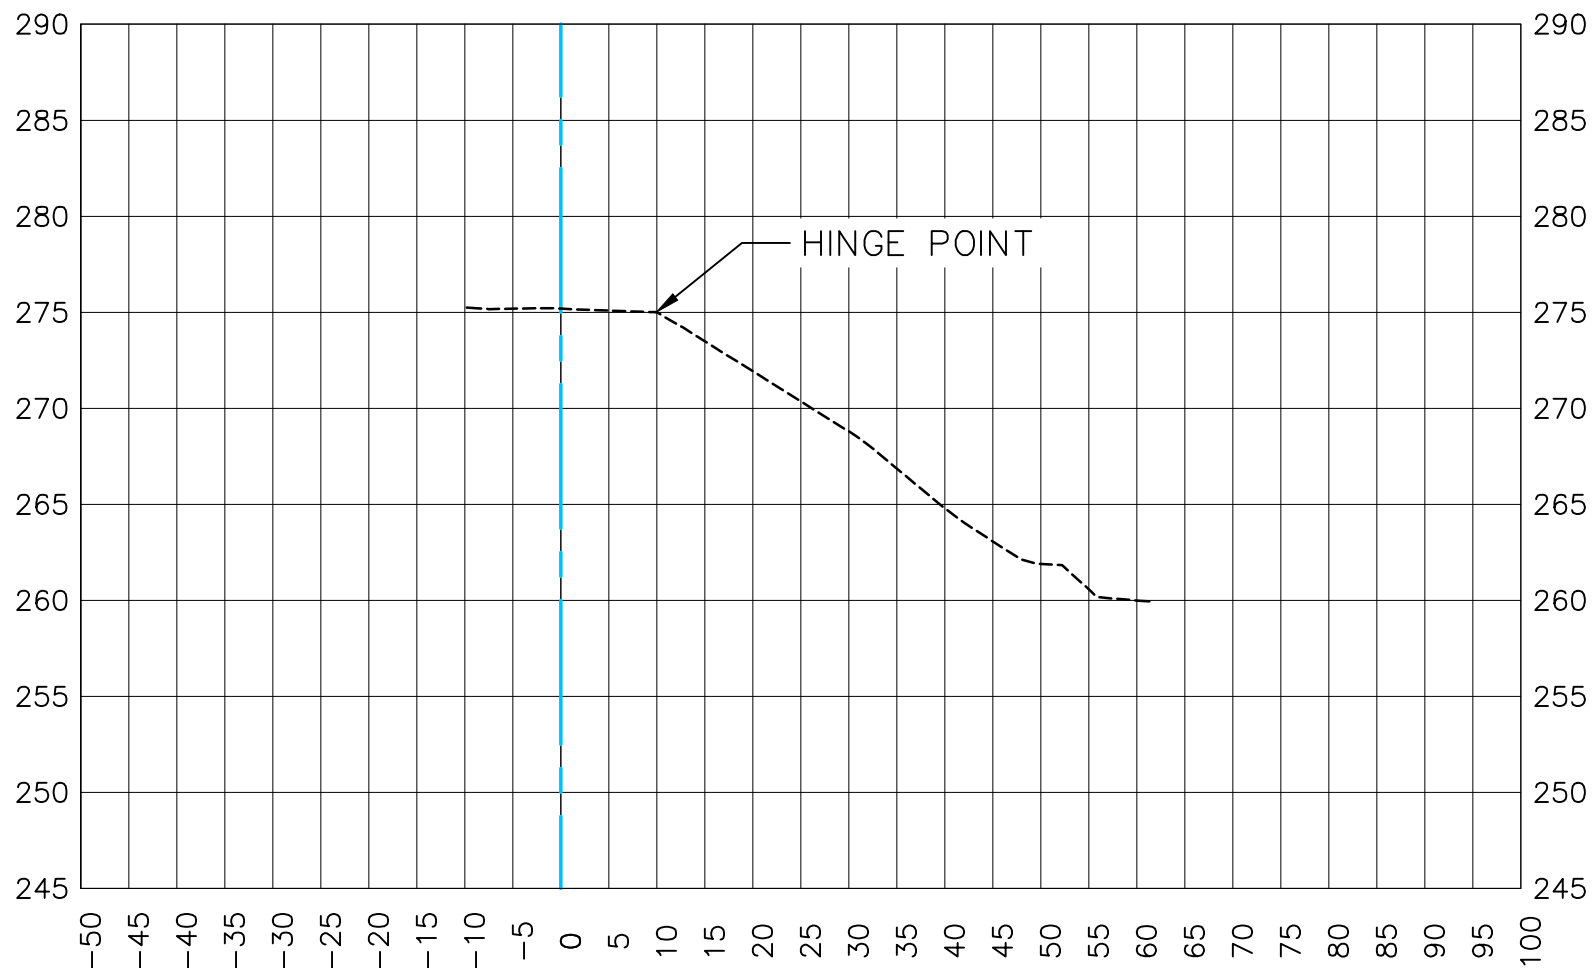


EXISTING CONDITION 2020


Station 44+00.00

Vert. Scale: 1"=5'
Hor. Scale: 1"=20'

DATE PREPARED: 03/23/2020

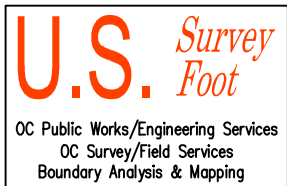

GALIVAN PERIMETER ROAD CL

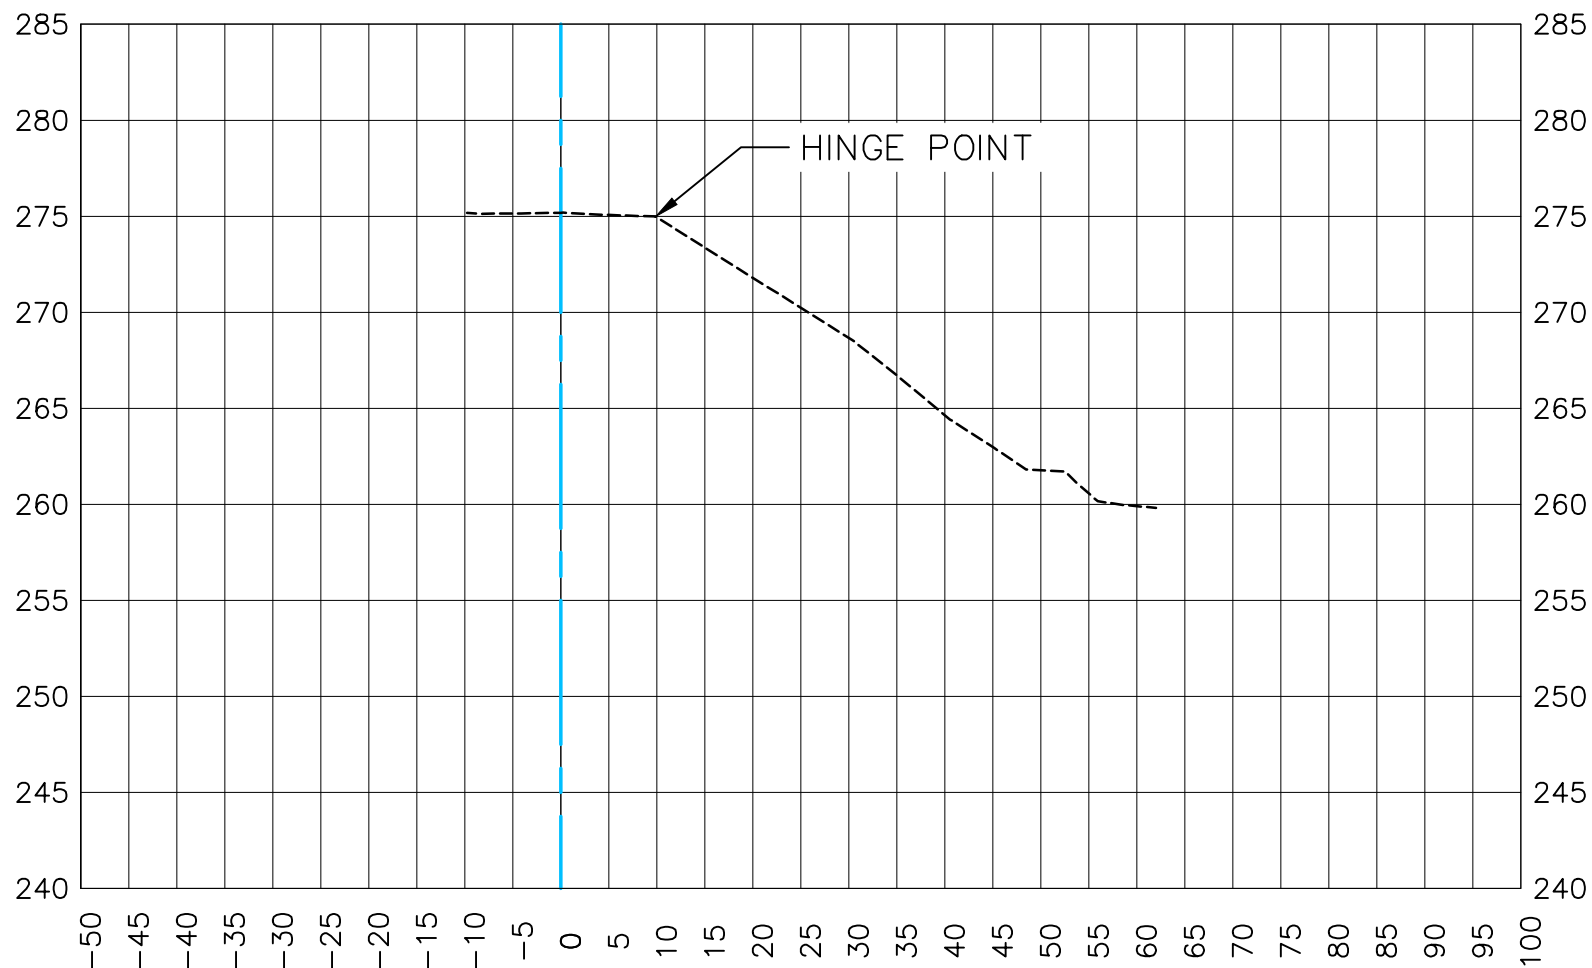


EXISTING CONDITION 2020

Station 44+25.00



Vert. Scale: 1"=5'

Hor. Scale: 1"=20'

DATE PREPARED: 03/23/2020

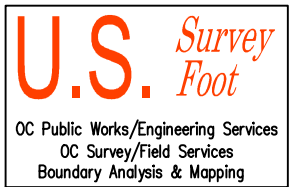

GALIVAN PERIMETER ROAD CL

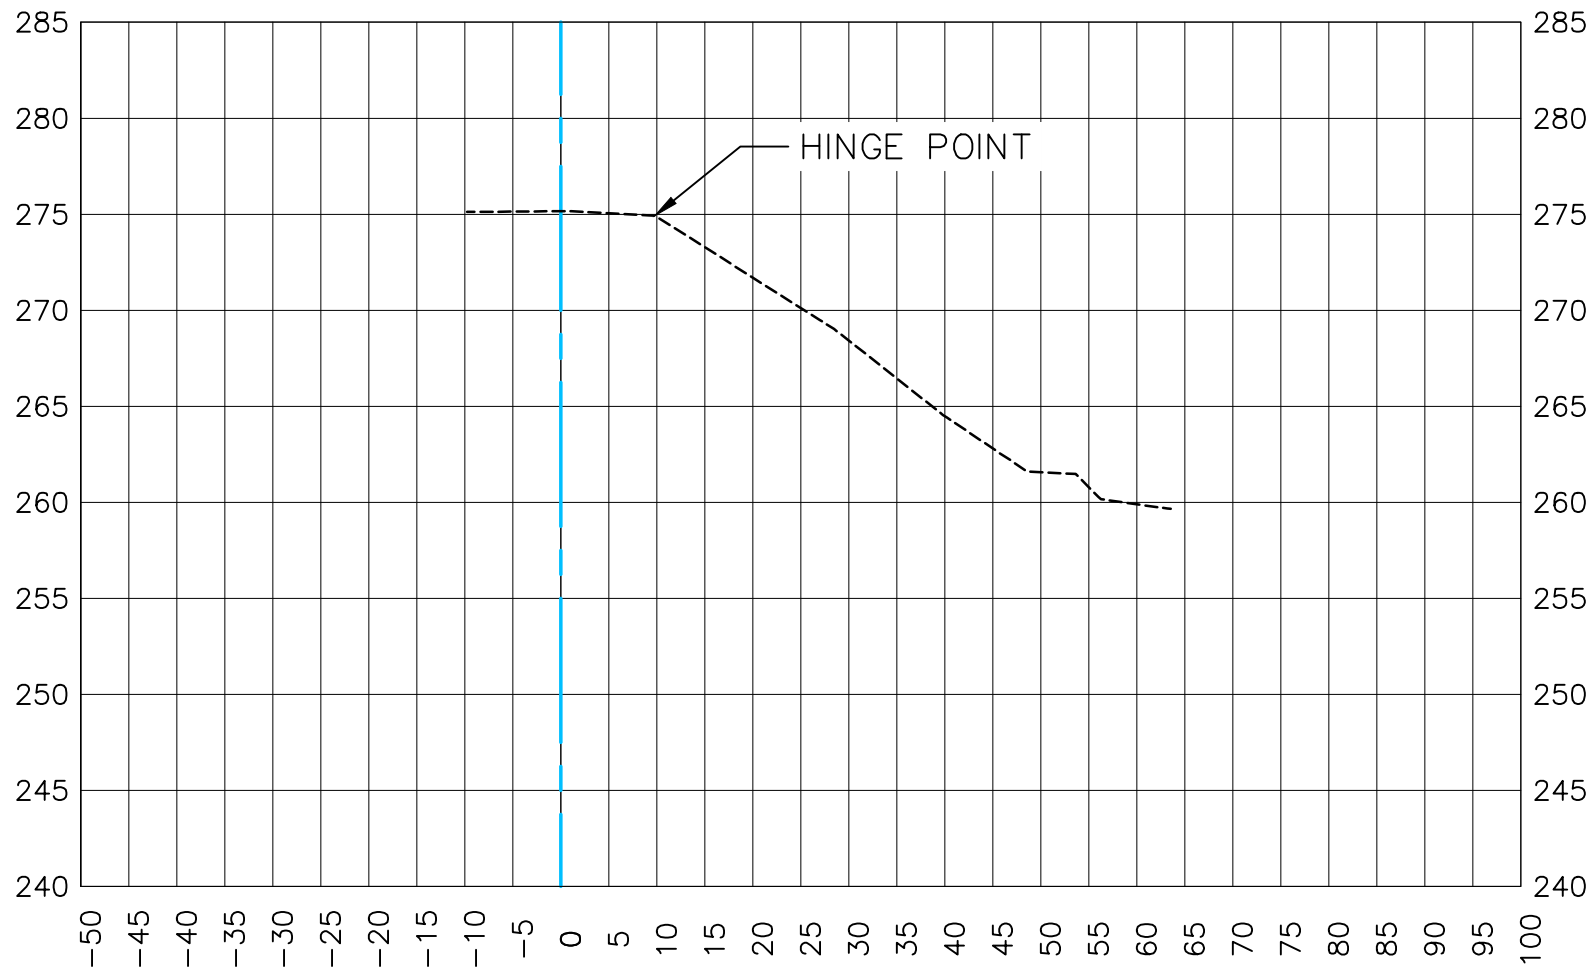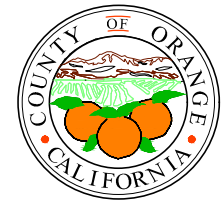


EXISTING CONDITION 2020


Station 44+50.00

Vert. Scale: 1"=5'
Hor. Scale: 1"=20'

DATE PREPARED: 03/23/2020

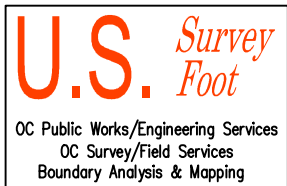

GALIVAN PERIMETER ROAD CL

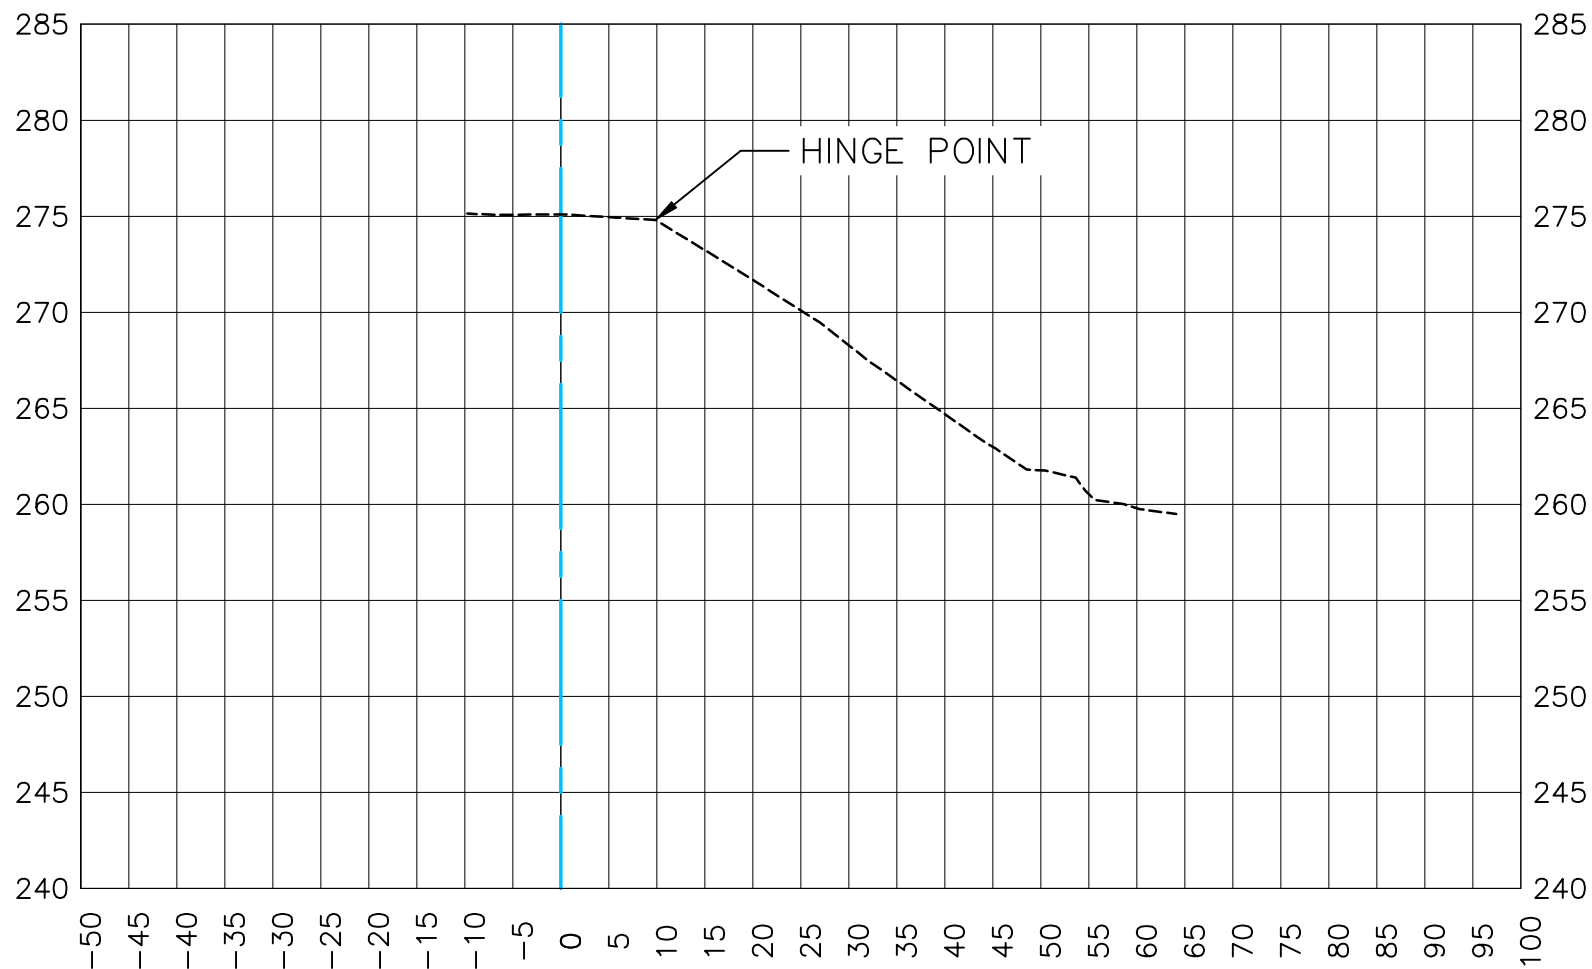


EXISTING CONDITION 2020



Station 44+75.00

Vert. Scale: 1"=5'
Hor. Scale: 1"=20'

DATE PREPARED: 03/23/2020

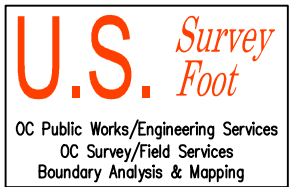

GALIVAN PERIMETER ROAD CL

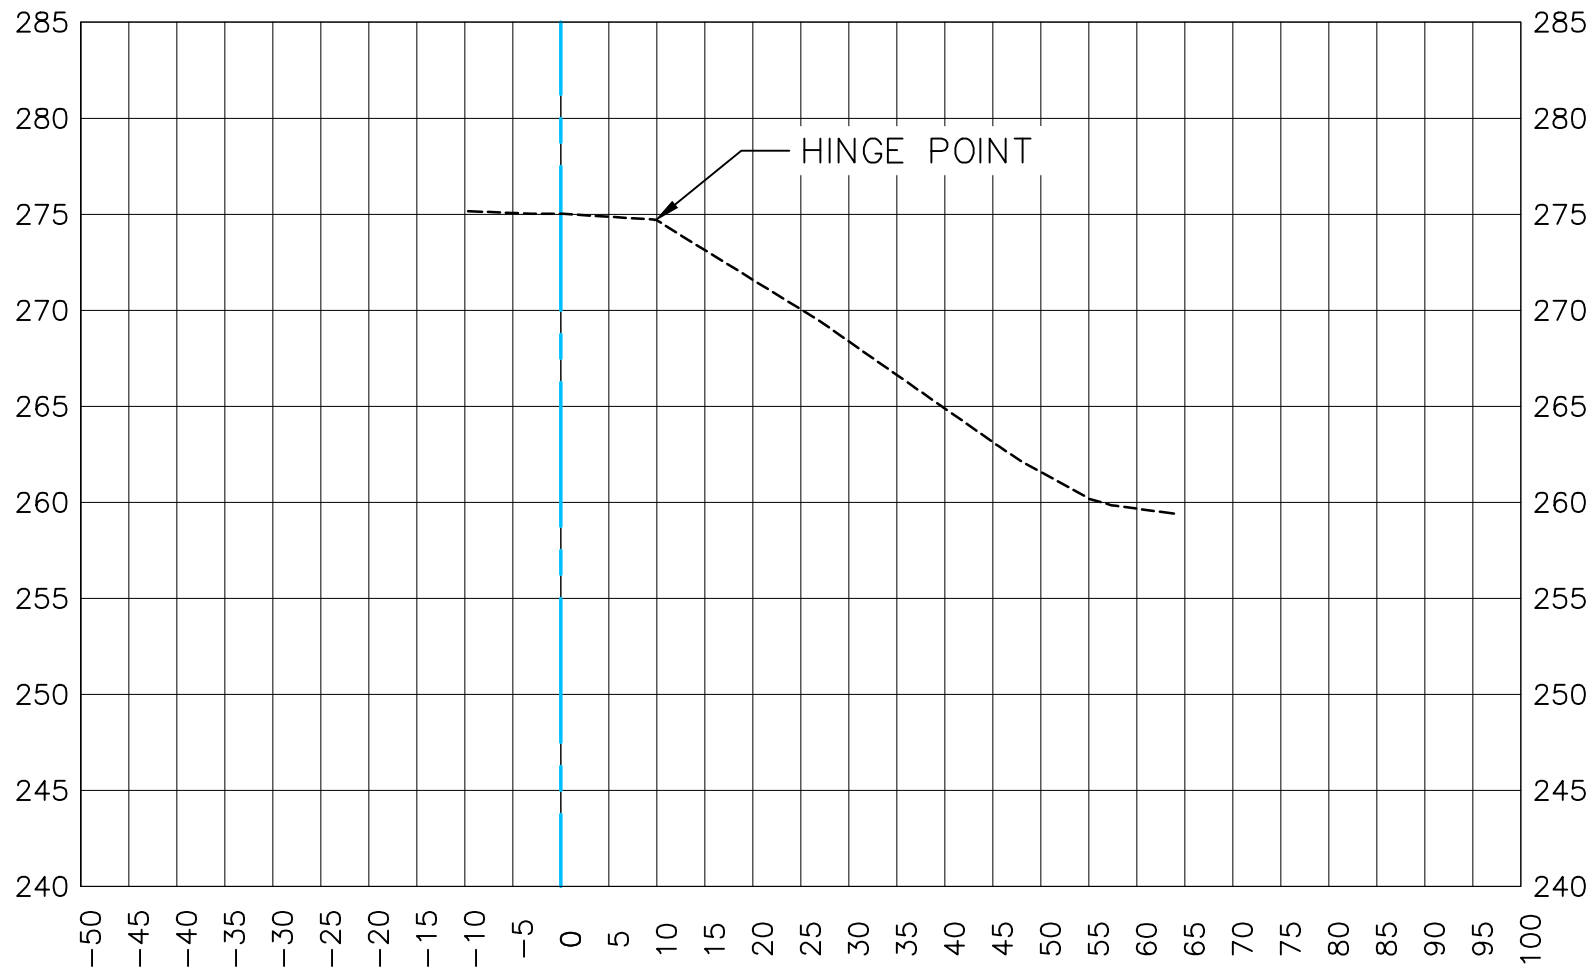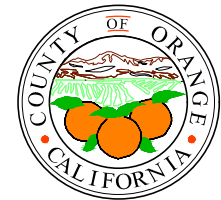


EXISTING CONDITION 2020

Station 45+00.00


Vert. Scale: 1"=5'

Hor. Scale: 1"=20'

DATE PREPARED: 03/23/2020

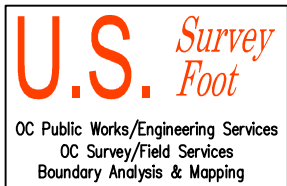

GALIVAN PERIMETER ROAD CL

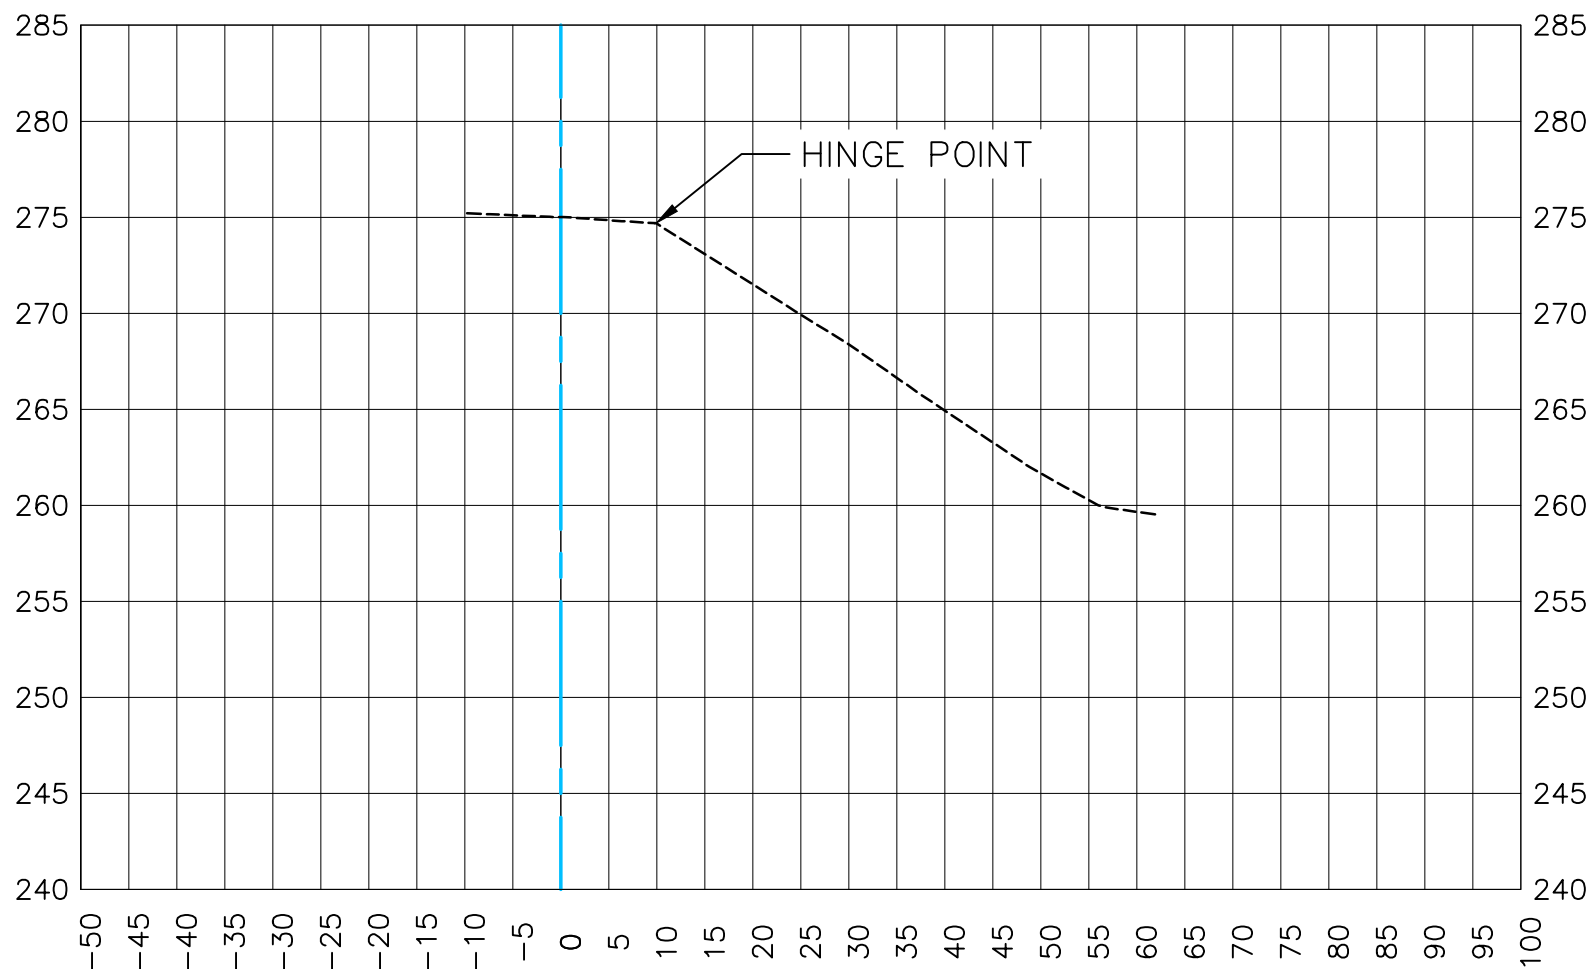

EXISTING CONDITION 2020

Station 45+25.00

Vert. Scale: 1"=5'



Hor. Scale: 1"=20'

DATE PREPARED: 03/23/2020

U.S. *Survey
Foot*

OC Public Works/Engineering Services
OC Survey/Field Services
Boundary Analysis & Mapping

GALIVAN PERIMETER ROAD CL

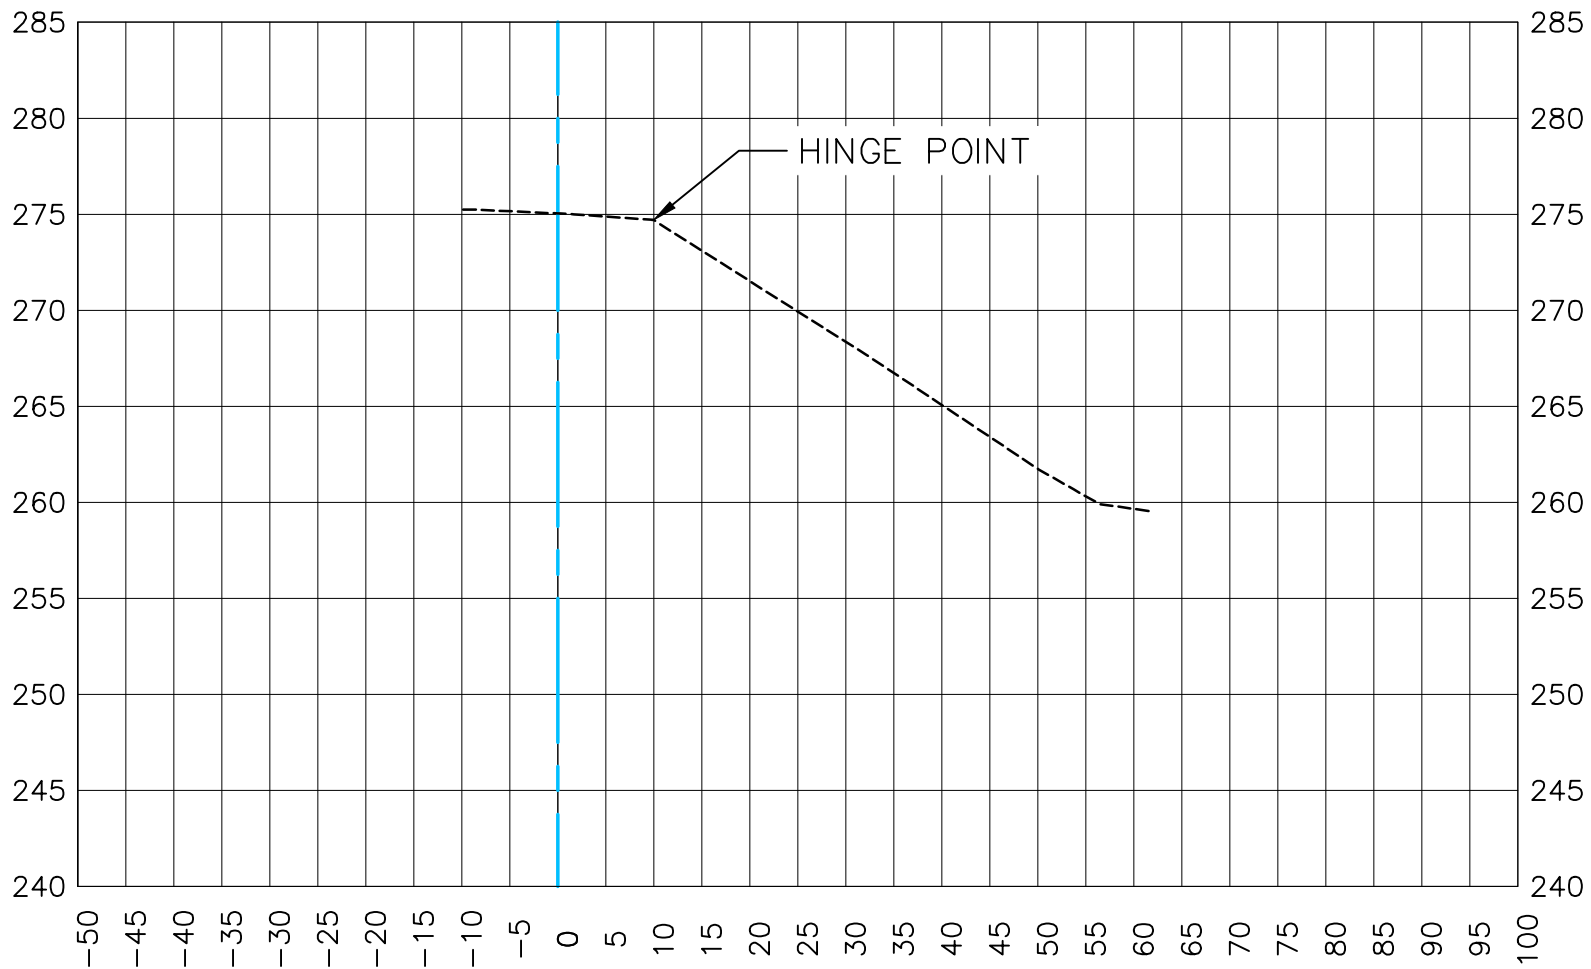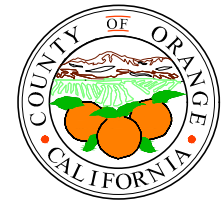


EXISTING CONDITION 2020

Station 45+50.00


Vert. Scale: 1"=5'

Hor. Scale: 1"=20'

DATE PREPARED: 03/23/2020

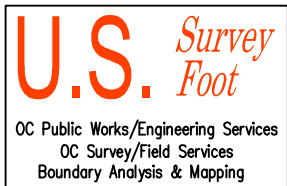

GALIVAN PERIMETER ROAD CL

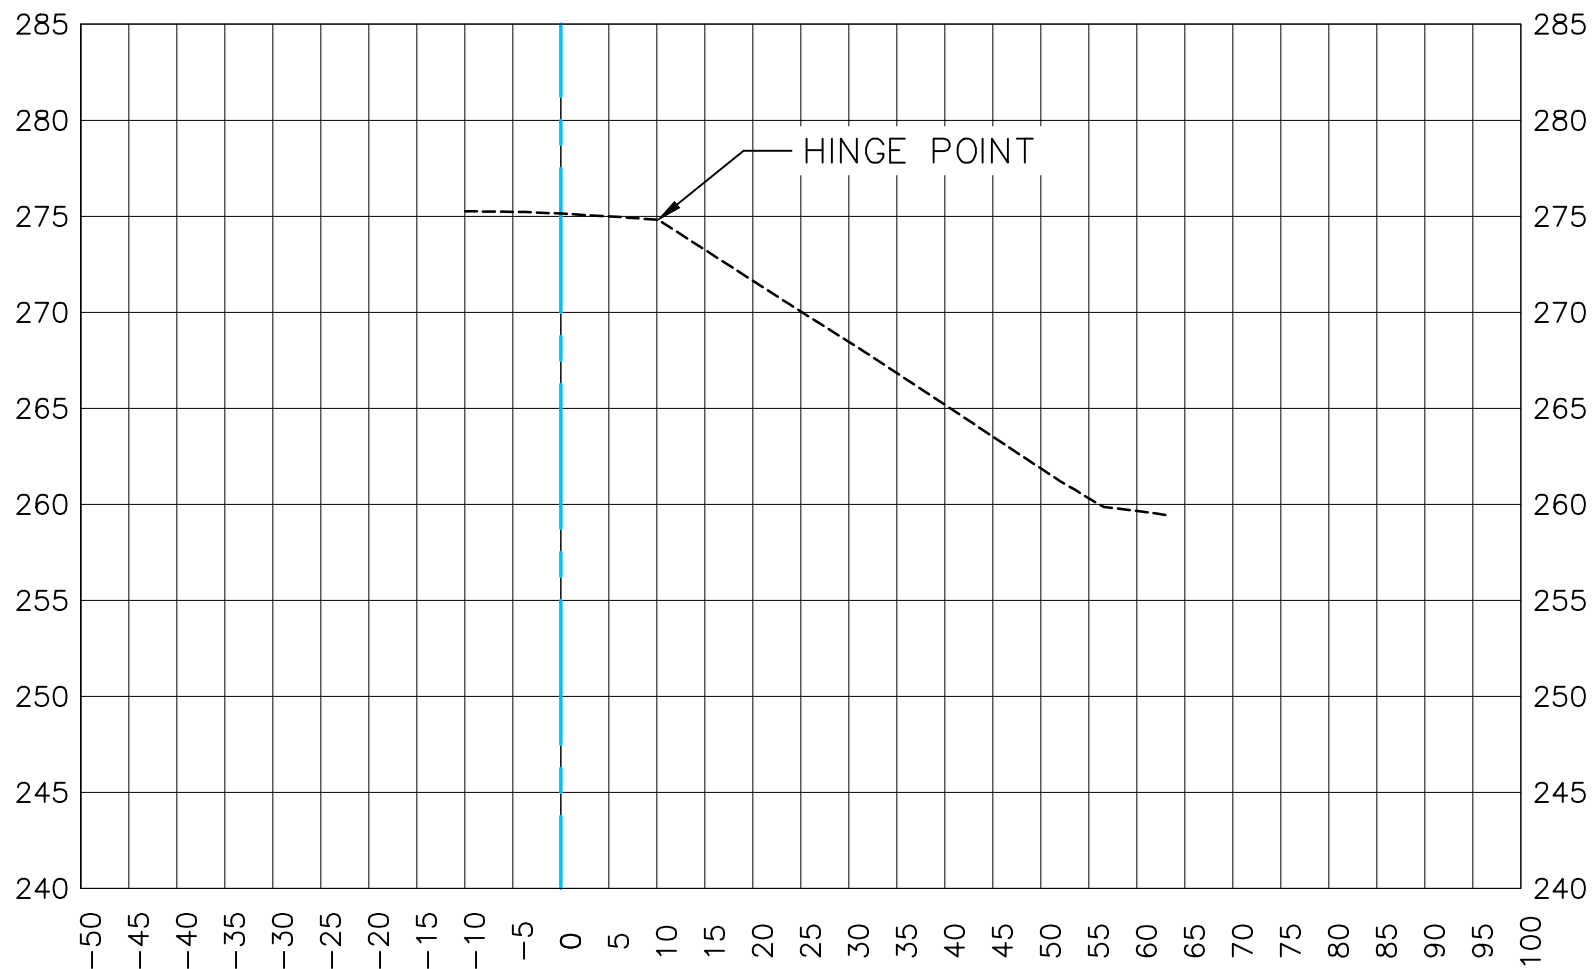


EXISTING CONDITION 2020

Station 45+75.00


Vert. Scale: 1"=5'

Hor. Scale: 1"=20'

DATE PREPARED: 03/23/2020

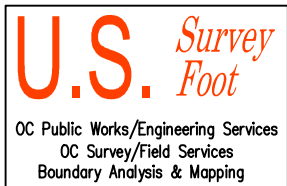

GALIVAN PERIMETER ROAD CL

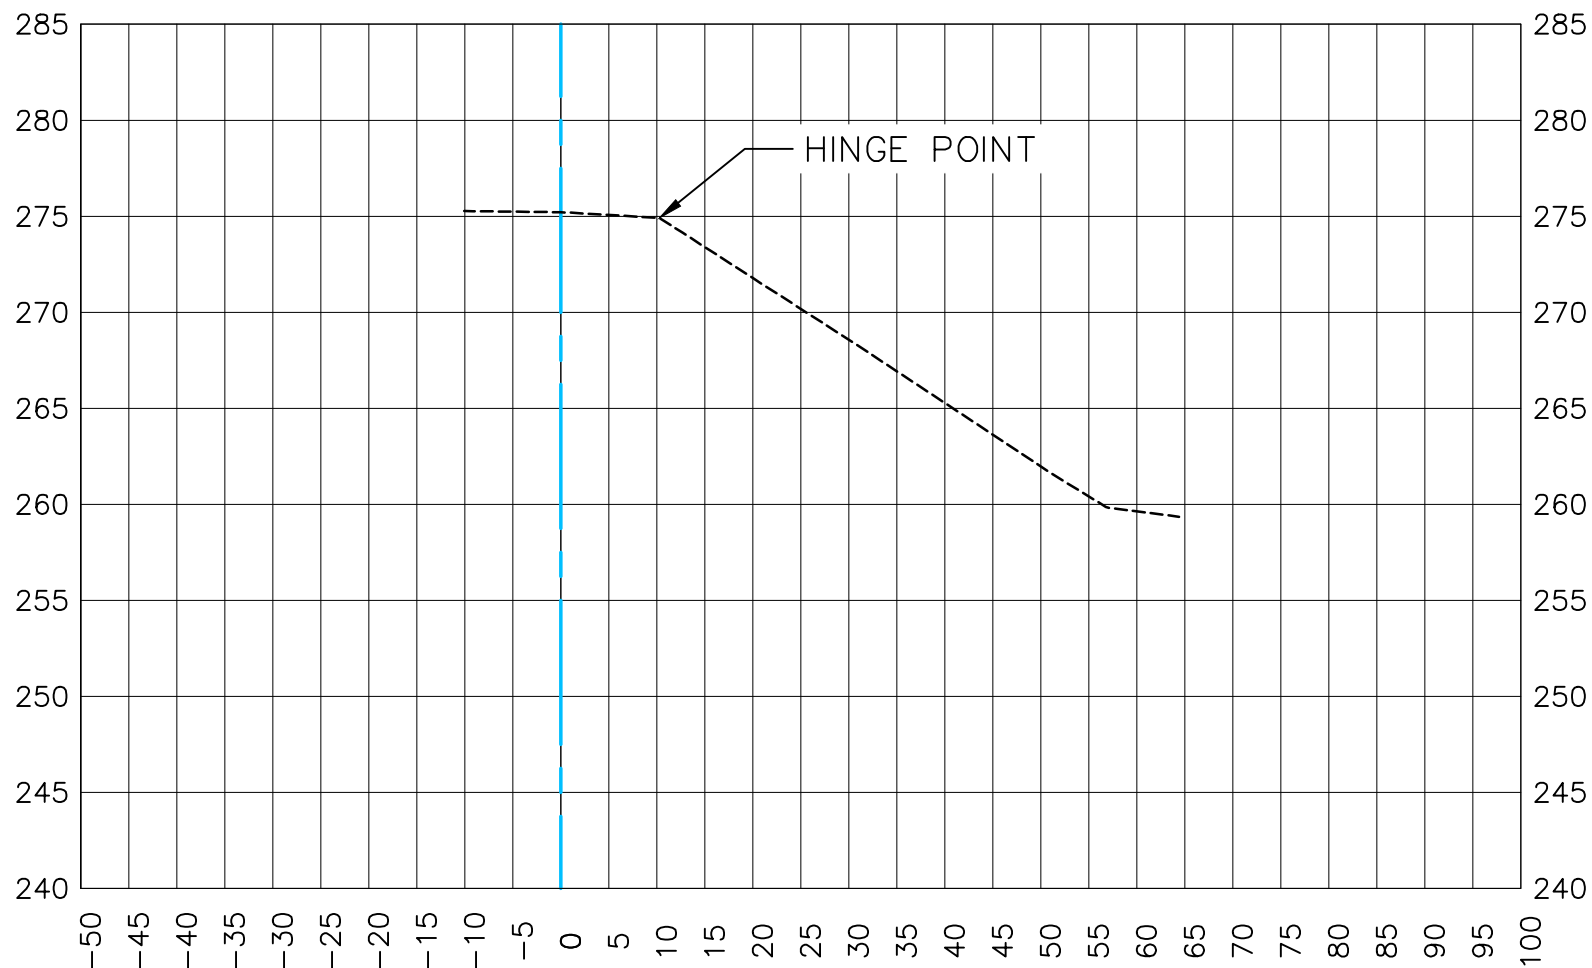


EXISTING CONDITION 2020

Station 46+00.00


Vert. Scale: 1"=5'

Hor. Scale: 1"=20'

DATE PREPARED: 03/23/2020

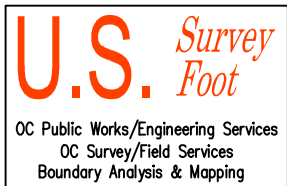

GALIVAN PERIMETER ROAD CL

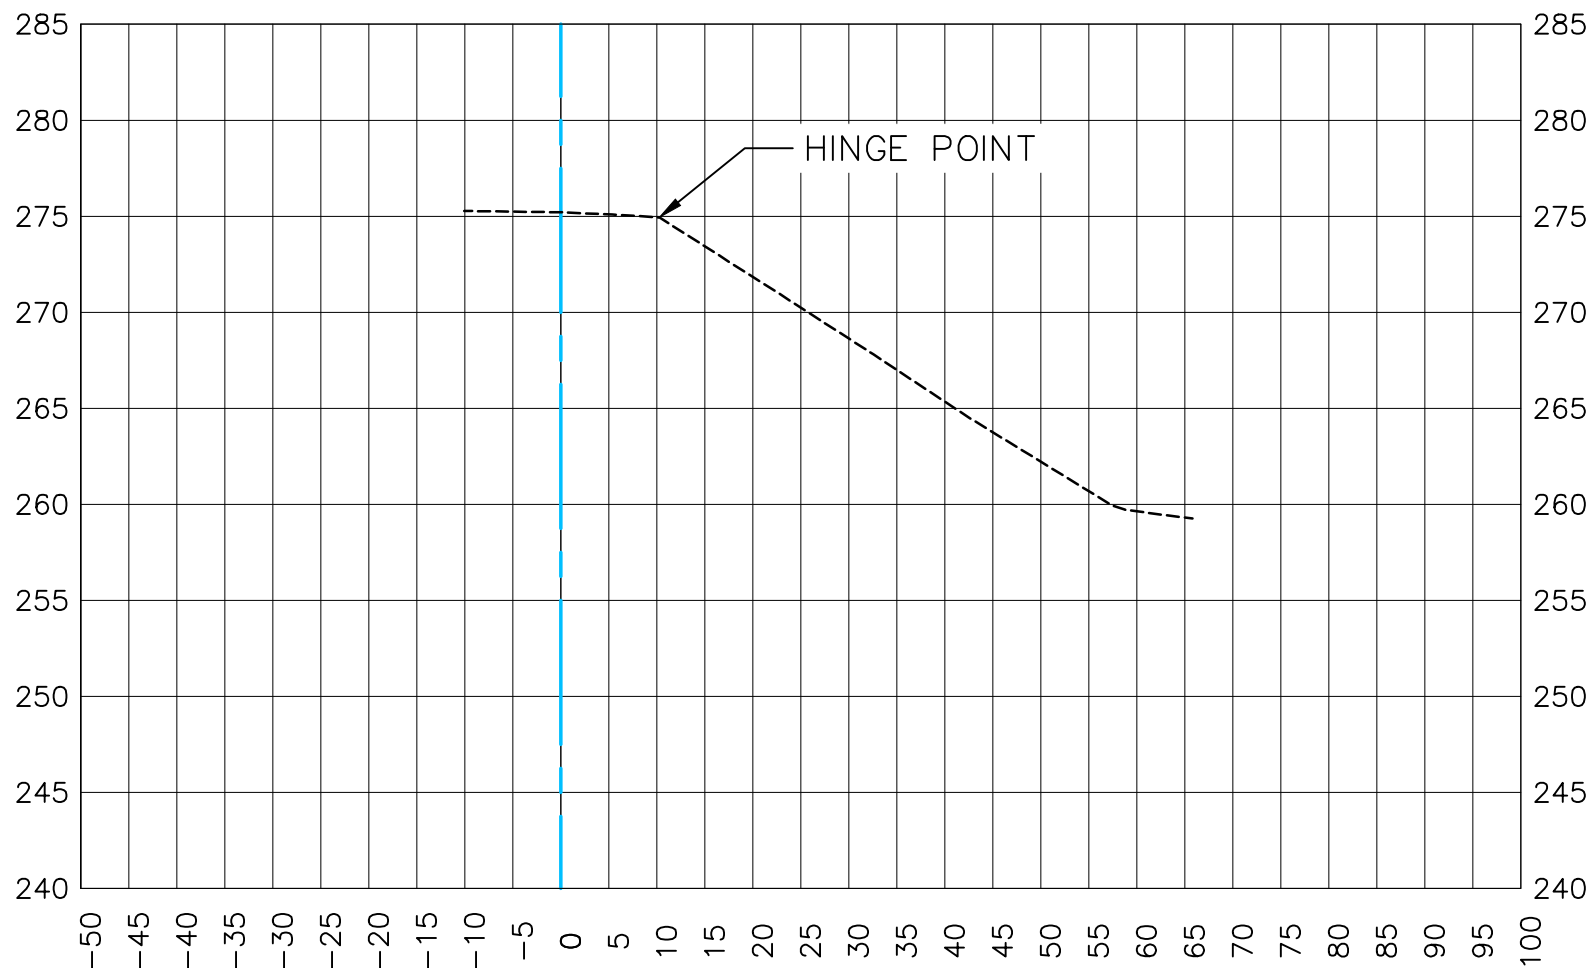

EXISTING CONDITION 2020

Station 46+25.00


Vert. Scale: 1"=5'
Hor. Scale: 1"=20'

DATE PREPARED: 03/23/2020

U.S. Survey Foot

OC Public Works/Engineering Services
OC Survey/Field Services
Boundary Analysis & Mapping

GALIVAN PERIMETER ROAD CL

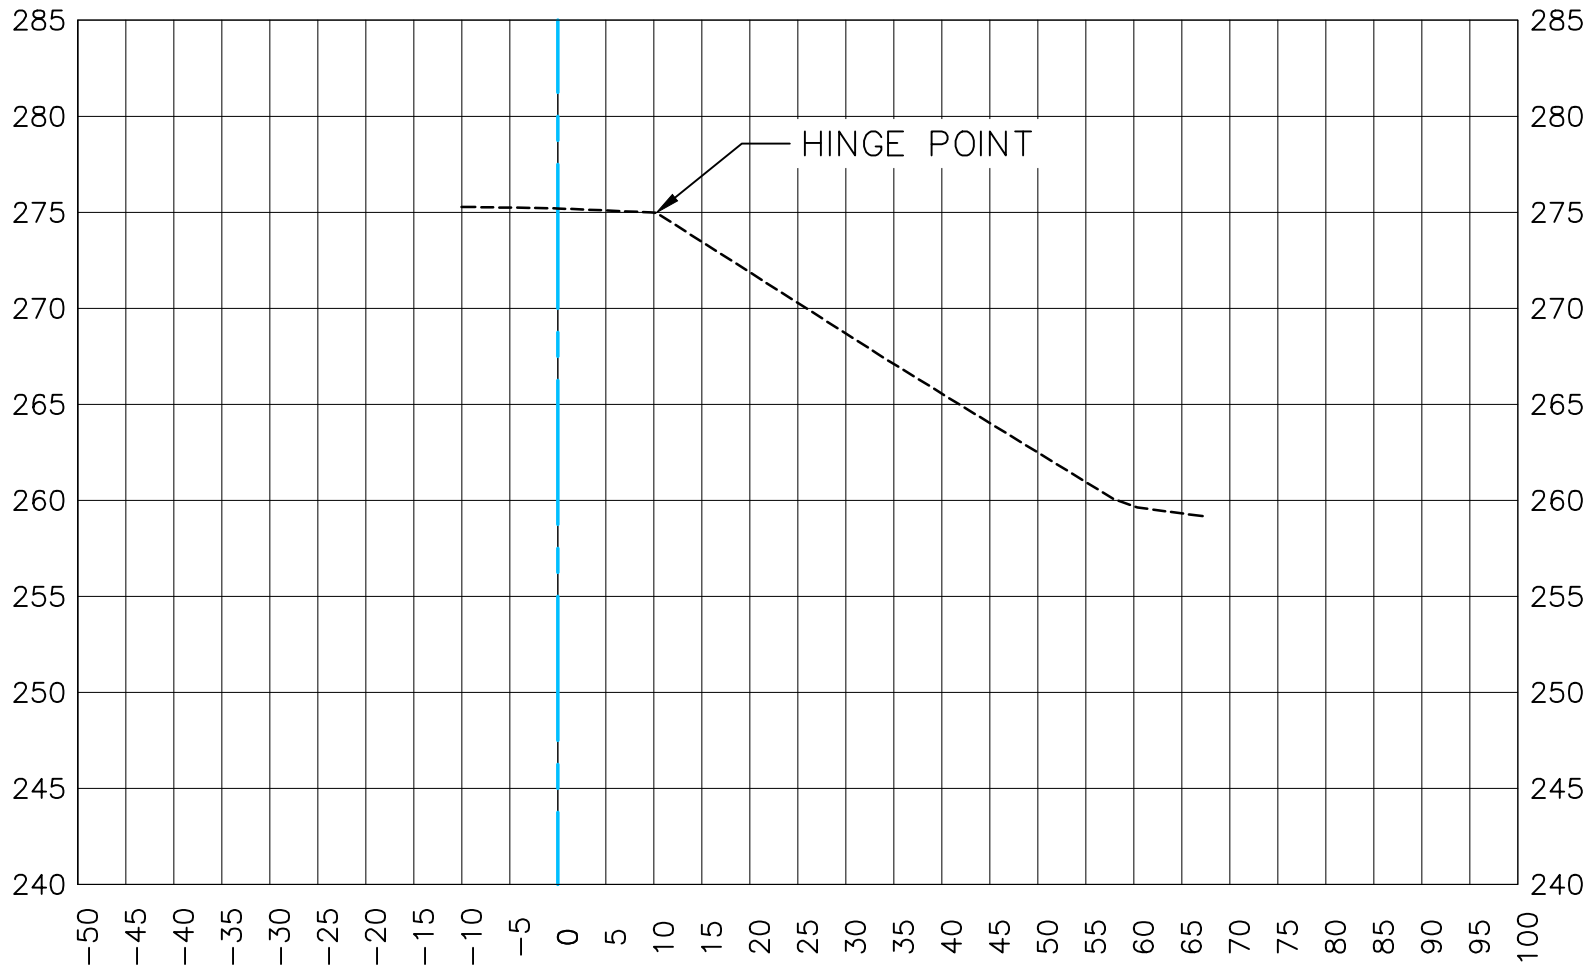


EXISTING CONDITION 2020



Station 46+50.00

Vert. Scale: 1"=5'
Hor. Scale: 1"=20'

DATE PREPARED: 03/23/2020

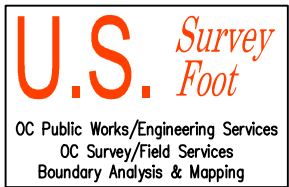

GALIVAN PERIMETER ROAD CL

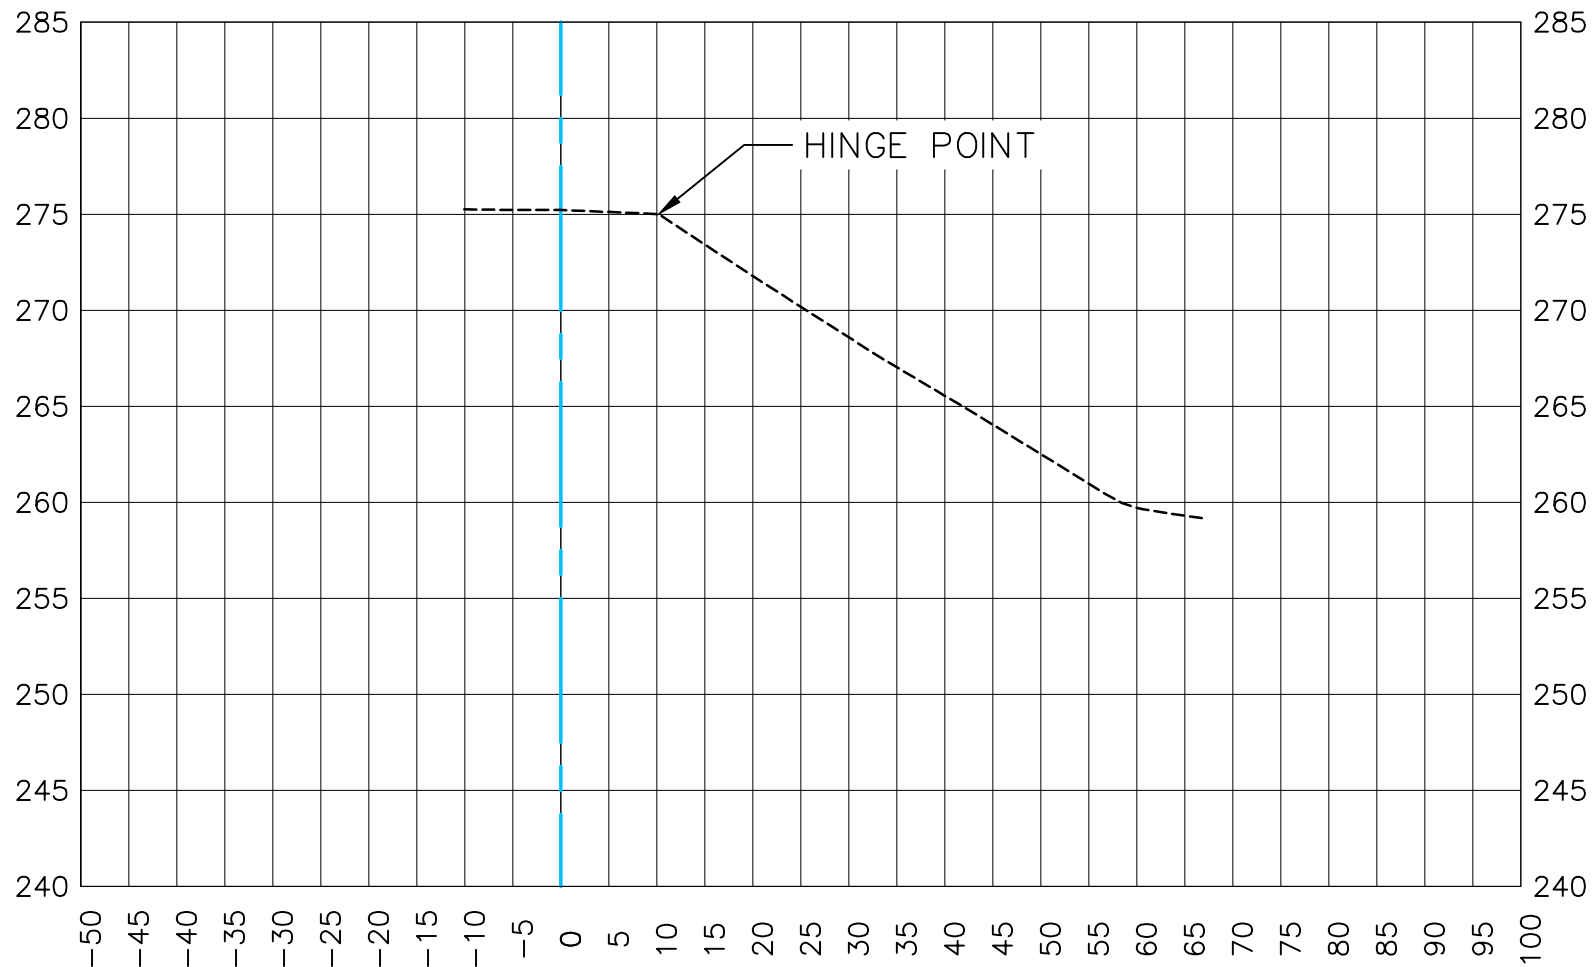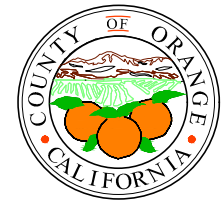


EXISTING CONDITION 2020

Station 46+75.00



Vert. Scale: 1"=5'

Hor. Scale: 1"=20'

DATE PREPARED: 03/23/2020

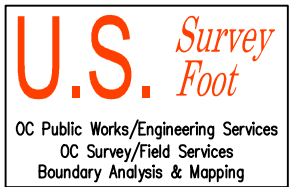

GALIVAN PERIMETER ROAD CL

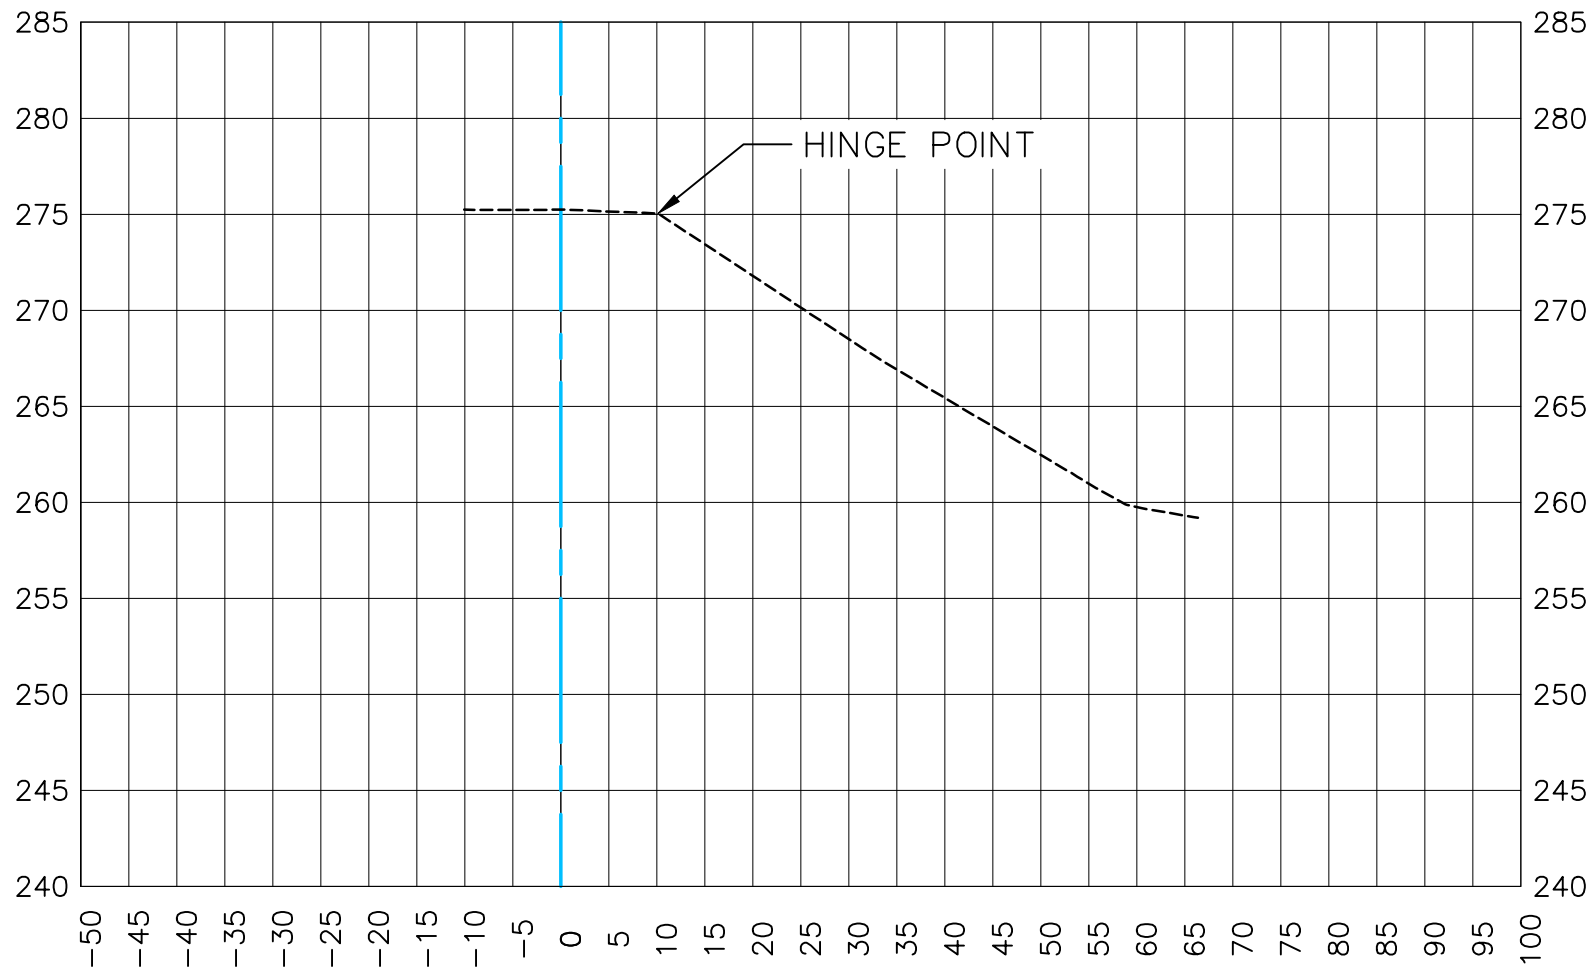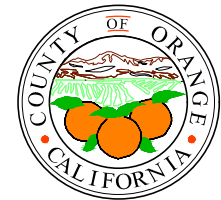


EXISTING CONDITION 2020

Station 47+00.00



Vert. Scale: 1"=5'

Hor. Scale: 1"=20'

DATE PREPARED: 03/23/2020

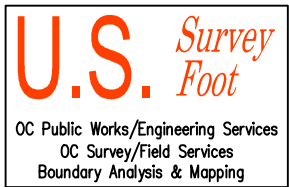

GALIVAN PERIMETER ROAD CL

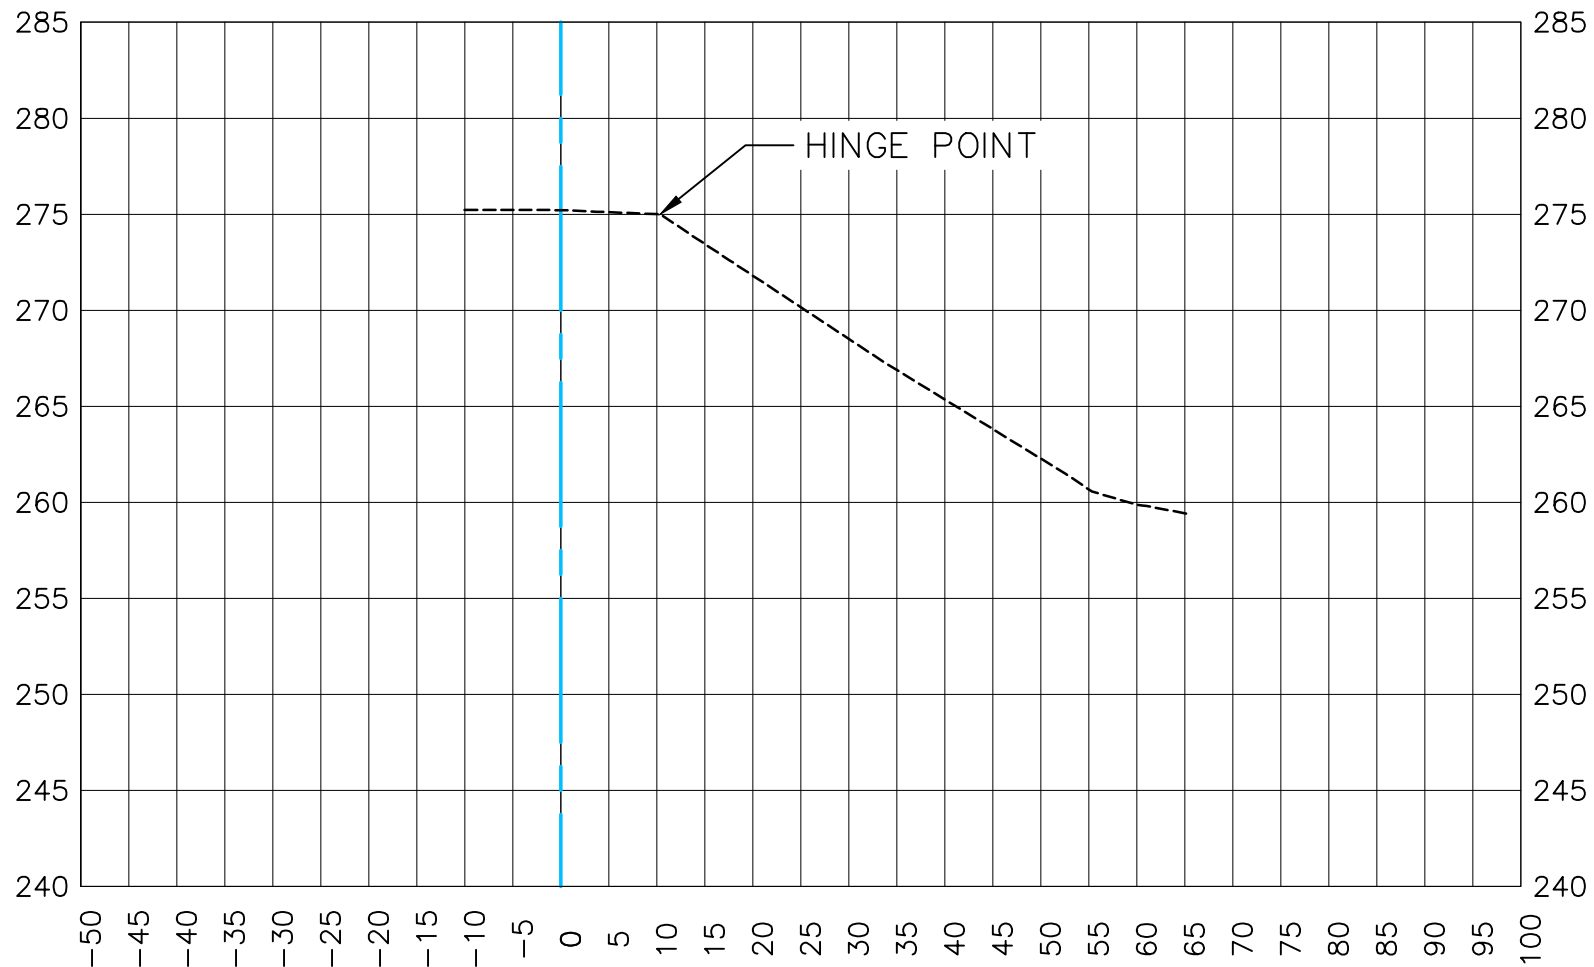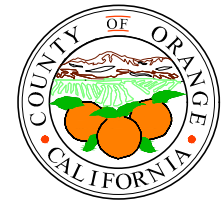

EXISTING CONDITION 2020

Station 47+25.00


Vert. Scale: 1"=5'

Hor. Scale: 1"=20'

DATE PREPARED: 03/23/2020



GALIVAN
PERIMETER ROAD
CL

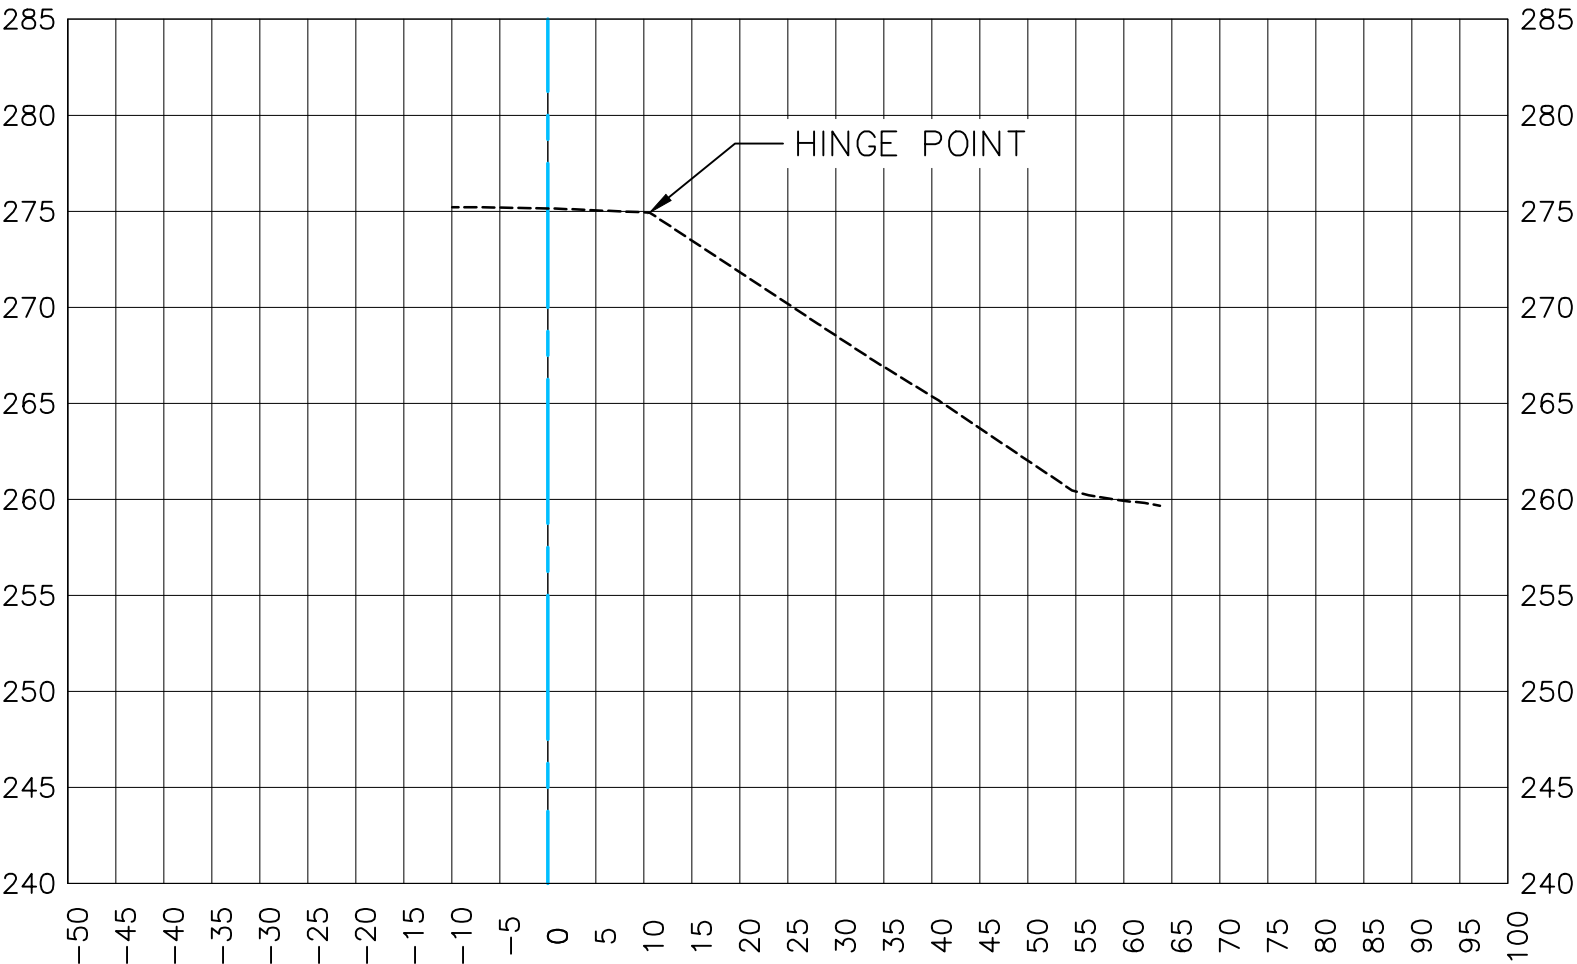


EXISTING CONDITION 2020


Station 47+50.00

Vert. Scale: 1"=5'
Hor. Scale: 1"=20'

DATE PREPARED: 03/23/2020

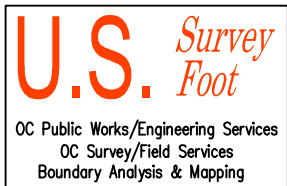

GALIVAN PERIMETER ROAD CL

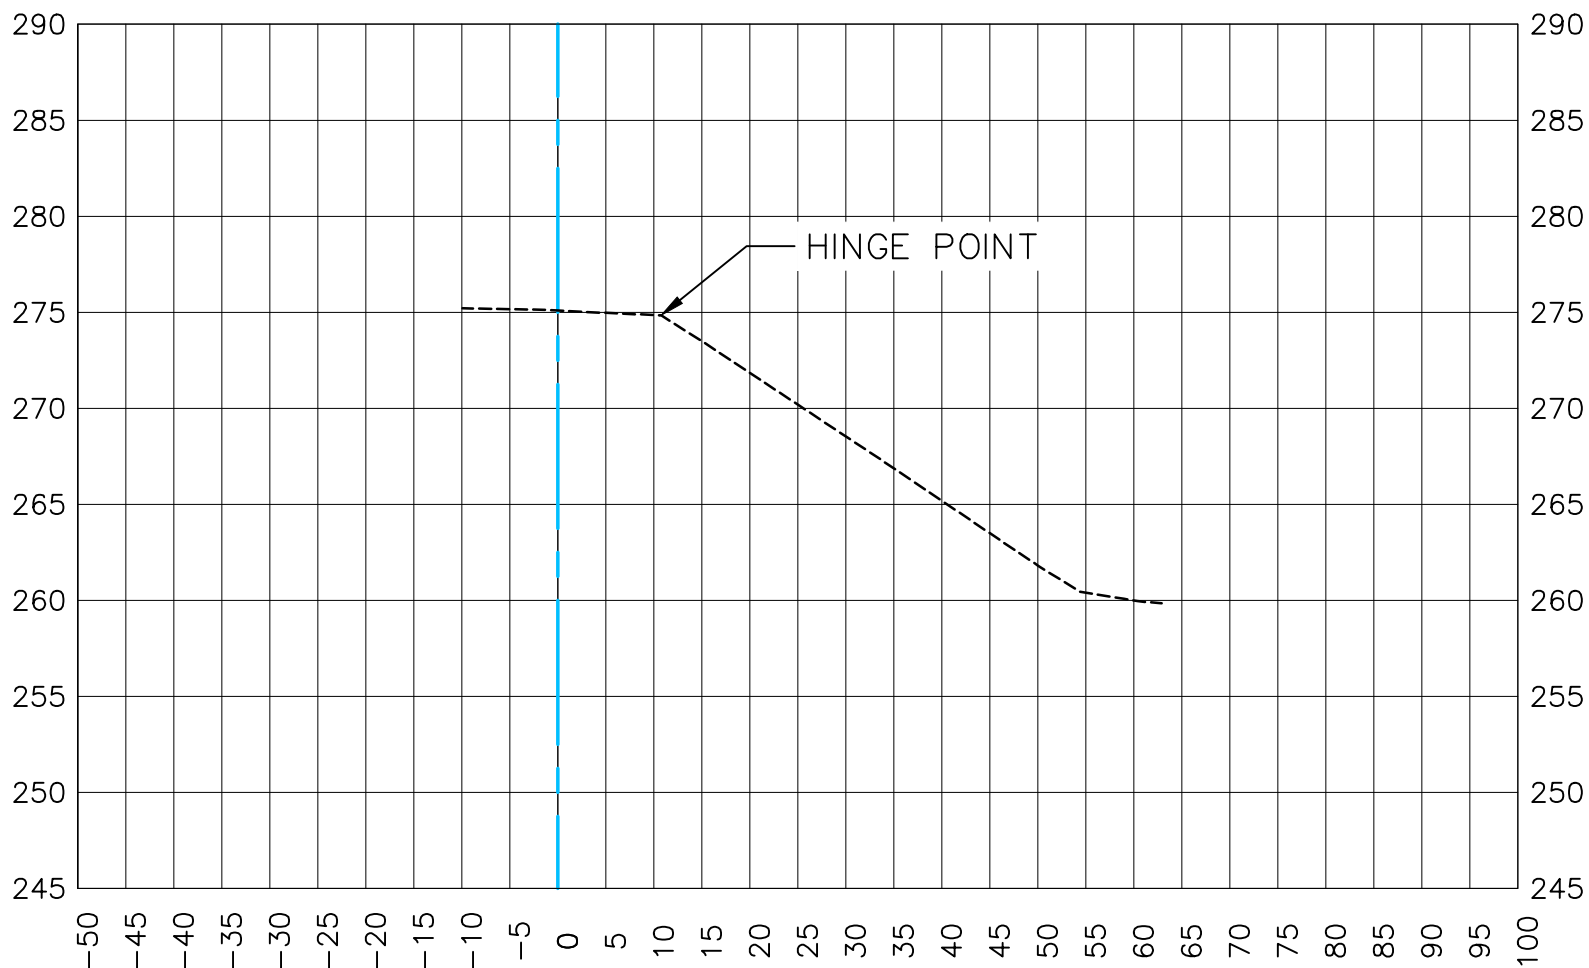

EXISTING CONDITION 2020

Station 47+75.00


Vert. Scale: 1"=5'

Hor. Scale: 1"=20'

DATE PREPARED: 03/23/2020



GALIVAN
PERIMETER ROAD
CL

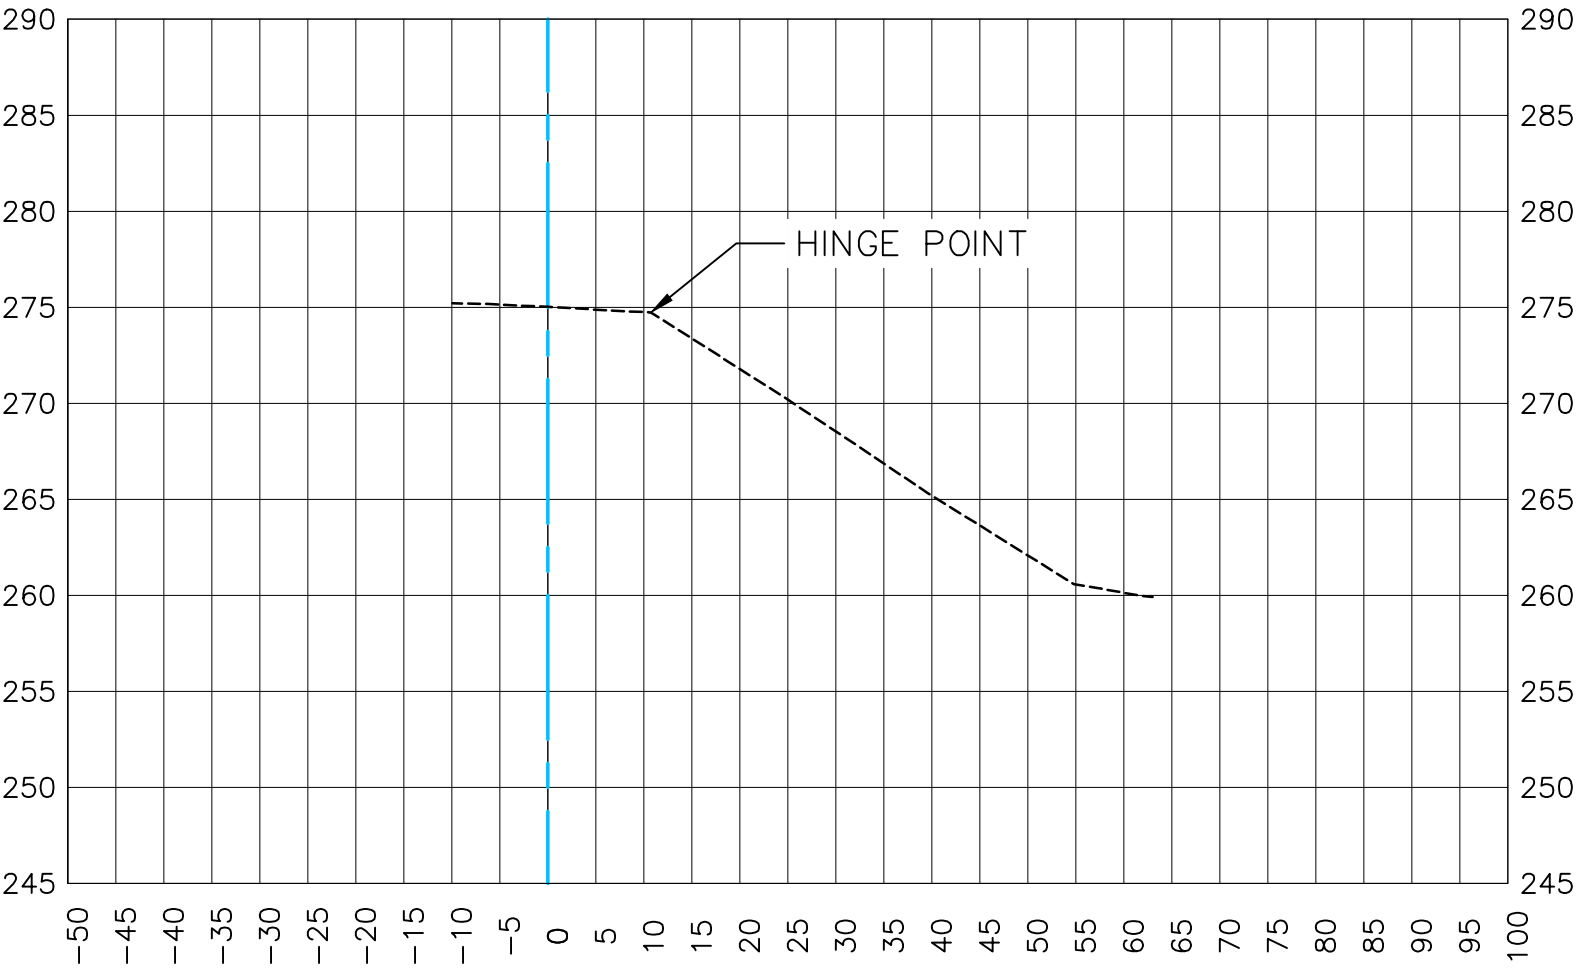

EXISTING CONDITION 2020

Station 48+00.00


Vert. Scale: 1"=5'
Hor. Scale: 1"=20'

DATE PREPARED: 03/23/2020

U.S. Survey Foot


OC Public Works/Engineering Services
OC Survey/Field Services
Boundary Analysis & Mapping

GALIVAN PERIMETER ROAD CL

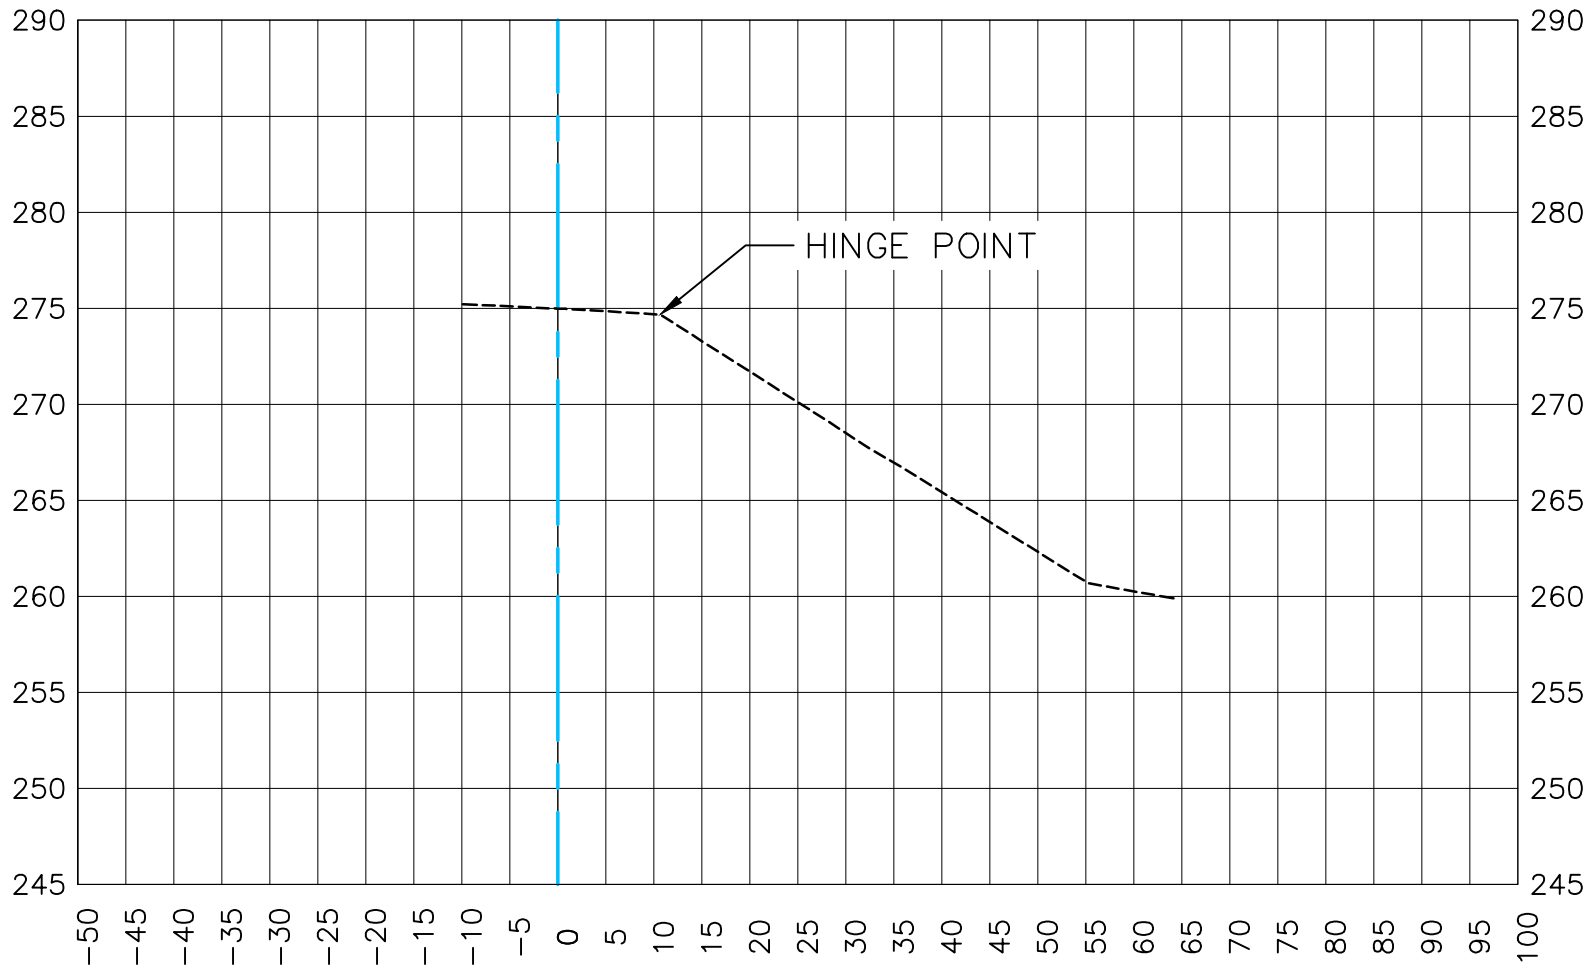


Vert. Scale: 1"=5'
Hor. Scale: 1"=20'

DATE PREPARED: 03/23/2020

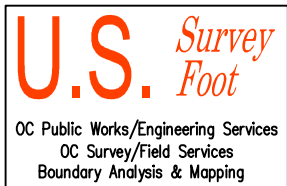

GALIVAN PERIMETER ROAD CL

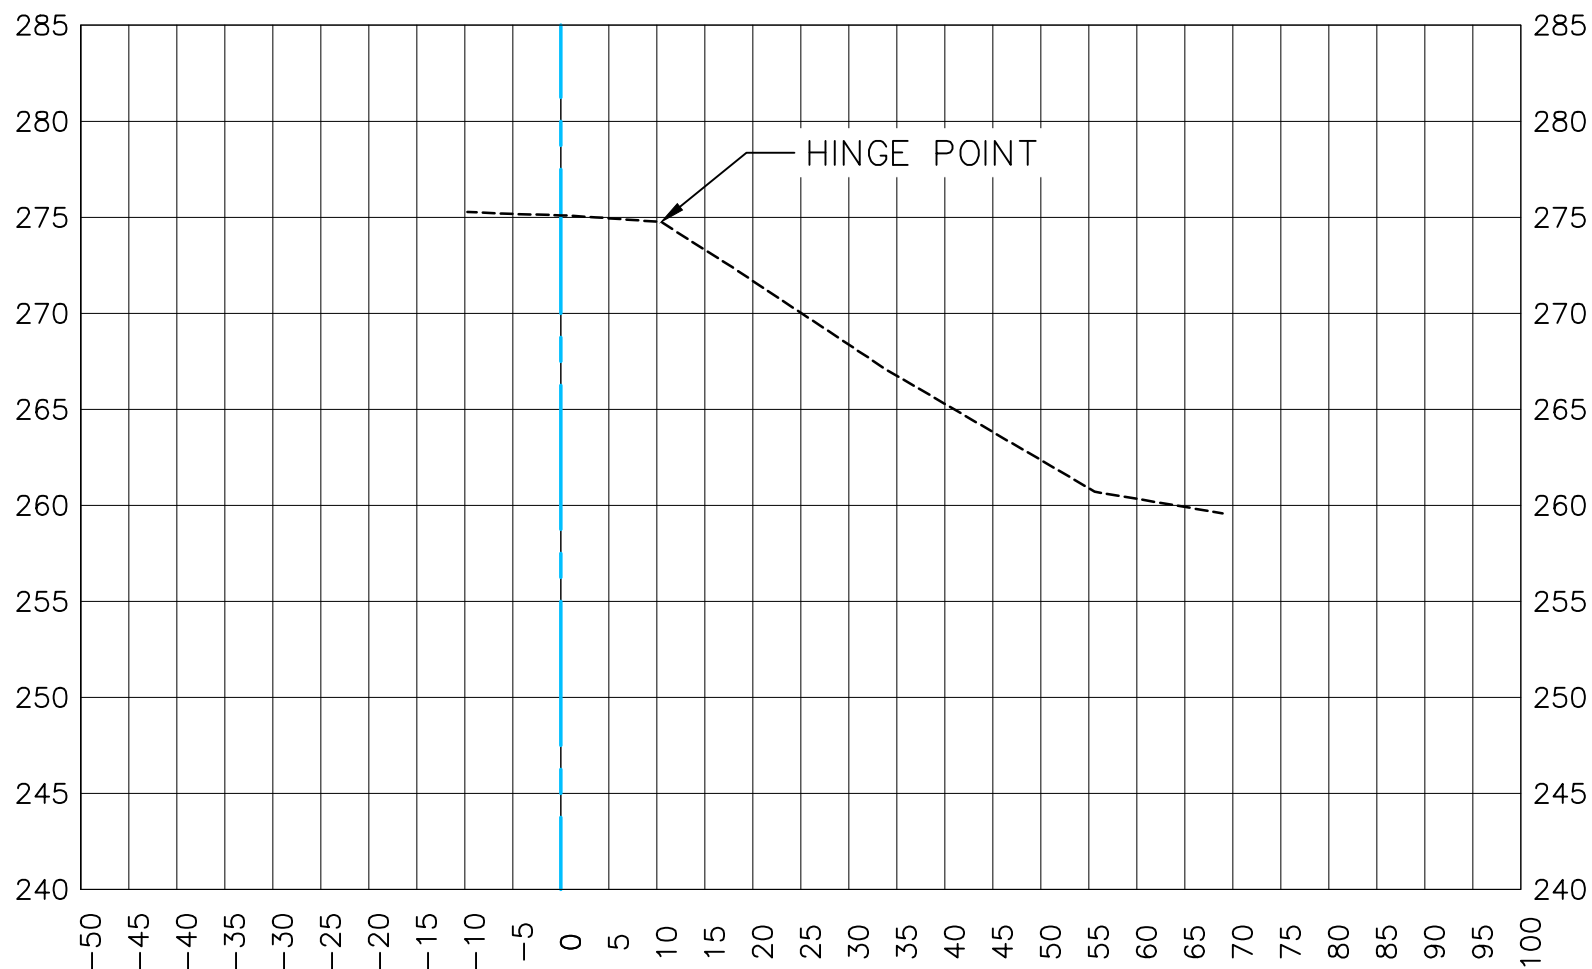


EXISTING CONDITION 2020

Station 48+50.00


Vert. Scale: 1"=5'

Hor. Scale: 1"=20'

DATE PREPARED: 03/23/2020

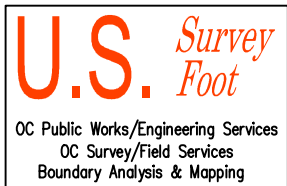

GALIVAN PERIMETER ROAD CL

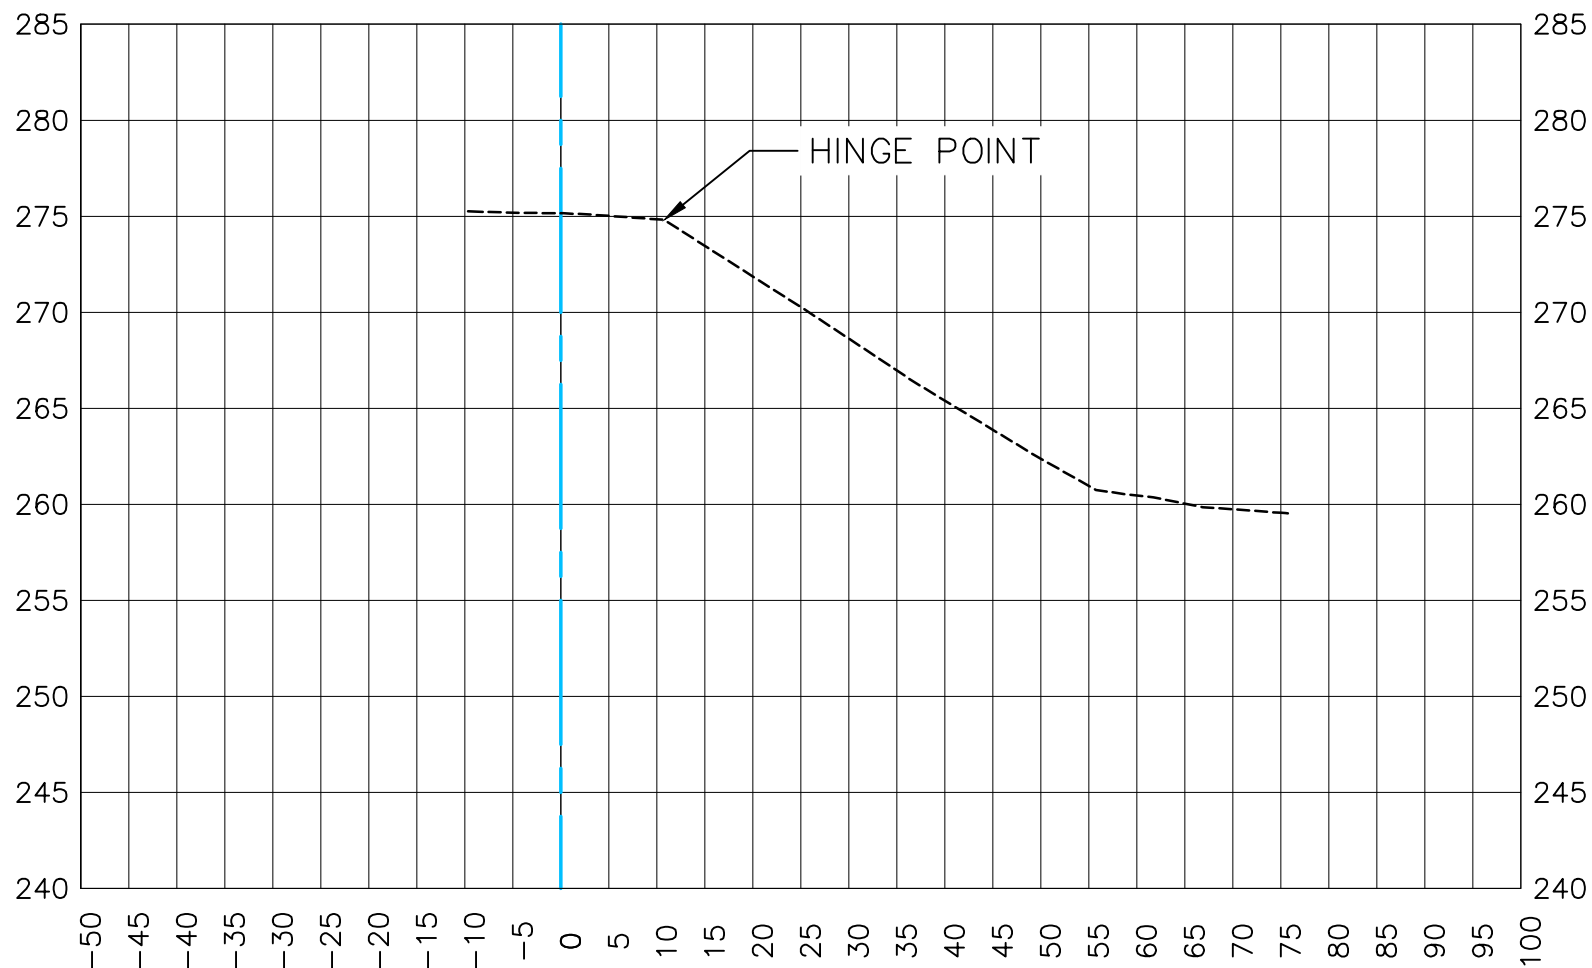


EXISTING CONDITION 2020

Station 48+75.00



Vert. Scale: 1"=5'

Hor. Scale: 1"=20'

DATE PREPARED: 03/23/2020

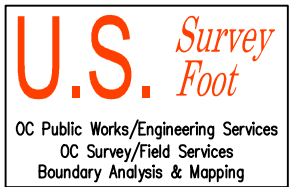

GALIVAN PERIMETER ROAD CL

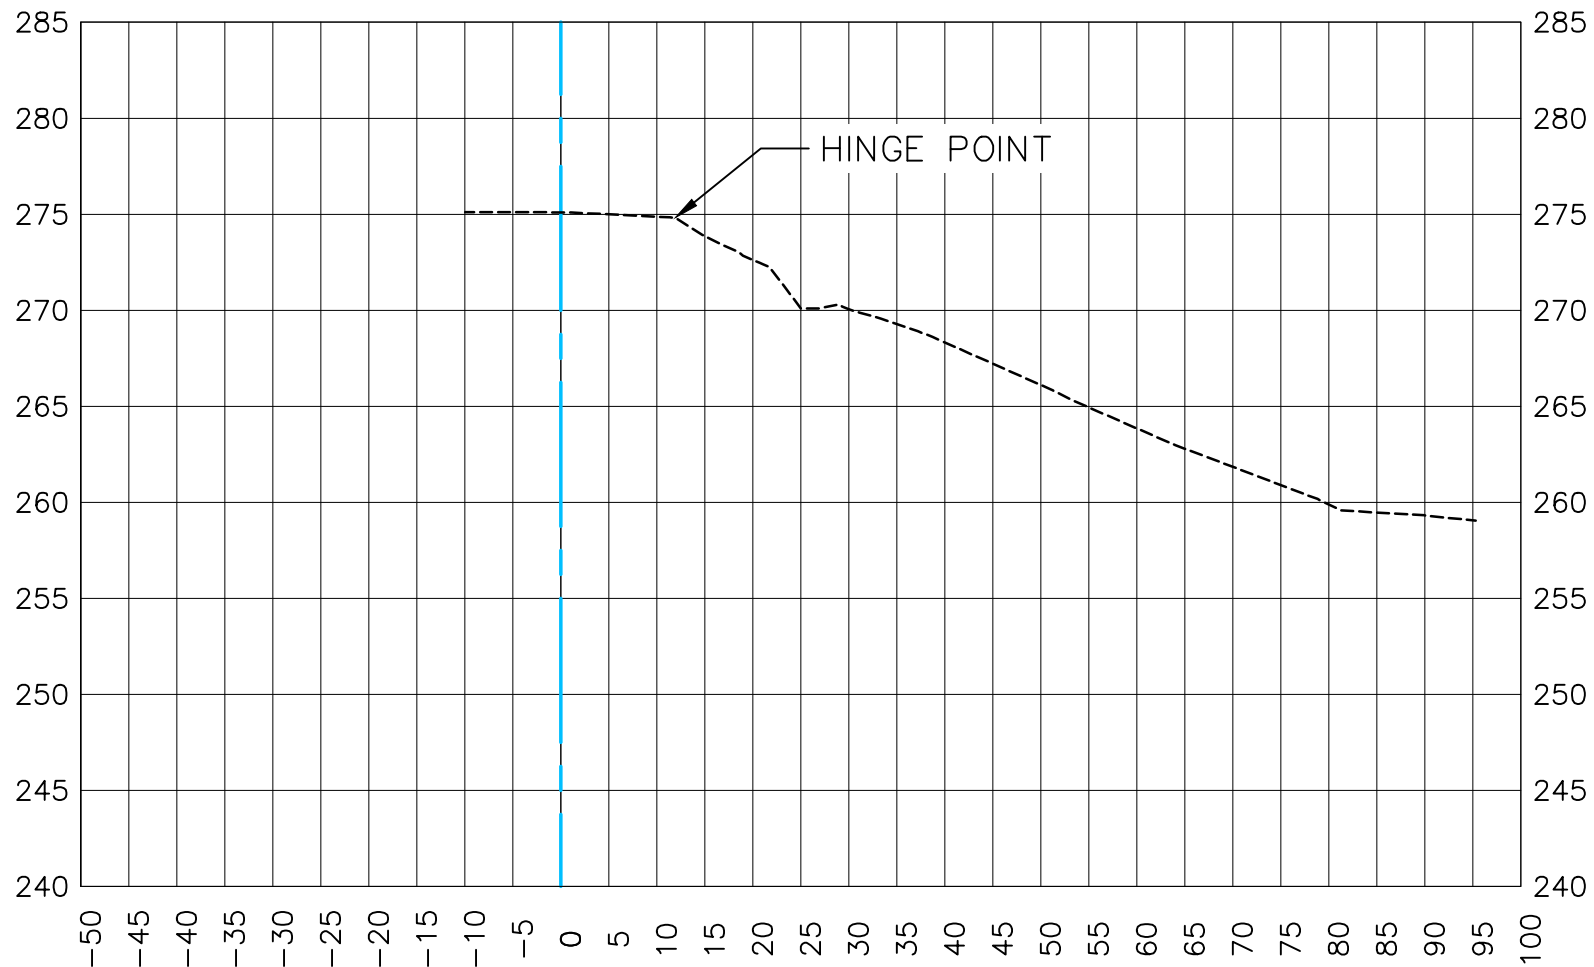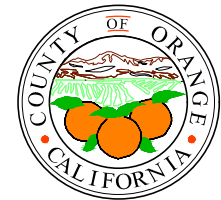

EXISTING CONDITION 2020

Station 49+00.00

Vert. Scale: 1"=5'


Hor. Scale: 1"=20'

DATE PREPARED: 03/23/2020

U.S. Survey Foot

OC Public Works/Engineering Services
OC Survey/Field Services
Boundary Analysis & Mapping

GALIVAN PERIMETER ROAD CL

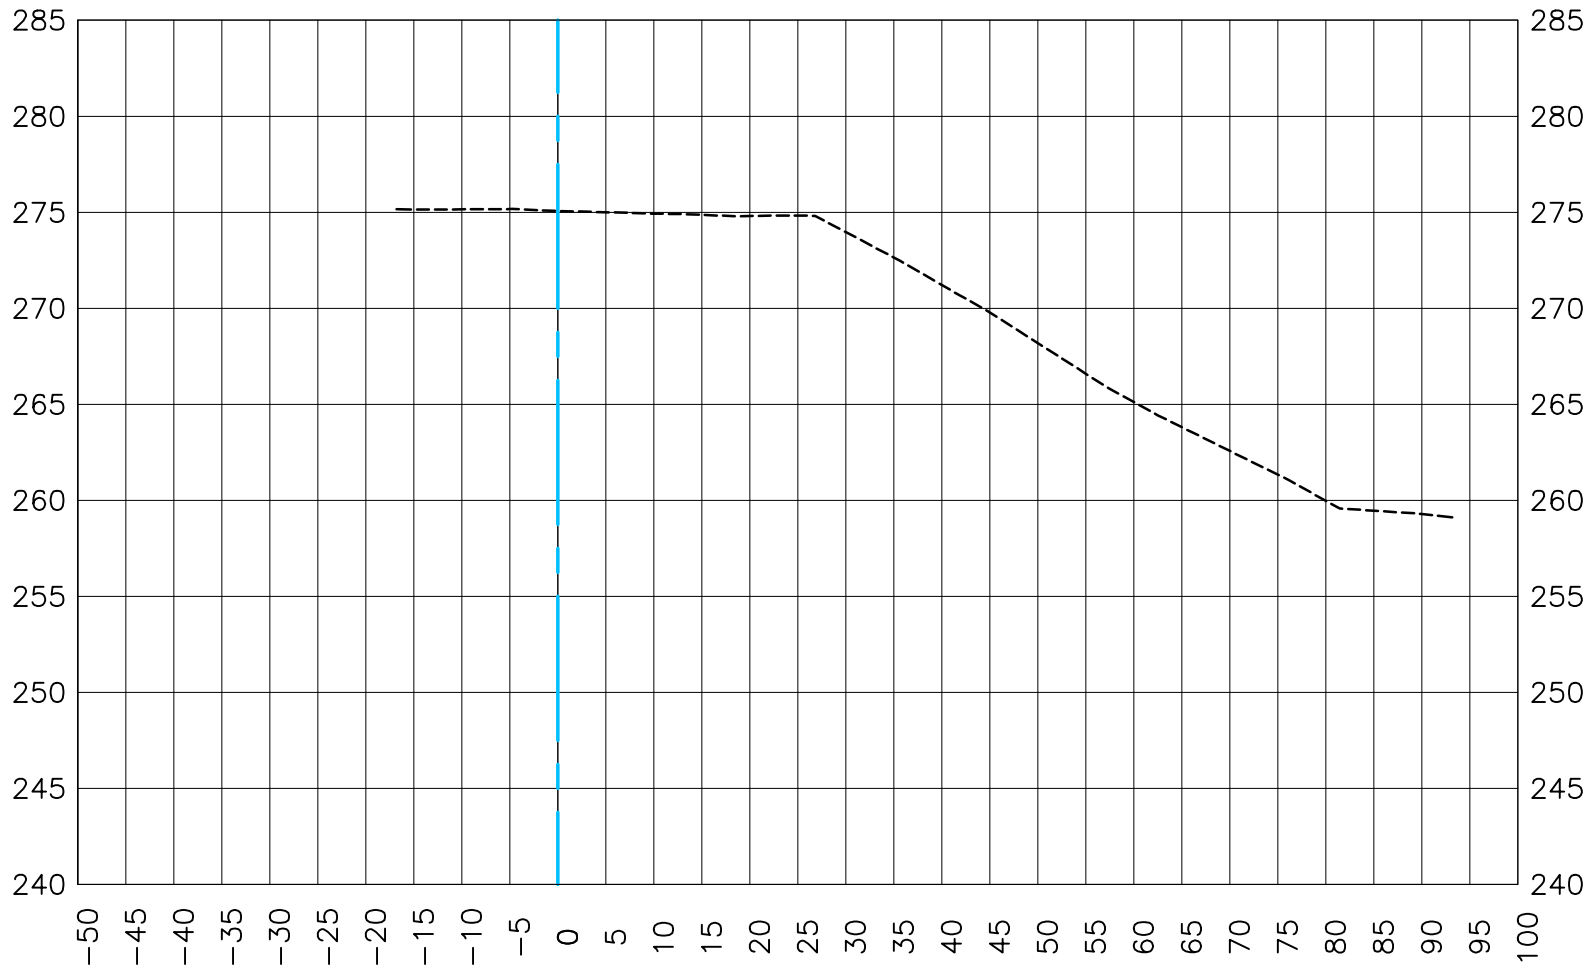

EXISTING CONDITION 2020

Station 49+25.00


Vert. Scale: 1"=5'

Hor. Scale: 1"=20'

DATE PREPARED: 03/23/2020



GALIVAN
PERIMETER ROAD
CL

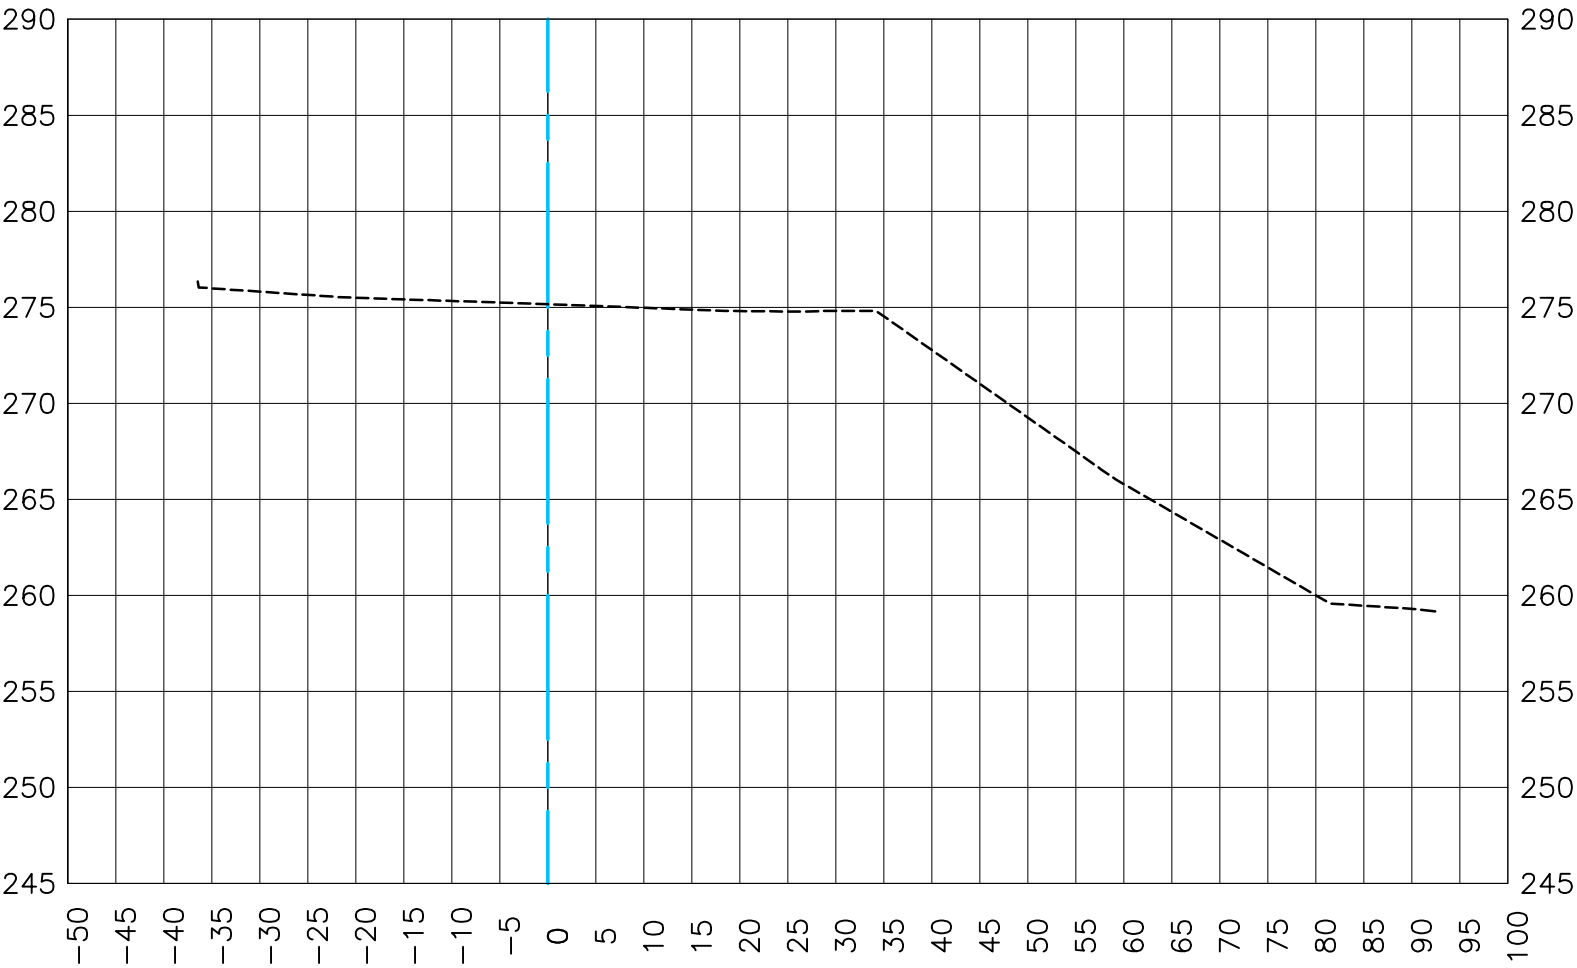

EXISTING CONDITION 2020

Station 49+50.00

Vert. Scale: 1"=5'
Hor. Scale: 1"=20'

DATE PREPARED: 03/23/2020